


92-02-LWL VPL

**SPECIFICATIONS:**

OAL 92.0'  
 BEAM 25'  
 DEPTH 12'  
 DRAFT 7'  
 LWL 82'  
 DISPL 180 TONS  
 CRUISE SPEED --- 10.0 KTS  
 MAX SPEED --- 12.5 KTS

**Crew Separation As Built**

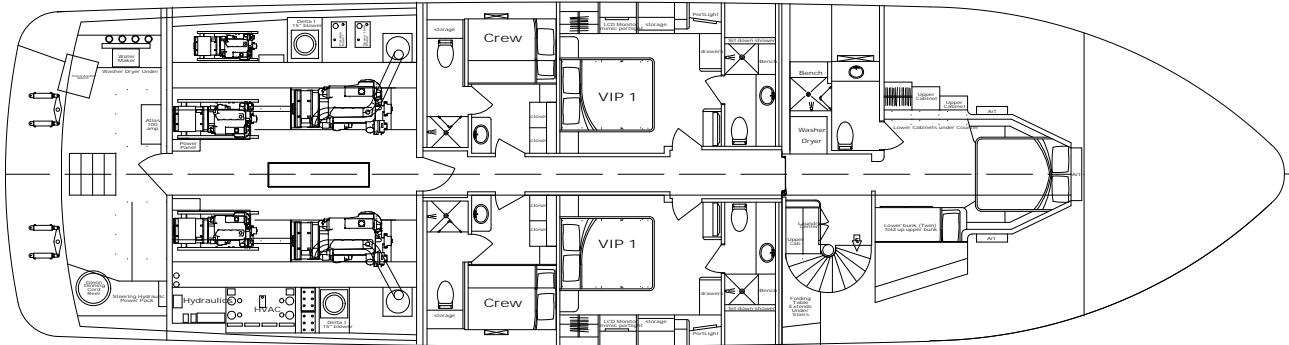

**92 FT, LOWER LEVEL PLAN**

ALL DIMENSIONS ARE IN INCHES UNLESS OTHERWISE SPECIFIED.		MATERIAL		ALLSEAS YACHTS	
TOLERANCES:		DR	CHK	APP	REL
2 PLC DEG ± .06		NAME 92 FT. MAIN DECK PLAN			
3 PLC DEG ± .03		MODEL(S) 92-02			
4 PLC DEG ± .01		CONTRACT NO.			
ANGLES ± 1°		CASE NO.	SCALE	SHEET	DWG NO.
			NTS	1 OF 1	92-02-LWL VPL
				C	REV NC

NC	PRODUCTION RELEASE	DWA	3/06
LTR	REVISION RECORD	APP	DATE

4

3

2

1

C

B

A

THIS INFORMATION IS CONFIDENTIAL AND IS DISCLOSED TO YOU ON CONDITION THAT NO FURTHER DISCLOSURE IS MADE BY YOU TO OTHER THAN ALLSEAS YACHTS PERSONNEL WITHOUT WRITTEN AUTHORIZATION FROM ALLSEAS YACHTS, LLC