


0.0 ← * 74.8 MIDSPAN. BUSINESS ← |

149.6

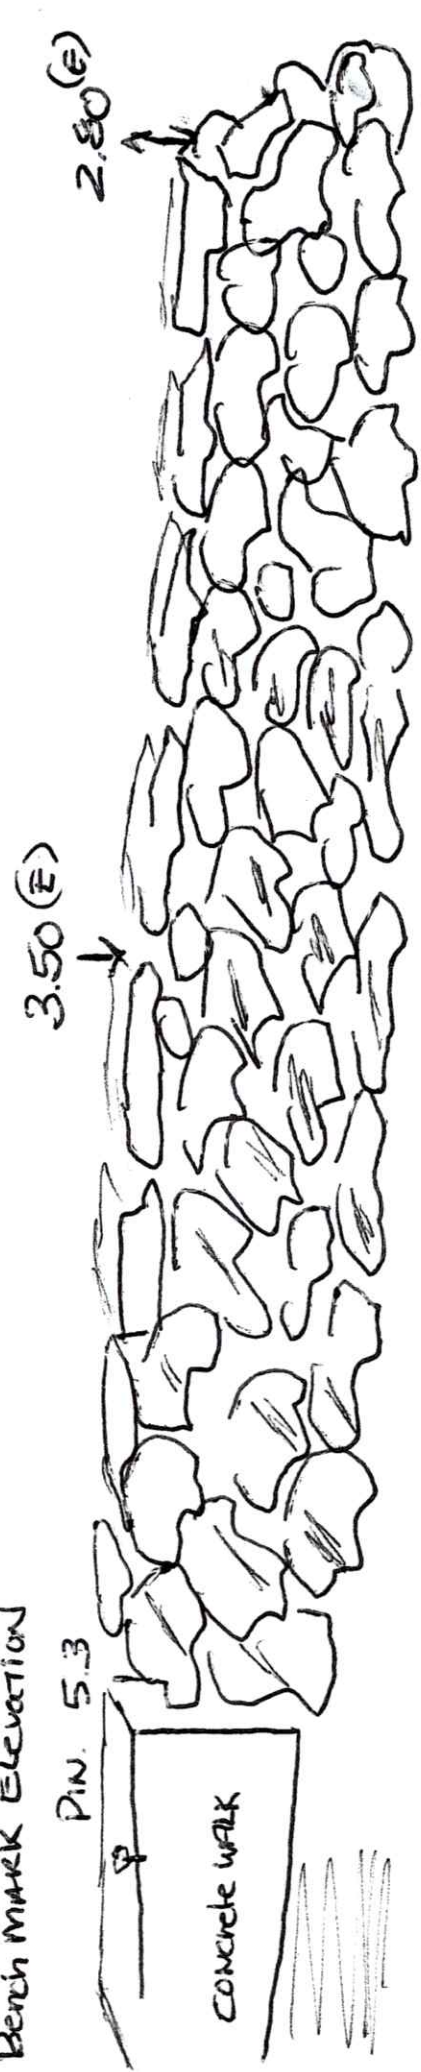

REVIEMENT
STONE REPAIR Pqect.

WIDTH @ BULLNOSE 14'
WIDTH @ NORTH END 15'



AS COURTESY TO
DISTRICT of Chapman Beach
AS BUILT. Per Completed.
3/15/2024

K.E. BRAZA CONSTRUCTION LLC

- Excavation
- Demolition
- Bank Retainment
- Foundations
- Seawalls
- Helical Piles

Office: 860-399-5290
Cell: 860-662-0124
Email: ksbraza@aol.com

Kevin E. Braza
Westbrook, CT

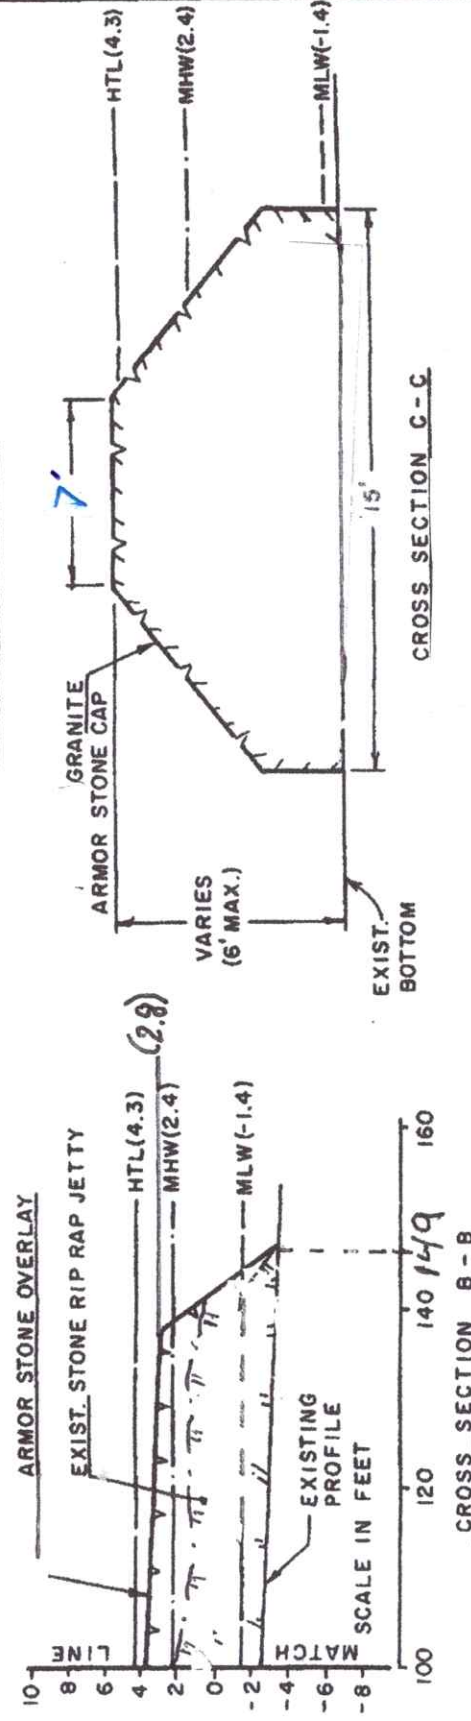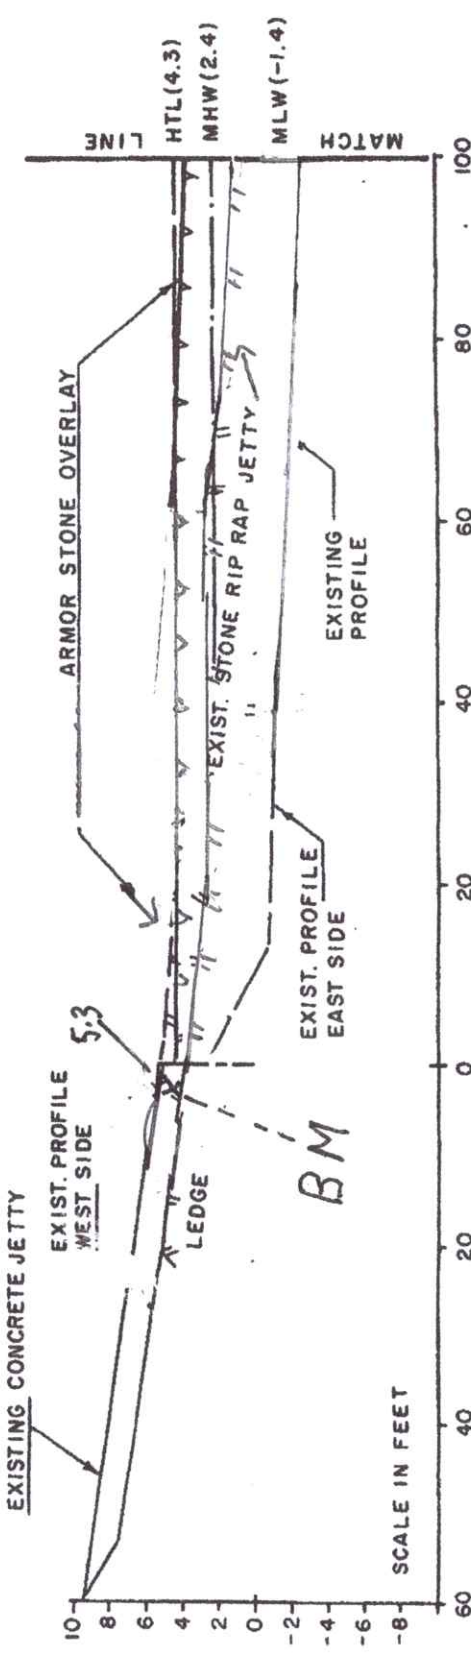

LEGEND

- 5 x 5 SPOT ELEVATION
- 5— CONTOUR
- HTL HIGH TIDE LINE (4.3)
- MHW MEAN HIGH WATER (2.4)
- MLW MEAN LOW WATER (-1.4)

NOTE:
ALL ELEVATIONS REFERENCED TO N.G.V.D MEAN SEA LEVEL DATUM.

DISTRICT OF CHAPMAN BEACH
MAJOR PROJECTS COMMITTEE
UNOFFICIAL AS-BUILT

SHOWING AS-BUILT CONDITIONS
PREPARED FOR
DISTRICT OF CHAPMAN BEACH
CHAPMAN BEACH & HOGAN ROAD
WESTBROOK, CONNECTICUT
DATED: March 17, 2024

Paul McGil
President, District of Chapman Beach
PO Box 356
Westrook, Ct. 06498

Letter of Completion

The repair of the rock jetty at Chapman Beach has been completed in accordance with the Contract Agreement, dated 11/18/2023, following the guidelines of COP-20040177-MG


Contractor
K.E. Braza Construction, LLC

Date Mar. 15/2024