


**3 FIFTH FLOOR PLAN**  
SCALE: 3/16" = 1'-0"



**2 FOURTH FLOOR PLAN**  
SCALE: 3/16" = 1'-0"

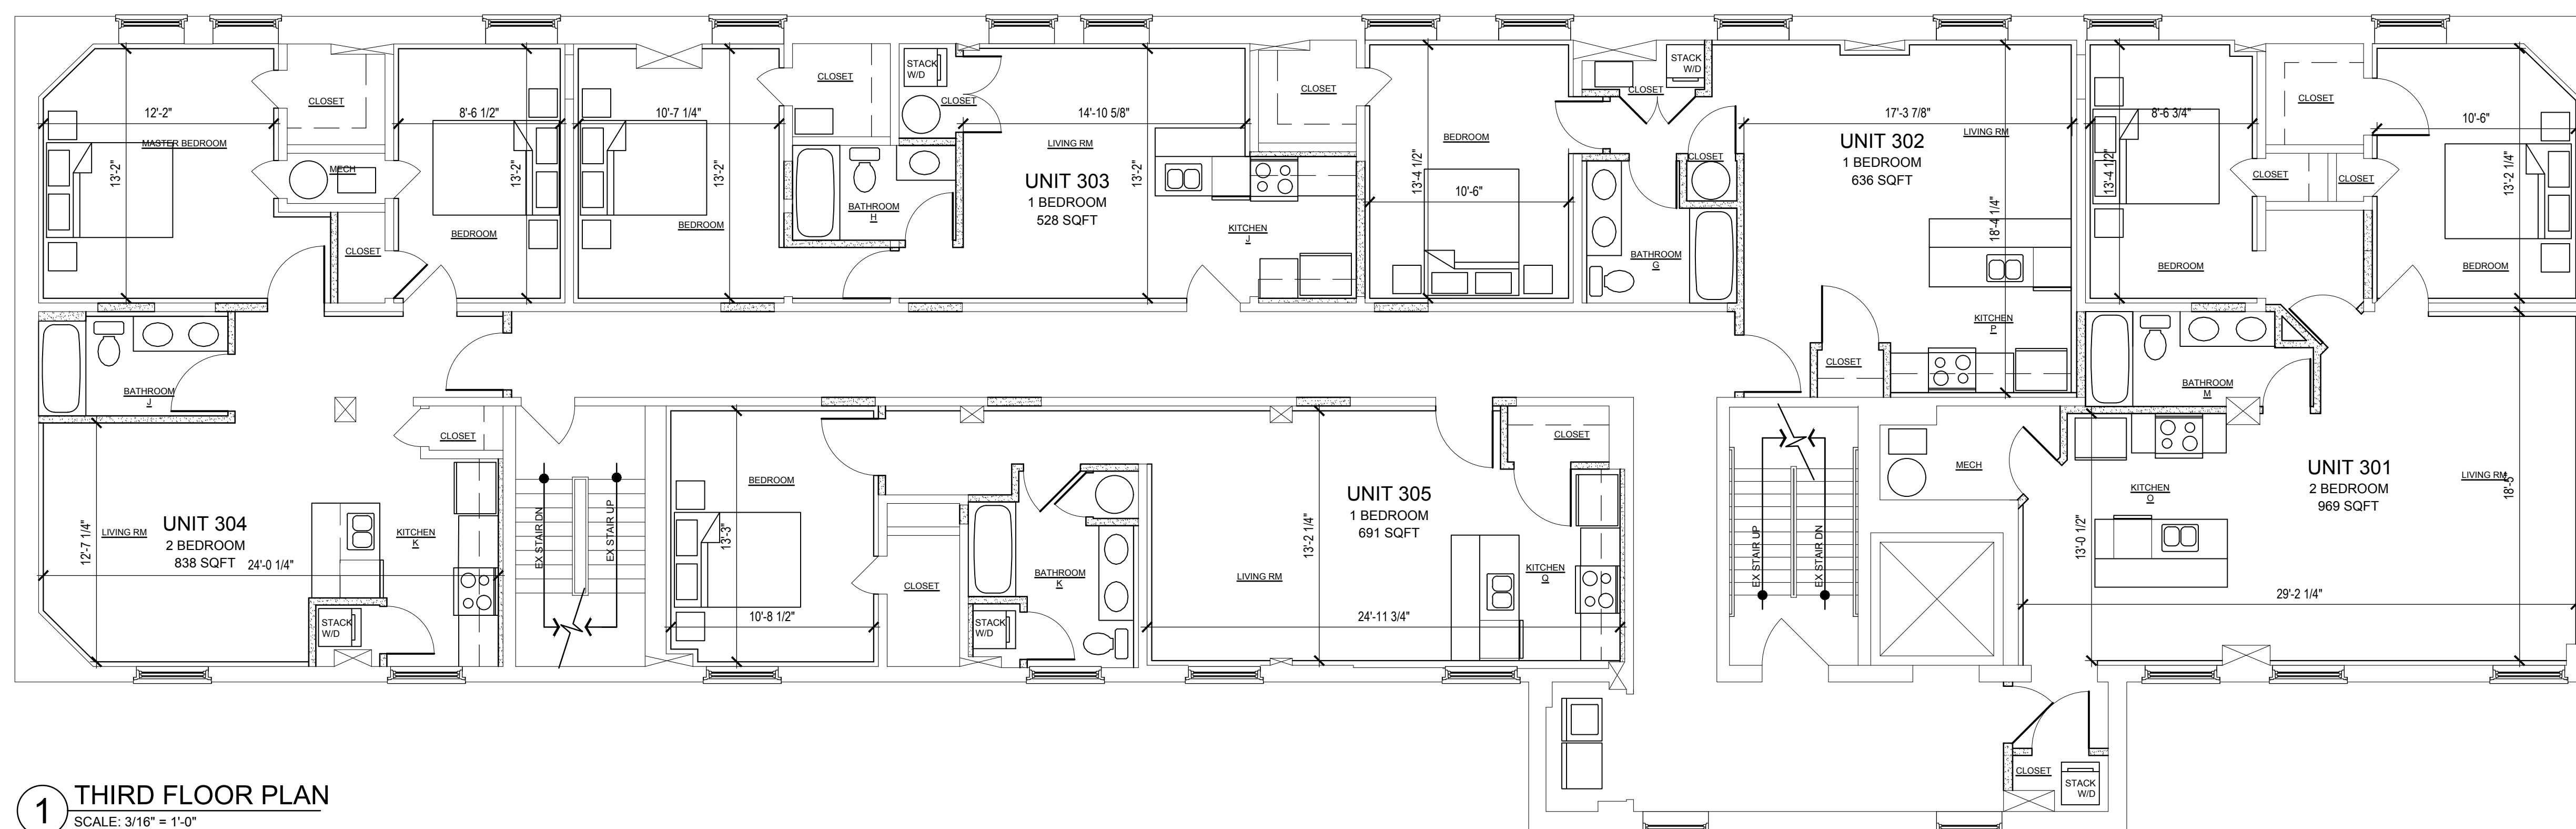

**1 THIRD FLOOR PLAN**  
SCALE: 3/16" = 1'-0"

NOTE: DIMENSIONS INDICATED WHERE APPROPRIATE AT TYPICAL LOCATIONS THROUGHOUT THE DRAWING SHALL BE TAKEN FROM THE FACE OF THE FINISH SURFACE UNLESS OTHERWISE NOTED. ALL DIMENSIONS SHALL BE TAKEN FROM THE FACE OF THE FINISH SURFACE UNLESS OTHERWISE NOTED.

THESE TECHNICAL DRAWINGS AND SPECIFICATIONS (THE "DOCUMENTS") HAVE BEEN PREPARED BY SAA ARCHITECTS, INC. (SAA) FOR THE ARCHITECT AND THE ARCHITECT'S CLIENT. THE DOCUMENTS ARE THE PROPERTY OF SAA ARCHITECTS, INC. AND ARE NOT TO BE REPRODUCED, COPIED, OR TRANSMITTED IN ANY FORM OR BY ANY MEANS, ELECTRONIC OR MECHANICAL, INCLUDING PHOTOCOPYING, RECORDING, OR BY ANY INFORMATION STORAGE AND RETRIEVAL SYSTEM, WITHOUT THE WRITTEN PERMISSION OF SAA ARCHITECTS, INC. THE ARCHITECT AND ARCHITECT'S CLIENT SHALL BE RESPONSIBLE FOR OBTAINING ALL NECESSARY PERMITS AND APPROVALS FROM THE APPROPRIATE AGENCIES AND FOR THE PROTECTION OF THE ARCHITECT AND ARCHITECT'S CLIENT FROM ANY AND ALL CLAIMS, DAMAGES, LOSSES, AND EXPENSES, INCLUDING REASONABLE ATTORNEY'S FEES, THAT MAY BE ASSERTED AGAINST THE ARCHITECT OR ARCHITECT'S CLIENT IN CONNECTION WITH THESE DOCUMENTS.

**SAA architects**  
600 North Liberty Street, Suite 150  
York, PA 17404  
1-717-843-3238 • 717-899-8265  
www.SAAarchitects.com

THIRD, FOURTH & FIFTH FLOOR PLANS  
AS BUILT DRAWINGS FOR:  
**McALLISTER LOFTS**  
11 YORK STREET  
HANOVER, PA 17331

DRAWING TITLE	THIRD, FOURTH & FIFTH FLOOR PLANS
FILE NO.	18-027
DATE	01.07.2020
SCALE	AS NOTED
DRAWN BY	KMS
DRAWING NO.	A-103