
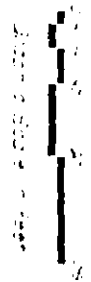


SPRINGDALE LAKE "D" A CONDOMINIUM


OFF REC 1057 pg 7, 9

DRAWN BY
SCHWECKE-SHISKIN & ASSOC. INC.
 1000 SPRINGDALE LAKE AVENUE, SUITE 100
 SPRINGDALE, AR 72762
 (501) 326-1111

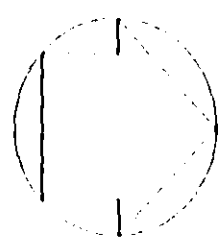

- REVISIONS:**
- 1. 1st Draft Survey, January 2, 1991
 - 2. 2nd Draft Survey, February 12, 1991
 - 3. 3rd Draft Survey, March 12, 1991
 - 4. 4th Draft Survey, April 12, 1991
 - 5. 5th Draft Survey, May 12, 1991
 - 6. 6th Draft Survey, June 12, 1991
 - 7. 7th Draft Survey, July 12, 1991
 - 8. 8th Draft Survey, August 12, 1991
 - 9. 9th Draft Survey, September 12, 1991
 - 10. 10th Draft Survey, October 12, 1991
 - 11. 11th Draft Survey, November 12, 1991
 - 12. 12th Draft Survey, December 12, 1991

Exhibit "A"

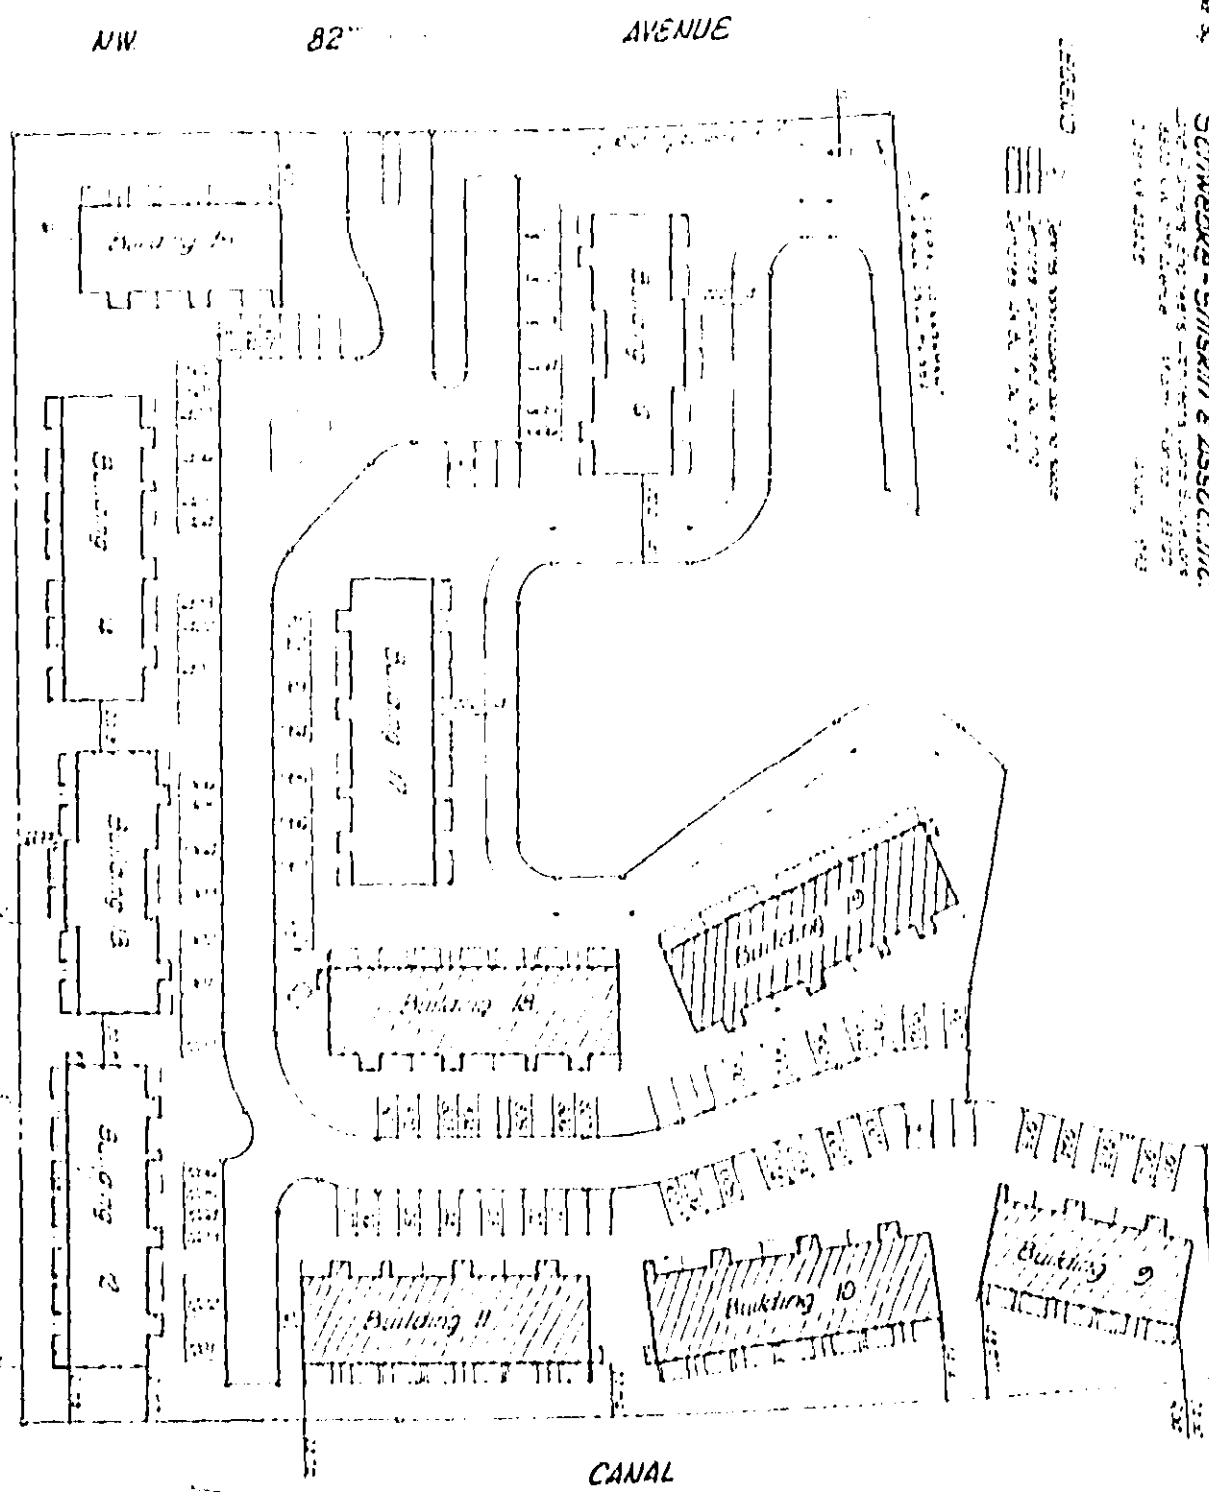

Condominium Site Plan
 Refer to Page 4 for Surveying Information

SPRINGDALE LAKE "D" A CONDOMINIUM

OFFICE
REC 11057pg 72J

The undersigned, a surveyor, duly authorized to practice under the laws of the State of Florida, hereby certifies that the construction of the improvements of the buildings listed herein as being included in an As-Built Survey are substantially complete so that the material, together with the provisions of the Declaration describing the condominium property i.e., Springdale Lake "D" A Condominium, is an accurate representation of the location and dimensions of the improvements, and that the identification, location and dimensions of the Common Elements, Limited Common Elements and of each Unit can be determined from those materials and further that all planned improvements for access, common elements, utilities and landscaping, serving the buildings listed herein as being included in an As-Built Survey have been substantially completed.

SCHWEBKE-SHISKIN & ASSOCIATES, INC.

Signed this 29 day of July, 1985.

By: L. H. Shiskin

Richard P. Shiskin, President
Professional Land Surveyor #075
State of Florida

DATE OF AS-BUILT SURVEY	DEED NUMBER
April 20, 1984	8-21167
June 1, 1984	1-5112
June 1, 1984	1-5112
July 1, 1984	1-5112
July 1, 1984	1-5112
July 1, 1984	1-5112

SURVEYOR'S
CERTIFICATION

Prepared by
Schwebke - Shiskin & Assoc., Inc.
Land Surveyors & Engineers
1400 N.W. 2nd Avenue, Miami, Florida 33135
Order 19143425 10/30/85


SPRINGDALE LAKE "D" A CONDOMINIUM

DESIGNED BY

Schwebke-Shiskin & Assoc., Inc.
 ARCHITECTS & ENGINEERS ARCHITECTS AND SURVEYORS
 6600 K.A. 2ND AVENUE SUITE 2000
 CHICAGO, ILLINOIS 60630

DATE REC'D 1057 PG 721

DATE OF ISSUE 10/23/83

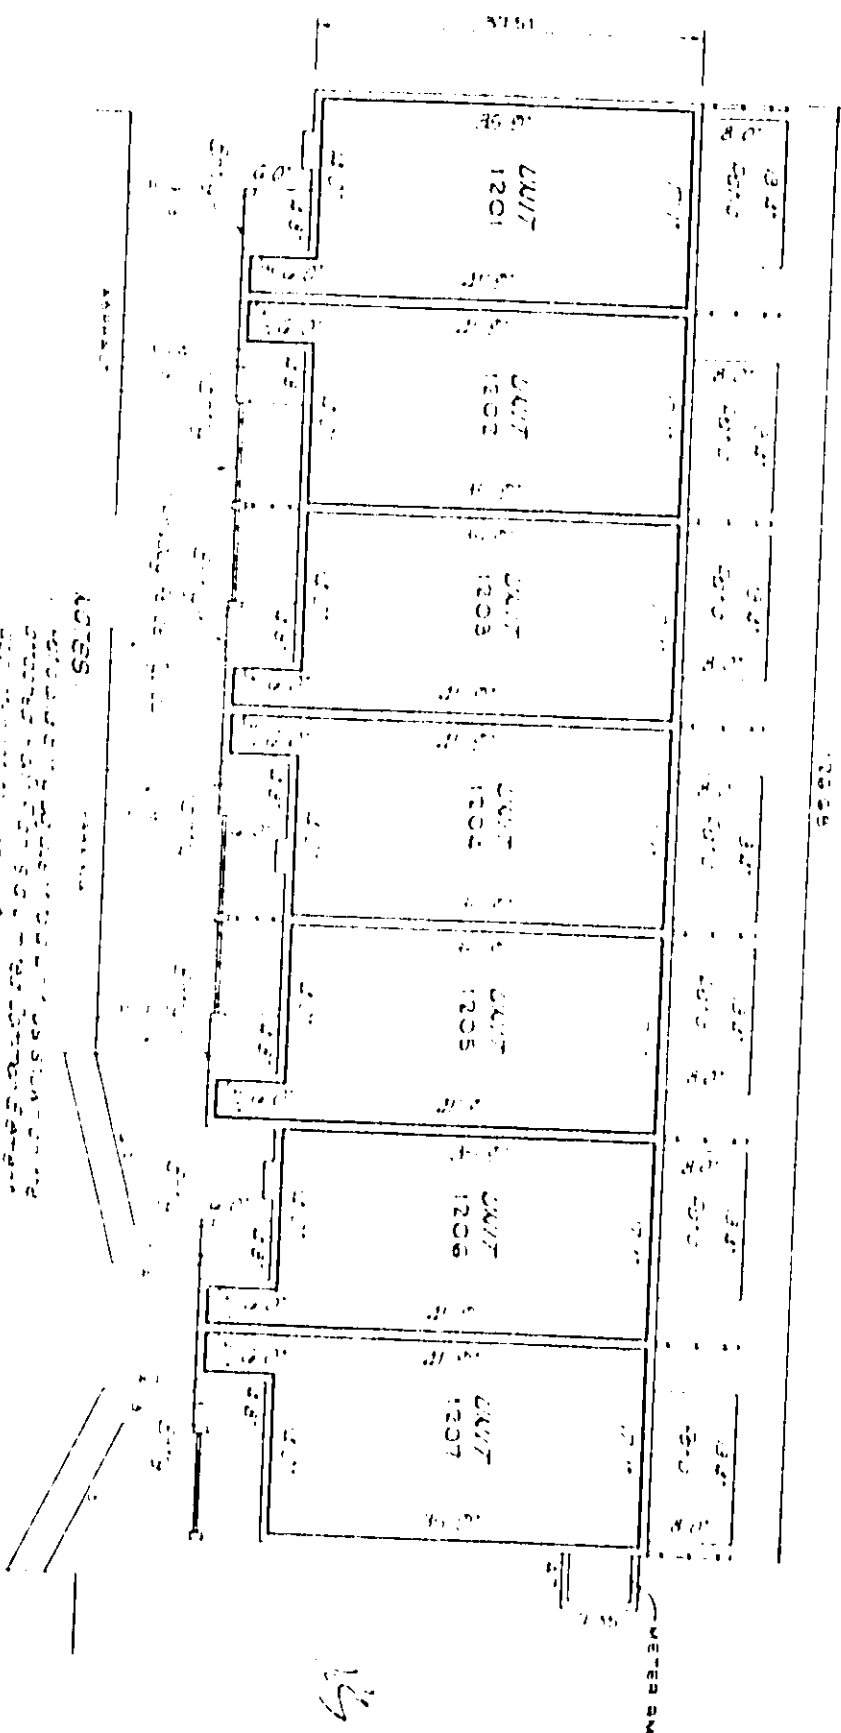

Building 12 First Floor Plan

Elevation of lower levels of unit 1201
 Elevation of upper levels of unit 1201

NOTES:

1. ALL DIMENSIONS ARE TO FACE UNLESS OTHERWISE NOTED.
 2. ALL WALLS ARE 8" THICK CONCRETE.
 3. ALL FLOORS ARE 4" THICK CONCRETE.
 4. ALL CEILINGS ARE 8" THICK CONCRETE.
 5. ALL ROOFS ARE 8" THICK CONCRETE.



SPRINGDALE LAKE "D" A CONDOMINIUM

Drawn by

Schweike-Shislin & Assoc., Inc.

1100 FORMER BUILDING COMPANY BUILDERS
3800 LAKE DRIVE UNIT 4000 38100

CHICAGO, ILL.

DATE: 12/23/83

REF: 1057 PG 722

17' 3"	17' 3"	17' 3"	17' 3"	17' 3"	17' 3"	17' 3"
UNIT 1201	UNIT 1202	UNIT 1203	UNIT 1204	UNIT 1205	UNIT 1206	UNIT 1207
6' 4"	6' 4"	6' 4"	6' 4"	6' 4"	6' 4"	6' 4"
12' 3"	12' 3"	12' 3"	12' 3"	12' 3"	12' 3"	12' 3"

725

Building 12 Second Floor Plan

Elevation of lower limits of Unit Boundary
Elevation of upper limits of Unit Boundary

12' 3"
27' 5"

3' 3" (measured ceiling)

0 3 7 2 3 25
Graphic Scale in Feet


SPRINGDALE LAKE "D" A CONDOMINIUM

OWNER

Schwebke - Shiskin & Assoc., Inc.

SEE 1057 pg 7 & 3

1000 SPRINGDALE LAKE "D" A CONDOMINIUM

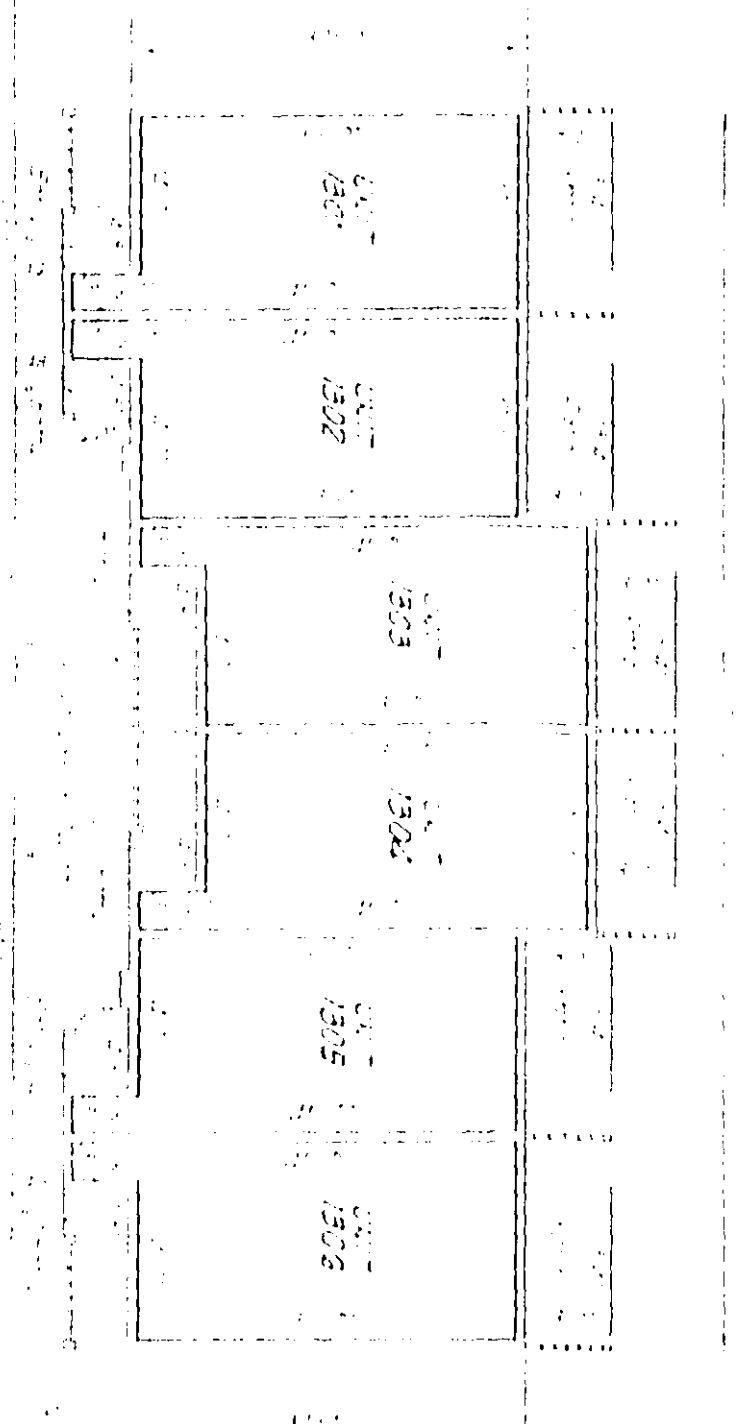

Building 13
First Floor Plan

1000

SPRINGDALE LAKE "D" A CONDOMINIUM


Prepared by

Schwebke-Shiskin & Assoc. Inc.

1000 Somerset Square, Suite 100, Springfield, MA 01103
 (413) 271-1111 FAX (413) 271-1112

REC 11057 PG 744

REGISTERED PROFESSIONAL
 ARCHITECT
 F. T. JOHNSON
 1000 Somerset Square, Suite 100, Springfield, MA 01103

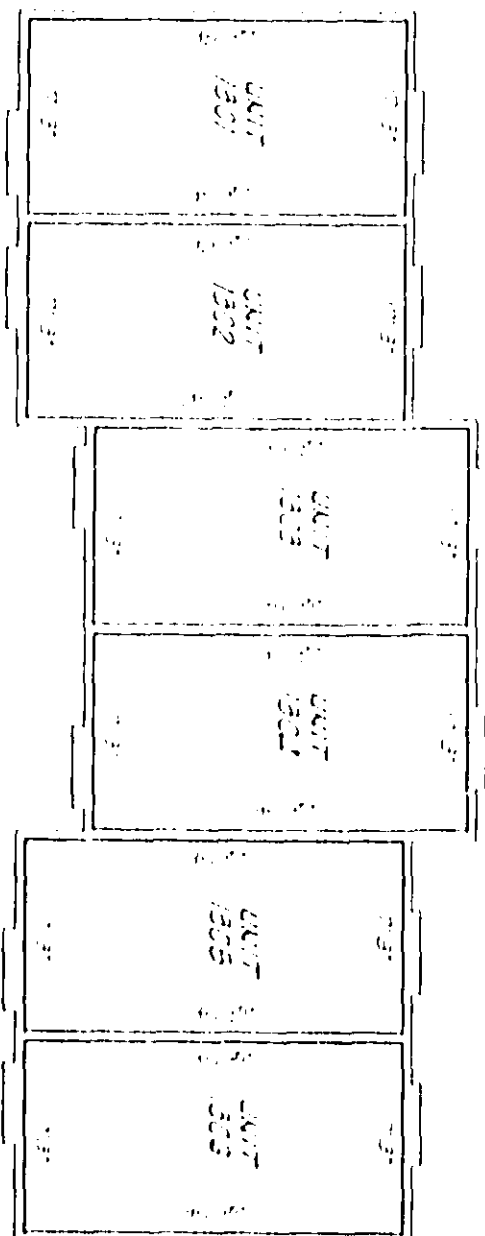

Building 13 Second Floor Plan

Scale of drawing: 1/8" = 1'-0"
 Date: 10/1/83

Scale: 1/8" = 1'-0"