


1 SITE PLAN
1/8" = 1'-0"

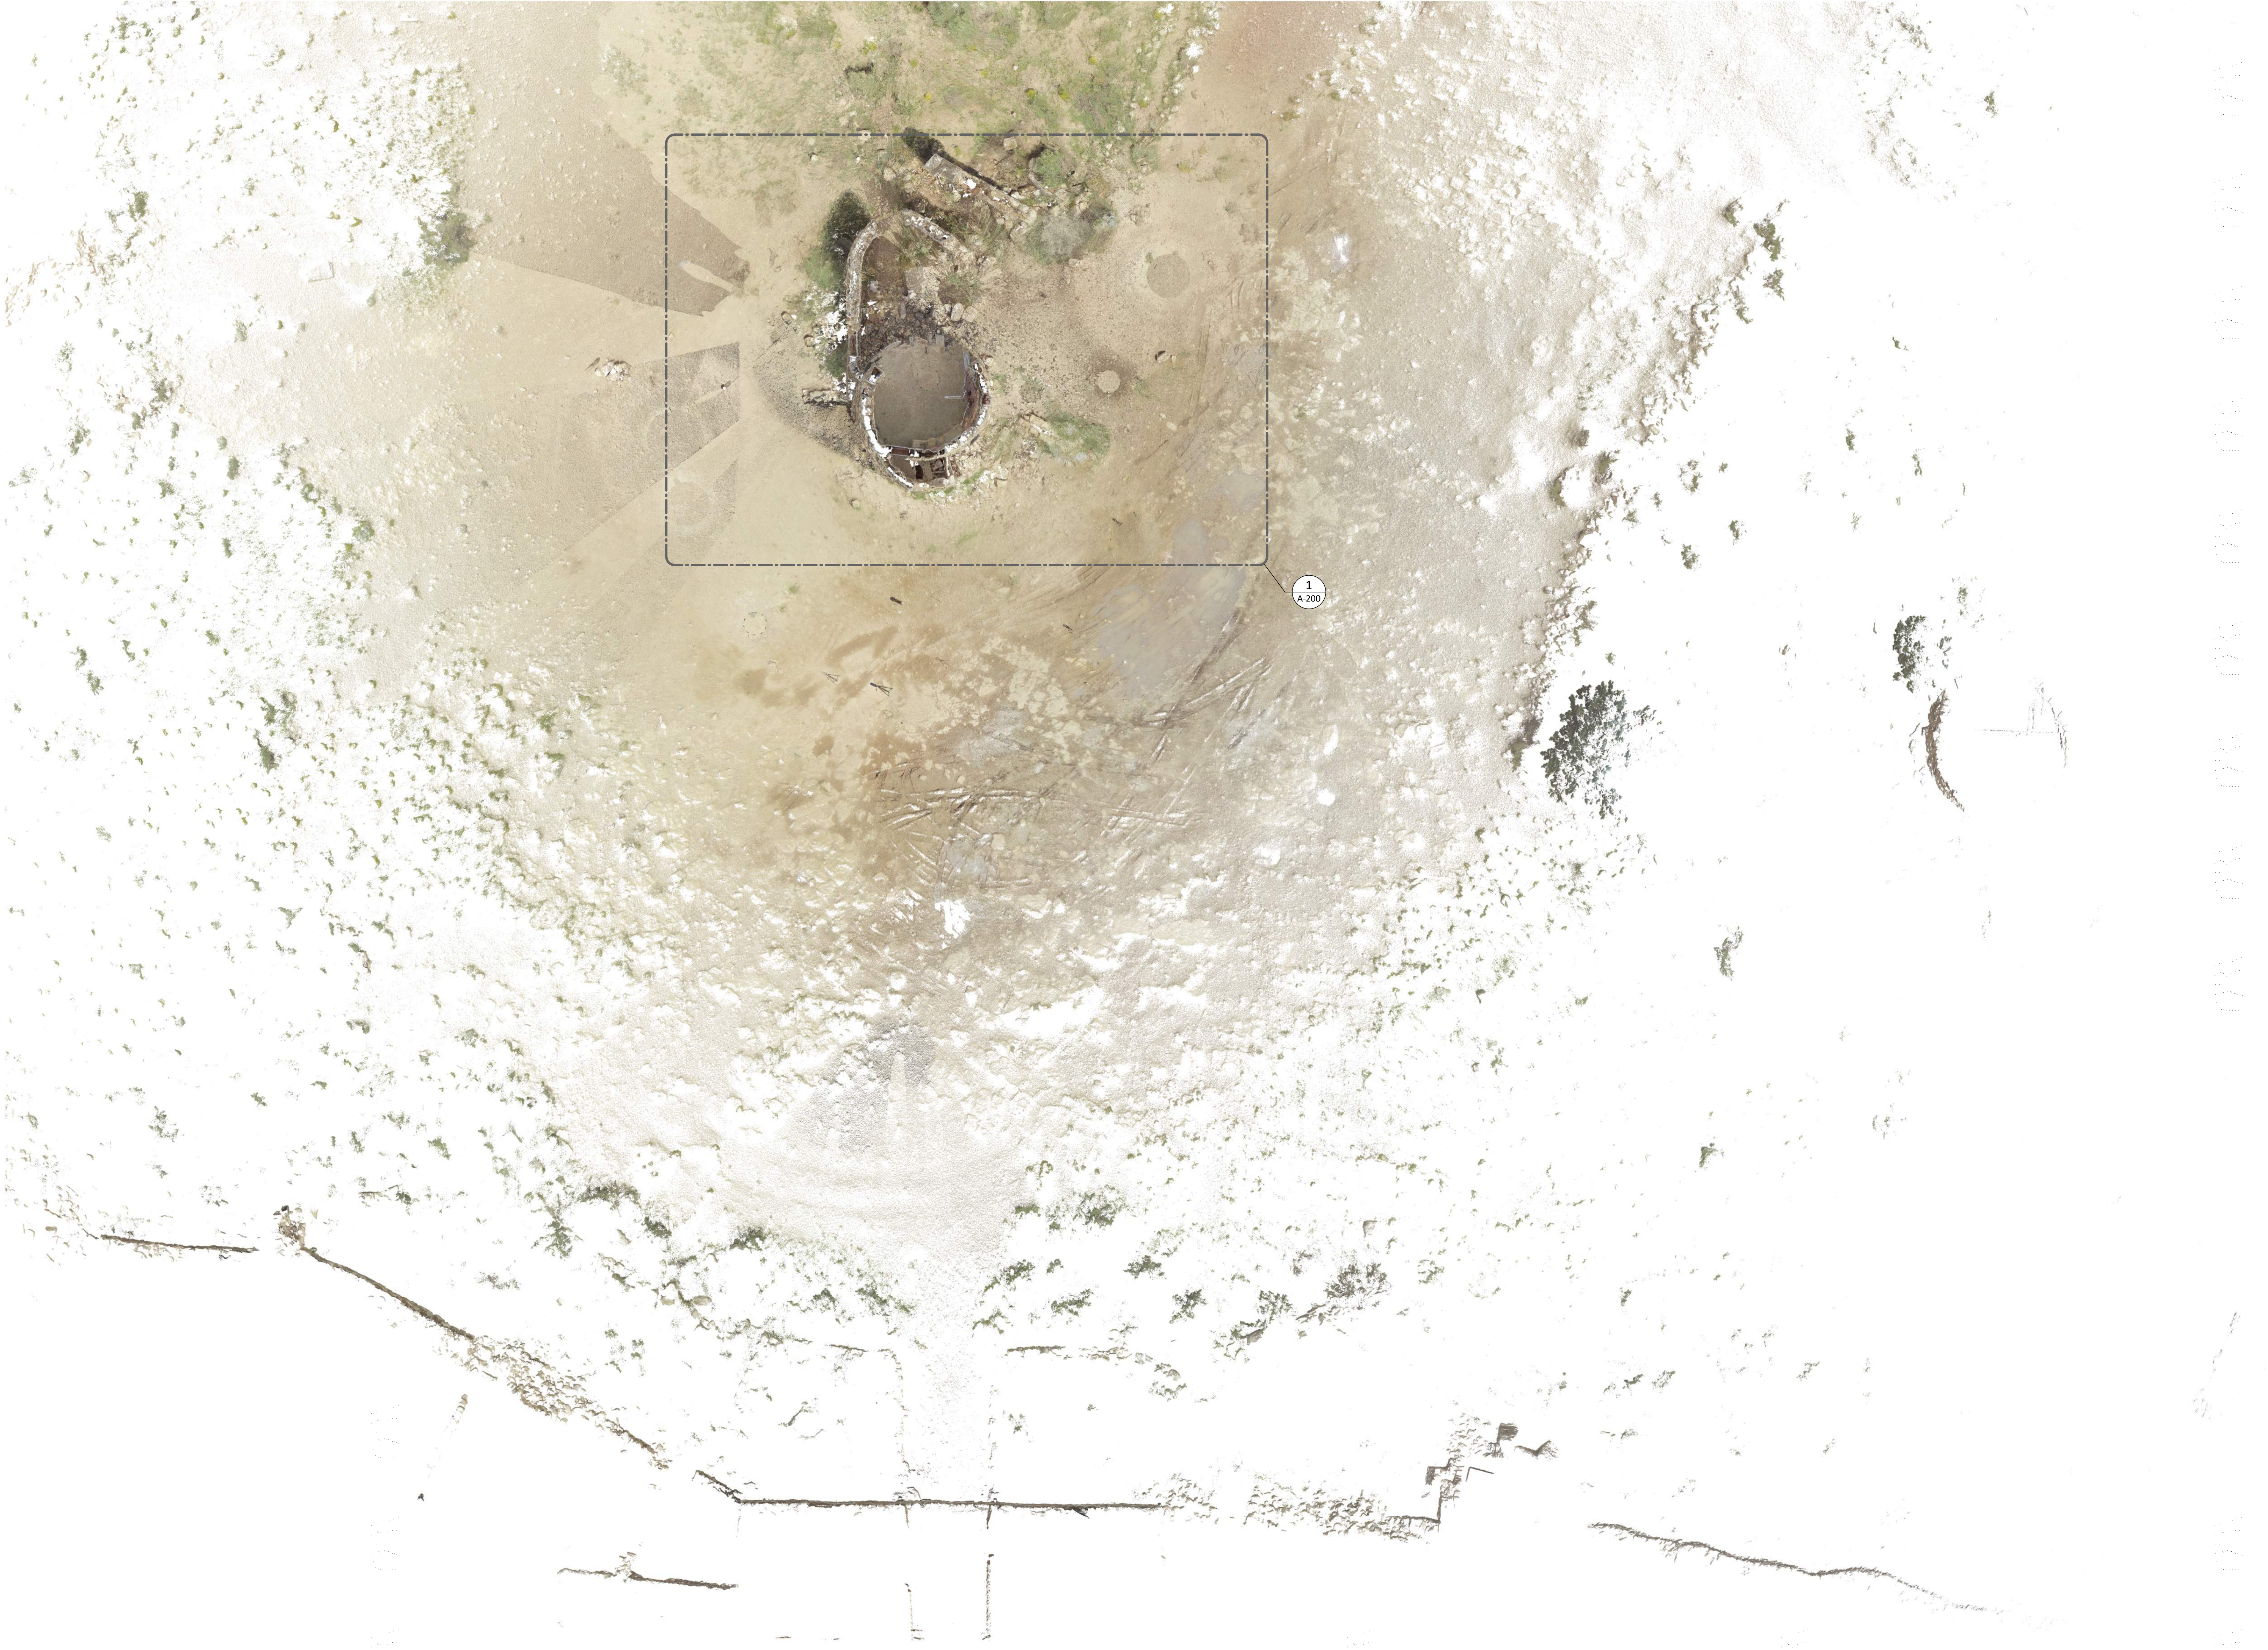

ROUND HOUSE / TOWER RUINS
2 GUNS ARIZONA
2 GUNS
WINSLOW, AZ. 86047

REV	DATE	DESCRIPTION
-----	------	-------------

PROJECT #

23-0101

DATE

01/03/2023

SHEET TITLE

SITE PLAN

SHEET #


A-100

AS-BUILT
EXISTING CONDITIONS DOCUMENT
NOT FOR CONSTRUCTION

LINE & CIRCLE
www.LC3d.com

This drawing is the property of Line & Circle, L.L.C., 344 S. Delaware St., New, AZ 85001, (602) 770-1535. This drawing is limited to the original use for which it was prepared. Changes, reproductions, or copying to any third party of this drawing for any other use is not permitted without written consent of Line & Circle, L.L.C.

1/9/2023 5:05:54 PM

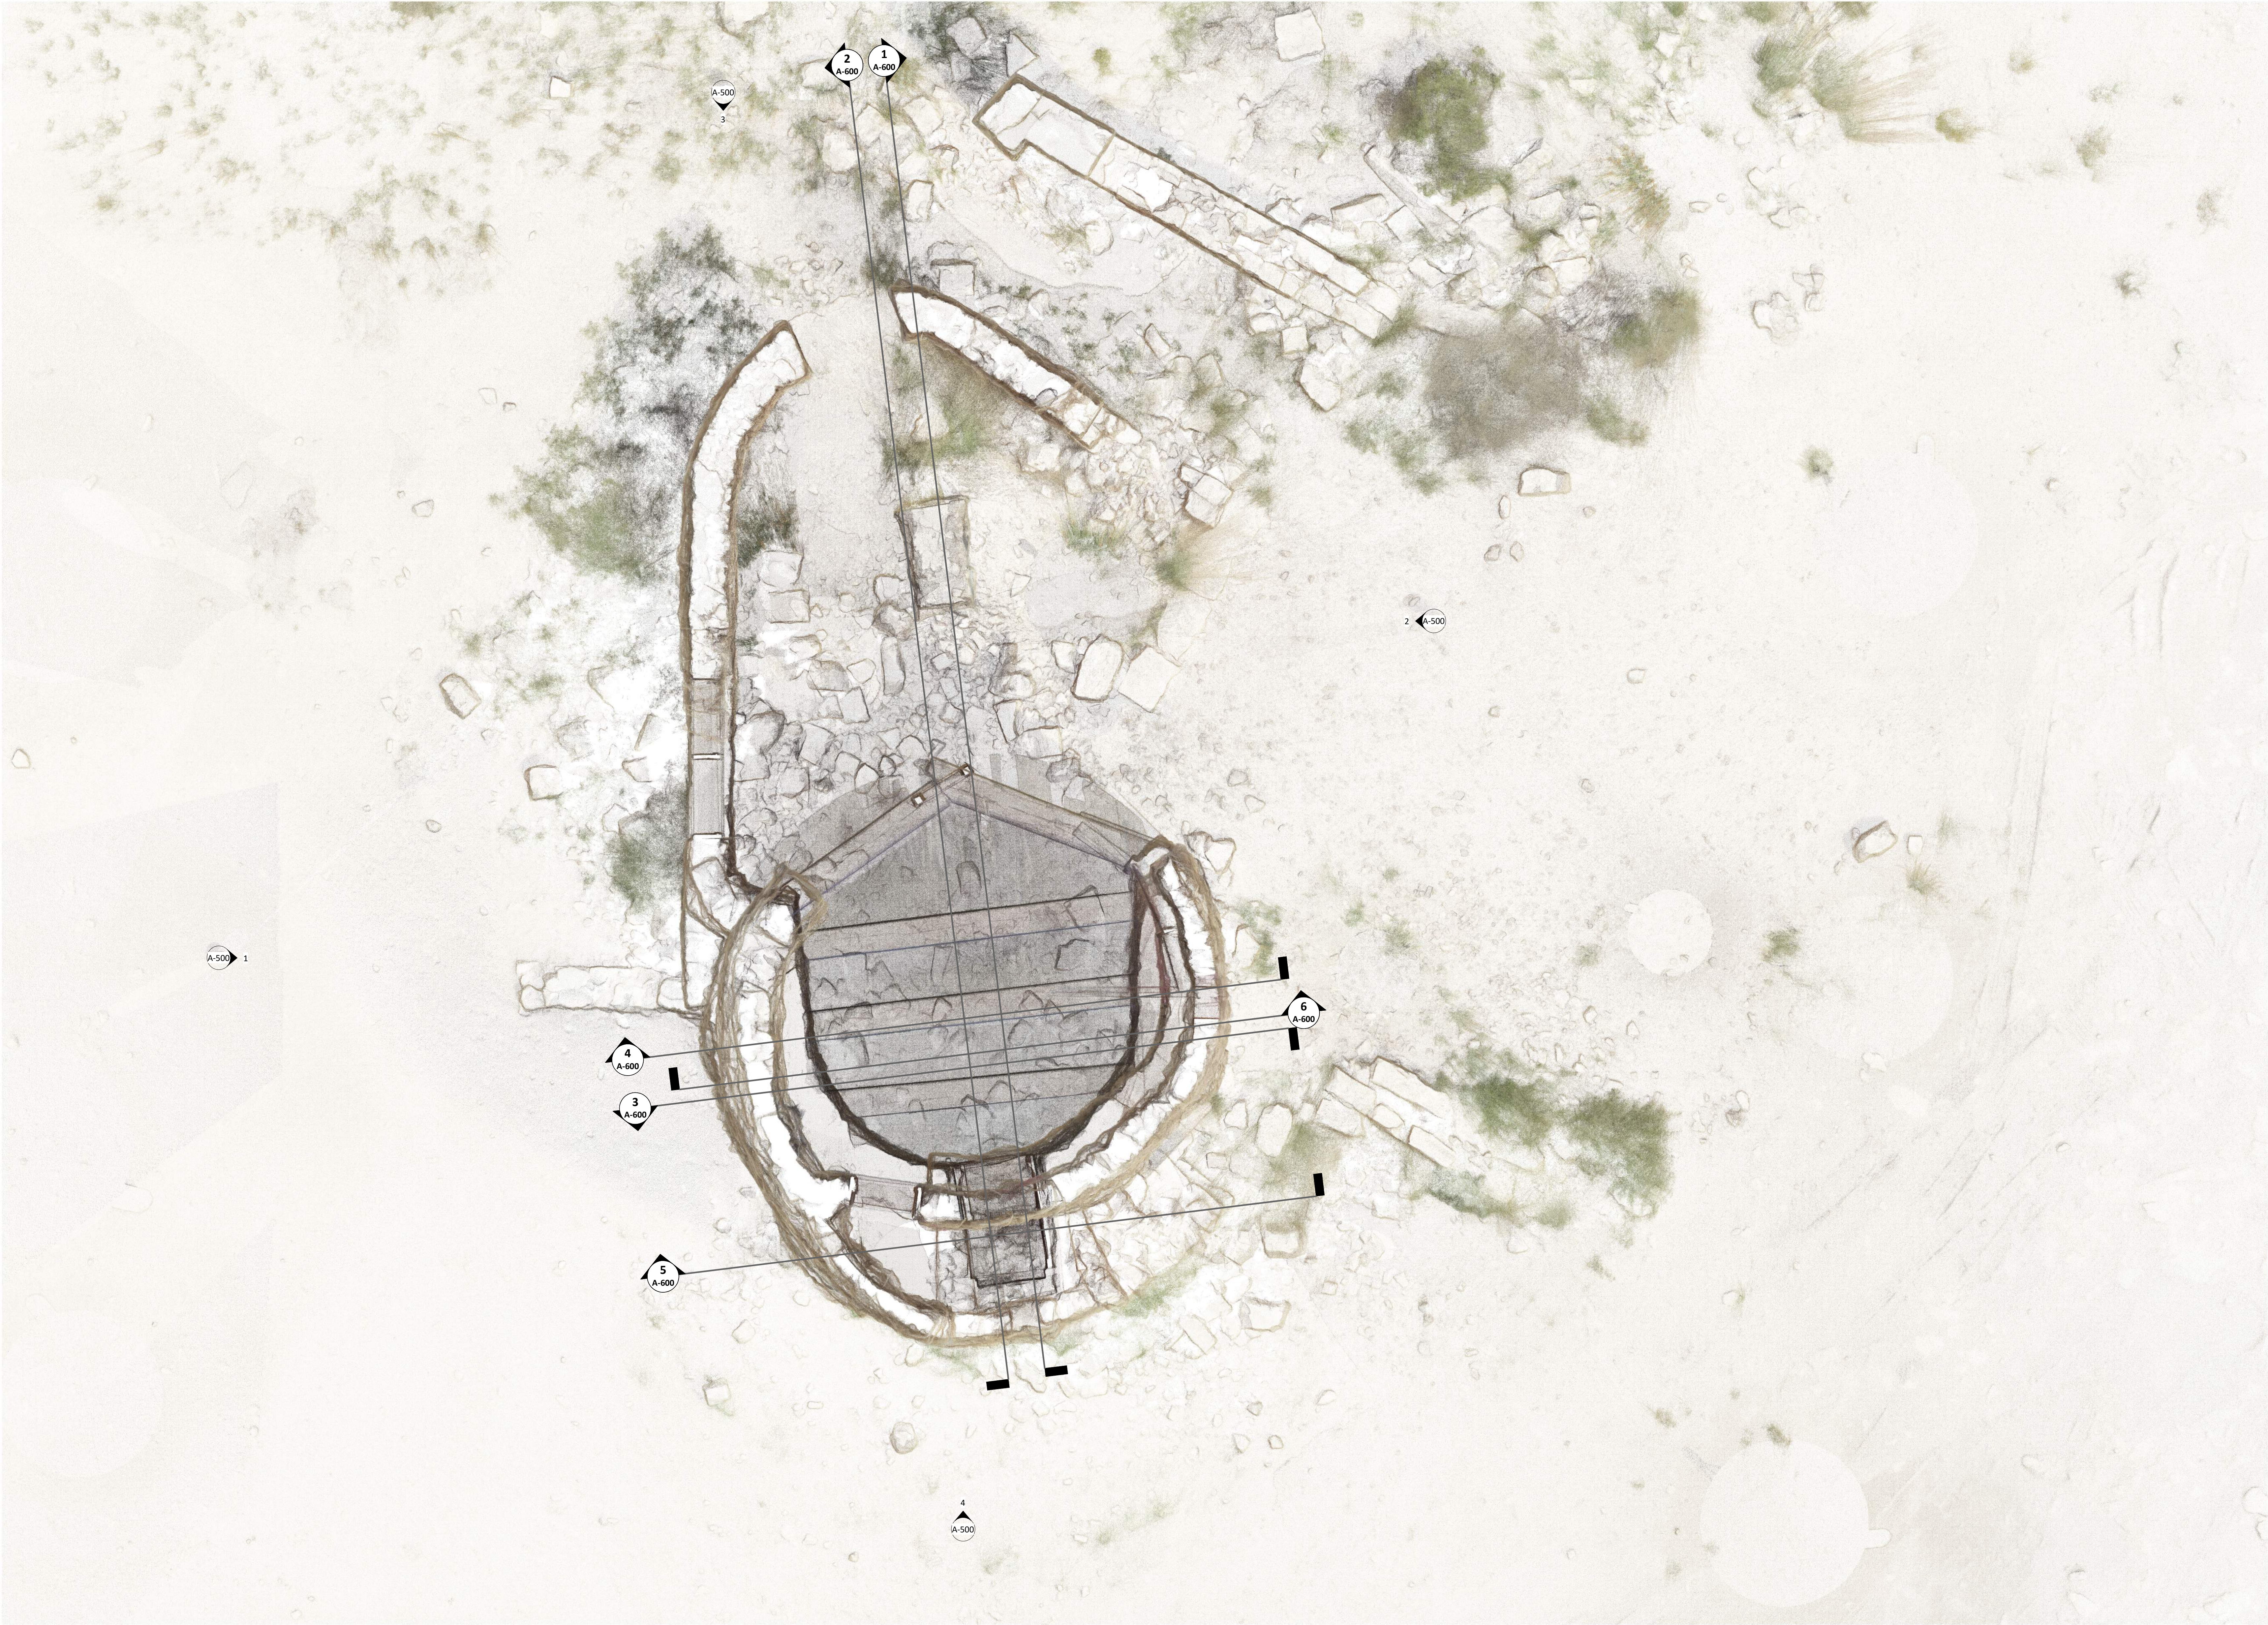

1 STAMP MILL PLAN / VIEW GUIDE

1/2" = 1'-0"



ROUND HOUSE / TOWER RUINS
2 GUNS ARIZONA
2 GUNS
WINSLOW, AZ. 86647

REV | DATE | DESCRIPTION

PROJECT #

23-0101

DATE

01/03/2023

SHEET TITLE

VIEW GUIDE

SHEET #

A-200

LINE & CIRCLE
www.LC3d.com



1 ENLARGED 1ST FLOOR PLAN
1/2" = 1'-0"



2 ENLARGED 2ND FLOOR PLAN
1/2" = 1'-0"



ROUND HOUSE / TOWER RUINS
2 GUNS ARIZONA
2 GUNS
WINSLOW, AZ. 86047

REV | DATE | DESCRIPTION

PROJECT #

23-0101

DATE

01/03/2023

SHEET TITLE


ENLARGED FLOOR
PLAN

SHEET #

A-300


1 REFLECTED CEILING PLAN 1ST FLOOR

1/2" = 1'-0"

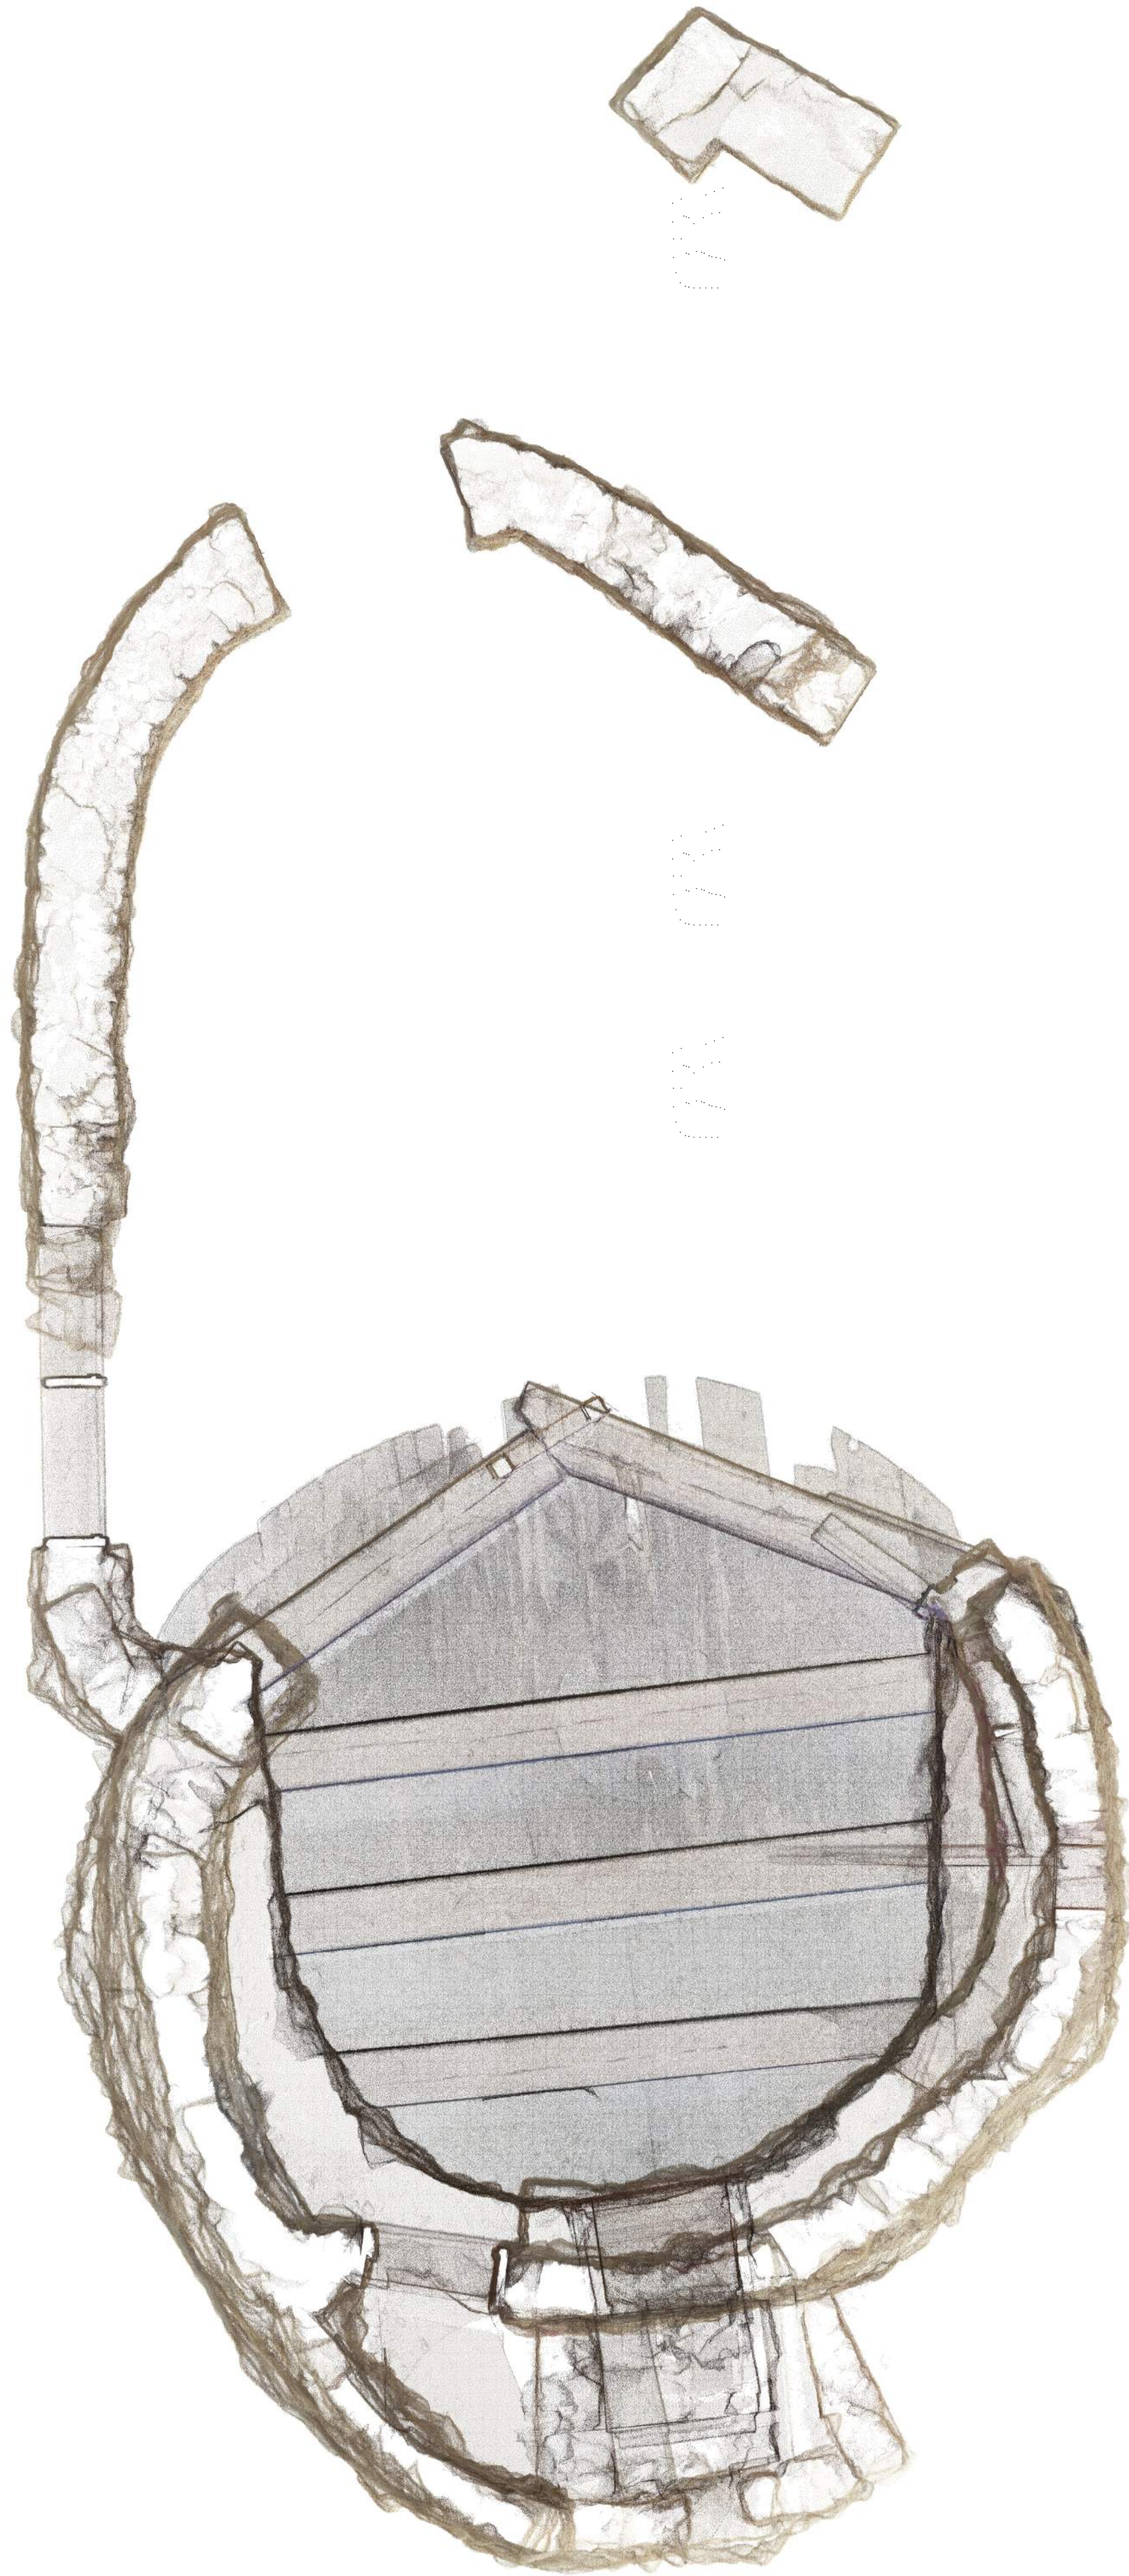

2 REFLECTED CEILING PLAN 2ND FLOOR

1/2" = 1'-0"

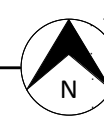

ROUND HOUSE / TOWER RUINS
2 GUNS ARIZONA
2 GUNS
WINSLOW, AZ. 86047

REV | DATE | DESCRIPTION

PROJECT #

23-0101

DATE

01/03/2023

SHEET TITLE

REFLECTED CEILING
PLAN

SHEET #

A-400



1 WEST ELEVATION
1/2" = 1'-0"



2 EAST ELEVATION
1/2" = 1'-0"



3 NORTH ELEVATION
1/2" = 1'-0"



4 SOUTH ELEVATION
1/2" = 1'-0"

ROUND HOUSE / TOWER RUINS
2 GUNS ARIZONA
2 GUNS
WINSLOW, AZ. 86047

REV	DATE	DESCRIPTION
-----	------	-------------

PROJECT #

23-0101

DATE

01/03/2023

SHEET TITLE


EXTERIOR
ELEVATIONS

SHEET #

A-500


This drawing is the property of Line & Circle, LLC. 3443 Delaney St., New, AZ. 85006. (602) 701-5335. This drawing is limited to the original use for which it was prepared. Changes, reproductions, or assigning to any third party of this drawing for any other use is not permitted without written consent of Line & Circle, LLC.

1/9/2023 5:08:09 PM

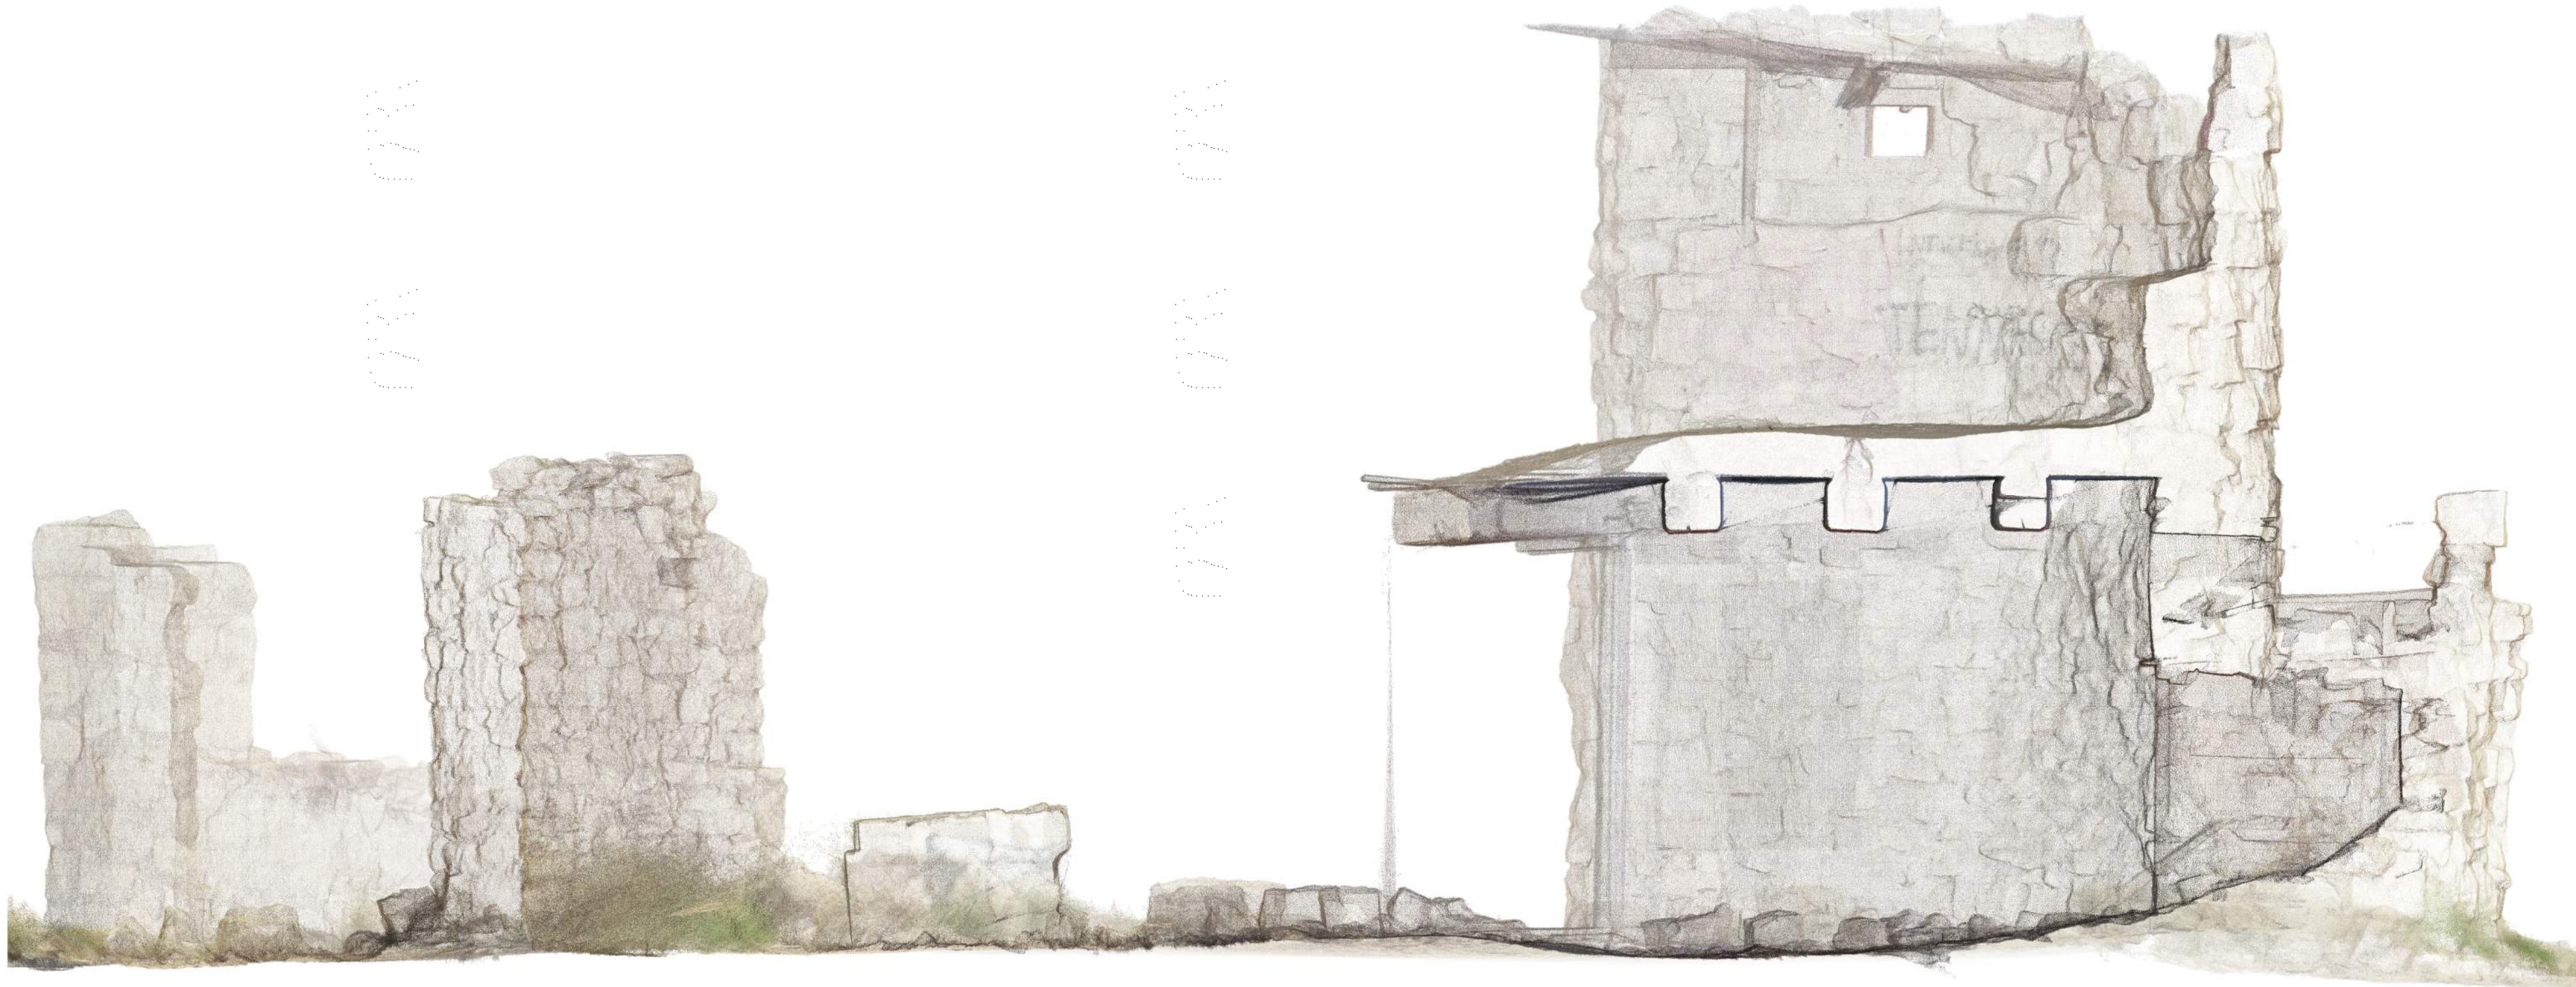

1 SECTION 1

1/2" = 1'-0"

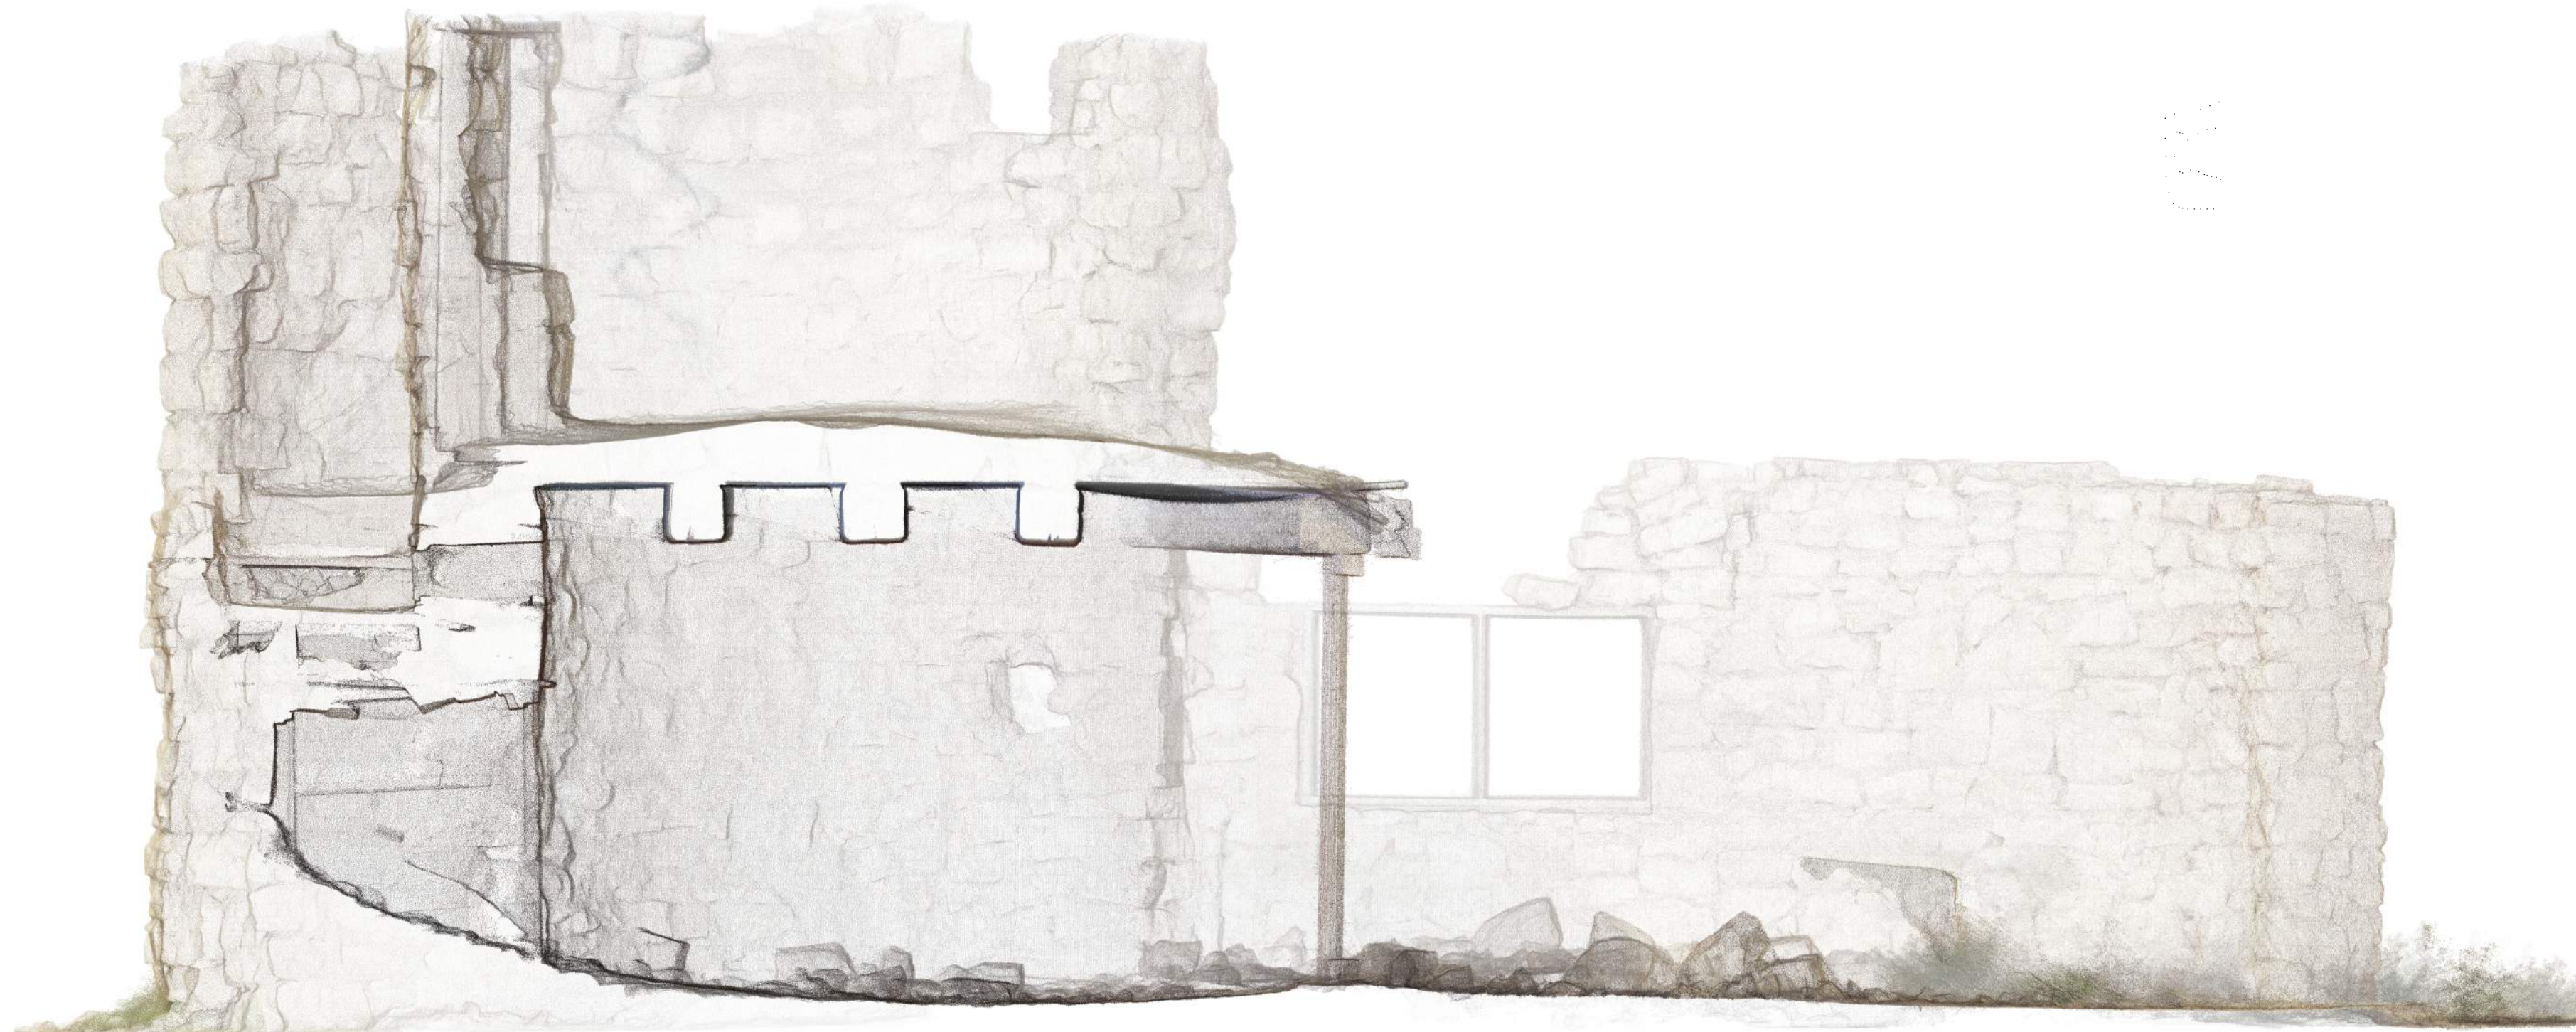


2 SECTION 2

1/2" = 1'-0"




3 SECTION 3

1/2" = 1'-0"

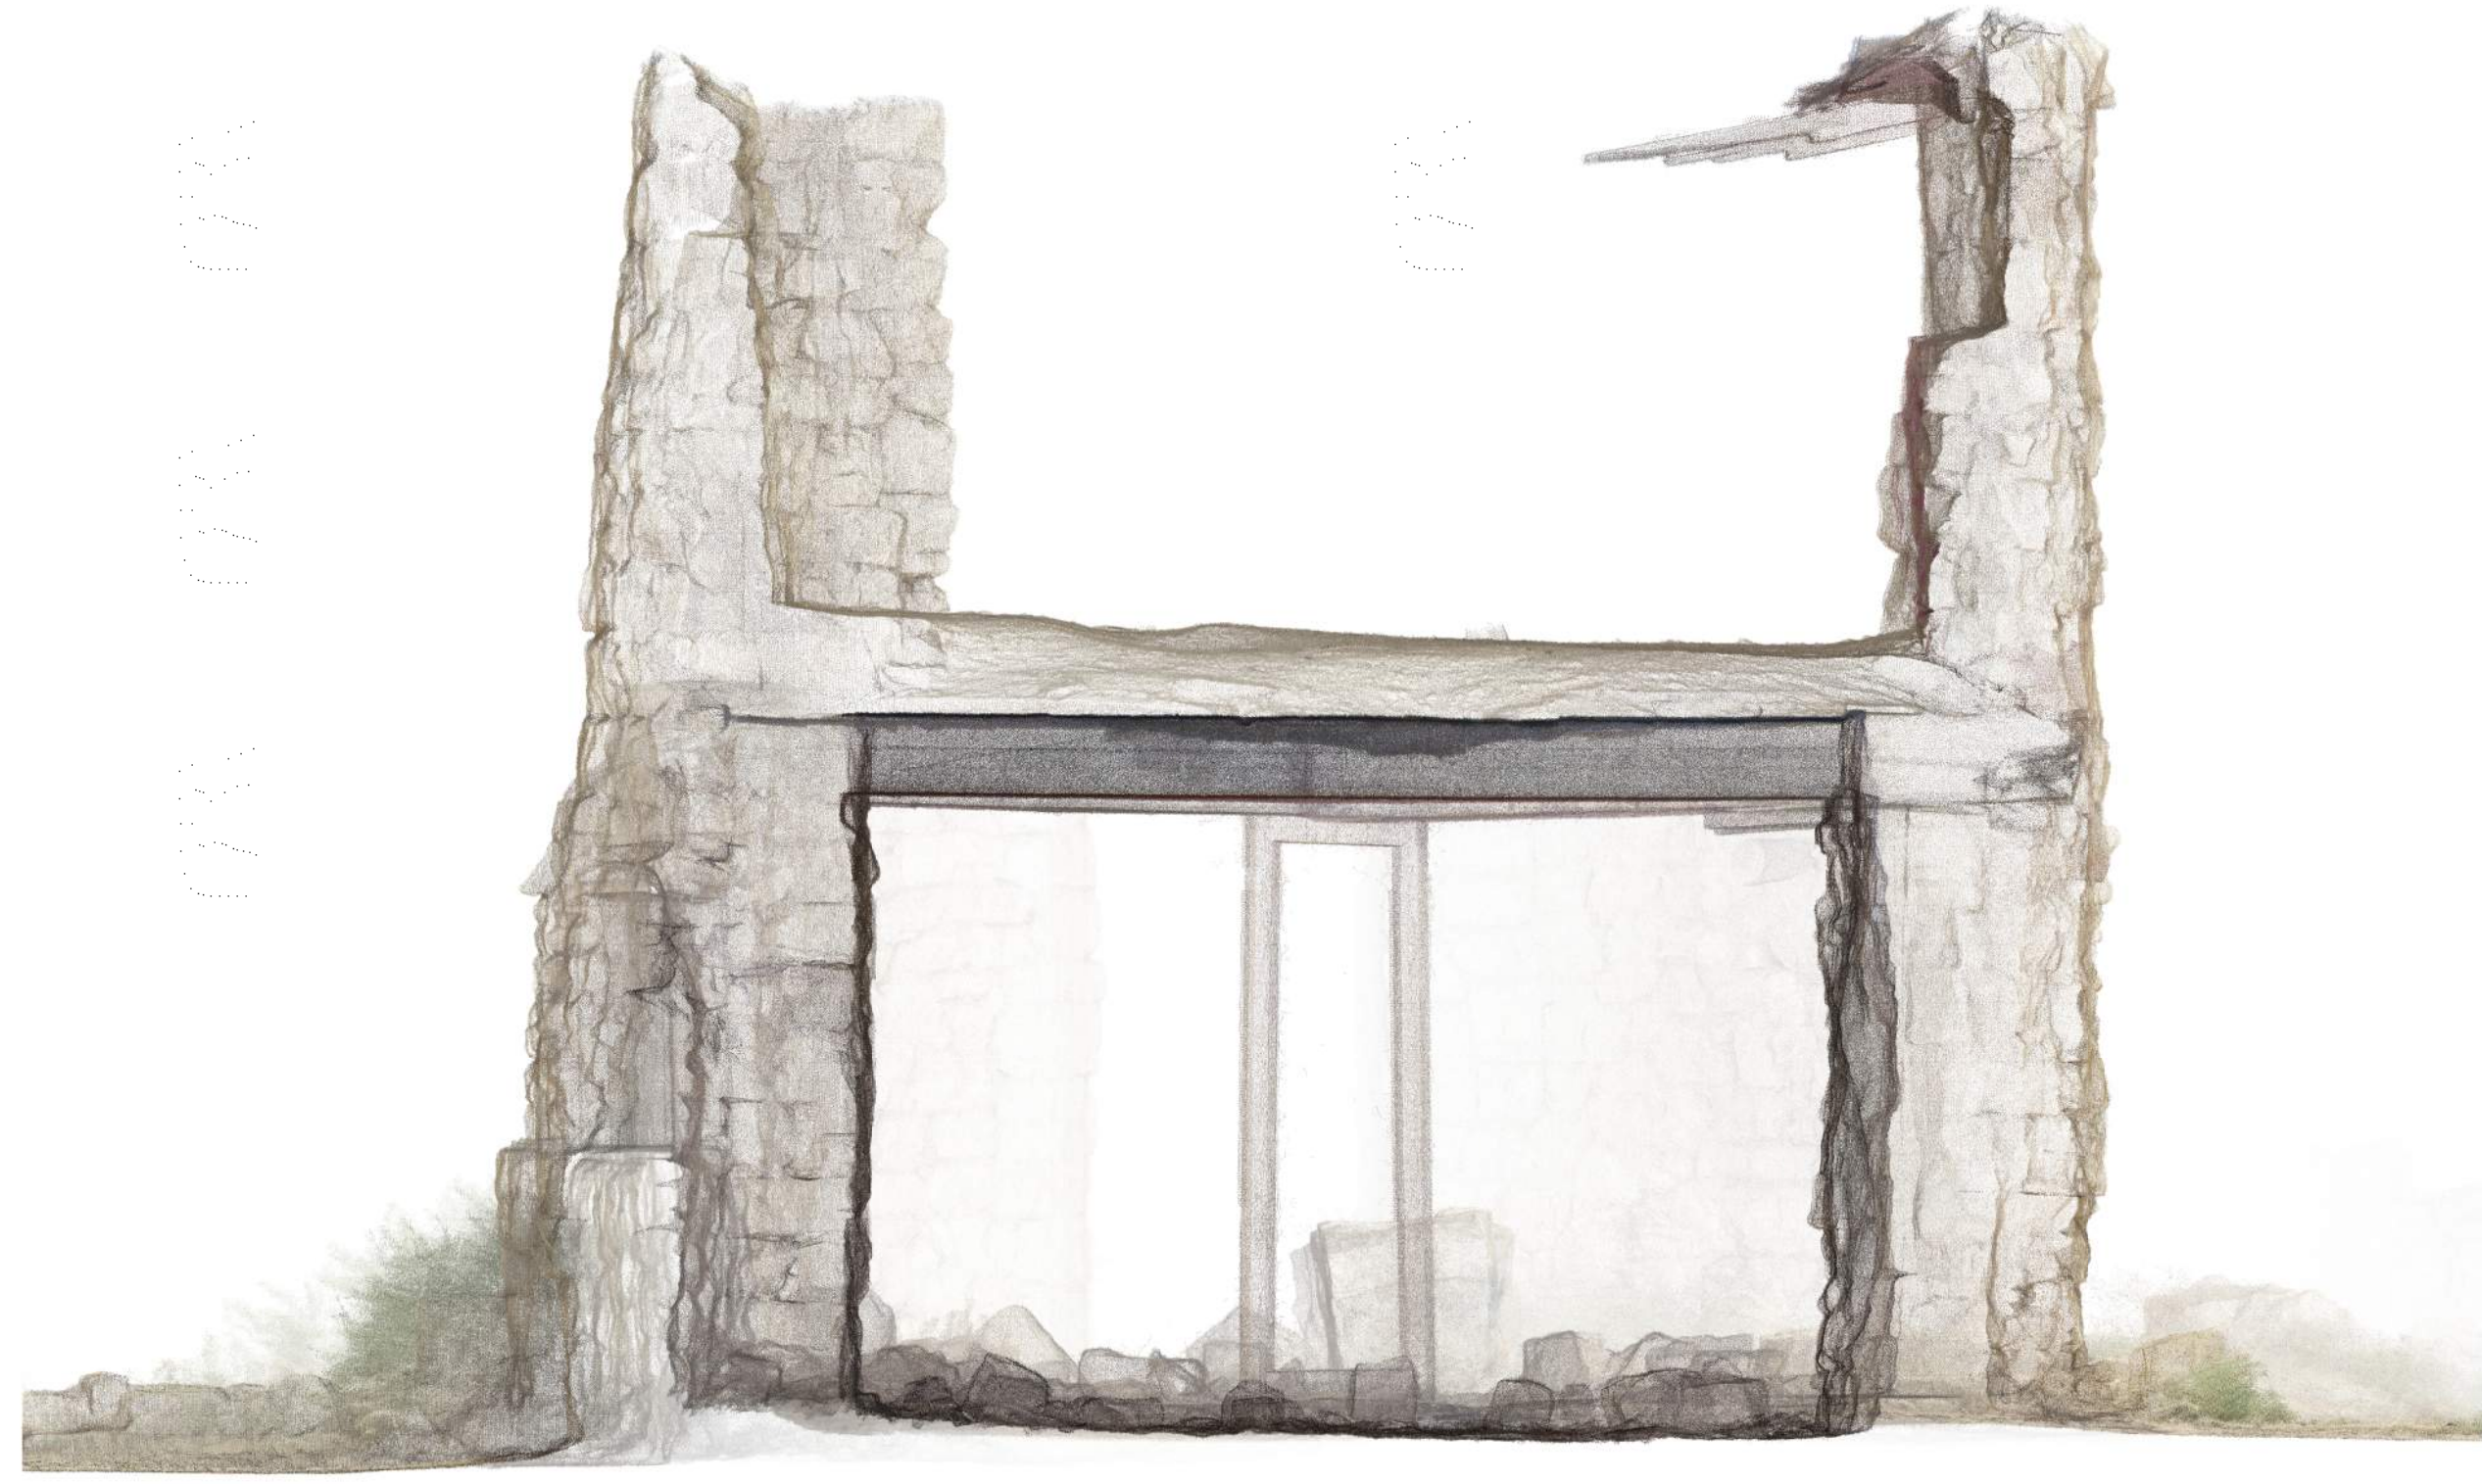


4 SECTION 4

1/2" = 1'-0"

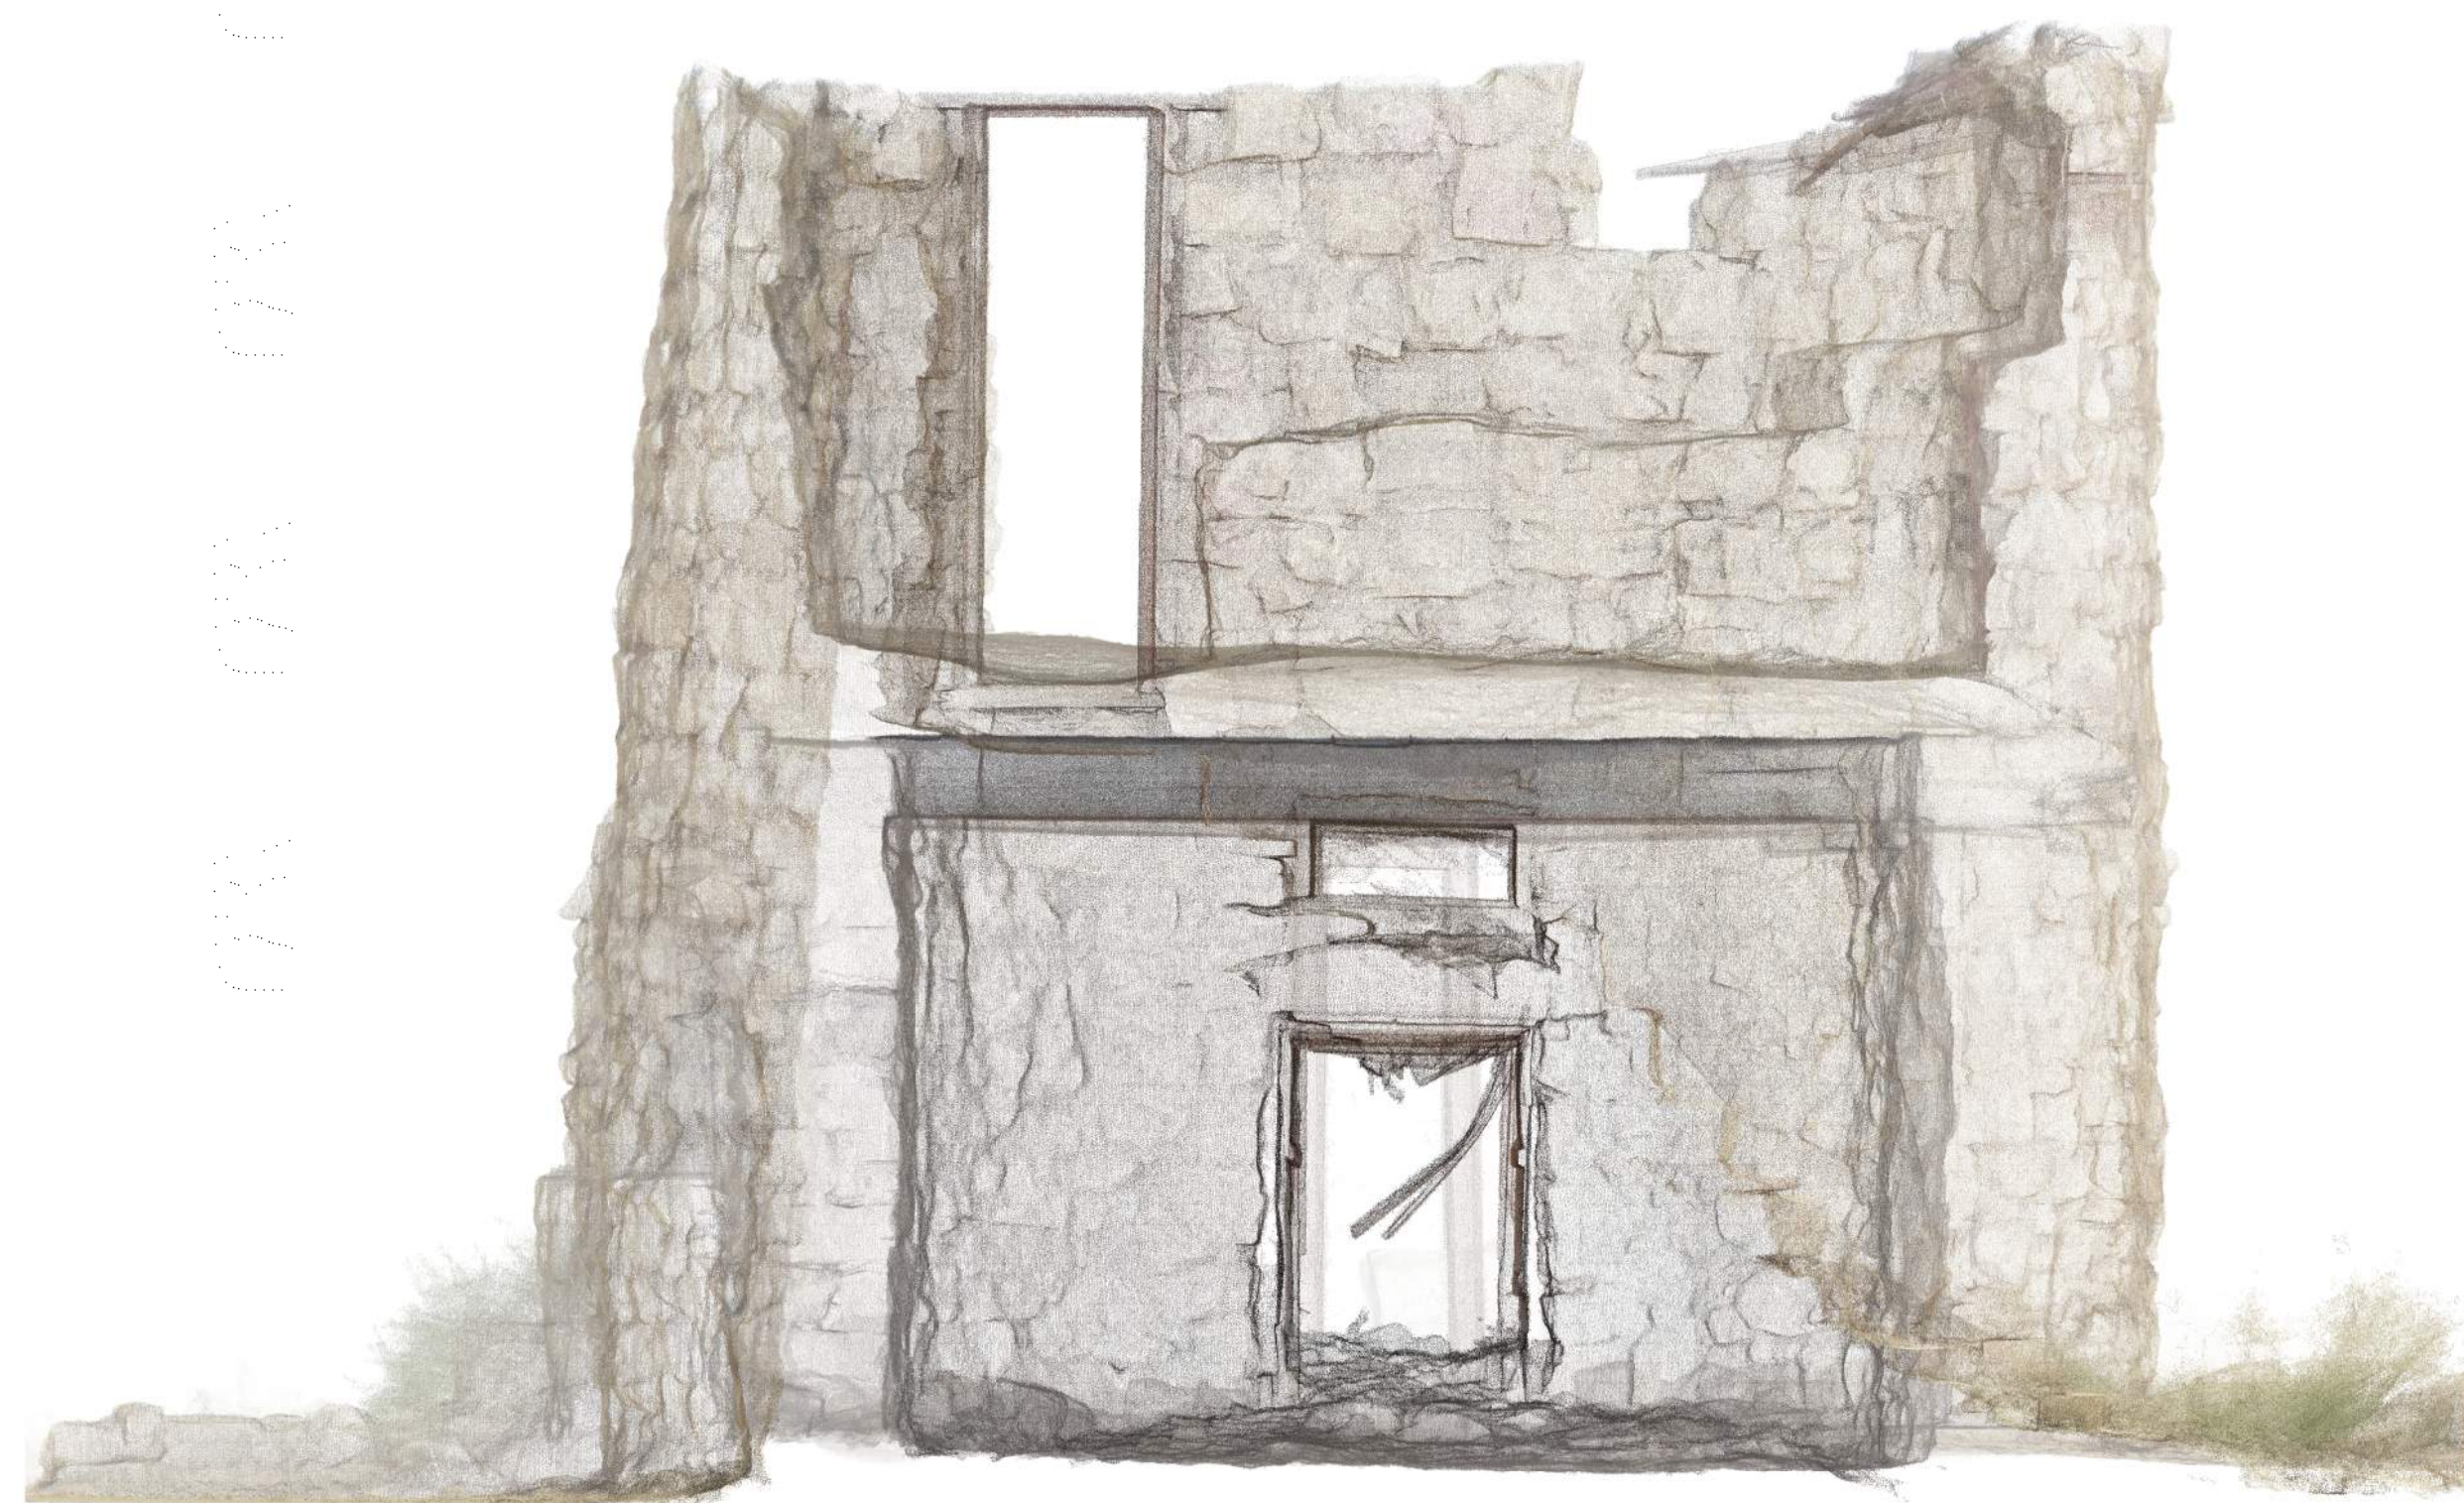

5 SECTION 5

1/2" = 1'-0"

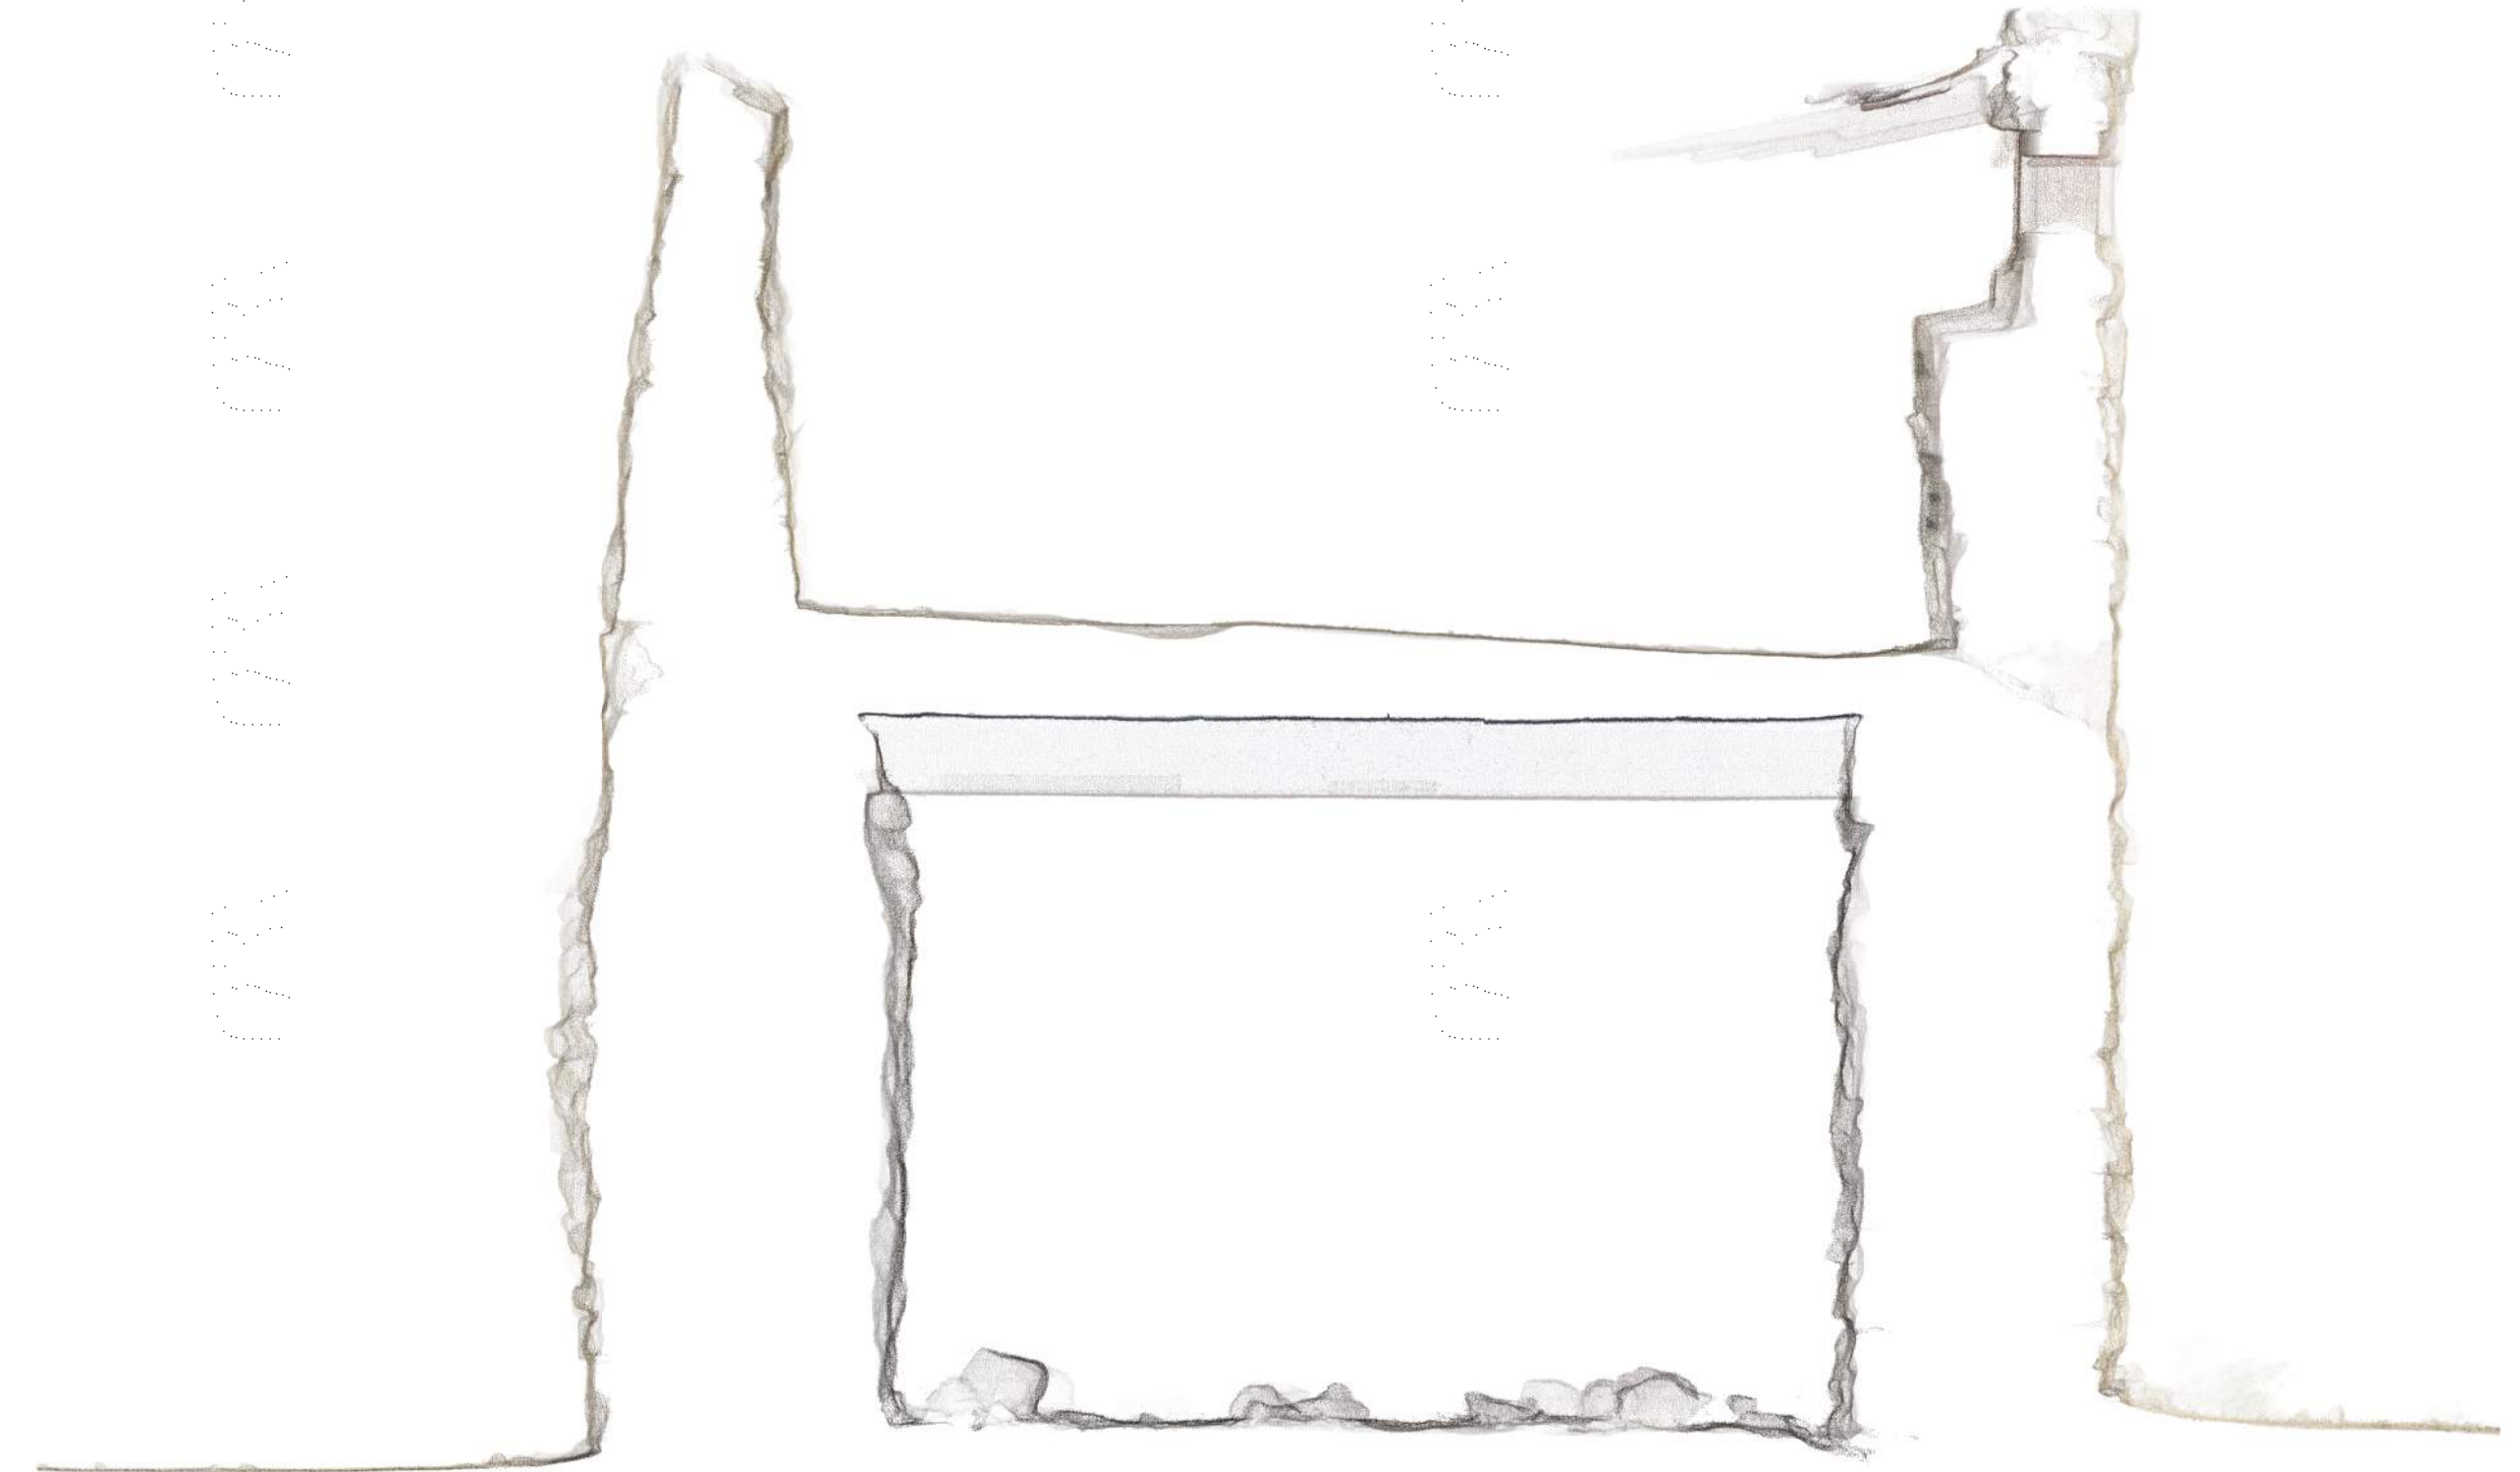

6 SECTION 6

1/2" = 1'-0"