


1 SITE PLAN

1/8" = 1'-0"

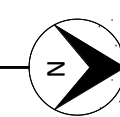

2195 EAST CAMELBACK ROAD
PHOENIX, AZ.

REV | DATE | DESCRIPTION

PROJECT #

23-0403

DATE

04/03/2022

SHEET TITLE

SITE PLAN

SHEET #

A-100

AS-BUILT

EXISTING CONDITIONS DO NOT FOR CONSTRUCTION

EXISTING CONDITIONS DO NOT FOR CONSTRUCTION





A-500 1

A-500
4


A-500 3

A-500
2

1 EXTERIOR FLOOR PLAN
1/4" = 1'-0"

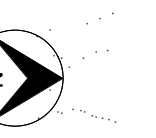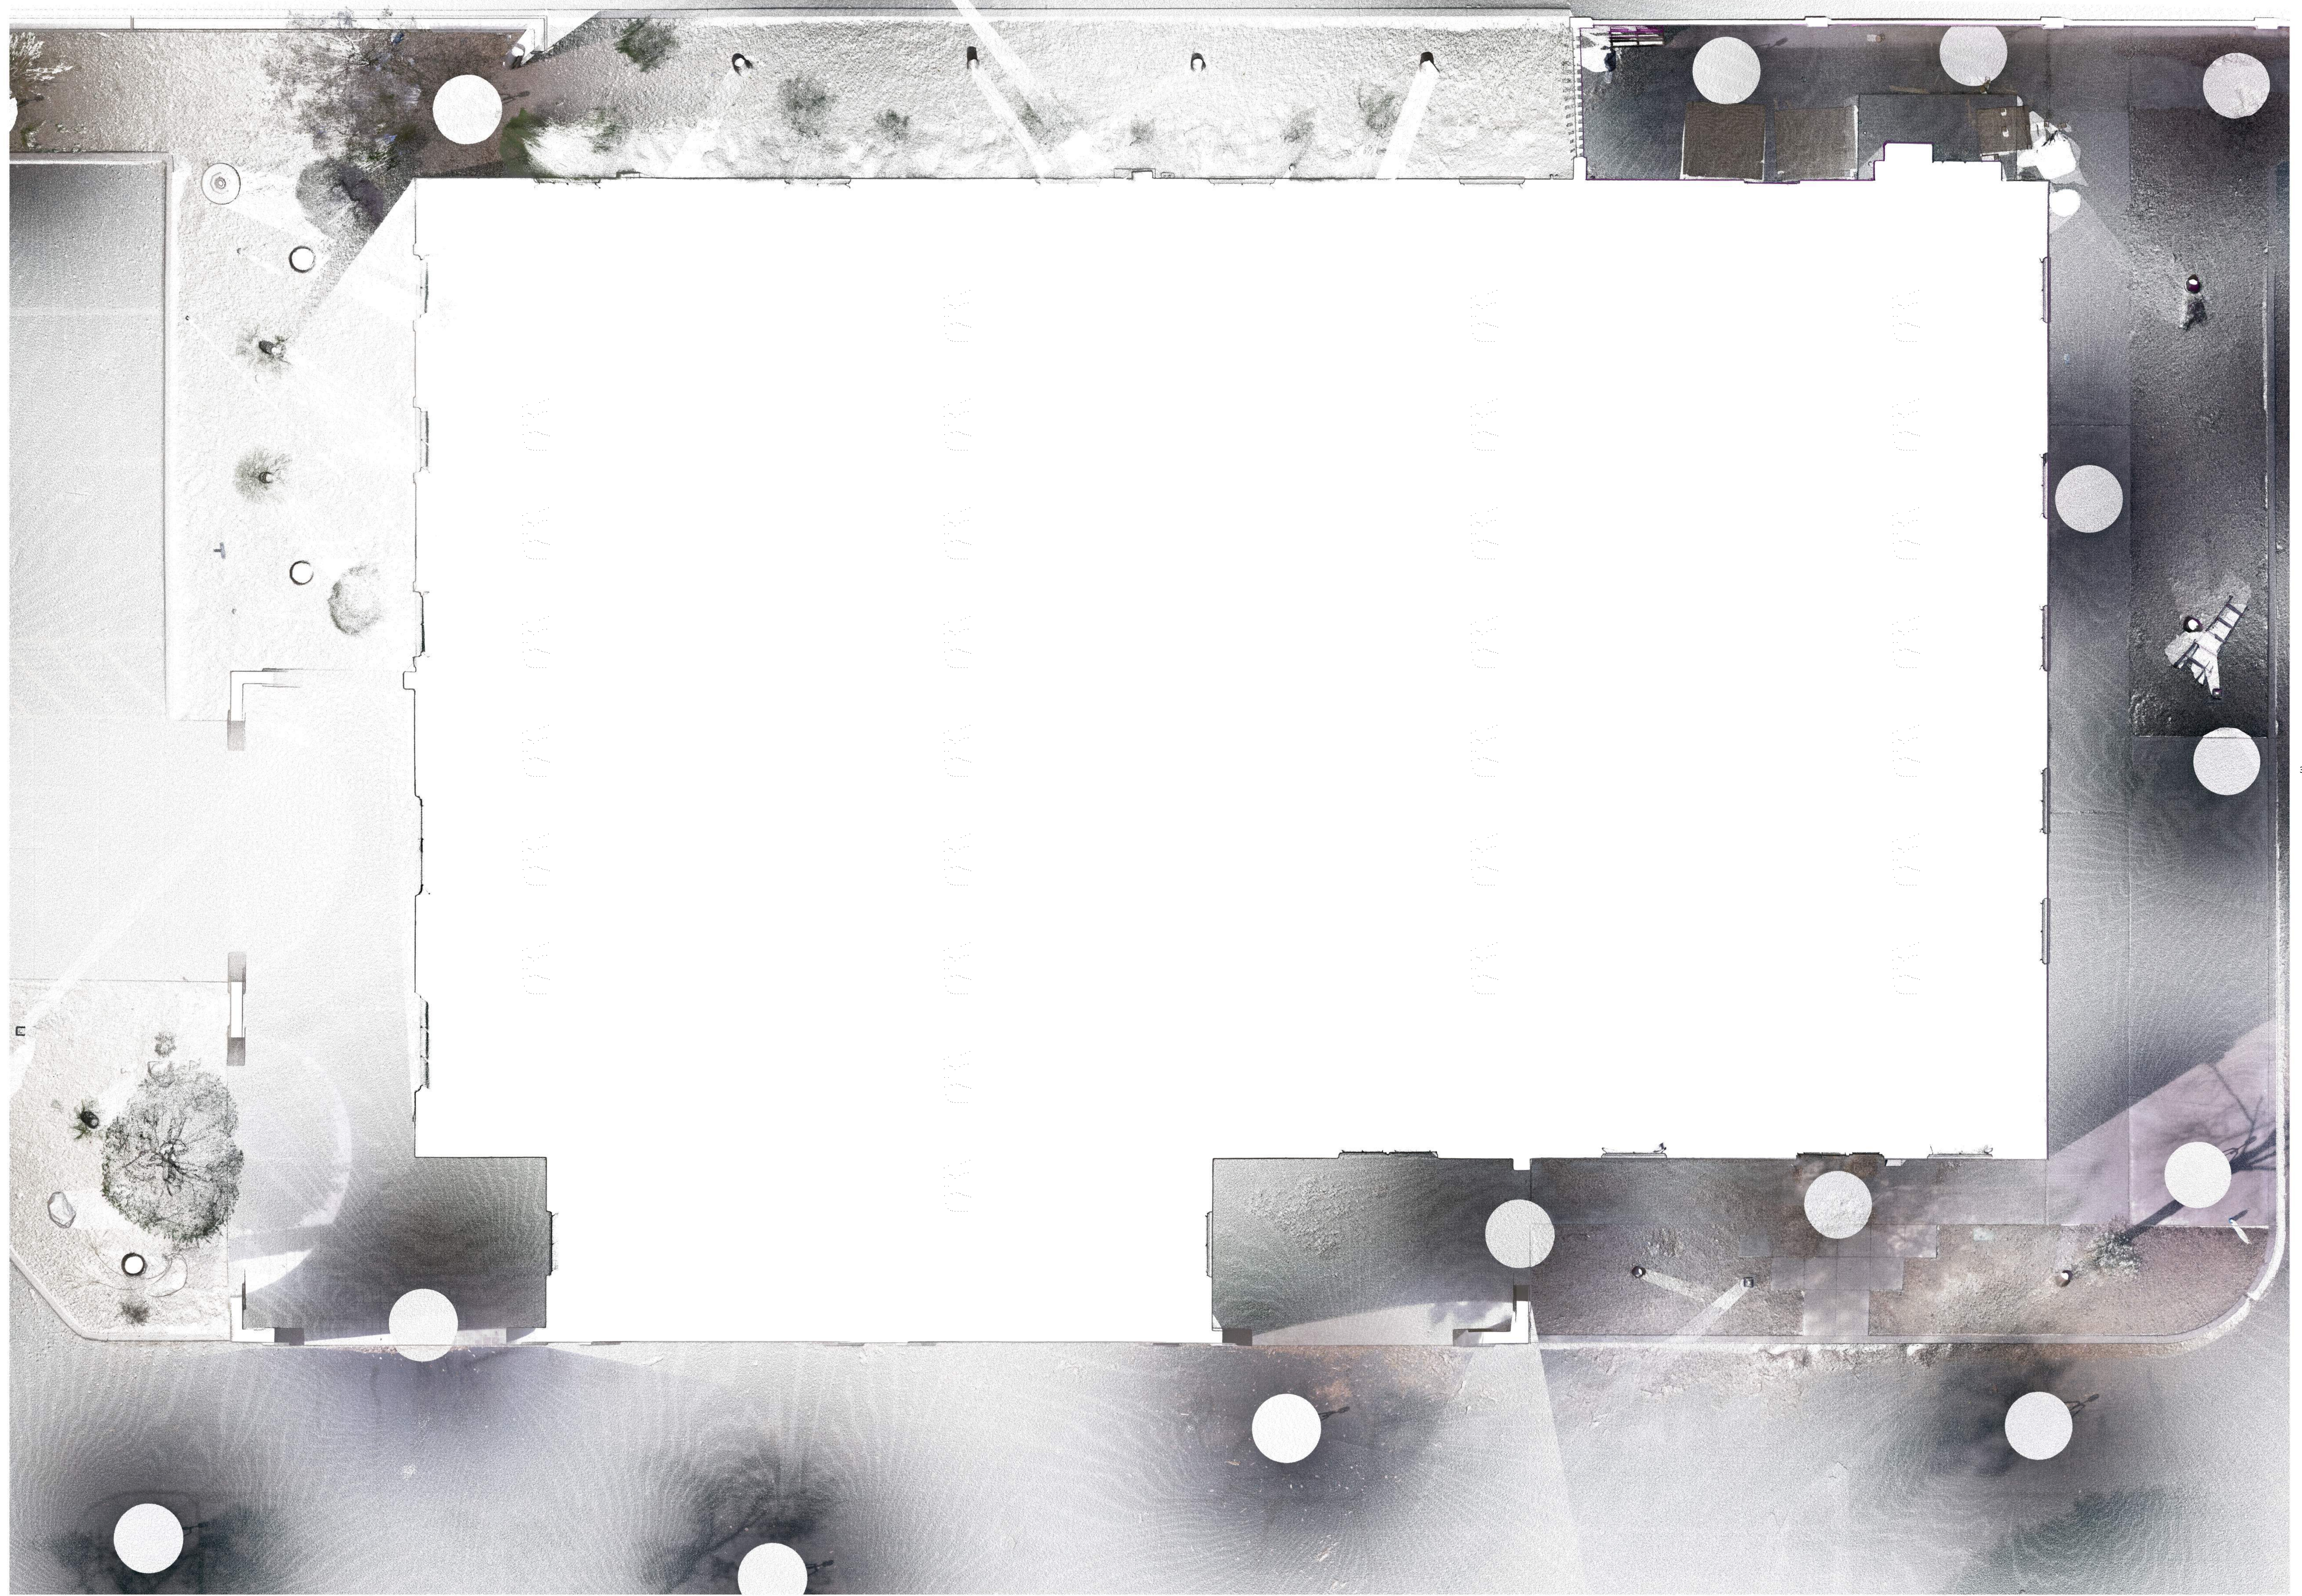


This drawing is the property of Line & Circle, L.L.C., 3445 Dolan Rd., Suite 200, Phoenix, AZ 85018. All rights reserved. This drawing is limited to the application for which it was prepared. Changes, reproductions, or copying to any part of this drawing for any other use is not permitted without written consent of Line & Circle, L.L.C. 1/20/2022 12:52:42 PM

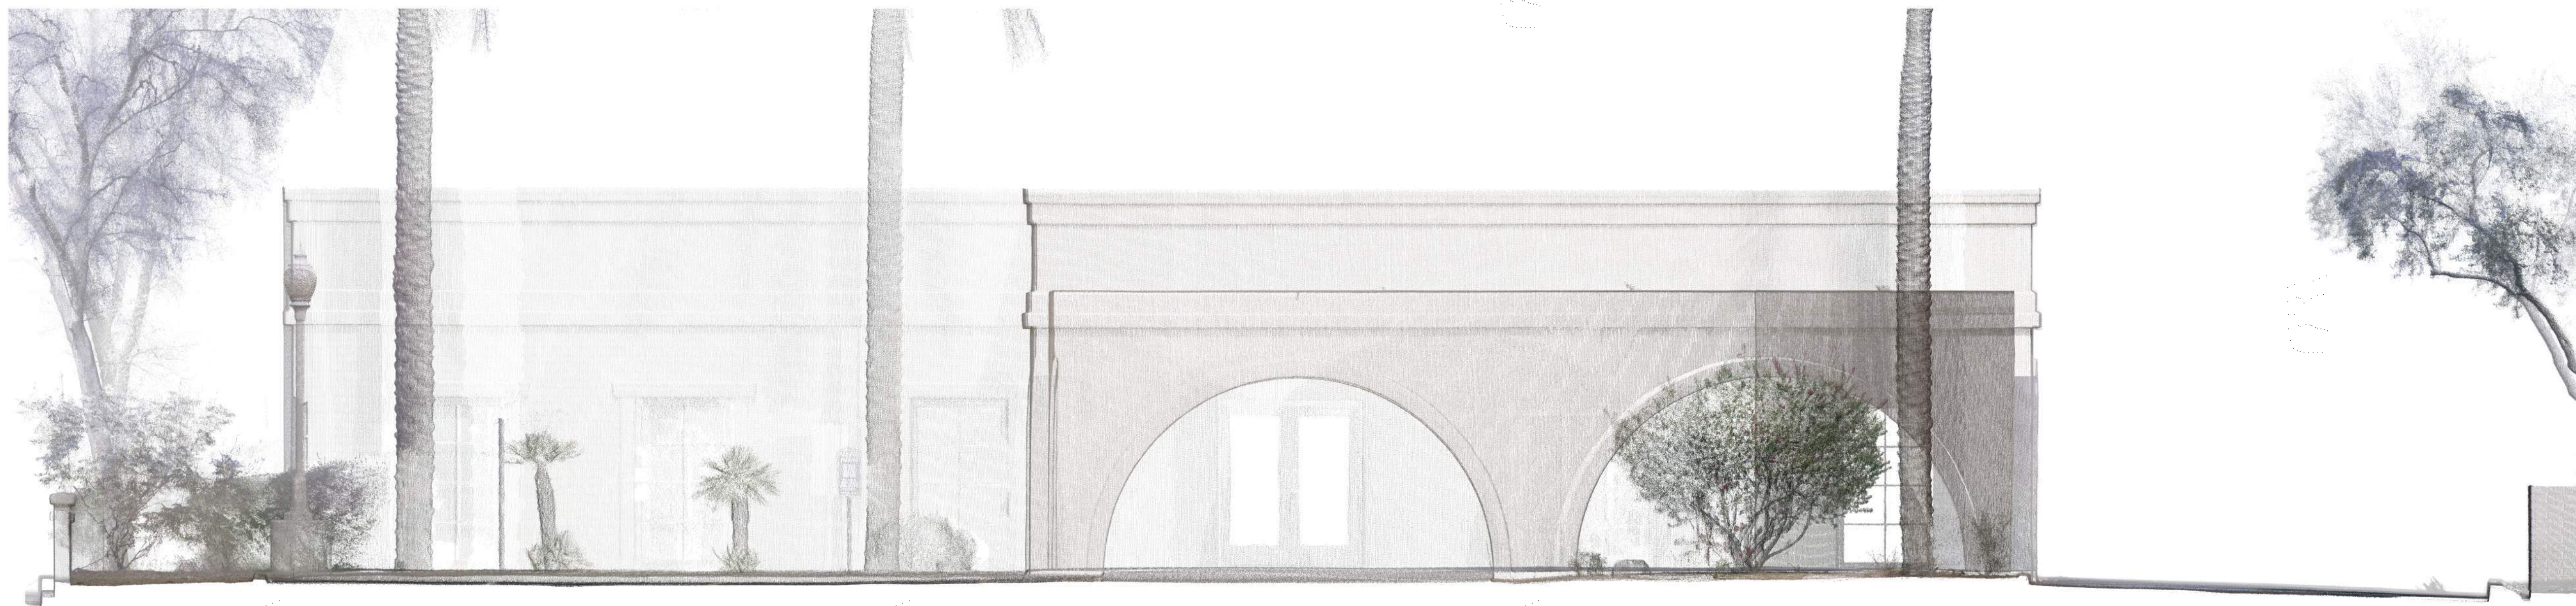

1 SOUTH ELEVATION
1/4" = 1'-0"



2 EAST ELEVATION
1/4" = 1'-0"

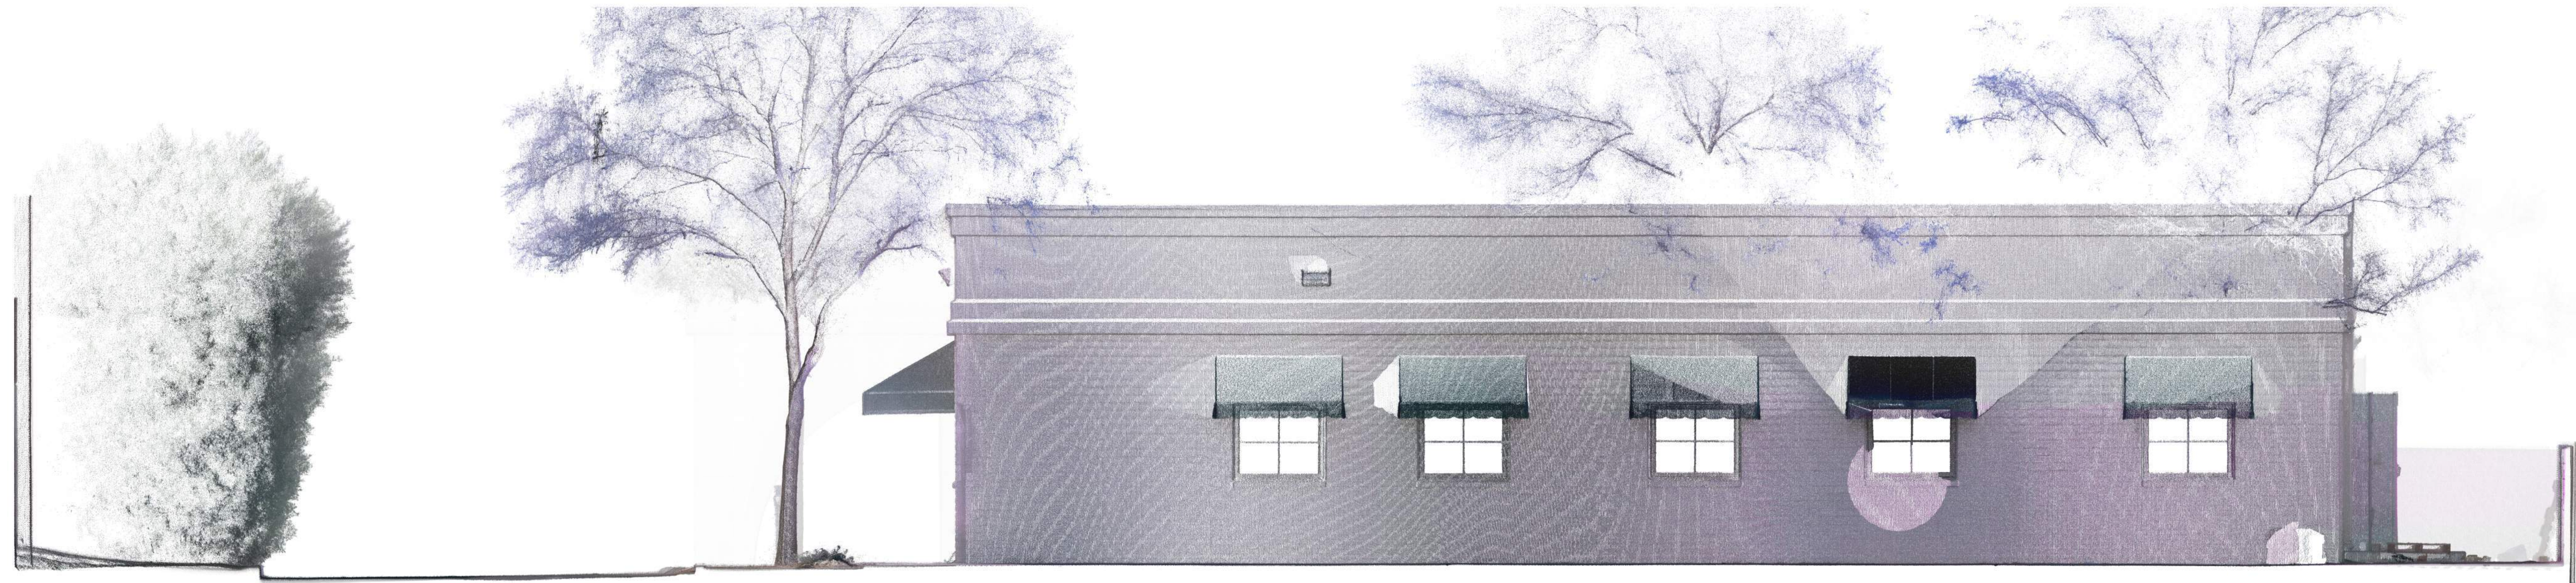

3 NORTH ELEVATION
1/4" = 1'-0"



4 WEST ELEVATION
1/4" = 1'-0"

REV	DATE	DESCRIPTION
PROJECT #	23-0403	
DATE	04/03/2022	
SHEET TITLE	EXTERIOR ELEVATIONS	
SHEET #	A-500	