
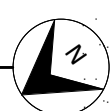


1 SITE PLAN
3/4" = 1'-0"

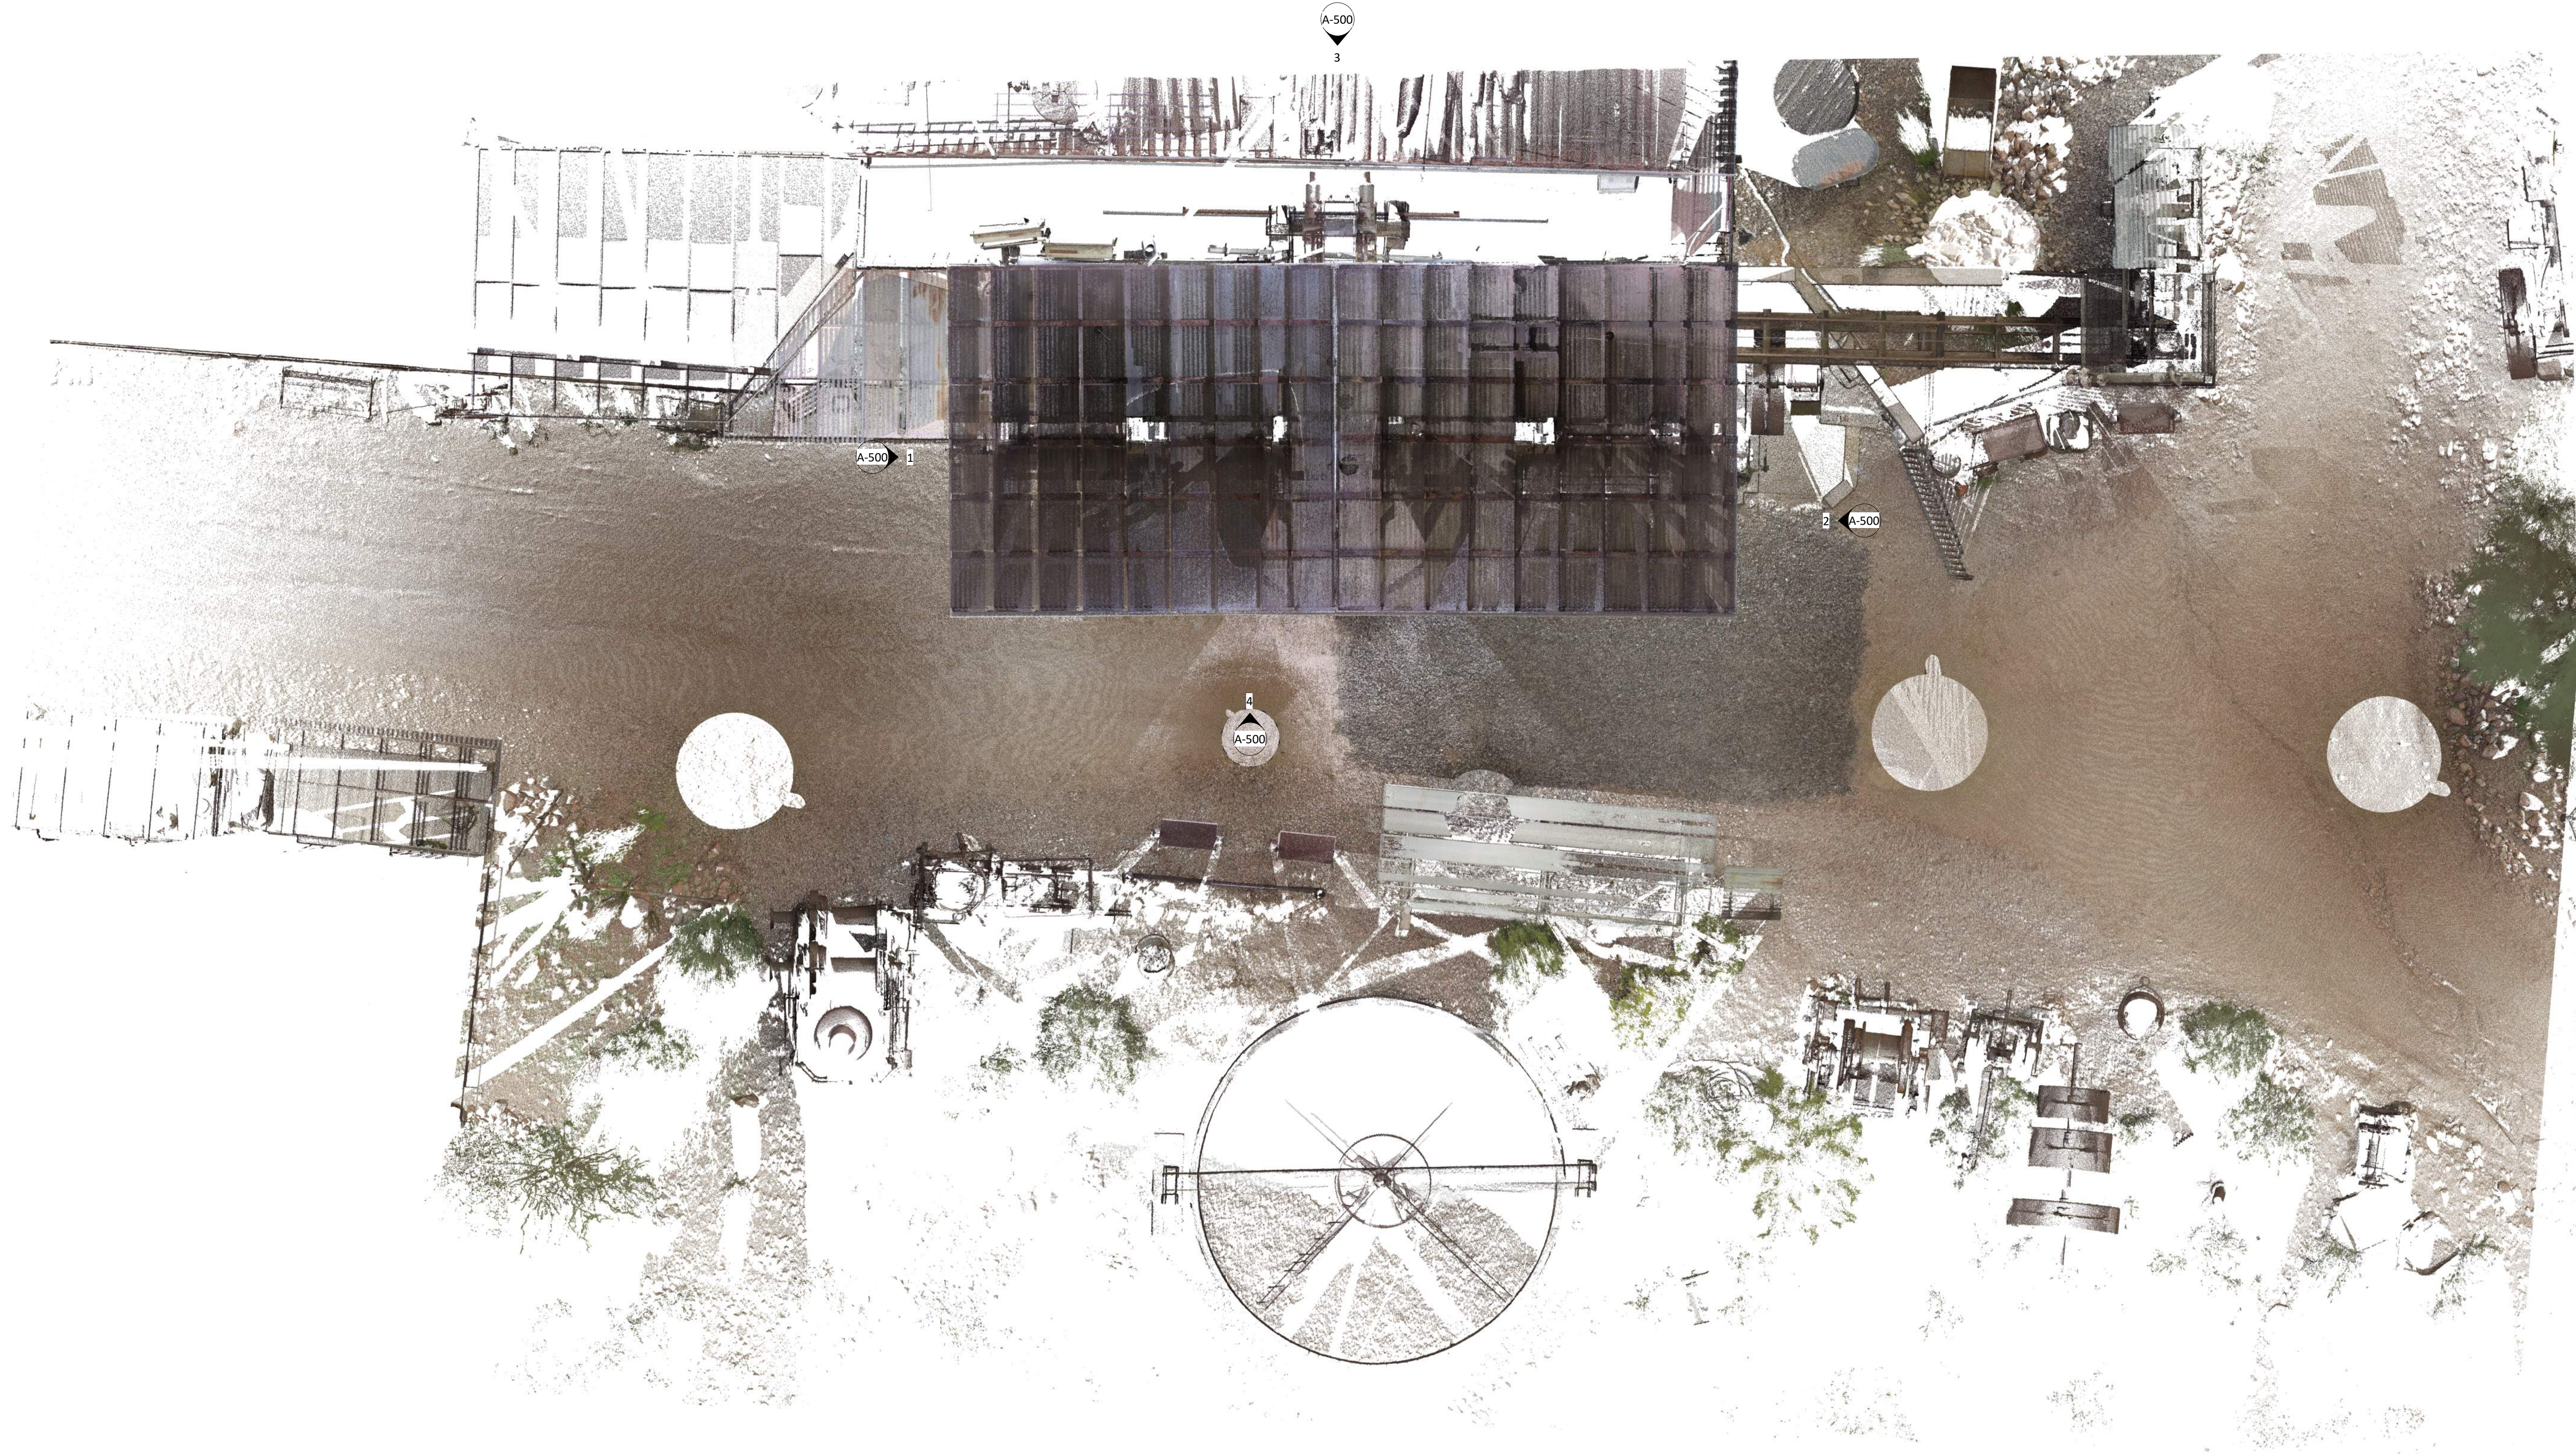

COSSACK 20-STAMP ORE MILL
SUPERSTITION MOUNTAIN MUSEUM
4087 E APACHE TRAIL
APACHE JUNCTION, ARIZONA 85119

REV	DATE	DESCRIPTION
-----	------	-------------

PROJECT #	23-0102
DATE	01/03/2023
SHEET TITLE	

SITE PLAN
SHEET #



A-100

EXISTING CONDITIONS DOCUMENT
NOT FOR CONSTRUCTION

AS-BUILT

1 STAMP MILL PLAN / VIEW GUIDE

1/2" = 1'-0"

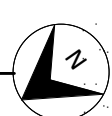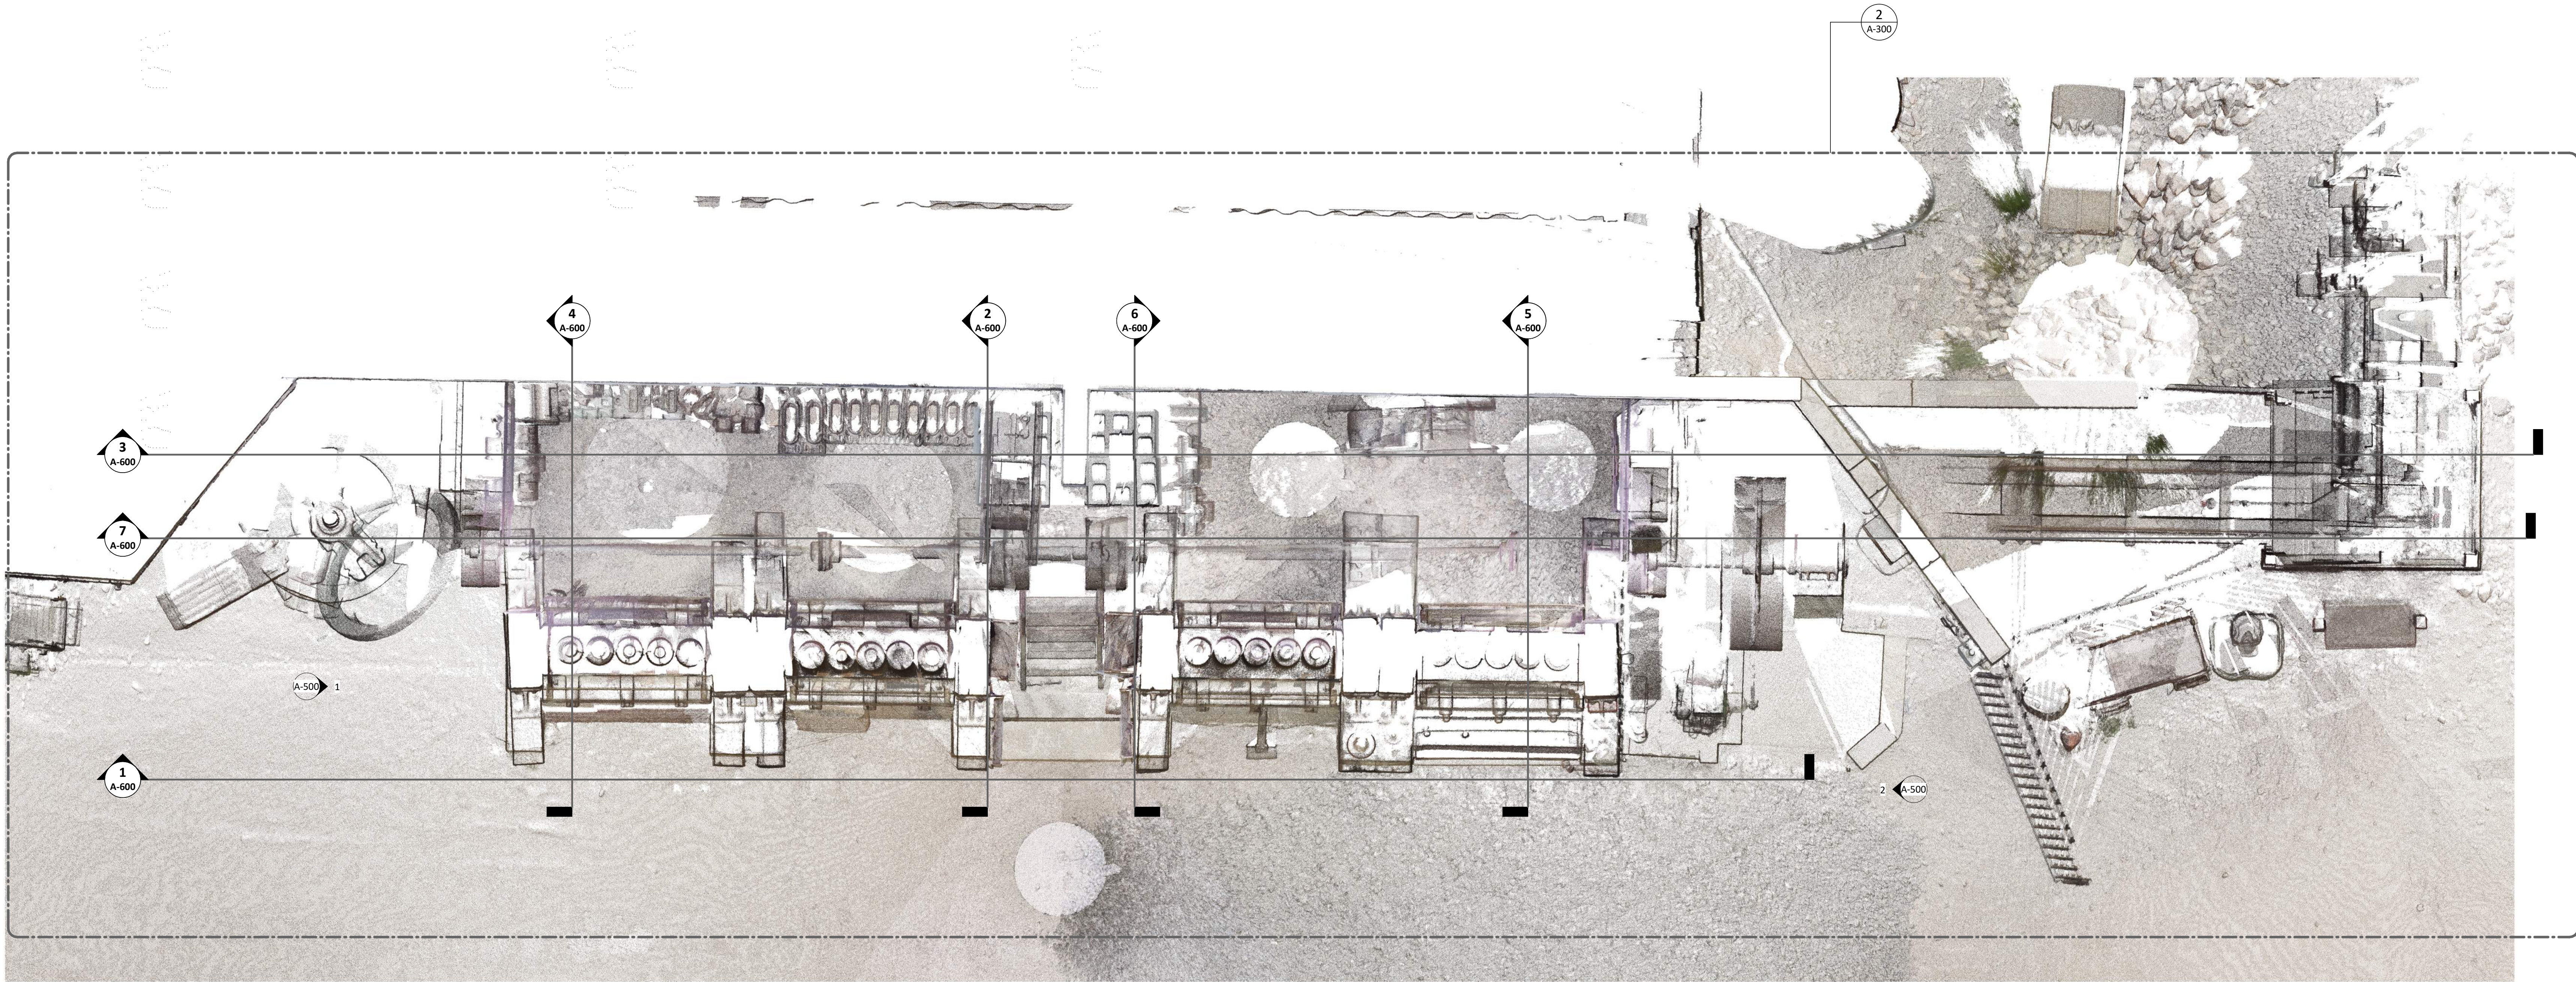

COSSACK 20-STAMP ORE MILL
SUPERSTITION MOUNTAIN MUSEUM
4087 E APACHE TRAIL
APACHE JUNCTION, ARIZONA 85119

REV | DATE | DESCRIPTION

PROJECT #

23-0102

DATE


01/03/2023

SHEET TITLE


MILL PLAN & VIEW
GUIDE

SHEET #


A-200

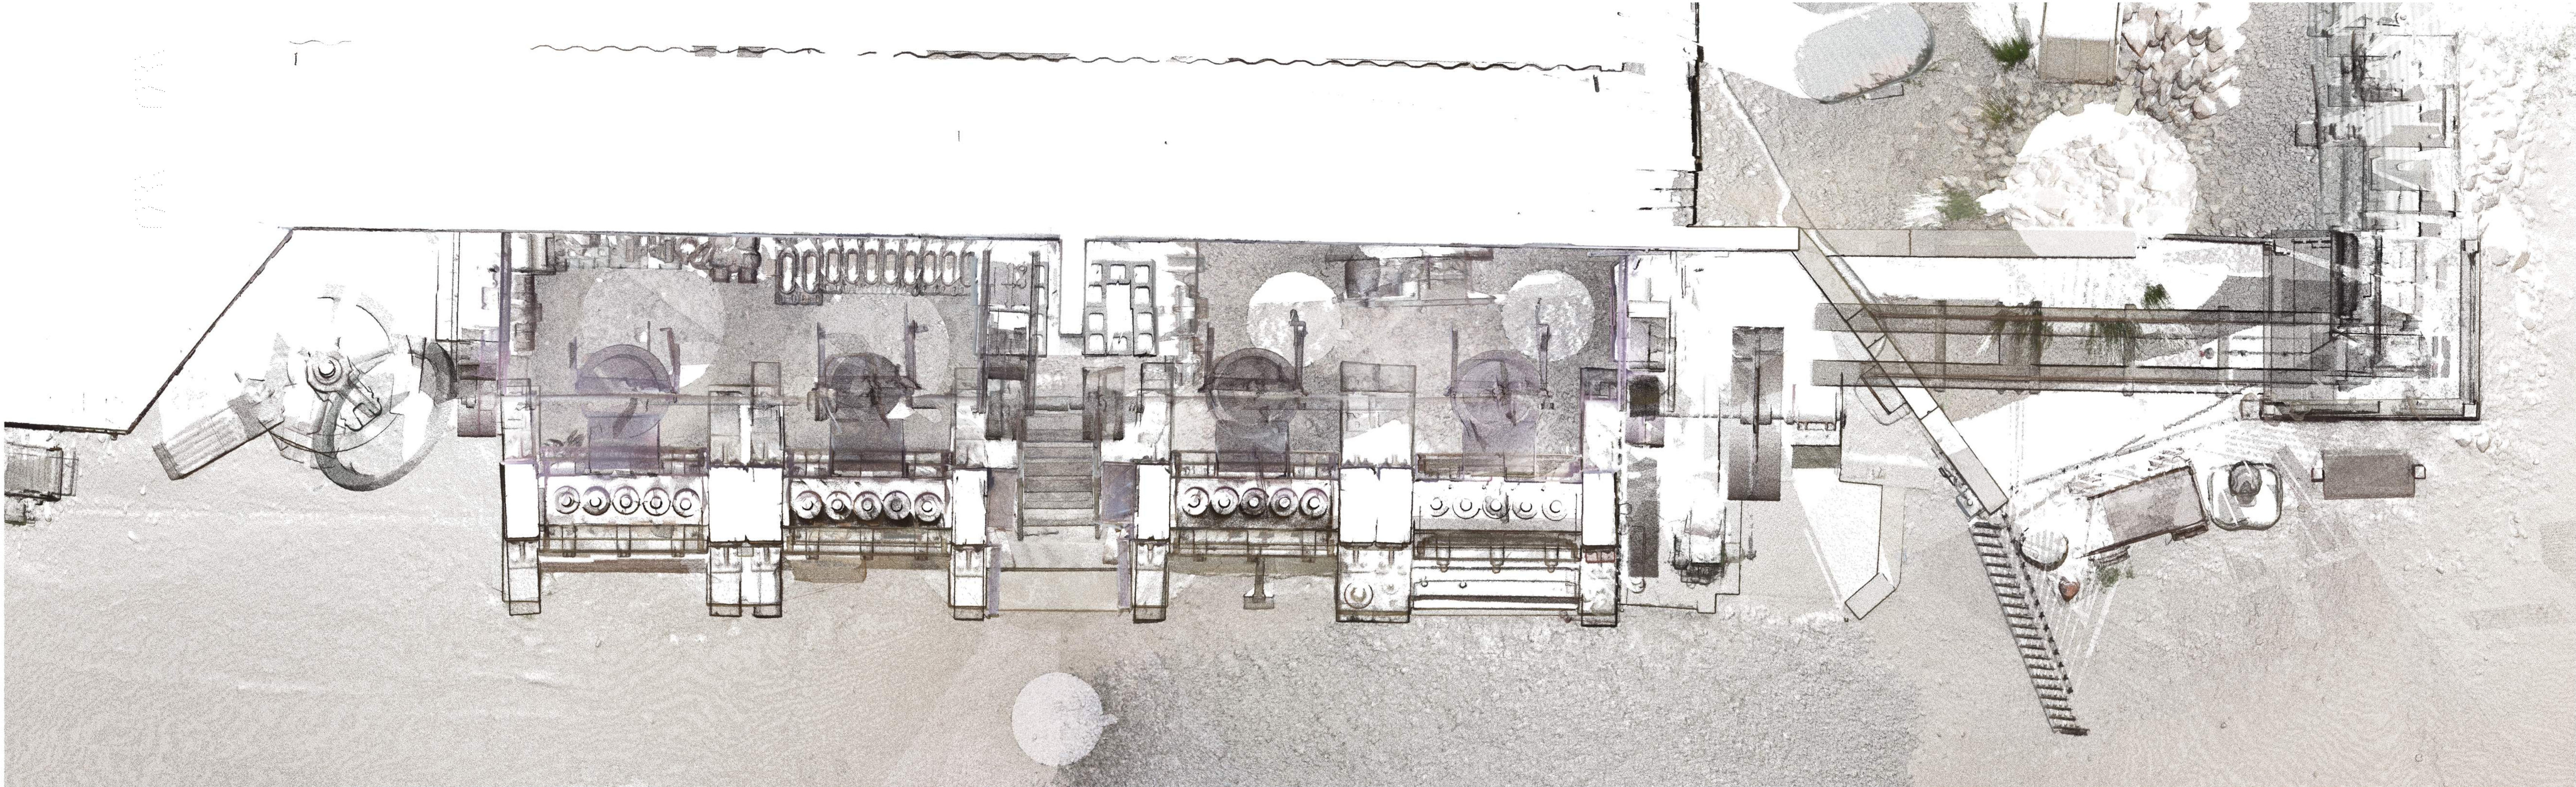

1 ENLARGED 1ST FLOOR PLAN
1/2" = 1'-0"

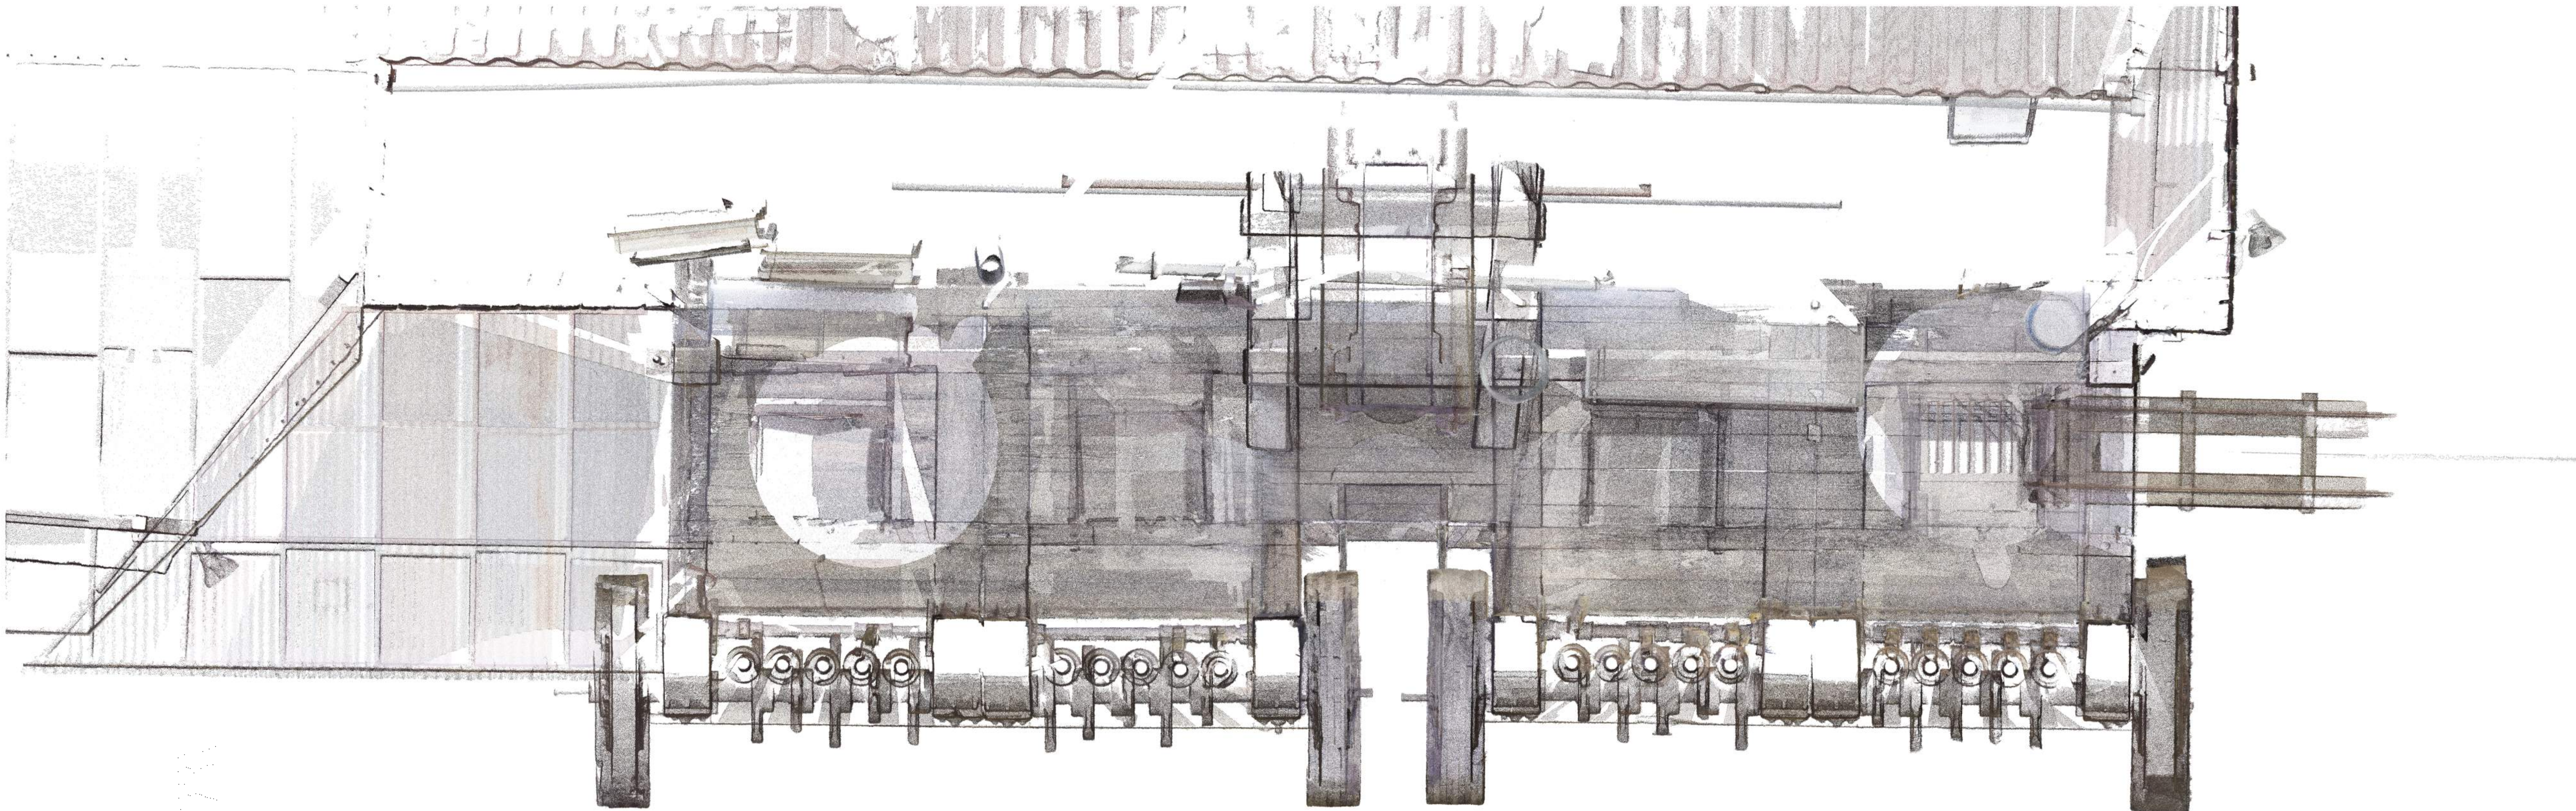

2 ENLARGED 2ND FLOOR PLAN
1/2" = 1'-0"

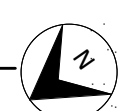

COSSACK 20-STAMP ORE MILL
SUPERSTITION MOUNTAIN MUSEUM
4087 E APACHE TRAIL
APACHE JUNCTION, ARIZONA 85119

REV | DATE | DESCRIPTION

PROJECT #

23-0102

DATE

01/03/2023

SHEET TITLE


ENLARGED STAMP
MILL FLOOR PLAN

SHEET #

A-300



1 REFLECTED CEILING PLAN 1ST FLOOR

1/2" = 1'-0"

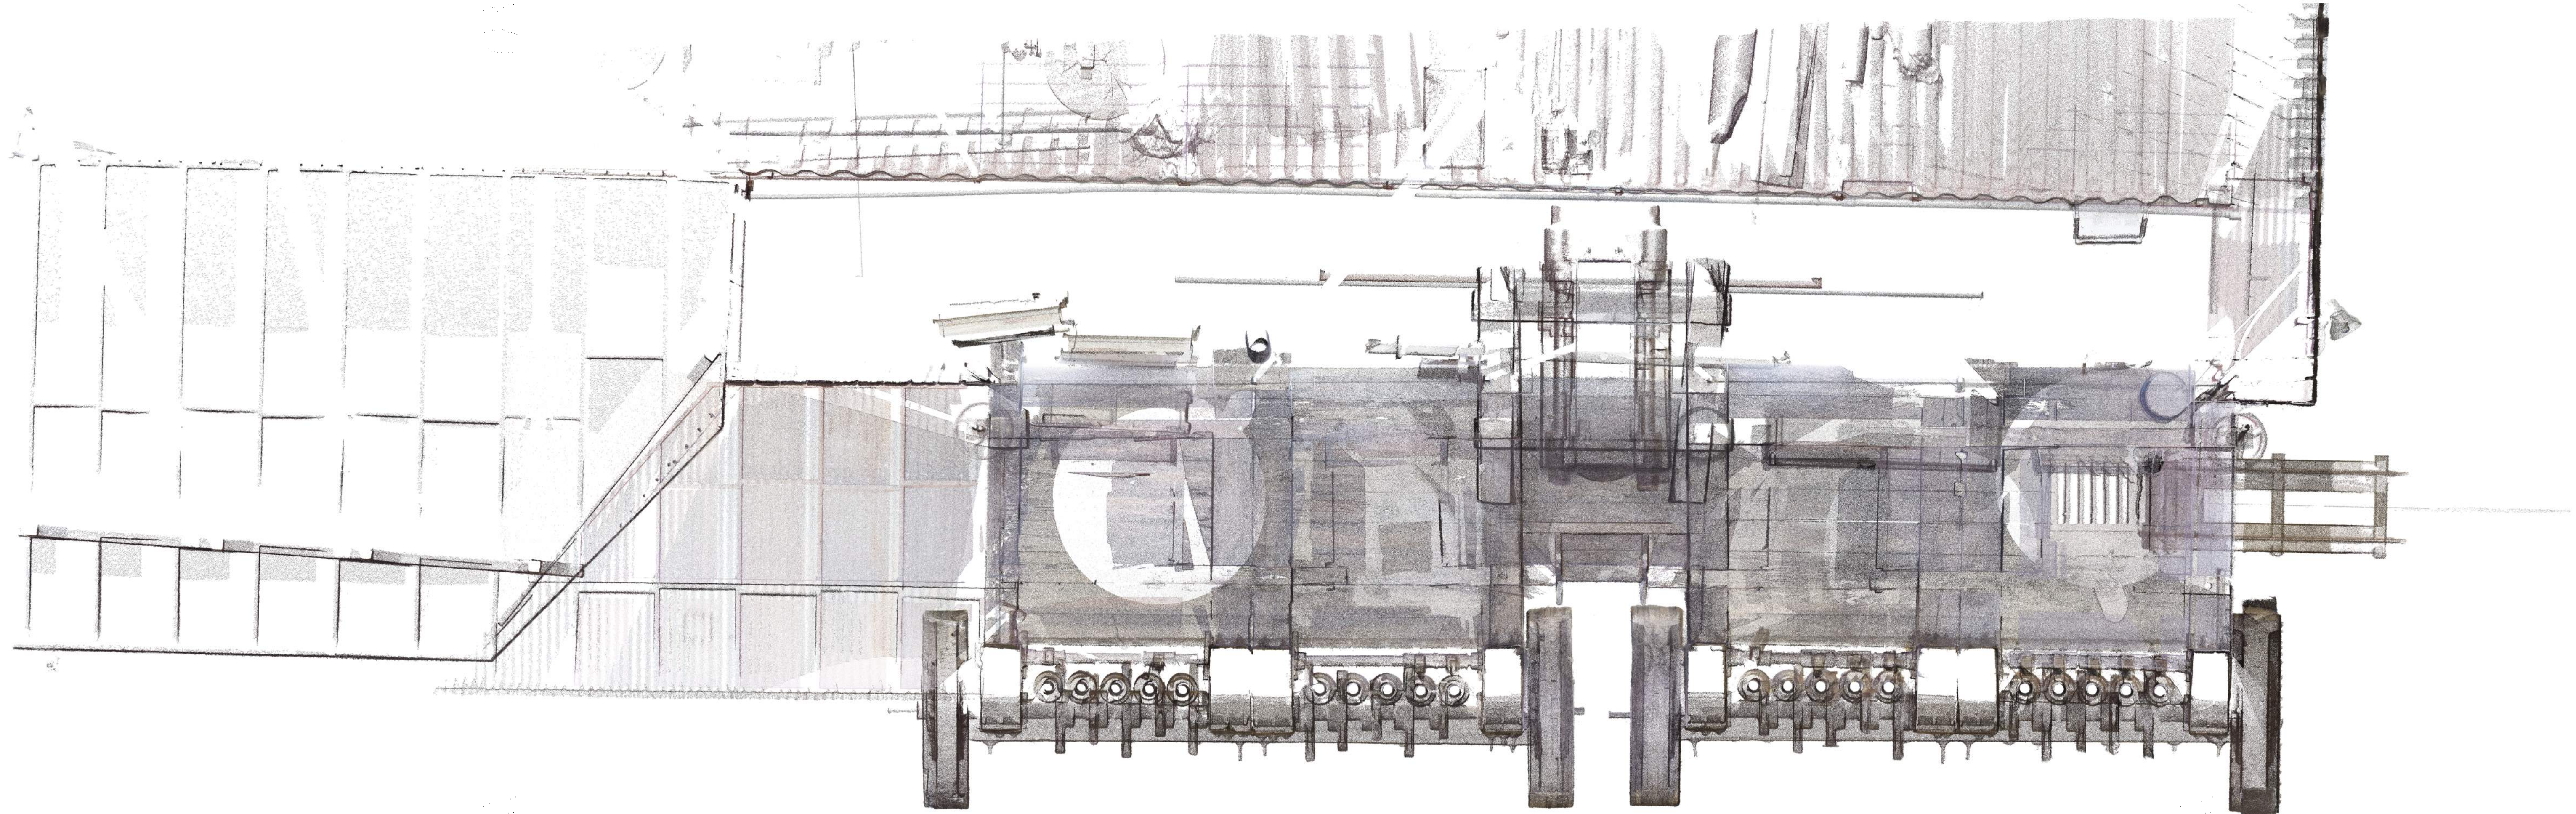

2 REFLECTED CEILING PLAN 2ND FLOOR

1/2" = 1'-0"

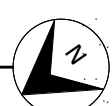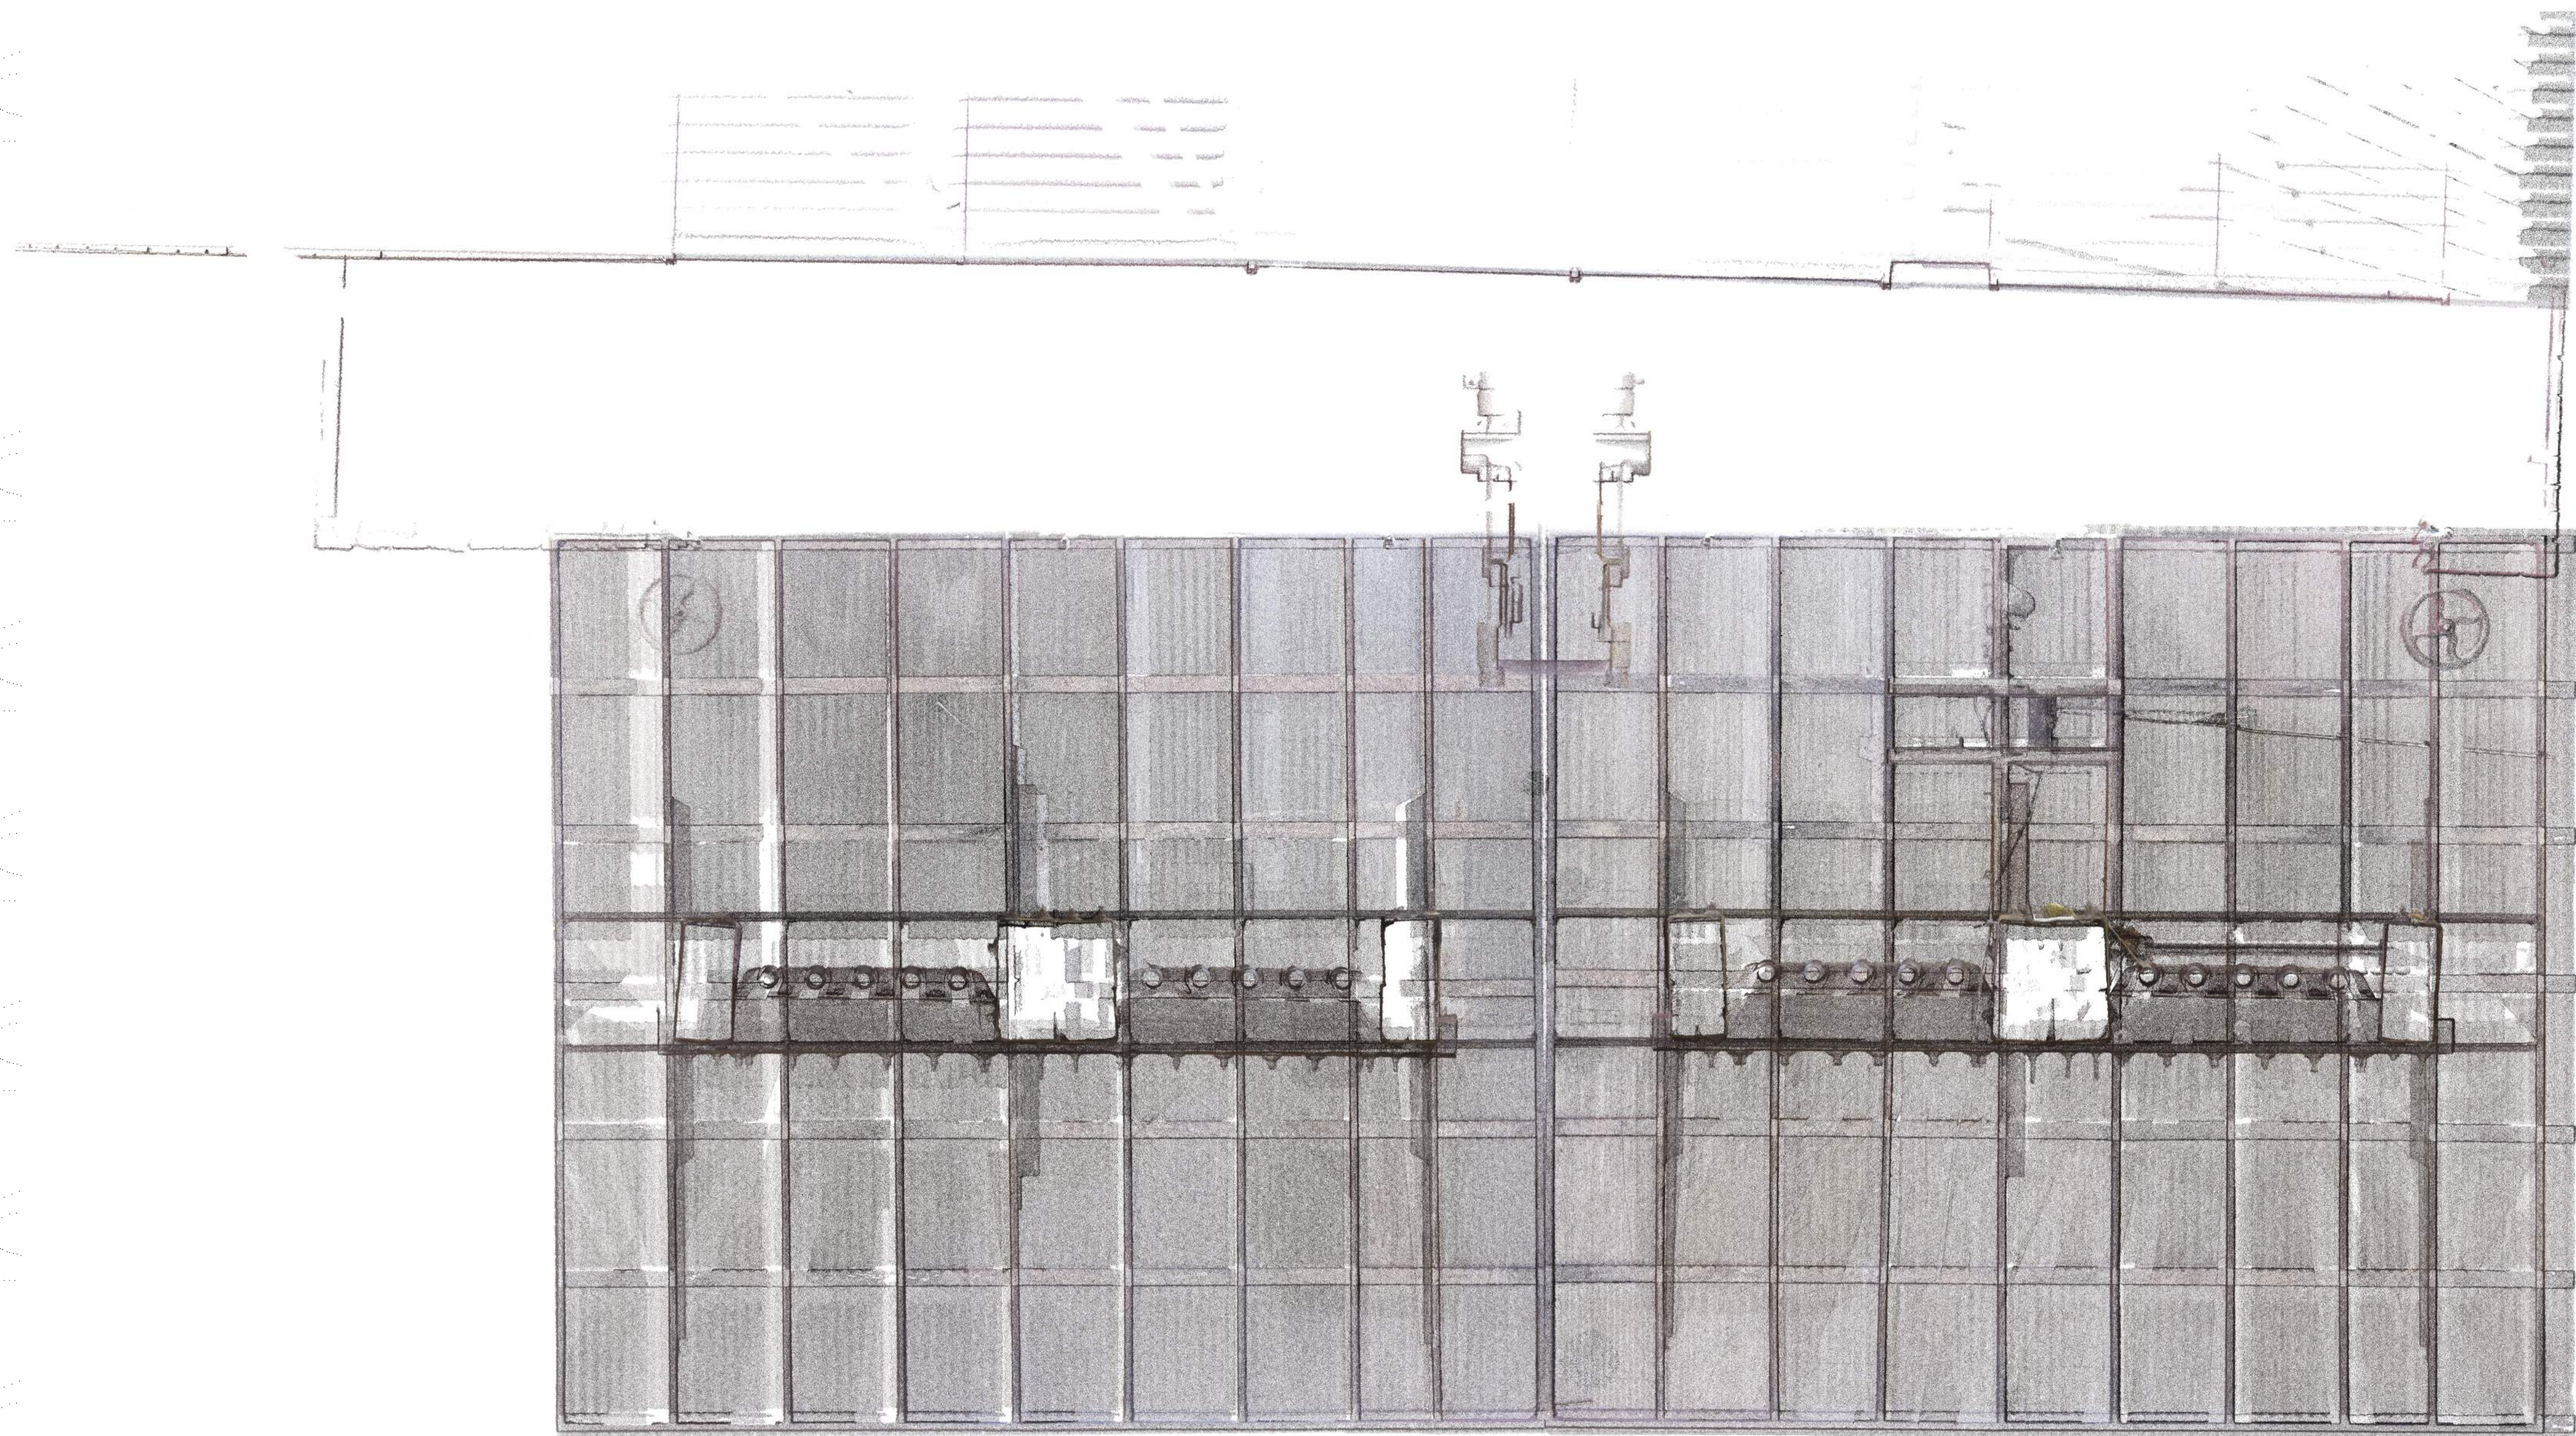

COSSACK 20-STAMP ORE MILL
SUPERSTITION MOUNTAIN MUSEUM
4087 E APACHE TRAIL
APACHE JUNCTION, ARIZONA 85119

REV	DATE	DESCRIPTION
-----	------	-------------

PROJECT #

23-0102

DATE


01/03/2023

SHEET TITLE


REFLECTED CEILING
PLAN

SHEET #


A-400

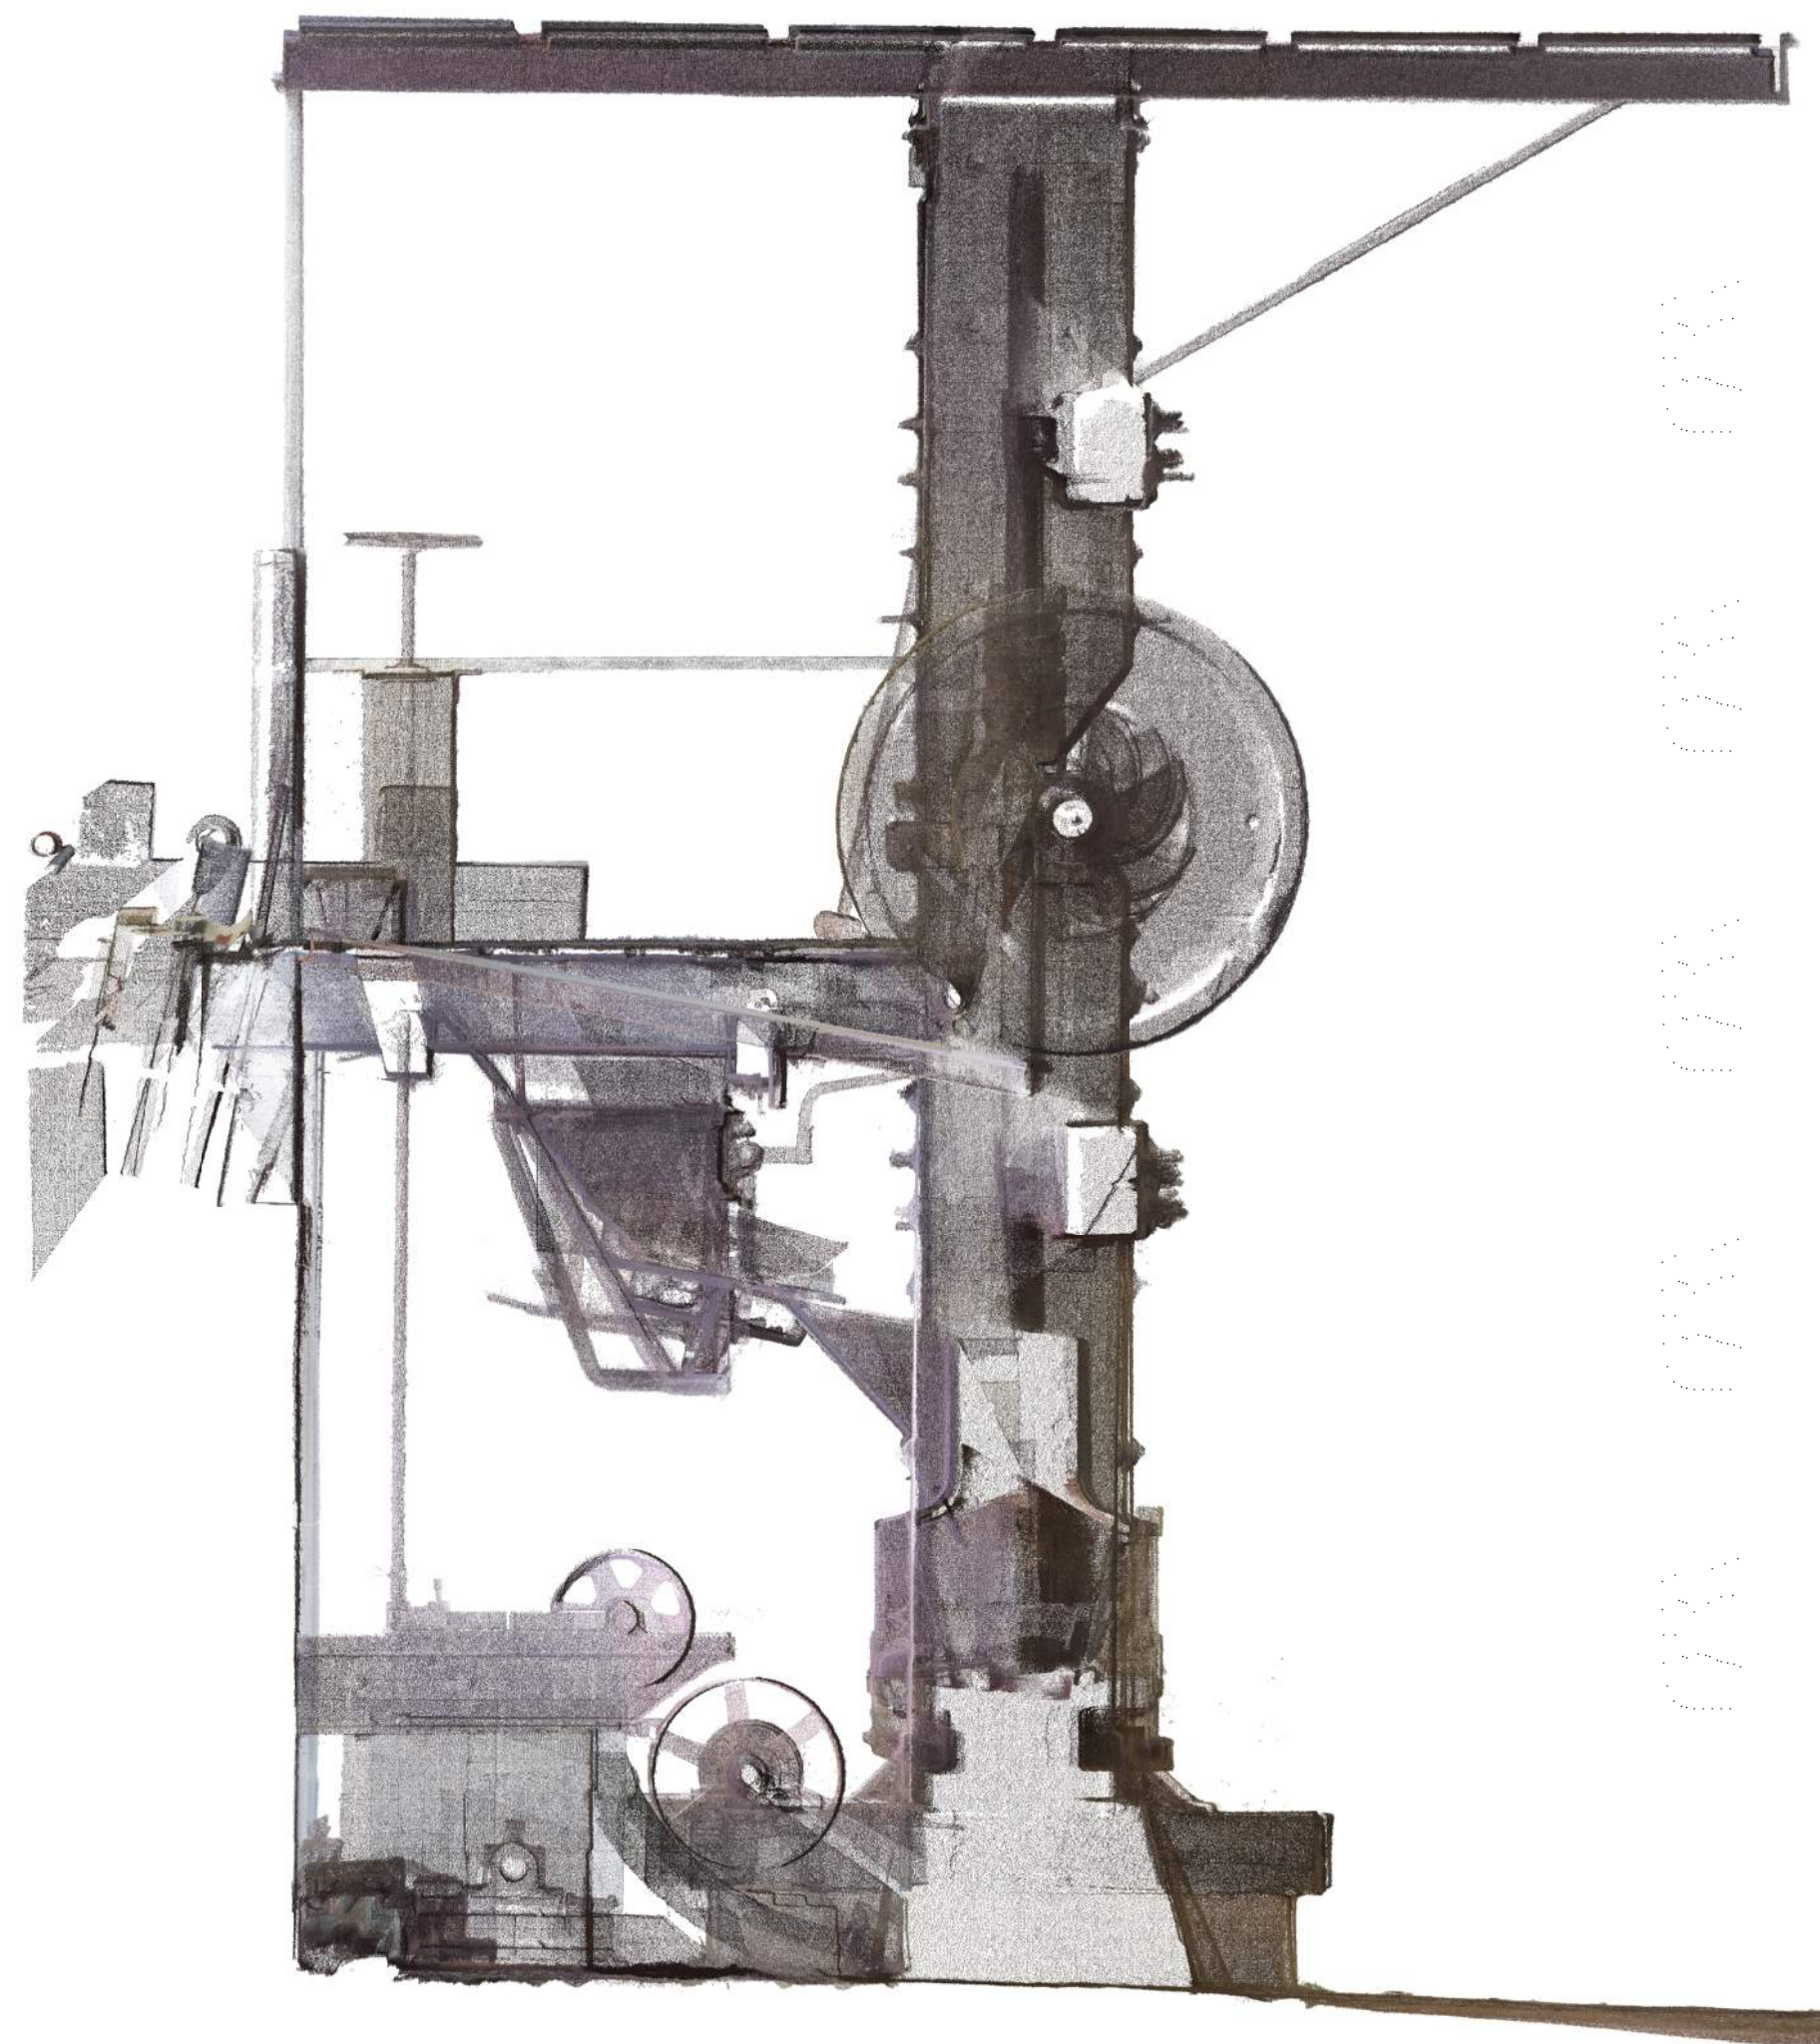


1 LEFT SIDE ELEVATION
1/2" = 1'-0"

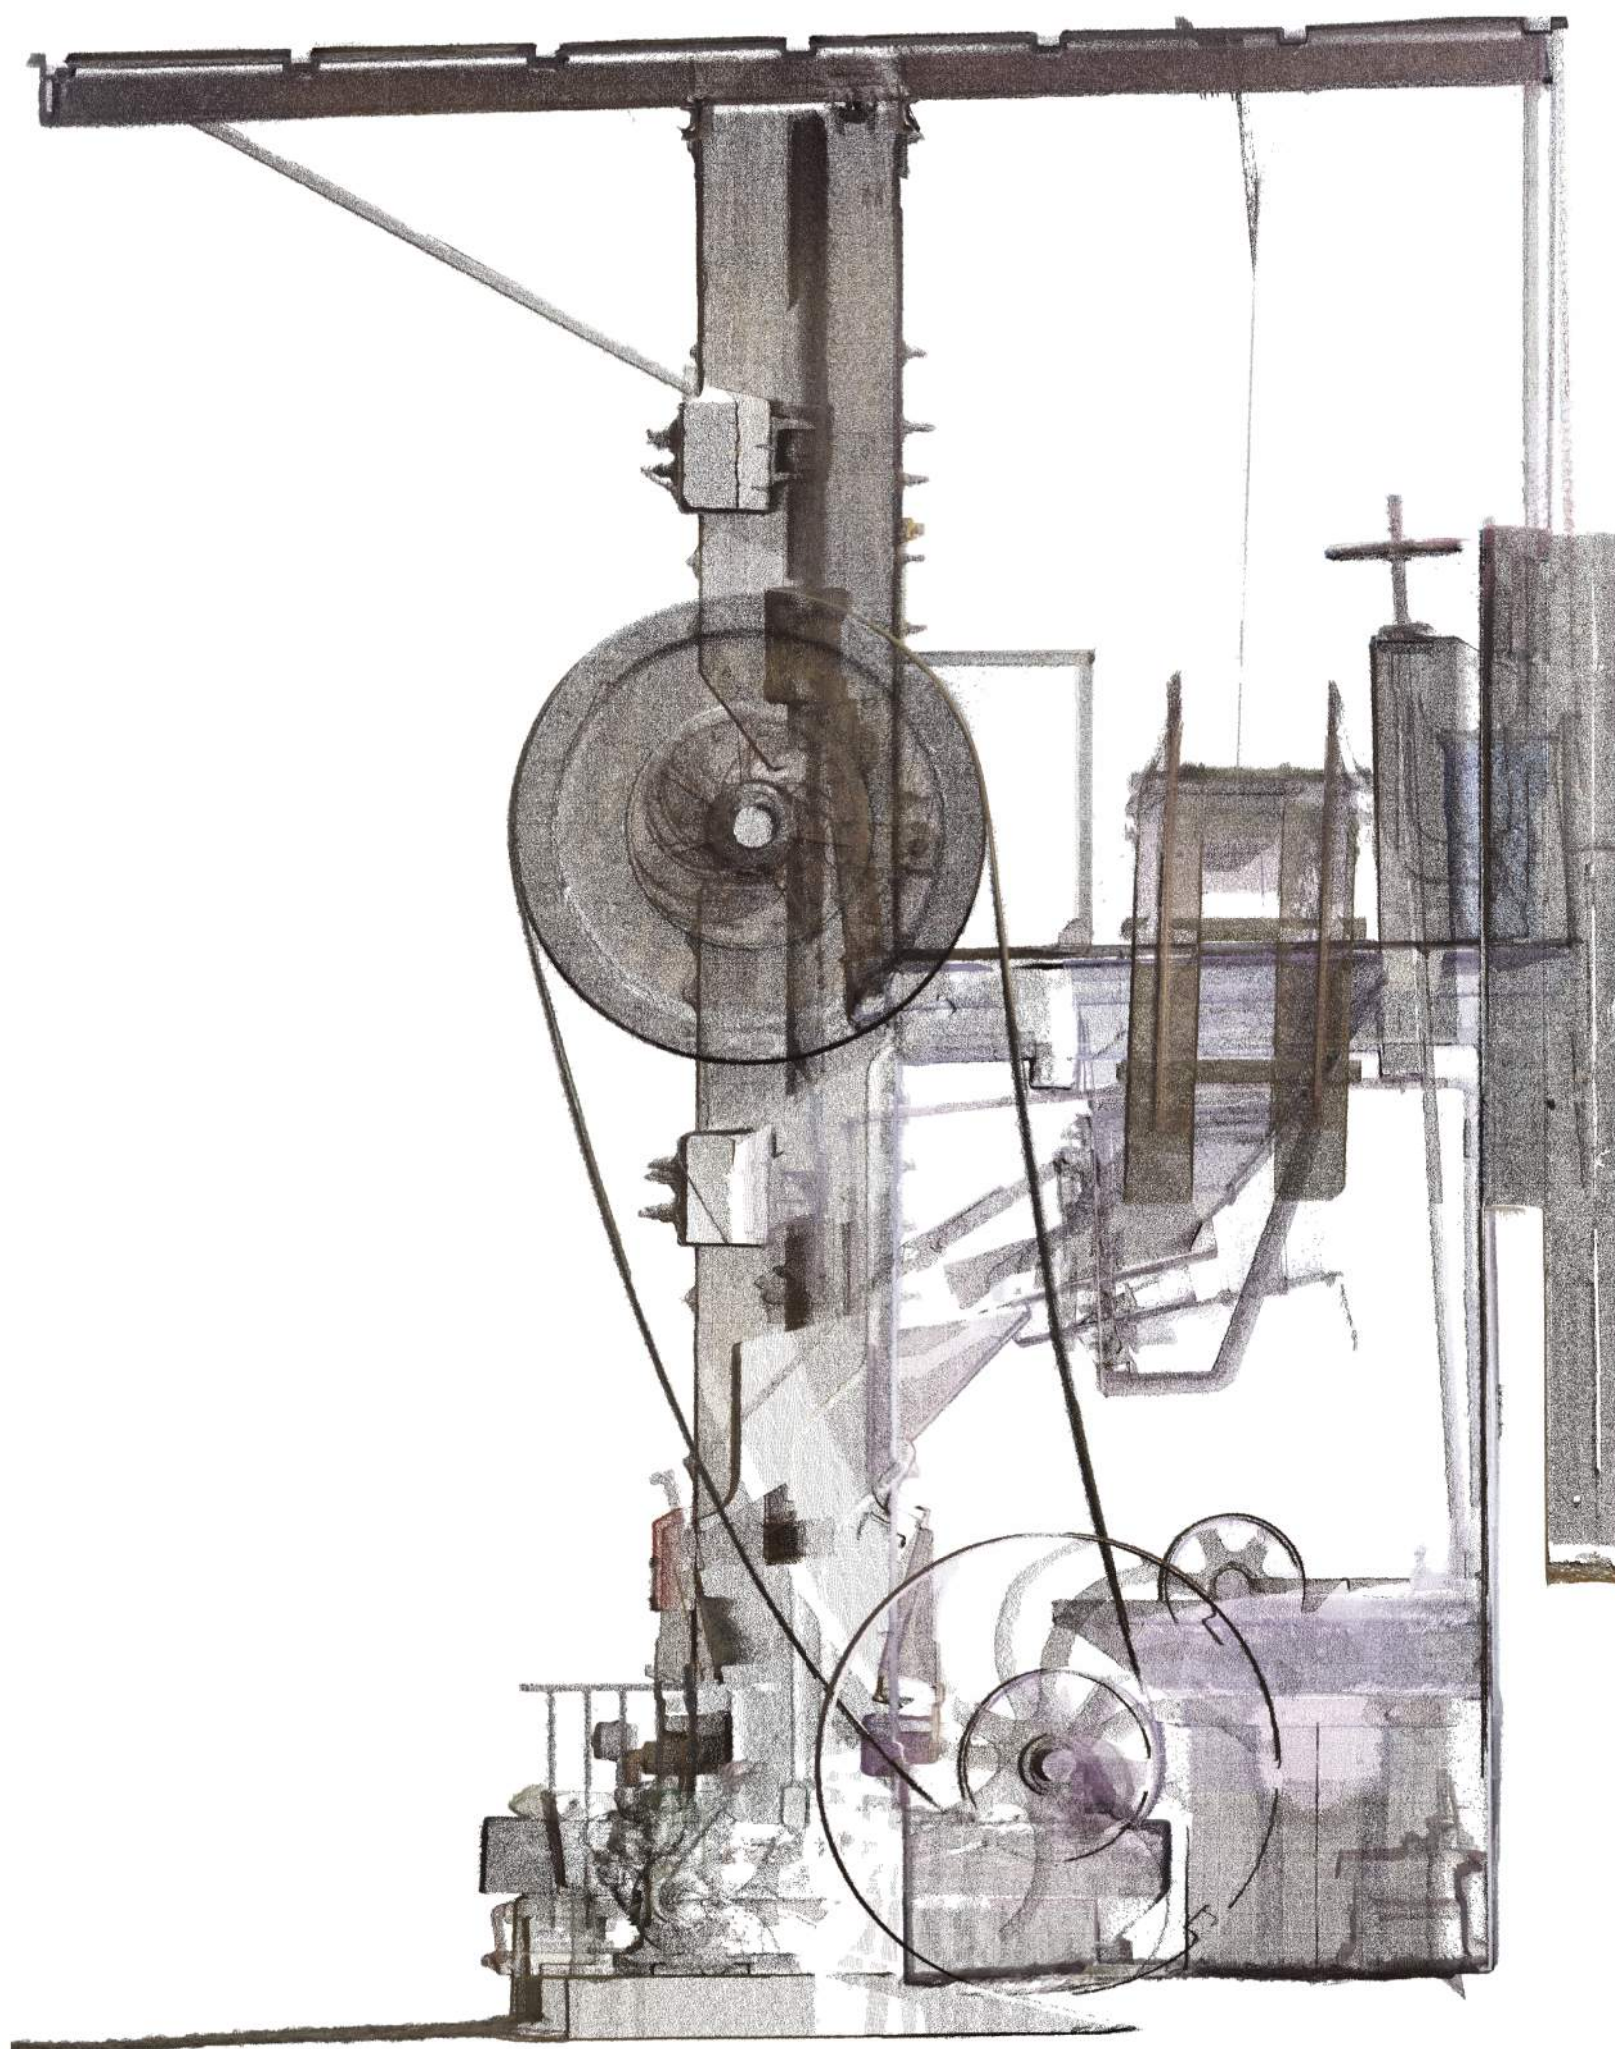


2 RIGHT SIDE ELEVATION
1/2" = 1'-0"

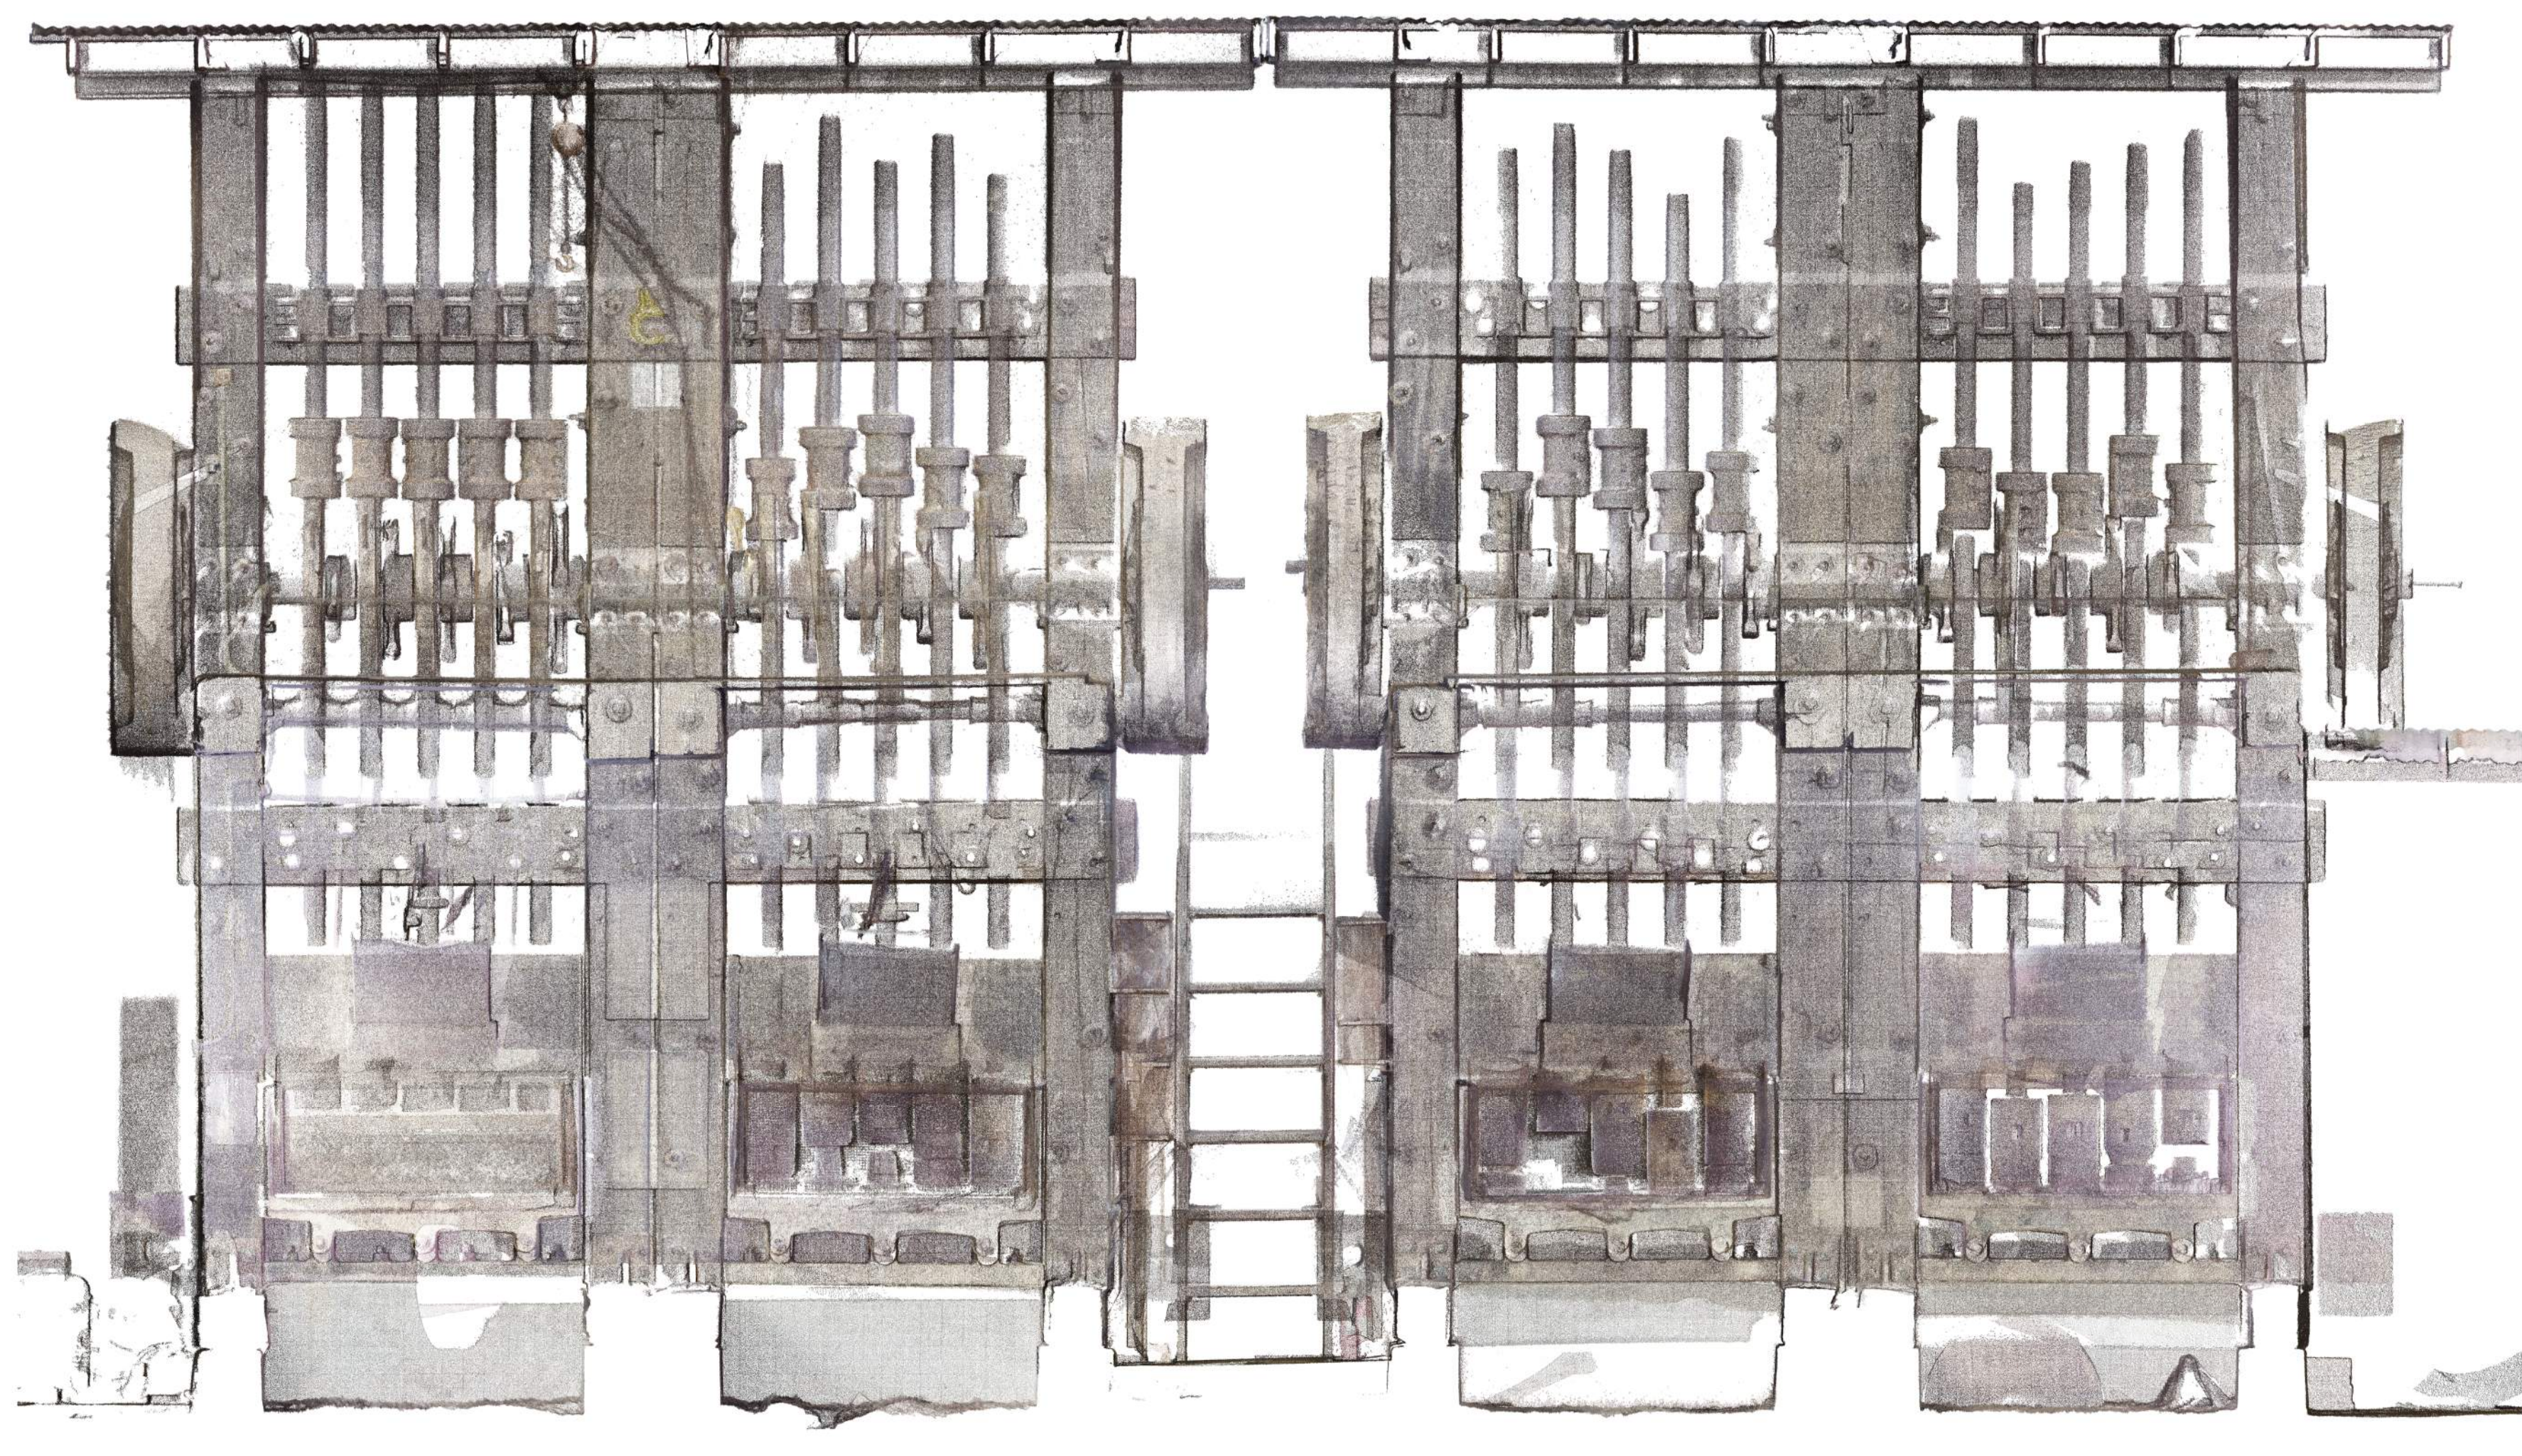


3 INSIDE ELEVATION
1/2" = 1'-0"

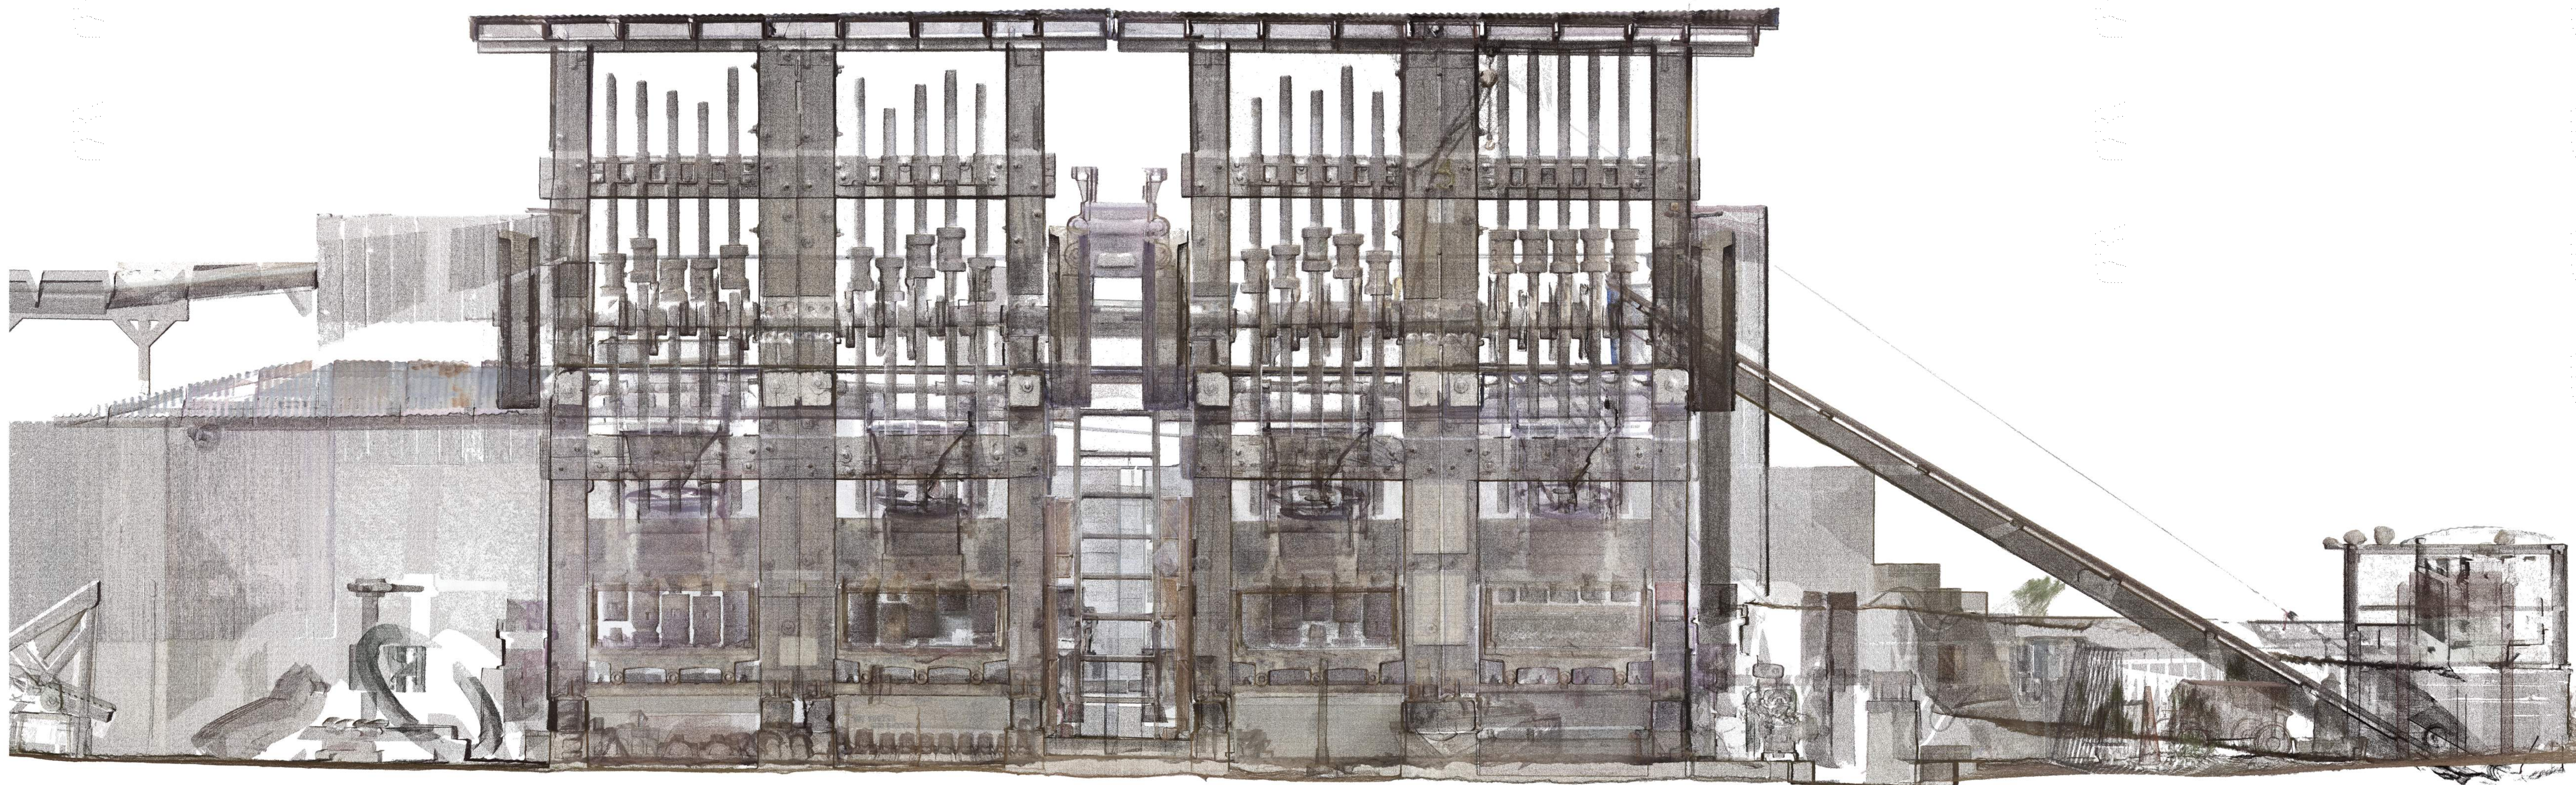


4 FRONT ELEVATION
1/2" = 1'-0"

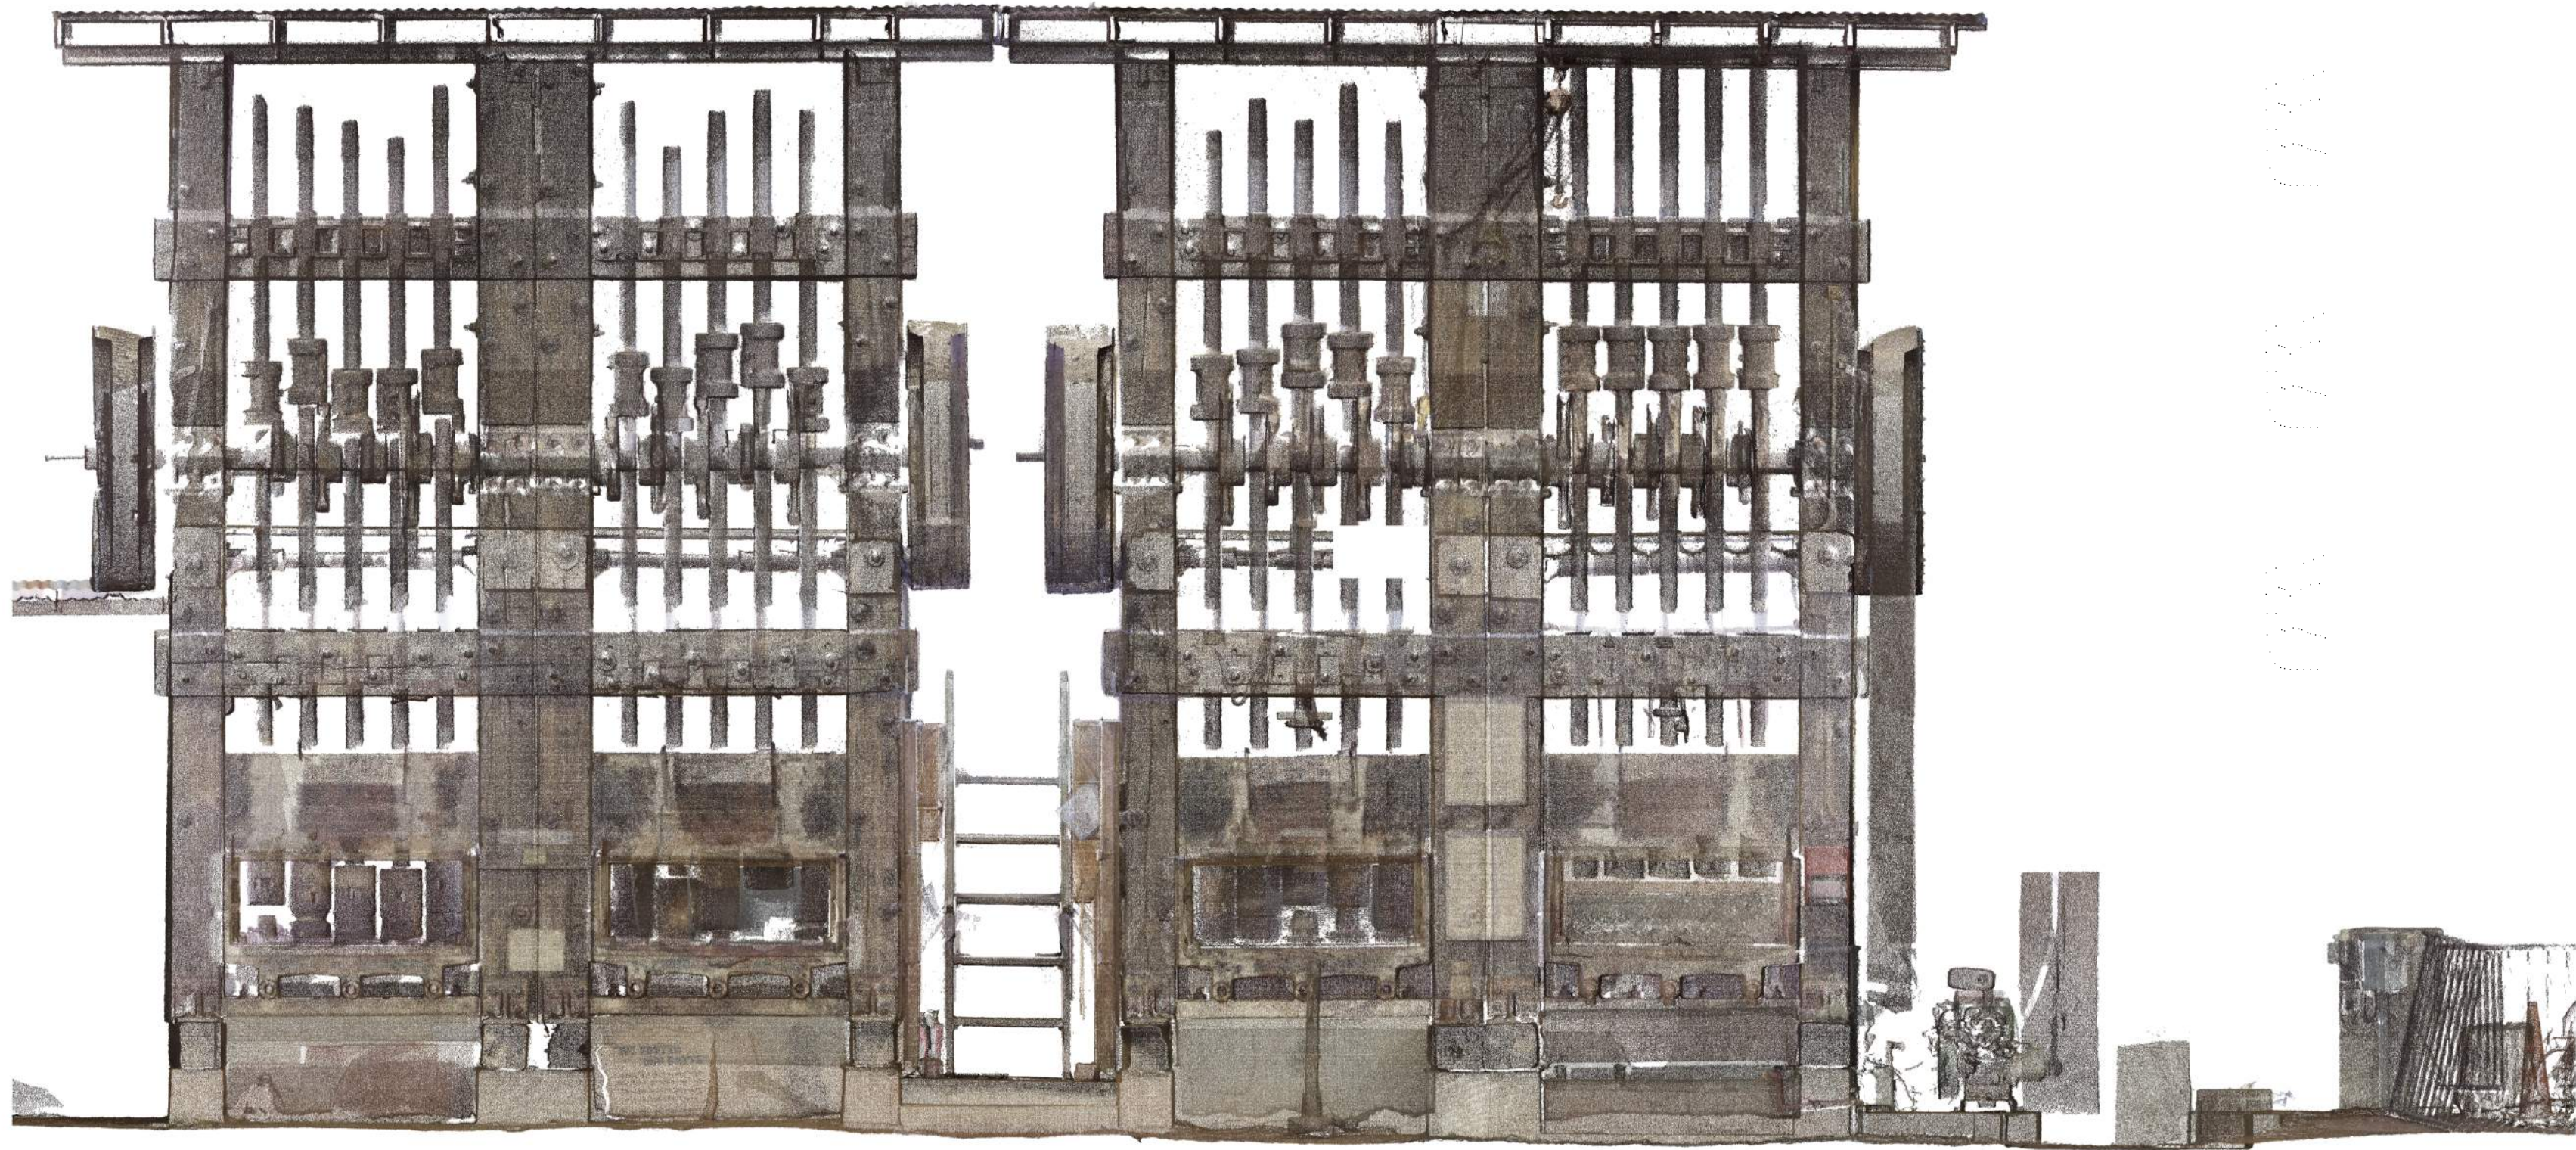


1 STAMP MILL - SECTION 1
3/8" = 1'-0"

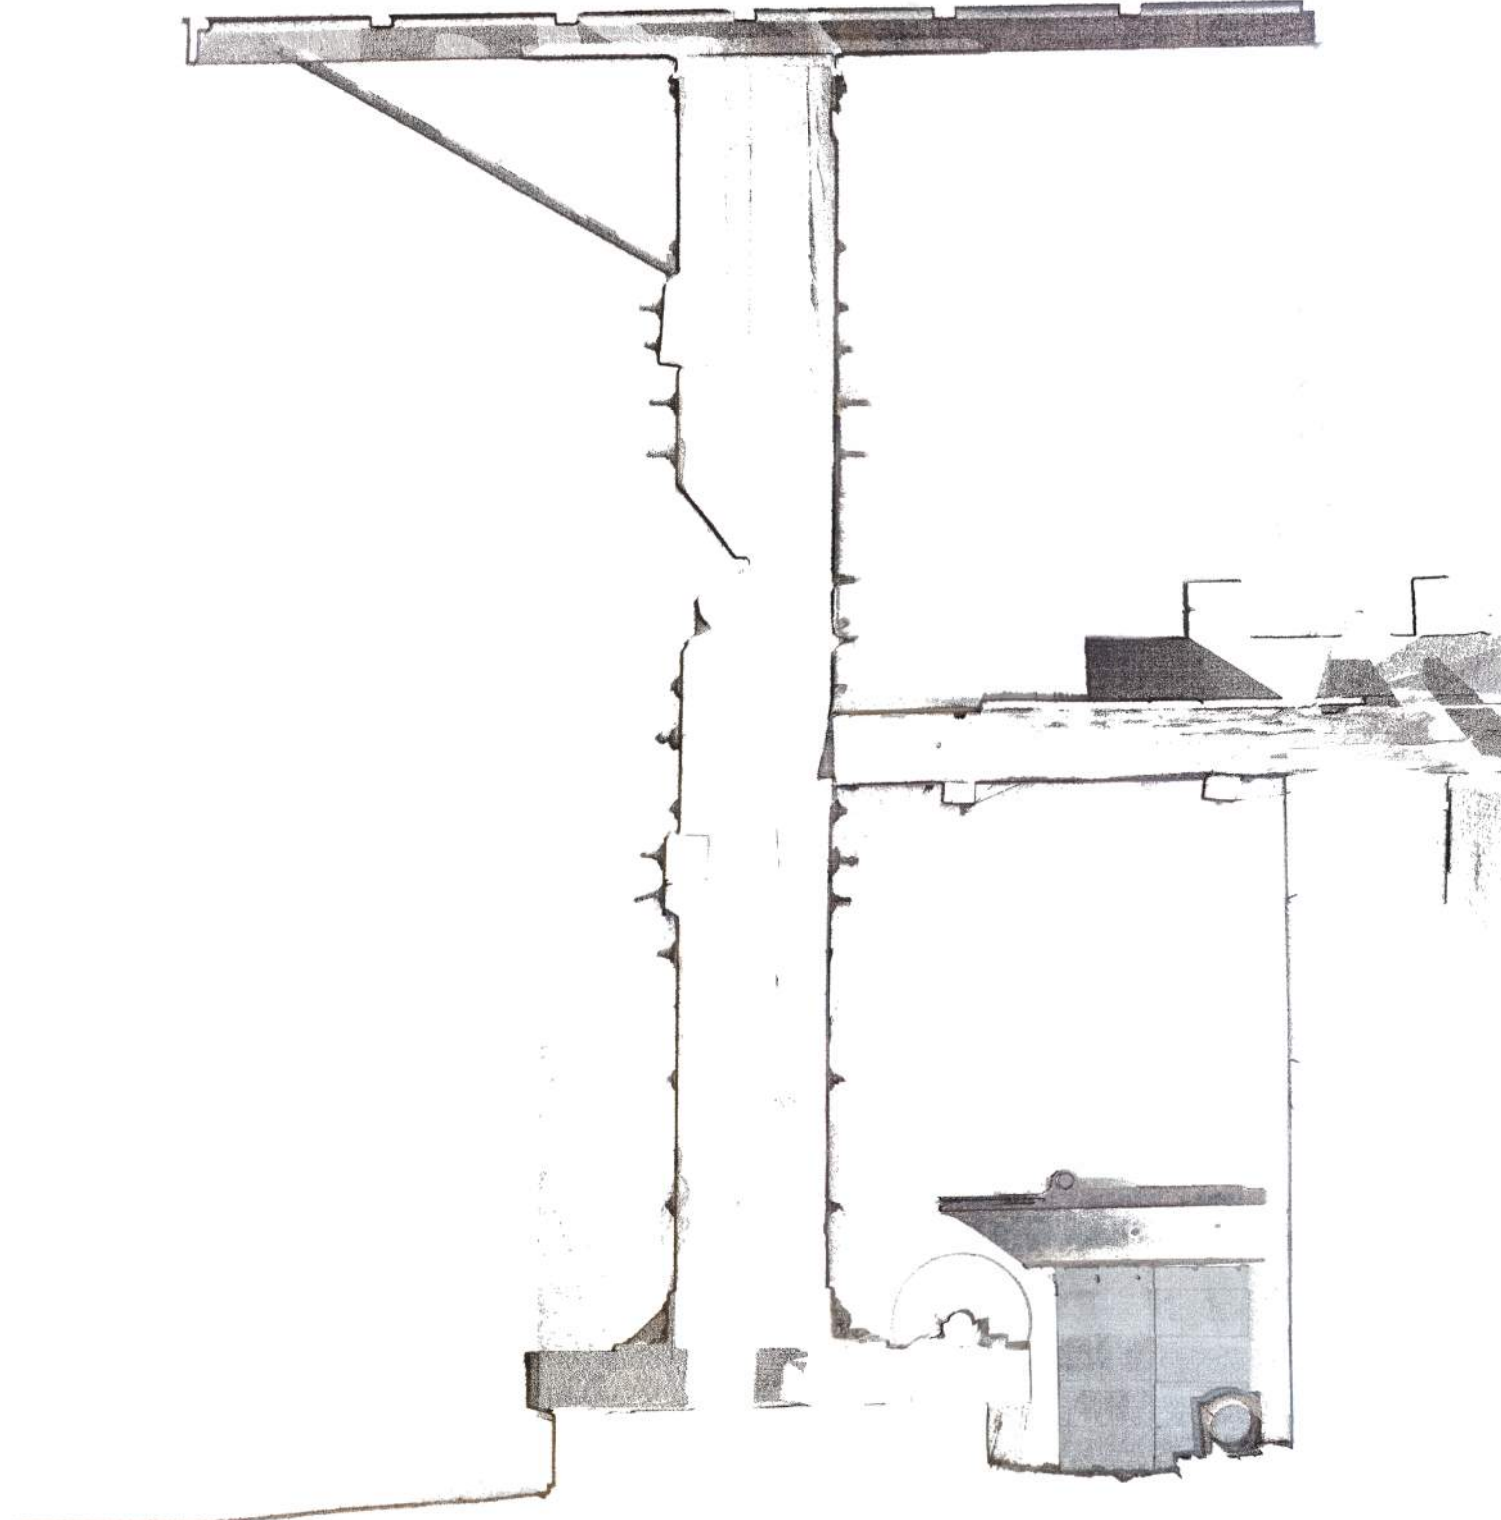


2 STAMP MILL - SECTION 2
3/8" = 1'-0"

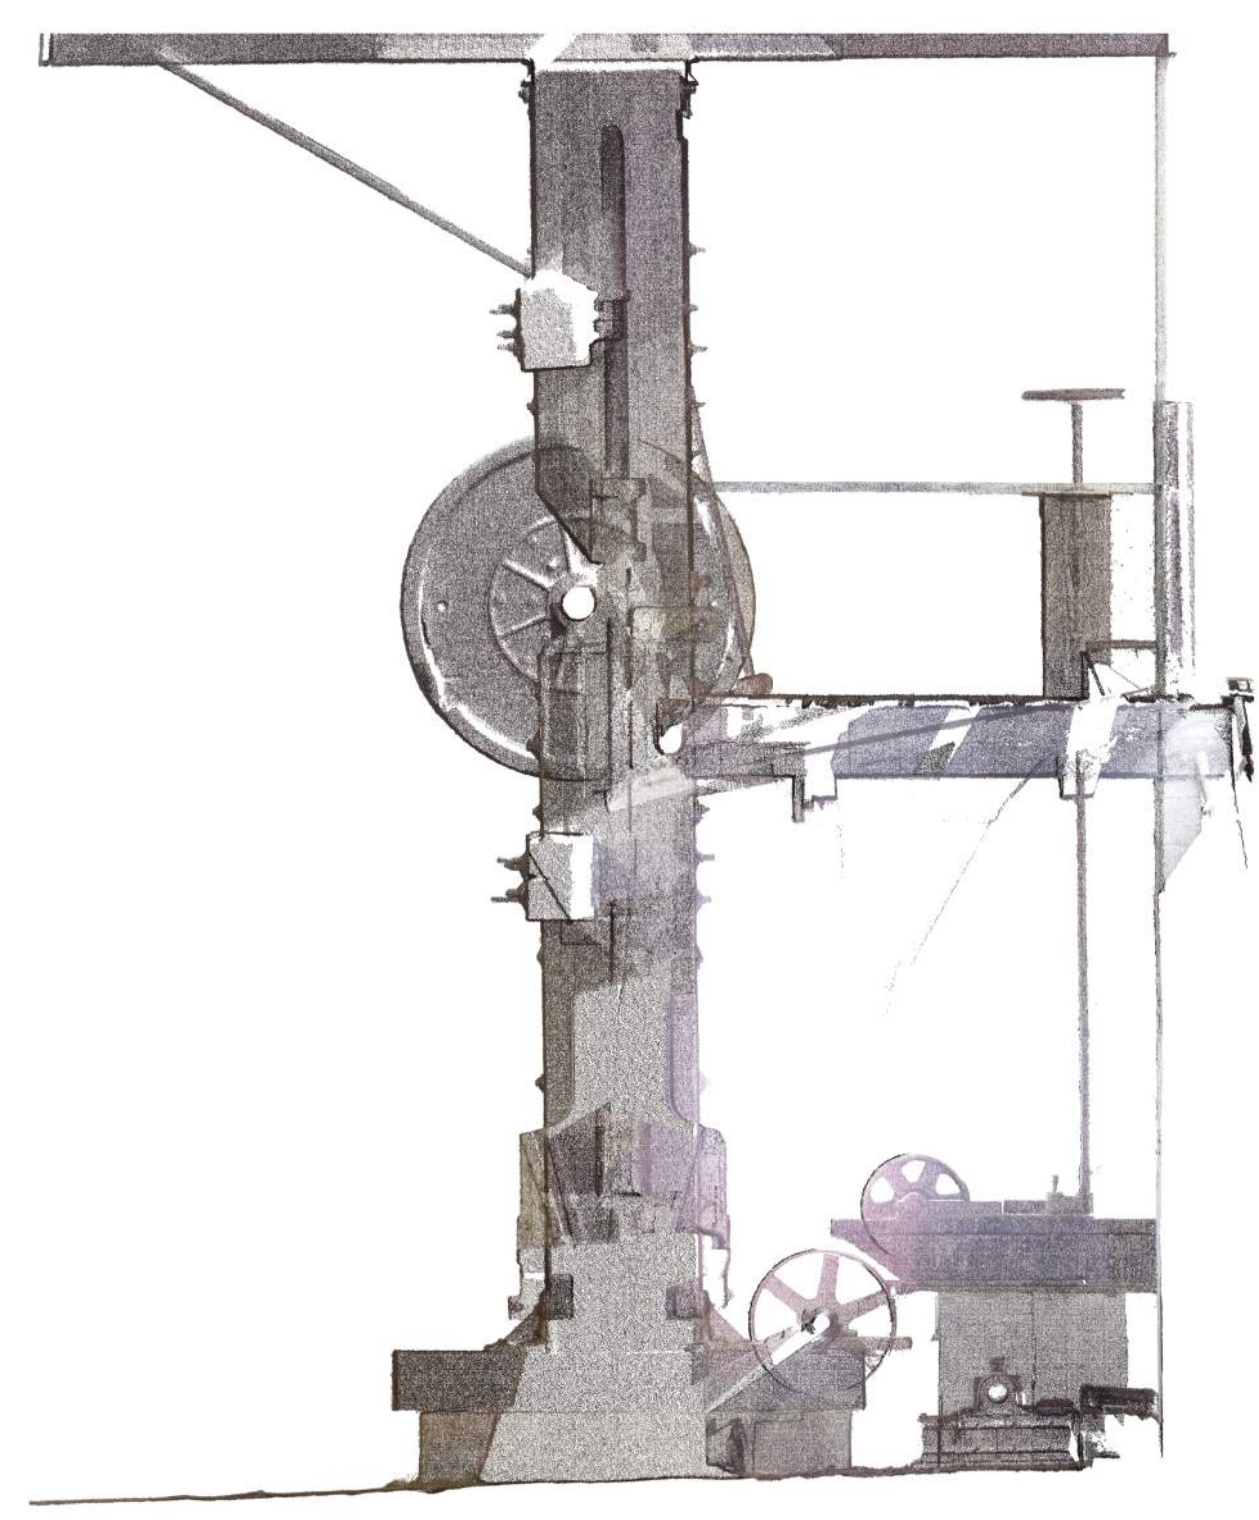


4 STAMP MILL - SECTION 4
3/8" = 1'-0"

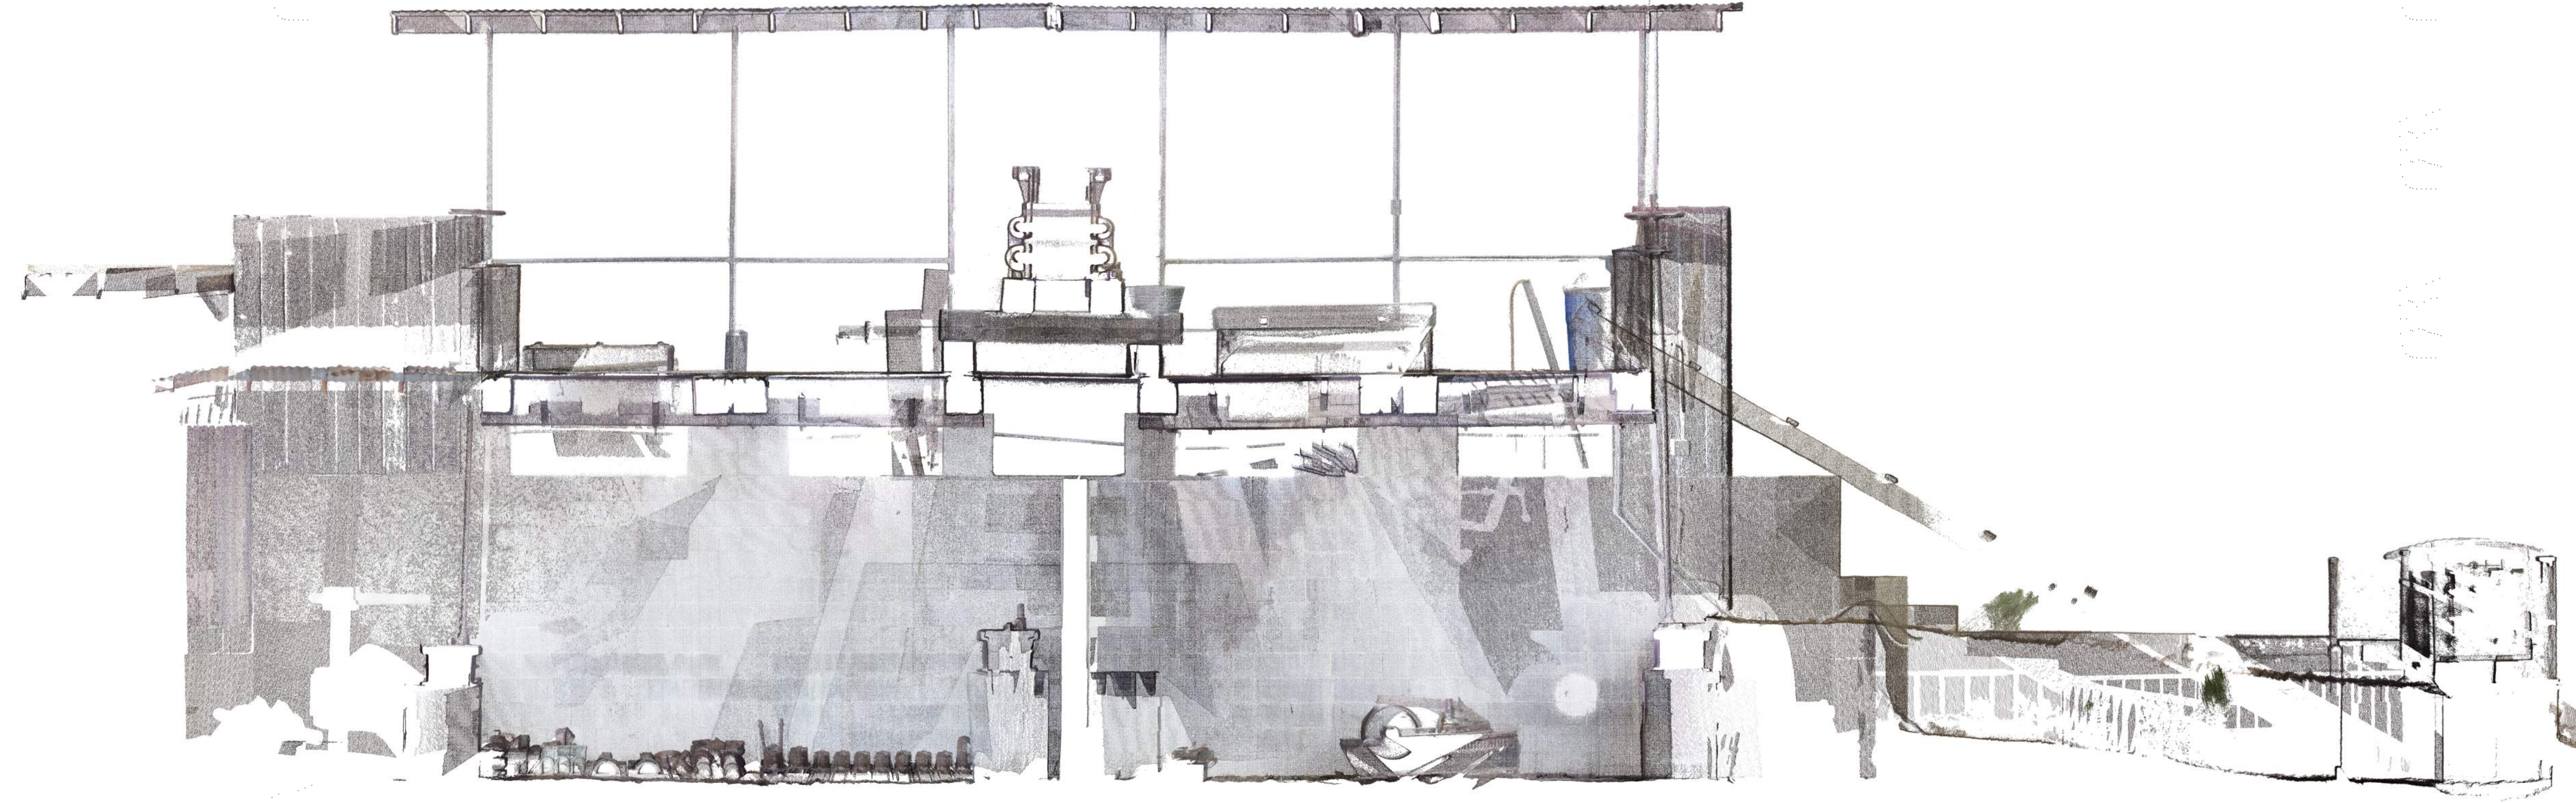


3 STAMP MILL - SECTION 5
3/8" = 1'-0"

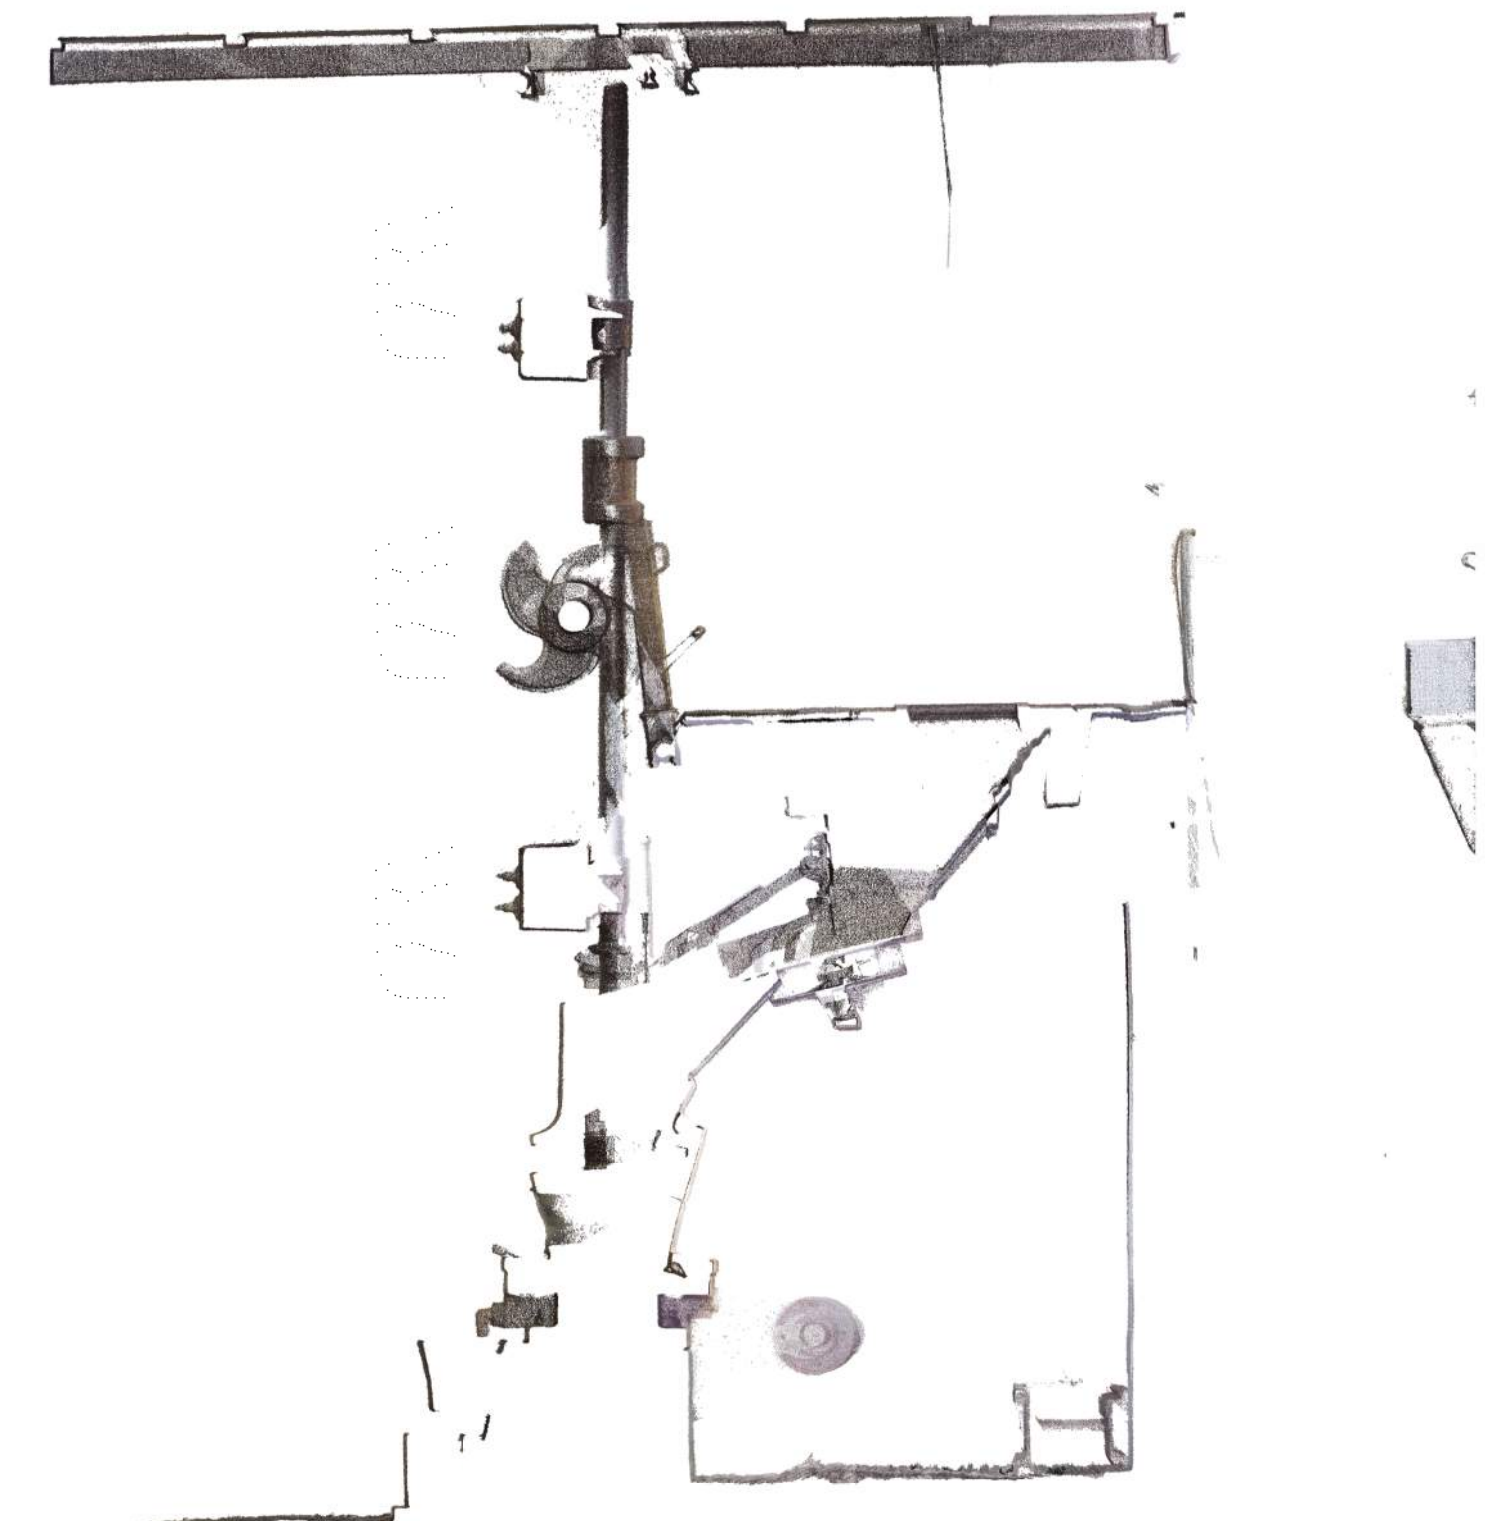

5 STAMP MILL - SECTION 3
3/8" = 1'-0"

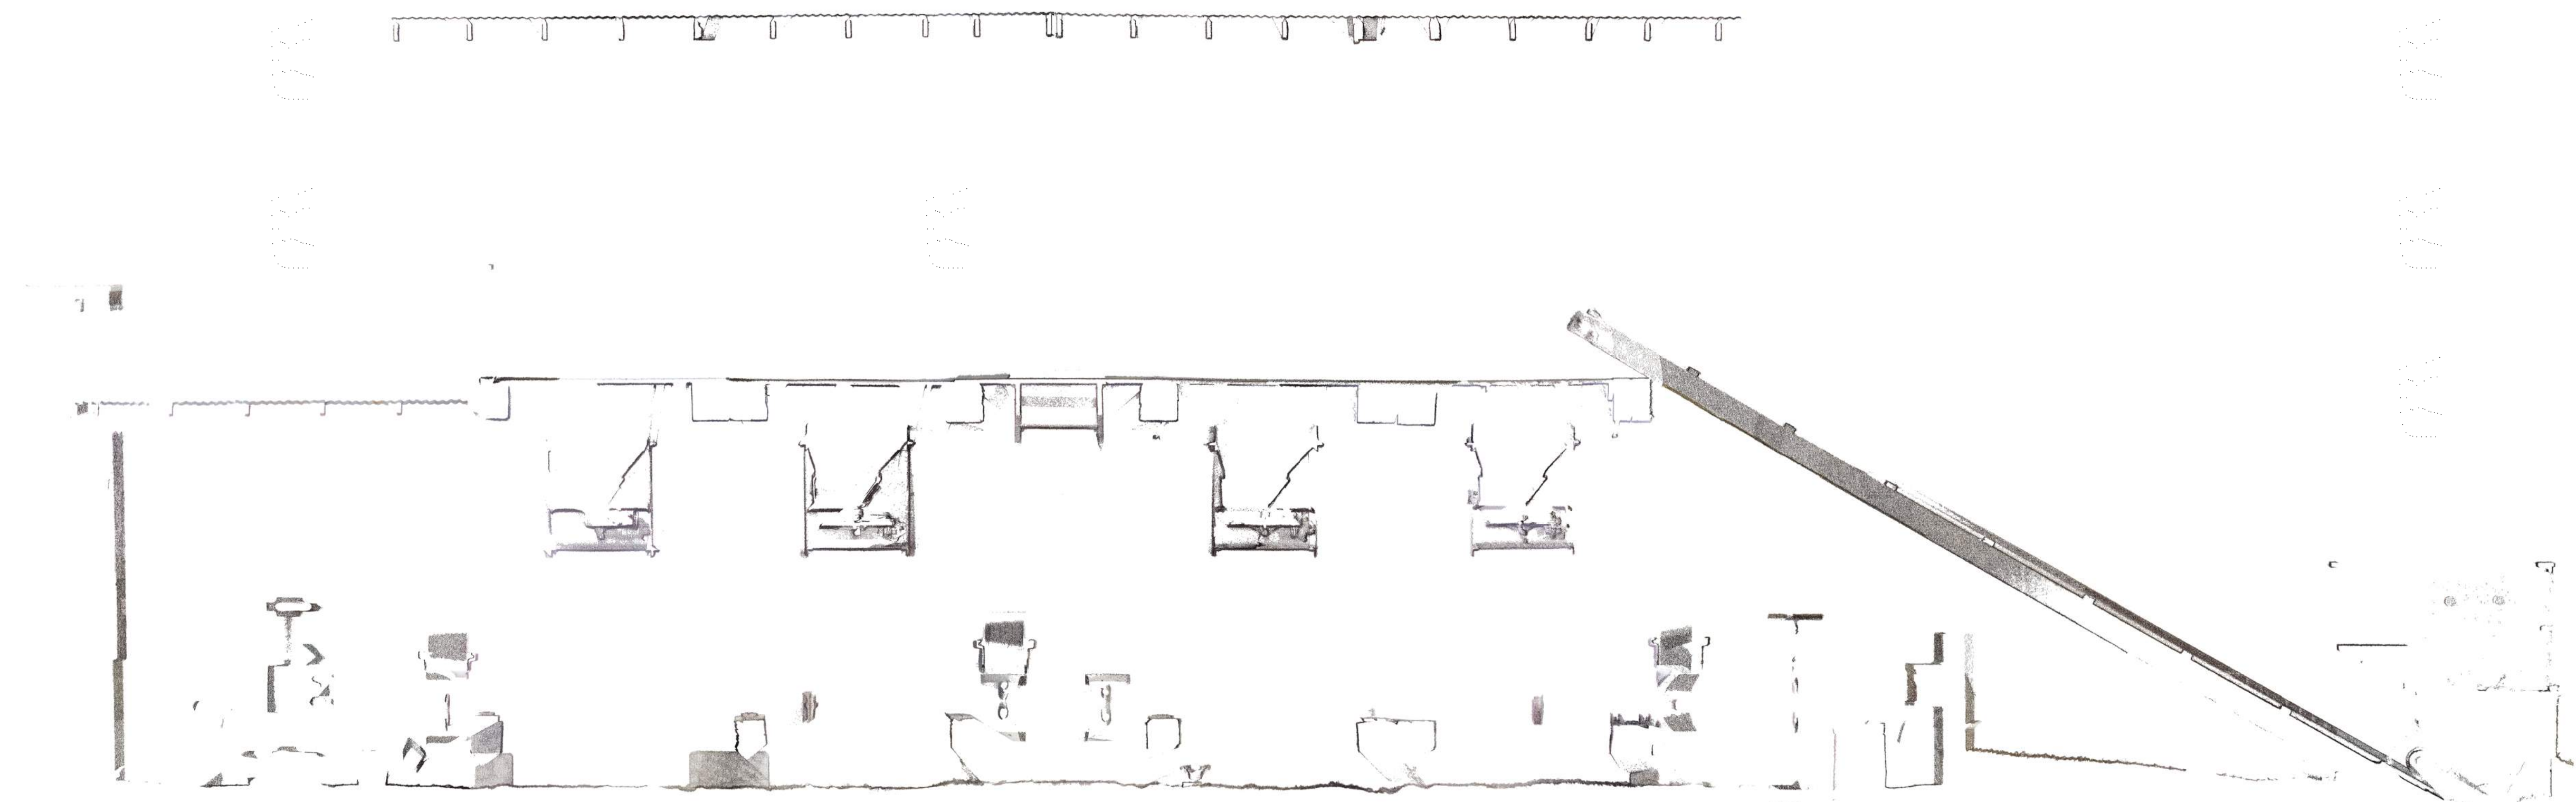

7 STAMP MILL - SECTION 7
3/8" = 1'-0"

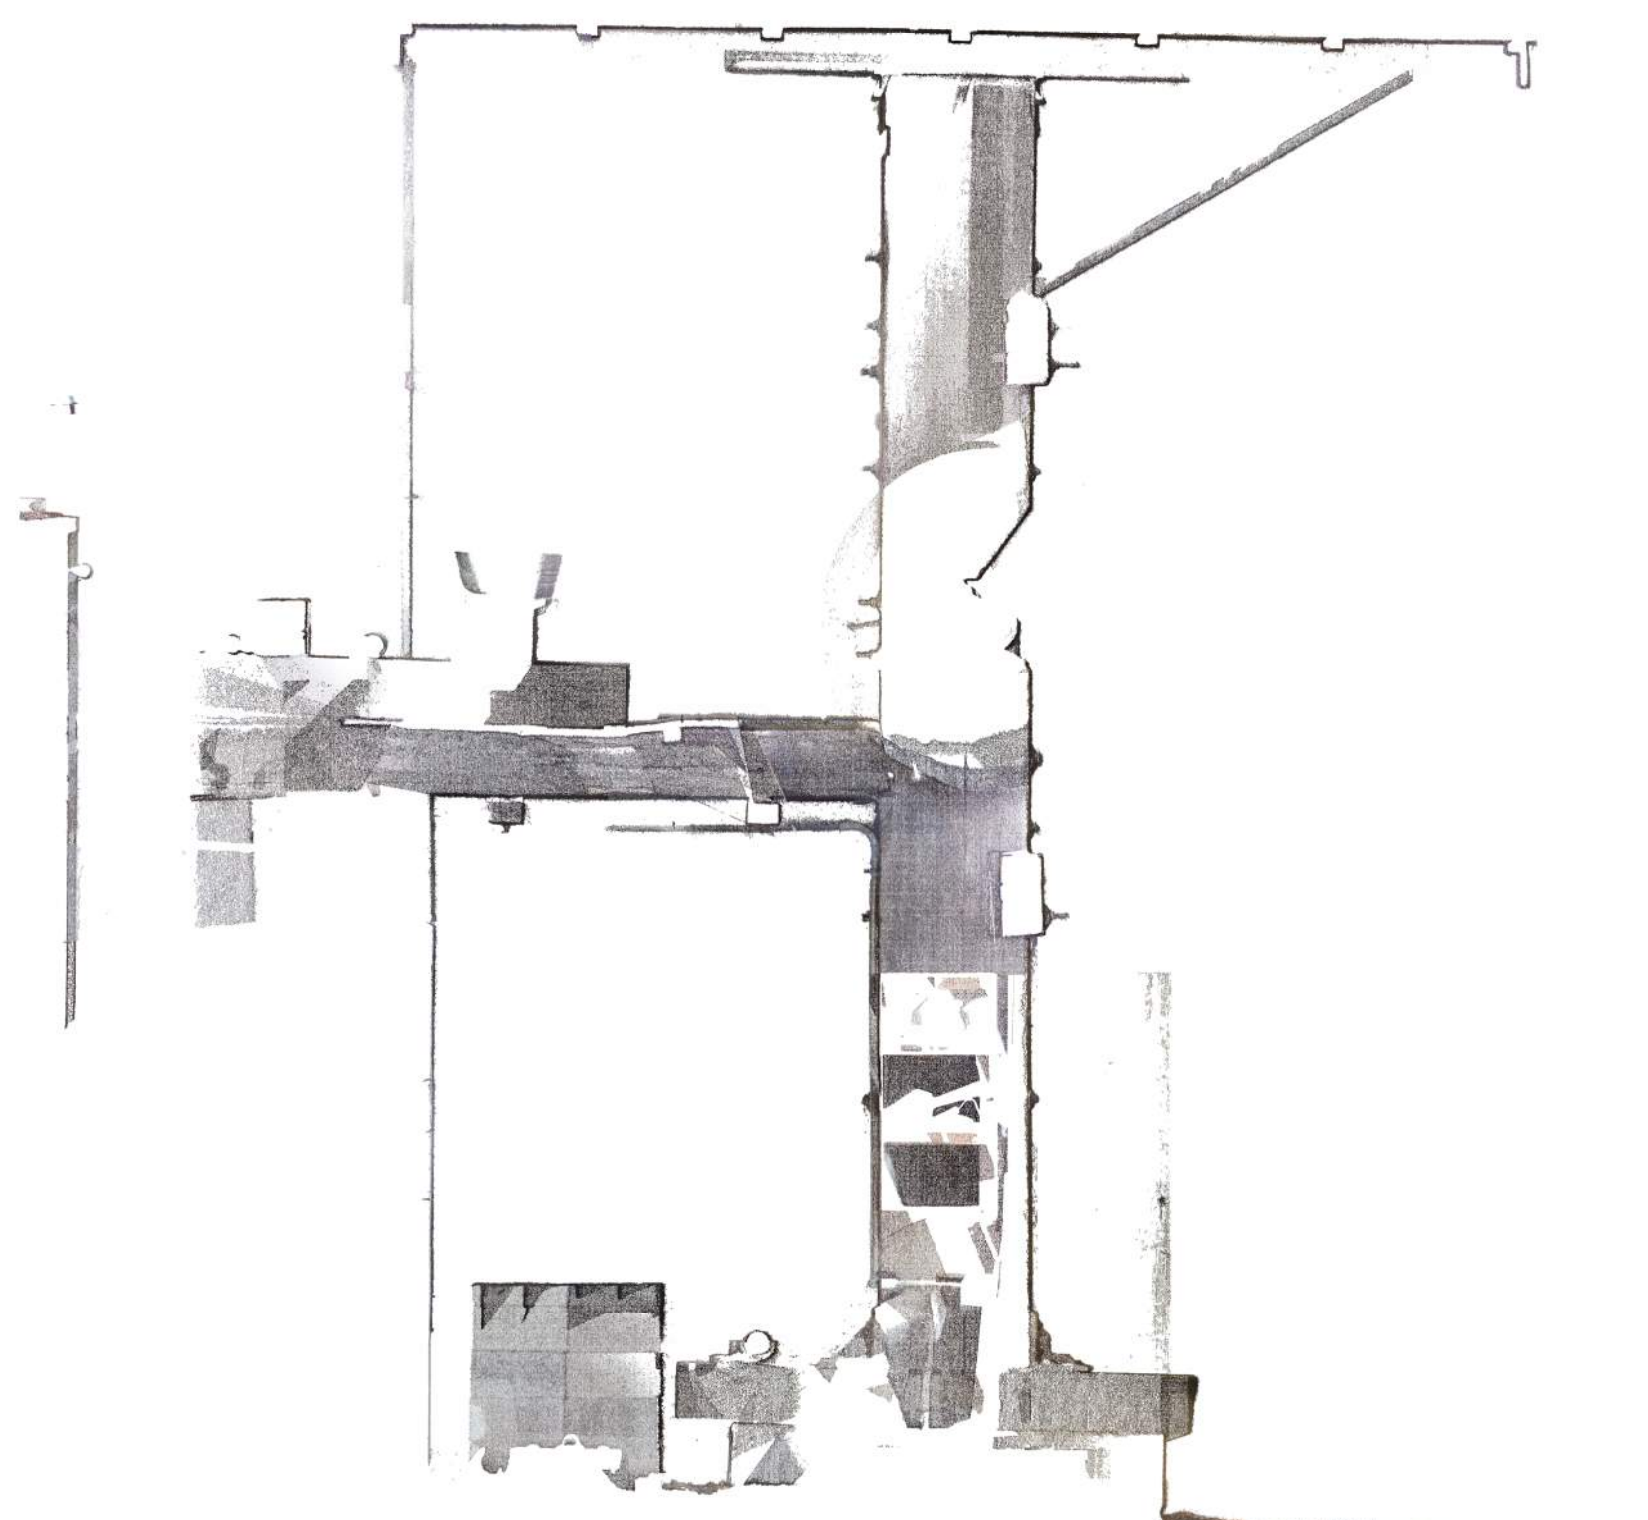

6 STAMP MILL - SECTION 6
3/8" = 1'-0"