
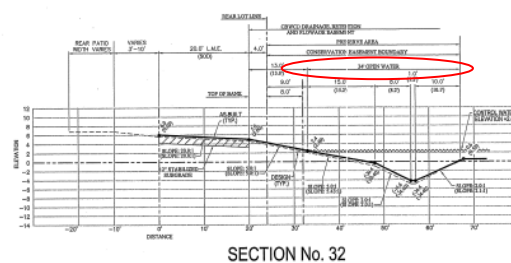
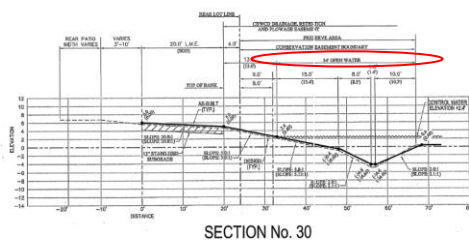


Appendix T: Blatant falsification of Lennar's as-built survey as determined from aerial images from Broward County Property Appraiser (Section 30 and 32). This as-built survey was used as a basis for ~\$7.38 million bond fund release.

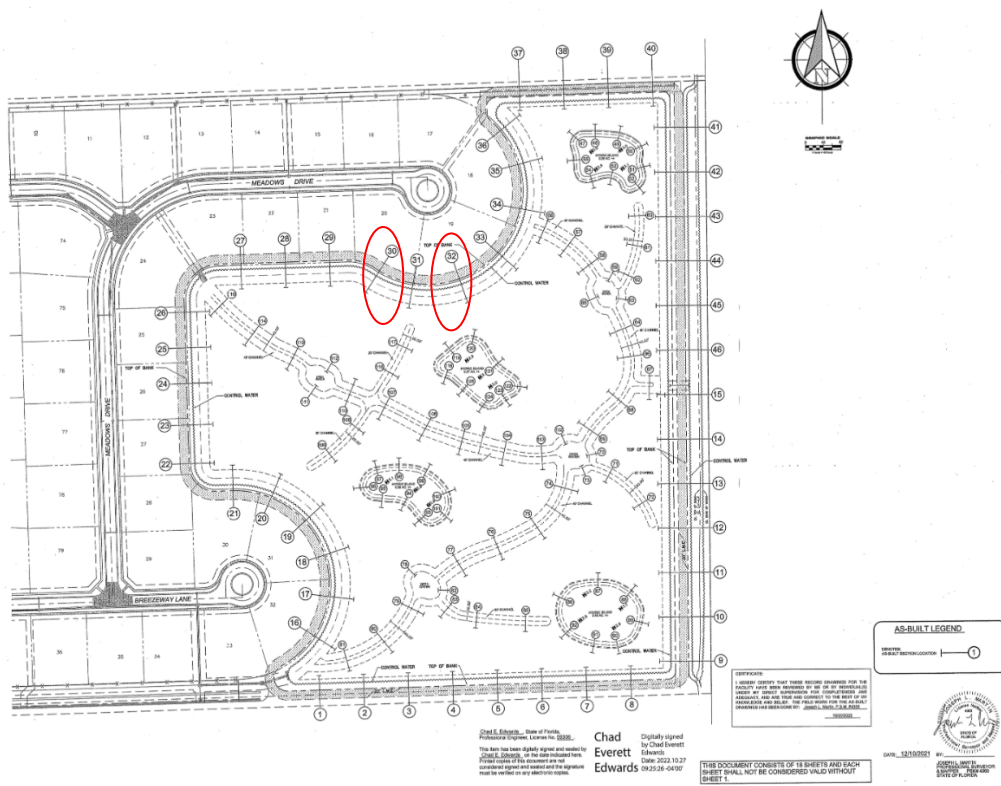

Aerial View of Wetland Preserve (taken 2022)