




G:\land projects 2008\Sierra Ranch\dwg\AS BUILT\AB - PRESERVE AREA\AB - PRESERVE AREA.dwg, 7/24/2023 1:39:27 PM, 1:1

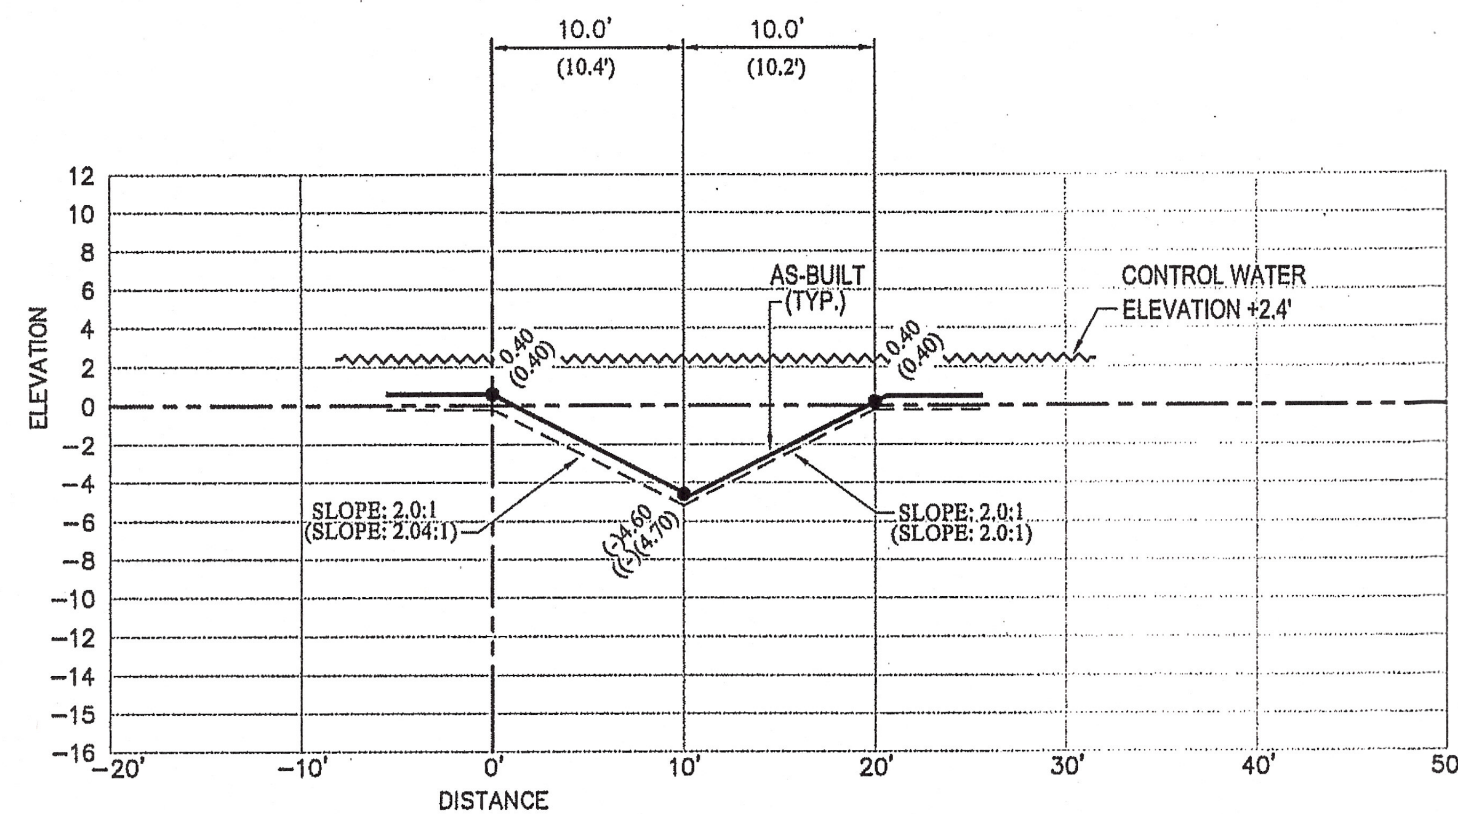


SECTION No. 72
20' CHANNEL

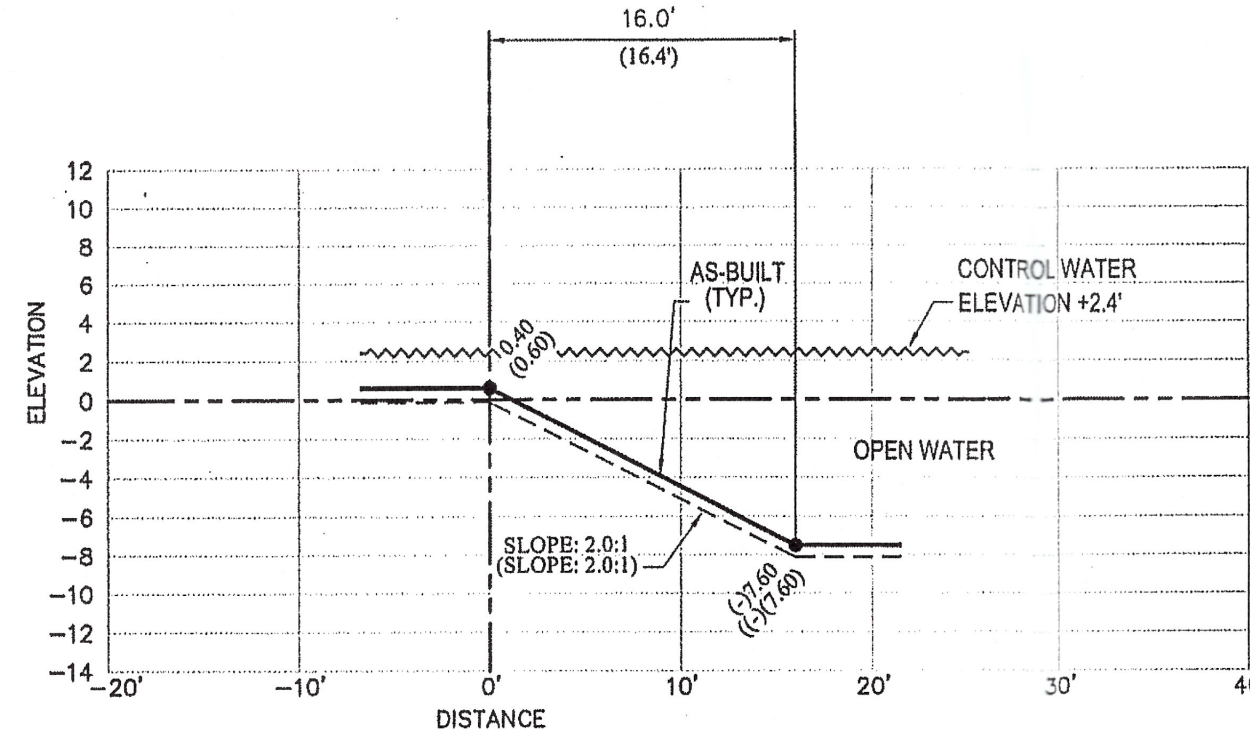


SECTION No. 73
OPEN WATER

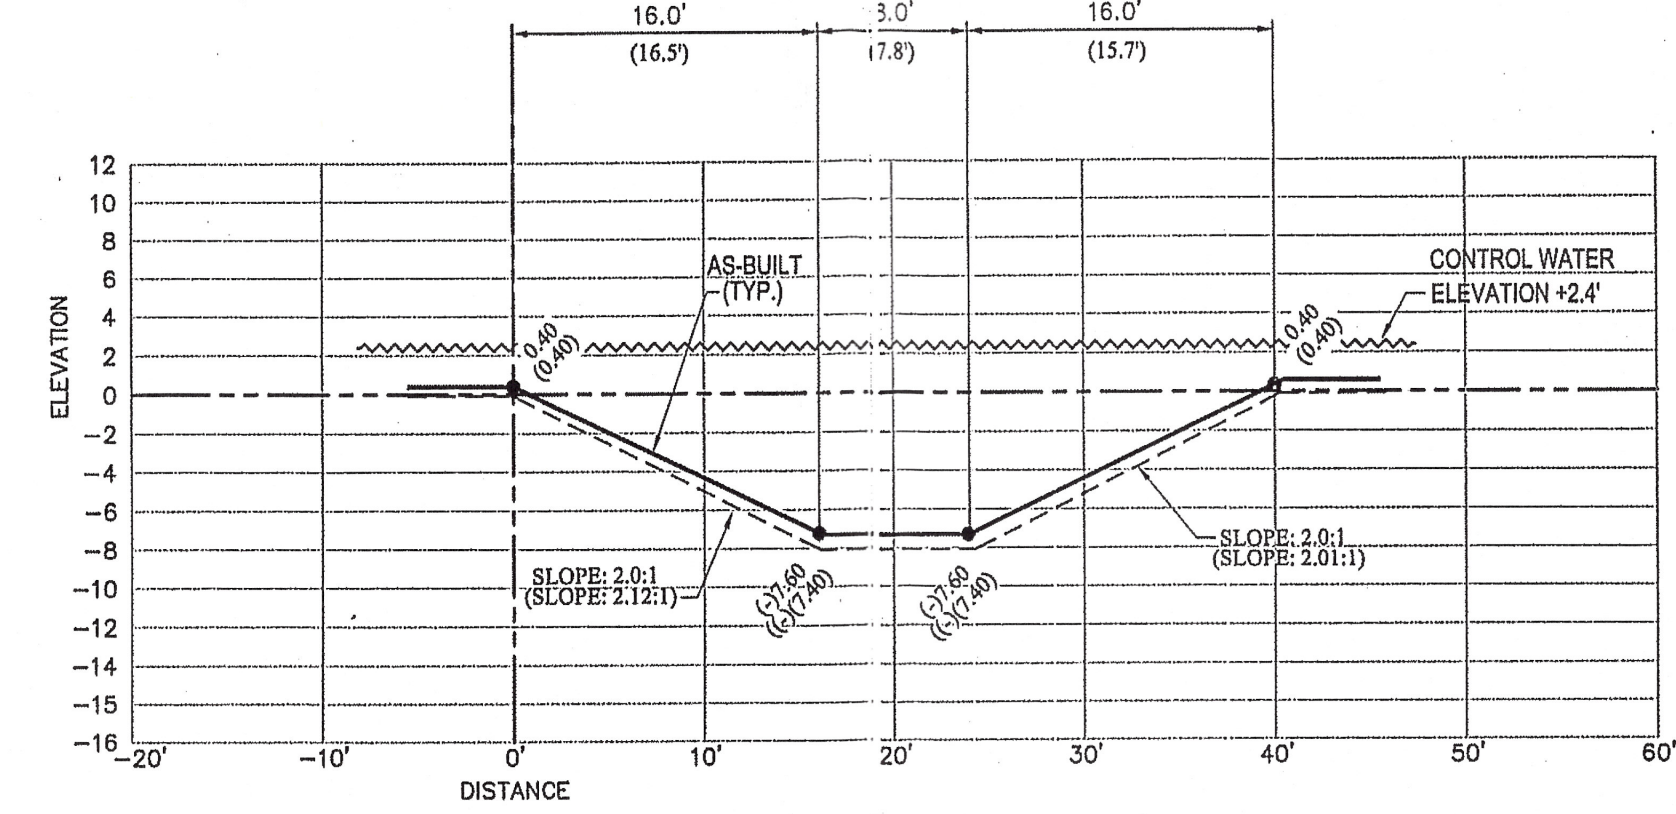


SECTION No. 74
40' CHANNEL

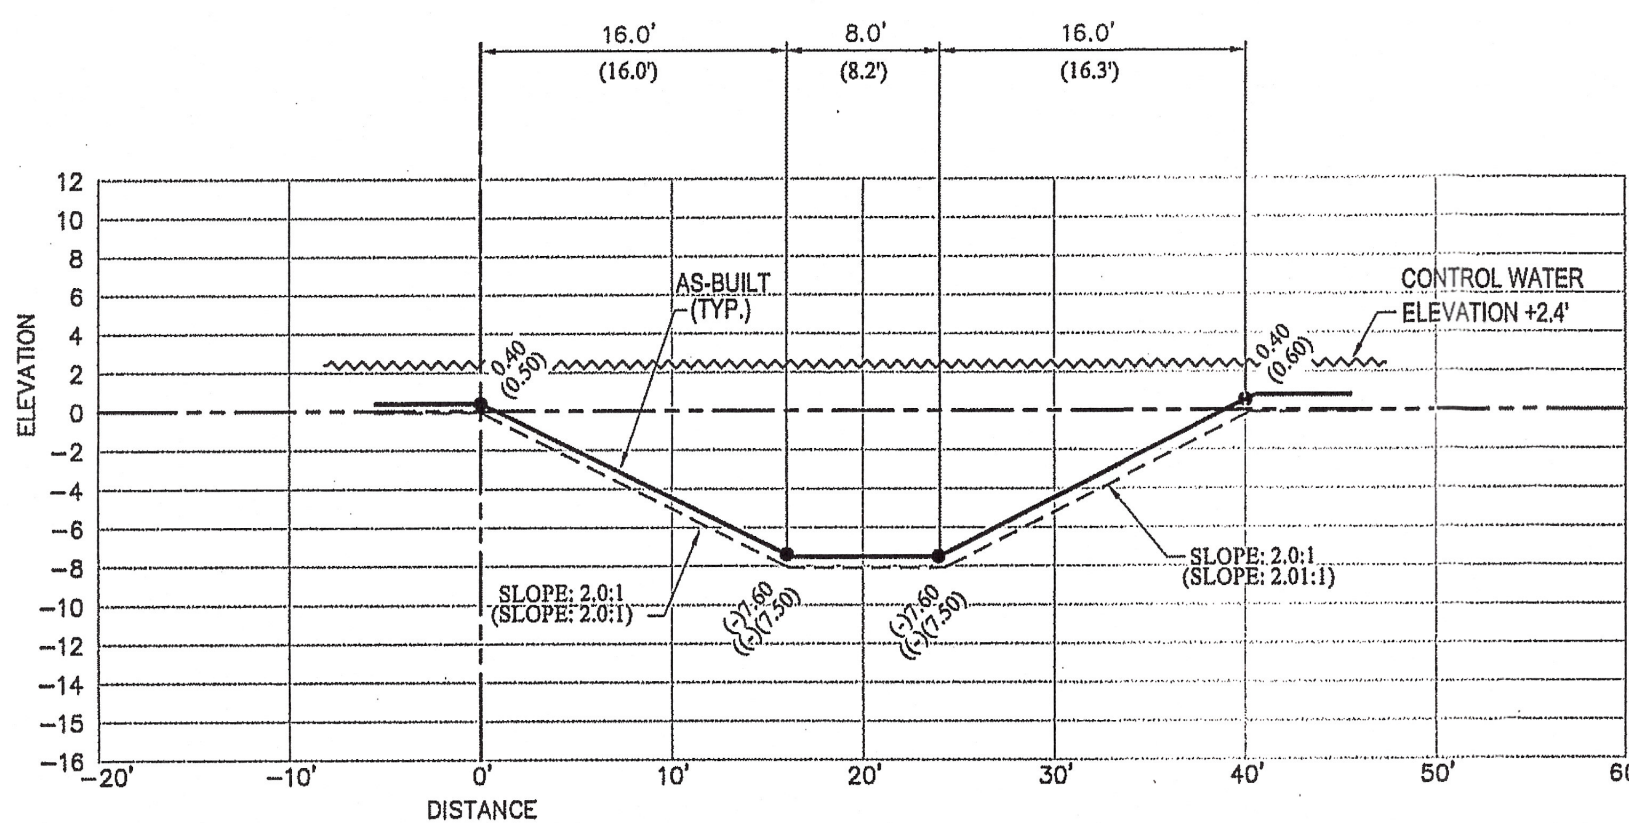


SECTION No. 75
40' CHANNEL

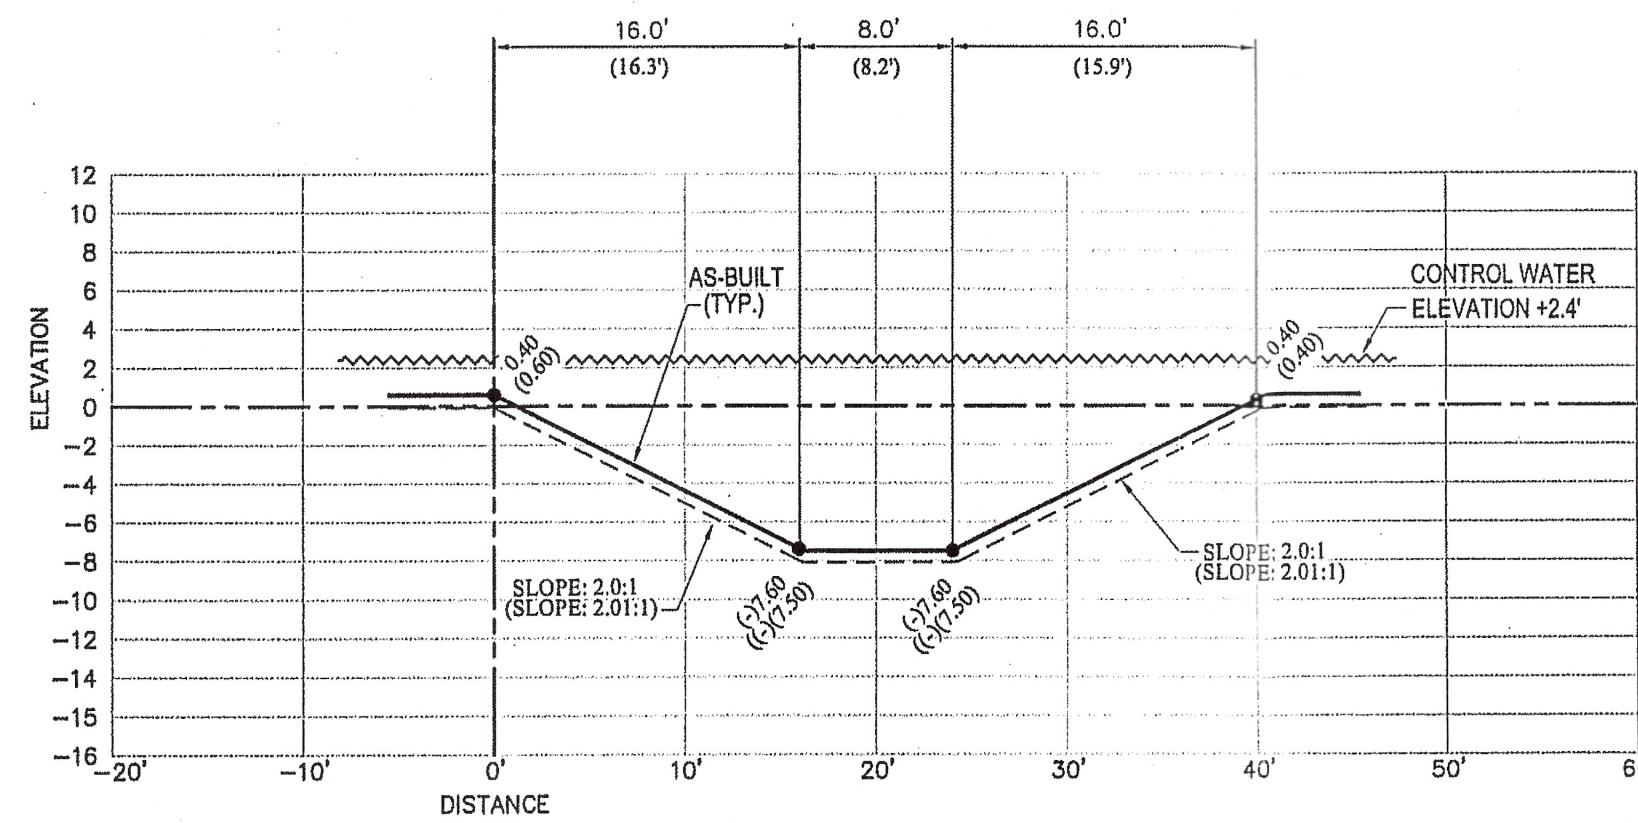


SECTION No. 76
40' CHANNEL

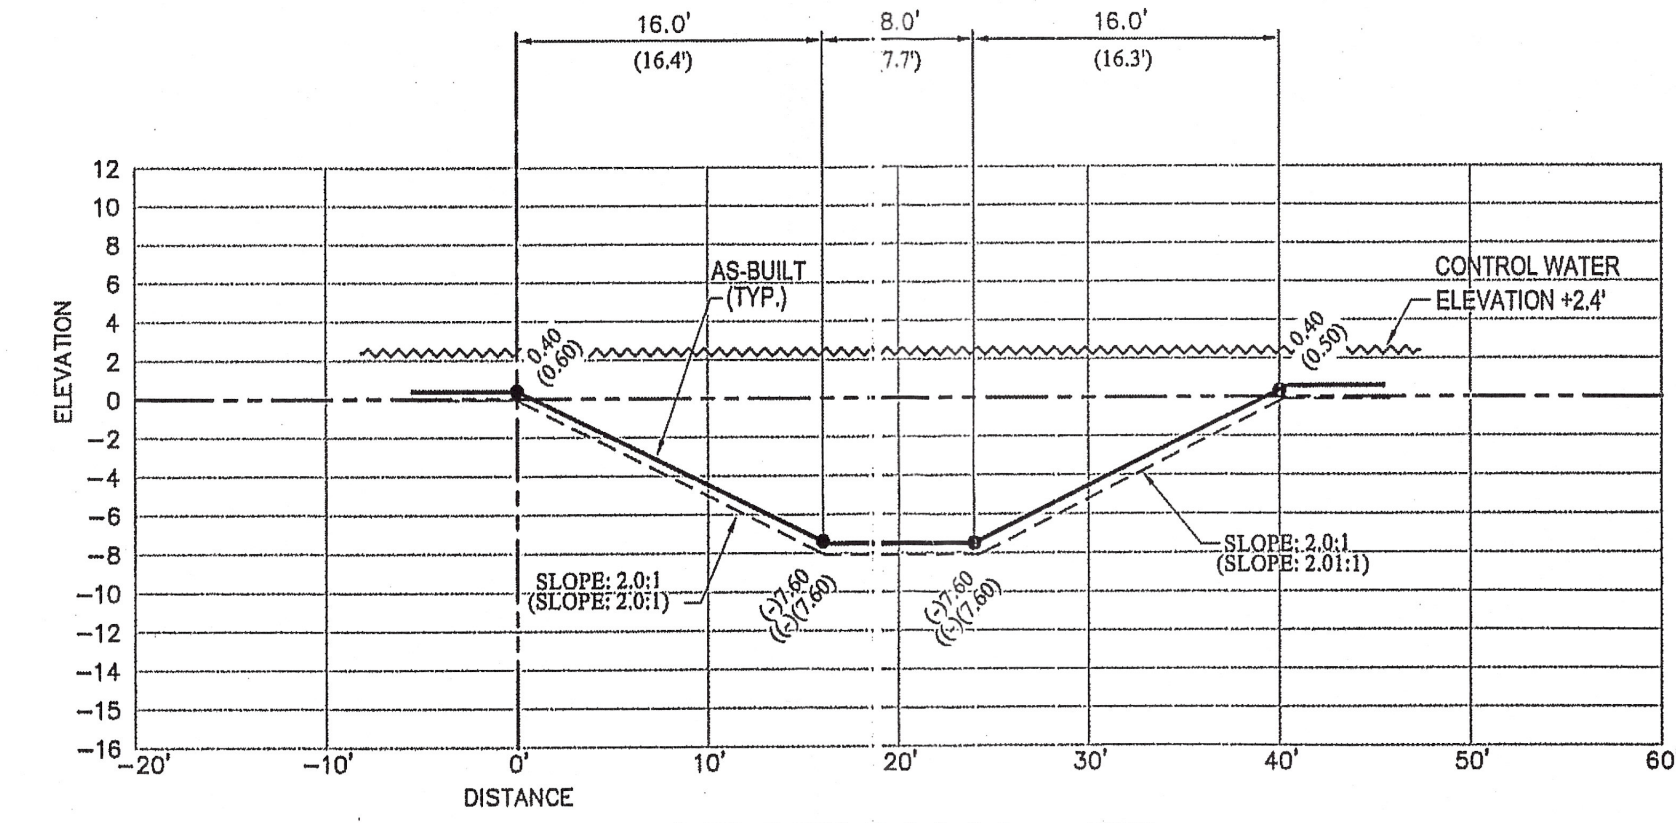


SECTION No. 77
40' CHANNEL

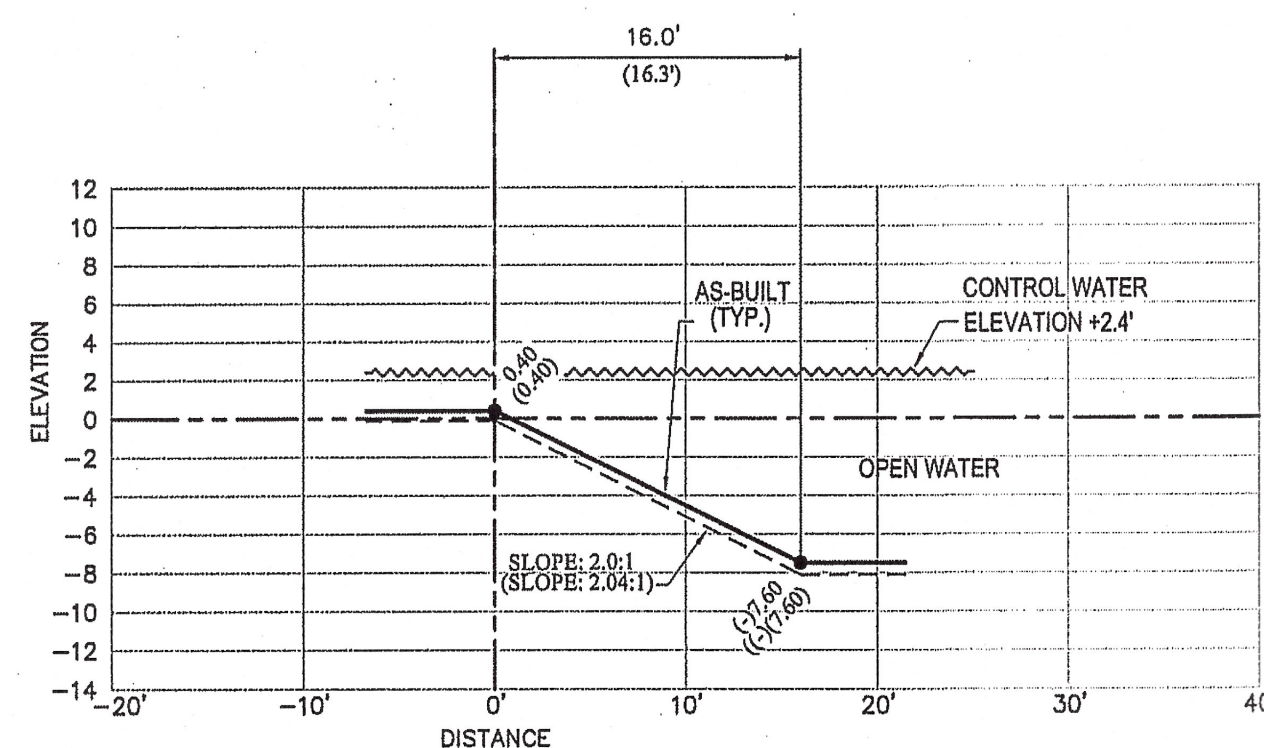

SECTION No. 78
OPEN WATER

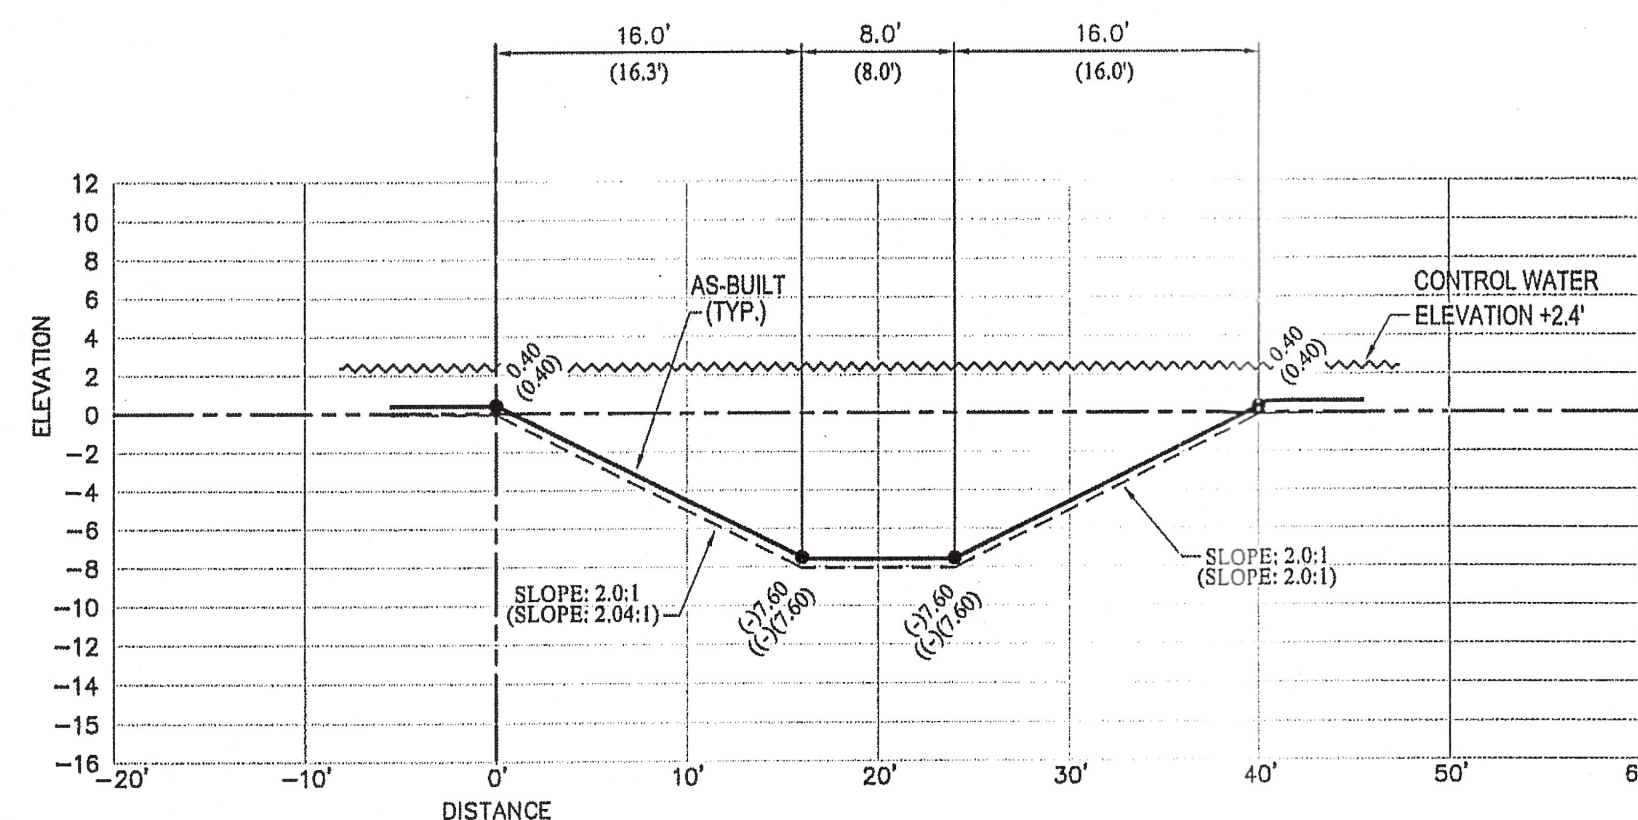

SECTION No. 79
40' CHANNEL

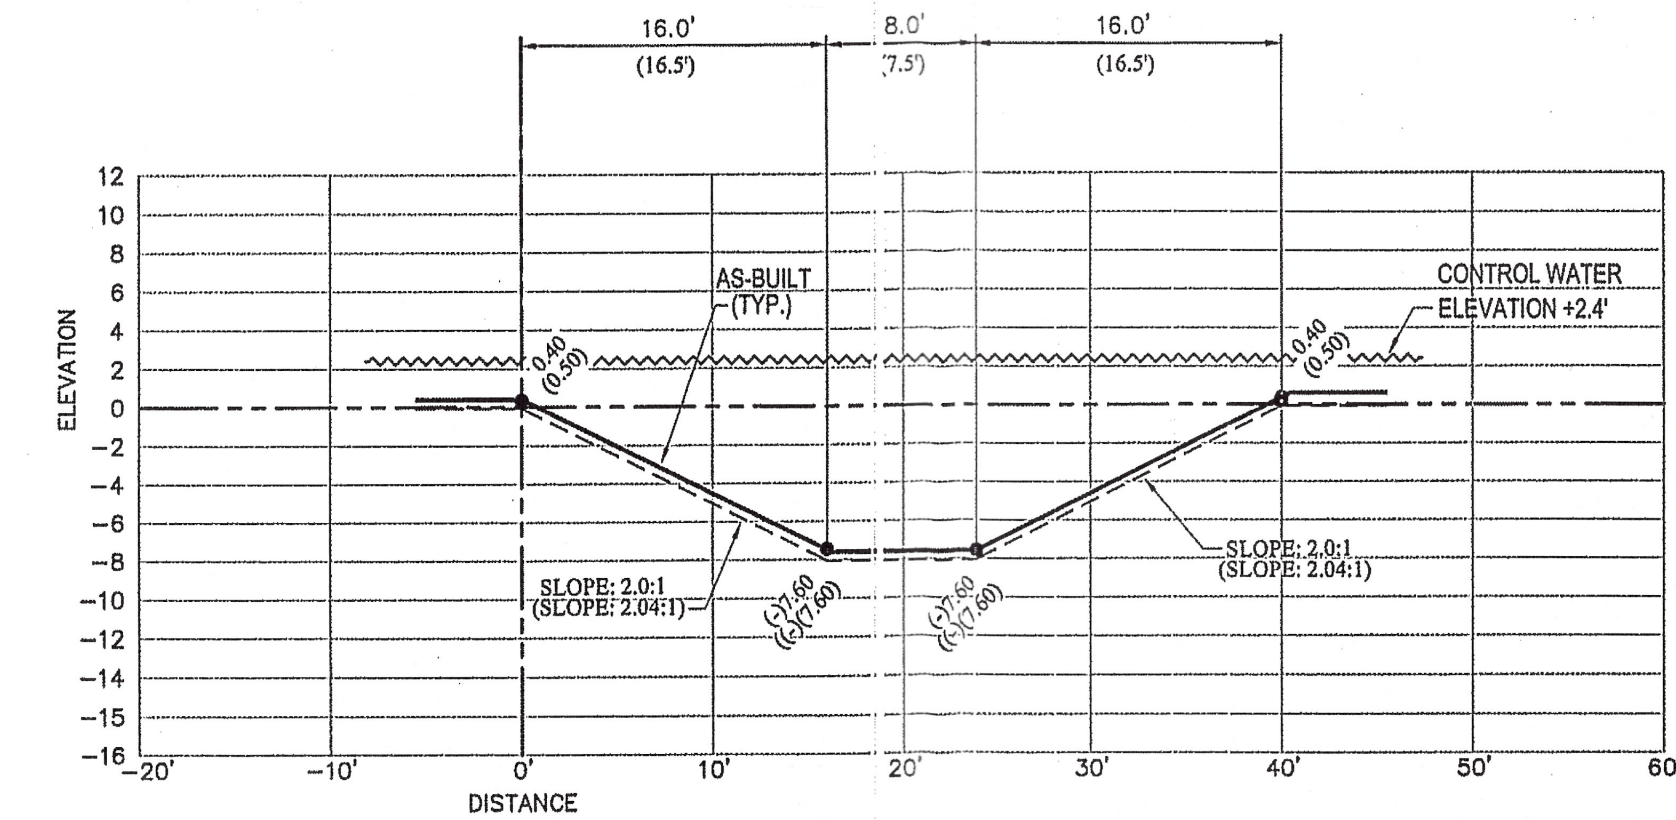

SECTION No. 80
40' CHANNEL


AS-BUILT LEGEND:

- (15.2) DENOTES AS-BUILT DISTANCE
15.0 DENOTES DESIGN DISTANCE
(5) DENOTES AS-BUILT ELEVATION
5 DENOTES DESIGN ELEVATION
(SLOPE: 20.2:1) DENOTES AS-BUILT SLOPE
SLOPE: 20.0:1 DENOTES DESIGN SLOPE
L.M.E. DENOTES LAKE MAINTENANCE EASEMENT
— DENOTES AS-BUILT LINE
--- DENOTES DESIGN LINE

NOTE:

THE AS-BUILT LINEWORK SHOWN HEREON IS A GRAPHICAL REPRESENTATION AND MAY NOT BE DRAWN TO SCALE FOR CLARITY PURPOSES.

DATE: 7/25/23

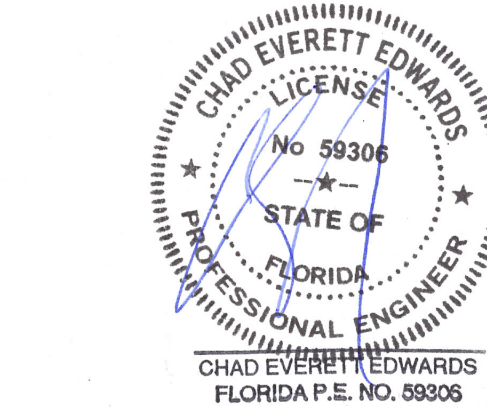



BY: JOSEPH L. MARTIN
PROFESSIONAL SURVEYOR &
MAPPER No 4368
STATE OF FLORIDA

SIERRA RANCH
DAVE, FL.


AS-BUILT CROSS SECTIONS	DATE	REVISION COMMENTS	BY	APP
1950 SOUTH HIATUS ROAD	05-18-21	REVISED PER ENGINEER'S COMMENTS	L.A.	J.M.
SEC. 18, TWP. 50S, RGE. 41E	11-8-21	REVISED TO ADD SECTIONS FROM 16 TO 36	L.A.	J.M.
	12-8-21	REVISED TO ADD SECTIONS FROM 37 TO 125	L.A.	G.B.
	12-10-21	REVISED PER ENGINEER'S COMMENTS	L.A.	G.B.

SCALE:	H:1"=10' / V:1"=10'
SURVEYOR:	COUNTY-WIDE
DRAWN BY:	LESLEY
CHECKED BY:	G.B.
AS-BUILT:	PRESERVE AREA
DATE:	04/14/2021
DRE PROJECT No:	2019-043
SHEET No:	

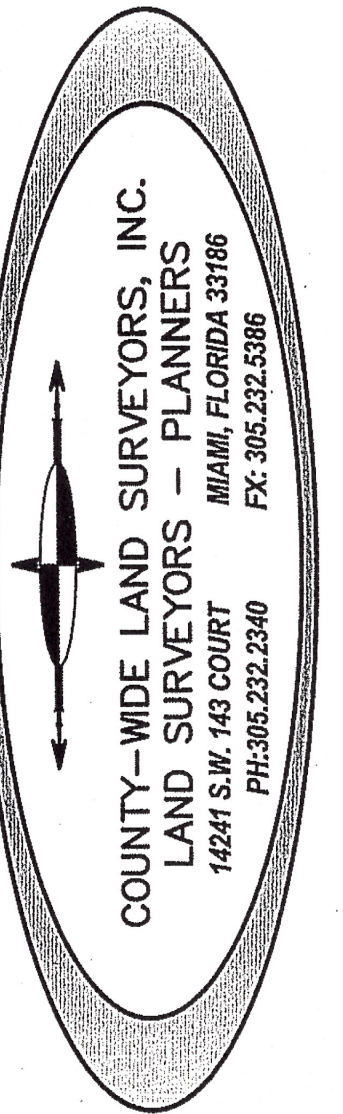


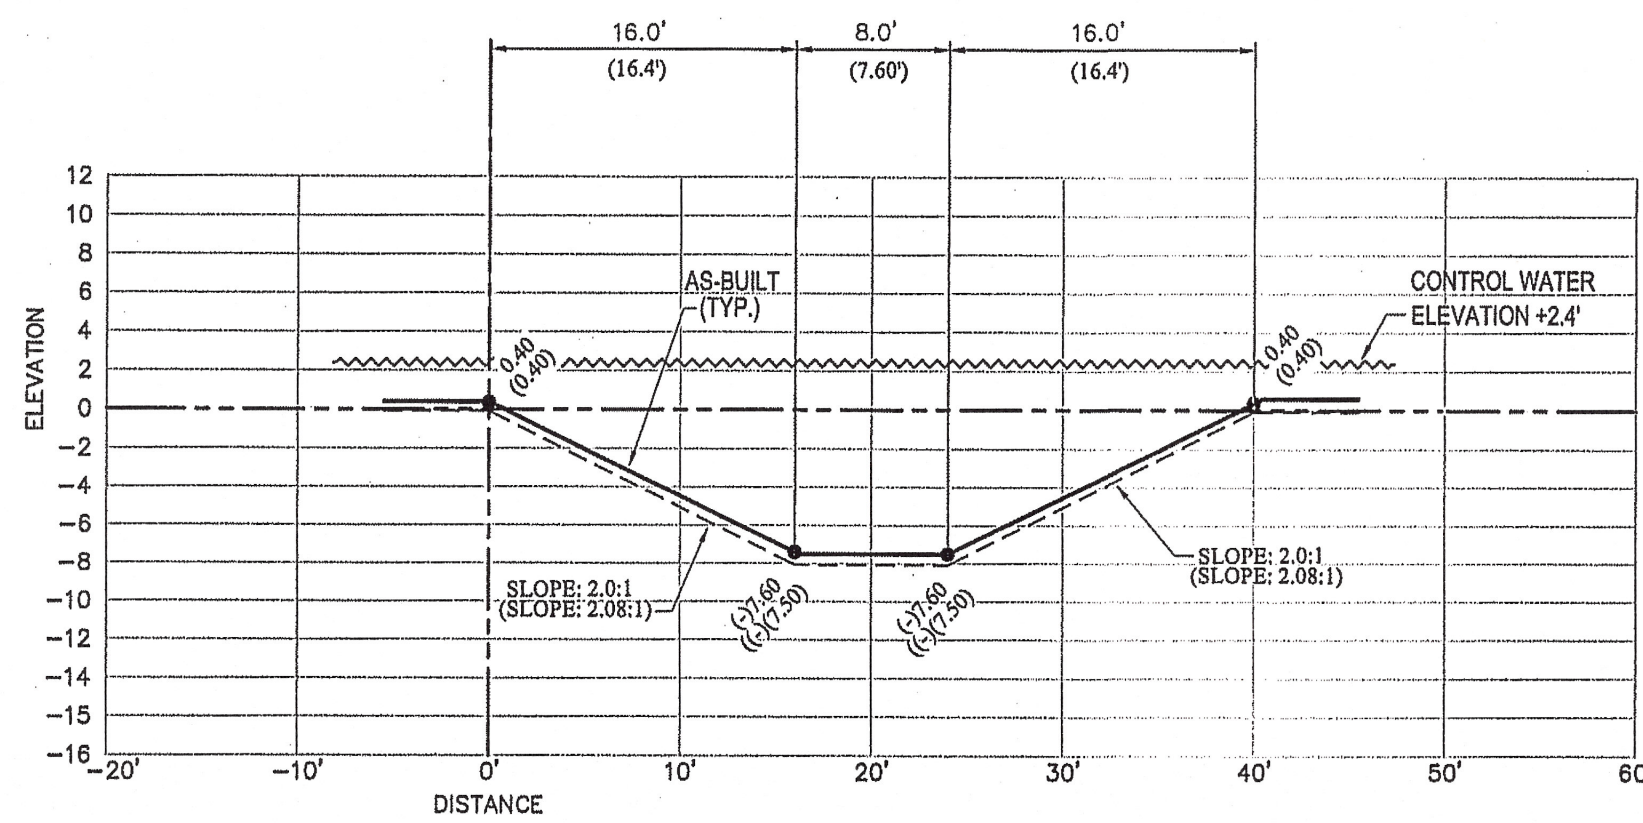


SECTION No. 81
40' CHANNEL

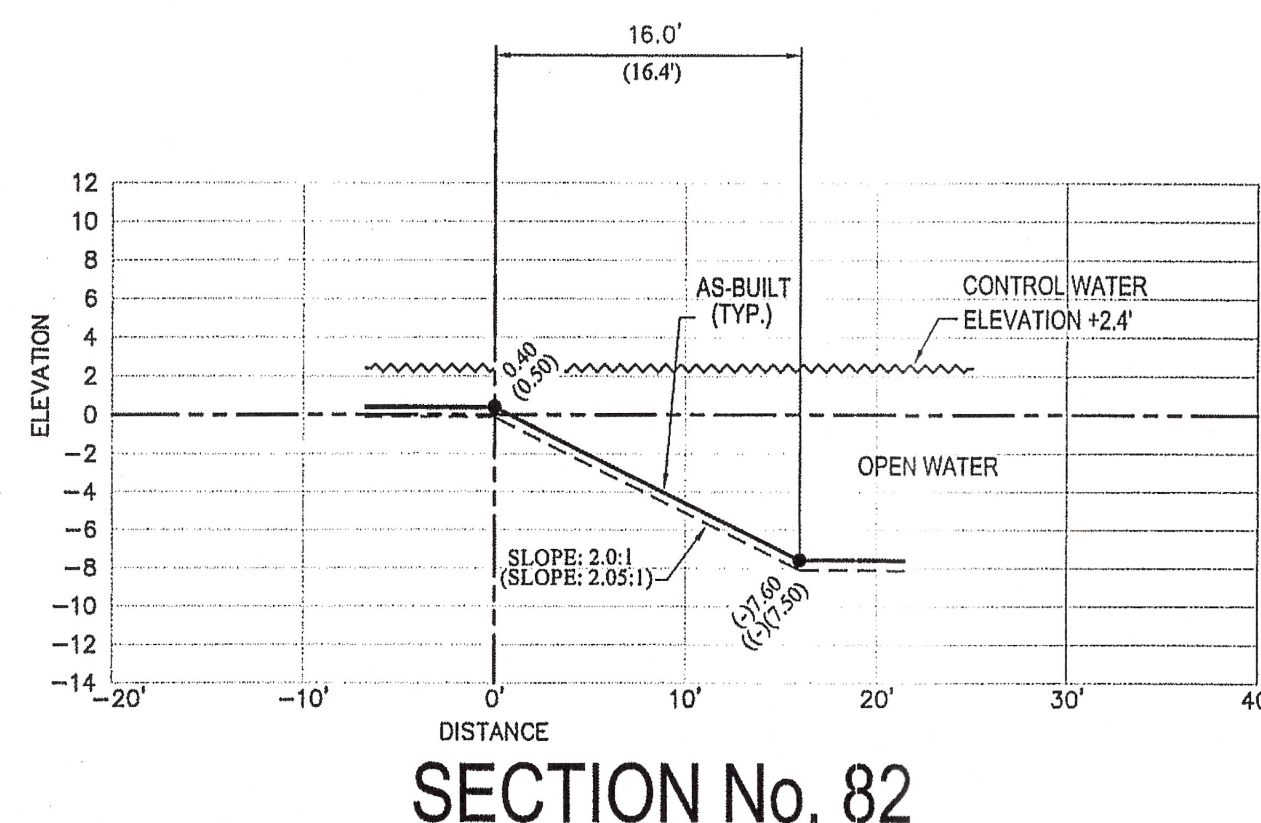


SECTION No. 82
OPEN WATER

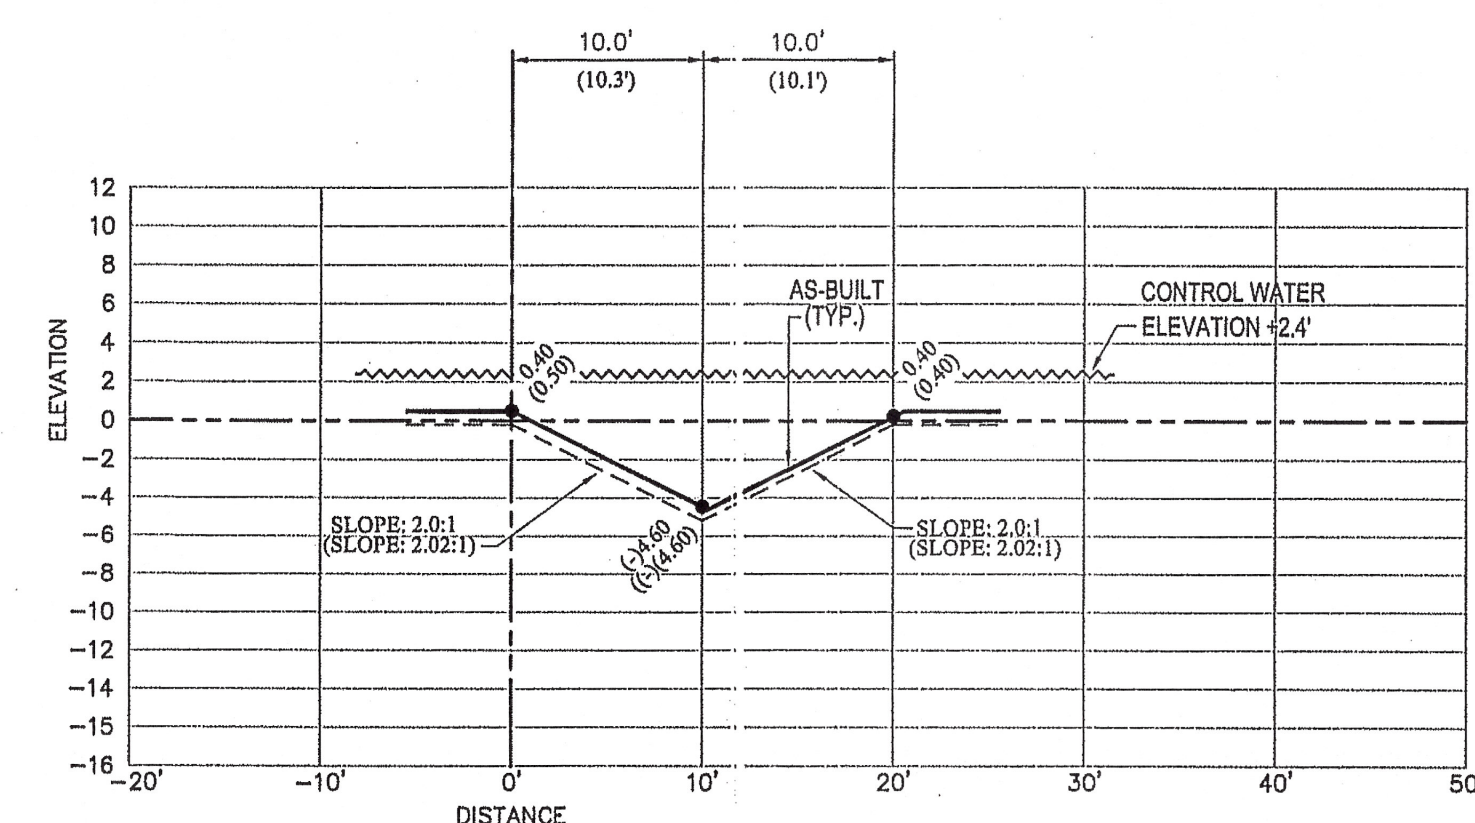


SECTION No. 83
20' CHANNEL

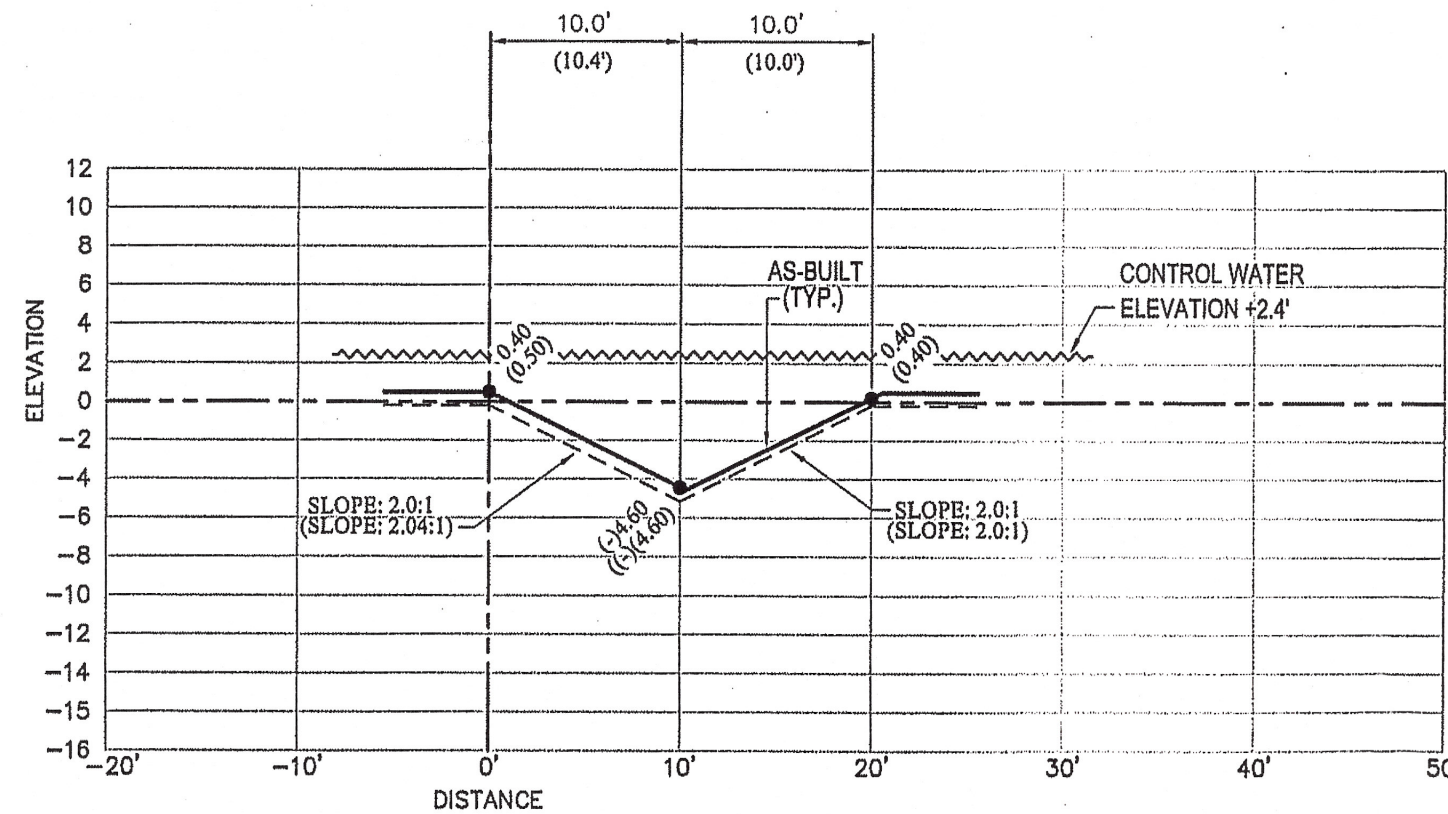


SECTION No. 84
20' CHANNEL

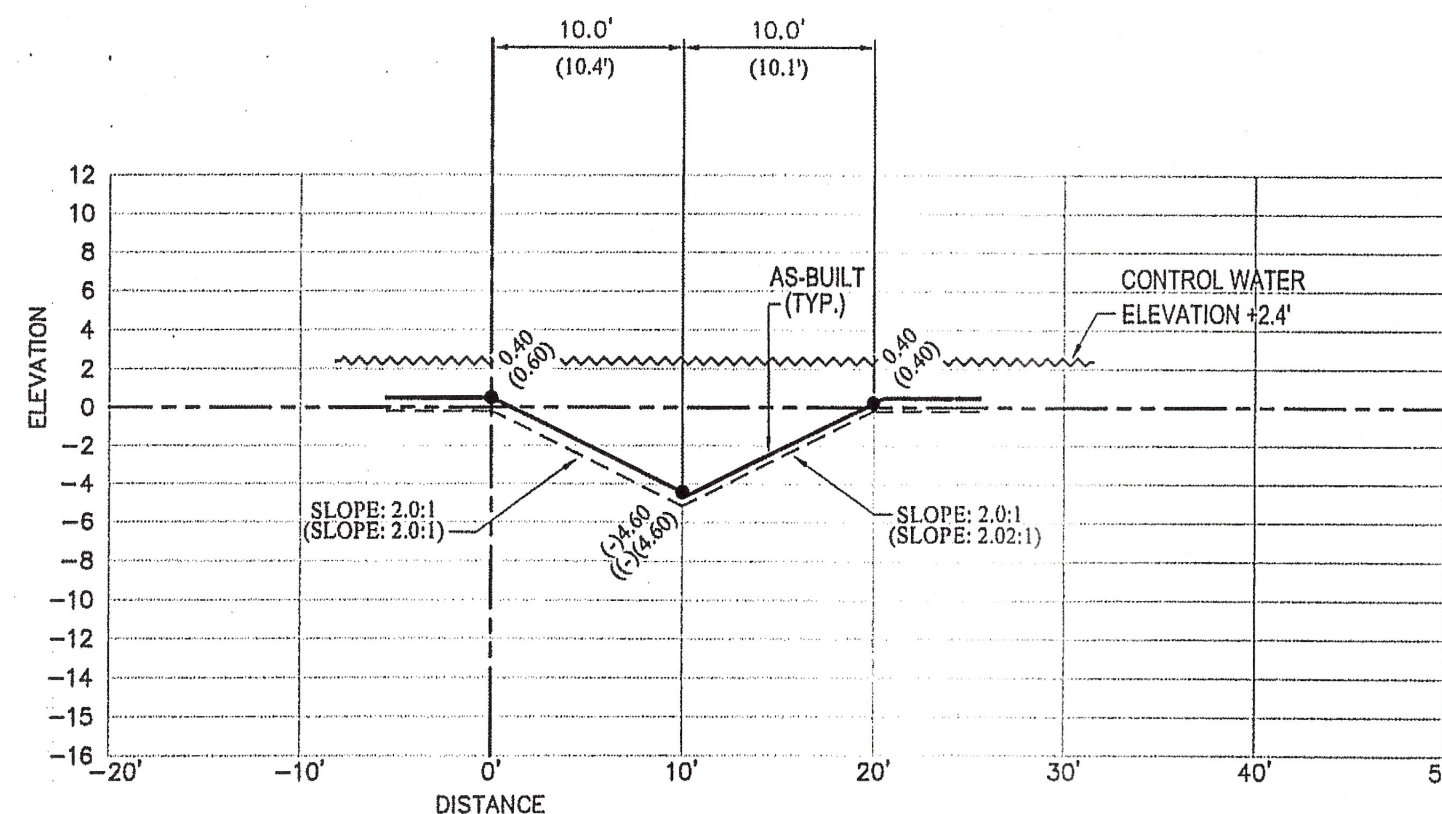


SECTION No. 85
20' CHANNEL

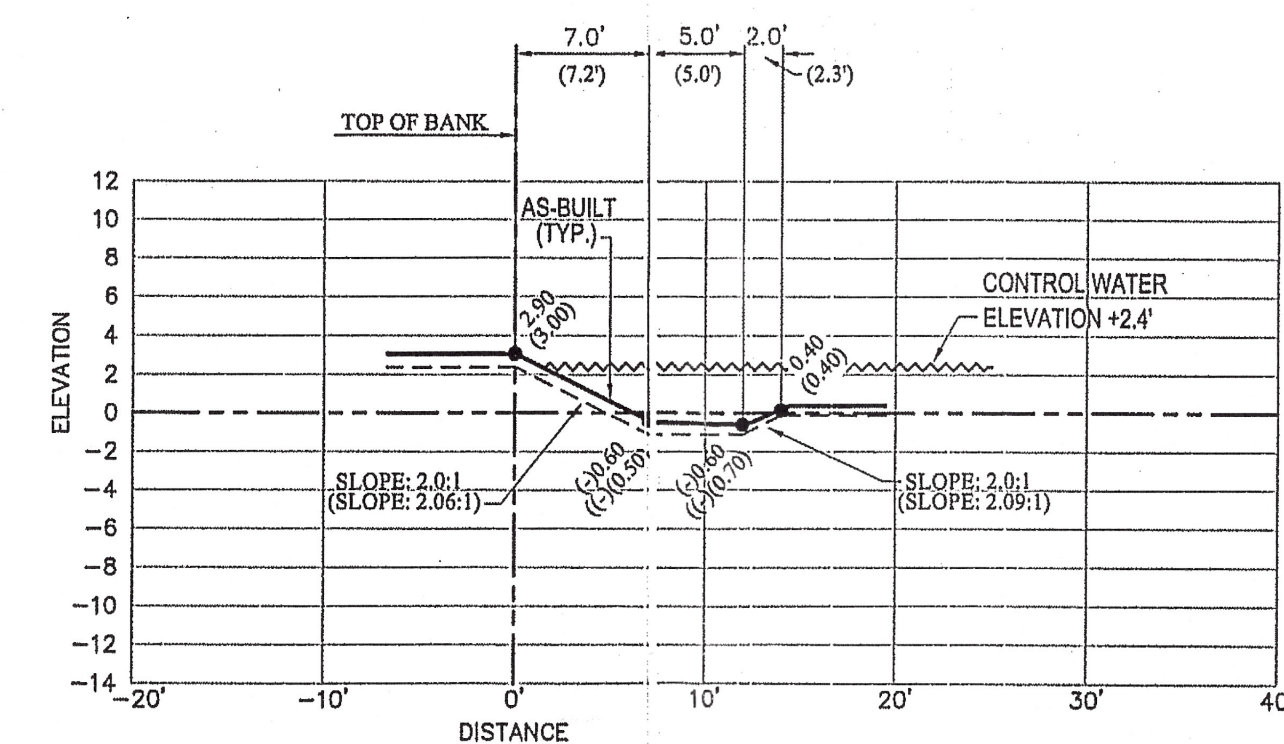


SECTION No. 86
HYDRIC ISLAND

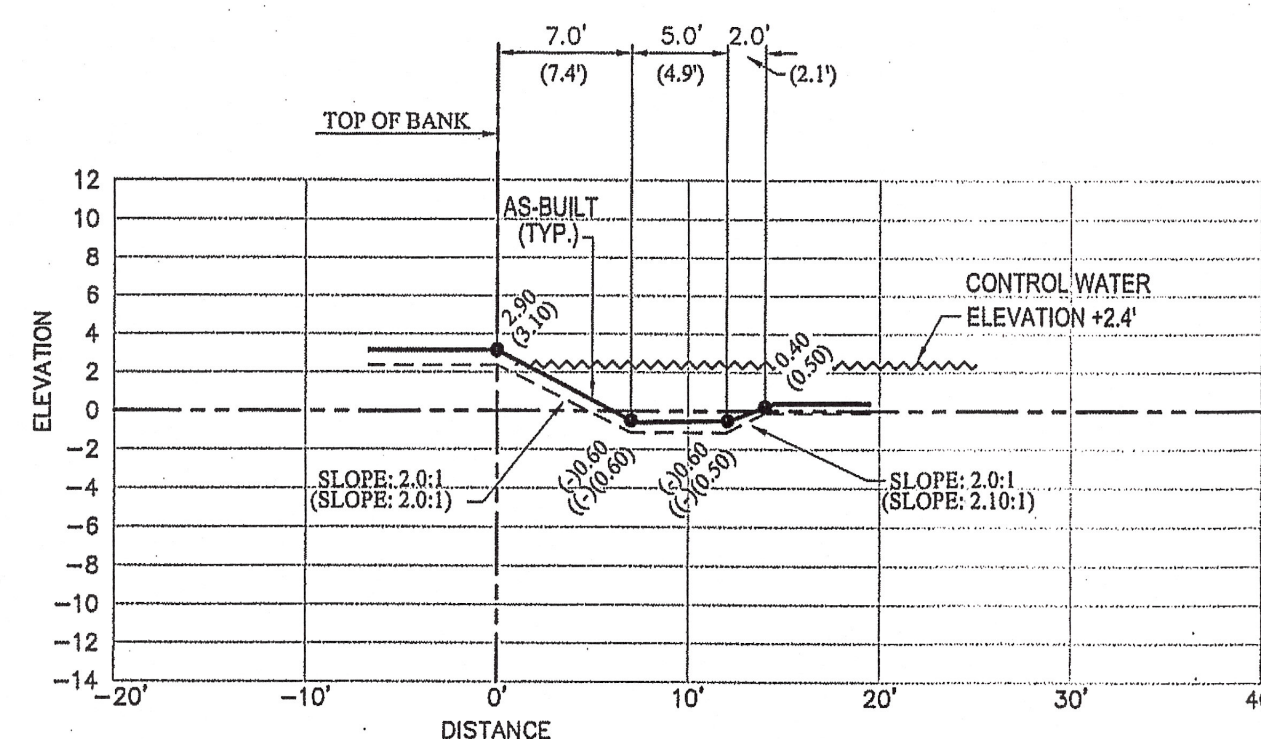

SECTION No. 87
HYDRIC ISLAND

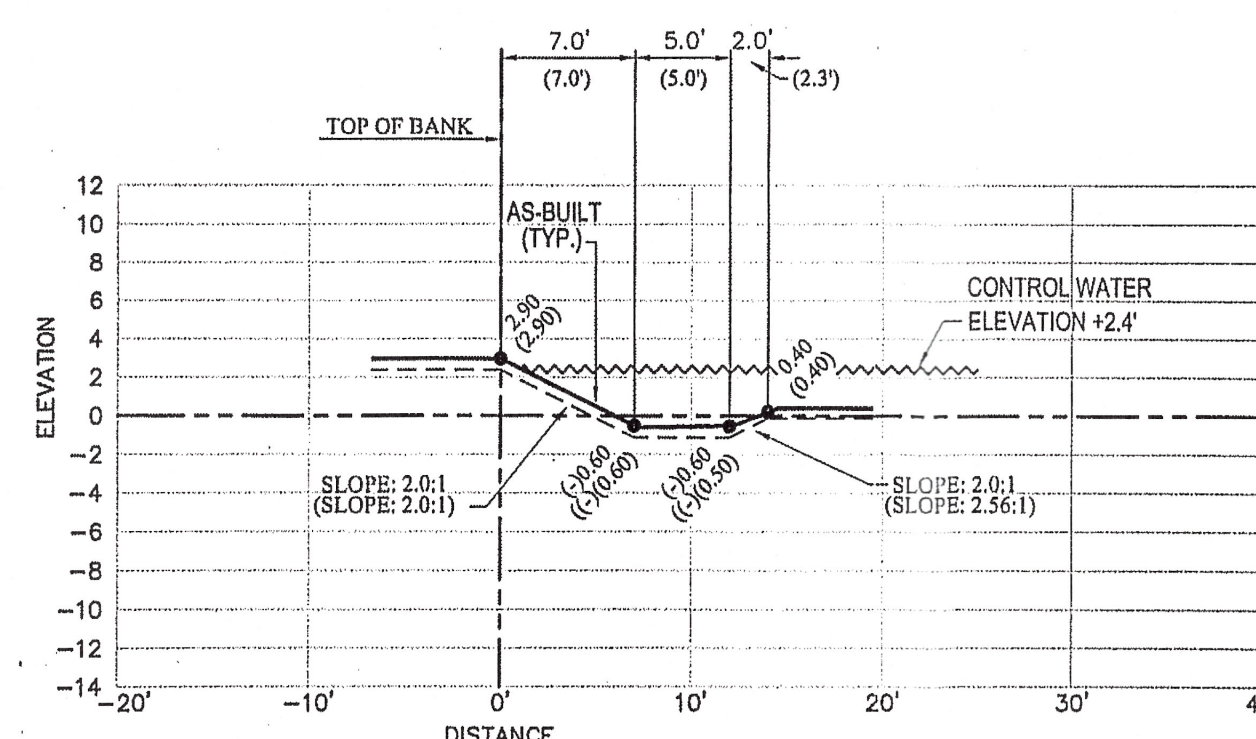

SECTION No. 88
HYDRIC ISLAND

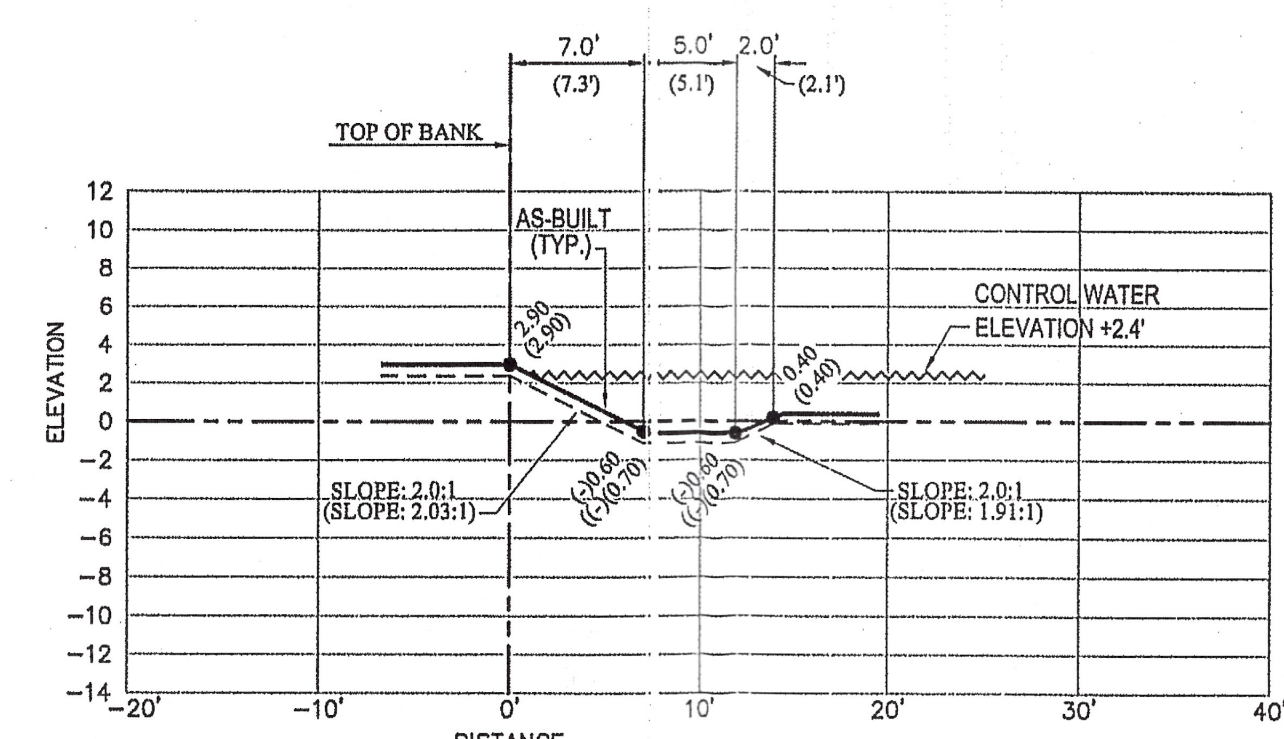


SECTION No. 89
HYDRIC ISLAND


AS-BUILT LEGEND:

- (15.2') DENOTES AS-BUILT DISTANCE
- 15.0' DENOTES DESIGN DISTANCE
- (2.4) DENOTES AS-BUILT ELEVATION
- 2.4 DENOTES DESIGN ELEVATION
- (SLOPE: 2.0:1) DENOTES AS-BUILT SLOPE
- SLOPE: 2.0:1 DENOTES DESIGN SLOPE
- L.M.E. DENOTES LAKE MAINTENANCE EASEMENT
- DENOTES AS-BUILT LINE
- - - - DENOTES DESIGN LINE

NOTE:
THE AS-BUILT LINEWORK SHOWN HEREON IS A GRAPHICAL REPRESENTATION
AND MAY NOT BE DRAWN TO SCALE FOR CLARITY PURPOSES.

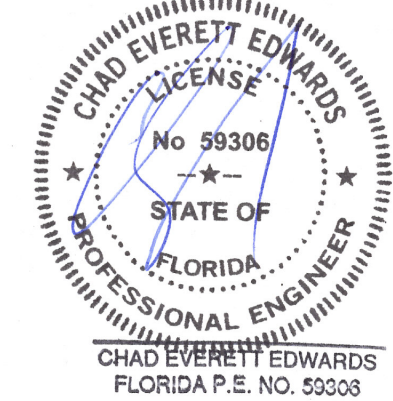

DATE: 7/25/23 BY: JOSEPH L. MARTIN
PROFESSIONAL SURVEYOR &
MAPPER No 4368
STATE OF FLORIDA

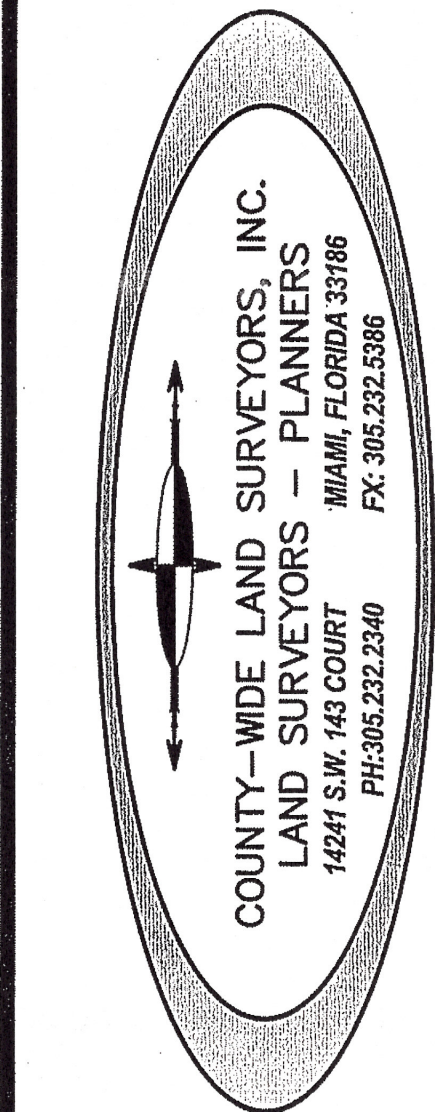

SIERRA RANCH
DAVE, FL.

AS-BUILT CROSS SECTIONS	DATE	REVISION COMMENTS	BY	APP
1950 SOUTH HIATUS ROAD	05-18-21	REVISED PER ENGINEER'S COMMENTS	L.A.	J.M.
SEC. 18, TWP. 50S, RGE. 41E	11-8-21	REVISED TO ADD SECTIONS FROM 16 TO 36	L.A.	J.M.
	12-8-21	REVISED TO ADD SECTIONS FROM 37 TO 125	L.A.	J.M.
	12-10-21	REVISED PER ENGINEER'S COMMENTS	L.A.	G.B.

SCALE:	H:1"=10' / V:1"=10'
SURVEYOR:	COUNTY-WIDE
DRAWN BY:	LESLEY
CHECKED BY:	G.B.
AS-BUILT:	PRESERVE AREA
DATE:	04/14/2021
DRE PROJECT No:	2019-043
SHEET No:	