



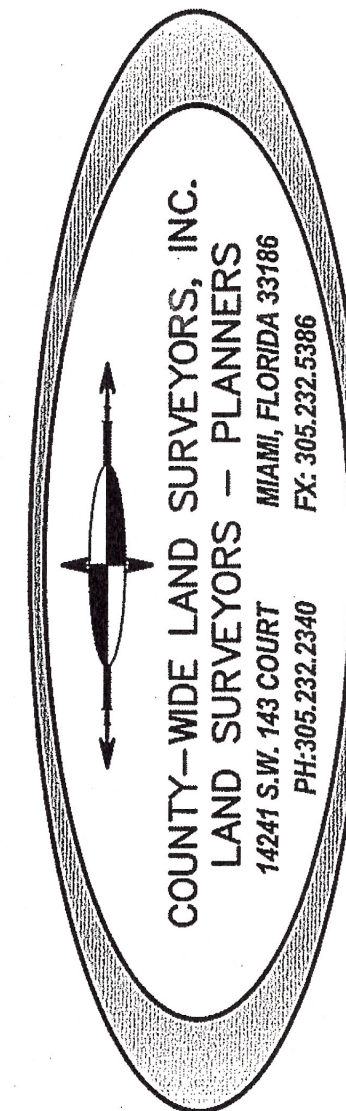


SIERRA RANCH
DAVIE, FL.

BY	APP	REVISION COMMENTS	DATE	AS-BUILT CROSS SECTIONS
L.A.	J.M.	REVISED PER ENGINEER'S COMMENTS	05-18-21	1950 SOUTH HIATUS ROAD
L.A.	J.M.	REVISED TO ADD SECTIONS FROM 16 TO 36	11-8-21	SEC. 18, TWP. 50S, RGE. 41E
L.A.	J.M.	REVISED TO ADD SECTIONS FROM 37 TO 125	12-8-21	
L.A.	G.B.	REVISED PER ENGINEER'S COMMENTS	12-10-21	


SCALE:	H:1"=10' / V:1"=10'
SURVEYOR:	COUNTY-WIDE
DRAWN BY:	LESLY
CHECKED BY:	G.B.
AS-BUILT:	PRESERVE AREA
DATE:	04/14/2021
DRE PROJECT NO:	2019-043
SHEET NO:	7 of 18

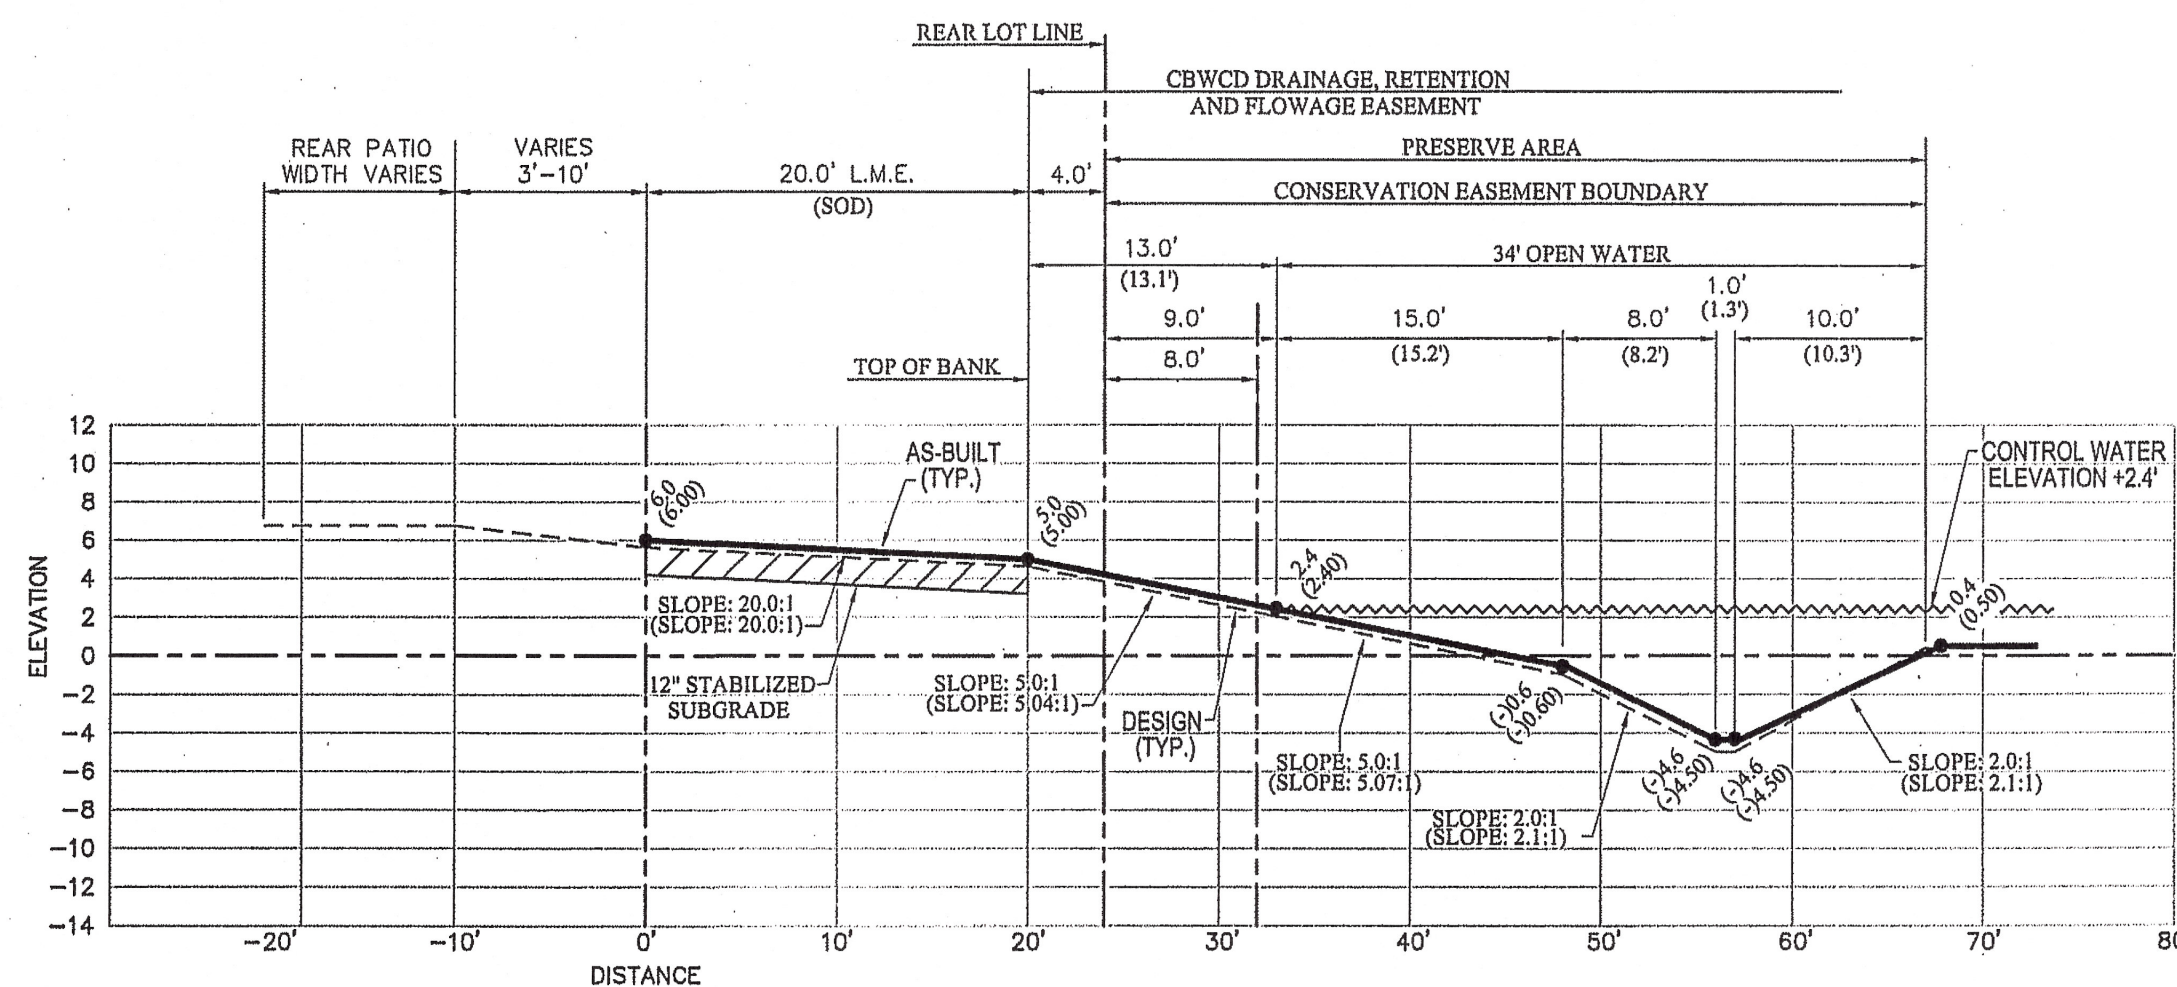


SECTION No. 28

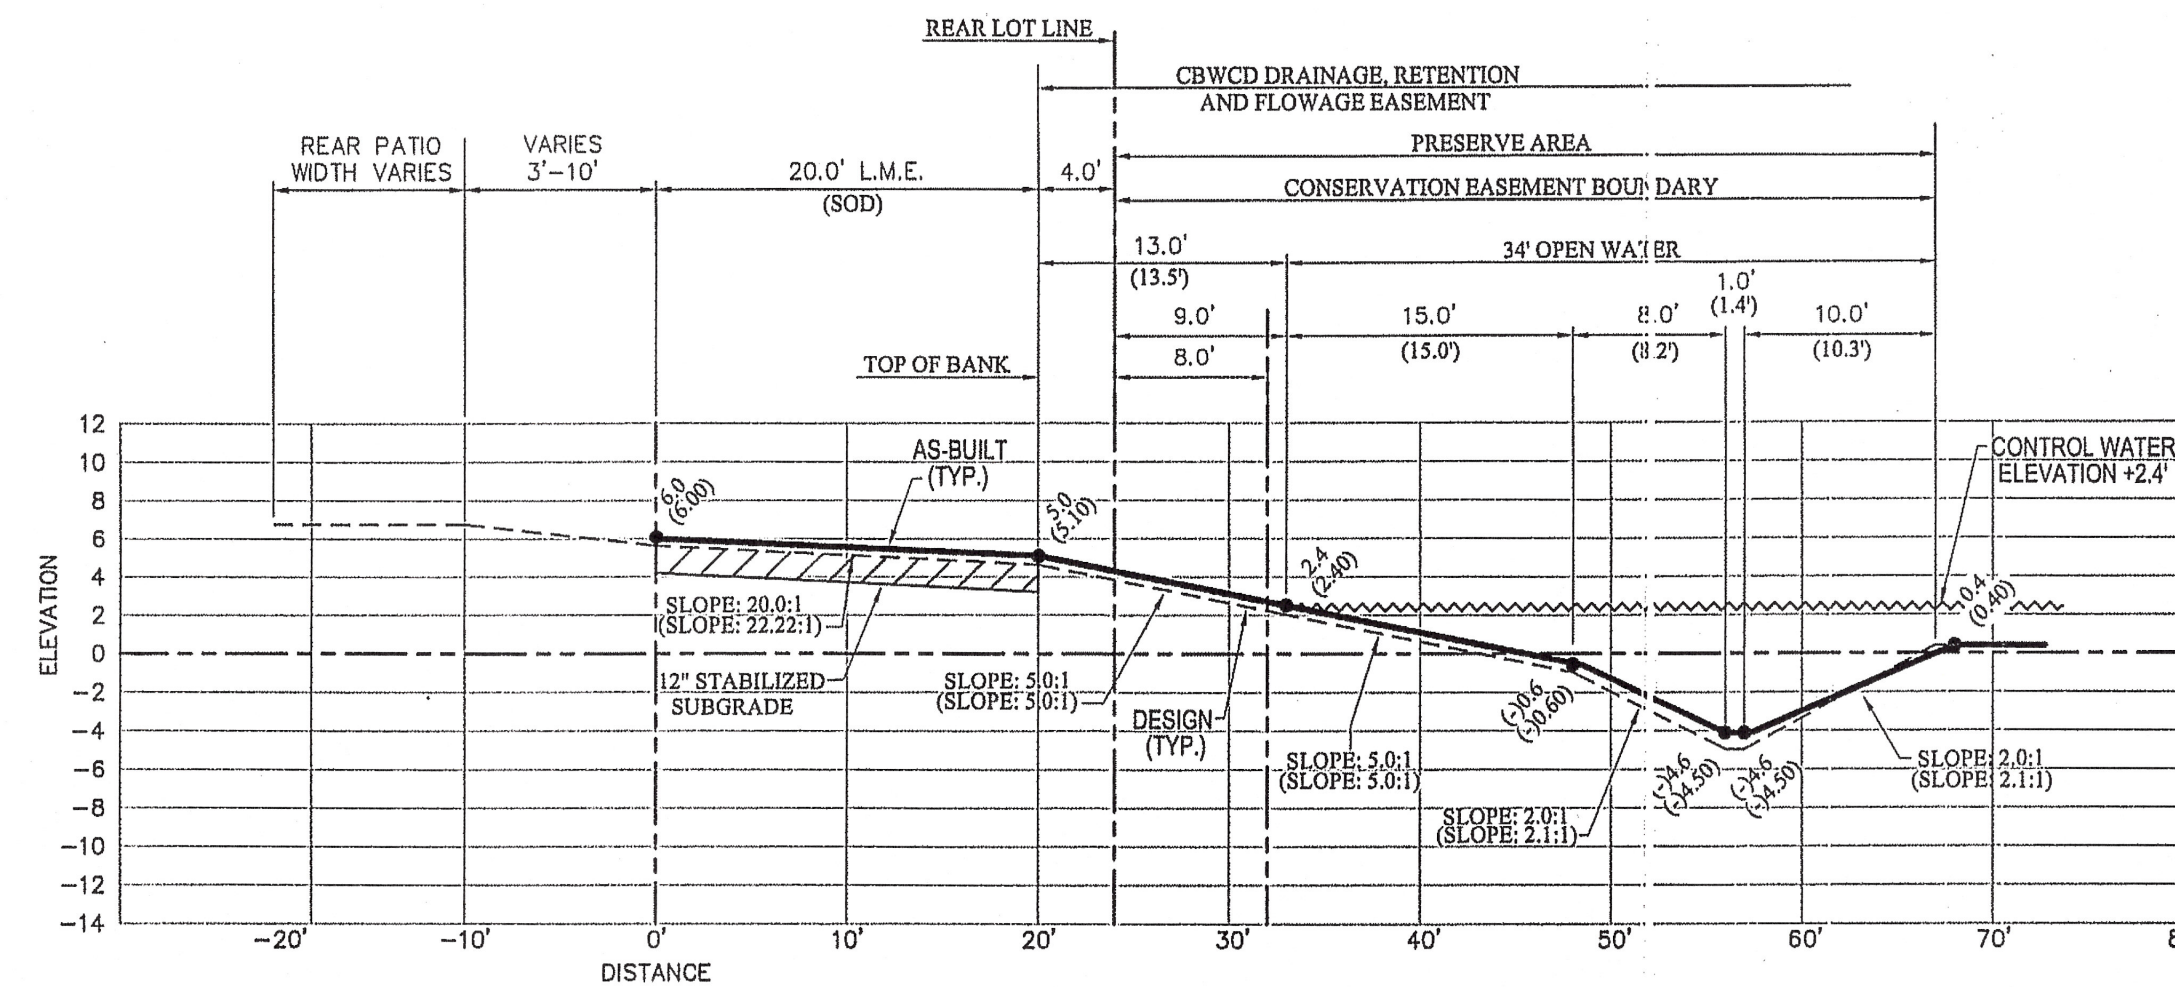


SECTION No. 29

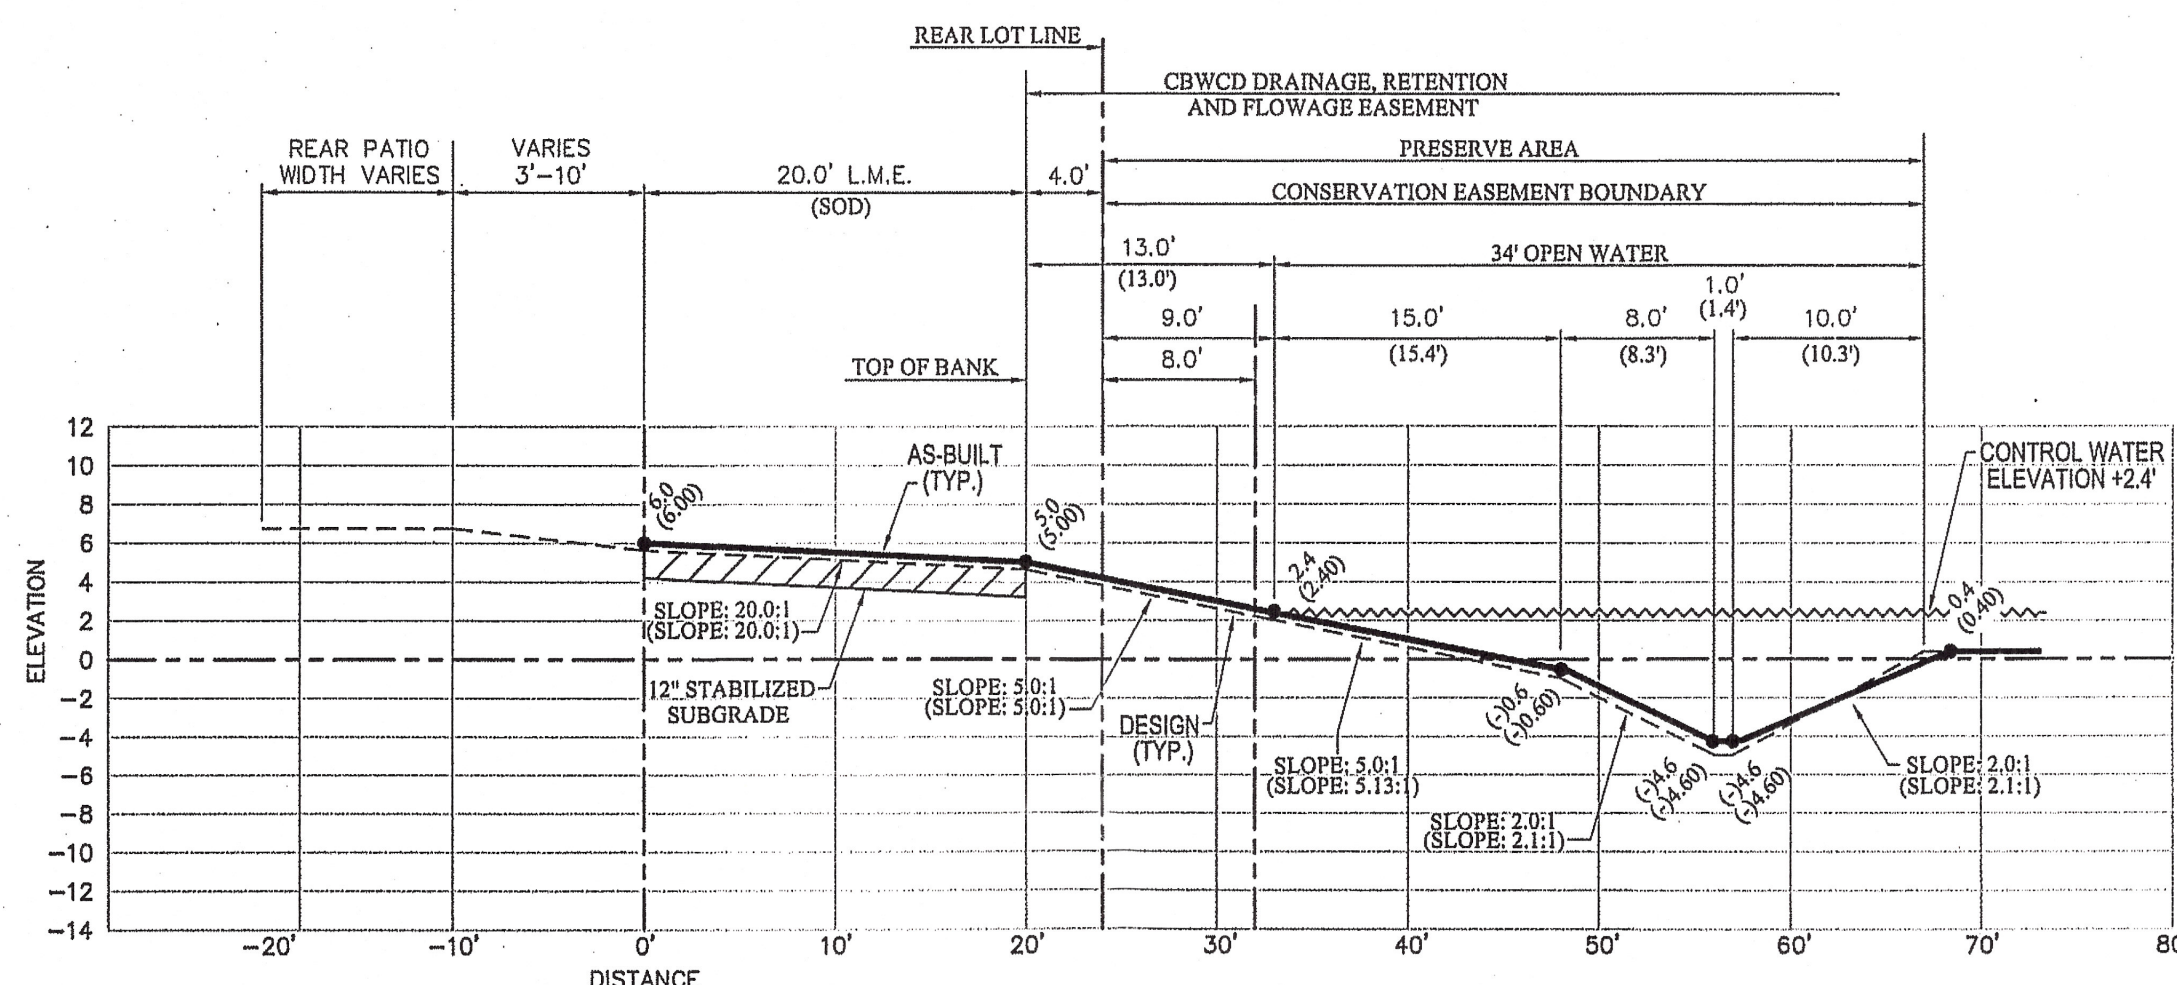


SECTION No. 30

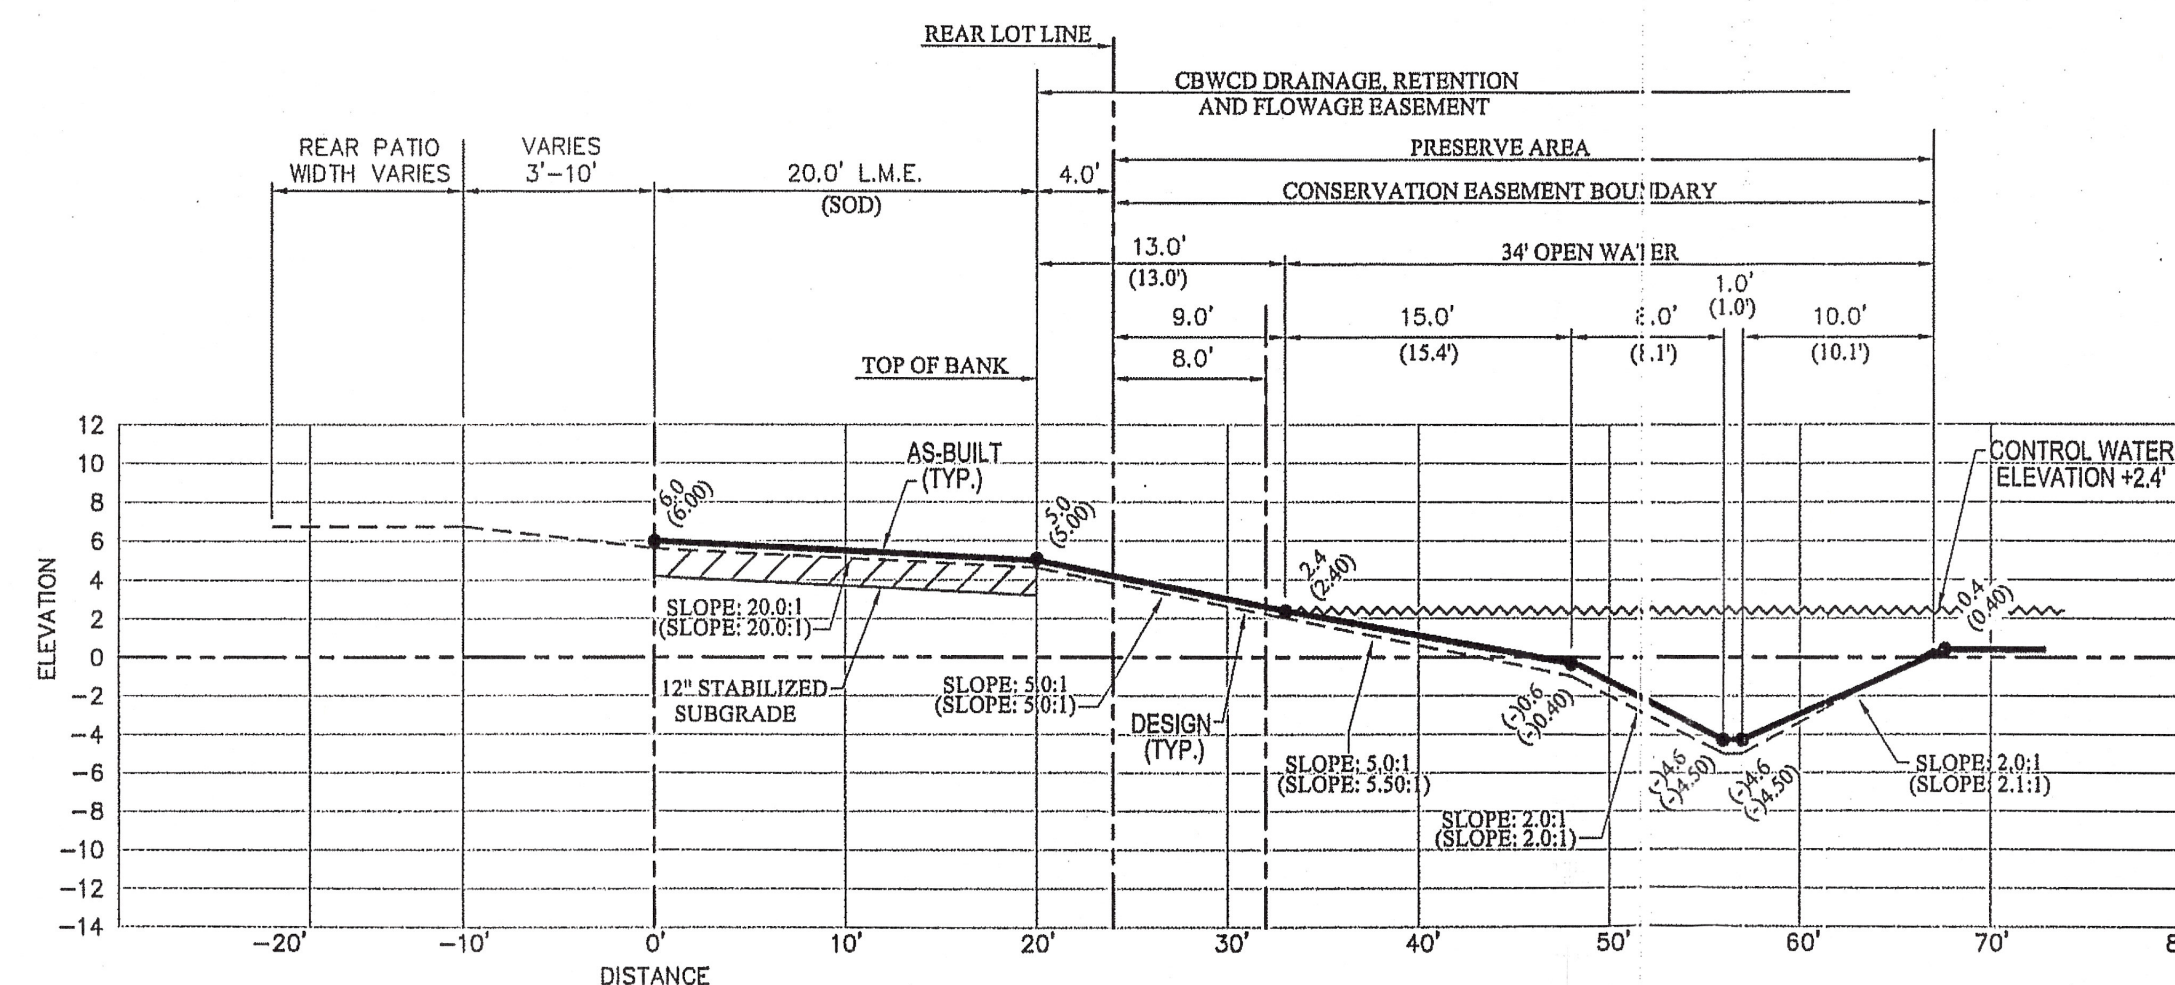

SECTION No. 31

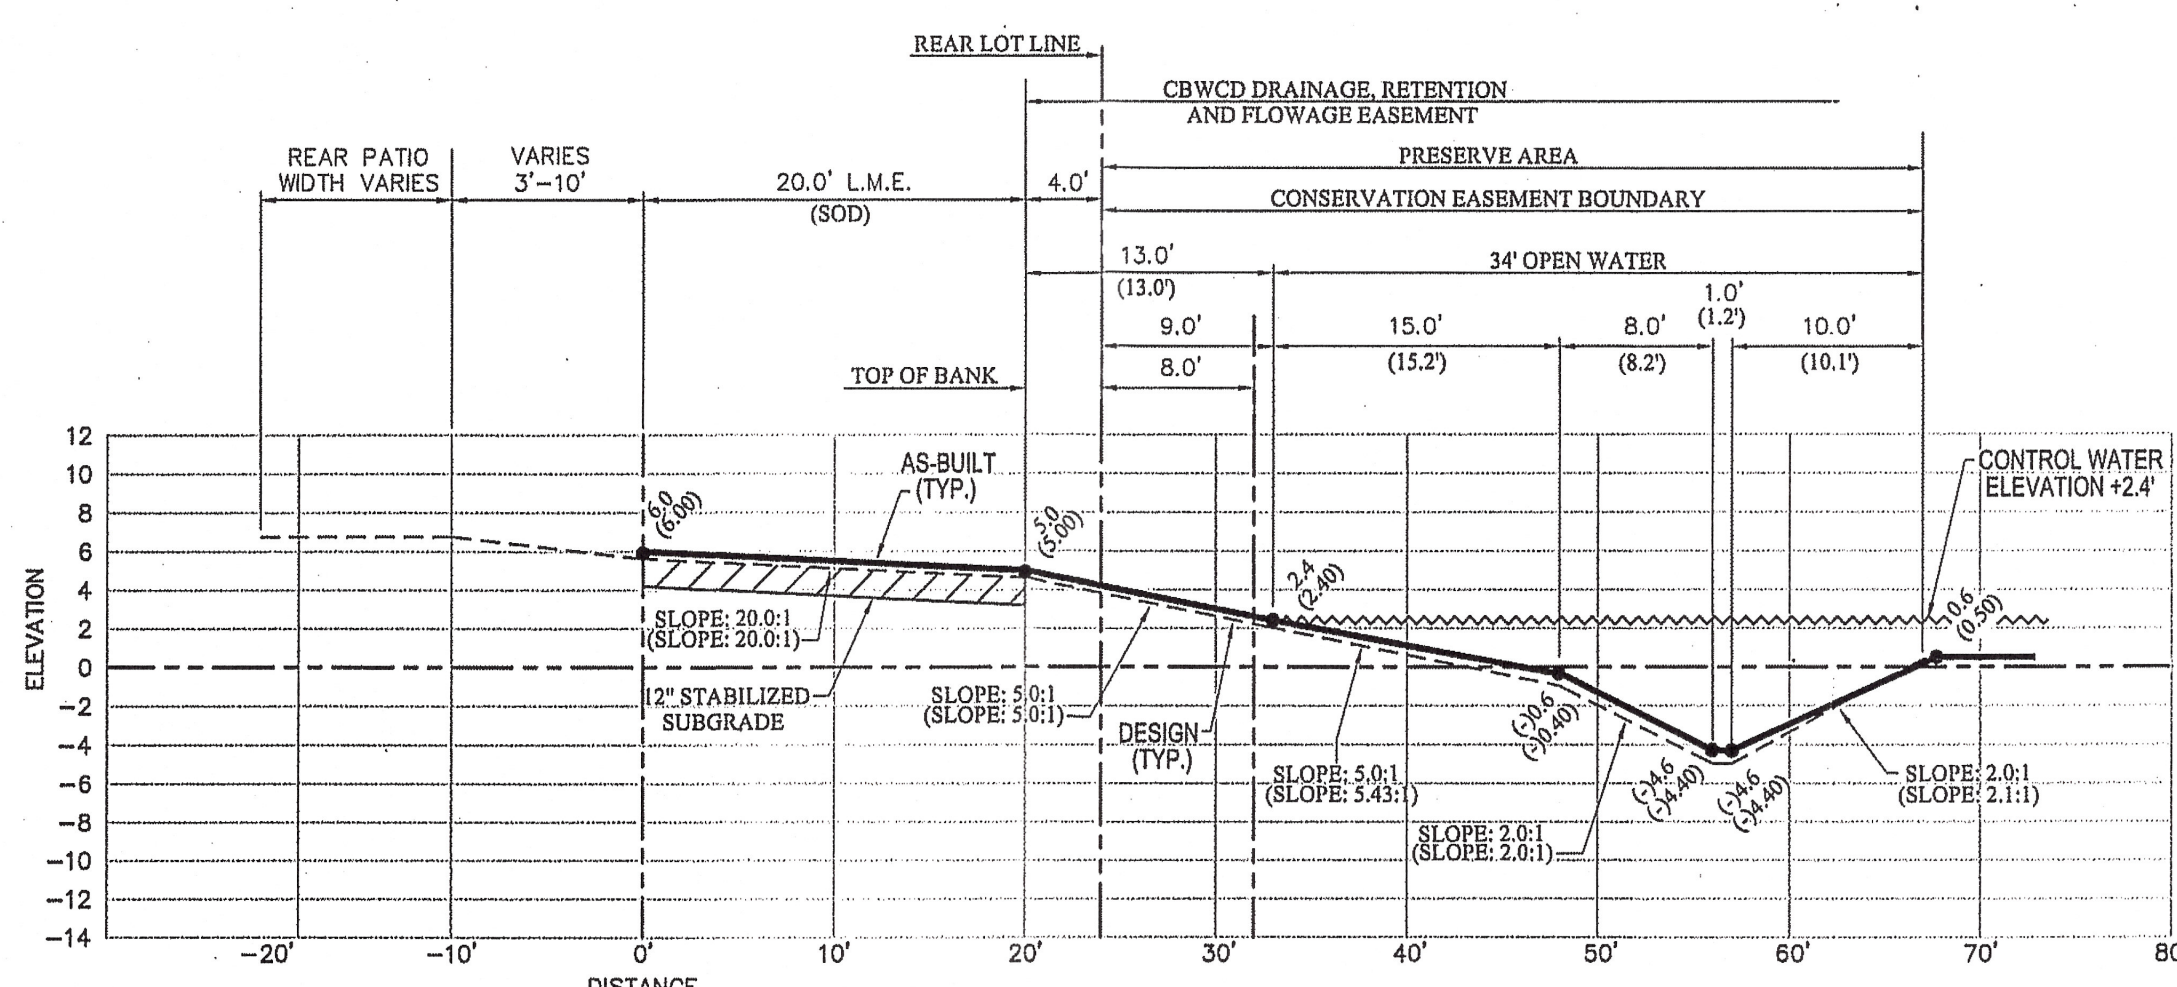

SECTION No. 32

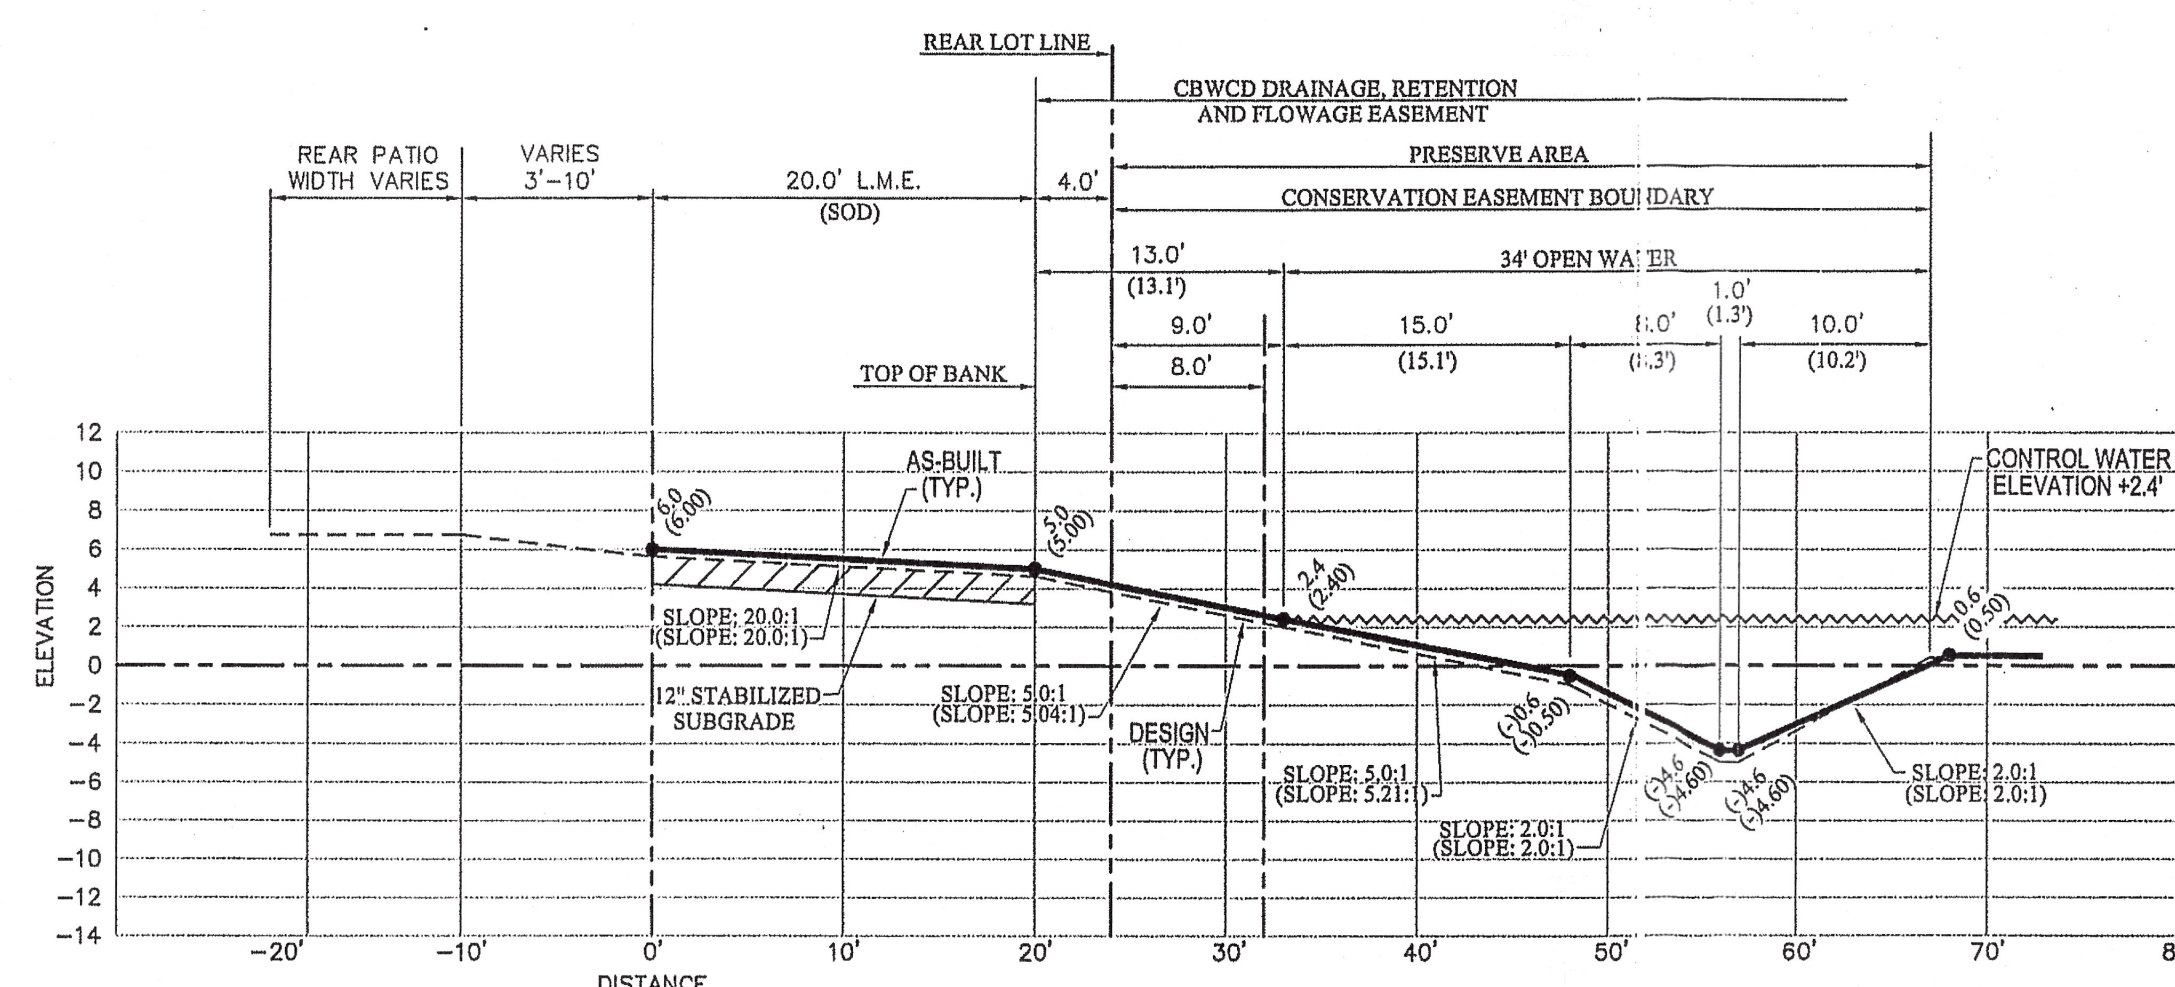


SECTION No. 33

AS-BUILT LEGEND:

- (15.2) DENOTES AS-BUILT DISTANCE
- 15.0' DENOTES DESIGN DISTANCE
- 13.0 DENOTES AS-BUILT ELEVATION
- 13.0 DENOTES DESIGN ELEVATION
- (SLOPE: 20.2:1) DENOTES AS-BUILT SLOPE
- SLOPE: 20.0:1 DENOTES DESIGN SLOPE
- L.M.E. DENOTES LAKE MAINTENANCE EASEMENT
- DENOTES AS-BUILT LINE
- - - - - DENOTES DESIGN LINE

NOTE:


THE AS-BUILT LINEWORK SHOWN HEREON IS A GRAPHICAL REPRESENTATION AND MAY NOT BE DRAWN TO SCALE FOR CLARITY PURPOSES.

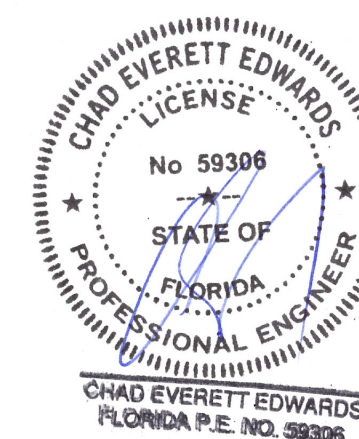

DATE: 7/25/23

BY: JOSEPH L. MARTIN
PROFESSIONAL SURVEYOR &
MAPPER No 4368
STATE OF FLORIDA


NOT VALID WITHOUT THE SIGNATURE AND THE ORIGINAL RAISED SEAL OF A FLORIDA LICENSED SURVEYOR AND MAPPER.

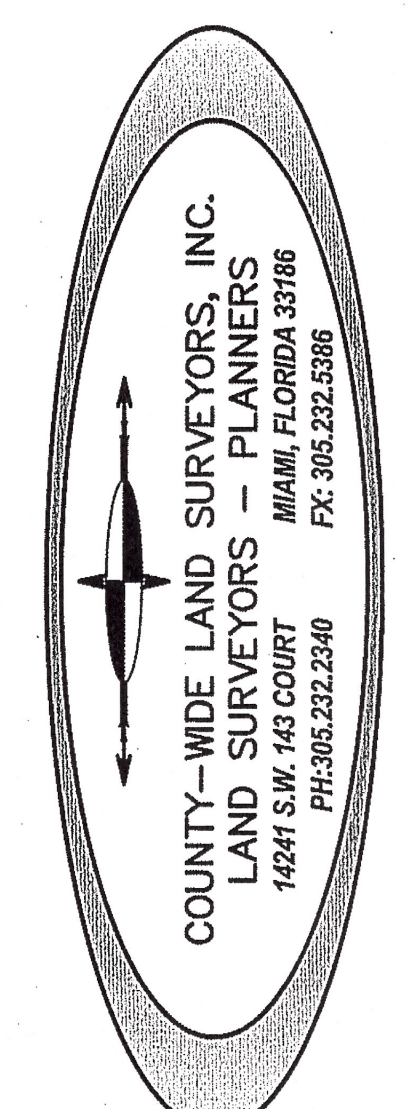


SIERRA RANCH
DAVIE, FL.

PROJ. TYPE	AS-BUILT CROSS SECTIONS	DATE	REVISION COMMENTS	BY	APP
	1950 SOUTH HIATUS ROAD	05-18-21	REVISED PER ENGINEER'S COMMENTS	L.A.	J.M.
	SEC. 18, TWP. 50S. RGE. 41E	11-8-21	REVISED TO ADD SECTIONS FROM 16 TO 36	L.A.	J.M.
		12-8-21	REVISED TO ADD SECTIONS FROM 37 TO 125	L.A.	G.B.
		12-10-21	REVISED PER ENGINEER'S COMMENTS	L.A.	G.B.


AUG 16 2023

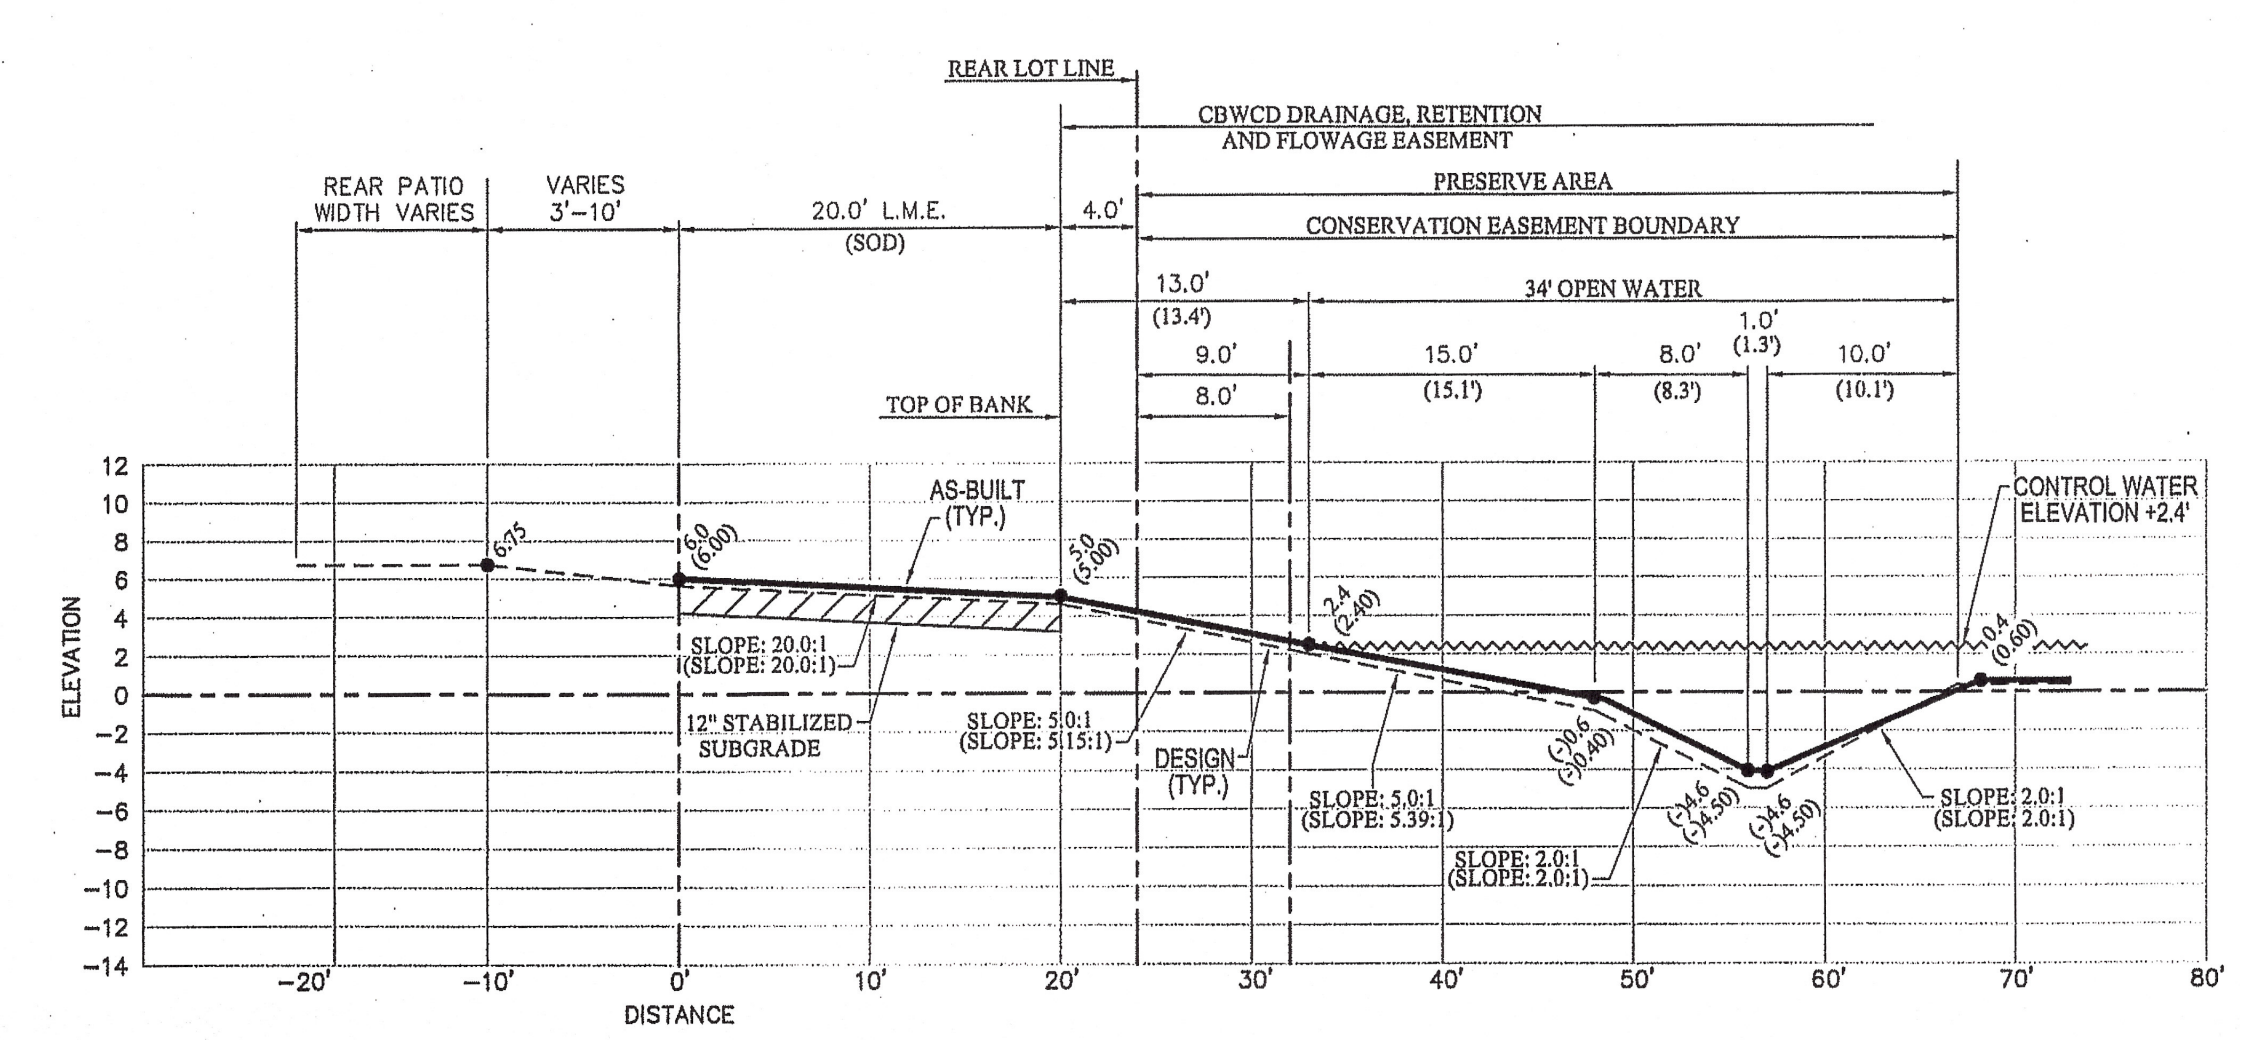


SECTION No. 34

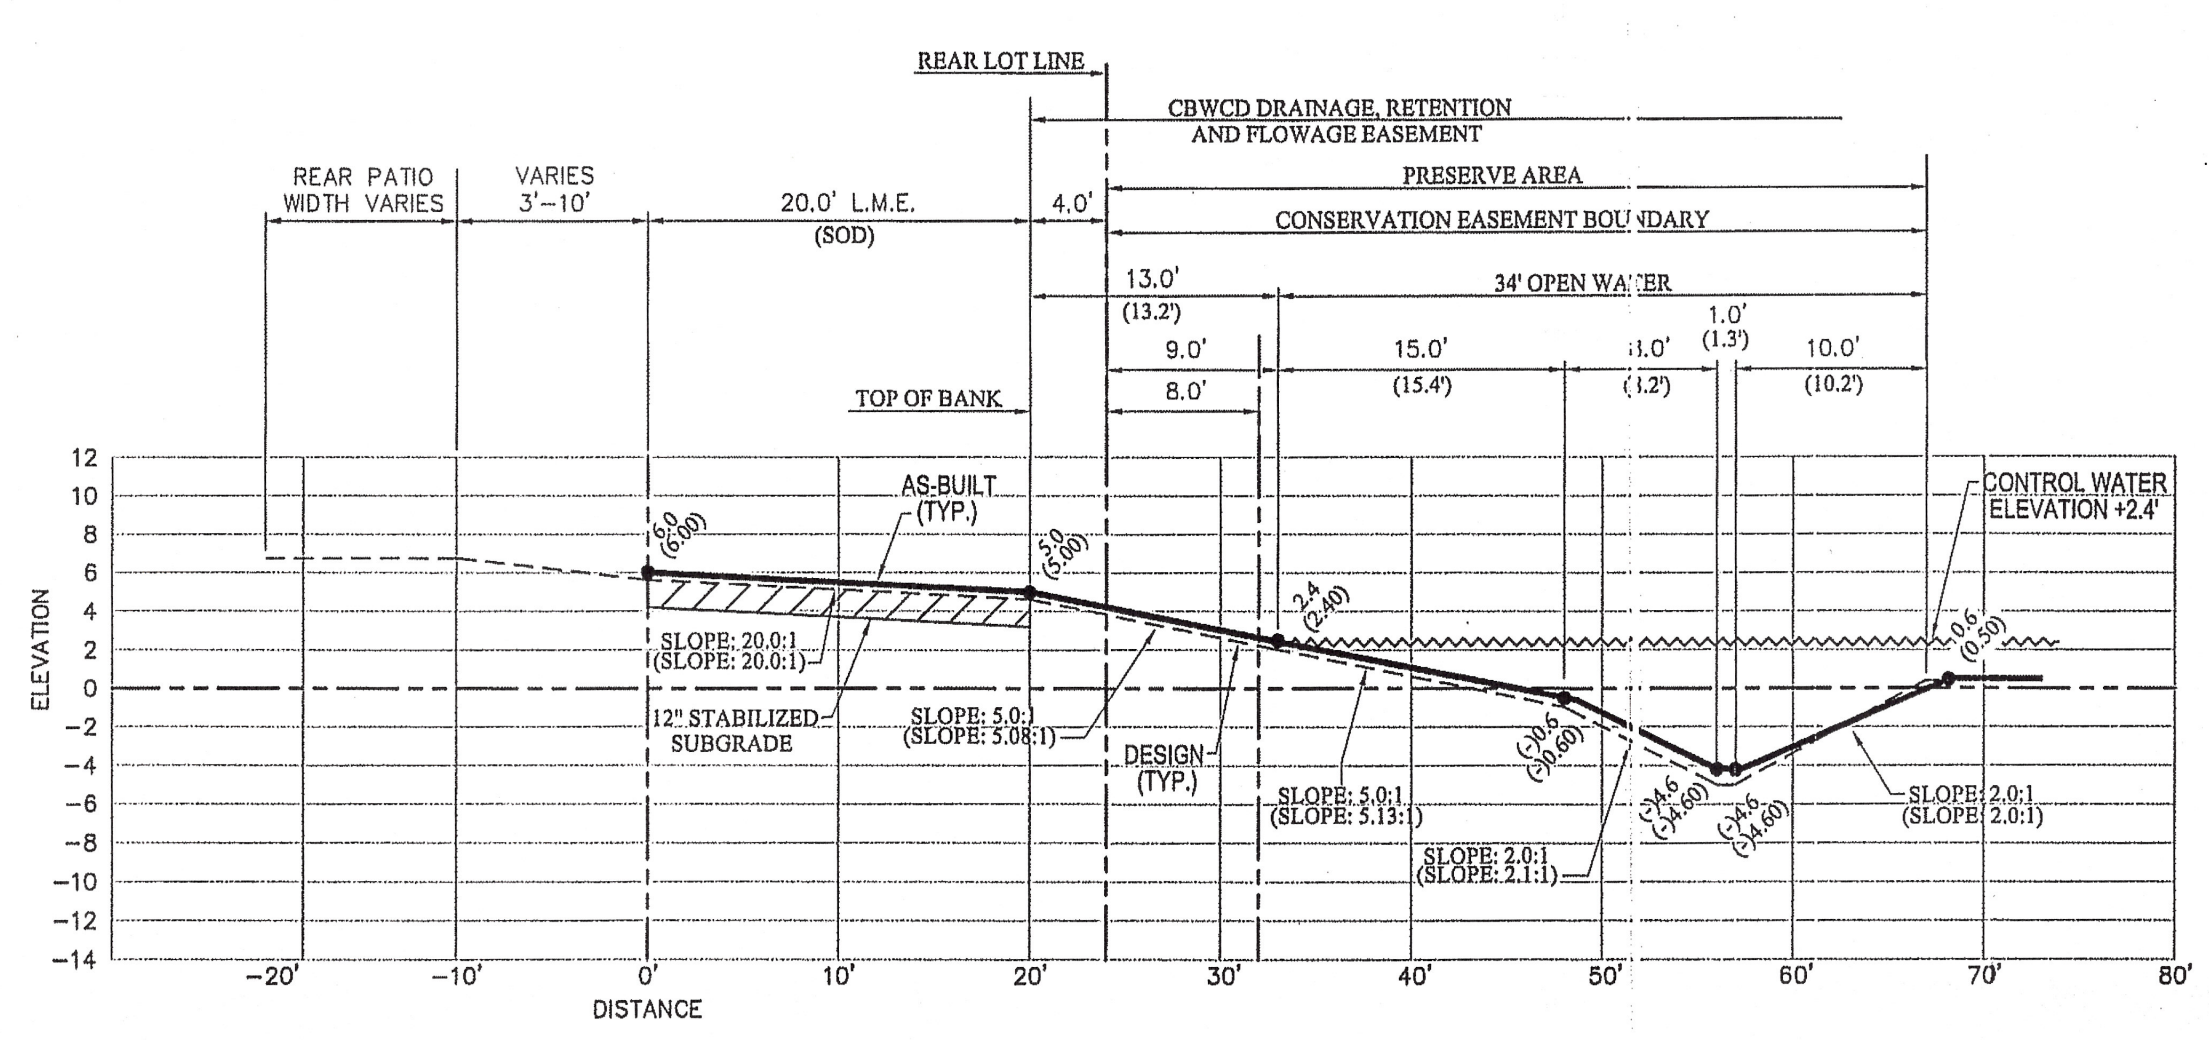

SECTION No. 35

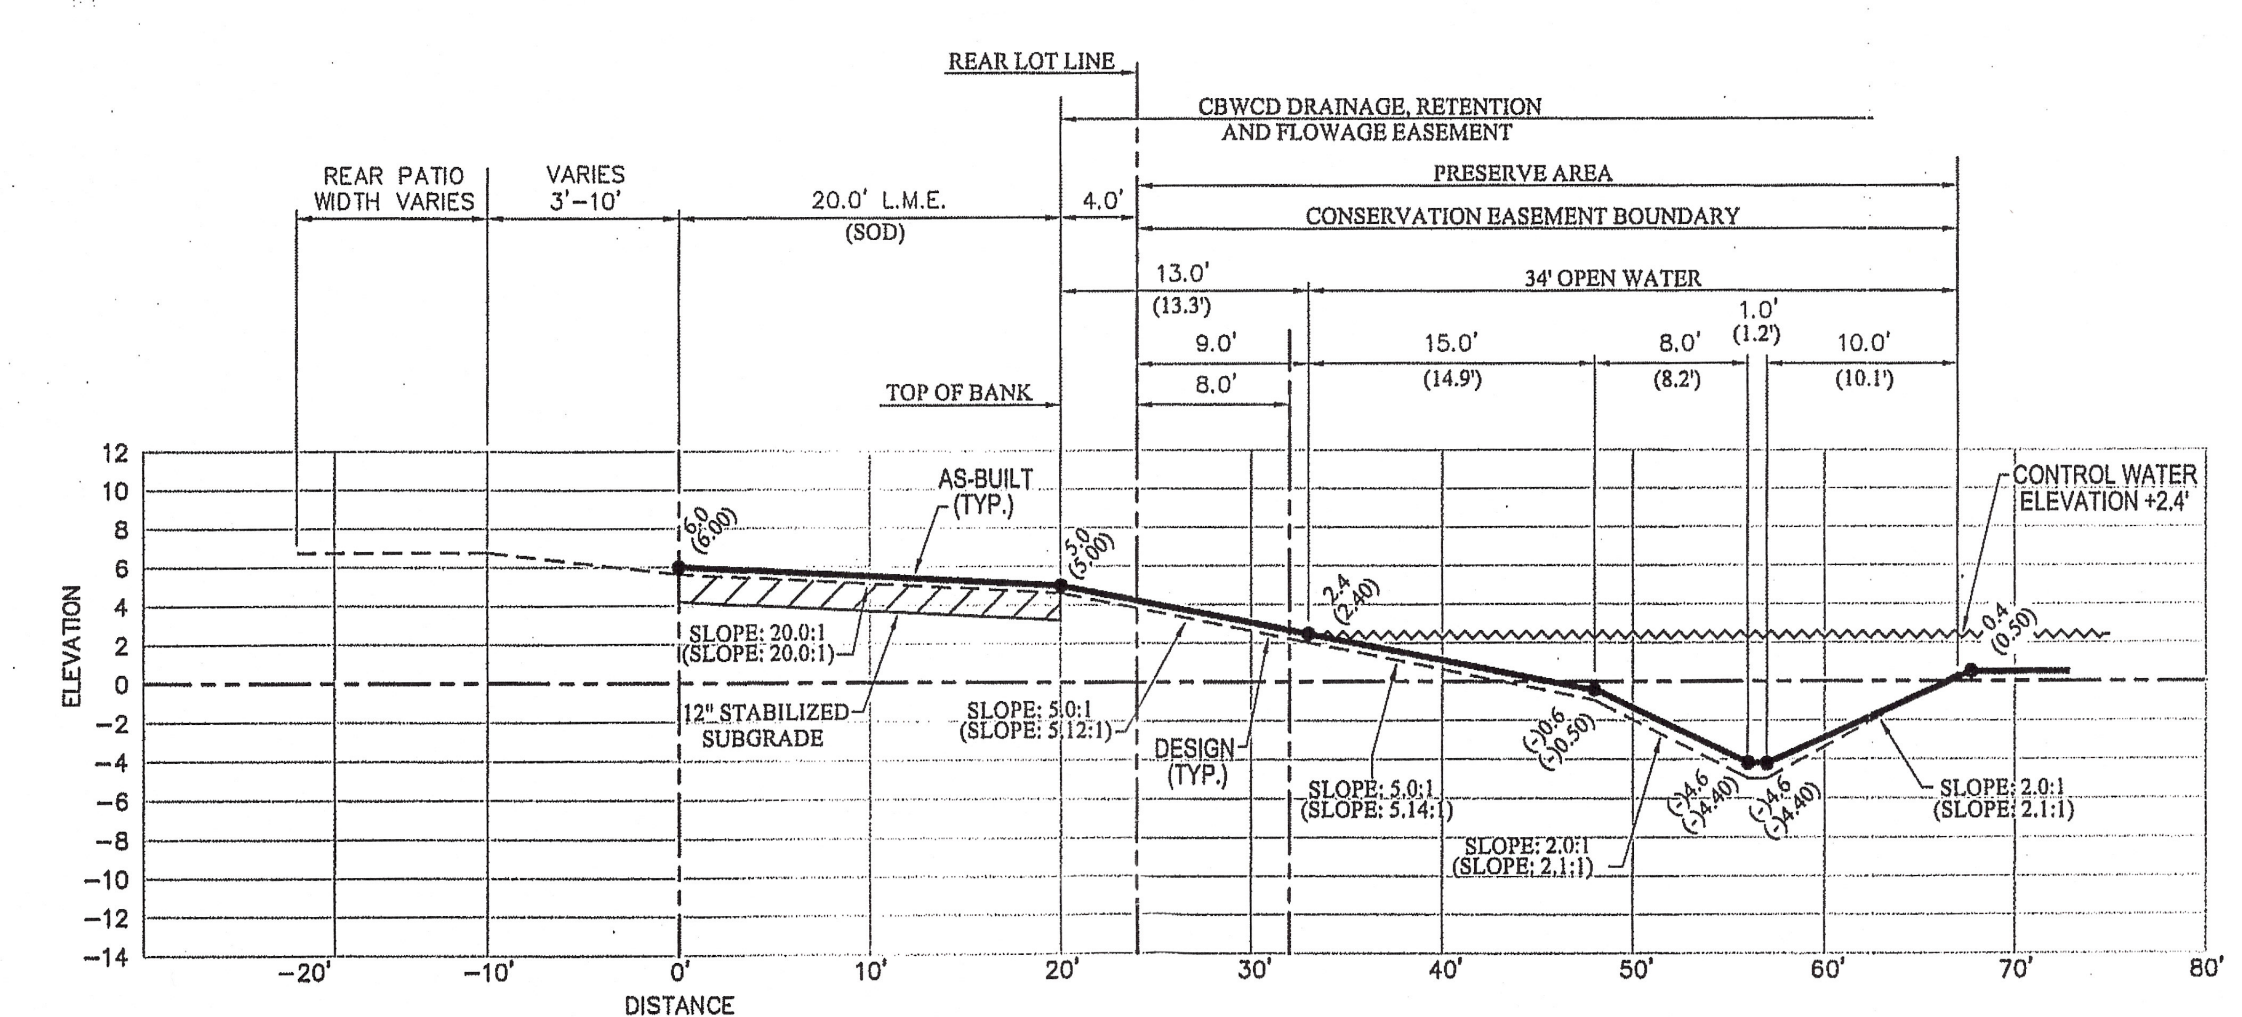


SECTION No. 36

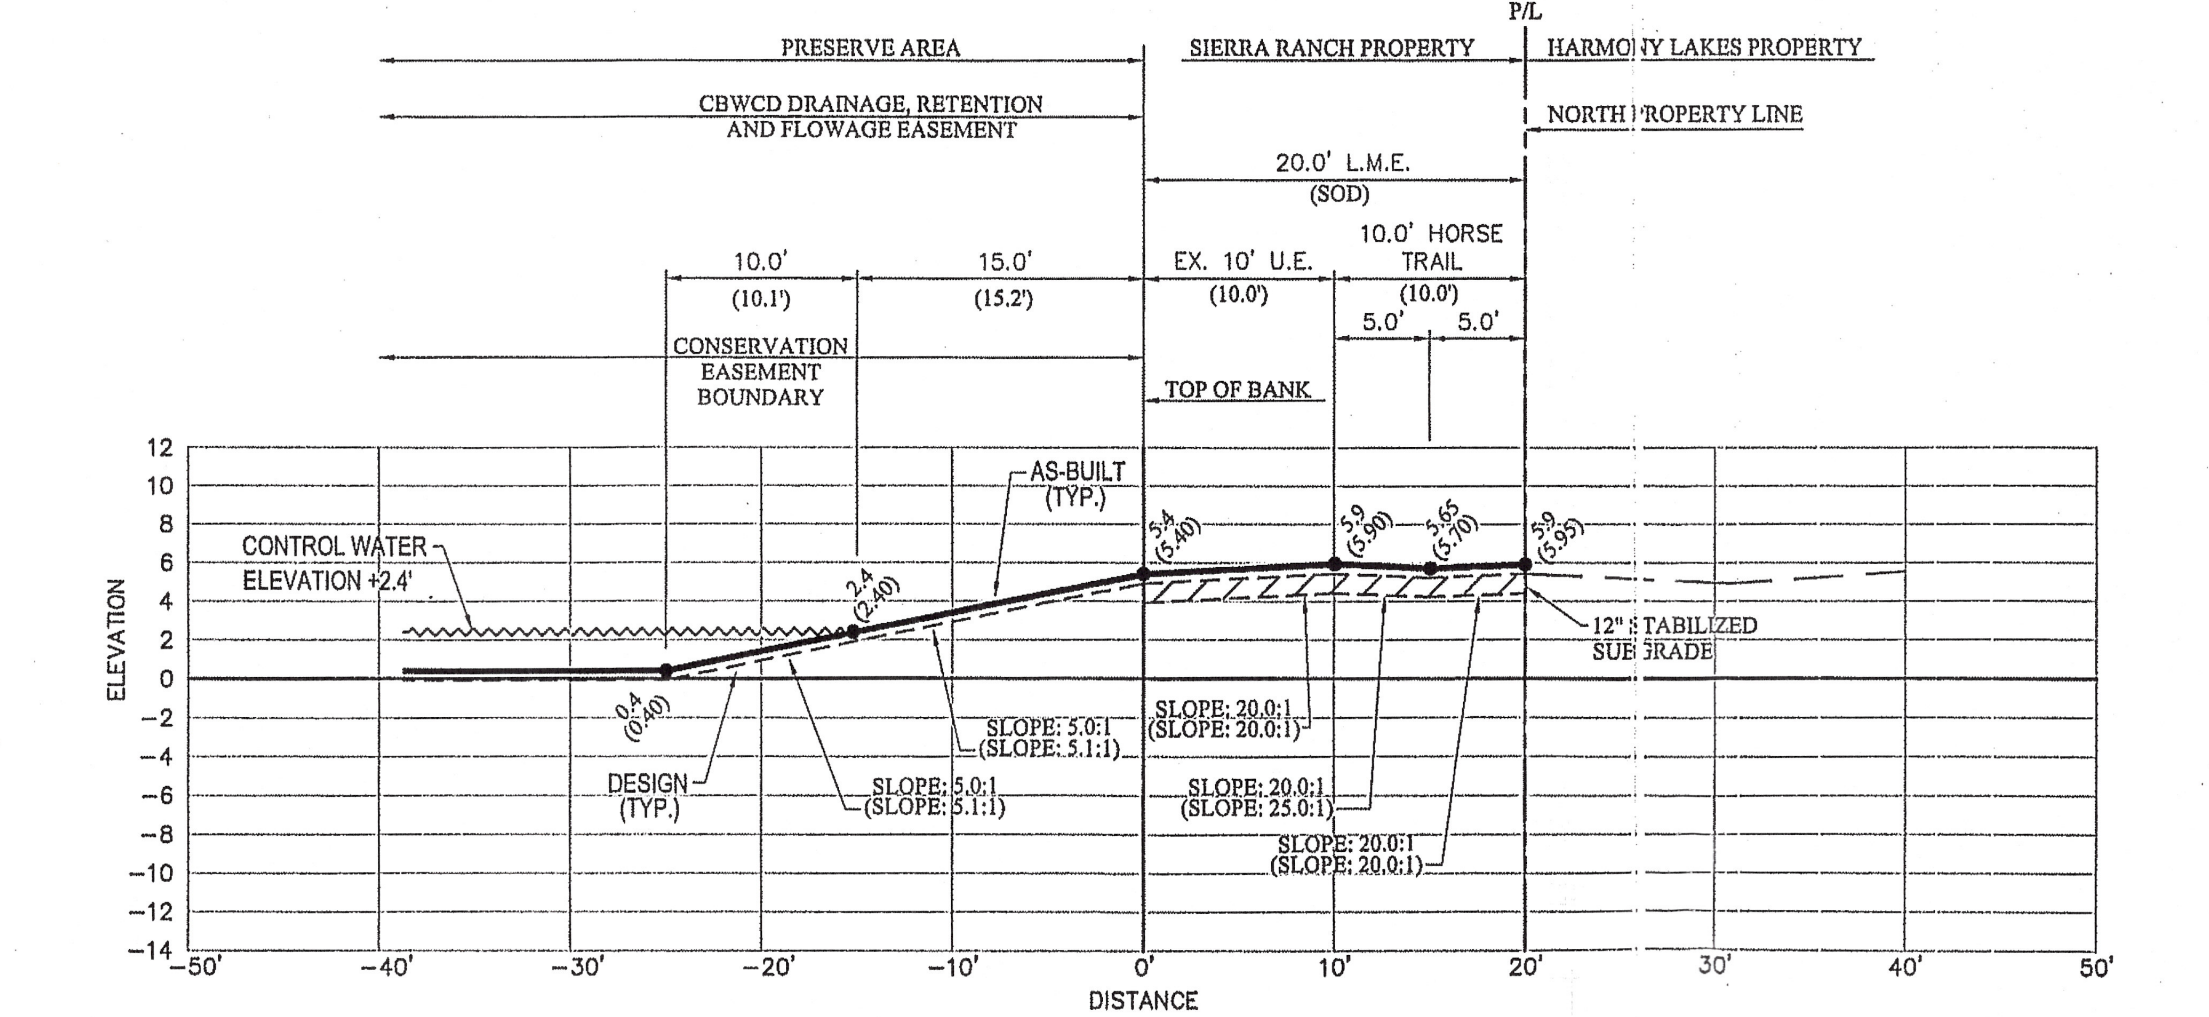


SECTION No. 37

NORTH PROPERTY LINE

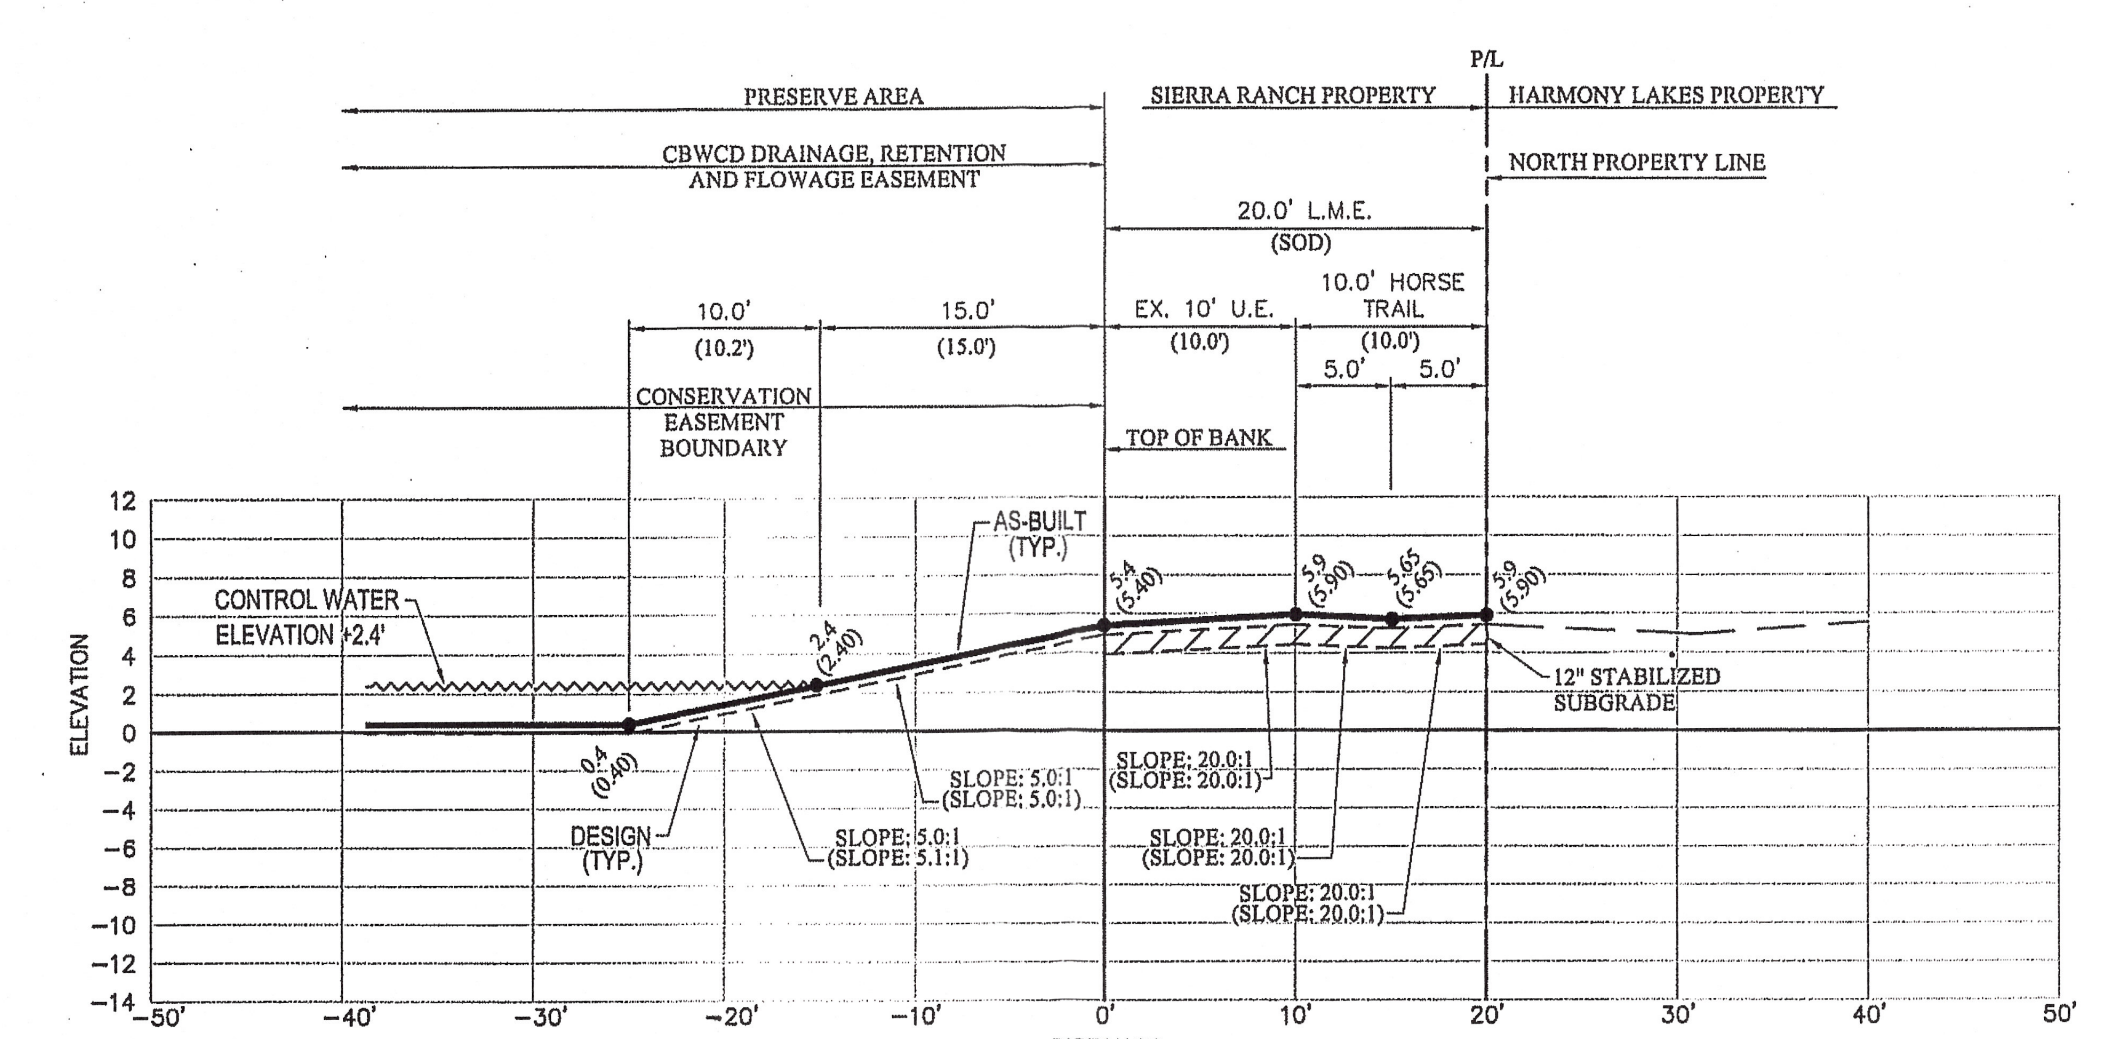

SECTION No. 38

NORTH PROPERTY LINE

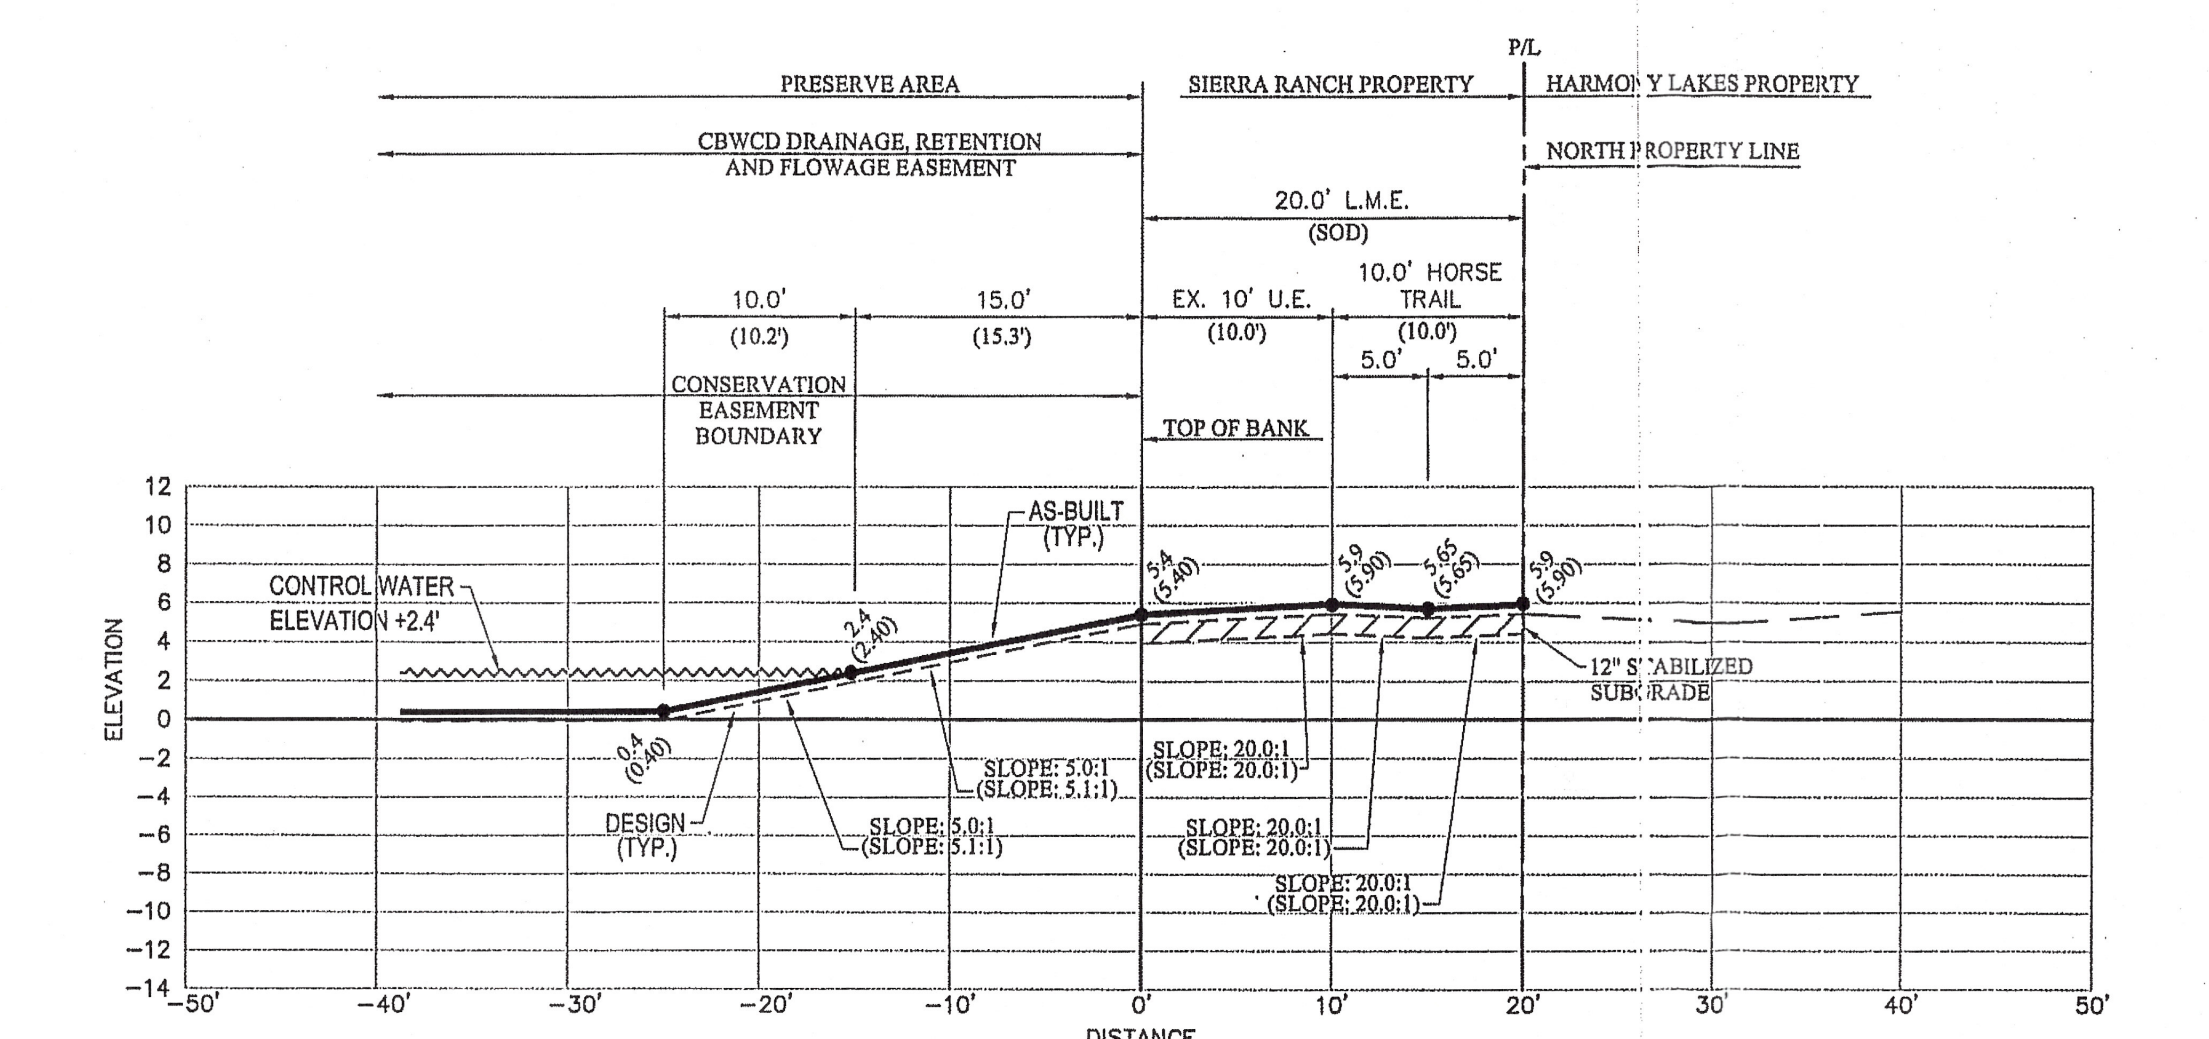


SECTION No. 39

NORTH PROPERTY LINE

AS-BUILT LEGEND:

- (15.2') DENOTES AS-BUILT DISTANCE
- 15.0' DENOTES DESIGN DISTANCE
- 6.5 DENOTES AS-BUILT ELEVATION
- 6.5 DENOTES DESIGN ELEVATION
- (SLOPE: 20.0:1) DENOTES AS-BUILT SLOPE
- SLOPE: 20.0:1 DENOTES DESIGN SLOPE
- L.M.E. DENOTES LAKE MAINTENANCE EASEMENT
- DENOTES AS-BUILT LINE
- - - - - DENOTES DESIGN LINE

NOTE:
THE AS-BUILT LINEWORK SHOWN HEREON IS A GRAPHICAL REPRESENTATION AND MAY NOT BE DRAWN TO SCALE FOR CLARITY PURPOSES.

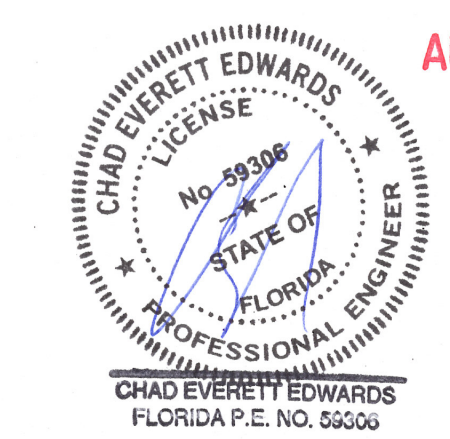

DATE: 7/25/23
BY: JOSEPH L. MARTIN
PROFESSIONAL SURVEYOR &
MAPPER No 4368
STATE OF FLORIDA