




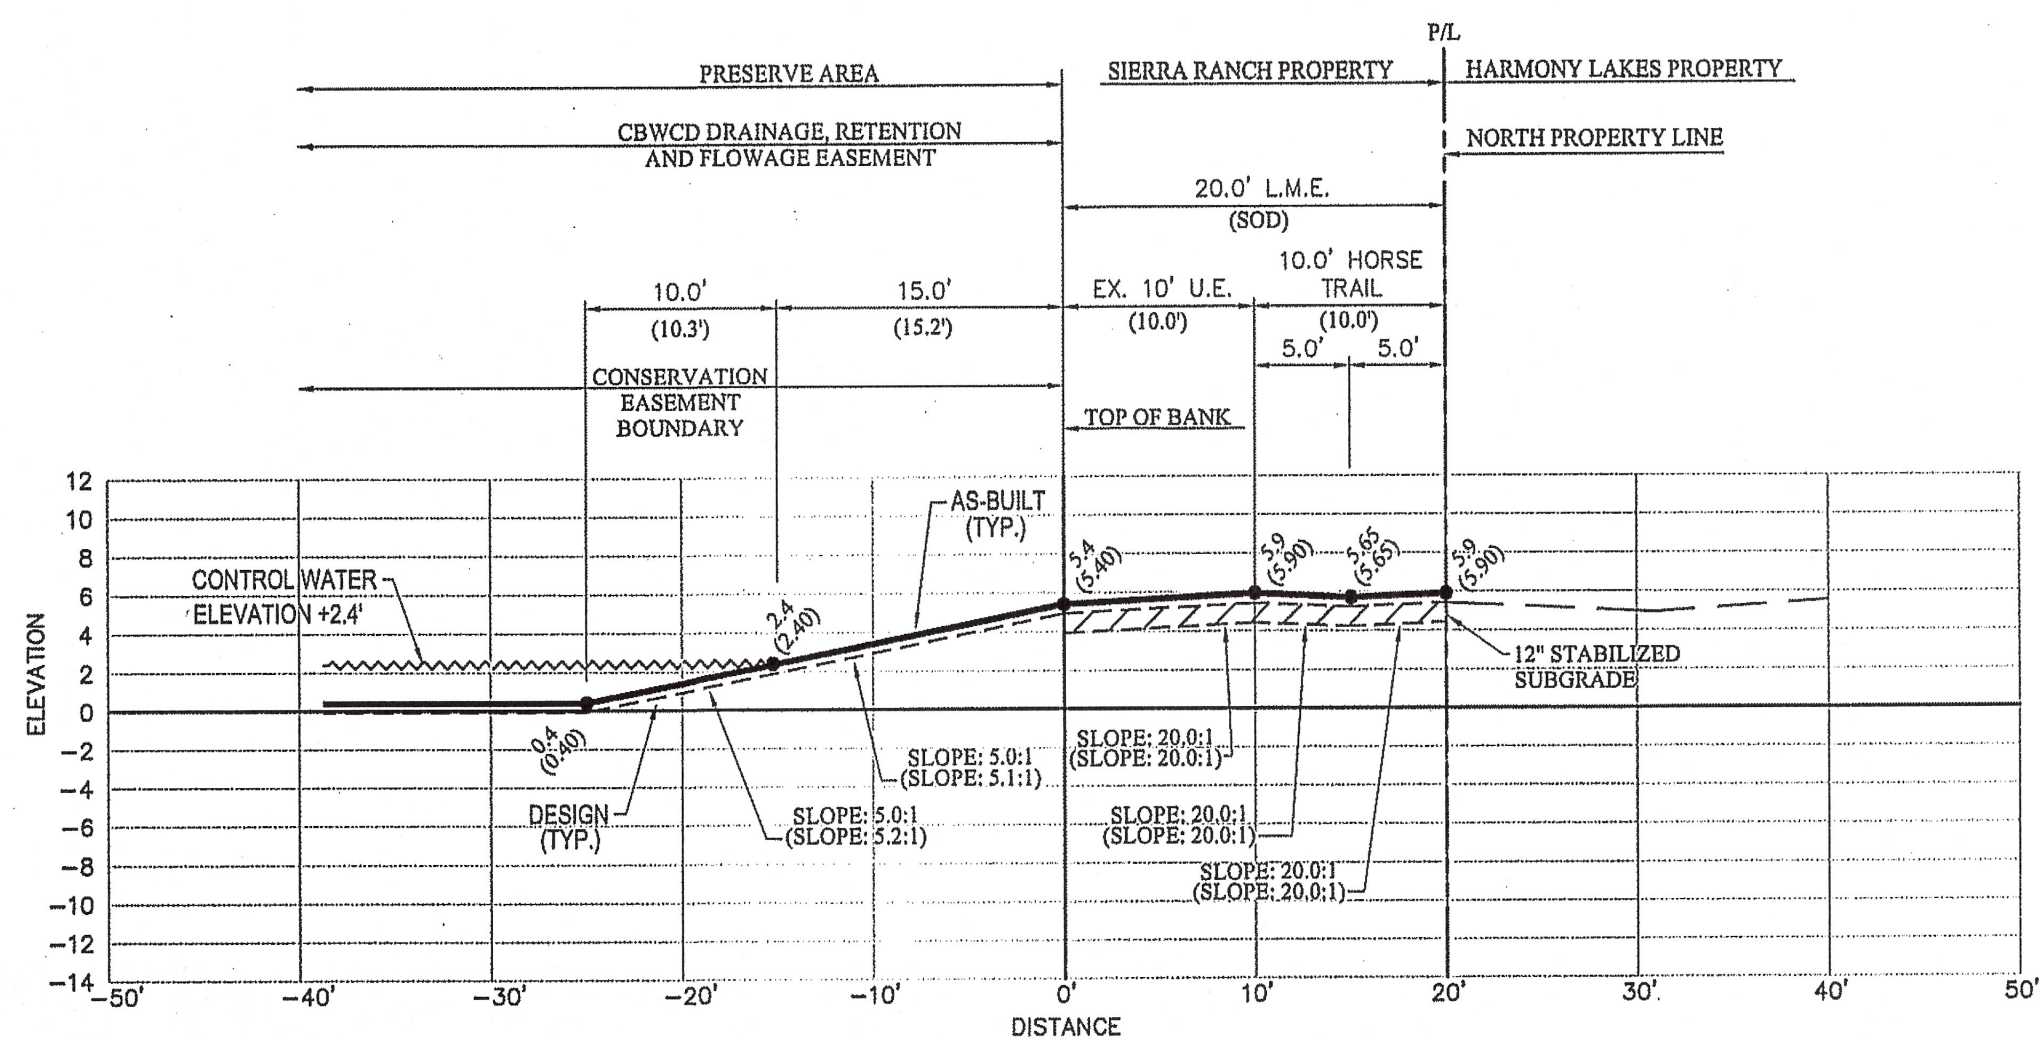


SECTION No. 40
NORTH PROPERTY LINE

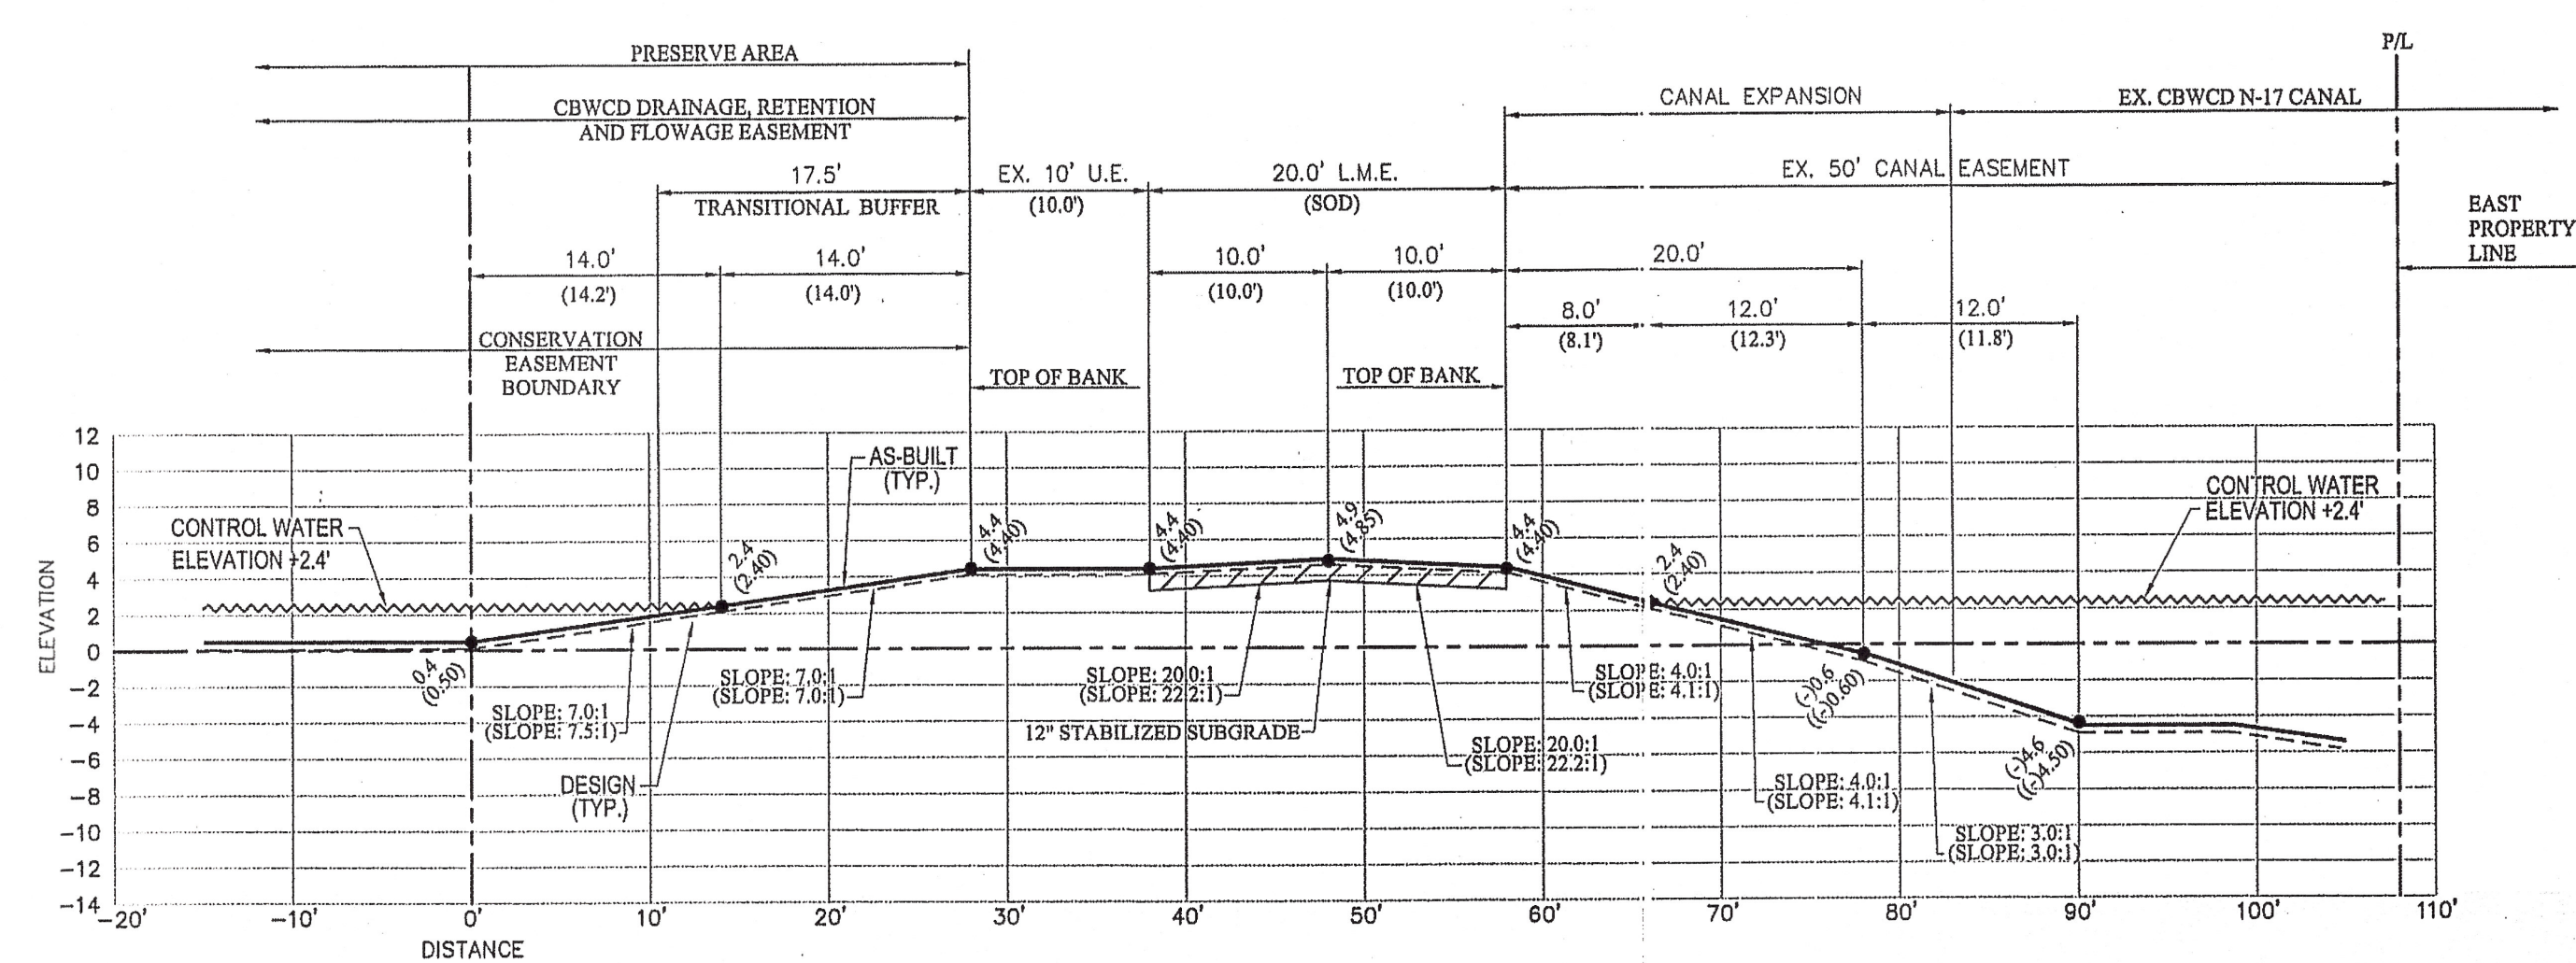


SECTION No. 41
EAST PROPERTY LINE

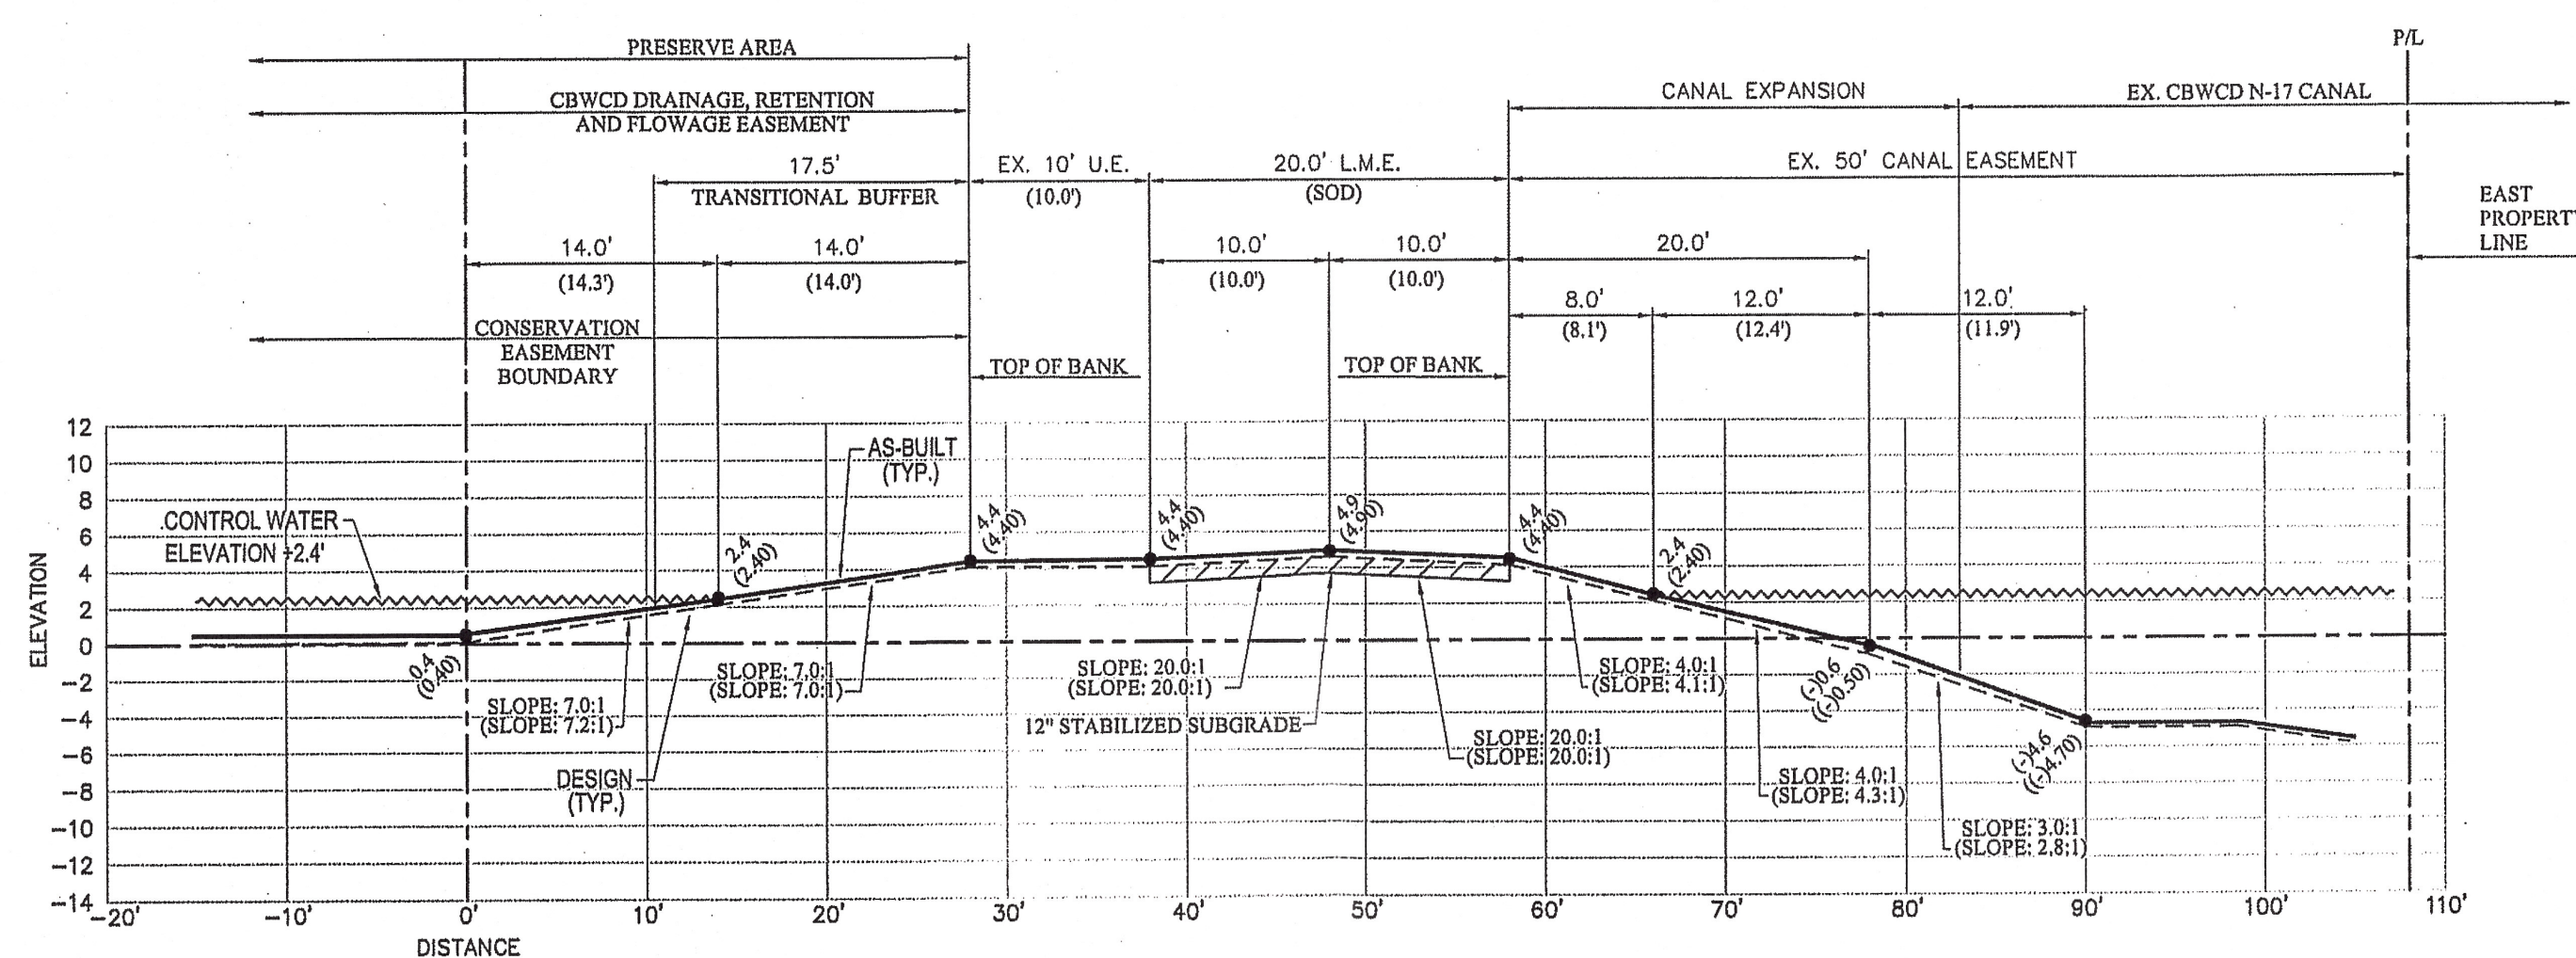


SECTION No. 42
EAST PROPERTY LINE

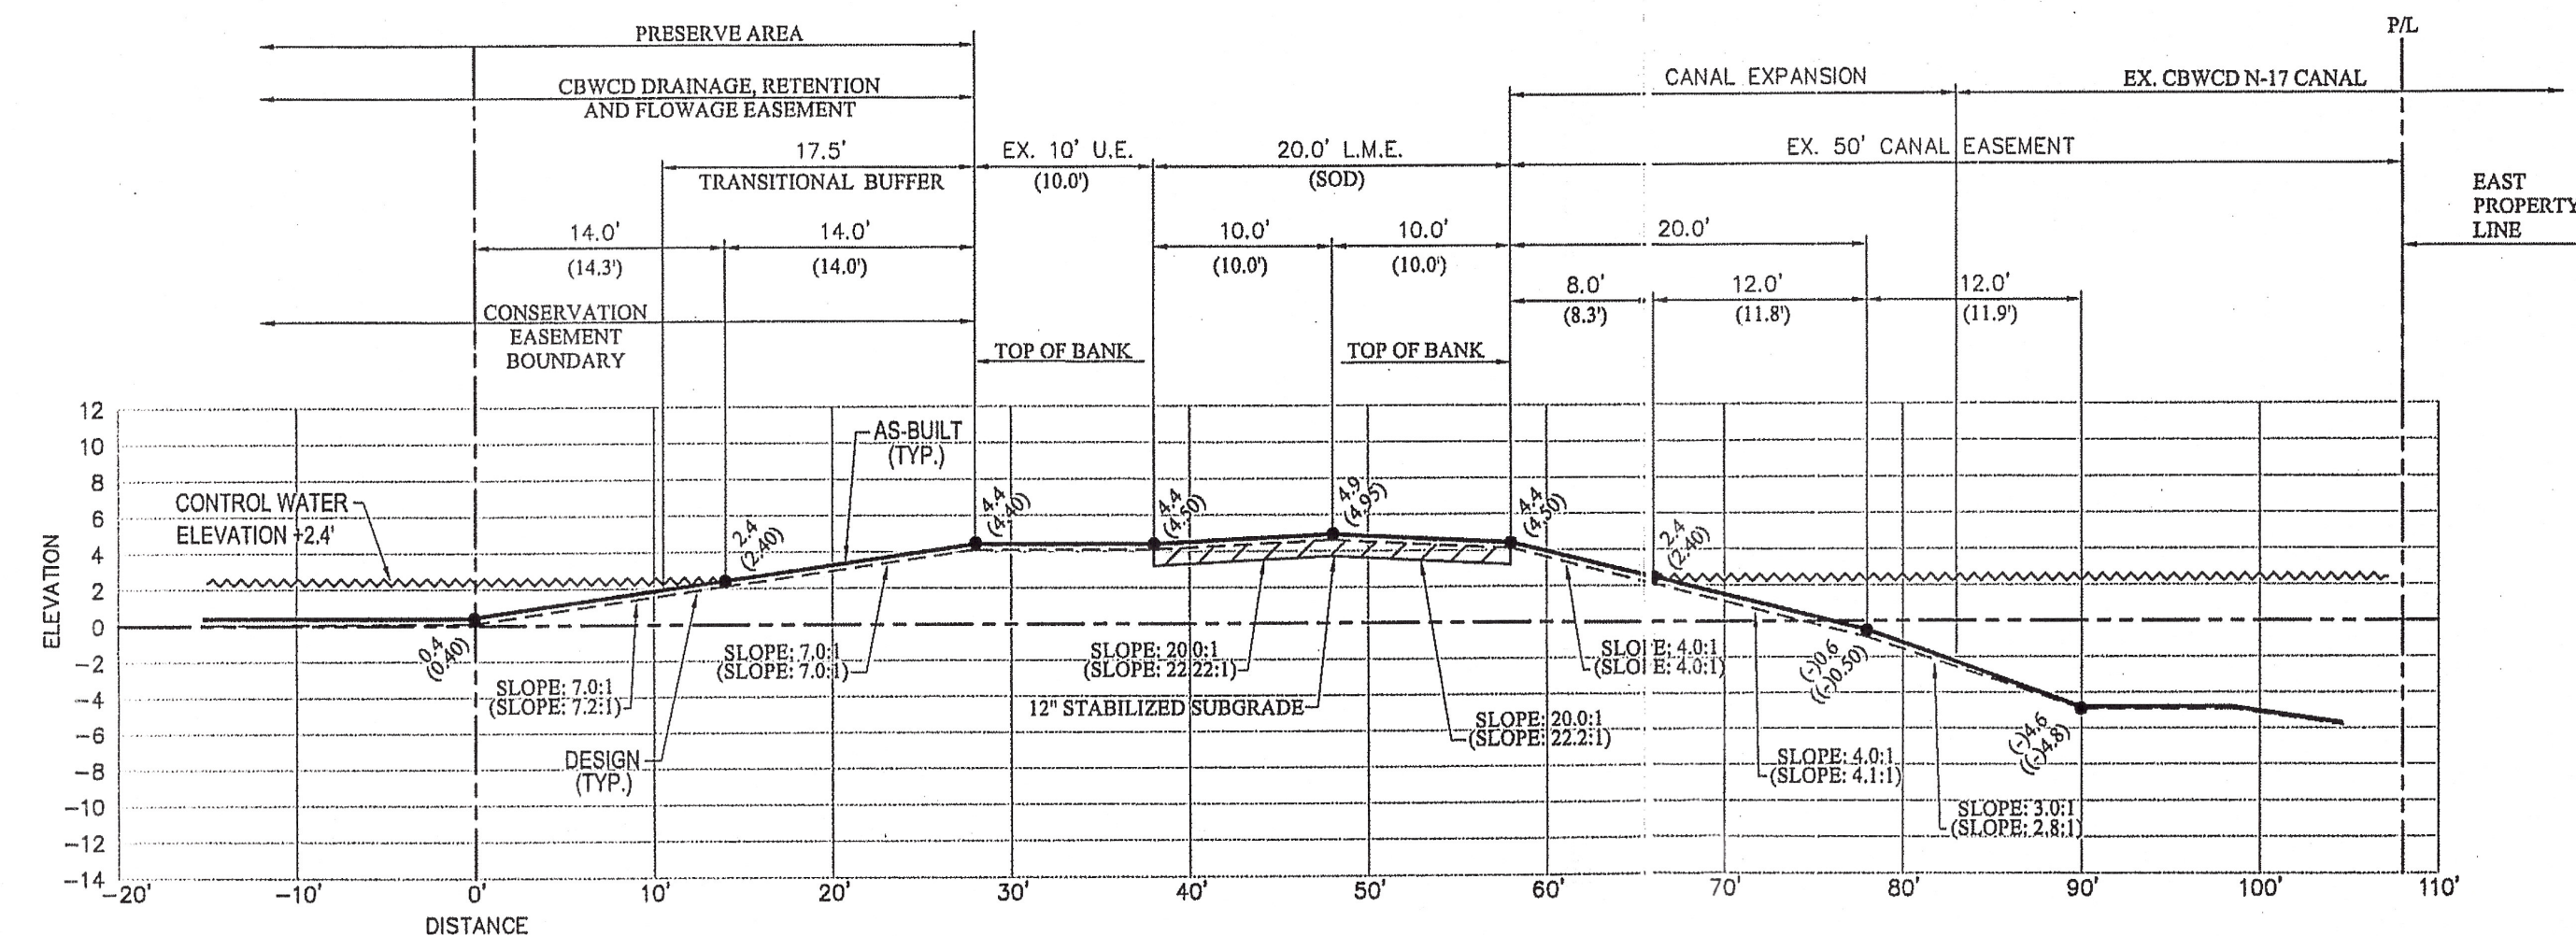

SECTION No. 43
EAST PROPERTY LINE

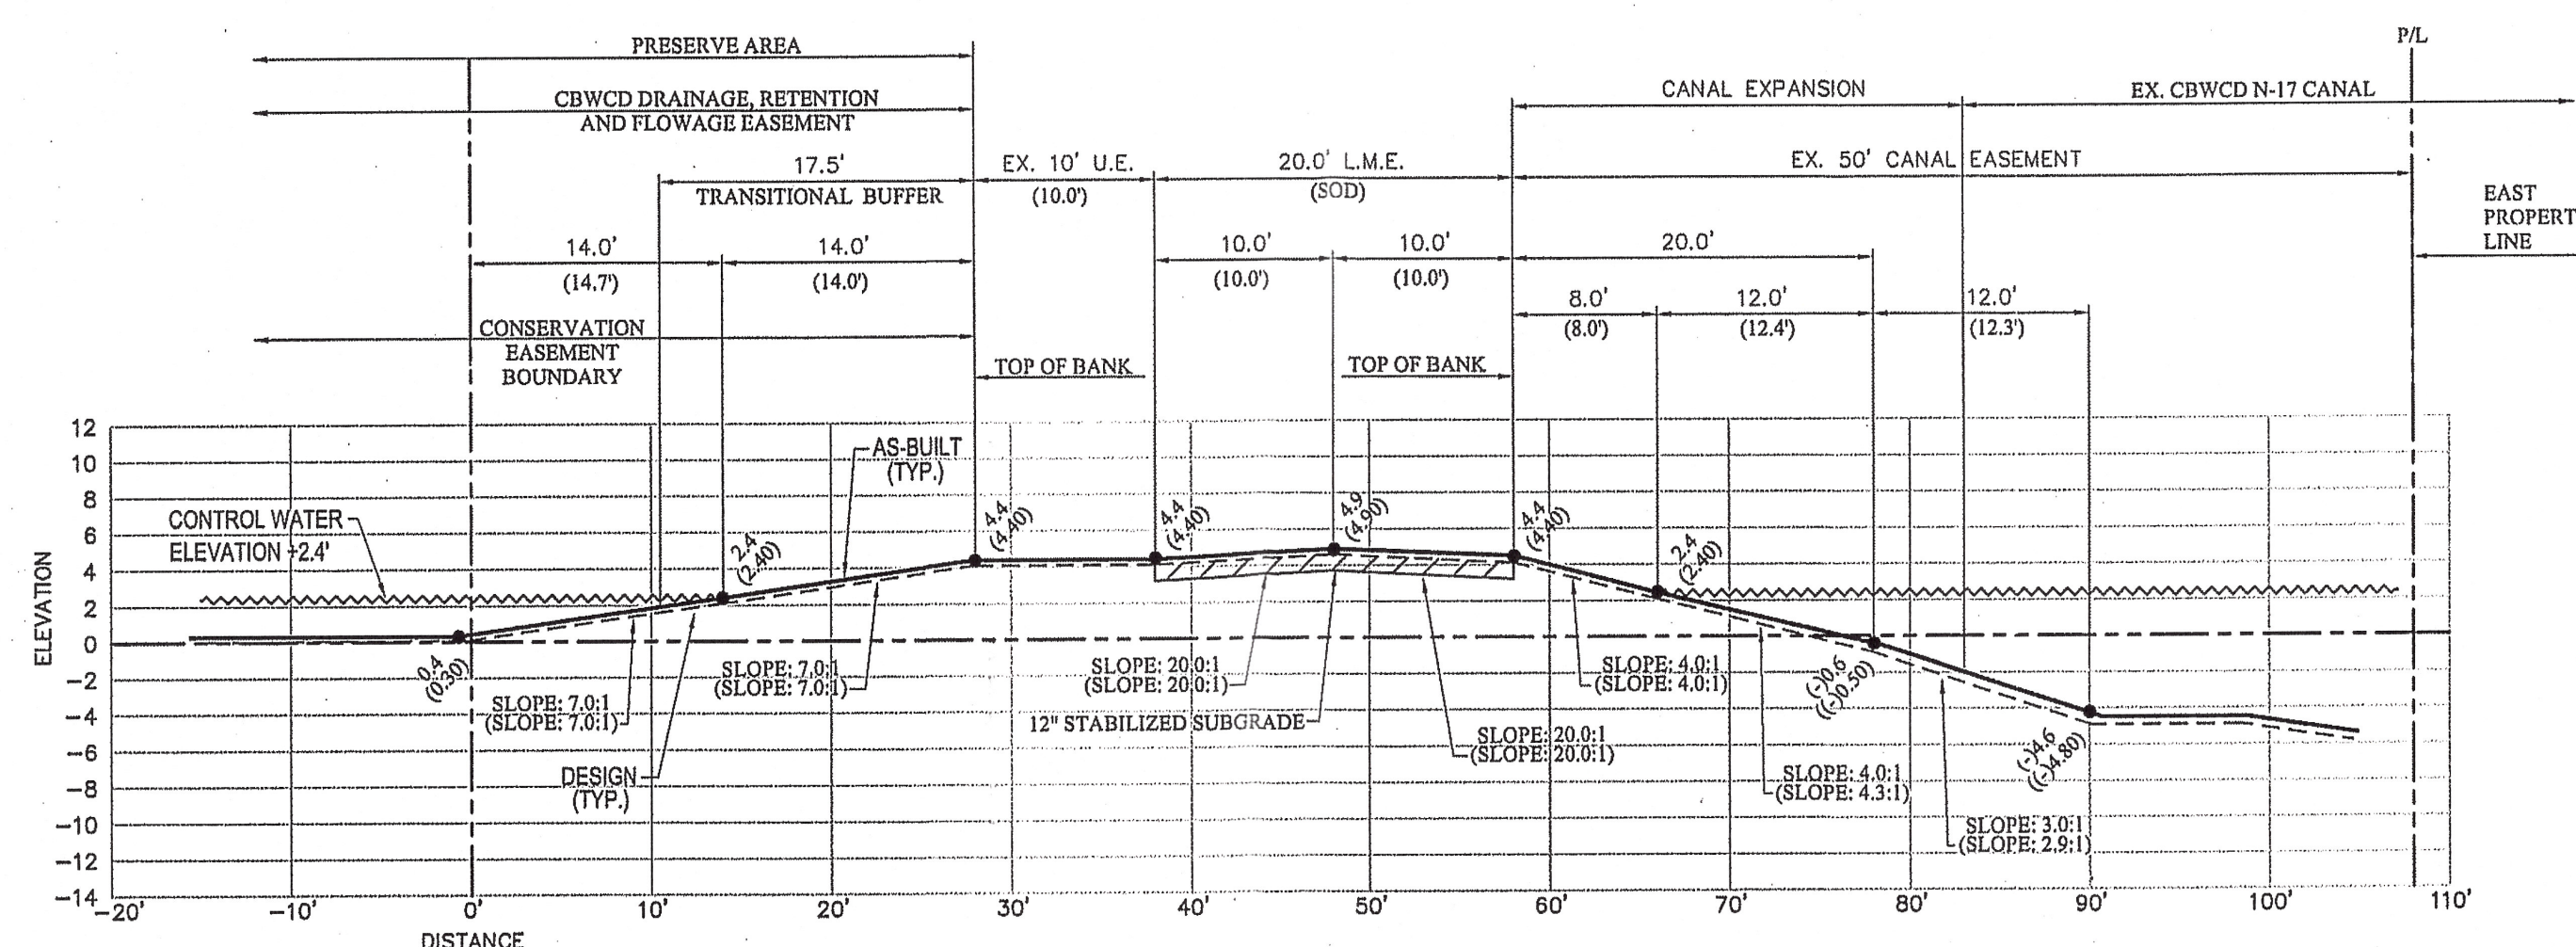

SECTION No. 44
EAST PROPERTY LINE

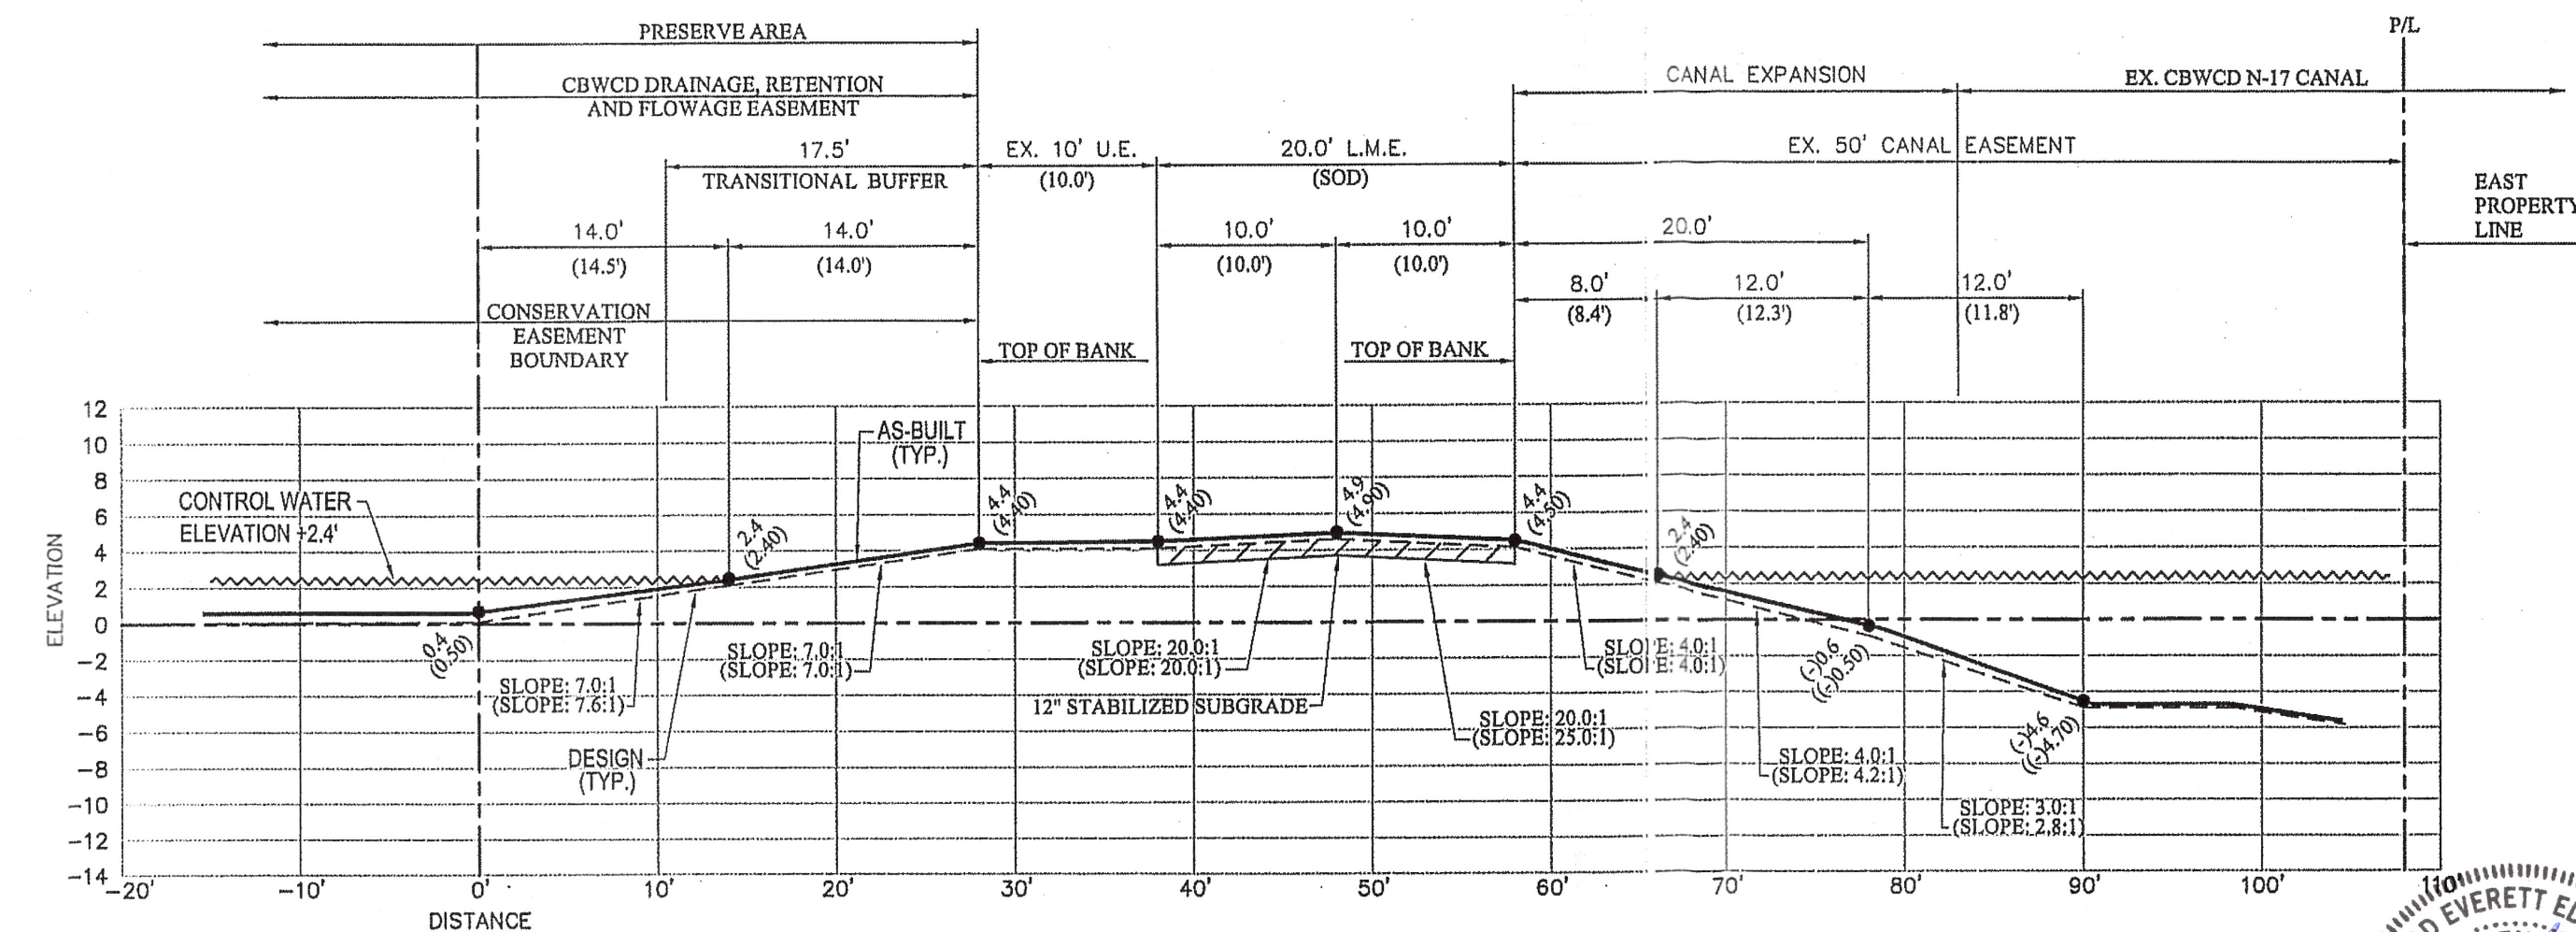

SECTION No. 45
EAST PROPERTY LINE

AS-BUILT LEGEND:

- | | |
|---|-----------------------------------|
|  | DENOTES AS-BUILT DISTANCE |
|  | DENOTES DESIGN DISTANCE |
|  | DENOTES AS-BUILT ELEVATION |
|  | DENOTES DESIGN ELEVATION |
|  | DENOTES AS-BUILT SLOPE |
|  | DENOTES DESIGN SLOPE |
|  | DENOTES LAKE MAINTENANCE EASEMENT |
|  | DENOTES AS-BUILT LINE |
|  | DENOTES DESIGN LINE |

NOTE:









THE AS-BUILT LINEWORK SHOWN HEREON IS A GRAPHICAL REPRESENTATION
AND MAY NOT BE DRAWN TO SCALE FOR CLARITY PURPOSES.

DATE: 1/13/23

BY: _____
JOSEPH L. MARTIN
PROFESSIONAL SURVEYOR &
MAPPER No 4368
STATE OF FLORIDA

SIERRA RANCH
DAVIE, FL.

PROJ. TYPE	AS-BUILT CROSS SECTIONS	DATE	REVISION COMMENTS	BY	APP
PROJ. LOC.: SECTION:	1950 SOUTH HIATUS ROAD SEC. 18, TWP. 50S, RGE. 41E	05-18-21	REVISED PER ENGINEER'S COMMENTS	L.A.	J.M.
		11-8-21	REVISED TO ADD SECTIONS FROM 16 TO 36	L.A.	J.M.
		12-8-21	REVISED TO ADD SECTIONS FROM 37 TO 125	L.A.	G.B.
		12-10-21	REVISED PER ENGINEER'S COMMENTS	L.A.	G.B.

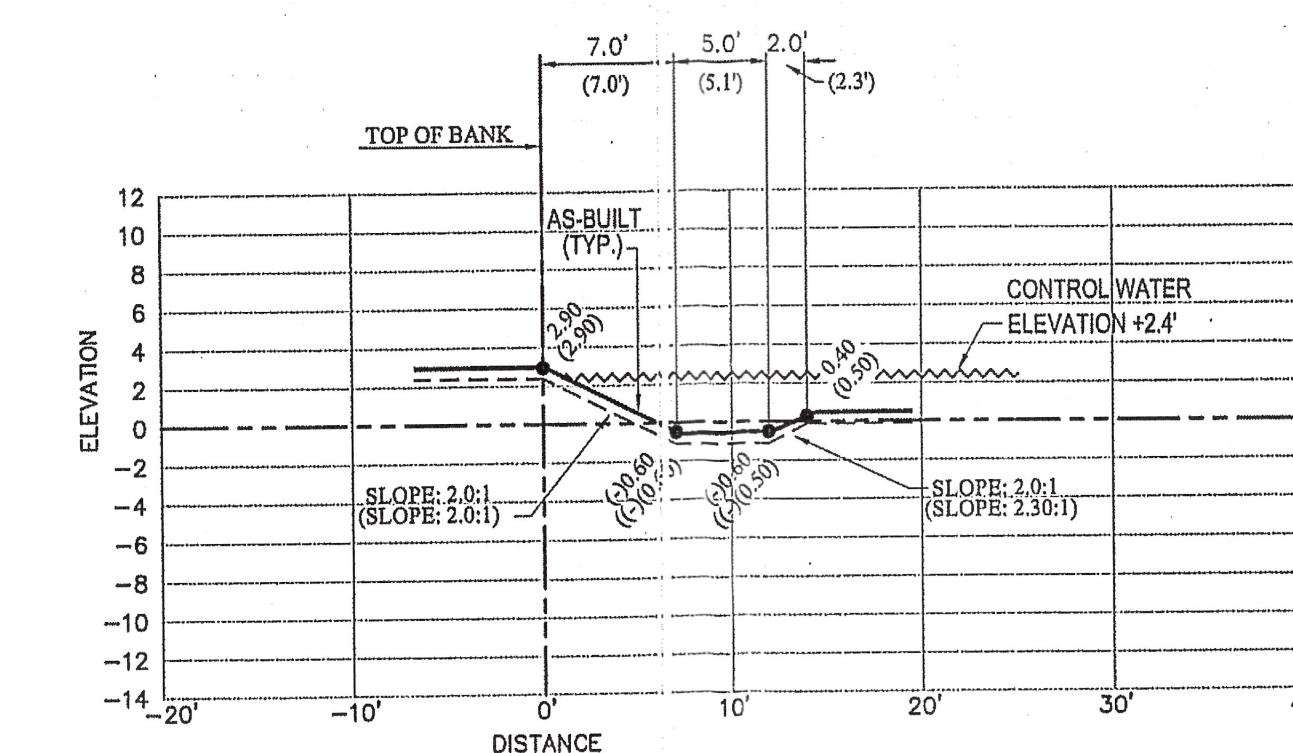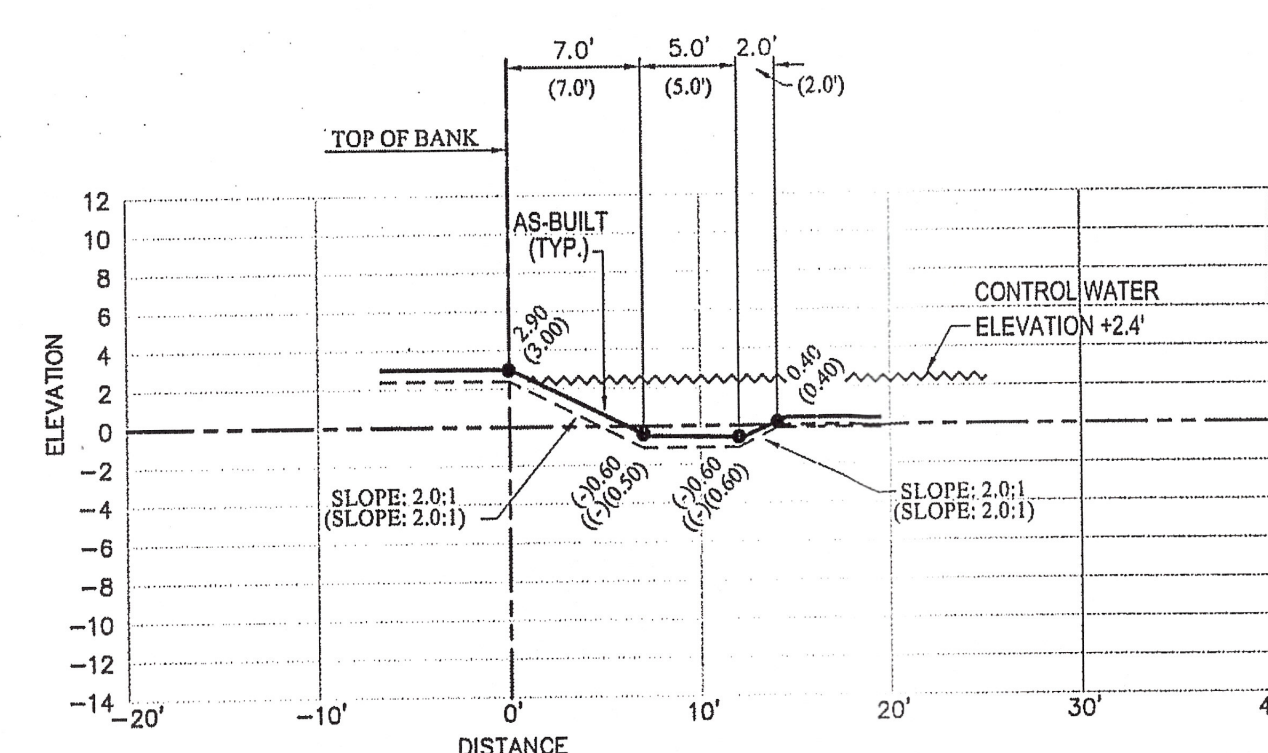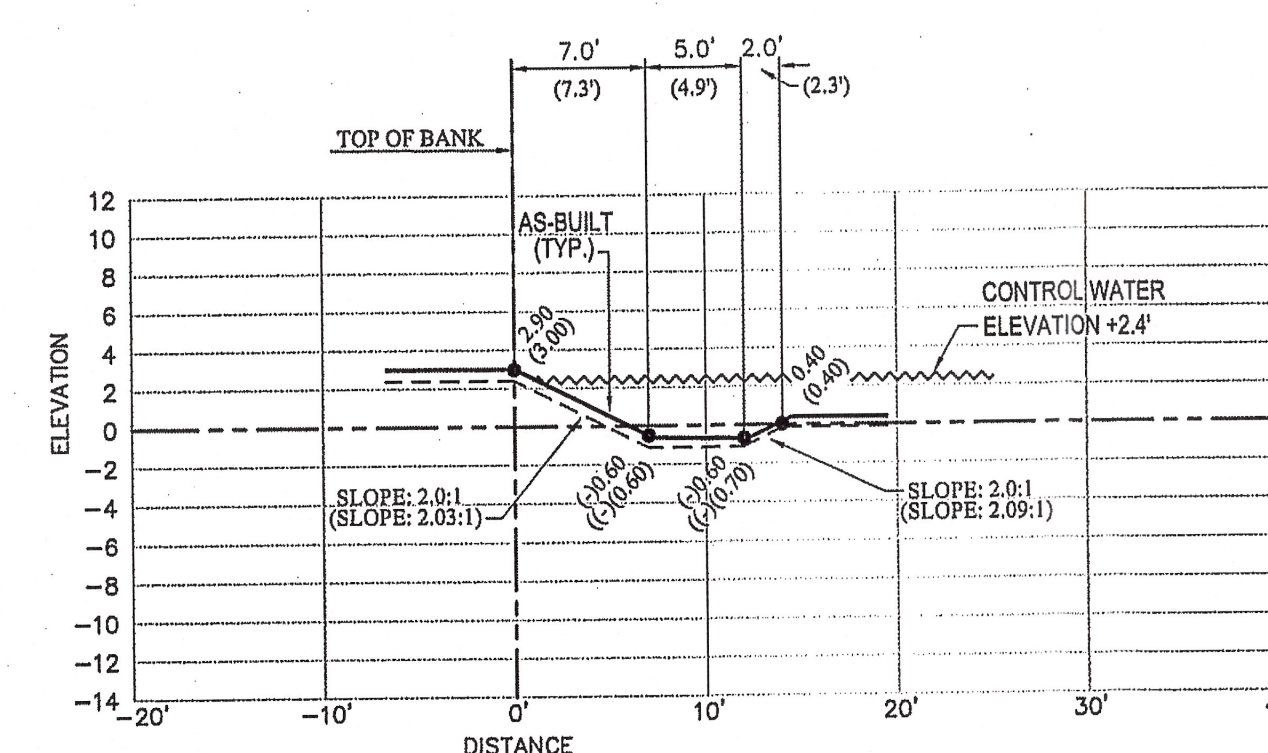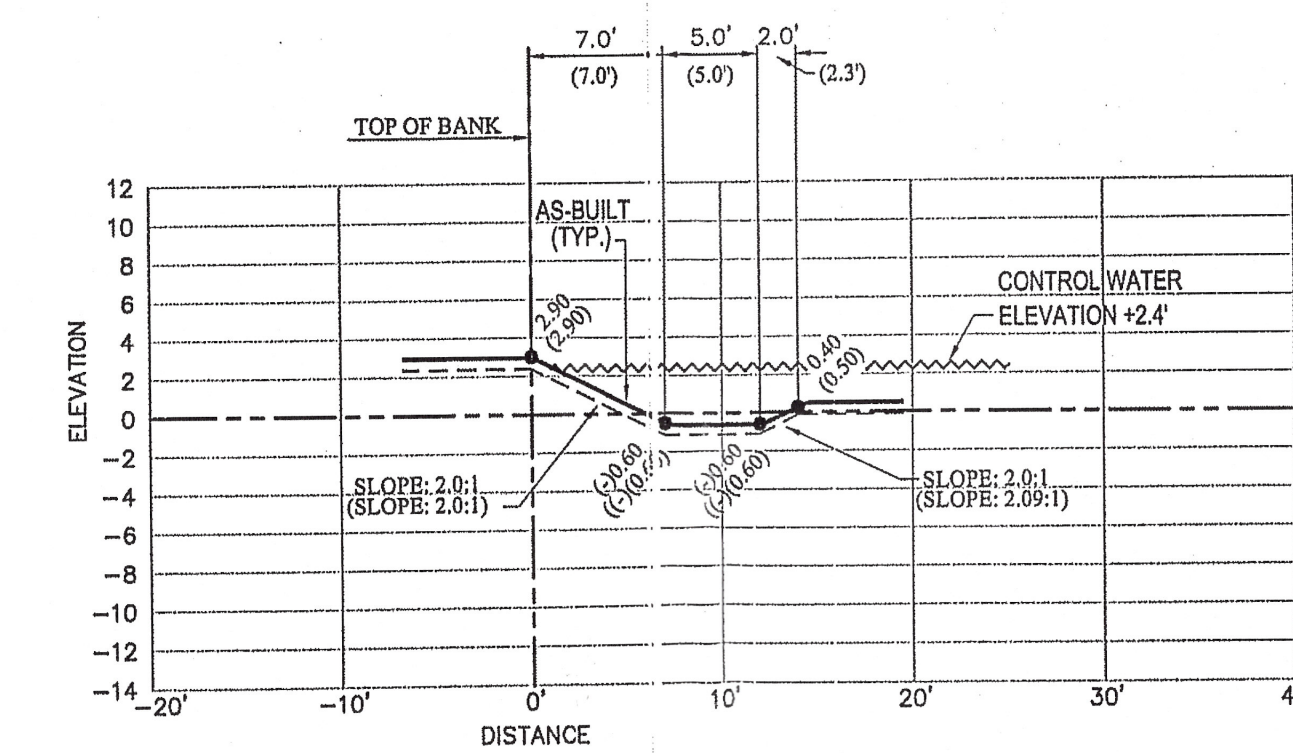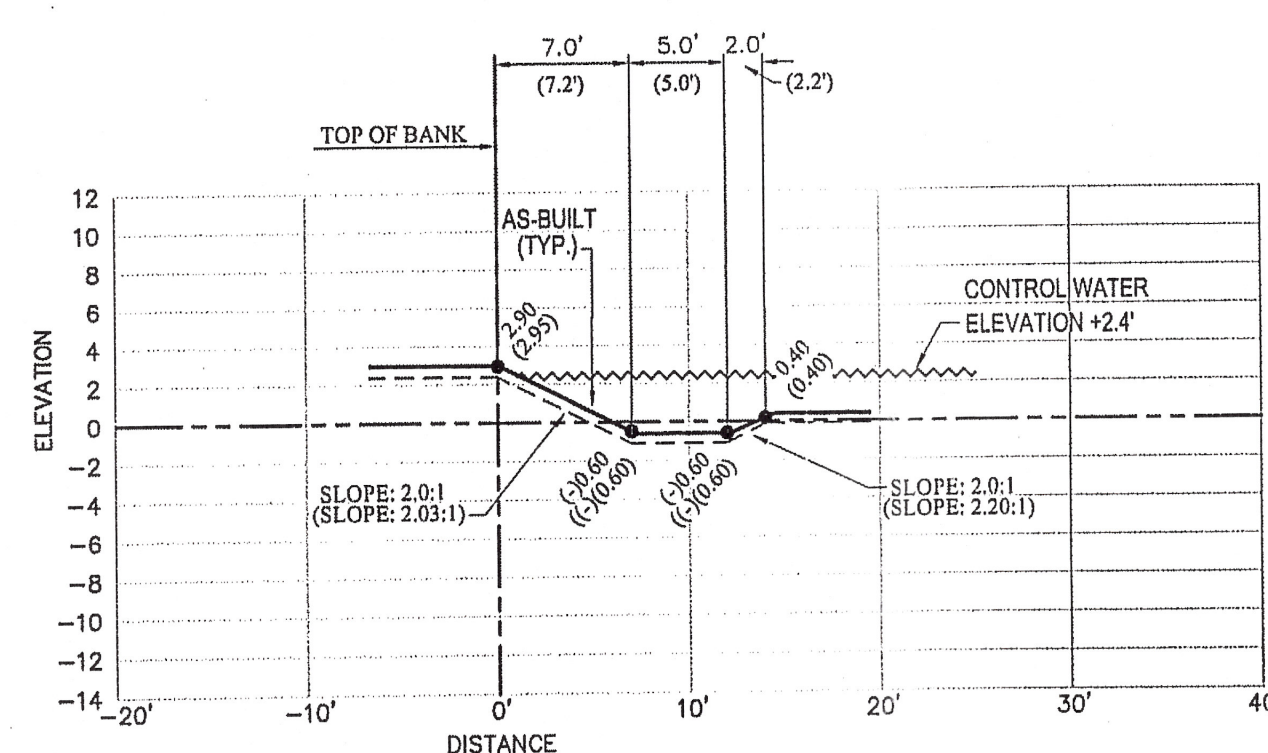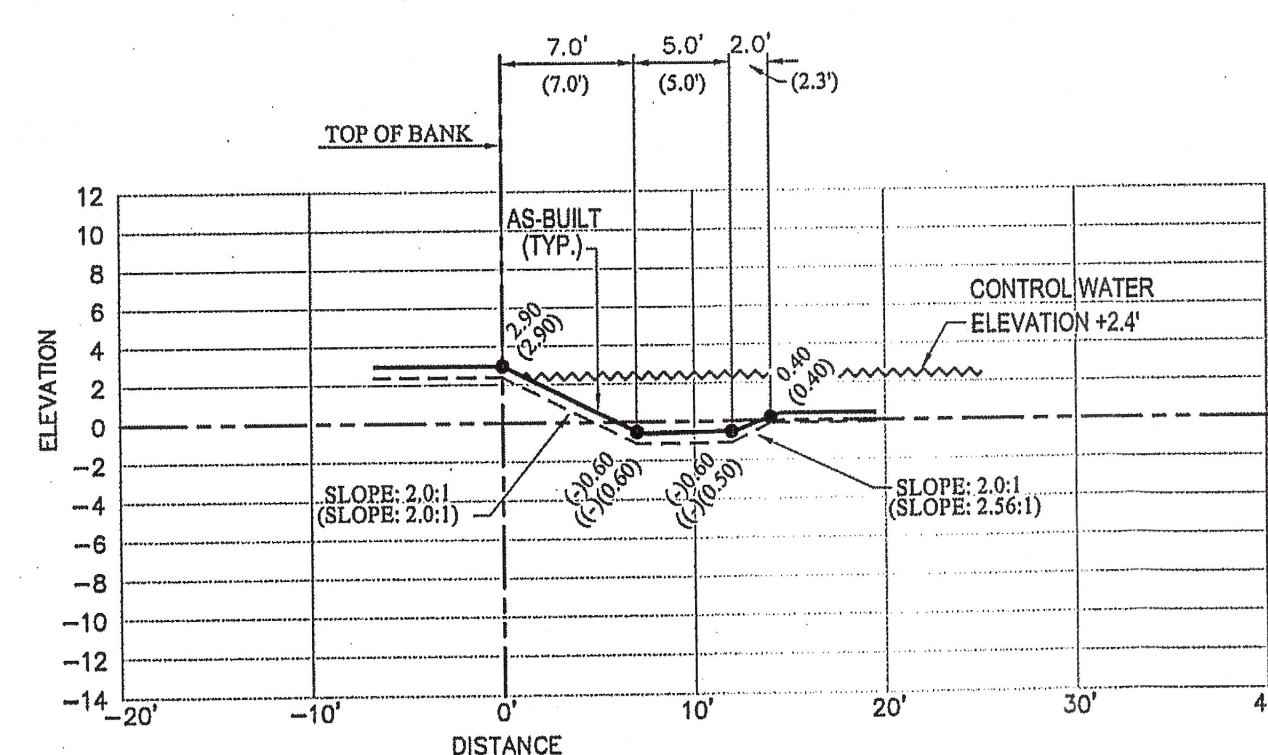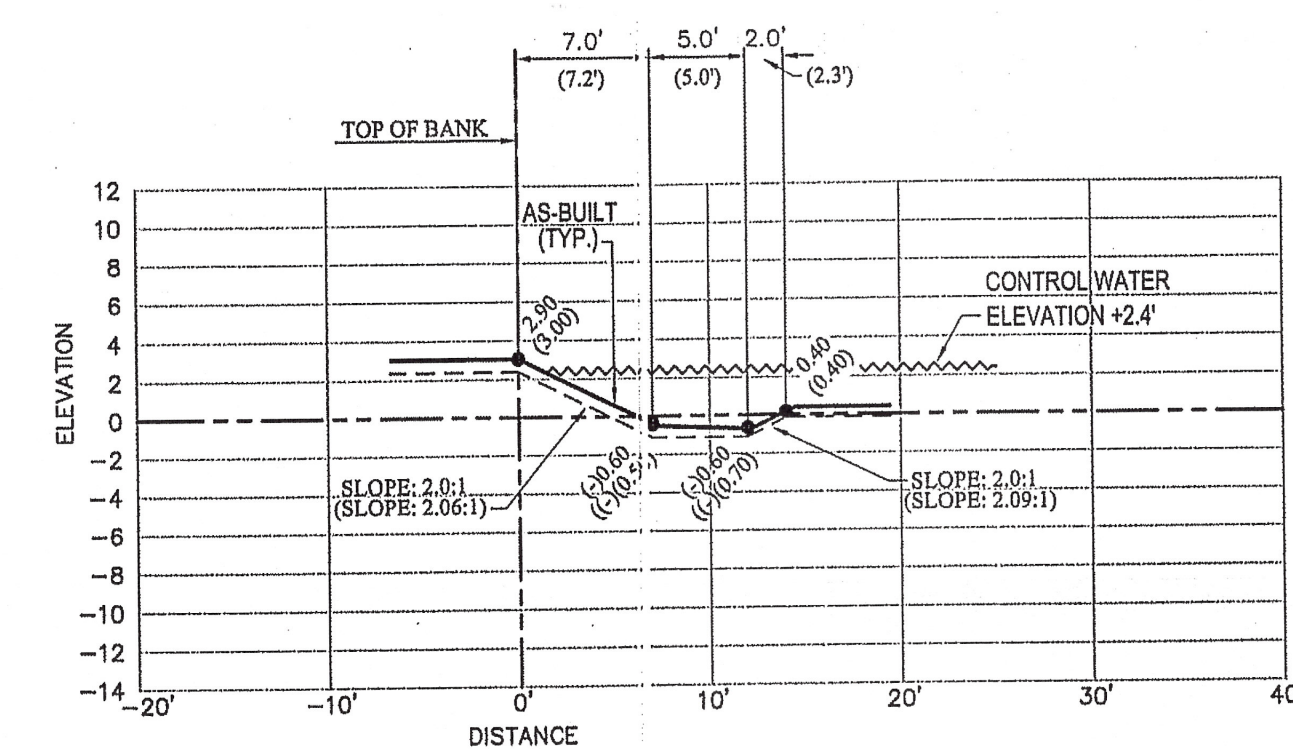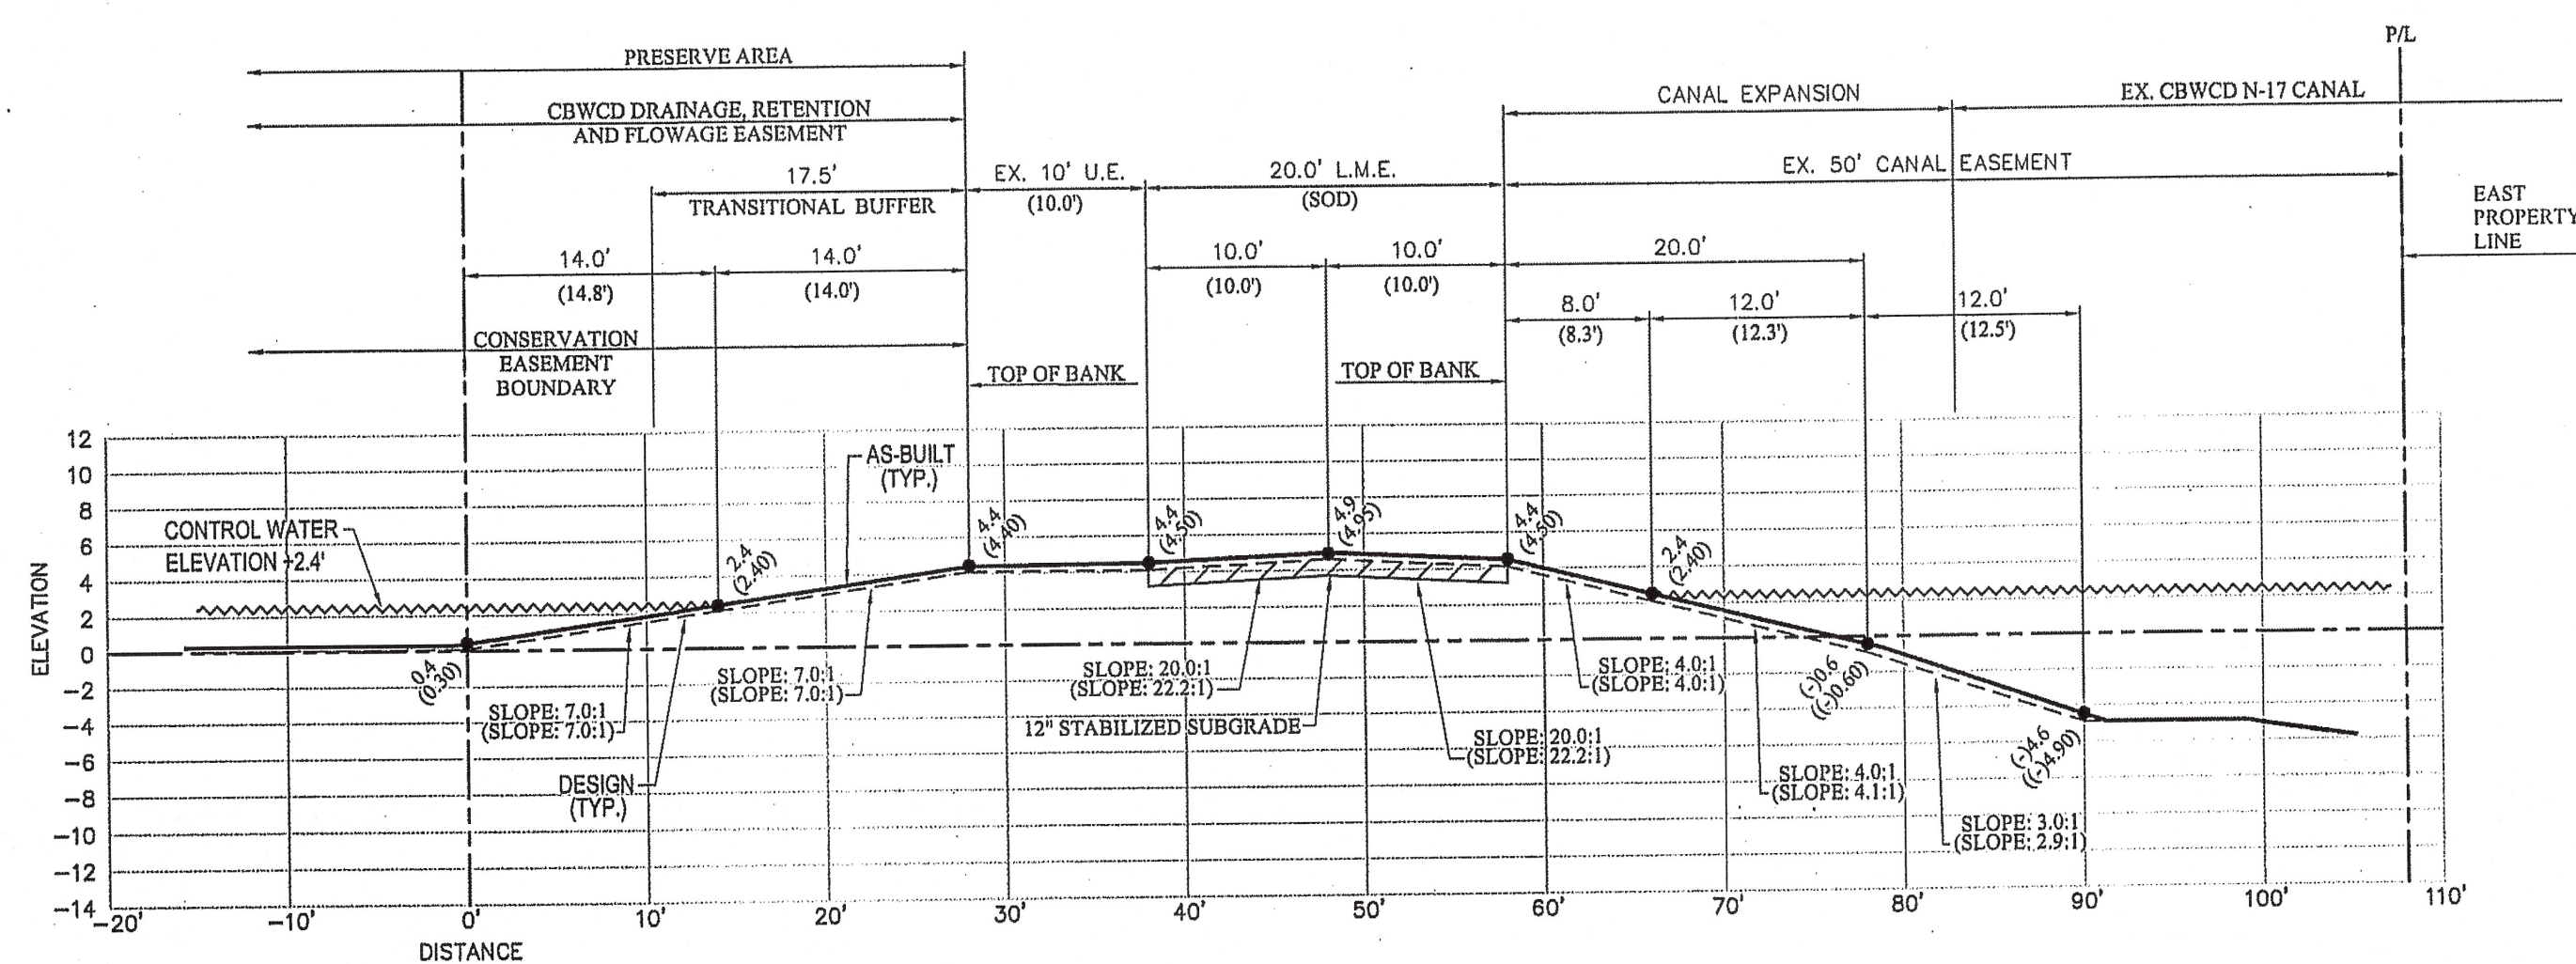


AS-BUILT LEGEND:

	DENOTES AS-BUILT DISTANCE
	DENOTES DESIGN DISTANCE
	DENOTES AS-BUILT ELEVATION
	DENOTES DESIGN ELEVATION
(SLOPE: 20.2:1)	DENOTES AS-BUILT SLOPE
SLOPE: 20.0:1	DENOTES DESIGN SLOPE
L.M.E.	DENOTES LAKE MAINTENANCE EASEMENT
	DENOTES AS-BUILT LINE
	DENOTES DESIGN LINE


NOTE:

NOTE:
THE AS-BUILT LINEWORK SHOWN HEREON IS A GRAPHICAL REPRESENTATION
AND MAY NOT BE DRAWN TO SCALE FOR CLARITY PURPOSES.

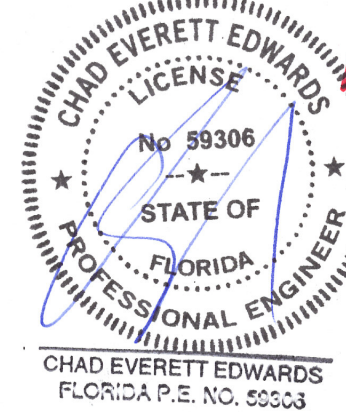

DATE: 1/31/23 BY: 1
JOSEPH L. MARTIN
PROFESSIONAL SURVEYOR &
MAPPER No 4368
STATE OF FLORIDA

NOT VALID WITHOUT THE SIGNATURE AND THE ORIGINAL RAISED SEAL OF A FLORIDA LICENSED SURVEYOR AND MAPPER.

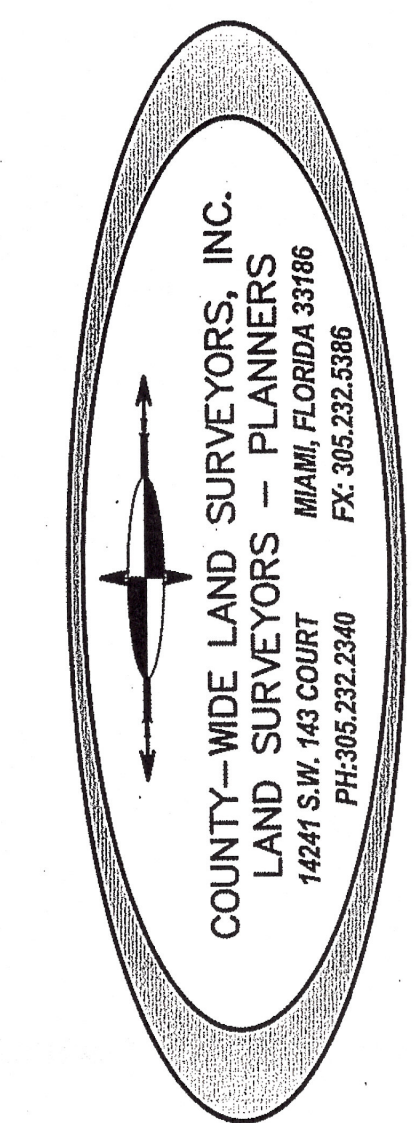

SIERRA RANCH
DAVIE, FL.

PROJ. TYPE	DATE	REVISION COMMENTS	BY	APP
PROJ. LOC:	05-18-21	REVISED PER ENGINEER'S COMMENTS	L.A.	J.M.
SECTION:	11-8-21	REVISED TO ADD SECTIONS FROM 16 TO 36	L.A.	J.M.
	12-8-21	REVISED TO ADD SECTIONS FROM 37 TO 125	L.A.	G.B.
	12-10-21	REVISED PER ENGINEER'S COMMENTS	L.A.	G.B.

SCALE:	H:1"=10' / V:1"=10'
SURVEYOR:	COUNTY-WID
DRAWN BY:	LESLY
CHECKED BY:	G.B.
AS-BUILT:	PRESERVE ARE
DATE:	04/14/202
DRE PROJECT No:	2019-04
SHEET No:	