
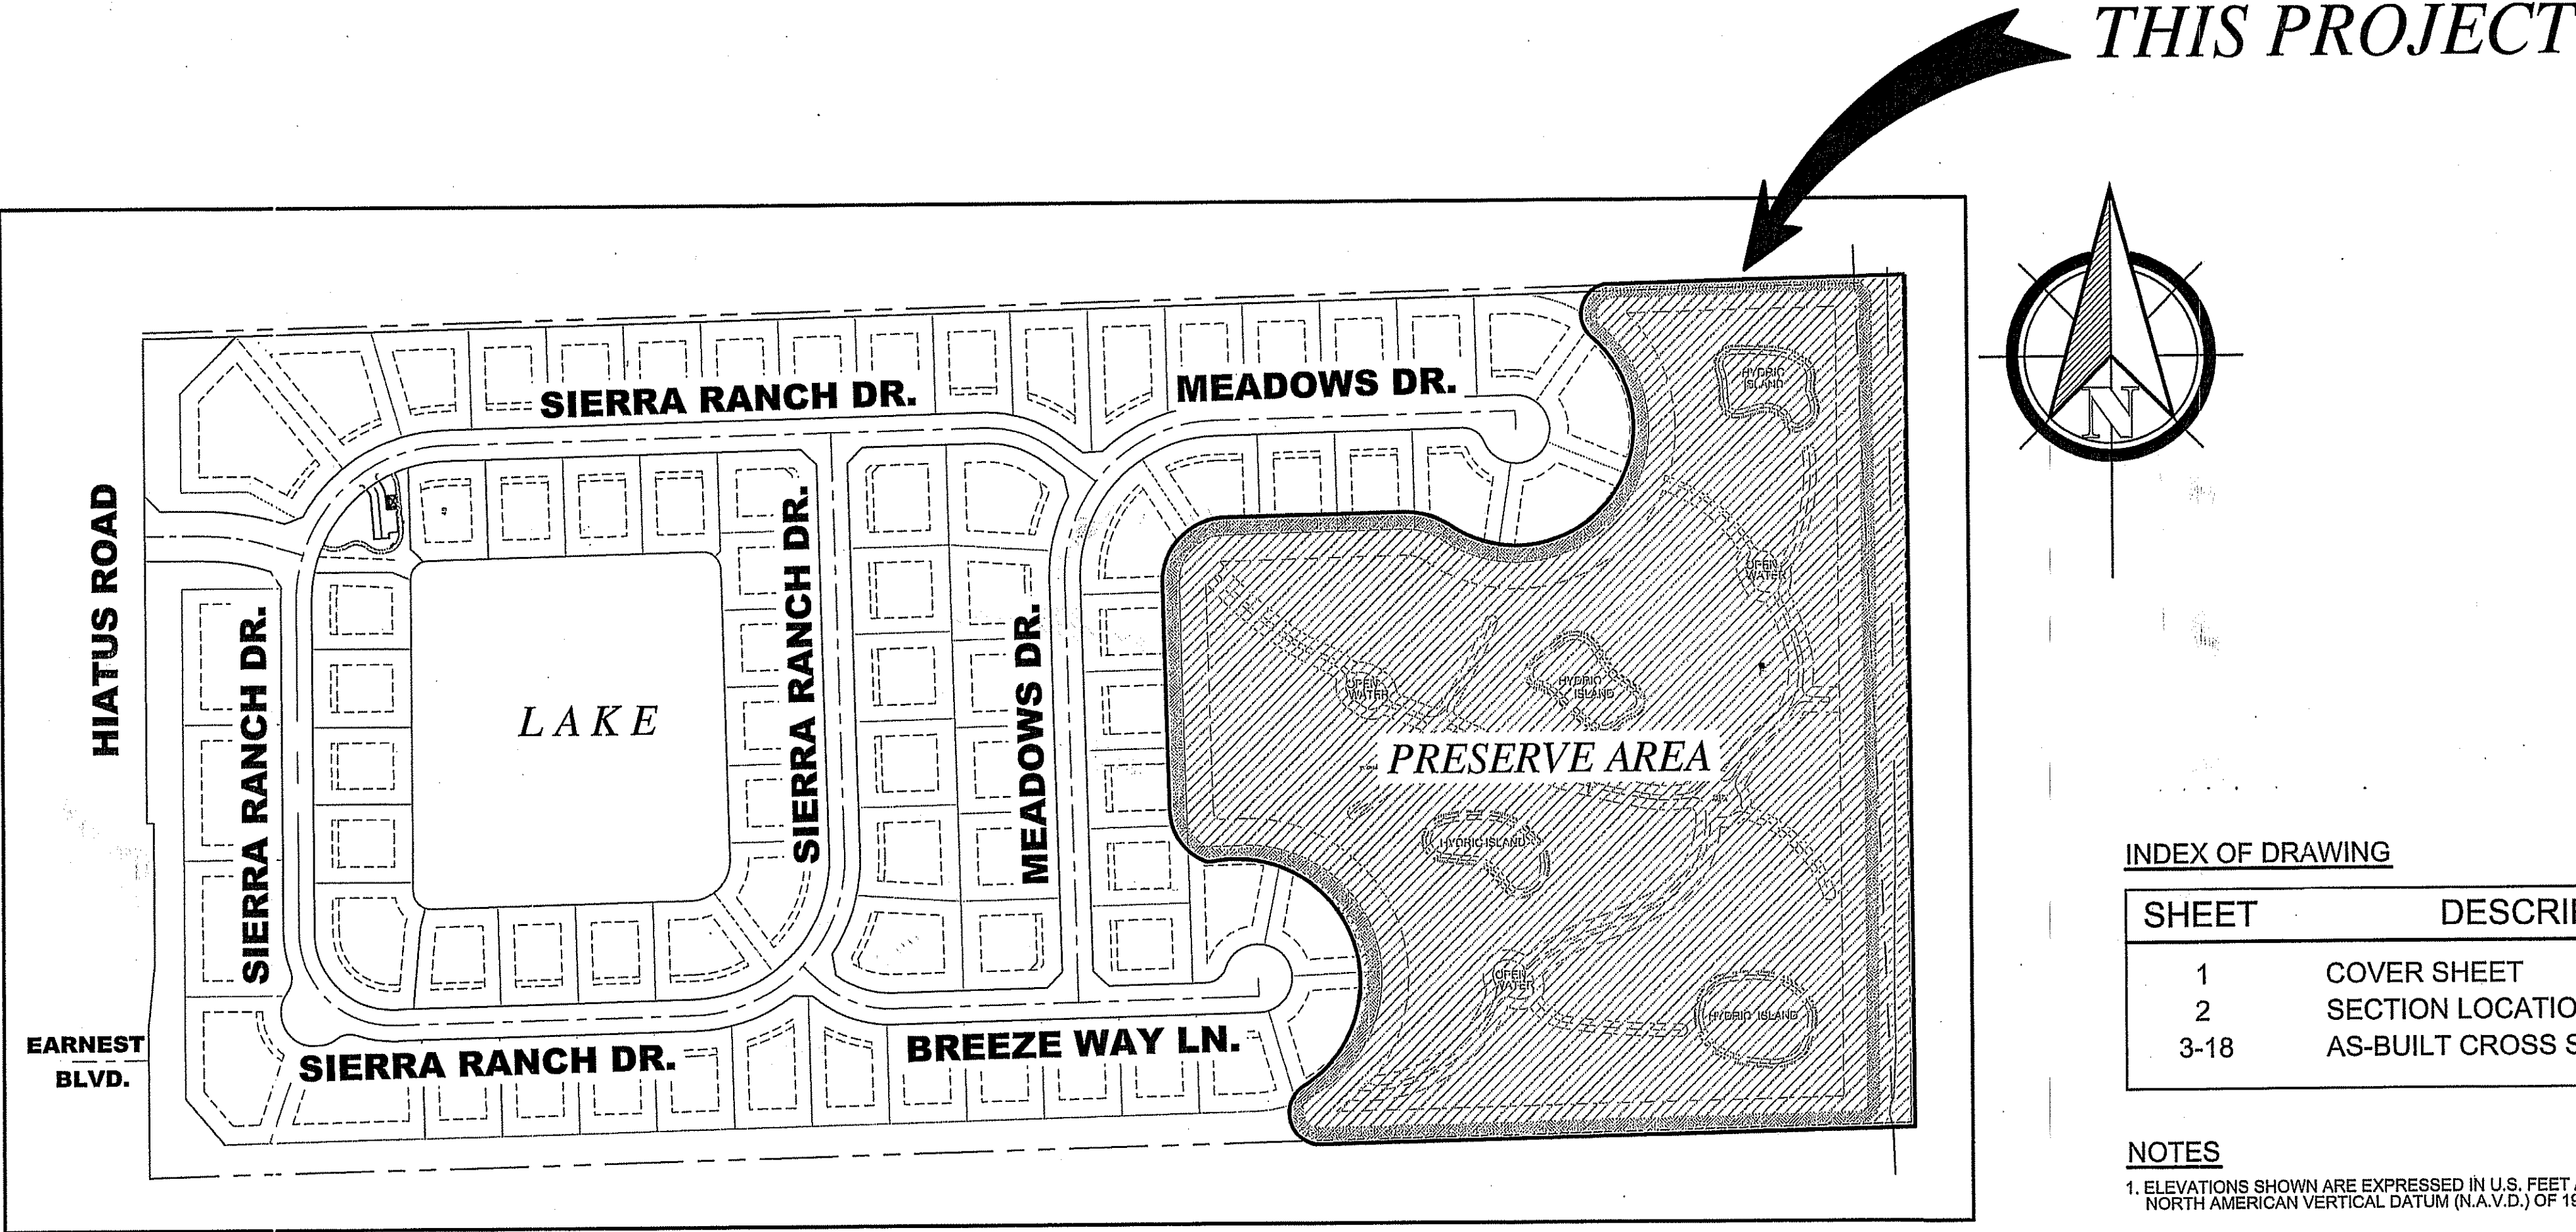


SIERRA RANCH
PRESERVE AREA AS-BUILT
TOWN OF DAVIE, FL.

SECTION 18, TWP. 50S, RGE. 41E

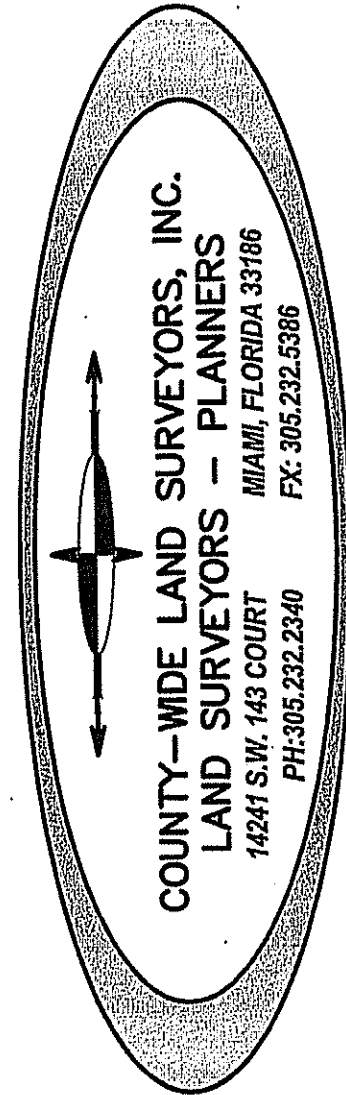

LOCATION MAP
SCALE 1"=200'

INDEX OF DRAWING

SHEET	DESCRIPTION
1	COVER SHEET
2	SECTION LOCATION PLAN
3-18	AS-BUILT CROSS SECTIONS

NOTES

- ELEVATIONS SHOWN ARE EXPRESSED IN U.S. FEET AND REFER TO NORTH AMERICAN VERTICAL DATUM (N.A.V.D.) OF 1988
- BROWARD COUNTY BENCH MARK #2352; ELEVATION: 7.132 FEET. DESCRIPTION: BRASS DISC, IN CONCRETE, NORTHEAST CORNER OF SECTION 13-50-40, 175 ± OR- SOUTH OF CENTERLINE OF SOUTHWEST 13 PLACE, 7.5 ± WEST OF WEST EDGE OF PAVEMENT OF HIATUS ROAD. B.M. FOUND 8-9-2000. NOTE: MARK FOUND AT W.E.O.P., ABOUT 1' BELOW GROUND LEVEL.
- THIS DRAWING REFLECTS OUR FINDINGS AS PER A FIELD SURVEY PERFORMED ON: 12/01/2021
- COUNTY-WIDE LAND SURVEYORS, INC. CARRIES PROFESSIONAL LIABILITY INSURANCE FOR SURVEYING AND MAPPING SERVICES.
- AS-BUILT PLAN NOT VALID WITHOUT THE SIGNATURE AND THE ORIGINAL RAISED SEAL OF A FLORIDA LICENSED SURVEYOR AND MAPPER.

SURVEYOR'S CERTIFICATION:

I HEREBY CERTIFY: THAT THE ATTACHED "SKETCH OF AS-BUILT SURVEY" WAS PREPARED UNDER MY SUPERVISION AND THAT THIS SURVEY MEETS THE STANDARDS OF PRACTICE SET FORTH BY THE FLORIDA BOARD OF PROFESSIONAL SURVEYORS AND MAPPERS IN CHAPTER 51-17.50 THROUGH 51-17.52 OF THE FLORIDA ADMINISTRATIVE CODE, PURSUANT TO SECTION 472.027, FLORIDA STATUTES.

COUNTY-WIDE LAND SURVEYORS, INC. LB 4680


CERTIFICATE:
I HEREBY CERTIFY THAT THESE RECORD DRAWINGS FOR THE FACILITY HAVE BEEN REVIEWED BY ME OR BY INDIVIDUAL(S) UNDER MY DIRECT SUPERVISION FOR COMPLETENESS AND ADEQUACY, AND ARE TRUE AND CORRECT TO THE BEST OF MY KNOWLEDGE AND BELIEF. THE FIELD WORK FOR THE AS-BUILT DRAWINGS HAS BEEN DONE BY: Joseph L. Martin, P.S.M. #4368
10/20/2022

THIS DOCUMENT CONSISTS OF 18 SHEETS AND EACH SHEET SHALL NOT BE CONSIDERED VALID WITHOUT SHEET 1.

THIS ITEM HAS BEEN ELECTRONICALLY SIGNED AND SEALED BY JOSEPH L. MARTIN, PSM # 4368. PRINTED COPIES OF THIS DOCUMENT ARE NOT CONSIDERED SIGNED AND SEALED WITHOUT THE SIGNATURE AND EMBOSSED SEAL OF A FLORIDA LICENSED SURVEYOR. THE SIGNATURE MUST BE VERIFIED ON ANY ELECTRONIC COPIES.

Joseph
L Martin

Digitally signed by Joseph L. Martin
DN: C=US, O=COUNTY-WIDE LAND SURVEYORS INC.,
OU=A01427E00000168F1AD4C37000
00895, CN=Joseph L. Martin
Date: 2021-12-10 10:01:41

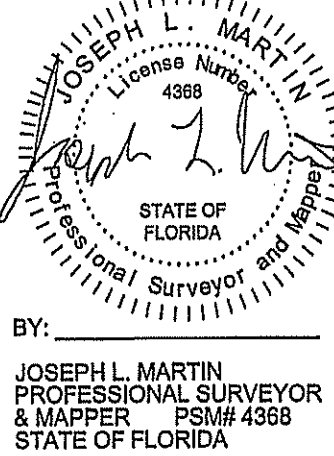

DATE: 12/10/2021

BY:

Chad E. Edwards, State of Florida,
Professional Engineer, License No. 59306

This item has been digitally signed and sealed by
Chad E. Edwards, on the date indicated here.
Printed copies of this document are not
considered signed and sealed and the signature
must be verified on any electronic copies.

CENTRAL BROWARD WATER CONTROL DISTRICT CERTIFICATION:

I HEREBY CERTIFY THAT THE SURFACE WATER MANAGEMENT FACILITIES FOR ABOVE REFERENCED PROJECT HAVE BEEN CONSTRUCTED IN SUBSTANTIAL ACCORDANCE WITH THE DESIGN APPROVED BY THE CENTRAL BROWARD WATER CONTROL DISTRICT, AND HEREBY AFFIX MY SEAL THIS
DAY OF _____, 20__

Chad Everett
Edwards

Digitally signed by
Chad Everett Edwards
Date: 2022.10.27
09:25:08 -04'00'

BY:




CHAD E. EDWARDS, P.E.
FLORIDA P.E. No. 59306

(SEAL)

SIERRA RANCH
DAVIE, FL.

PROJ. TYPE	COVER SHEET	DATE	REVISION COMMENTS	BY	APP
PROJ. LOC:	1950 SOUTH HIATUS ROAD, DAVIE, FL. 33324	05-18-21	REVISED PER ENGINEER'S COMMENTS	L.A.	J.M.
SECTION:	SEC. 18, TWP. 50S, RGE. 41E	11-8-21	REVISED TO ADD SECTIONS FROM 16 TO 36	L.A.	J.M.
		12-8-21	REVISED TO ADD SECTIONS FROM 37 TO 125	L.A.	G.B.
		12-10-21	REVISED PER ENGINEER'S COMMENTS	L.A.	G.B.

SCALE:	1" = 200'
SURVEYOR:	COUNTY-WIDE
DRAWN BY:	LESLEY
CHECKED BY:	G.B.
AS-BUILT:	PRESERVE AREA
DATE:	04/14/2021
DRE PROJECT NO:	2019-043
SHEET NO:	1 of 18

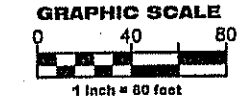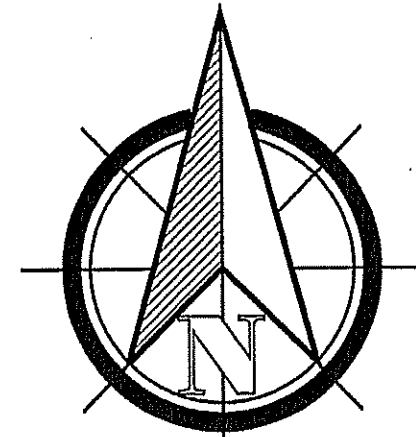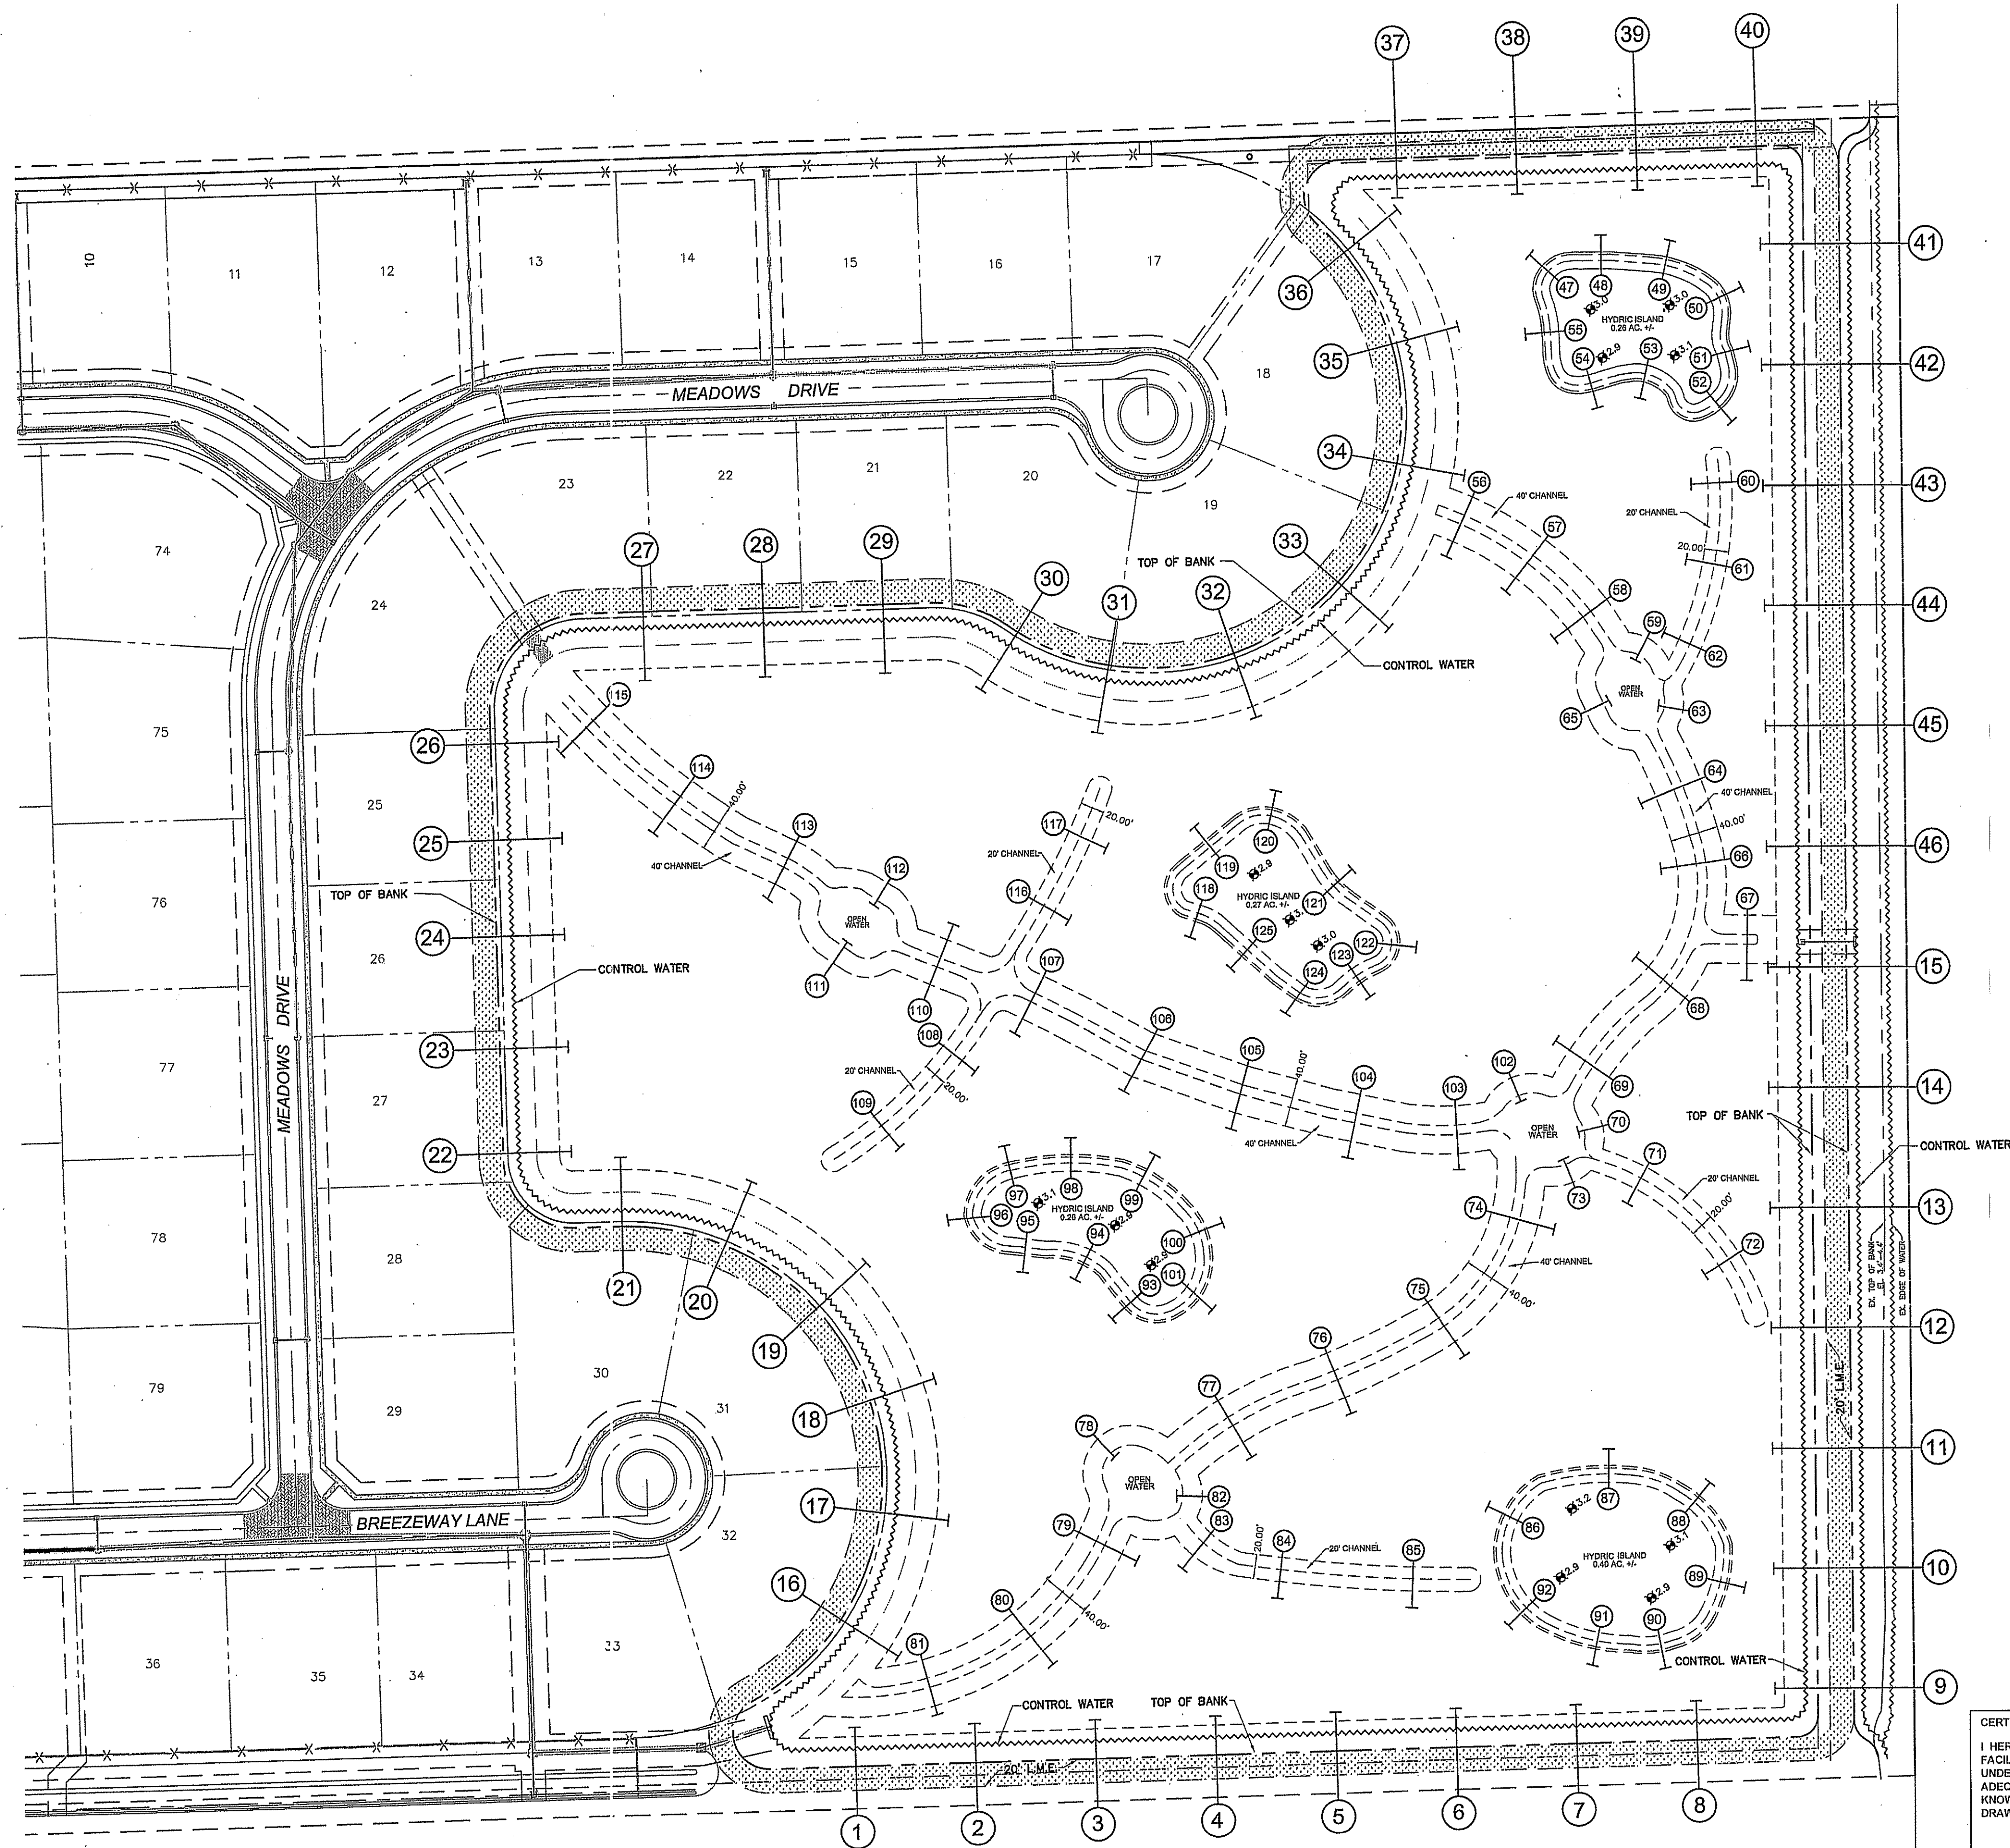

CERTIFICATE:
I HEREBY CERTIFY THAT THESE RECORD DRAWINGS FOR THE FACILITY HAVE BEEN REVIEWED BY ME OR BY INDIVIDUAL(S) UNDER MY DIRECT SUPERVISION FOR COMPLETENESS AND ADEQUACY, AND ARE TRUE AND CORRECT TO THE BEST OF MY KNOWLEDGE AND BELIEF. THE FIELD WORK FOR THE AS-BUILT DRAWINGS HAS BEEN DONE BY: Joseph L. Martin, P.S.M. #4368
10/20/2022


AS-BUILT LEGEND
DENOTES:
AS-BUILT SECTION LOCATION ①

Chad E. Edwards, State of Florida,
Professional Engineer, License No. 59306
This item has been digitally signed and sealed by
Chad E. Edwards on the date indicated here.
Printed copies of this document are not
considered signed and sealed and the signature
must be verified on any electronic copies.

Chad
Everett
Edwards
Digitally signed
by Chad Everett
Edwards
Date: 2022.10.27
09:25:26 -04'00'

THIS DOCUMENT CONSISTS OF 18 SHEETS AND EACH
SHEET SHALL NOT BE CONSIDERED VALID WITHOUT
SHEET 1.


DATE: 12/10/2021 BY:

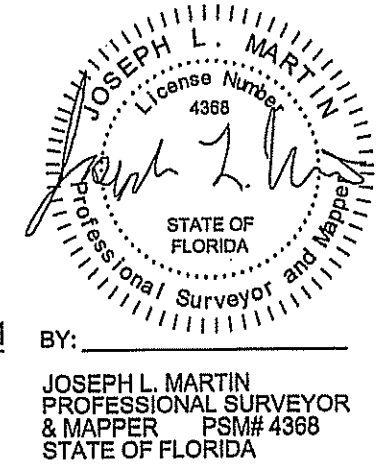


SIERRA RANCH DAVIE, FL.

PROJ. TYPE	REVISION COMMENTS	DATE	BY	APP
SECTION LOCATION PLAN				
PROJ. LOC:	1950 SOUTH HIATUS ROAD, DAVIE, FL. 33324	05-18-21	L.A.	J.M.
SECTION:	SEC. 18, TWP. 50S, RGE. 41E	11-8-21	L.A.	J.M.
		12-8-21	L.A.	G.B.
		12-10-21	L.A.	G.B.


SCALE:	1" = 60'
SURVEYOR:	COUNTY-WIDE
DRAWN BY:	LESLEY
CHECKED BY:	
AS-BUILT:	PRESERVE AREA
DATE:	04/14/2021
DRE PROJECT NO:	2019-043
SHEET NO:	2 of 18

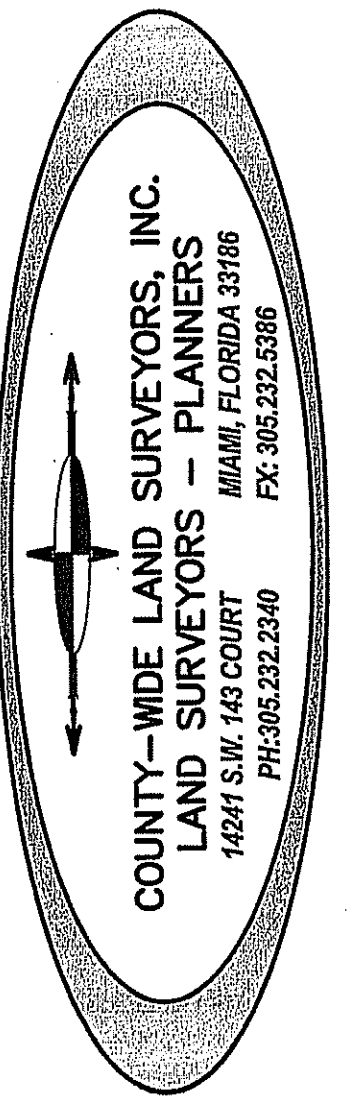


Client Project Description: Sierra Ranch - 1950 SOUTH HIATUS ROAD - LANE 50S & PRESERVE AREA - PRESERVE AREA, 1A

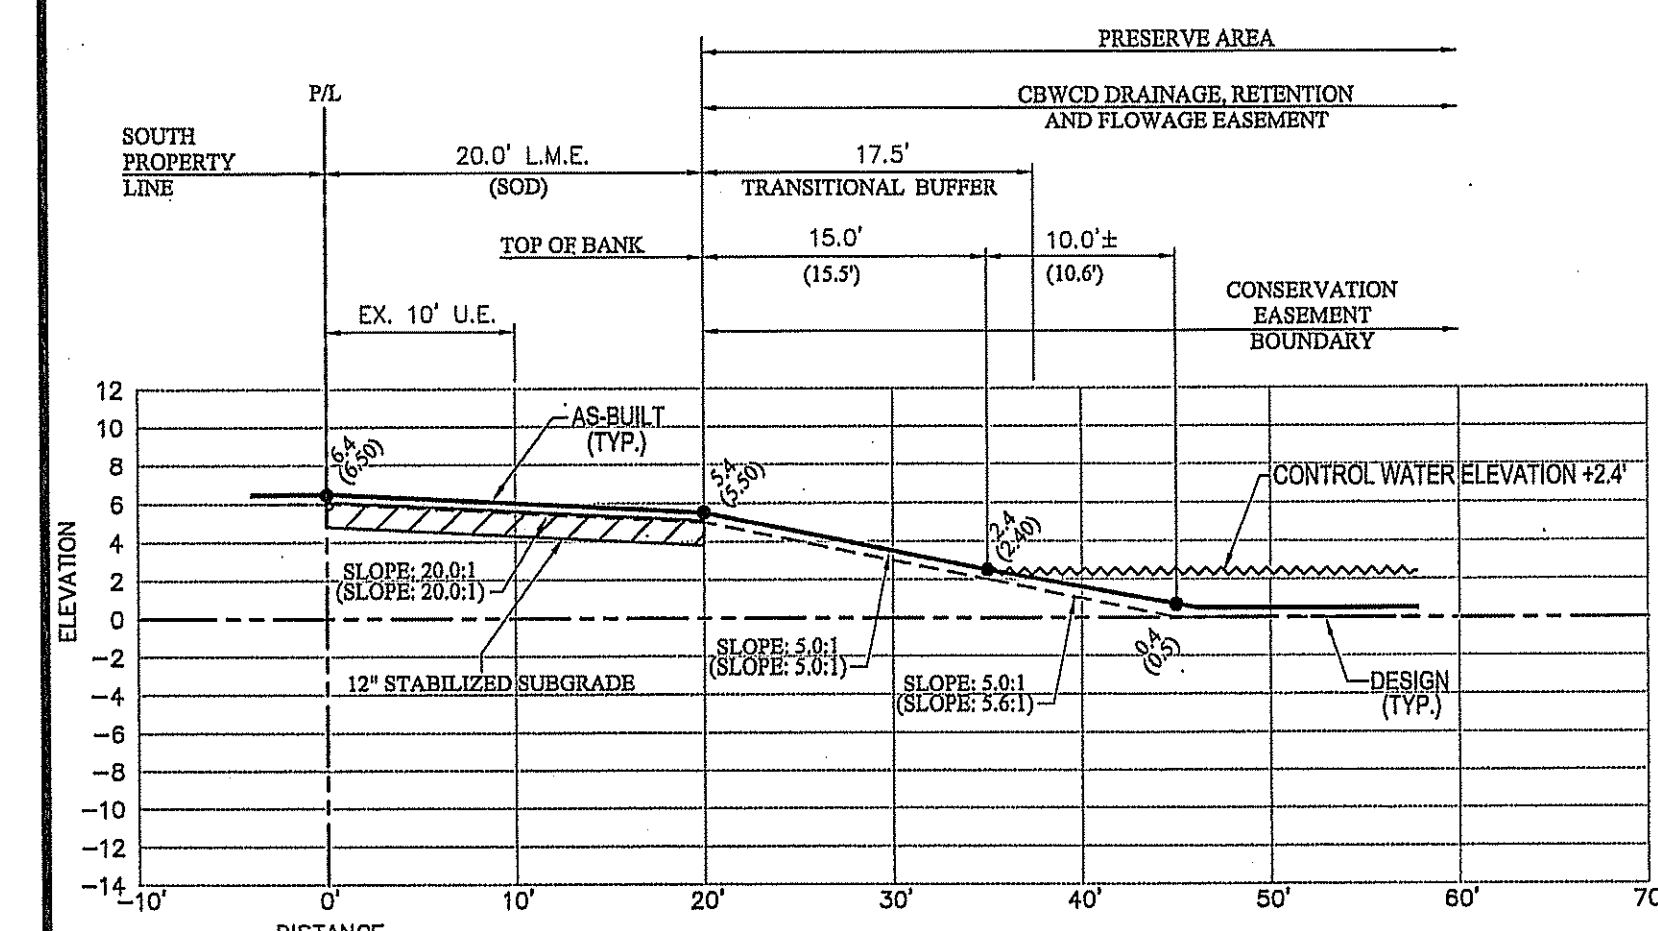


SECTION No. 1
SOUTH PROPERTY LINE

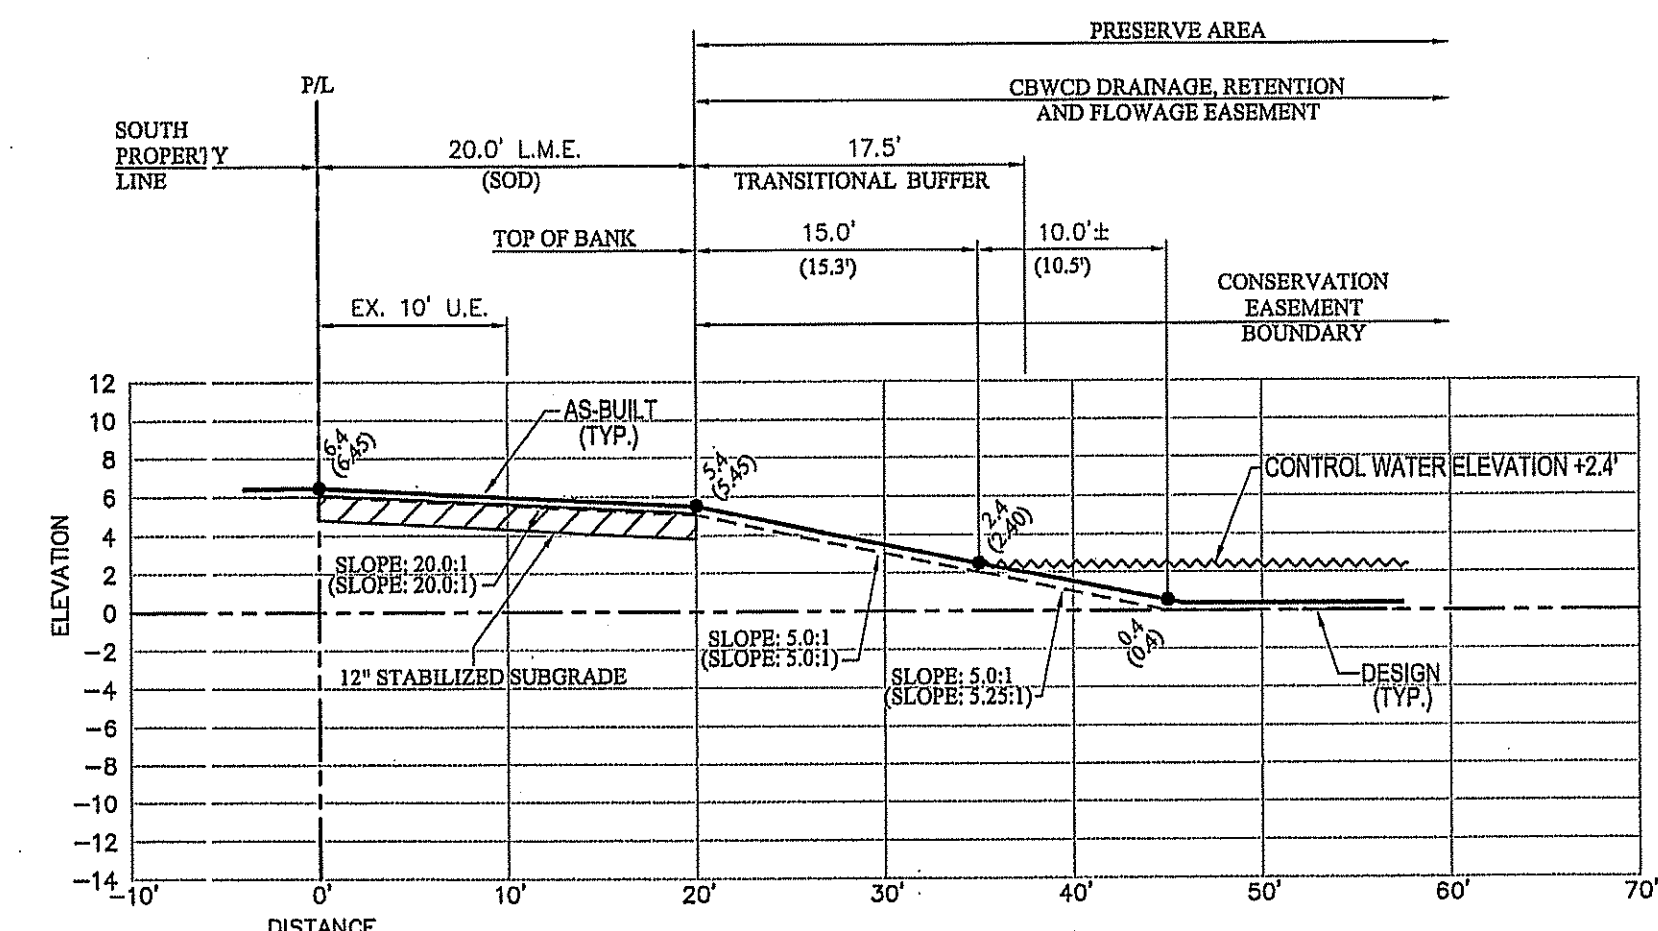


SECTION No. 2
SOUTH PROPERTY LINE

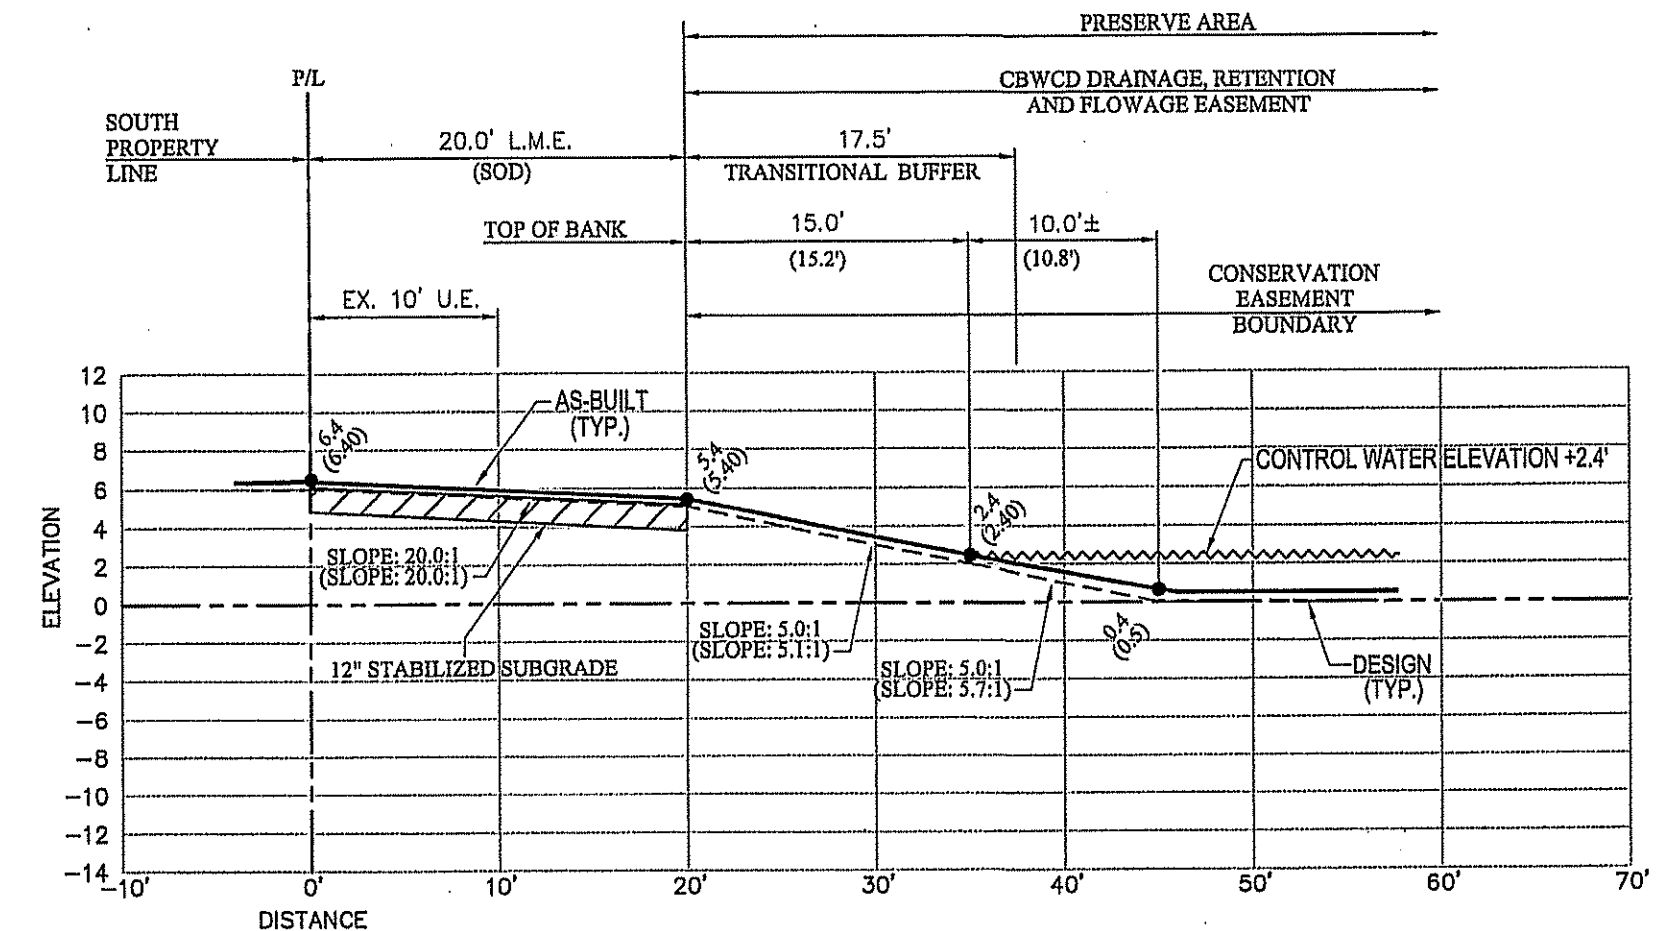


SECTION No. 3
SOUTH PROPERTY LINE

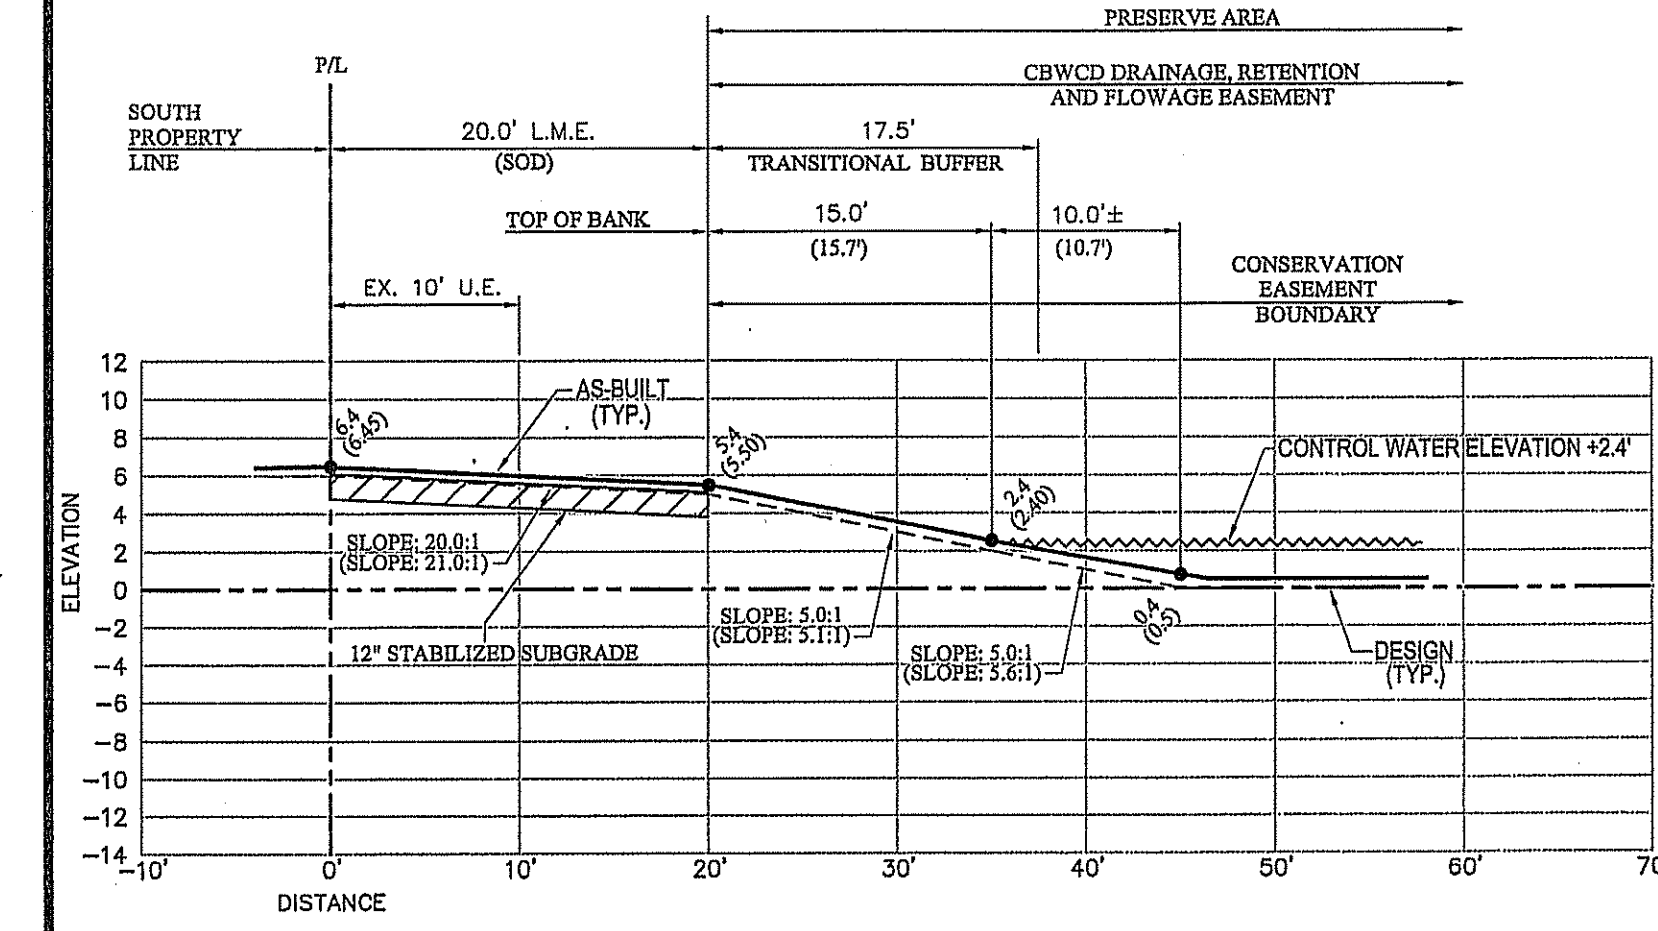


SECTION No. 4
SOUTH PROPERTY LINE

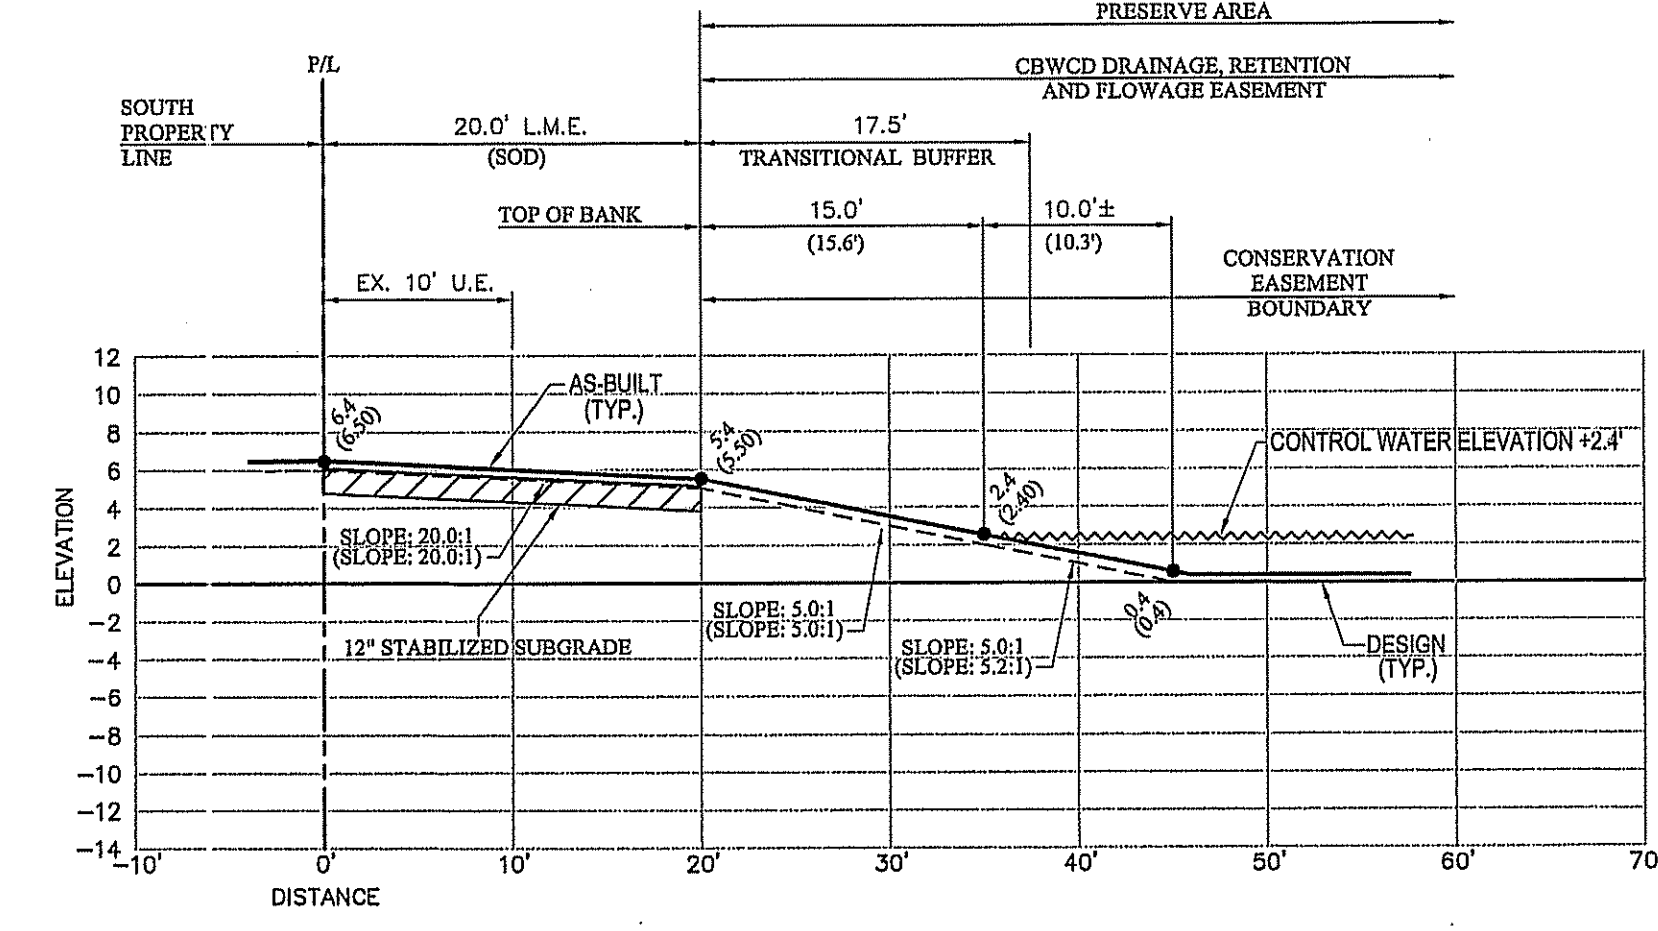


SECTION No. 5
SOUTH PROPERTY LINE

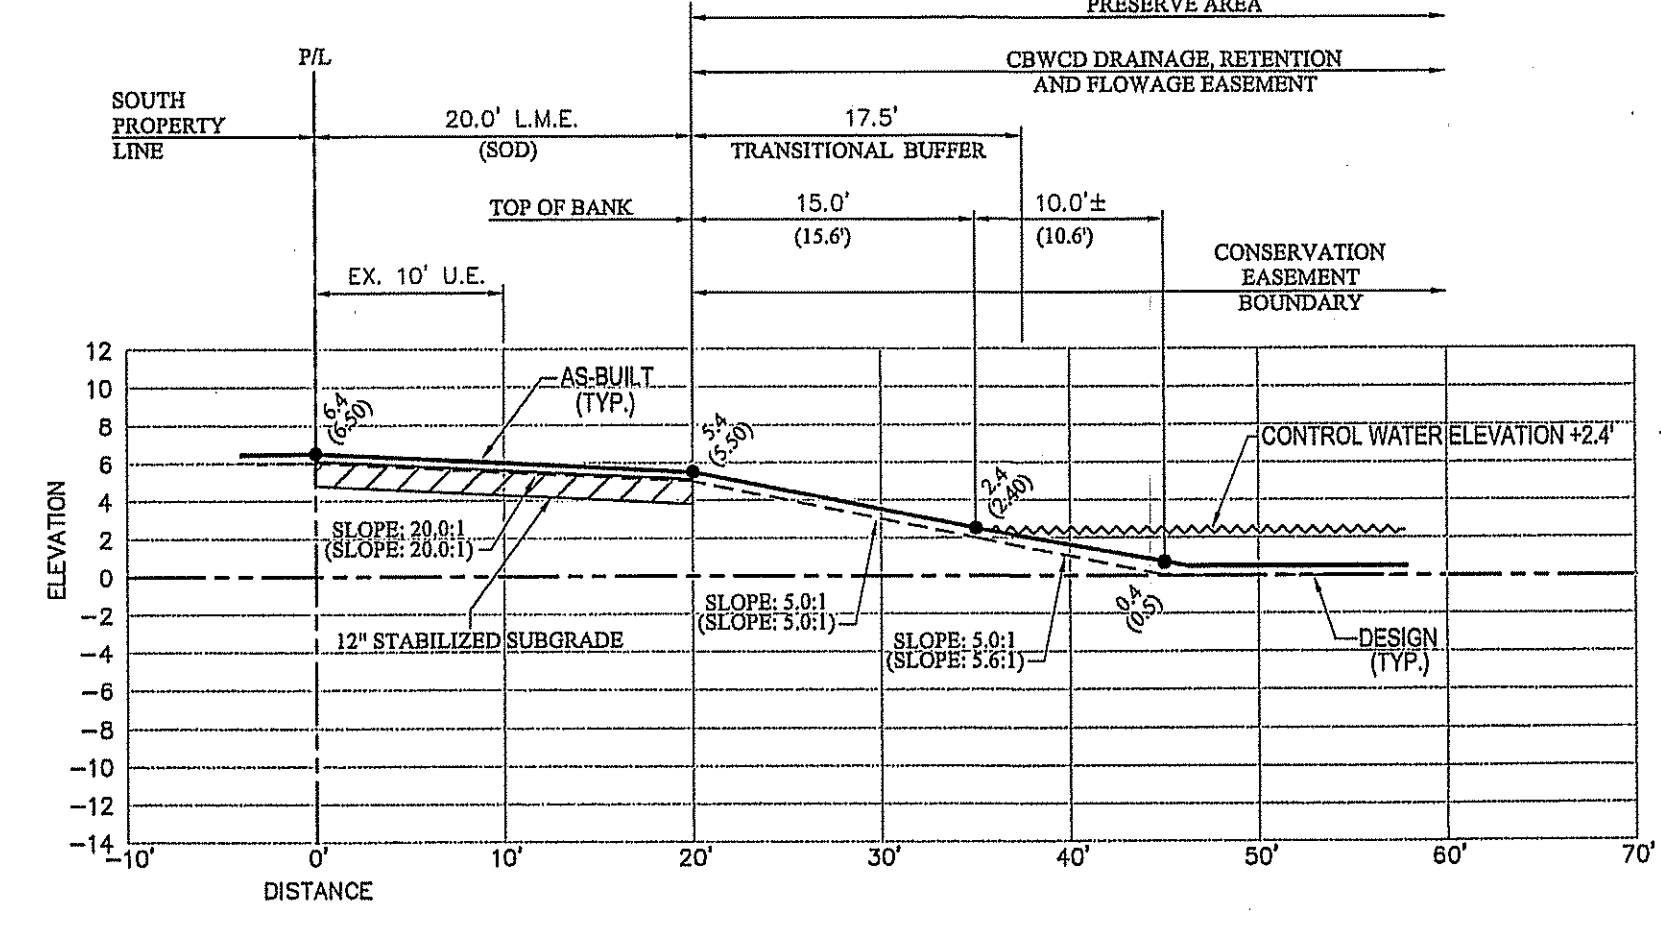


SECTION No. 6
SOUTH PROPERTY LINE

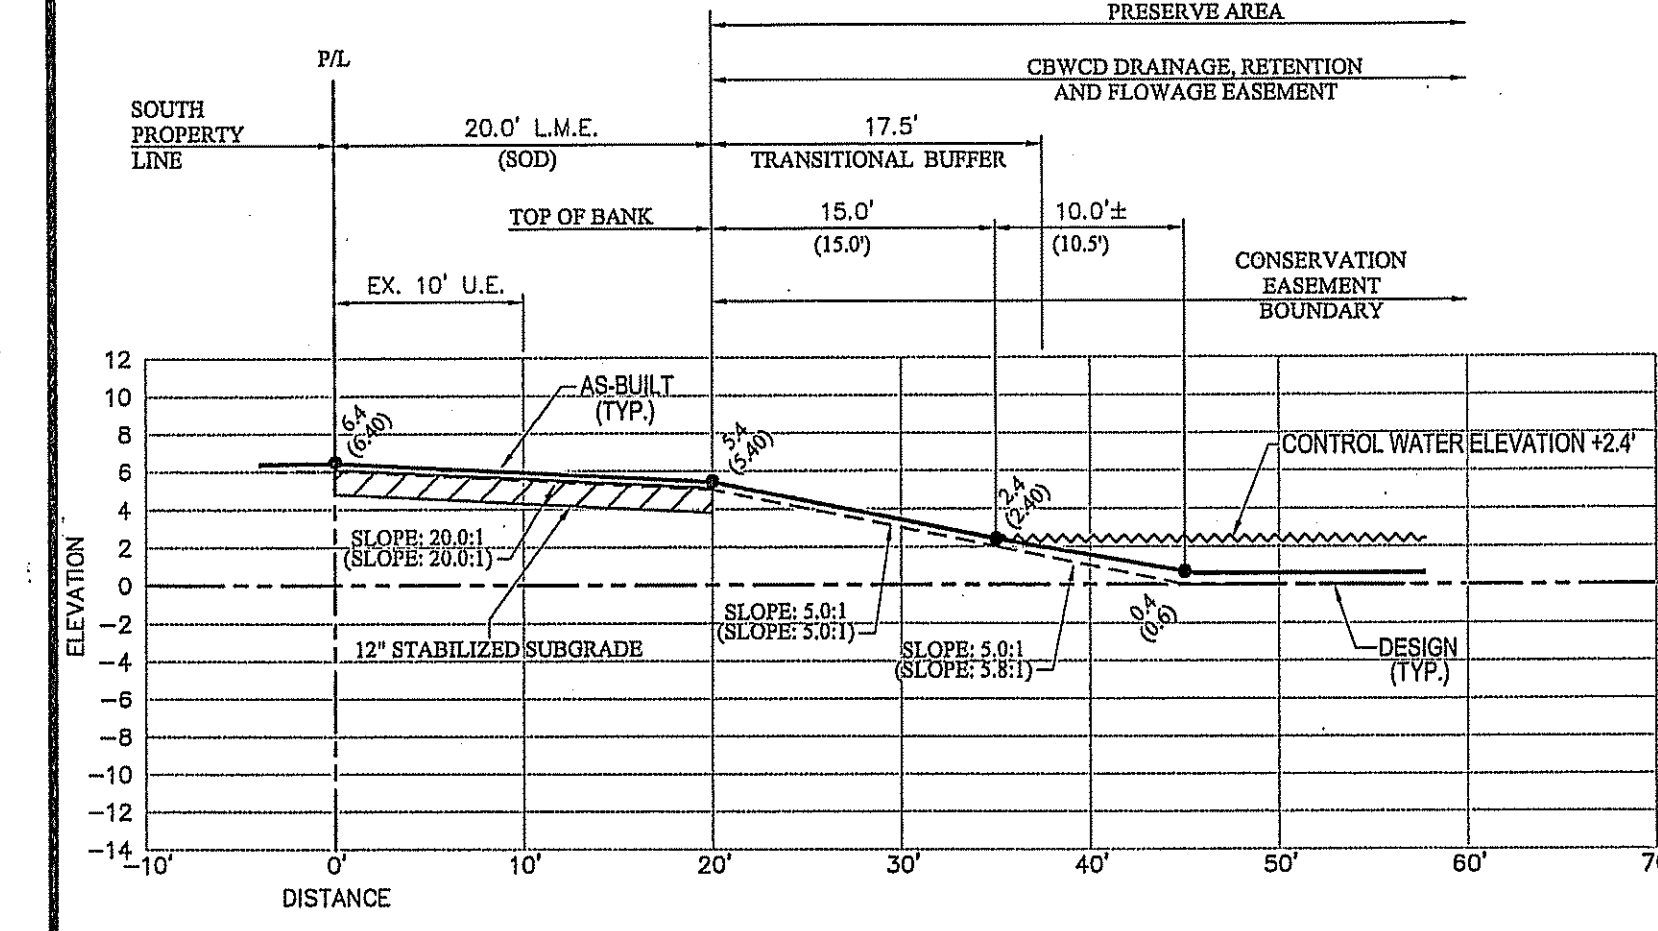

SECTION No. 7
SOUTH PROPERTY LINE

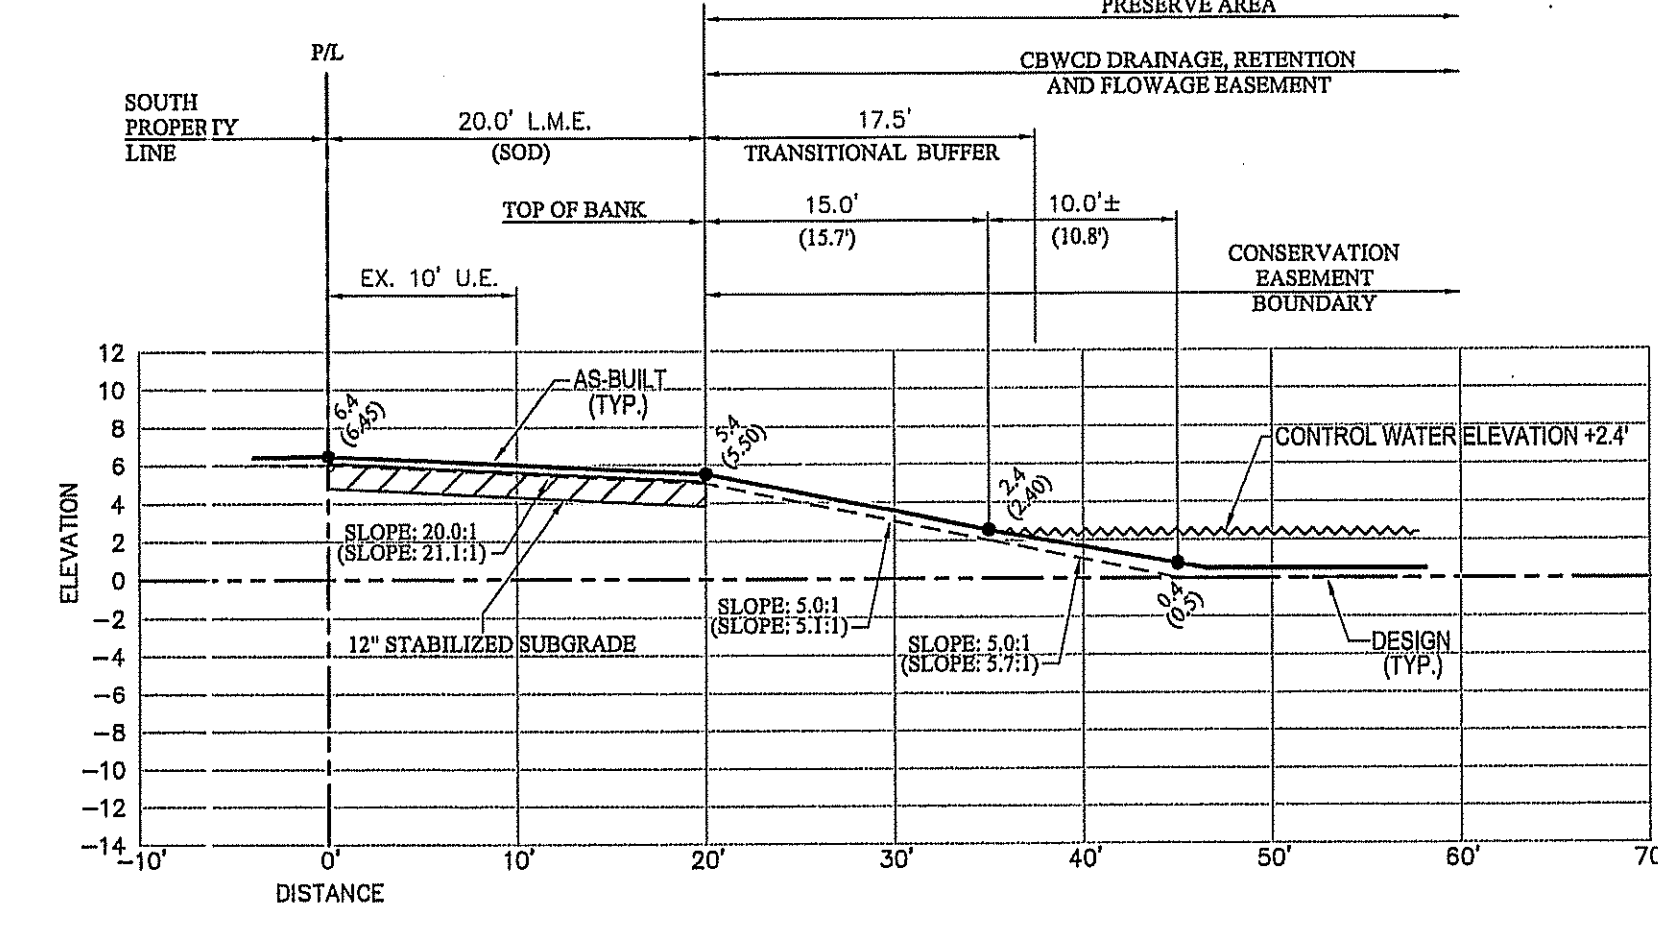

SECTION No. 8
SOUTH PROPERTY LINE

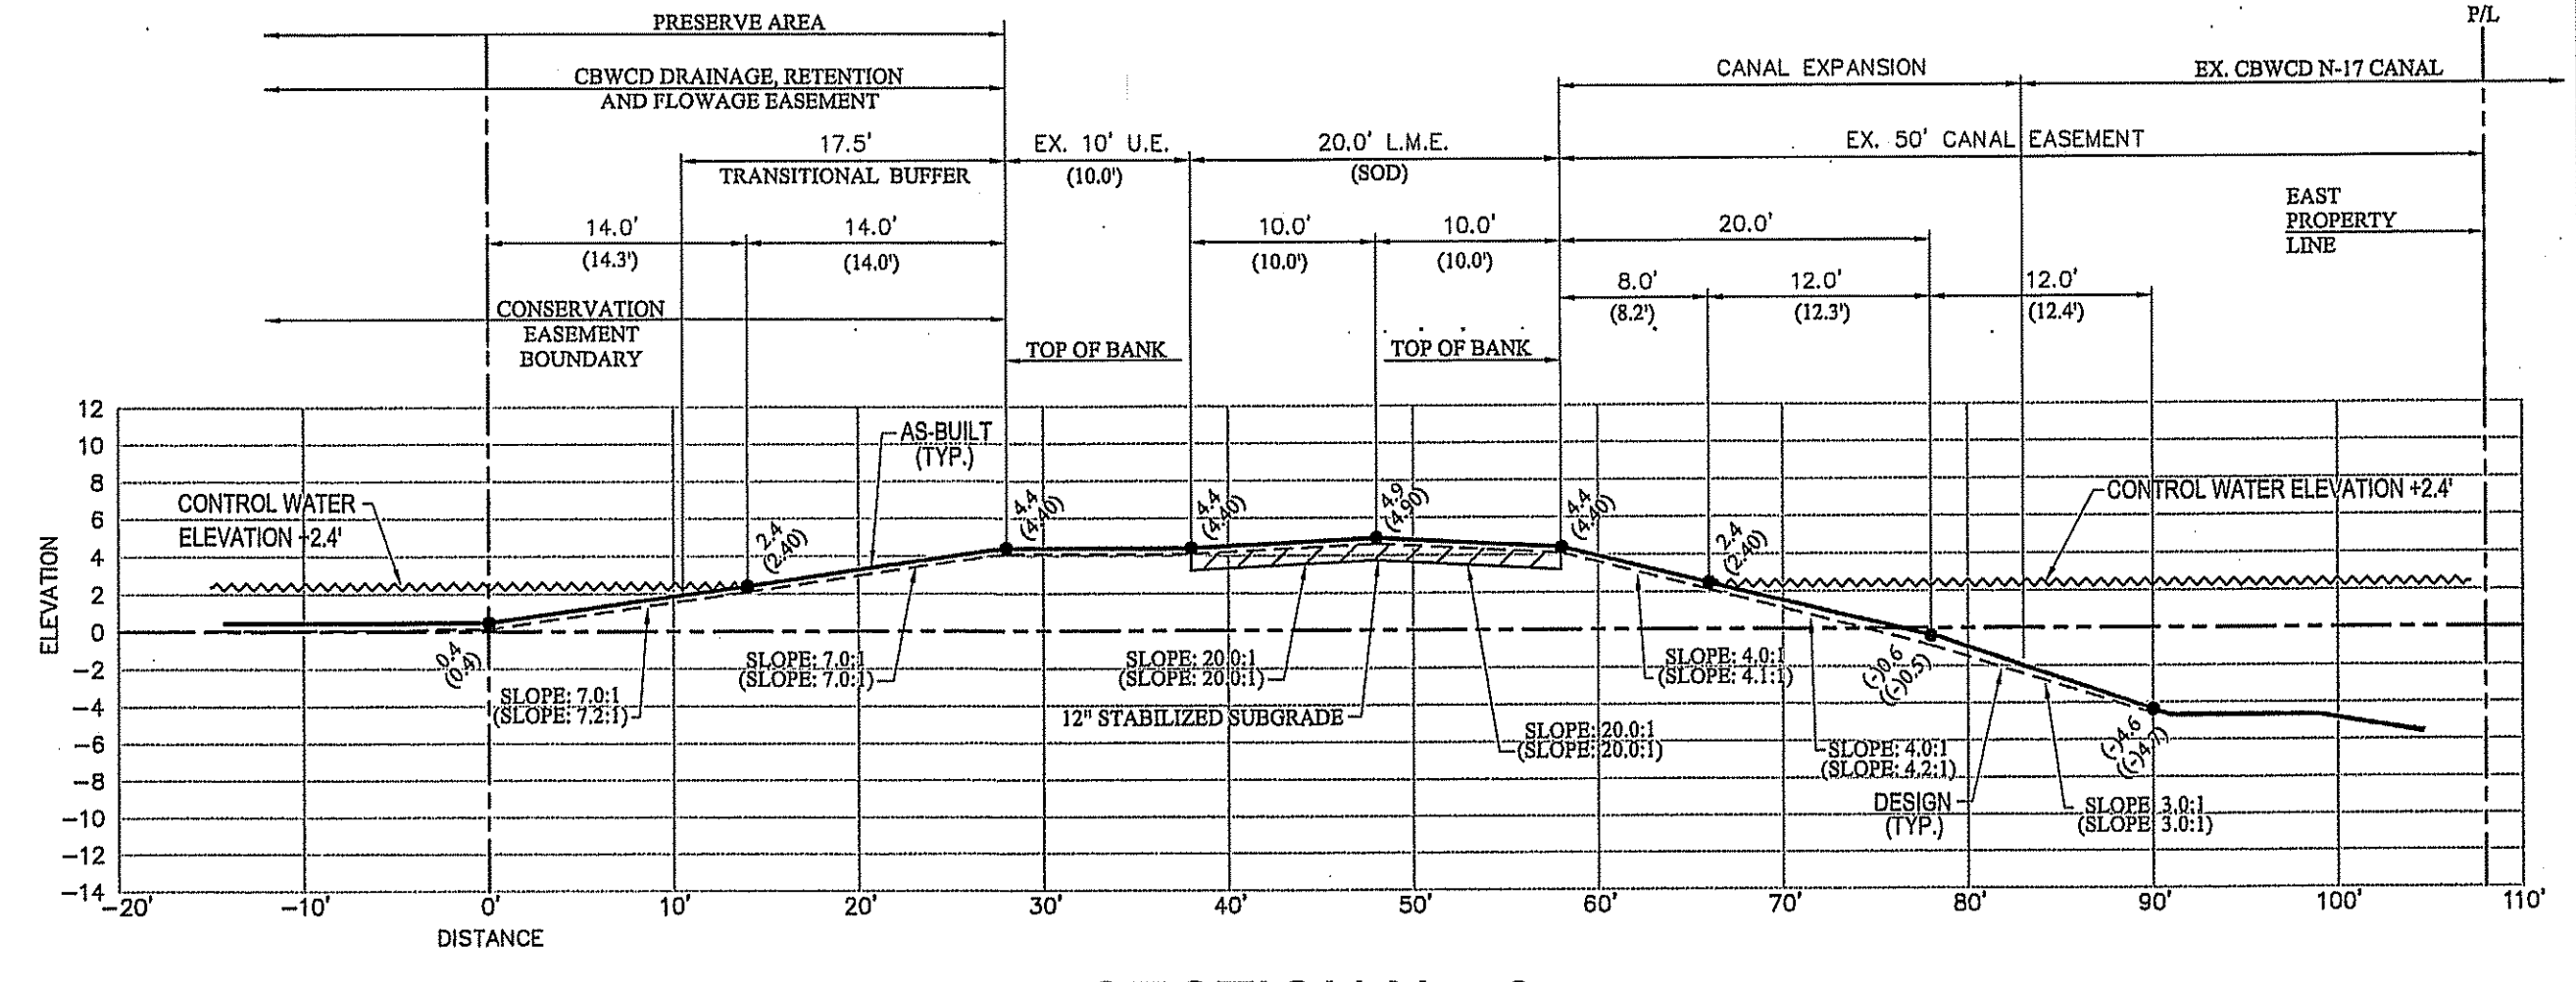

SECTION No. 9
EAST PROPERTY LINE

AS-BUILT LEGEND:

- (15.2) DENOTES AS-BUILT DISTANCE
- (15.0) DENOTES DESIGN DISTANCE
- AS-BUILT ELEVATION
- AS-BUILT ELEVATION
- (SLOPE: 20.0:1) DENOTES AS-BUILT SLOPE
- (SLOPE: 20.0:1) DENOTES DESIGN SLOPE
- L.M.E. DENOTES LAKE MAINTENANCE EASEMENT
- DENOTES AS-BUILT LINE
- - - - - DENOTES DESIGN LINE

CERTIFICATE:

I HEREBY CERTIFY THAT THESE RECORD DRAWINGS FOR THE FACILITY HAVE BEEN REVIEWED BY ME OR BY INDIVIDUAL(S) UNDER MY DIRECT SUPERVISION FOR COMPLETENESS AND ADEQUACY, AND ARE TRUE AND CORRECT TO THE BEST OF MY KNOWLEDGE AND BELIEF. THE FIELD WORK FOR THE AS-BUILT DRAWINGS HAS BEEN DONE BY: Joseph L. Martin, P.S.M. #4368

10/20/2022

JOSEPH L. MARTIN
Professional Engineer
License Number: 4368
State of Florida
Professional Engineer and Surveyor

DATE: 12/10/2021

JOSEPH L. MARTIN
PROFESSIONAL SURVEYOR
& MAPPER
FSM# 4368
STATE OF FLORIDA

THIS DOCUMENT CONSISTS OF 18 SHEETS AND EACH SHEET SHALL NOT BE CONSIDERED VALID WITHOUT SHEET 1.

Chad E. Edwards, State of Florida,
Professional Engineer, License No. 59306

This item has been digitally signed and sealed by
Chad E. Edwards, on the date indicated here.
Printed copies of this document are not
considered signed and sealed and the signature
must be verified on any electronic copies.

Chad Everett
Edwards


Digitally signed by Chad Everett
Edwards
Date: 2022.10.27 09:25:48 -04'00'


NOTE:
THE AS-BUILT LINEWORK SHOWN HEREON IS A GRAPHICAL REPRESENTATION
AND MAY NOT BE DRAWN TO SCALE FOR CLARITY PURPOSES.

SIERRA RANCH
DAVIE, FL.


AS-BUILT CROSS SECTIONS	DATE	REVISION COMMENTS	BY	APP
1950 SOUTH HIATUS ROAD	05-18-21	REVISED PER ENGINEER'S COMMENTS	L.A.	J.M.
SEC. 18, TWP. 50S, RGE. 41E	11-8-21	REVISED TO ADD SECTIONS FROM 16 TO 36	L.A.	J.M.
	12-8-21	REVISED TO ADD SECTIONS FROM 37 TO 125	L.A.	G.B.
	12-10-21	REVISED PER ENGINEER'S COMMENTS	L.A.	G.B.

SCALE: H:1"=10' / V:1"=10'
SURVEYOR: COUNTY-WIDE
DRAWN BY: LESLY
CHECKED BY: G.B.
AS-BUILT: PRESERVE AREA
DATE: 04/14/2021
ONE PROJECT No: 2019-043
SHEET No:

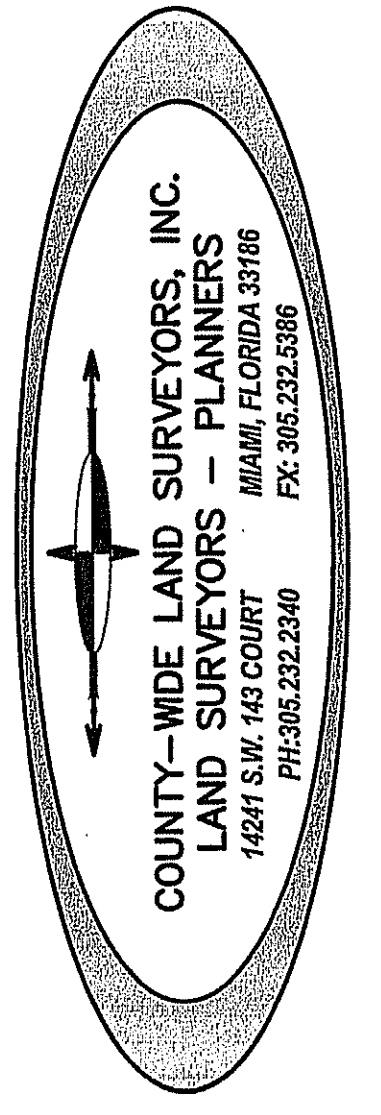


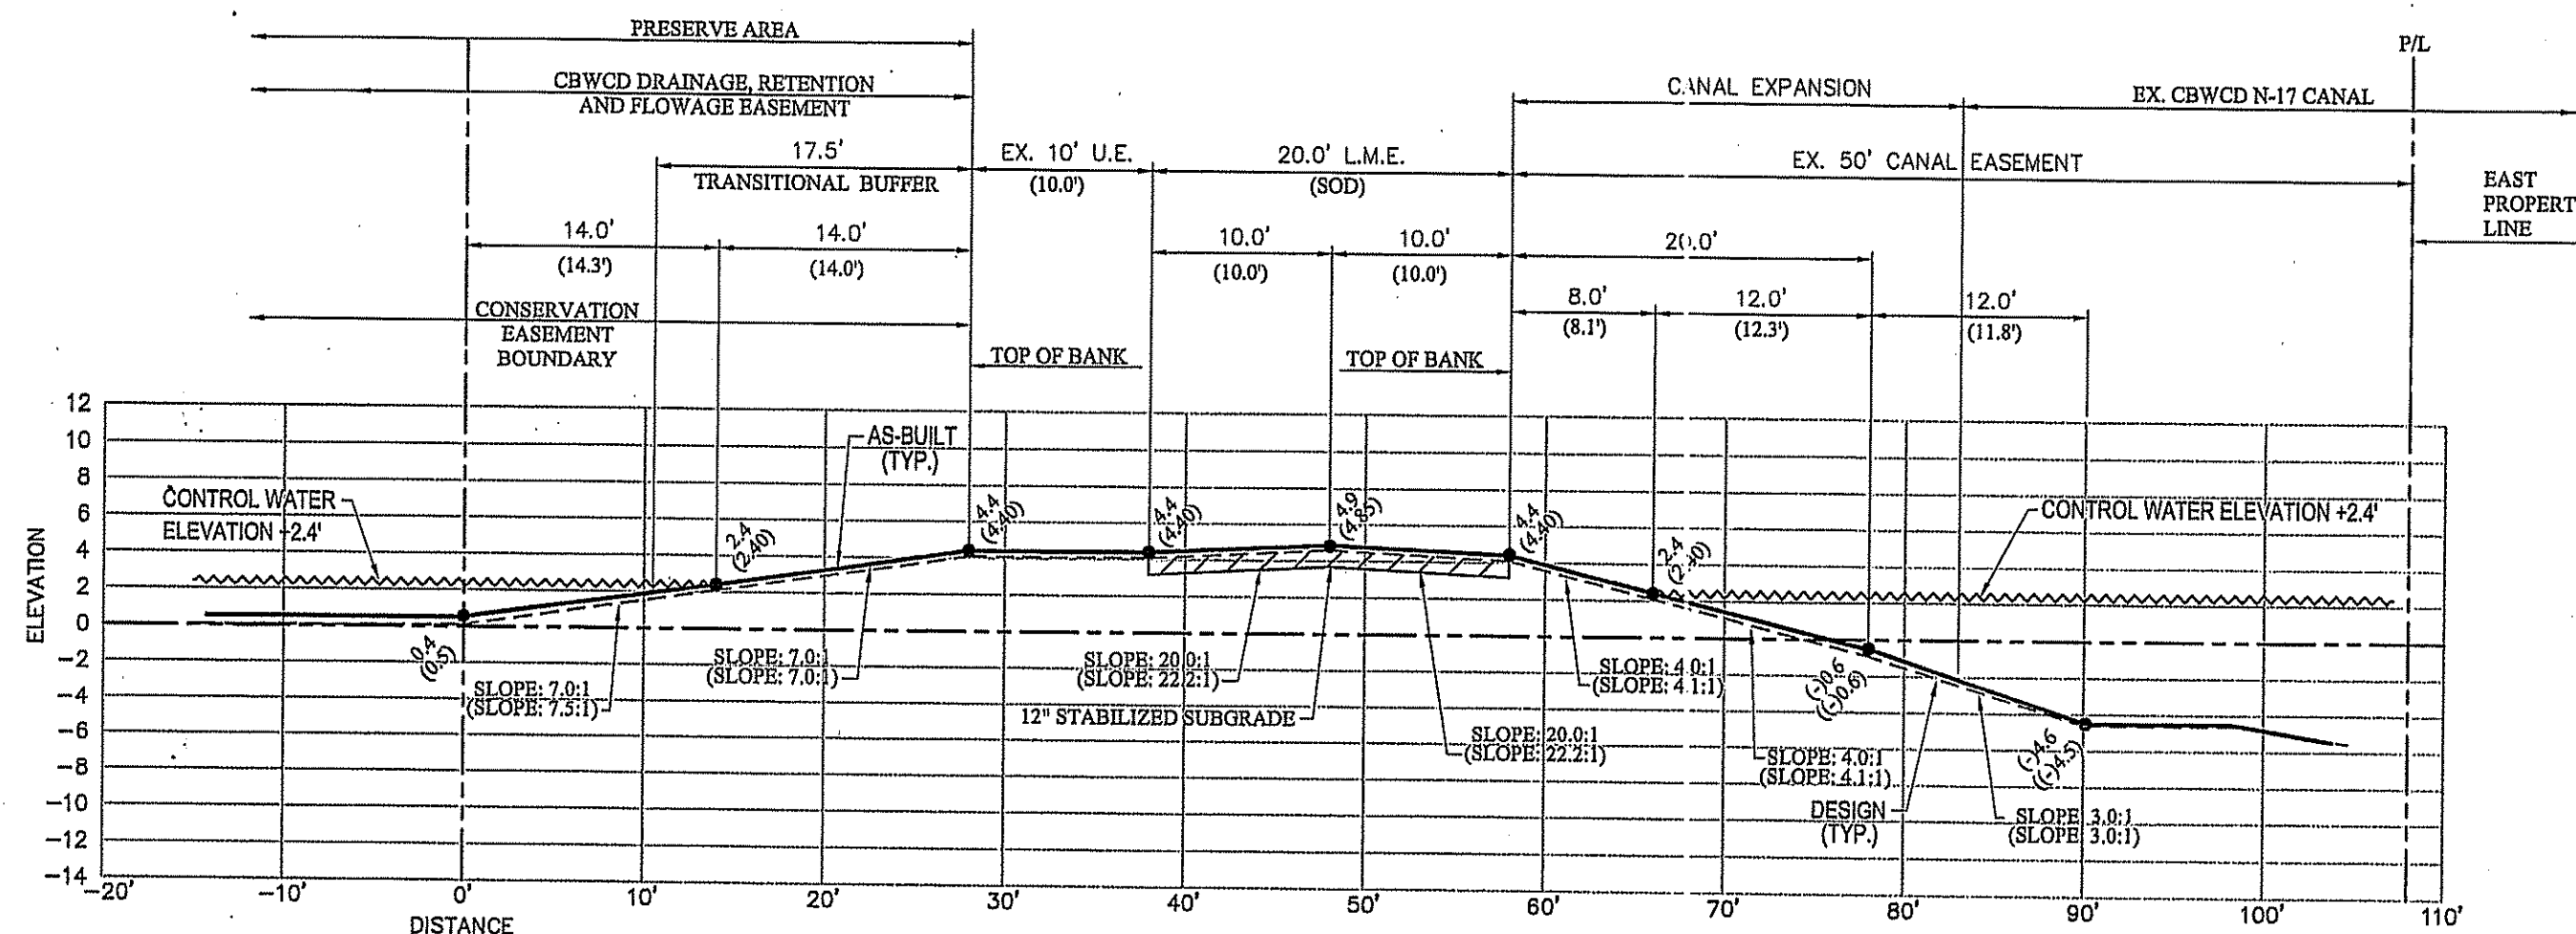


SECTION No. 10
EAST PROPERTY LINE

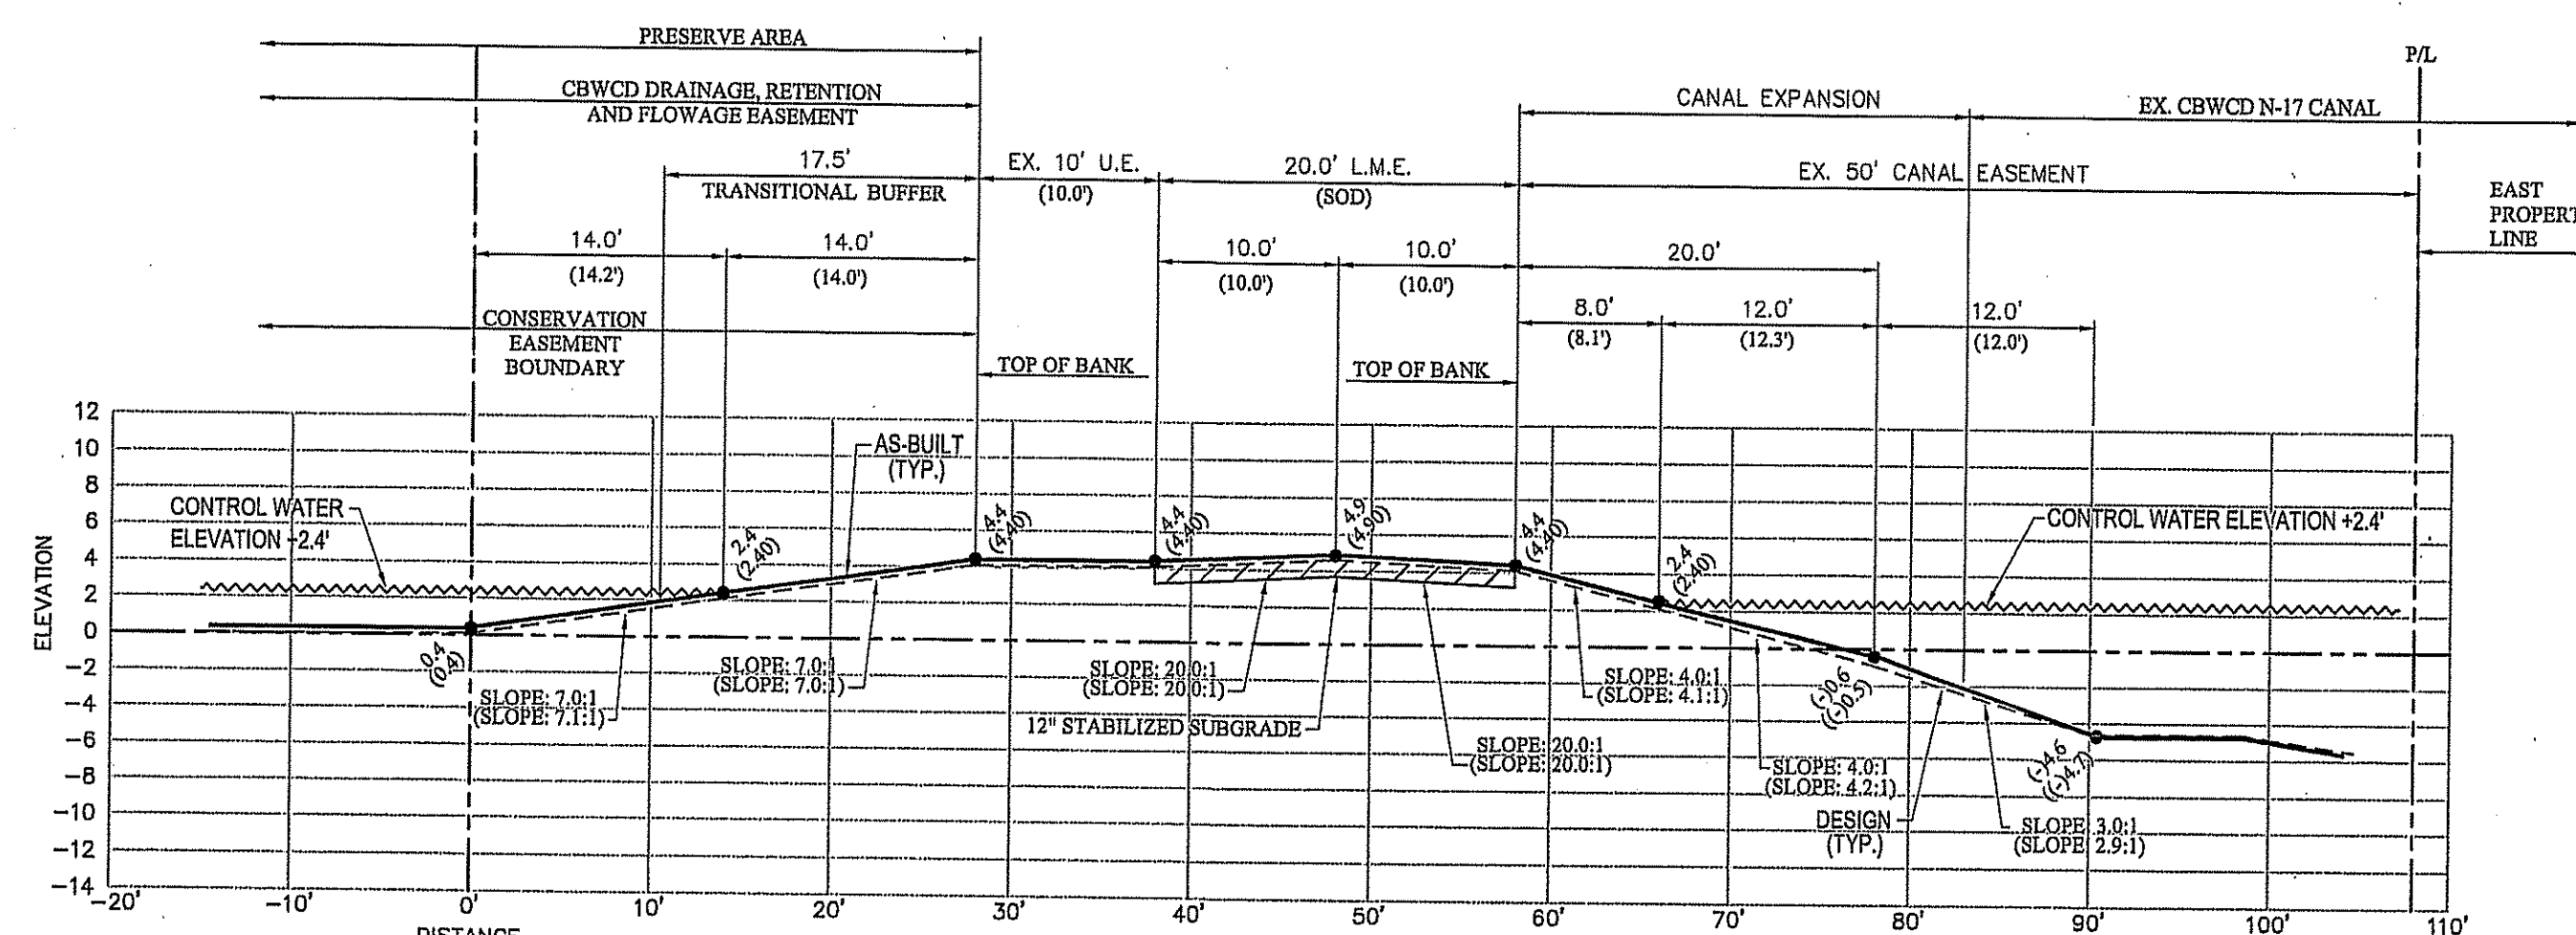


SECTION No. 11
EAST PROPERTY LINE

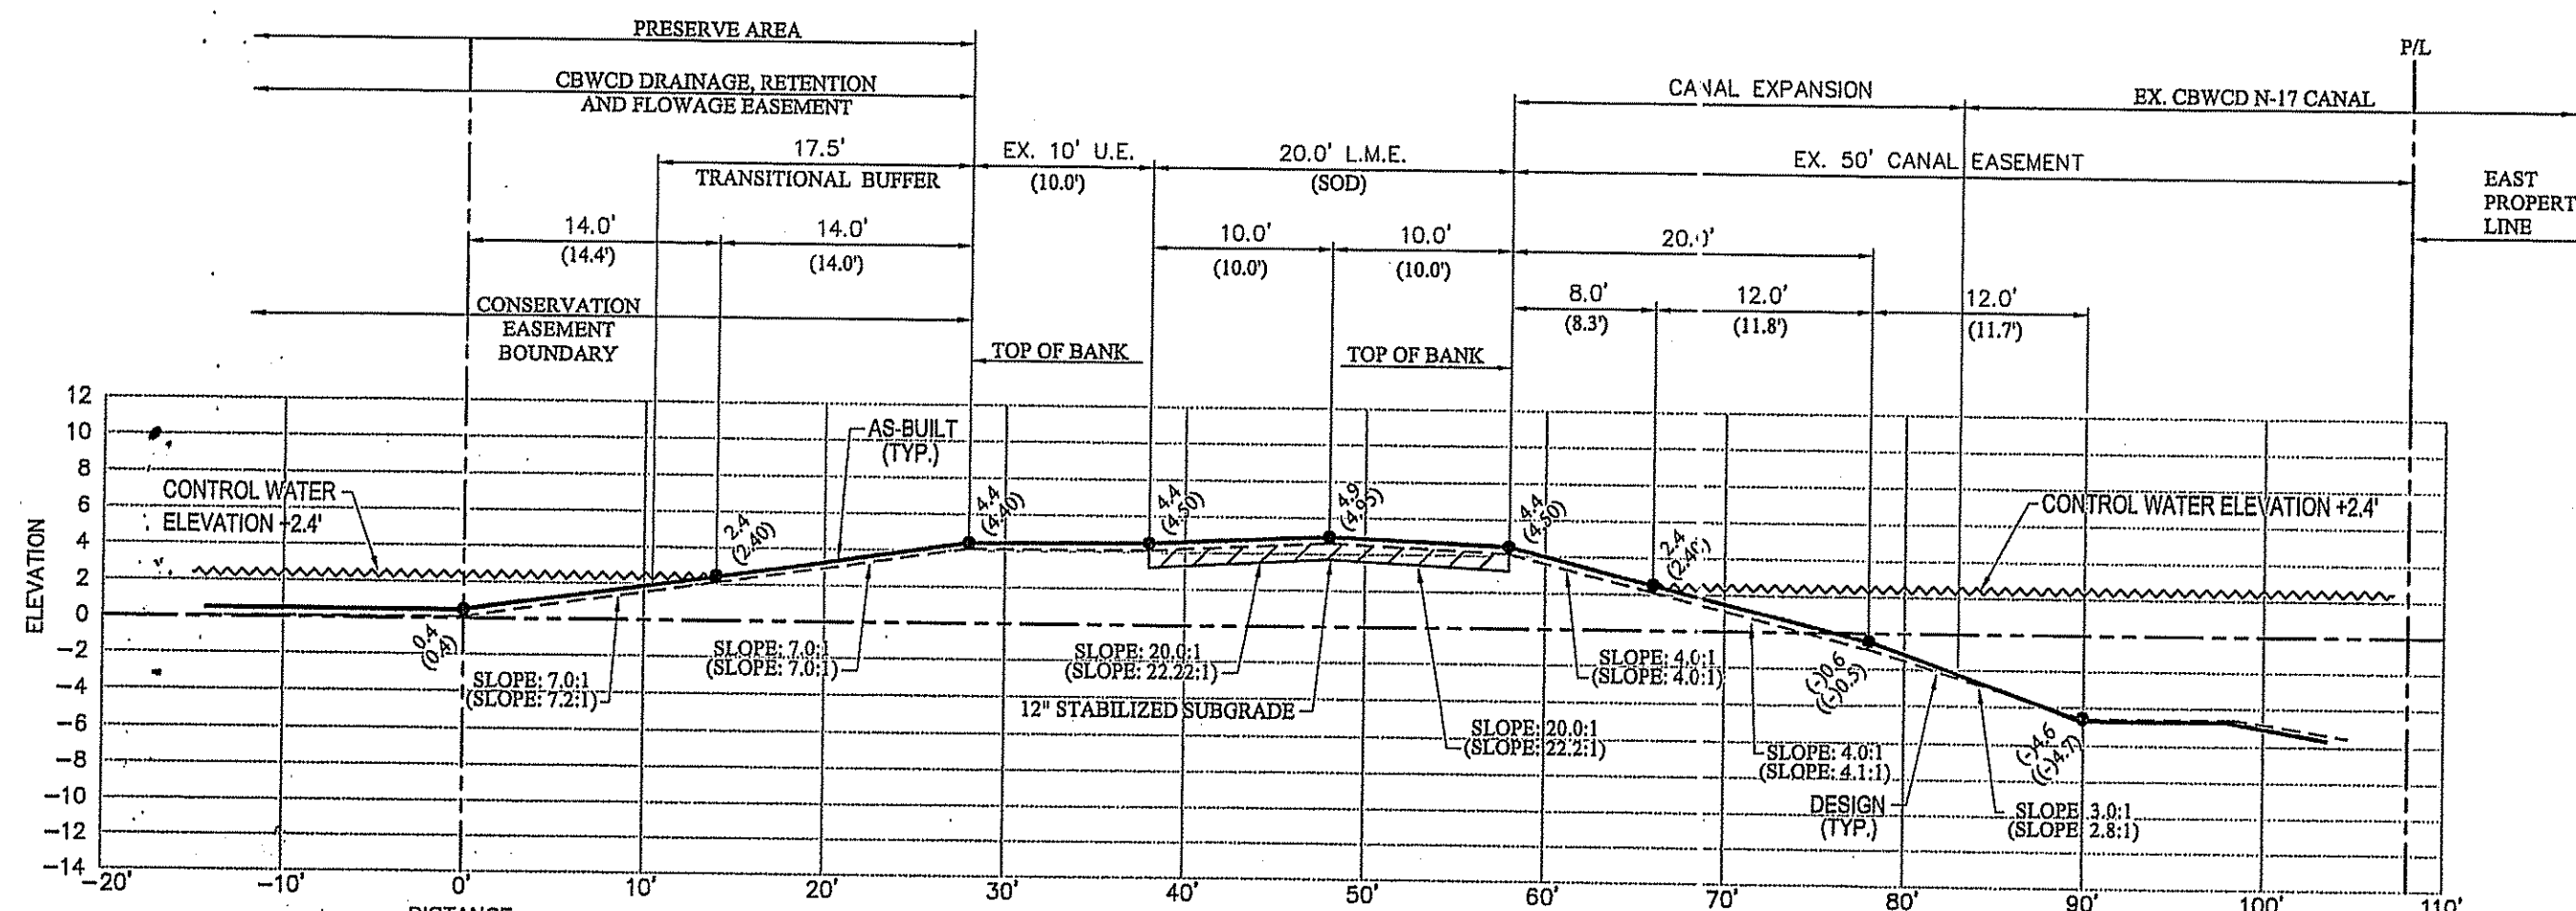


SECTION No. 12
EAST PROPERTY LINE

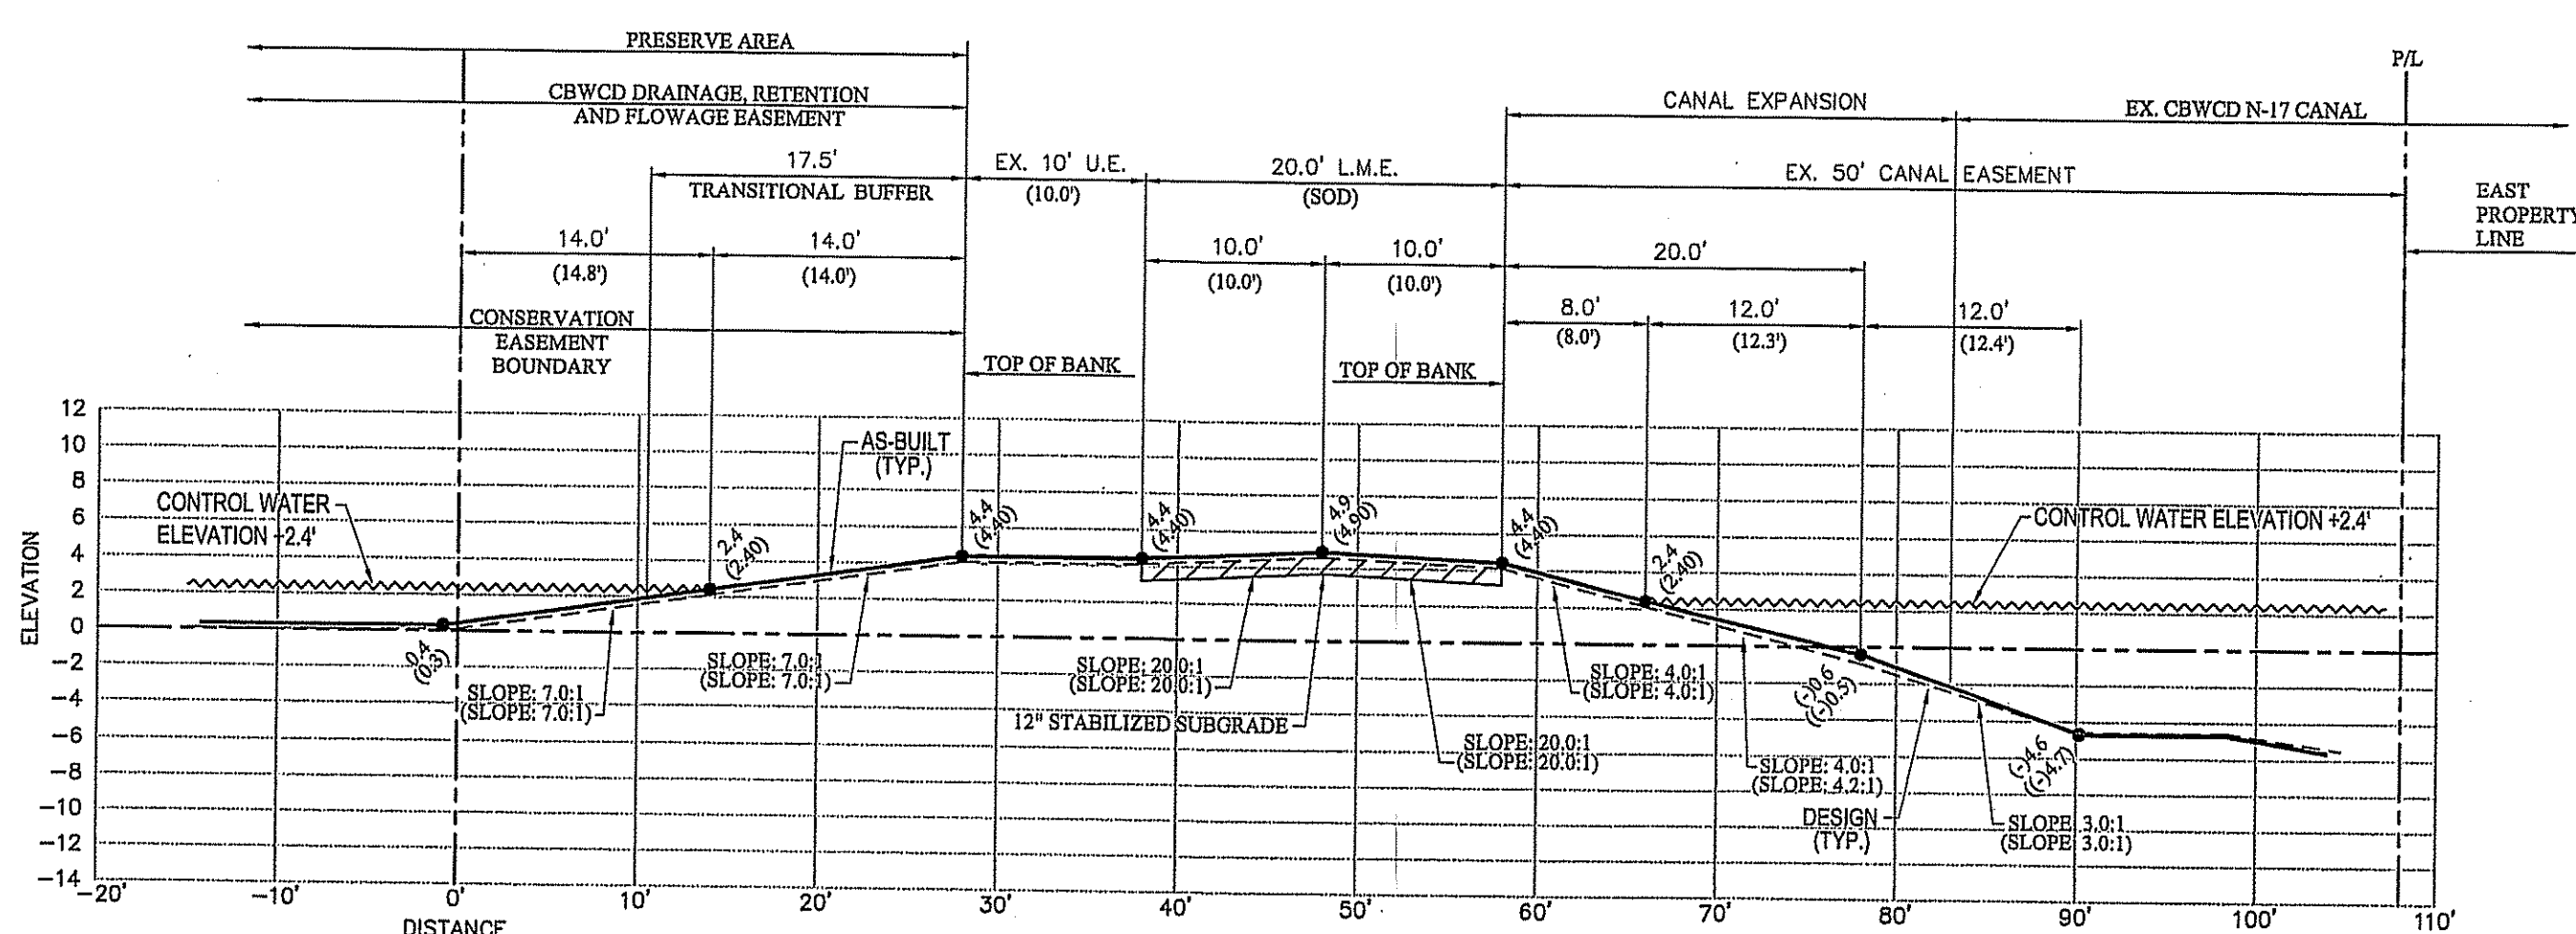

SECTION No. 13
EAST PROPERTY LINE

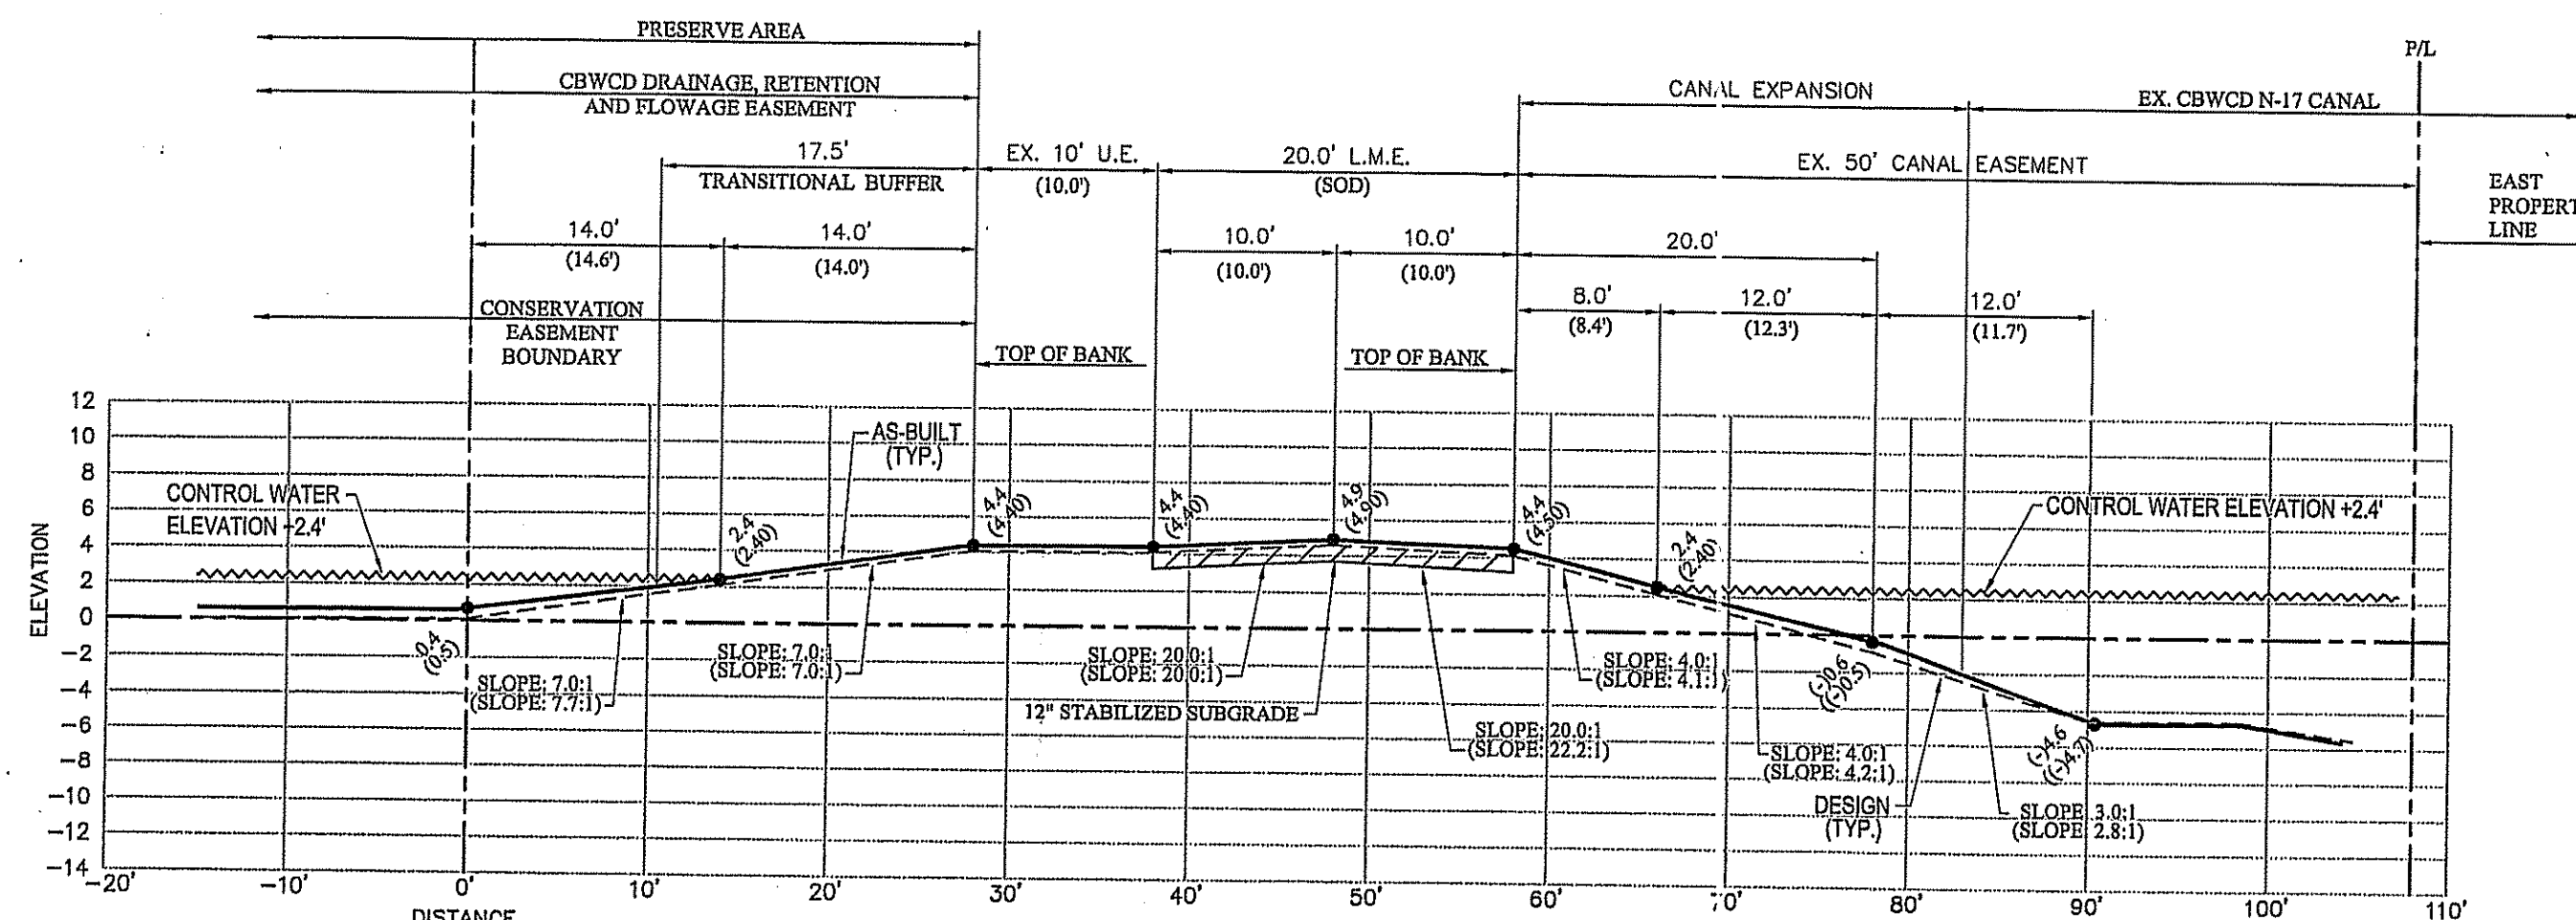

SECTION No. 14
EAST PROPERTY LINE

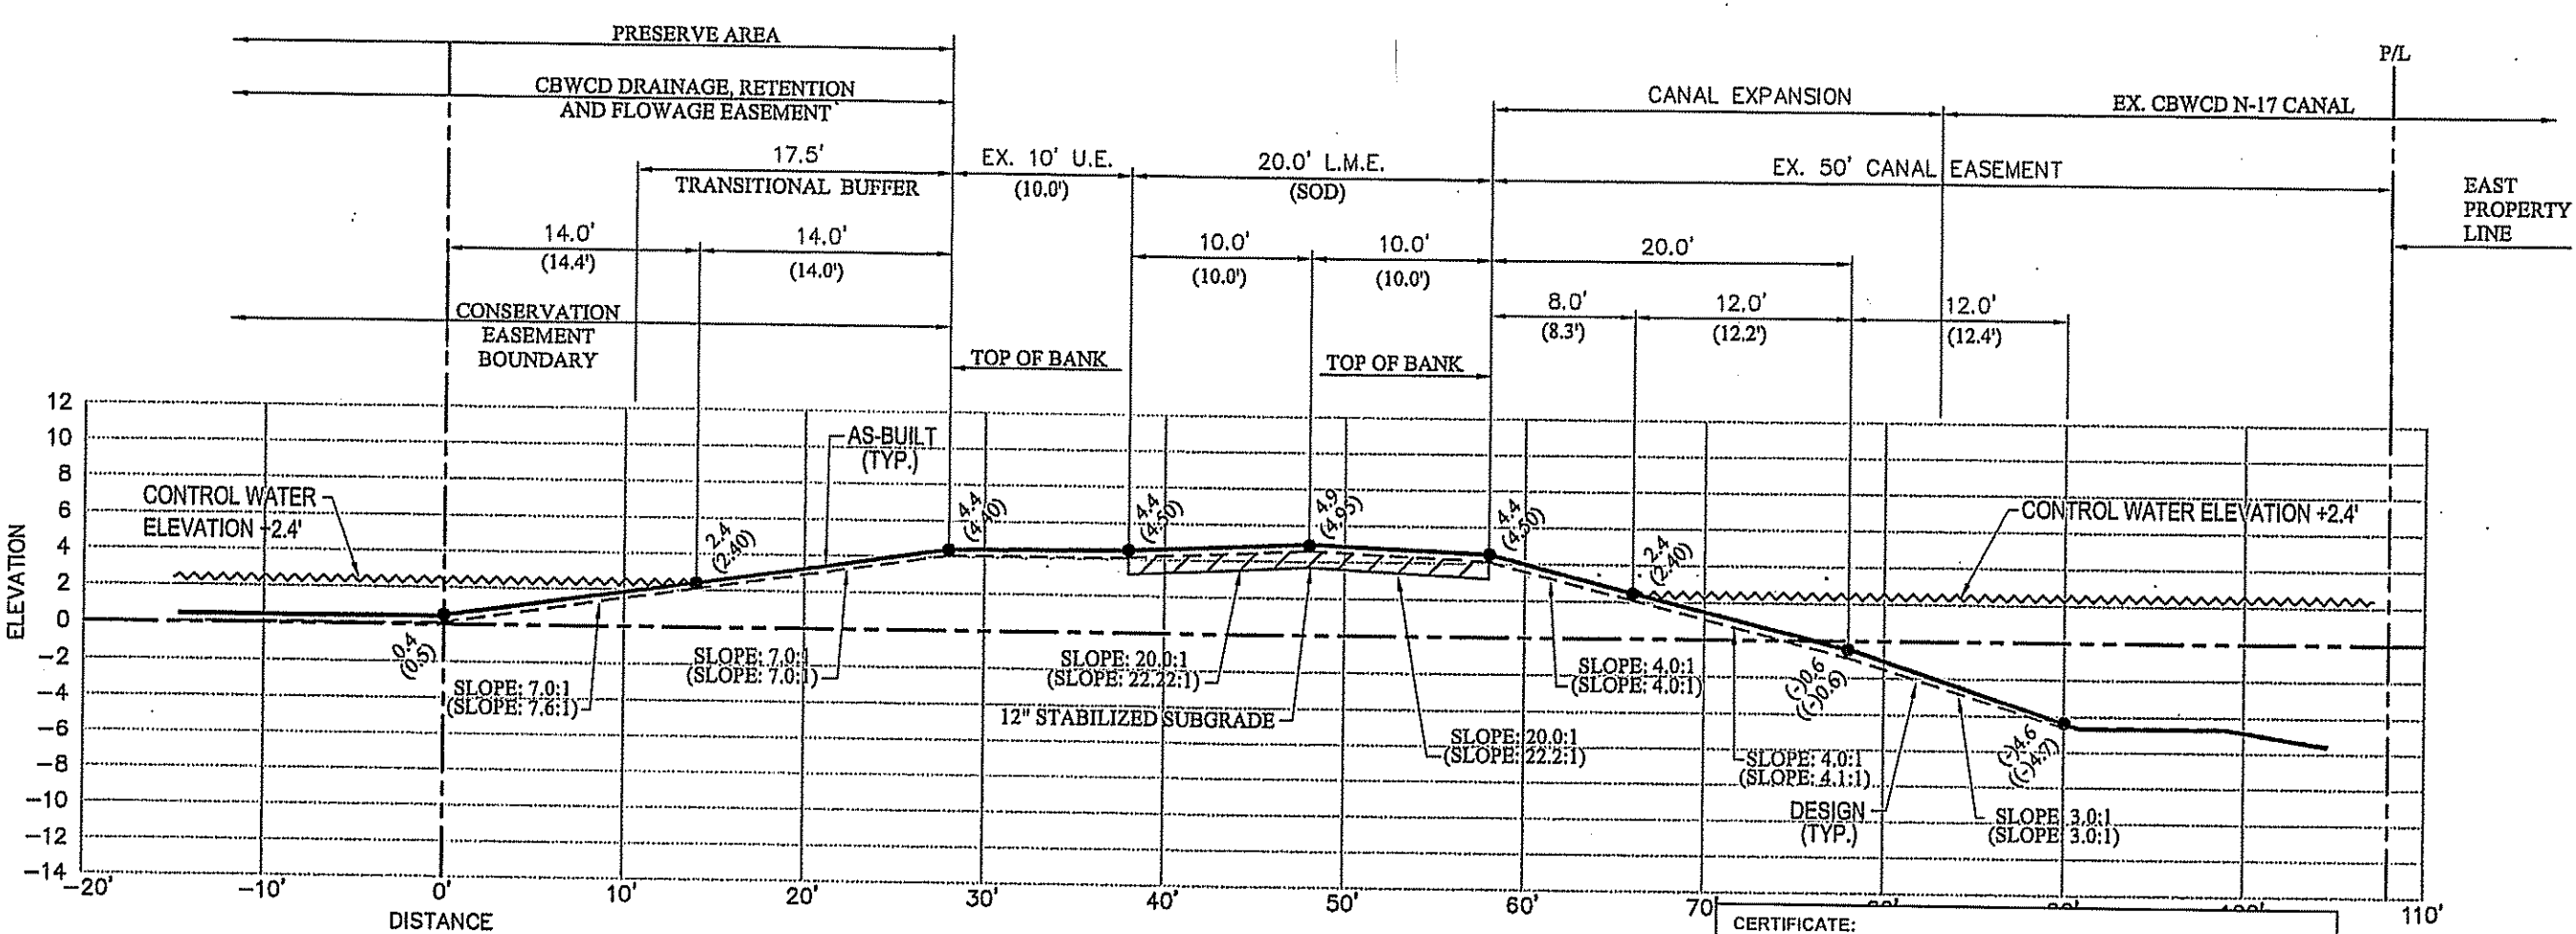

SECTION No. 15
EAST PROPERTY LINE

AS-BUILT LEGEND:

- (15.2) DENOTES AS-BUILT DISTANCE
- 15.0' DENOTES DESIGN DISTANCE
- 6.5 DENOTES AS-BUILT ELEVATION
- 6.7 DENOTES DESIGN ELEVATION
- (SLOPE: 20.0:1) DENOTES AS-BUILT SLOPE
- SLOPE: 20.0:1 DENOTES DESIGN SLOPE
- L.M.E. DENOTES LAKE MAINTENANCE EASEMENT
- DENOTES AS-BUILT LINE
- DENOTES DESIGN LINE


Chad E. Edwards, State of Florida,
Professional Engineer, License No. 59306

This item has been digitally signed and sealed by
Chad E. Edwards, on the date indicated here.
Printed copies of this document are not
considered signed and sealed and the signature
must be verified on any electronic copies.

Chad Everett
Edwards
Digitally signed by
Chad Everett Edwards
Date: 2022.10.27
09:26:40 -04'00'


NOTE:
THE AS-BUILT LINEWORK SHOWN HEREON IS A GRAPHICAL REPRESENTATION
AND MAY NOT BE DRAWN TO SCALE FOR CLARITY PURPOSES.

CERTIFICATE:
I HEREBY CERTIFY THAT THESE RECORD DRAWINGS FOR THE
FACILITY HAVE BEEN REVIEWED BY ME OR BY INDIVIDUAL(S)
UNDER MY DIRECT SUPERVISION FOR COMPLETENESS AND
ADEQUACY, AND ARE TRUE AND CORRECT TO THE BEST OF MY
KNOWLEDGE AND BELIEF. THE FIELD WORK FOR THE AS-BUILT
DRAWINGS HAS BEEN DONE BY: Joseph L. Martin, P.S.M. #4388
10/20/2022

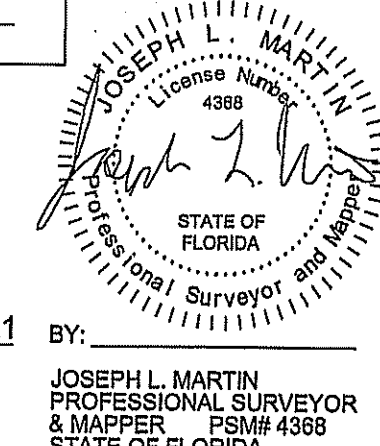

DATE: 12/10/2021 BY:

THIS DOCUMENT CONSISTS OF 18 SHEETS AND EACH
SHEET SHALL NOT BE CONSIDERED VALID WITHOUT
SHEET 1.

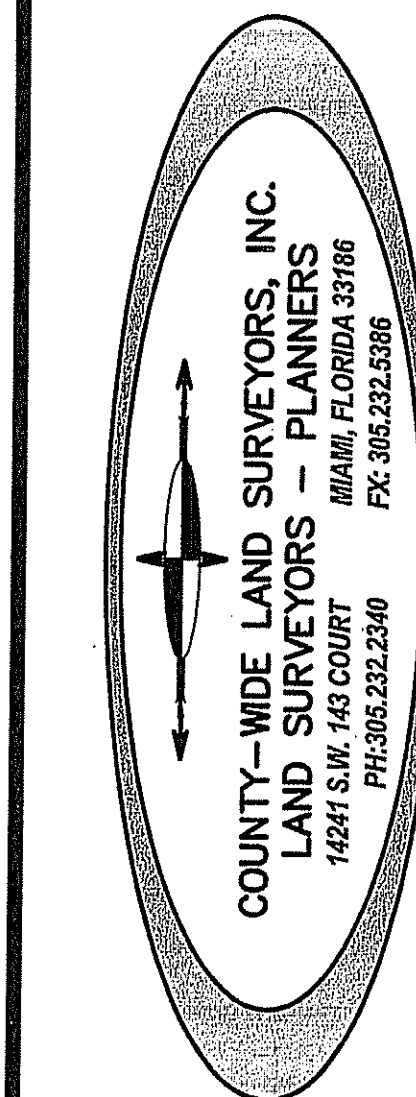


SIERRA RANCH
DAVIE, FL.


APP	BY	REVISION COMMENTS	DATE
J.M.	L.A.	REVISED PER ENGINEER'S COMMENTS	05-18-21
J.M.	L.A.	REVISED TO ADD SECTIONS FROM 16 TO 36	11-8-21
G.B.	L.A.	REVISED TO ADD SECTIONS FROM 37 TO 125	12-8-21
G.B.	L.A.	REVISED PER ENGINEER'S COMMENTS	12-10-21

AS-BUILT CROSS SECTIONS
1950 SOUTH HIATUS ROAD
SEC. 16, TWP. 50S, RGE. 41E


SCALE: H:1"=10' / V:1"=10'
SURVEYOR: COUNTY-WIDE
DRAWN BY: LESLY
CHECKED BY: G.B.
AS-BUILT: PRESERVE AREA
DATE: 04/14/2021
ORE PROJECT NO: 2019-043
SHEET NO: 4 of 18

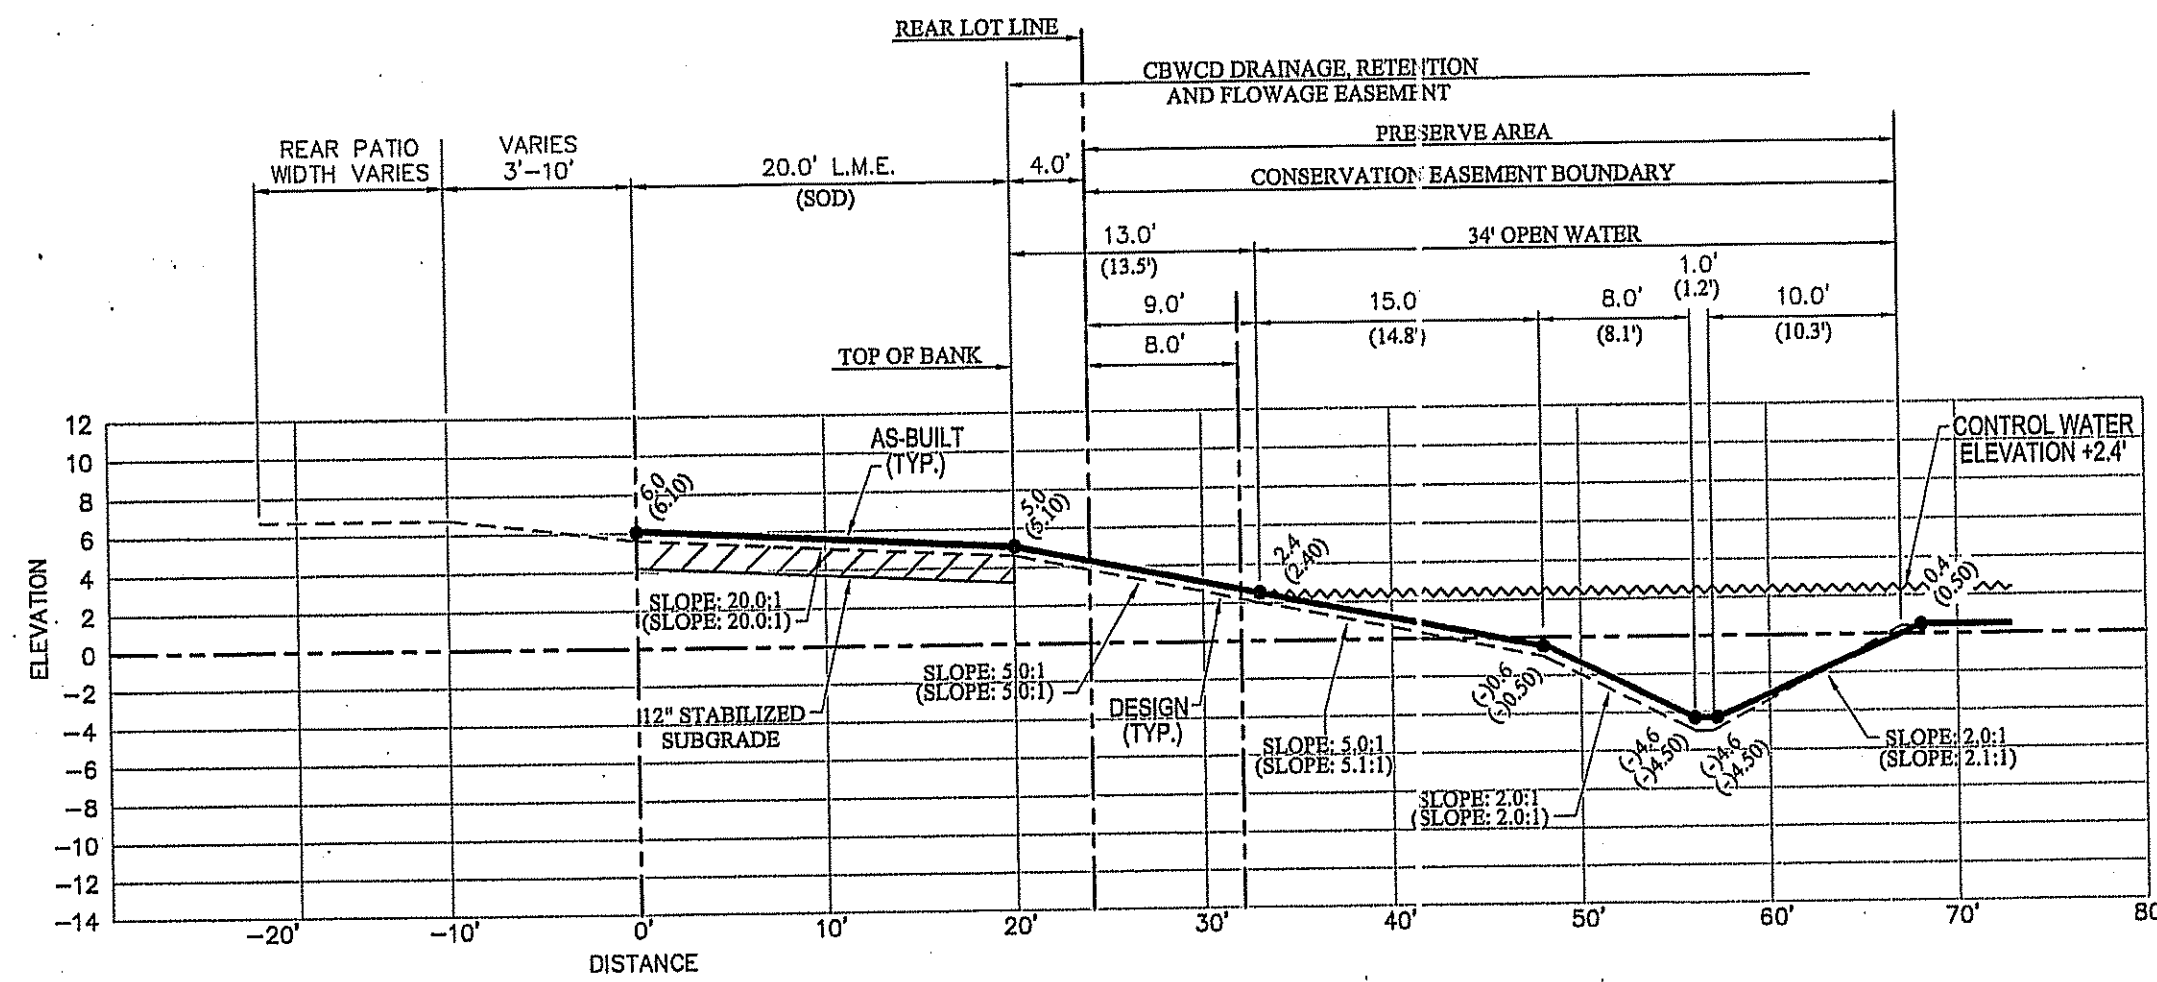


SECTION No. 16

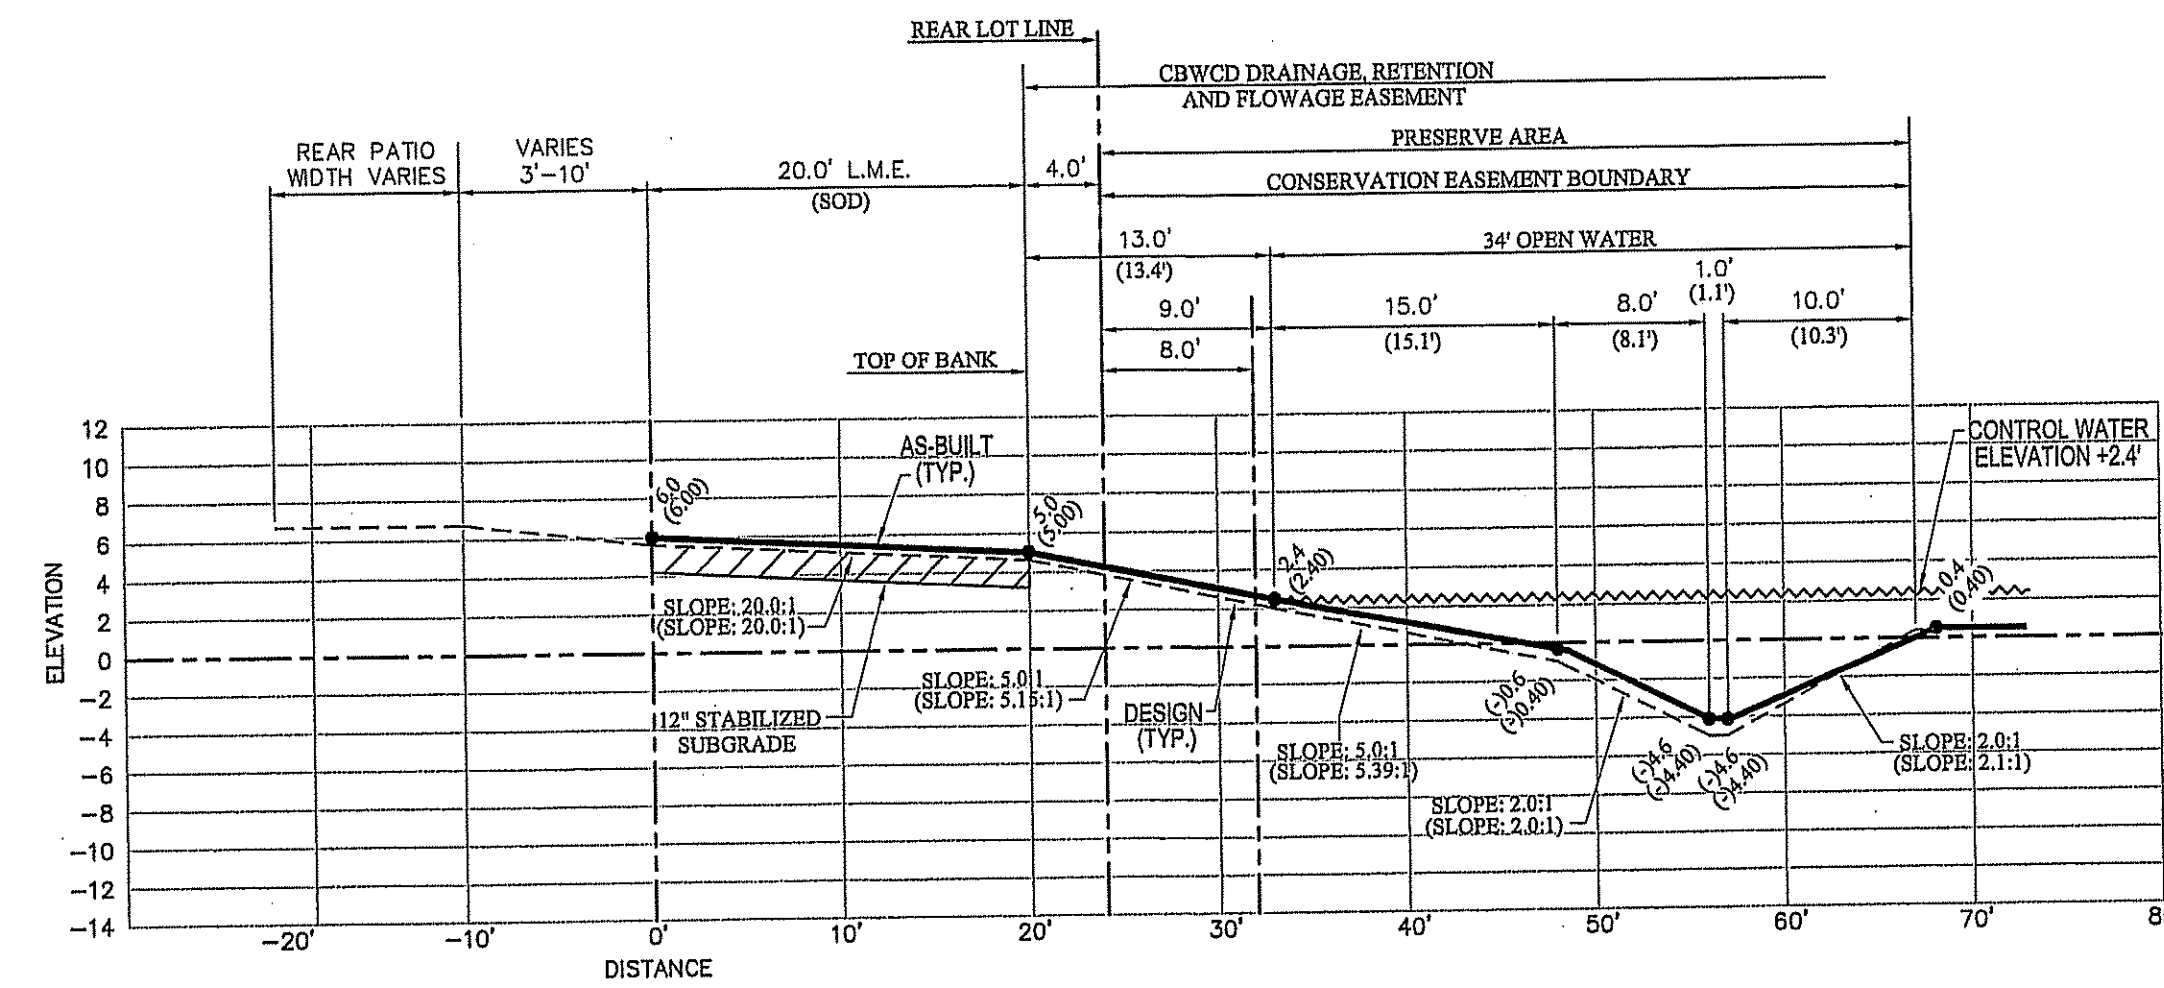


SECTION No. 17

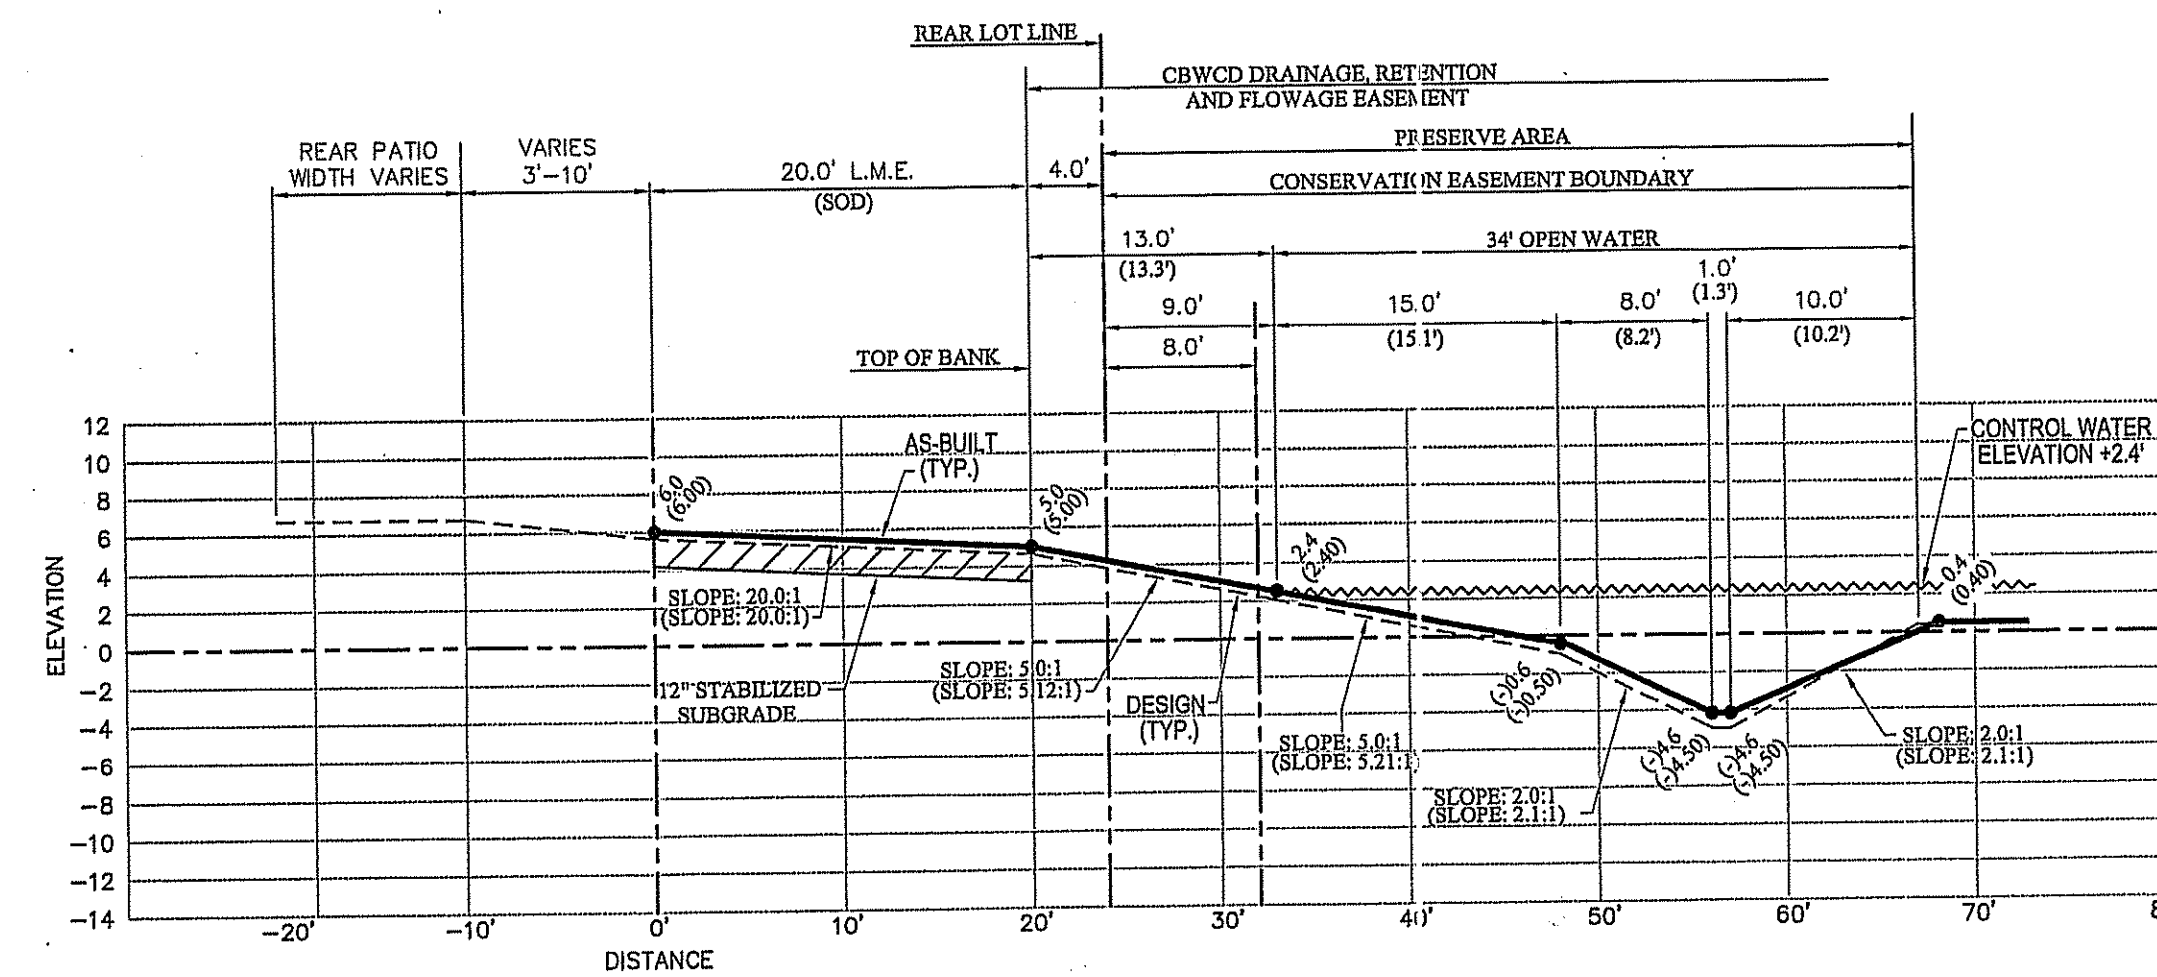


SECTION No. 18

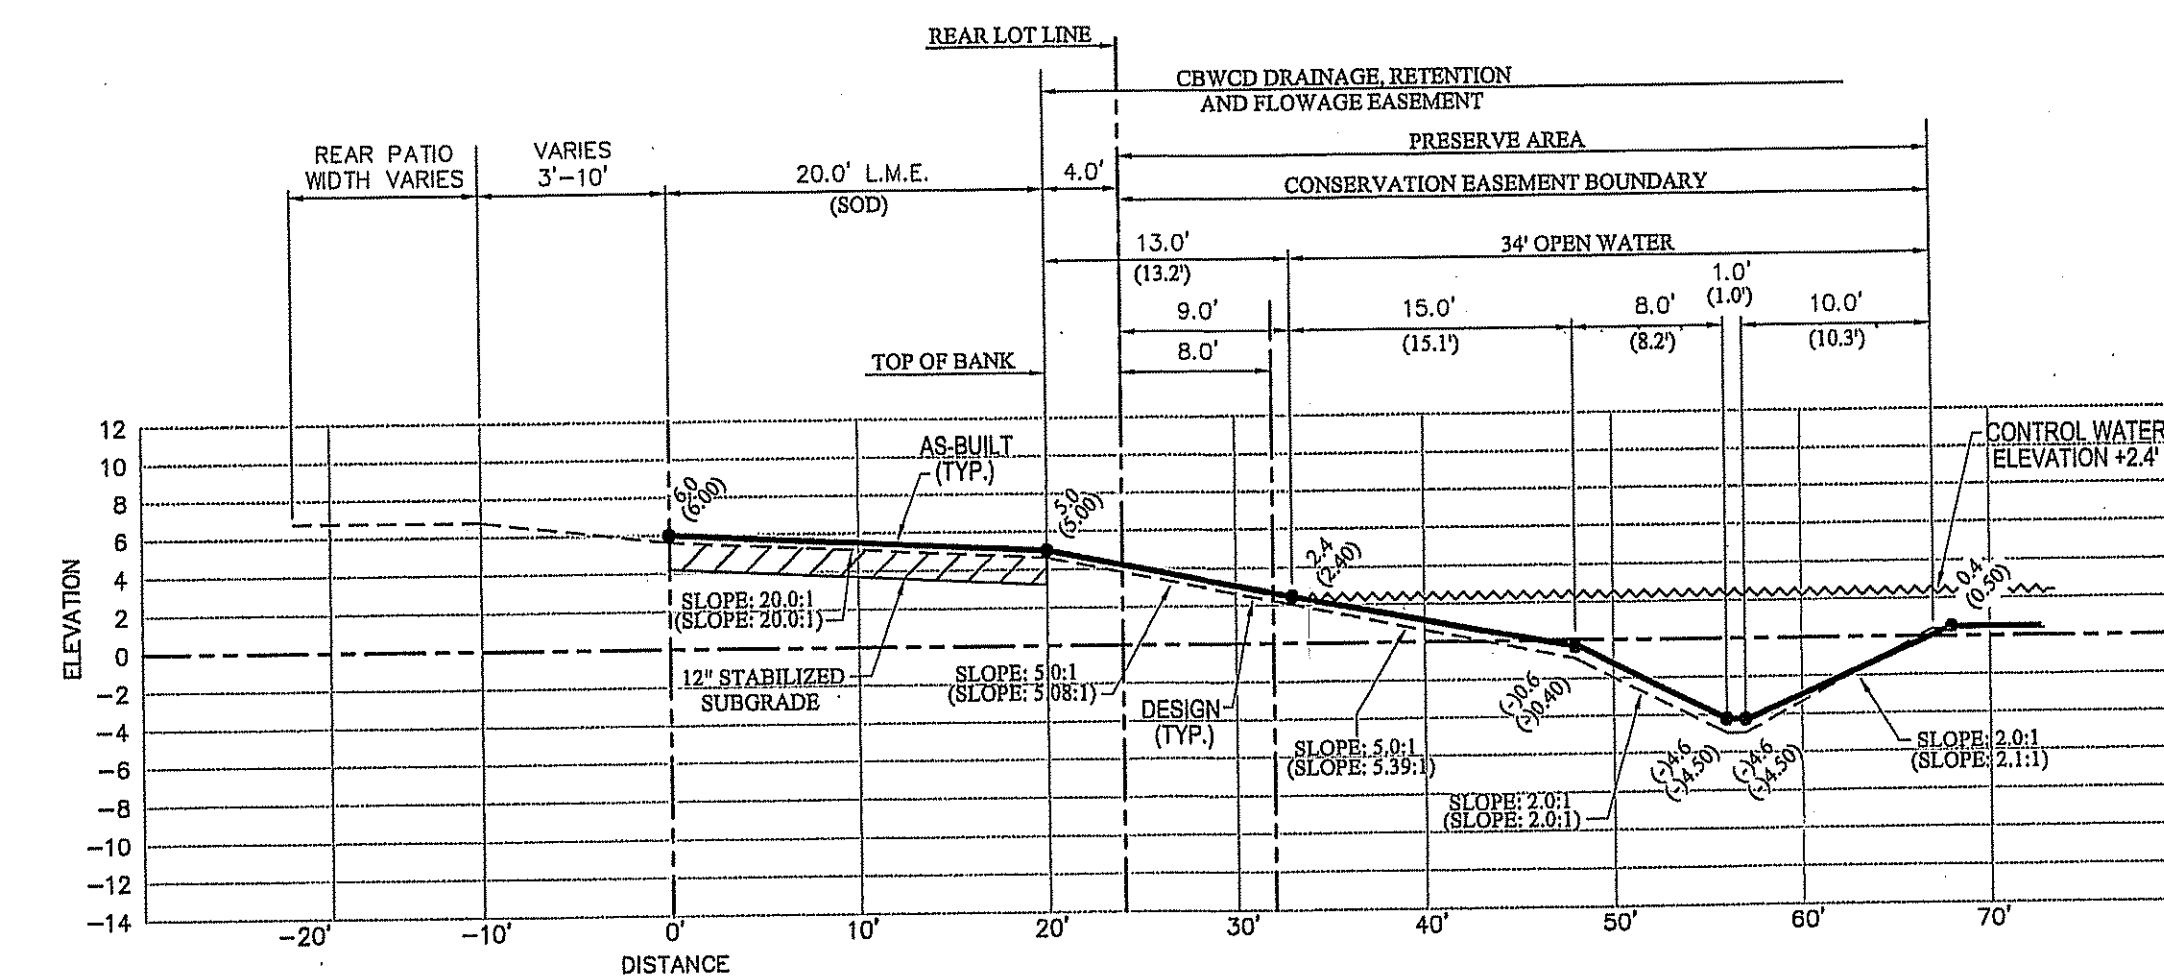

SECTION No. 19

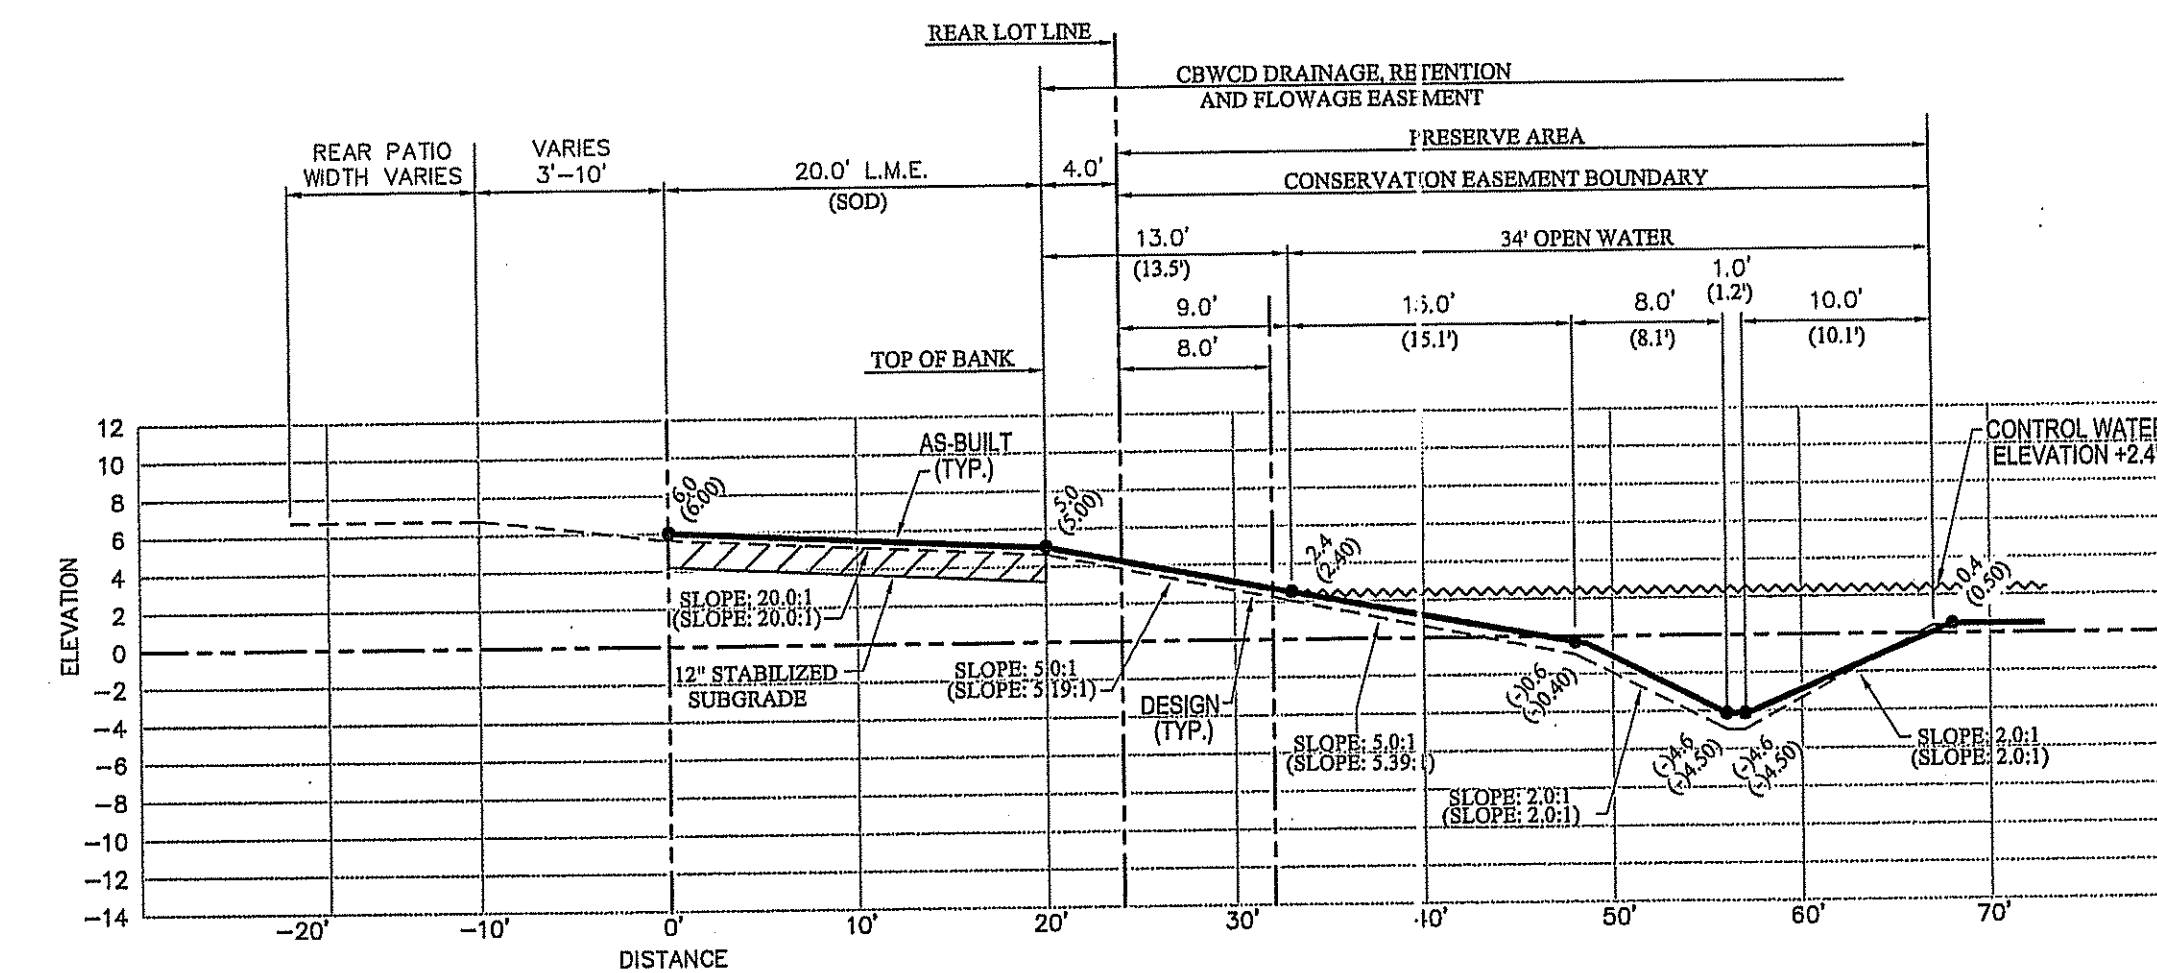

SECTION No. 20

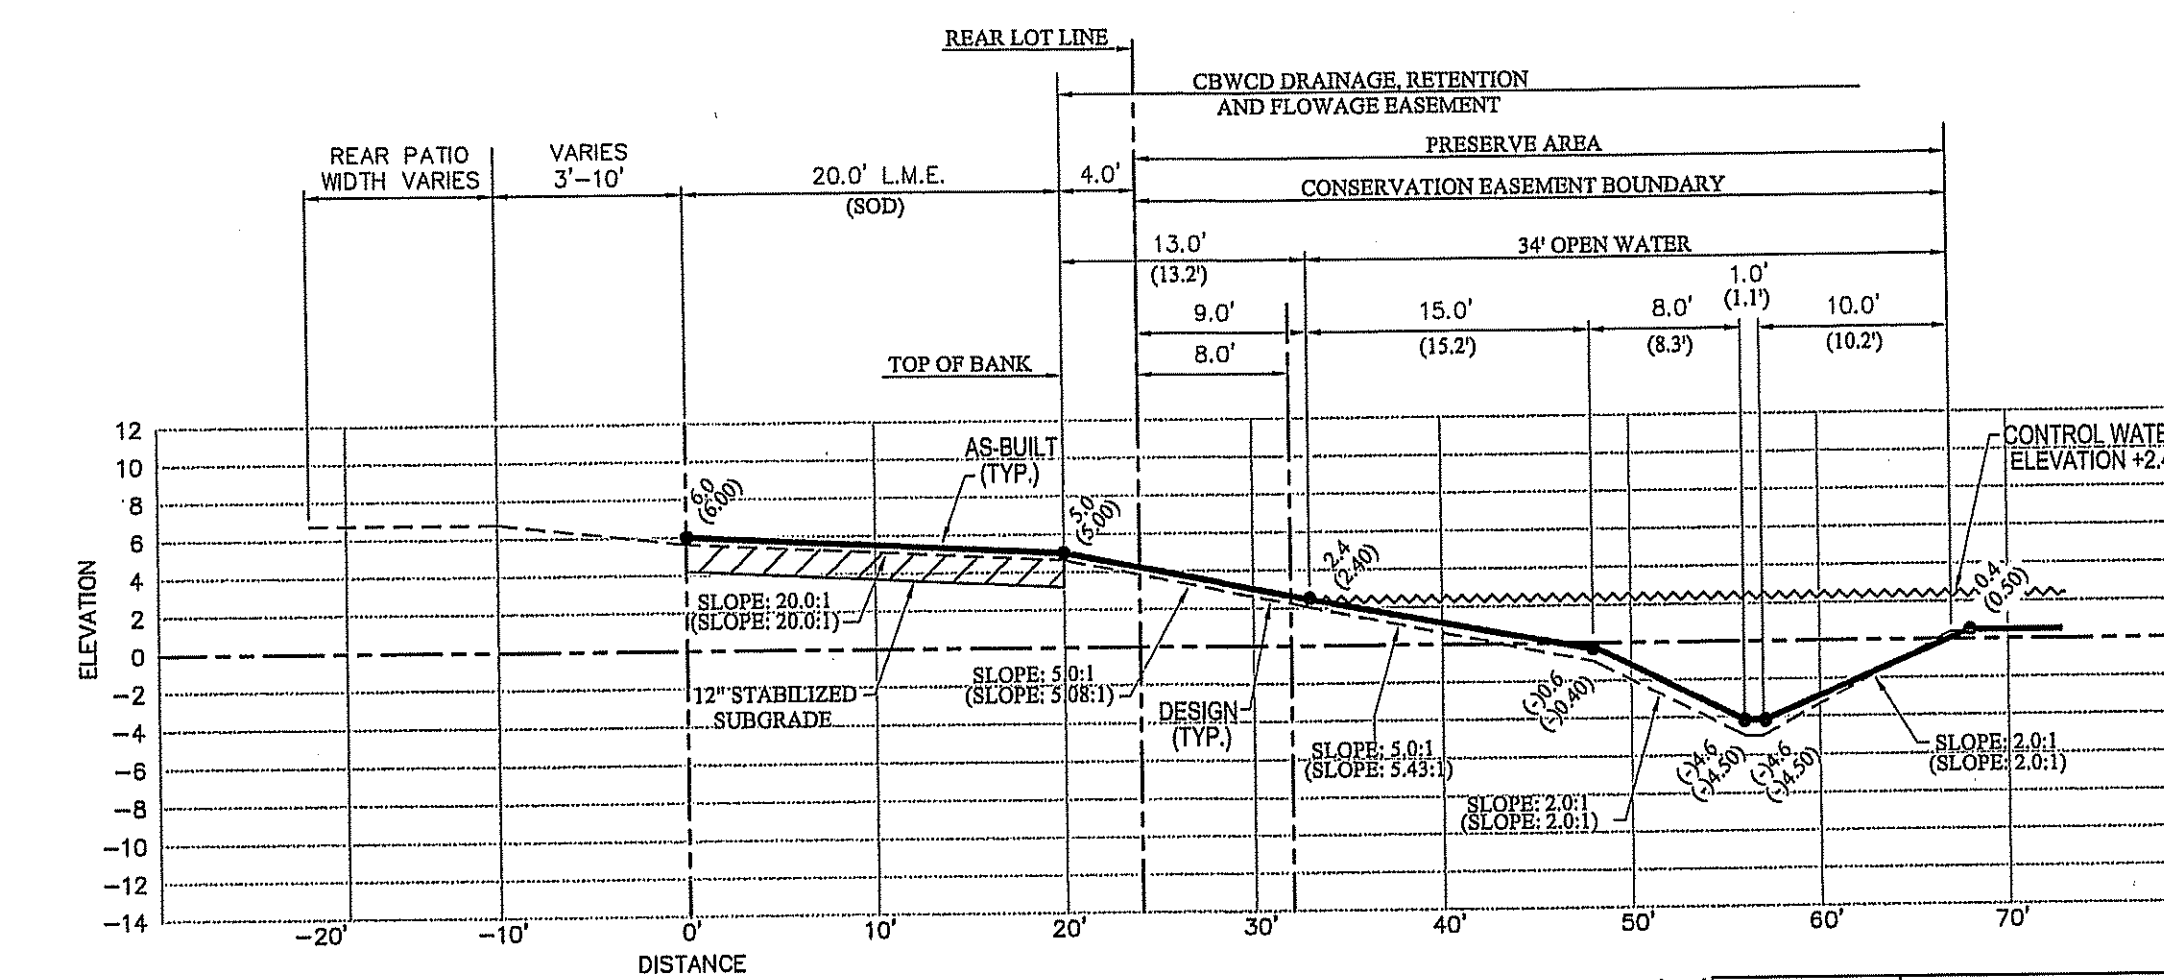

SECTION No. 21

Chad E. Edwards, State of Florida,
Professional Engineer, License No. 59306

This item has been digitally signed and sealed by
Chad E. Edwards on the date indicated here.
Printed copies of this document are not
considered signed and sealed and the signature
must be verified on any electronic copies.

Chad
Everett
Edwards

Digitally signed by
Chad Everett Edwards
Date: 2022.10.27
09:27:00 -04'00'

AS-BUILT LEGEND:

- (15.2) DENOTES AS-BUILT DISTANCE
- 15.0' DENOTES DESIGN DISTANCE
- 5.0' DENOTES AS-BUILT ELEVATION
- 5.0' DENOTES DESIGN ELEVATION
- (SLOPE: 2.0:1) DENOTES AS-BUILT SLOPE
- SLOPE: 2.0:1 DENOTES DESIGN SLOPE
- L.M.E. DENOTES LAKE MAINTENANCE EASEMENT
- DENOTES AS-BUILT LINE
- DENOTES DESIGN LINE

NOTE:

THE AS-BUILT LINEWORK SHOWN HEREON IS A GRAPHICAL REPRESENTATION
AND MAY NOT BE DRAWN TO SCALE FOR CLARITY PURPOSES.

THIS DOCUMENT CONSISTS OF 18 SHEETS AND EACH
SHEET SHALL NOT BE CONSIDERED VALID WITHOUT
SHEET 1.

CERTIFICATE:

I HEREBY CERTIFY THAT THESE RECORD DRAWINGS FOR THE
FACILITY HAVE BEEN REVIEWED BY ME OR BY INDIVIDUAL(S)
UNDER MY DIRECT SUPERVISION FOR COMPLETENESS AND
ADEQUACY, AND ARE TRUE AND CORRECT TO THE BEST OF MY
KNOWLEDGE AND BELIEF. THE FIELD WORK FOR THE AS-BUILT
DRAWINGS HAS BEEN DONE BY: Joseph L. Martin, P.S.M. #4368

DATE: 12/10/2021


BY:


JOSEPH L. MARTIN
PROFESSIONAL SURVEYOR
& MAPPER P.S.M. #4368
STATE OF FLORIDA

SIERRA RANCH
DAVIE, FL.


PROJ. TYPE	REVISION COMMENTS	DATE	BY	APP.
AS-BUILT CROSS SECTIONS	REVIS PER ENGINEER'S COMMENTS	05-18-21	L.A.	J.M.
1950 SOUTH HIATUS ROAD	REVISED TO ADD SECTIONS FROM 16 TO 36	11-8-21	L.A.	J.M.
SEC. 18, TWP. 50S. RGE. 41E	REVISED TO ADD SECTIONS FROM 37 TO 125	12-8-21	L.A.	G.B.
	REVISED PER ENGINEER'S COMMENTS	12-10-21	L.A.	G.B.

SCALE:	H:1"=10' / V:1"=10'
SURVEYOR:	COUNTY-WIDE
DRAWN BY:	LESLEY
CHECKED BY:	G.B.
AS-BUILT:	PRESERVE AREA
DATE:	04/14/2021
DRE PROJECT NO:	2019-043
SHEET NO:	5 of 18

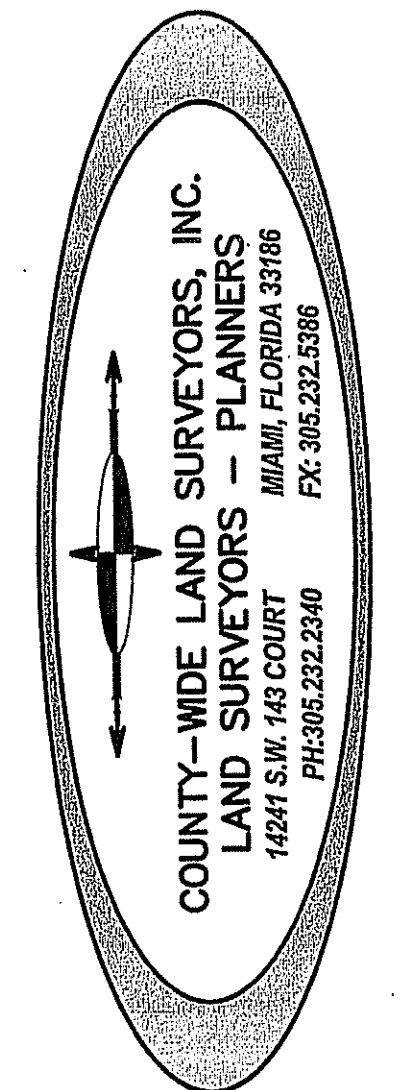


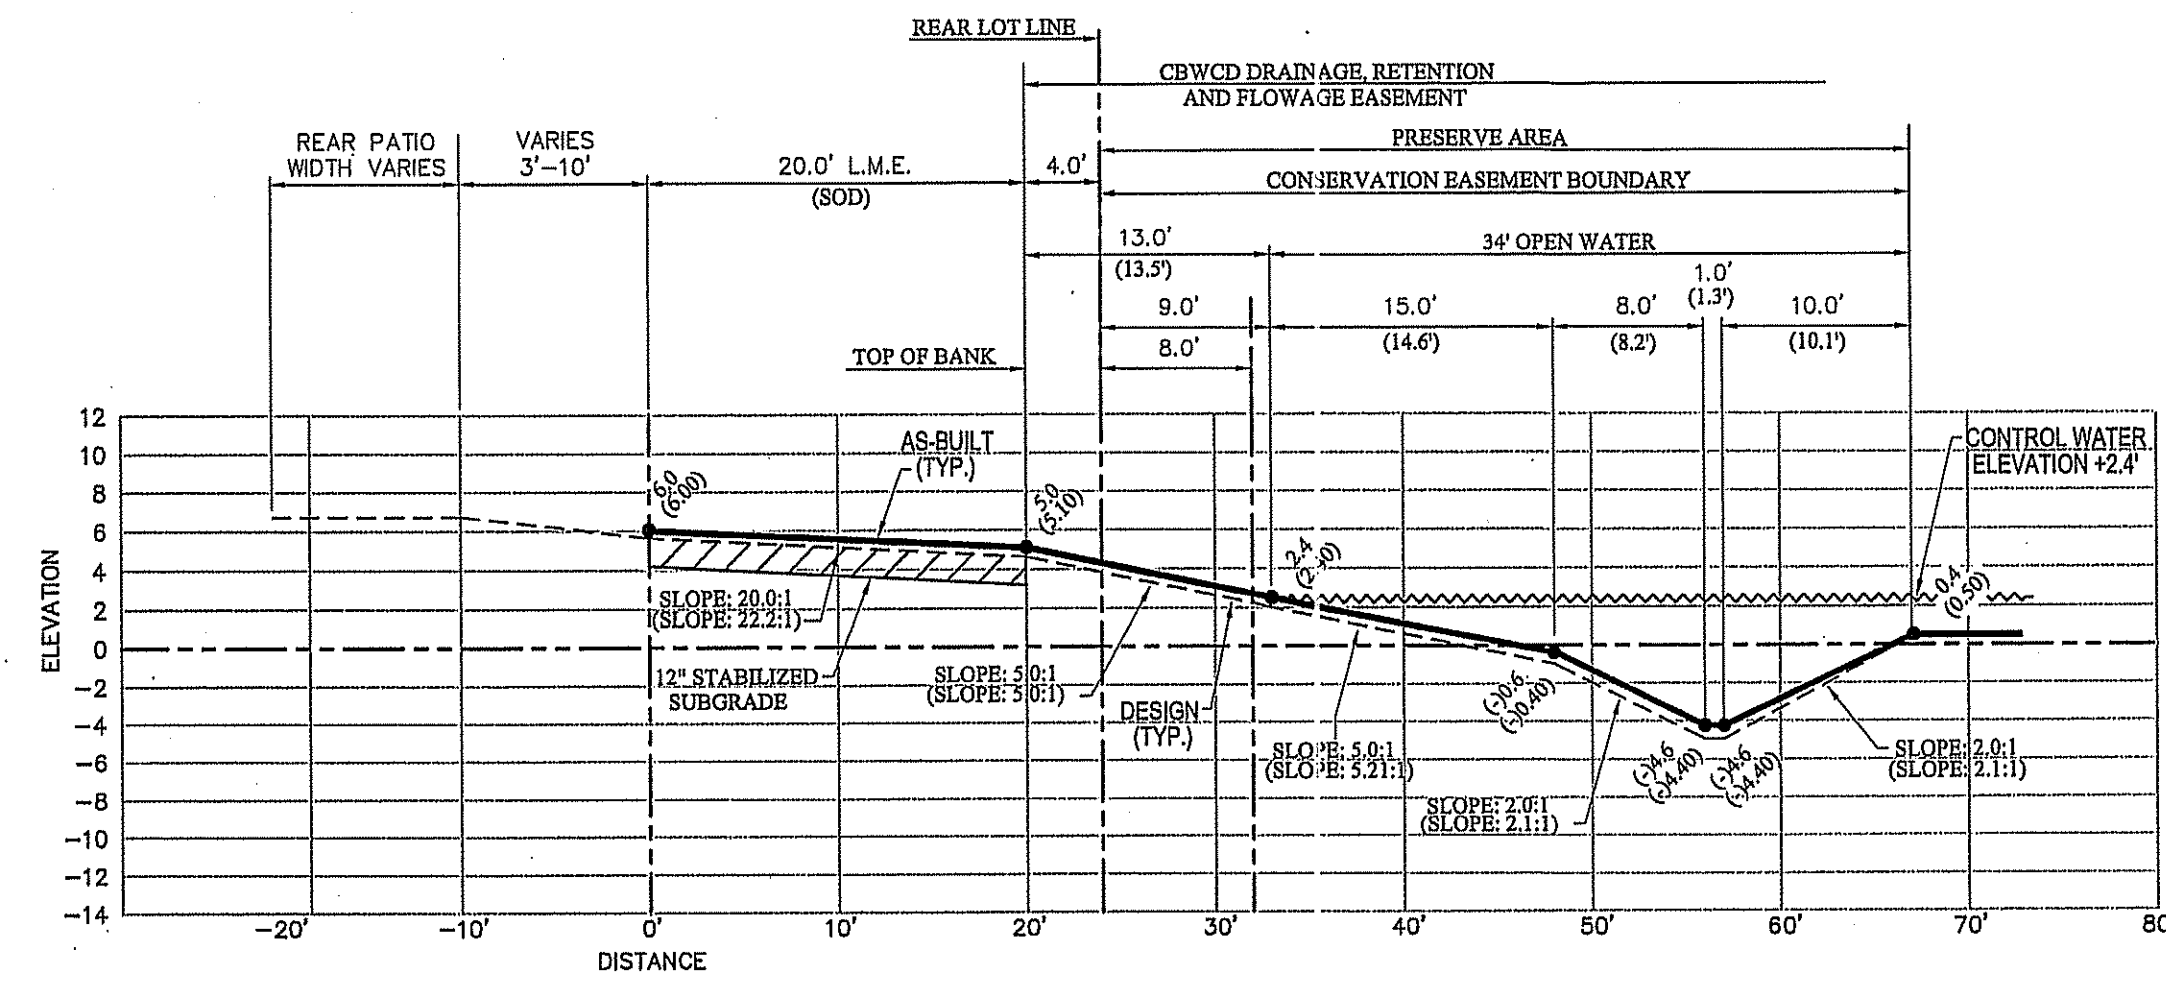


SECTION No. 22

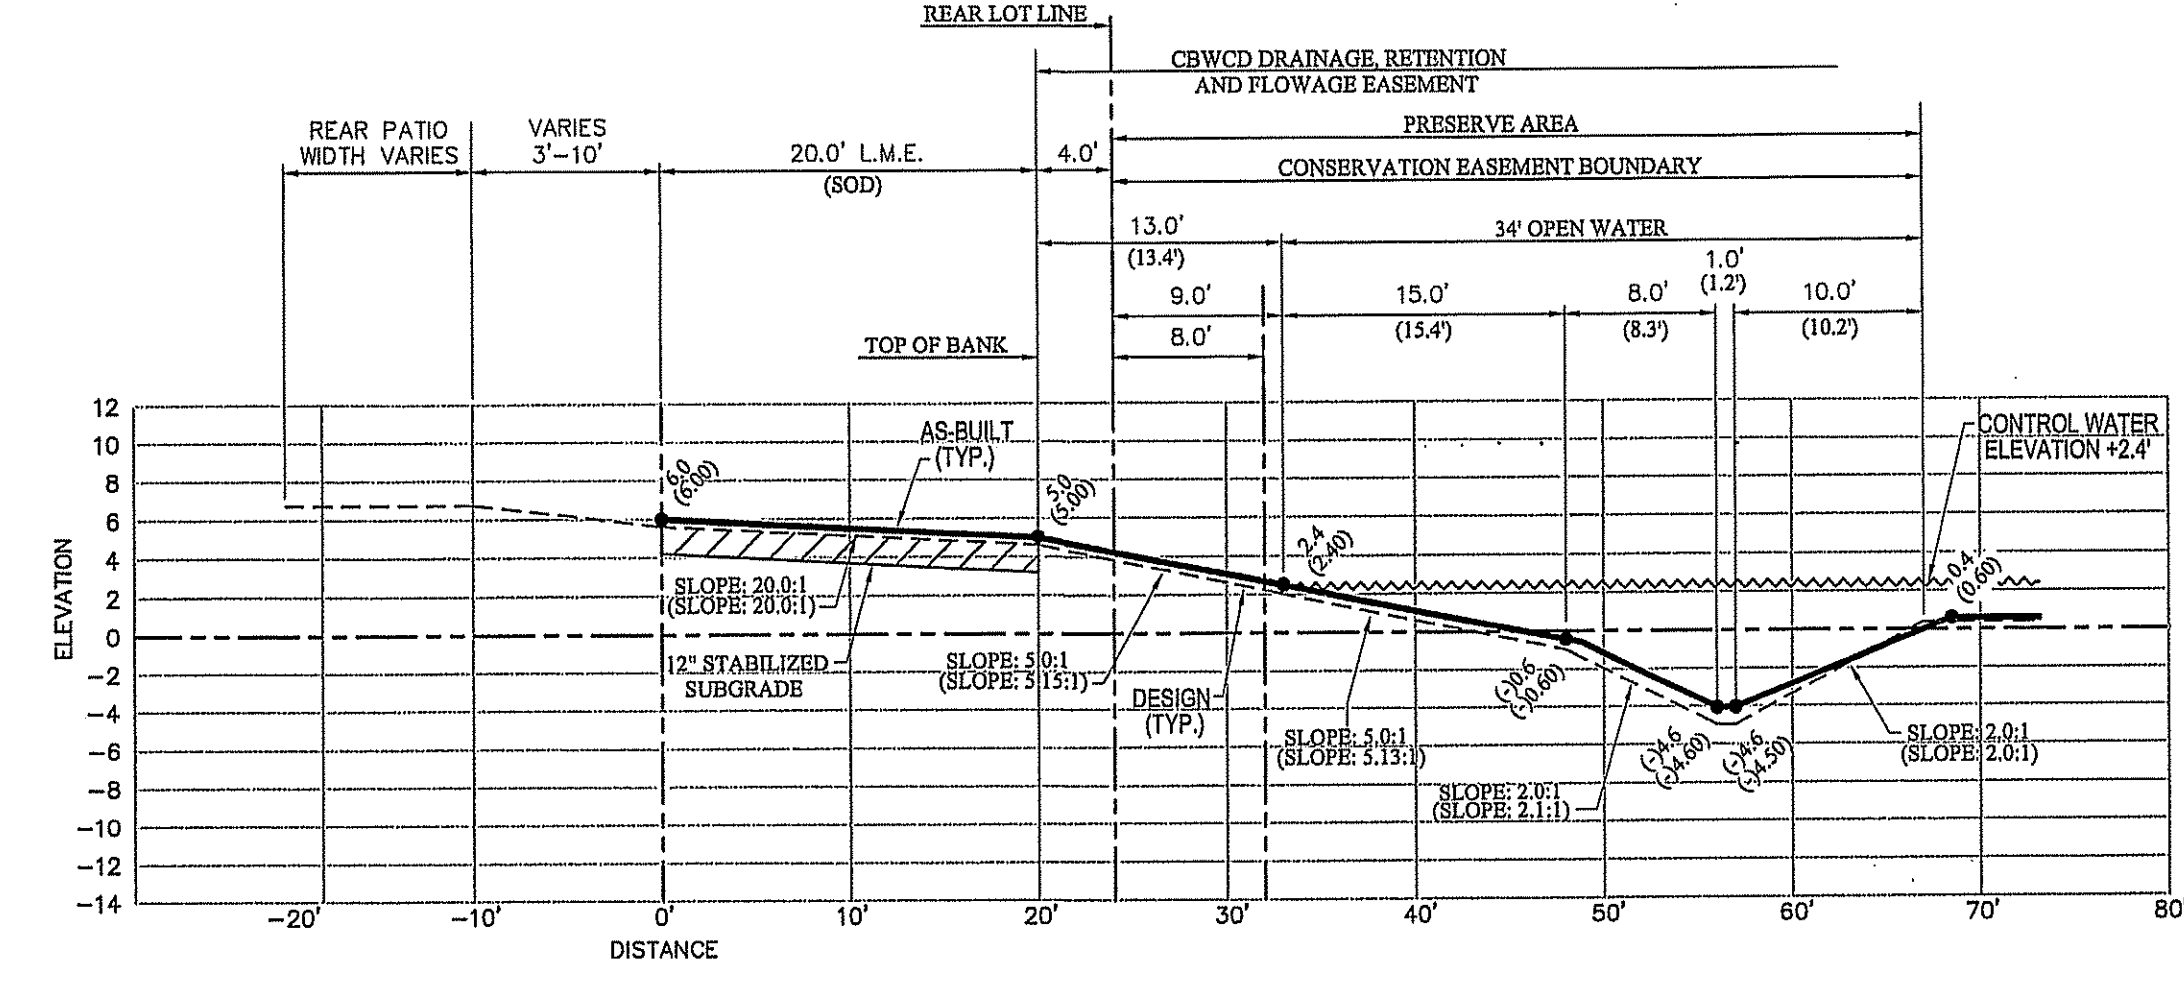


SECTION No. 23

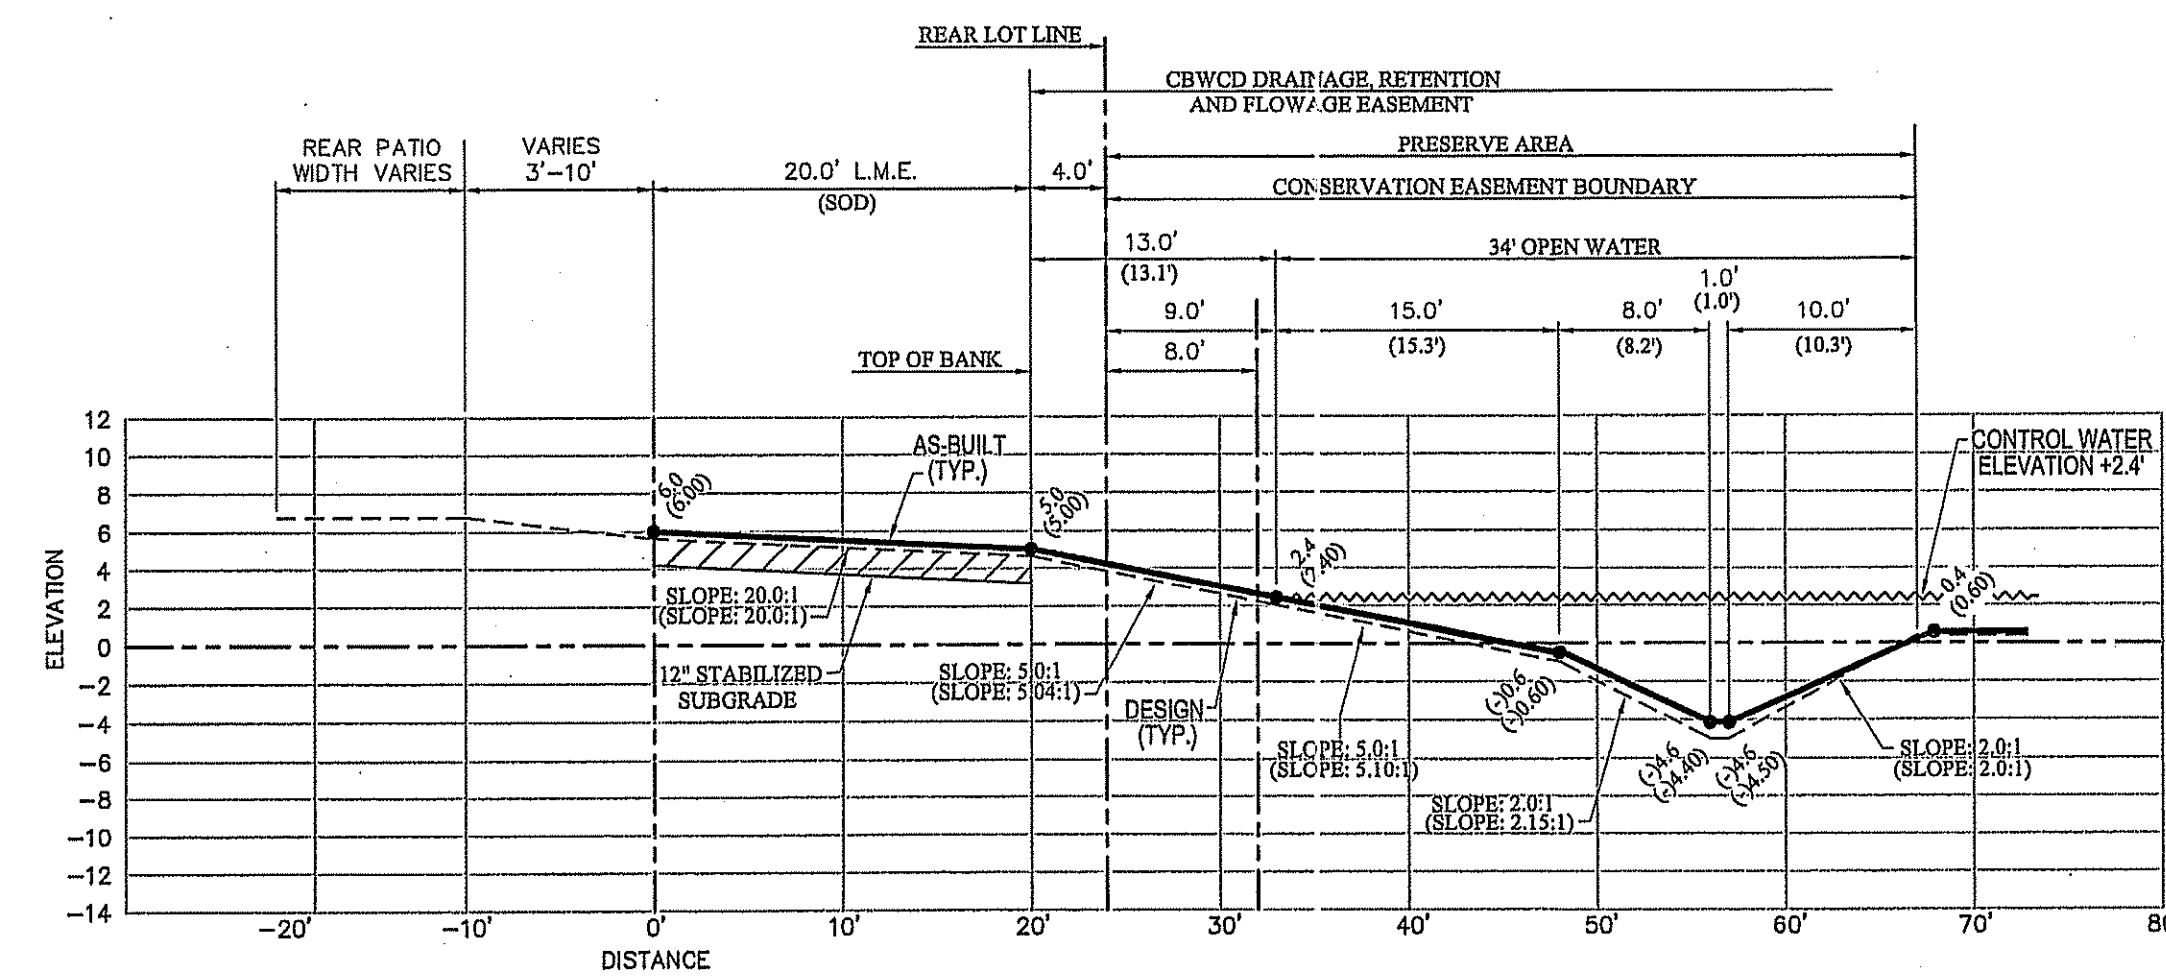


SECTION No. 24

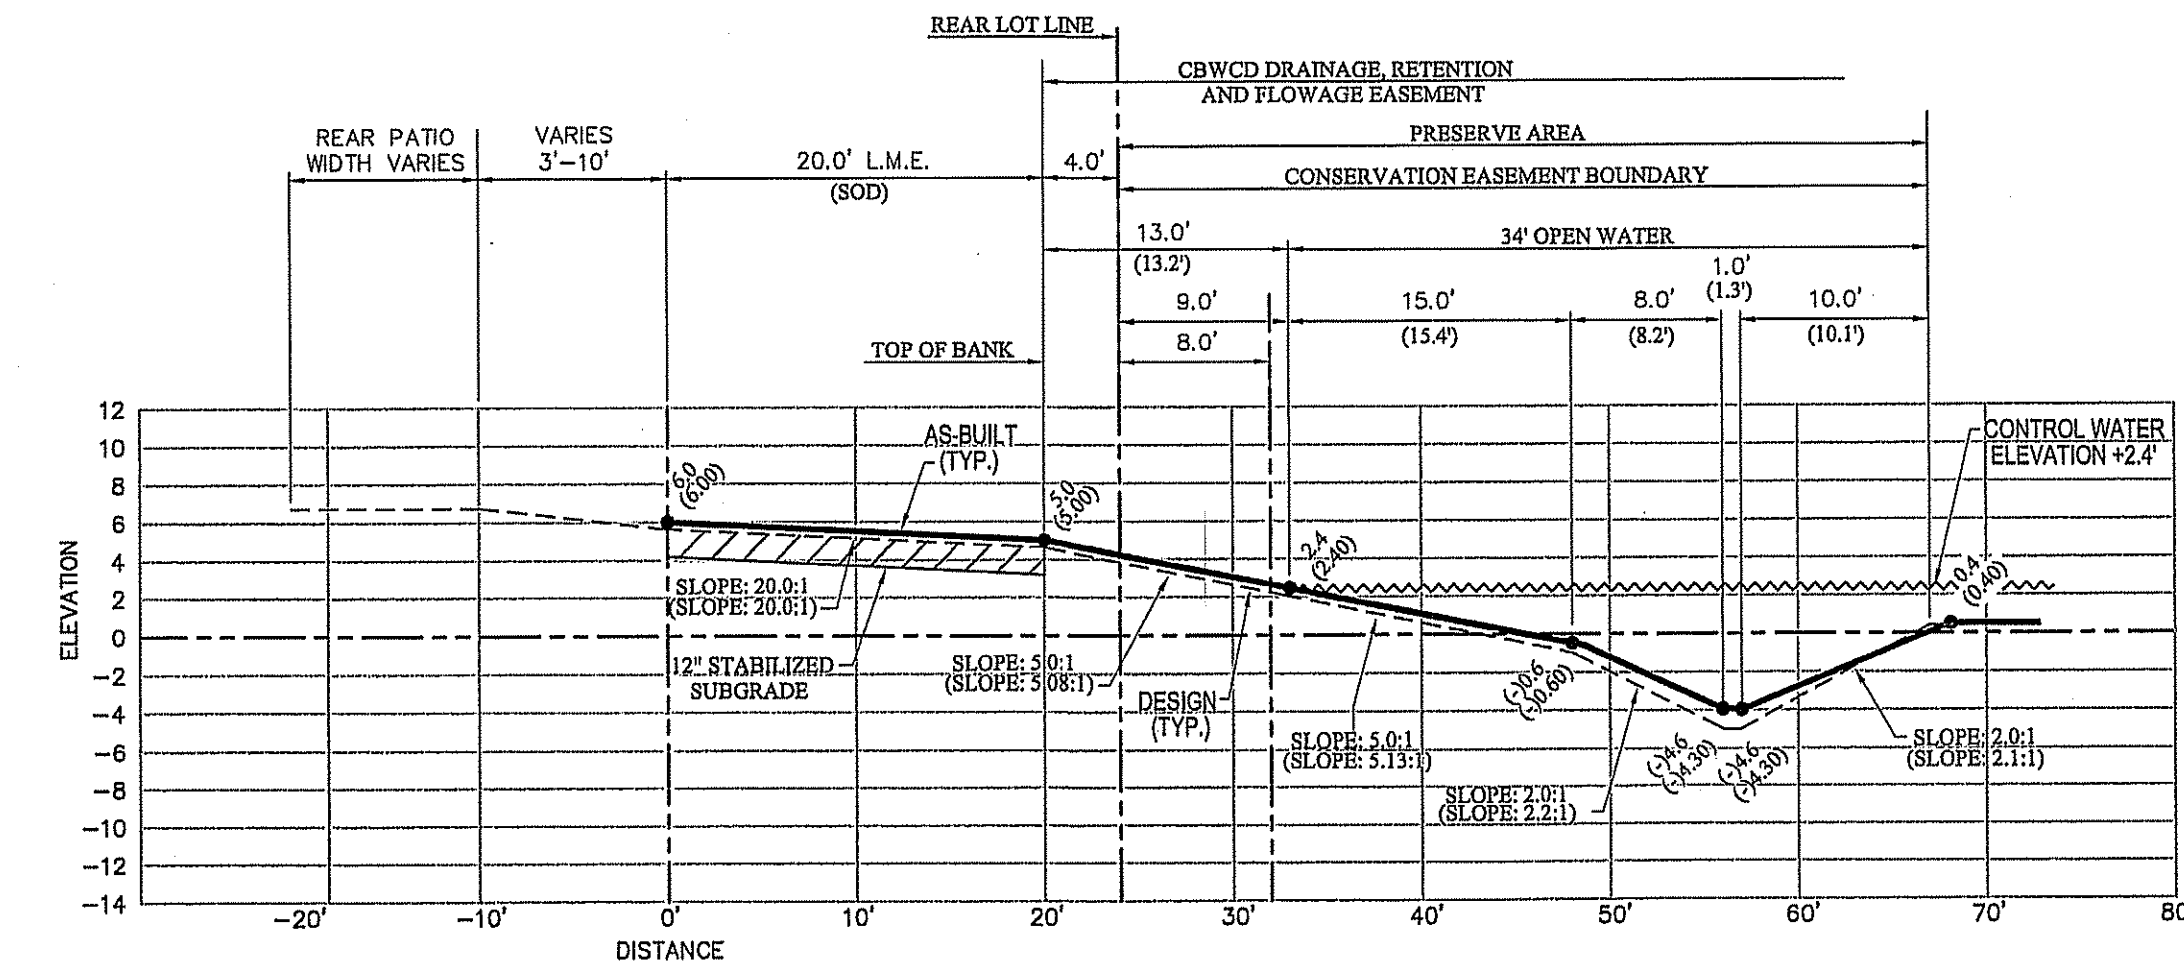

SECTION No. 25

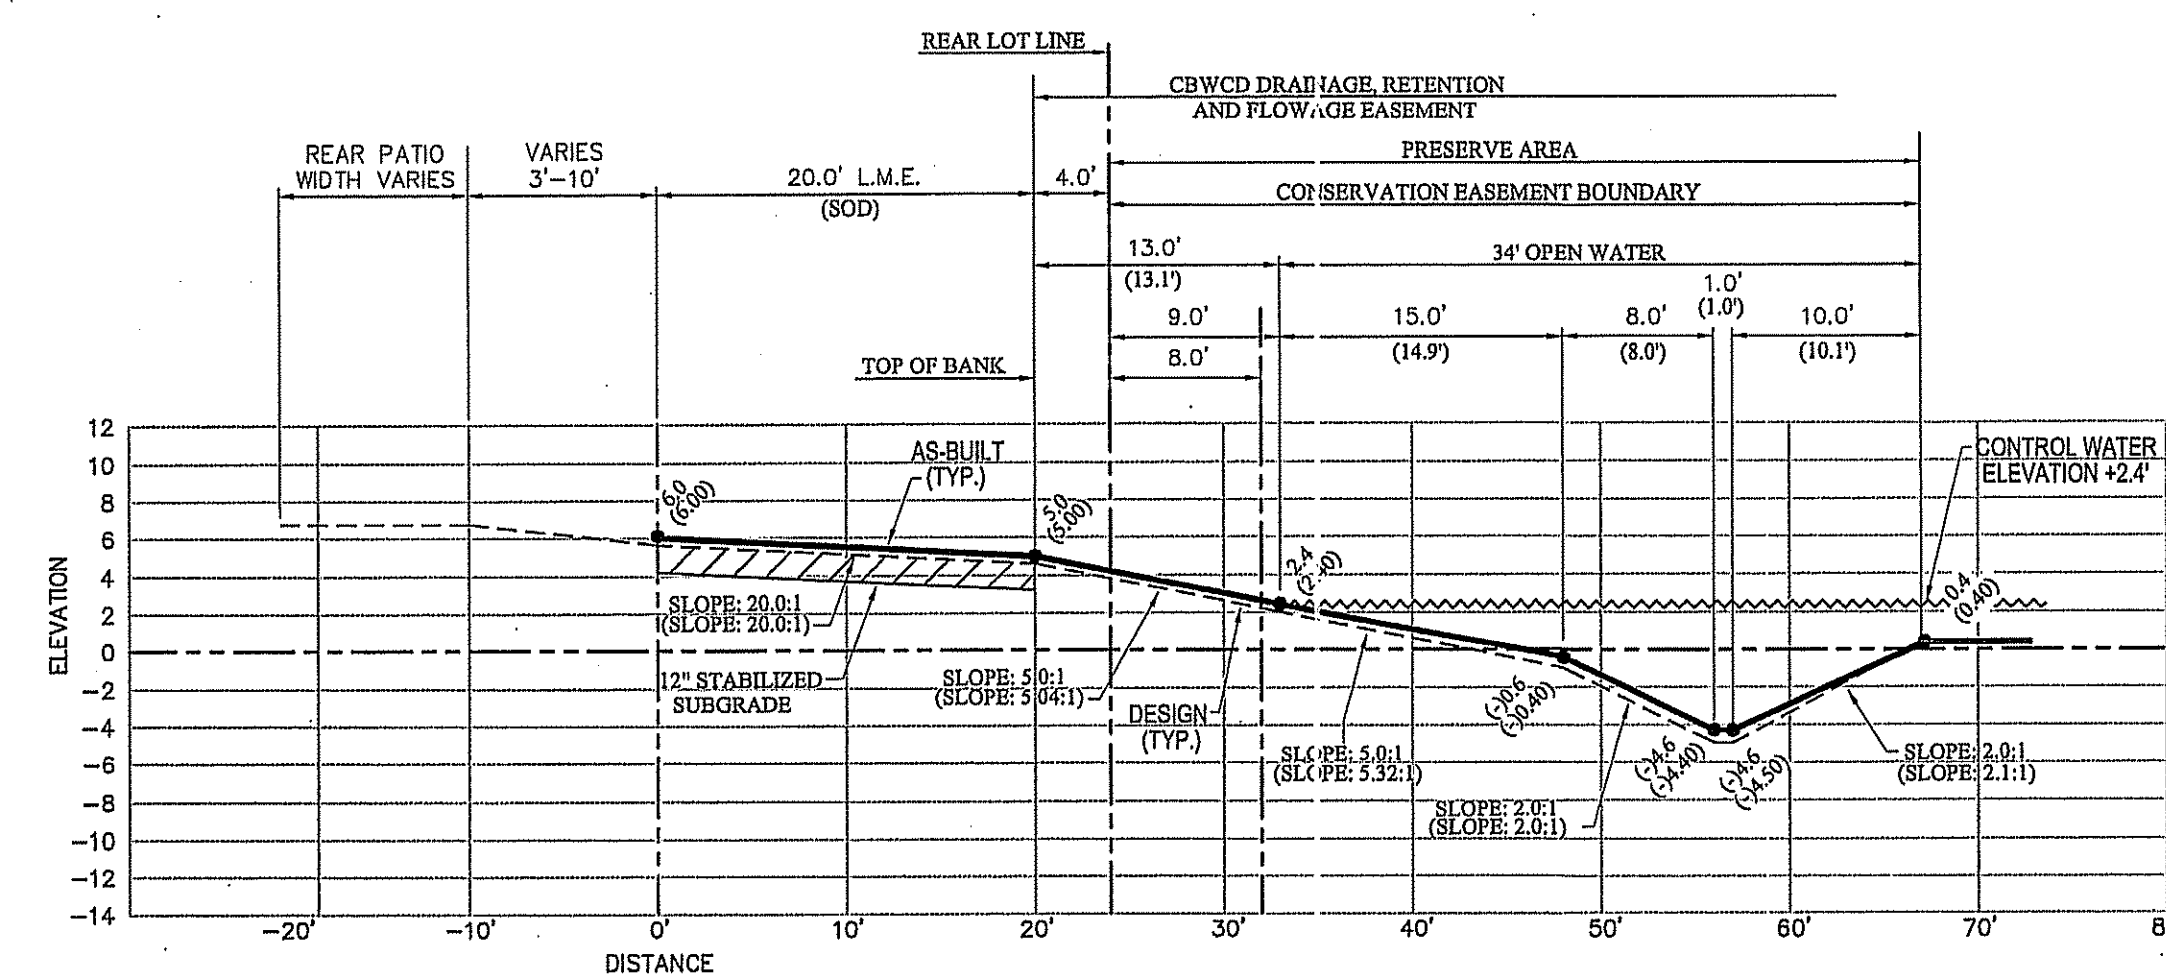

SECTION No. 26

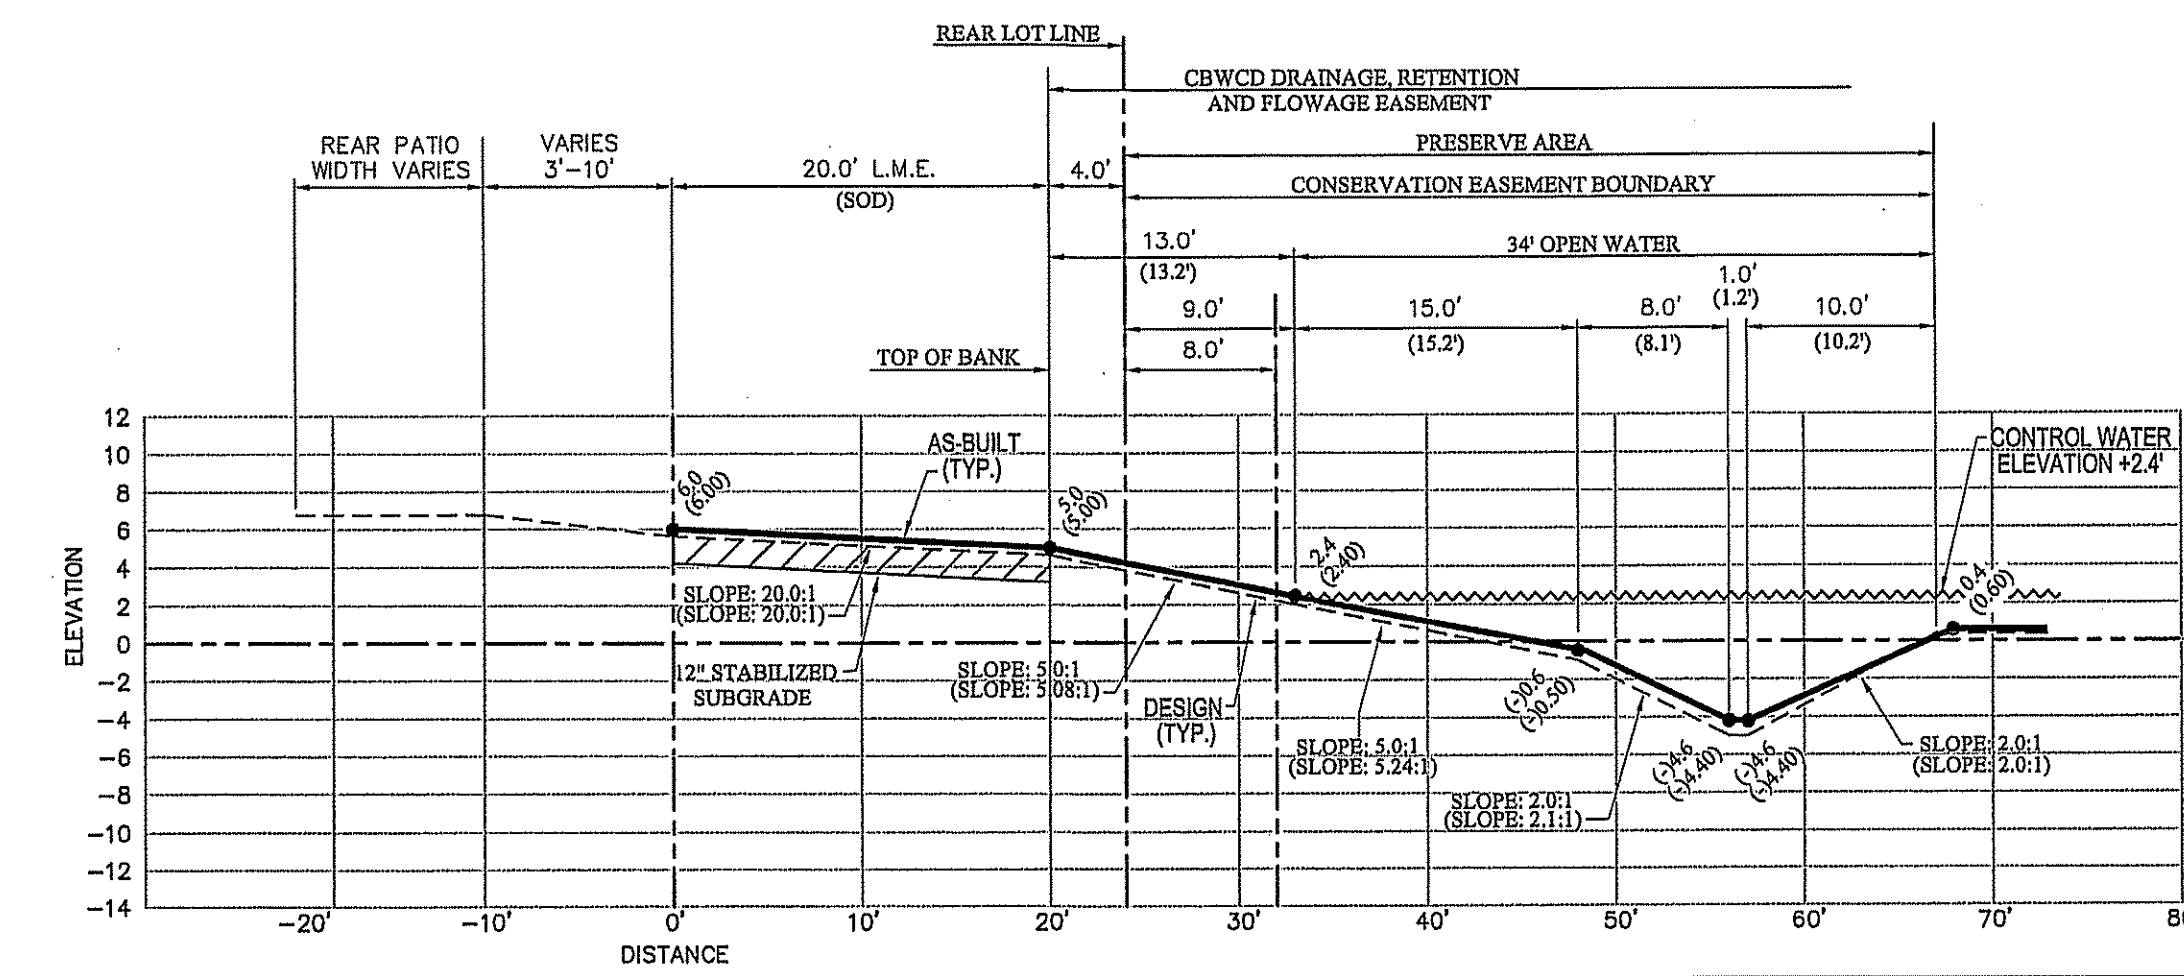

SECTION No. 27

Chad E. Edwards, State of Florida,
Professional Engineer, License No. 59306

This item has been digitally signed and sealed by
Chad E. Edwards, on the date indicated here.
Printed copies of this document are not
considered signed and sealed and the signature
must be verified on any electronic copies.

Chad Everett
Edwards

Digitally signed by
Chad Everett Edwards
Date: 2022.10.27
09:27:34 -04'00'

AS-BUILT LEGEND:

- (15.2) DENOTES AS-BUILT DISTANCE
- 15.0' DENOTES DESIGN DISTANCE
- 5.0 DENOTES AS-BUILT ELEVATION
- 5.0 DENOTES DESIGN ELEVATION
- (SLOPE: 20.2:1) DENOTES AS-BUILT SLOPE
- SLOPE: 20.0:1 DENOTES DESIGN SLOPE
- L.M.E. DENOTES LAKE MAINTENANCE EASEMENT
- DENOTES AS-BUILT LINE
- DENOTES DESIGN LINE

NOTE:

THE AS-BUILT LINEWORK SHOWN HEREON IS A GRAPHICAL REPRESENTATION
AND MAY NOT BE DRAWN TO SCALE FOR CLARITY PURPOSES.

CERTIFICATE:

I HEREBY CERTIFY THAT THESE RECORD DRAWINGS FOR THE
FACILITY HAVE BEEN REVIEWED BY ME OR BY INDIVIDUAL(S)
UNDER MY DIRECT SUPERVISION FOR COMPLETENESS AND
ADEQUACY, AND ARE TRUE AND CORRECT TO THE BEST OF MY
KNOWLEDGE AND BELIEF. THE FIELD WORK FOR THE AS-BUILT
DRAWINGS HAS BEEN DONE BY: Joseph L. Martin, P.E. M. 8558

DATE: 12/10/2021


BY: JOSEPH L. MARTIN
PROFESSIONAL SURVEYOR
& MAPPER
STATE OF FLORIDA
License Number: 288

THIS DOCUMENT CONSISTS OF 18 SHEETS AND EACH
SHEET SHALL NOT BE CONSIDERED VALID WITHOUT
SHEET 1.

SIERRA RANCH
DAVIE, FL.

AS-BUILT CROSS SECTIONS
1950 SOUTH HIATUS ROAD
SEC. 18, TWP. 50S, RGE. 41E


SCALE: H:1"=10' / V:1"=10'
SURVEYOR: COUNTY-WIDE
DRAWN BY: LESLY
CHECKED BY: G.B.
AS-BUILT: PRESERVE AREA
DATE: 04/14/2021
DRE PROJECT No: 2019-043
SHEET No: 6 of 18

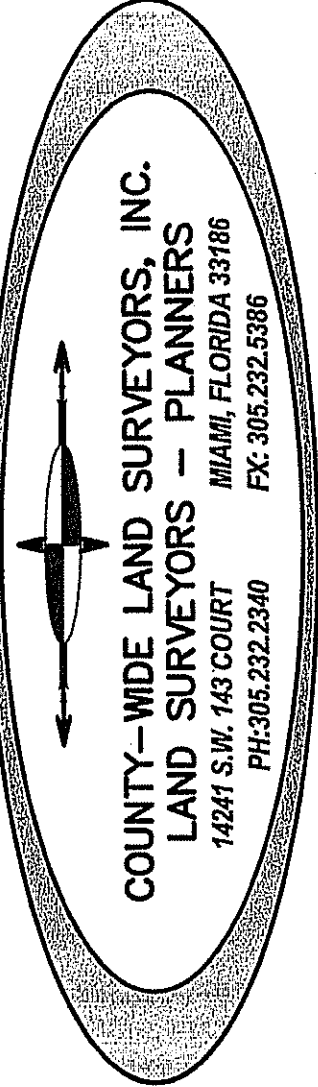

BY APP
L.A. J.M.
L.A. J.M.
L.A. G.B.
L.A. G.B.

REVISION COMMENTS
REVISED PER ENGINEER'S COMMENTS
REVISED TO ADD SECTIONS FROM 16 TO 36
REVISED TO ADD SECTIONS FROM 37 TO 125
REVISED PER ENGINEER'S COMMENTS

DATE
05-18-21
11-8-21
12-8-21
12-10-21

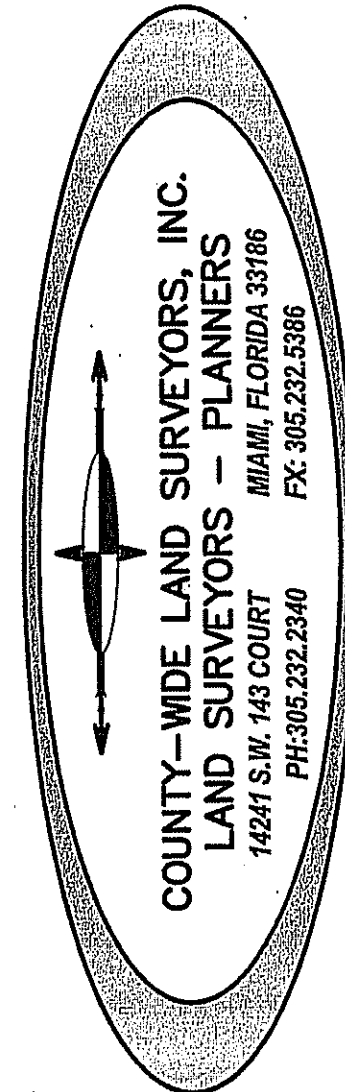


SIERRA RANCH
DAVIE, FL.


BY	APP	REVISION COMMENTS	DATE
L.A.	J.M.	REVISED PER ENGINEER'S COMMENTS	05-18-21
L.A.	J.M.	REVISED TO ADD SECTIONS FROM 16 TO 36	11-8-21
L.A.	G.B.	REVISED TO ADD SECTIONS FROM 37 TO 125	12-8-21
L.A.	G.B.	REVISED PER ENGINEER'S COMMENTS	12-10-21

AS-BUILT CROSS SECTIONS
1950 SOUTH HIATUS ROAD
SEC. 18, TWP. 50S, RGE. 41E


SCALE:	H:1"=10' / V:1"=10'
SURVEYOR:	COUNTY-WIDE
DRAWN BY:	LESLY
CHECKED BY:	G.B.
AS-BUILT:	PRESERVE AREA
DATE:	04/14/2021
DRE PROJECT No:	2019-043
SHEET No:	7 of 18

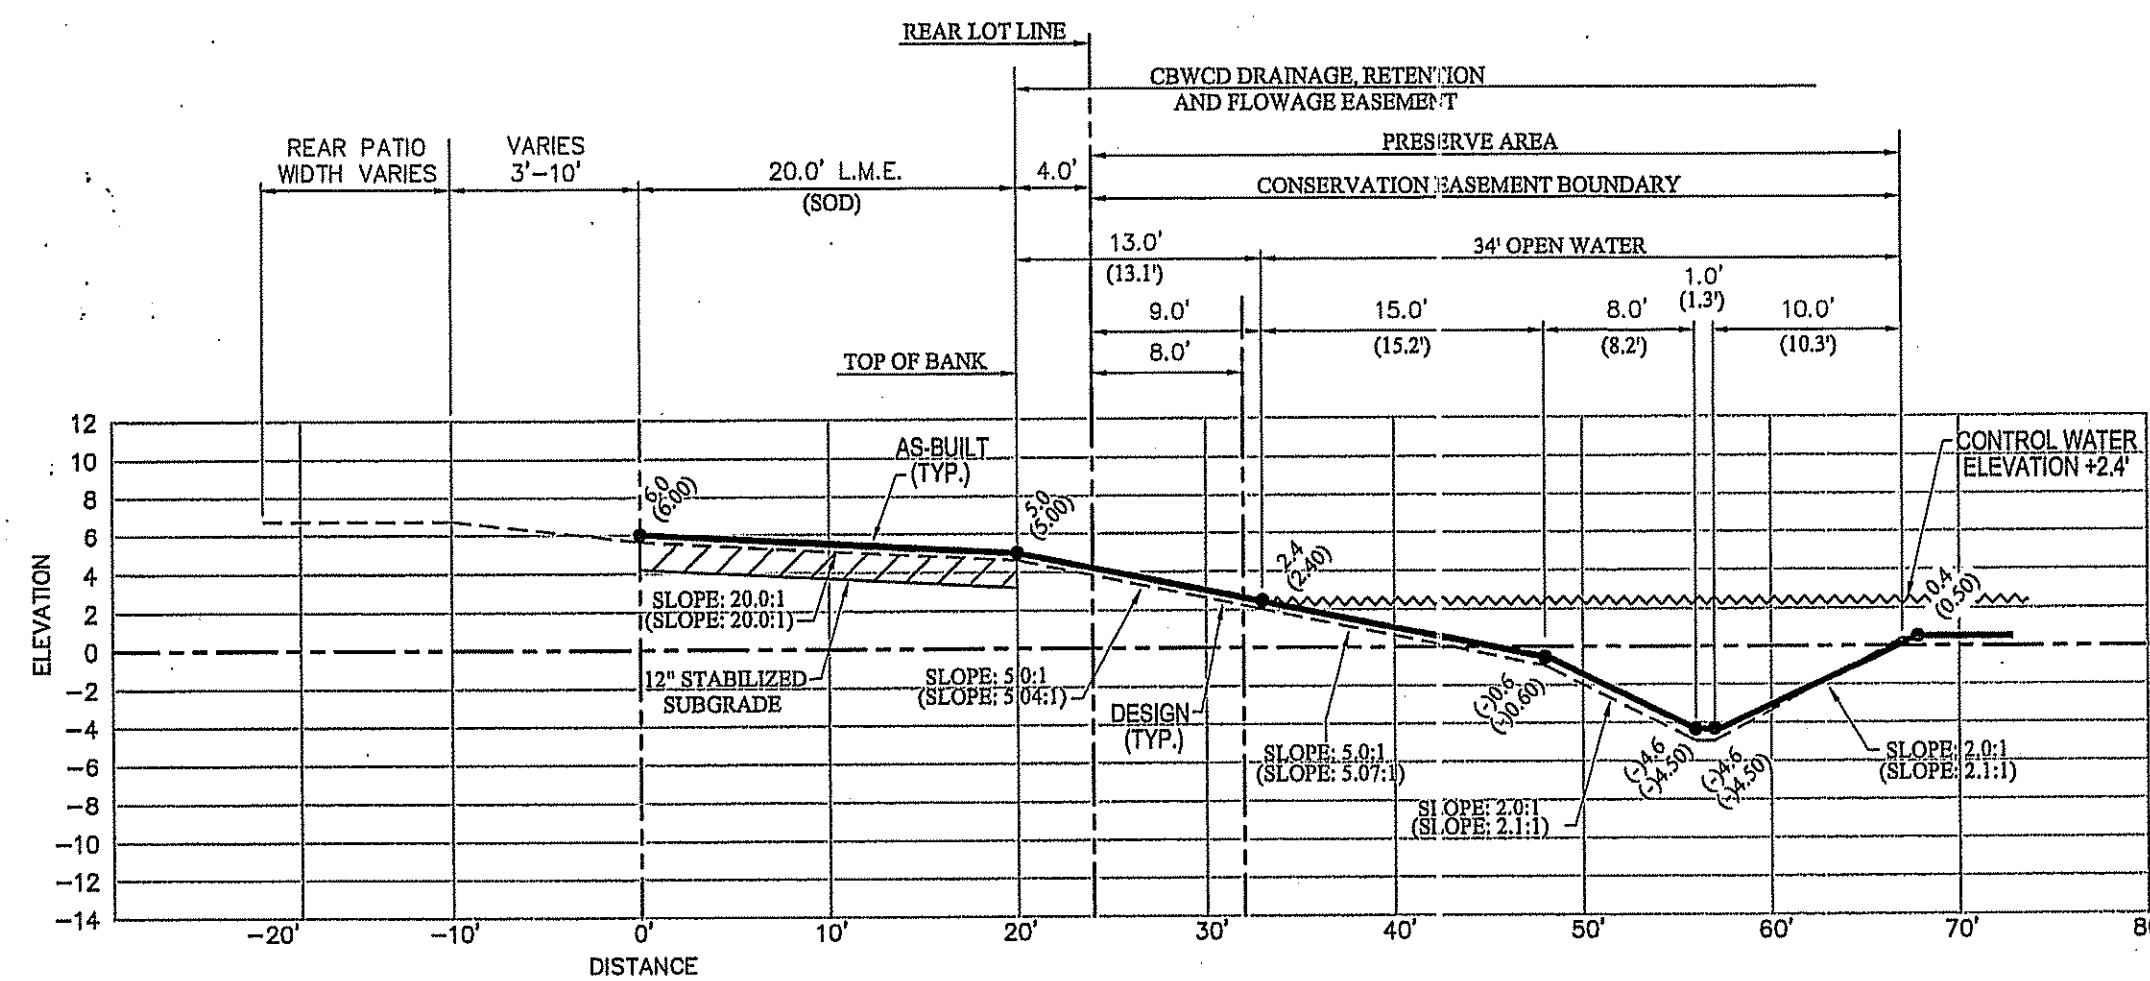


SECTION No. 28

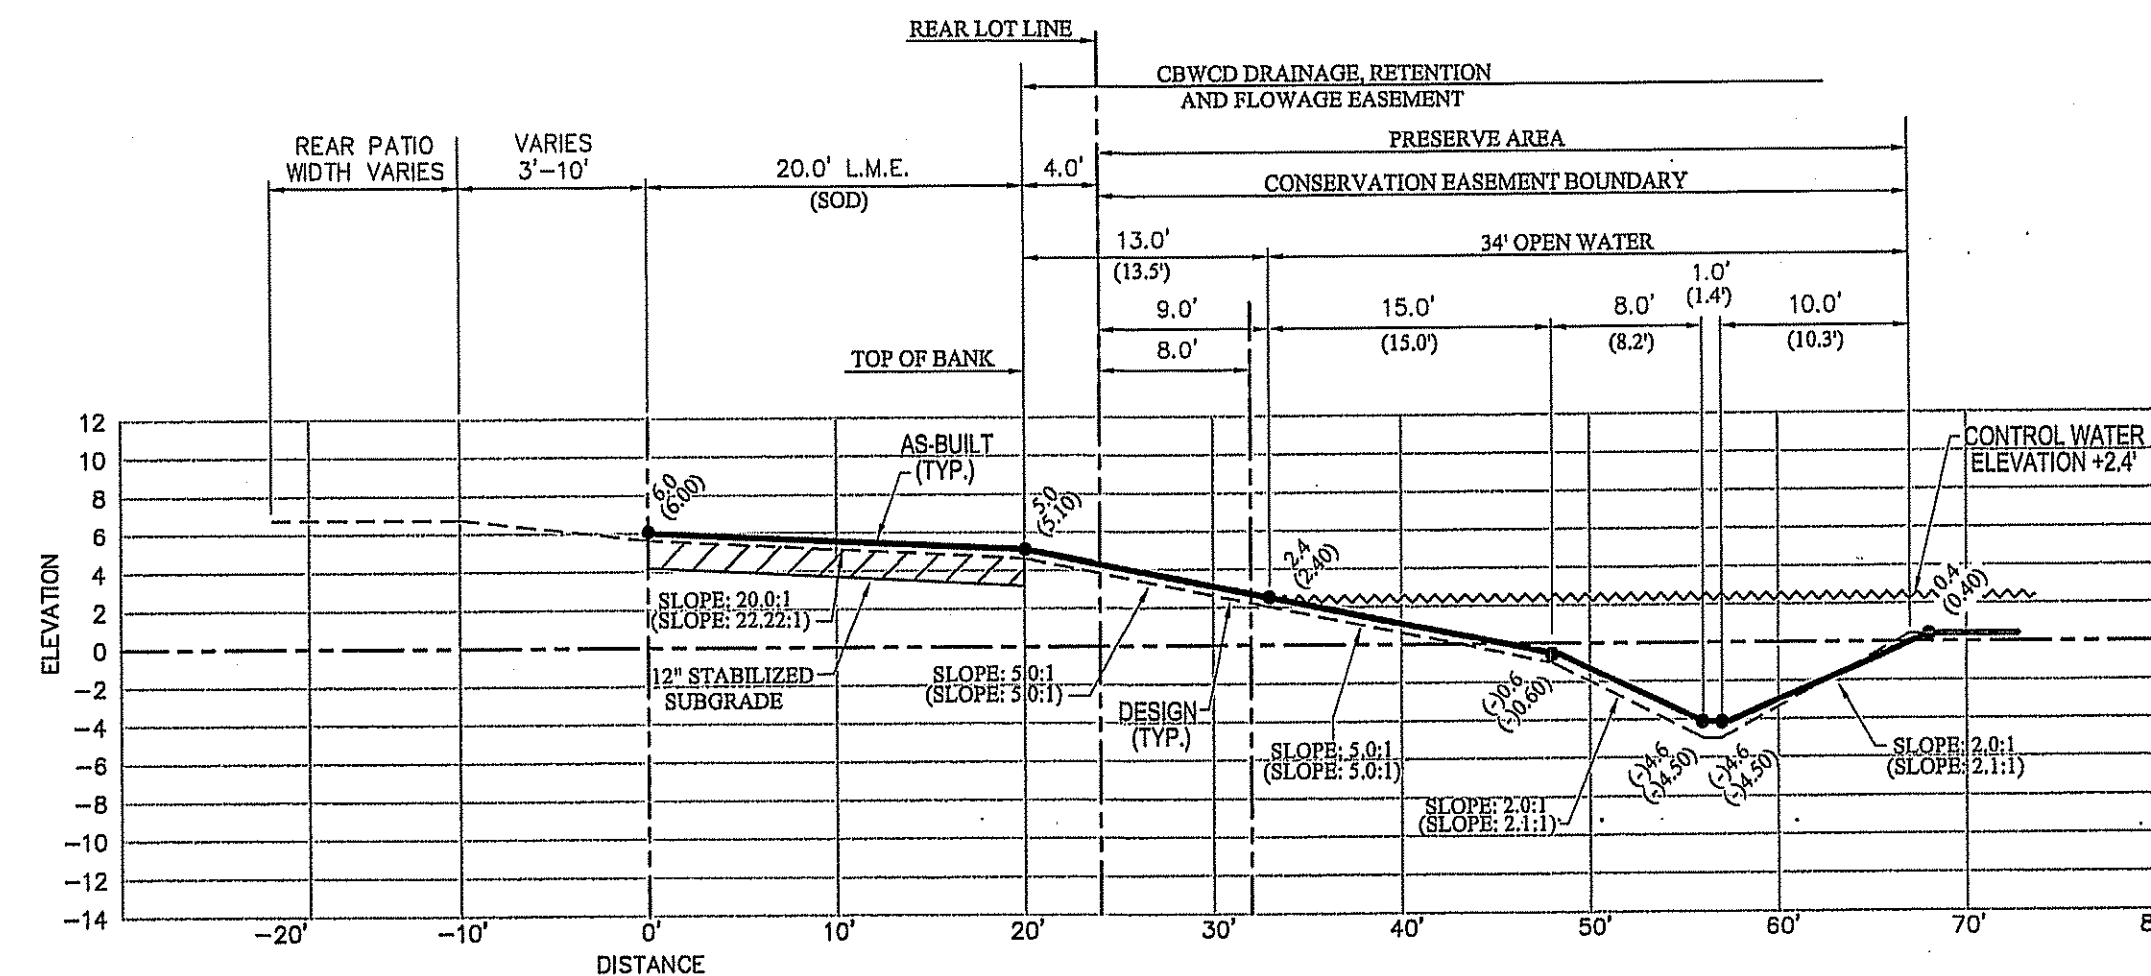


SECTION No. 29

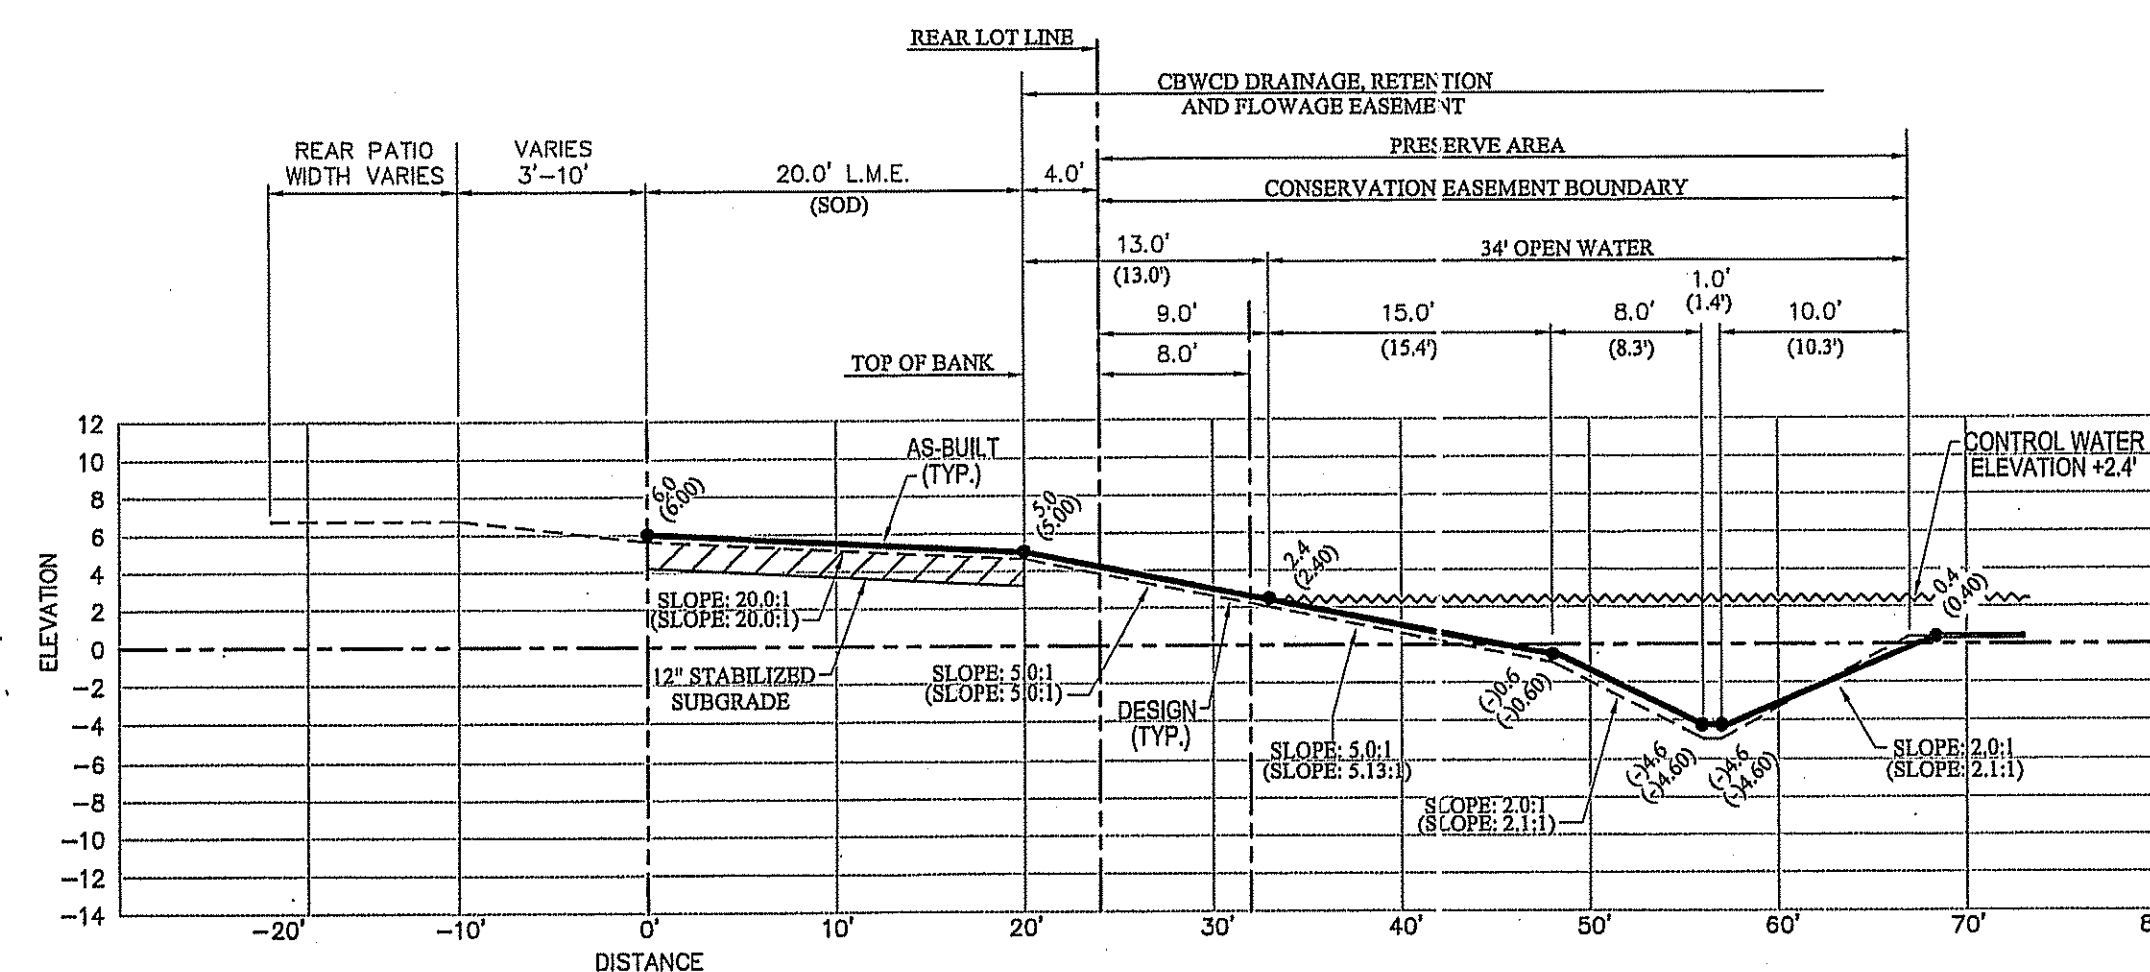


SECTION No. 30

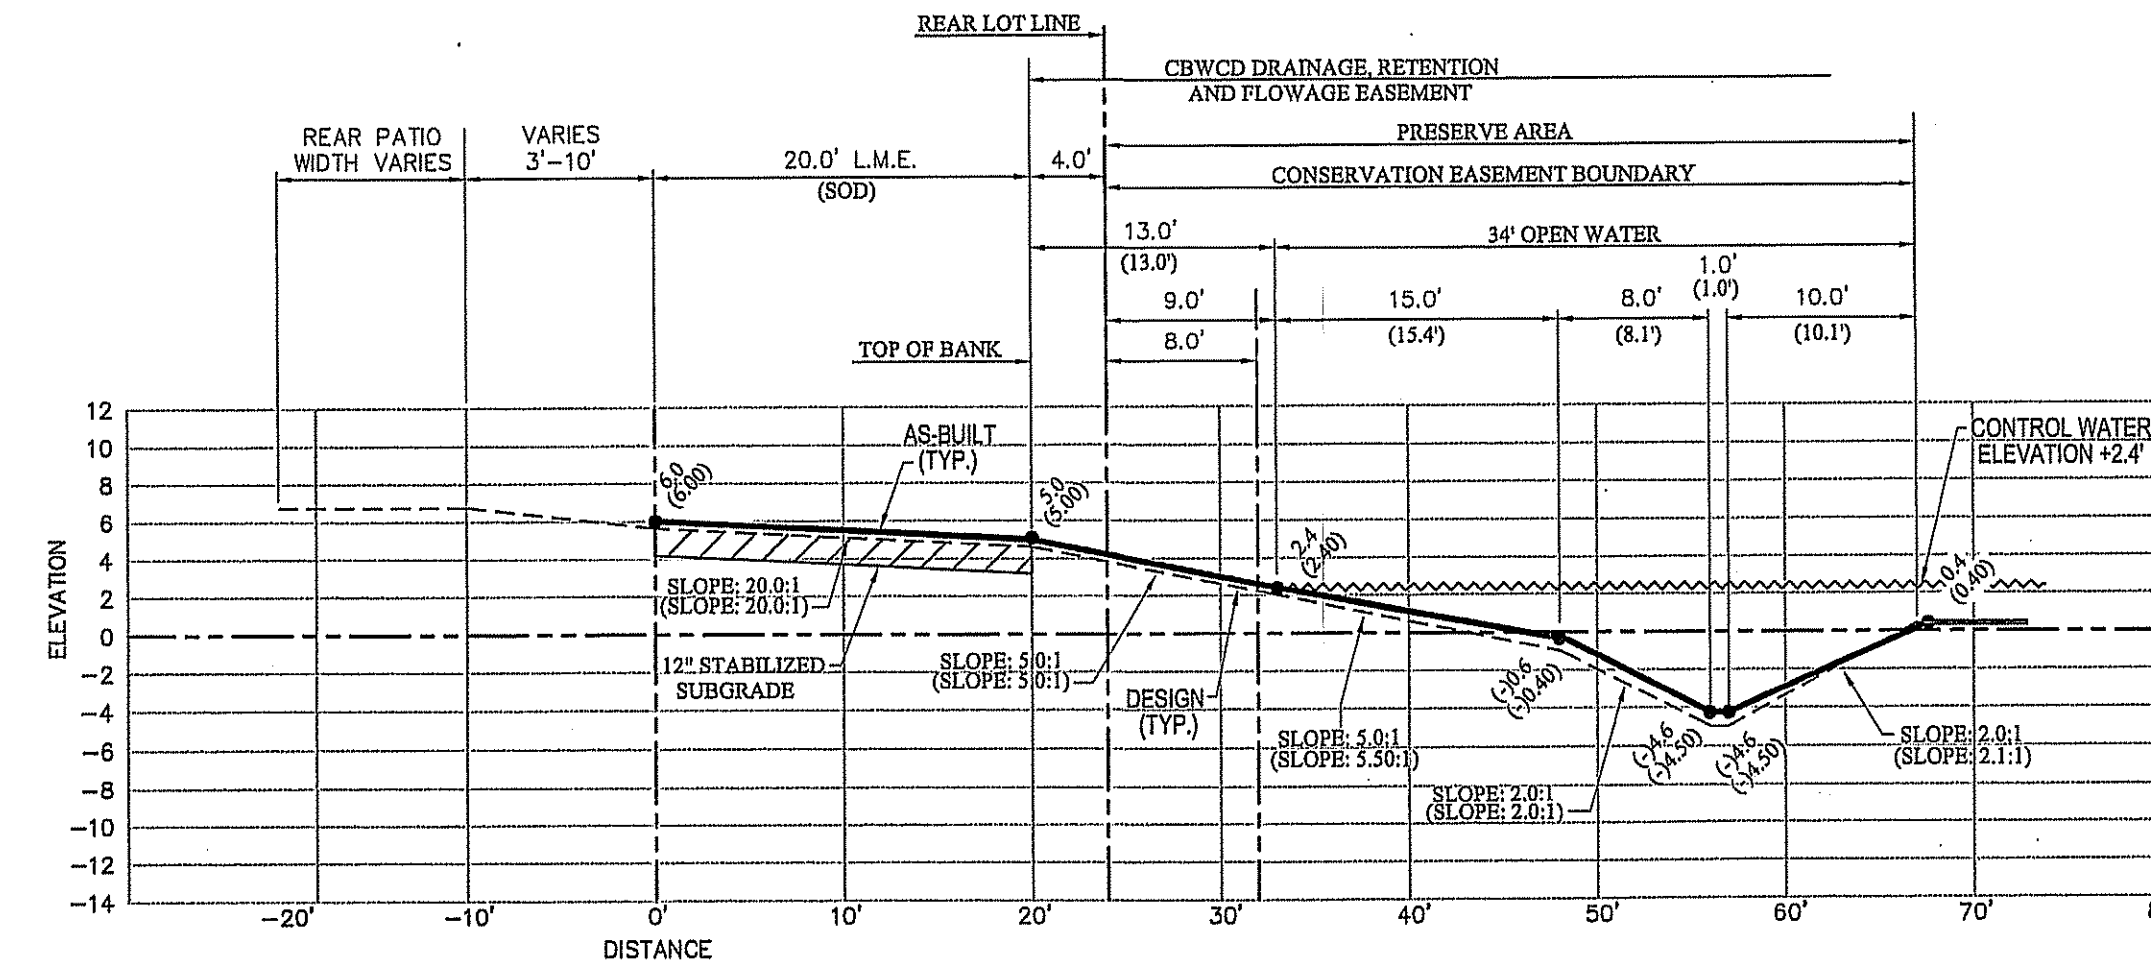

SECTION No. 31

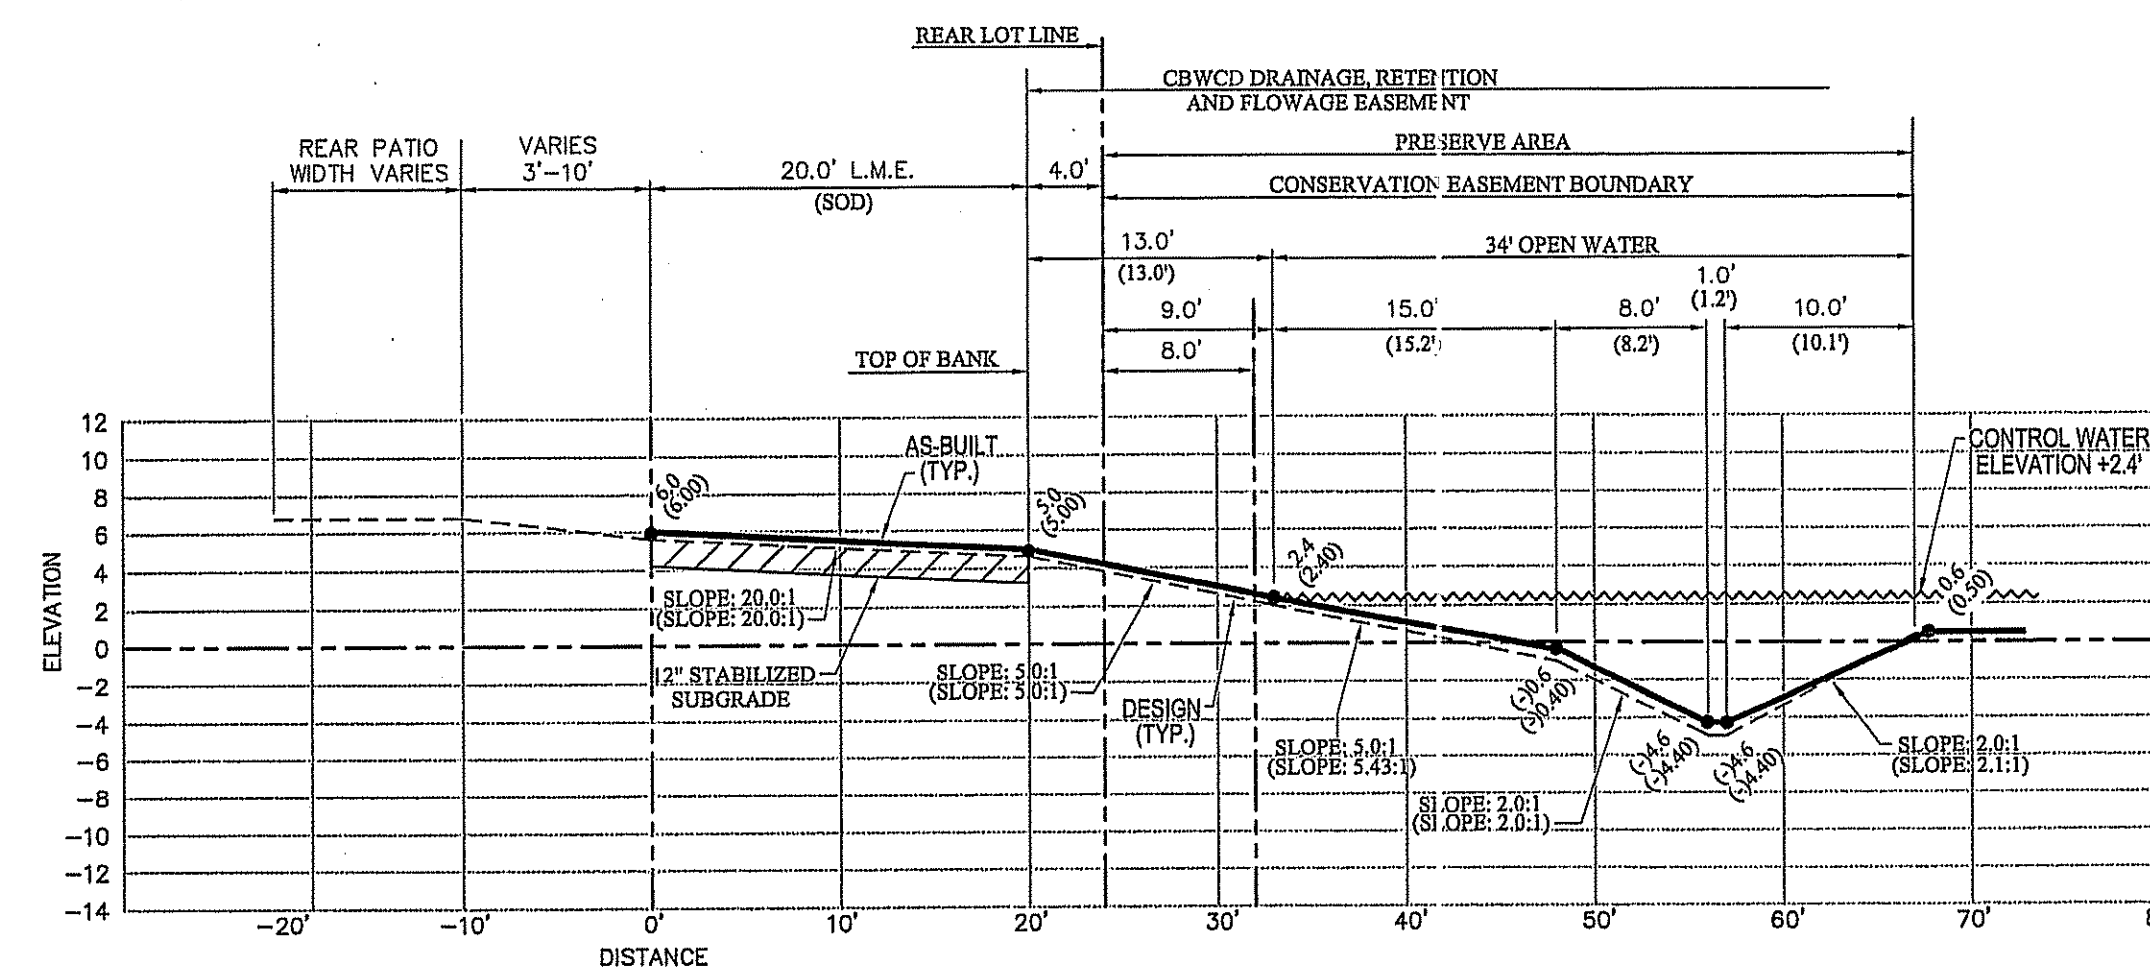

SECTION No. 32

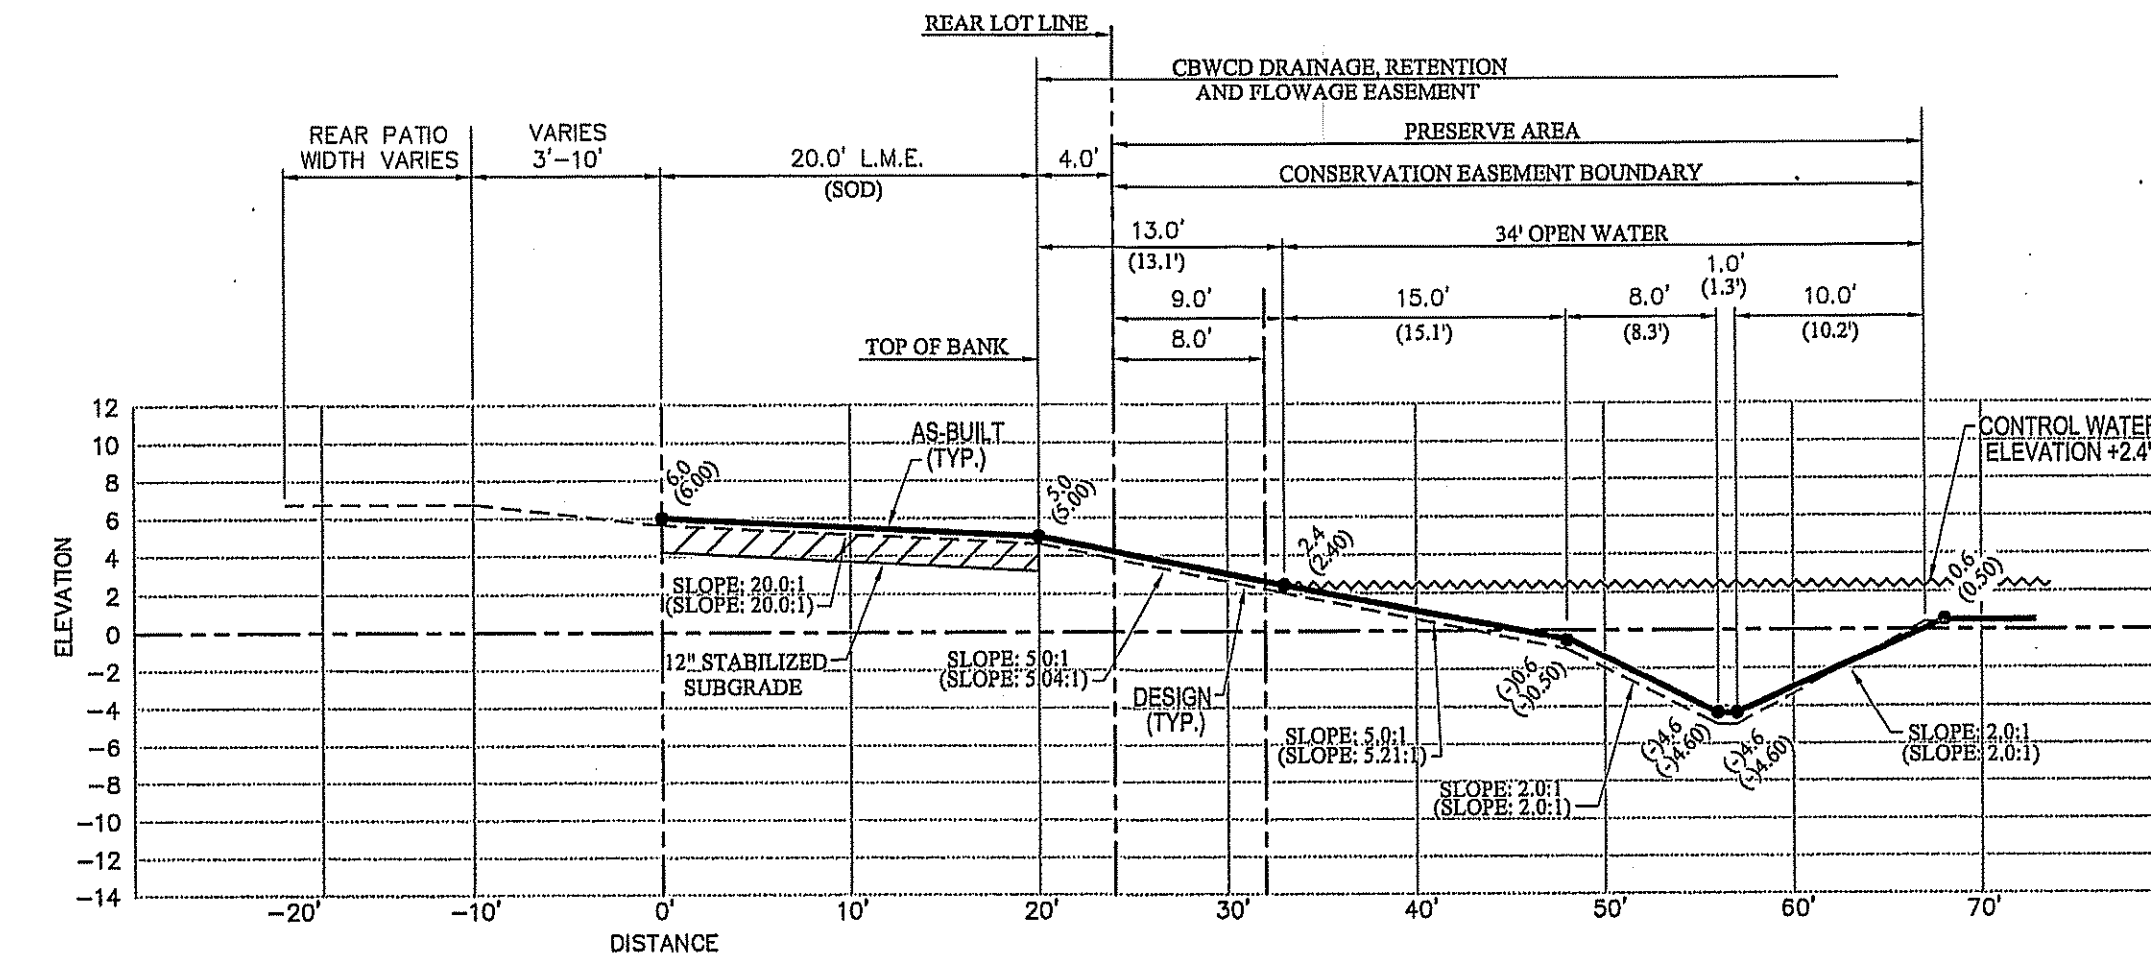

SECTION No. 33

AS-BUILT LEGEND:


- (15.2) DENOTES AS-BUILT DISTANCE
- 15.0' DENOTES DESIGN DISTANCE
- 5.0 DENOTES AS-BUILT ELEVATION
- 5.0 DENOTES DESIGN ELEVATION
- (SLOPE: 20.2:1) DENOTES AS-BUILT SLOPE
- SLOPE: 20.0:1 DENOTES DESIGN SLOPE
- L.M.E. DENOTES LAKE MAINTENANCE EASEMENT
- DENOTES AS-BUILT LINE
- - - DENOTES DESIGN LINE

NOTE:

THE AS-BUILT LINEWORK SHOWN HEREON IS A GRAPHICAL REPRESENTATION AND MAY NOT BE DRAWN TO SCALE FOR CLARITY PURPOSES.

CERTIFICATE:
I HEREBY CERTIFY THAT THESE RECORD DRAWINGS FOR THE FACILITY HAVE BEEN REVIEWED BY ME OR BY INDIVIDUAL(S) UNDER MY DIRECT SUPERVISION FOR COMPLETENESS AND ADEQUACY, AND ARE TRUE AND CORRECT TO THE BEST OF MY KNOWLEDGE AND BELIEF. THE FIELD WORK FOR THE AS-BUILT DRAWINGS HAS BEEN DONE BY: Joseph L. Martin, P.S.M. #4388
10/20/2022

DATE: 12/10/2021

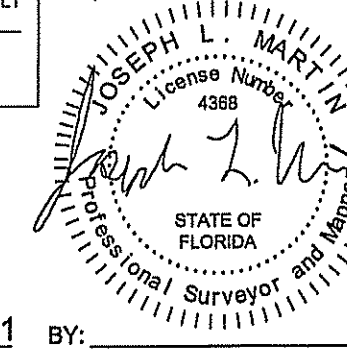


JOSEPH L. MARTIN
PROFESSIONAL SURVEYOR
& MAPPER PSM# 4388
STATE OF FLORIDA

THIS DOCUMENT CONSISTS OF 18 SHEETS AND EACH SHEET SHALL NOT BE CONSIDERED VALID WITHOUT SHEET 1.

Chad E. Edwards, State of Florida,
Professional Engineer, License No. 59308

This item has been digitally signed and sealed by
Chad E. Edwards, on the date indicated here.
Printed copies of this document are not
considered signed and sealed and the signature
must be verified on any electronic copies.

Chad Everett
Edwards
Digitally signed by
Chad Everett Edwards
Date: 2022.10.27
09:27:58 -04'00'

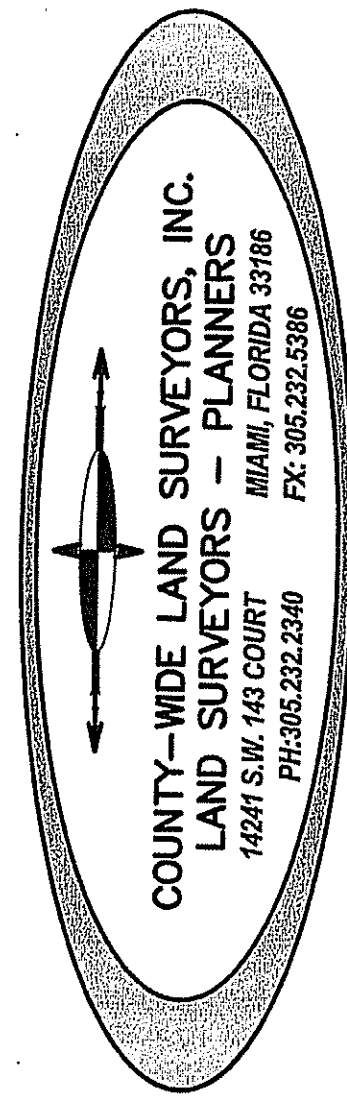


SIERRA RANCH
DAVIE, FL.


BY	APP	REVISION COMMENTS	DATE
L.A.	J.M.	REVISED PER ENGINEER'S COMMENTS	05-18-21
L.A.	J.M.	REVISED TO ADD SECTIONS FROM 16 TO 36	11-8-21
L.A.	J.M.	REVISED TO ADD SECTIONS FROM 37 TO 125	12-8-21
L.A.	G.B.	REVISED PER ENGINEER'S COMMENTS	12-10-21

AS-BUILT CROSS SECTIONS
1950 SOUTH HIATUS ROAD
SEC. 18, TWP. 50S, RGE. 41E


SCALE:	H:1"=10' / V:1"=10'
SURVEYOR:	COUNTY-WIDE
DRAWN BY:	LESLEY
CHECKED BY:	G.B.
AS-BUILT:	PRESERVE AREA
DATE:	04/14/2021
DRE PROJECT No:	2019-043
SHEET No:	8 of 18

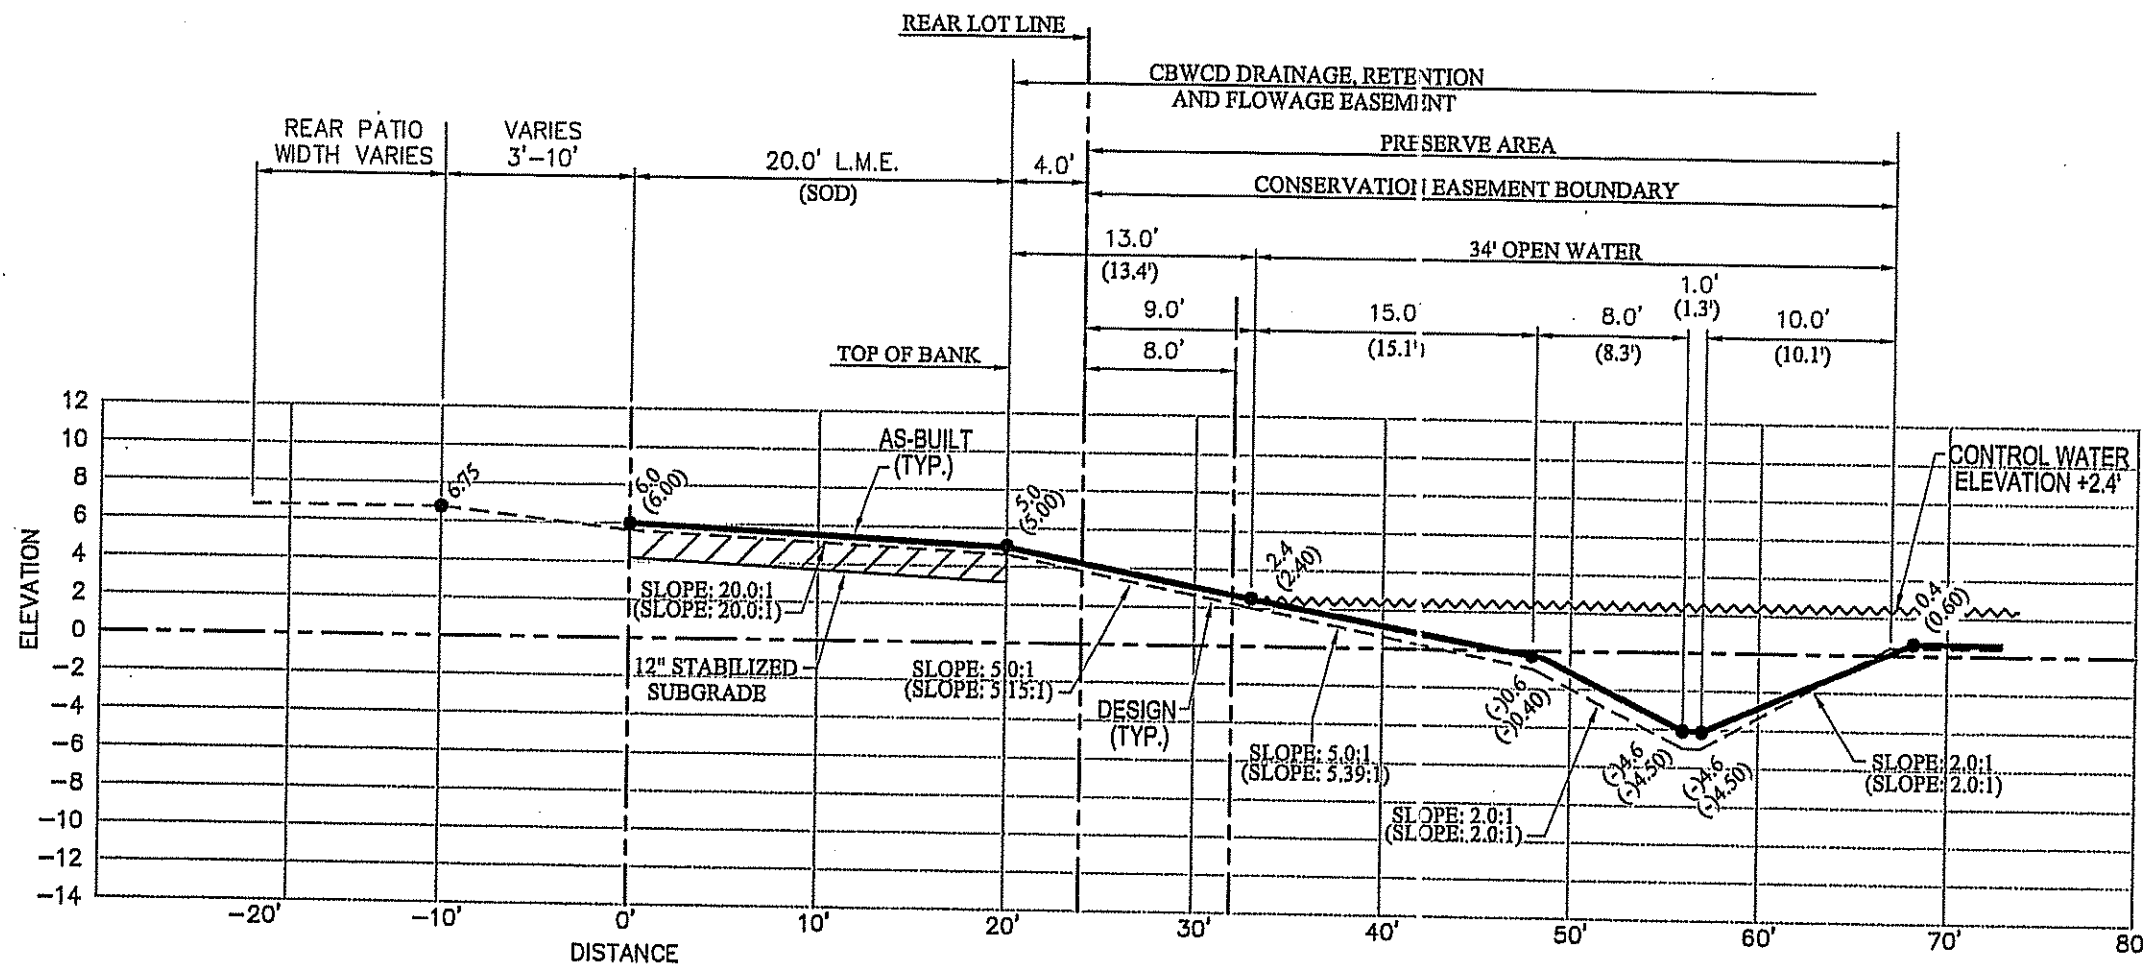


SECTION No. 34

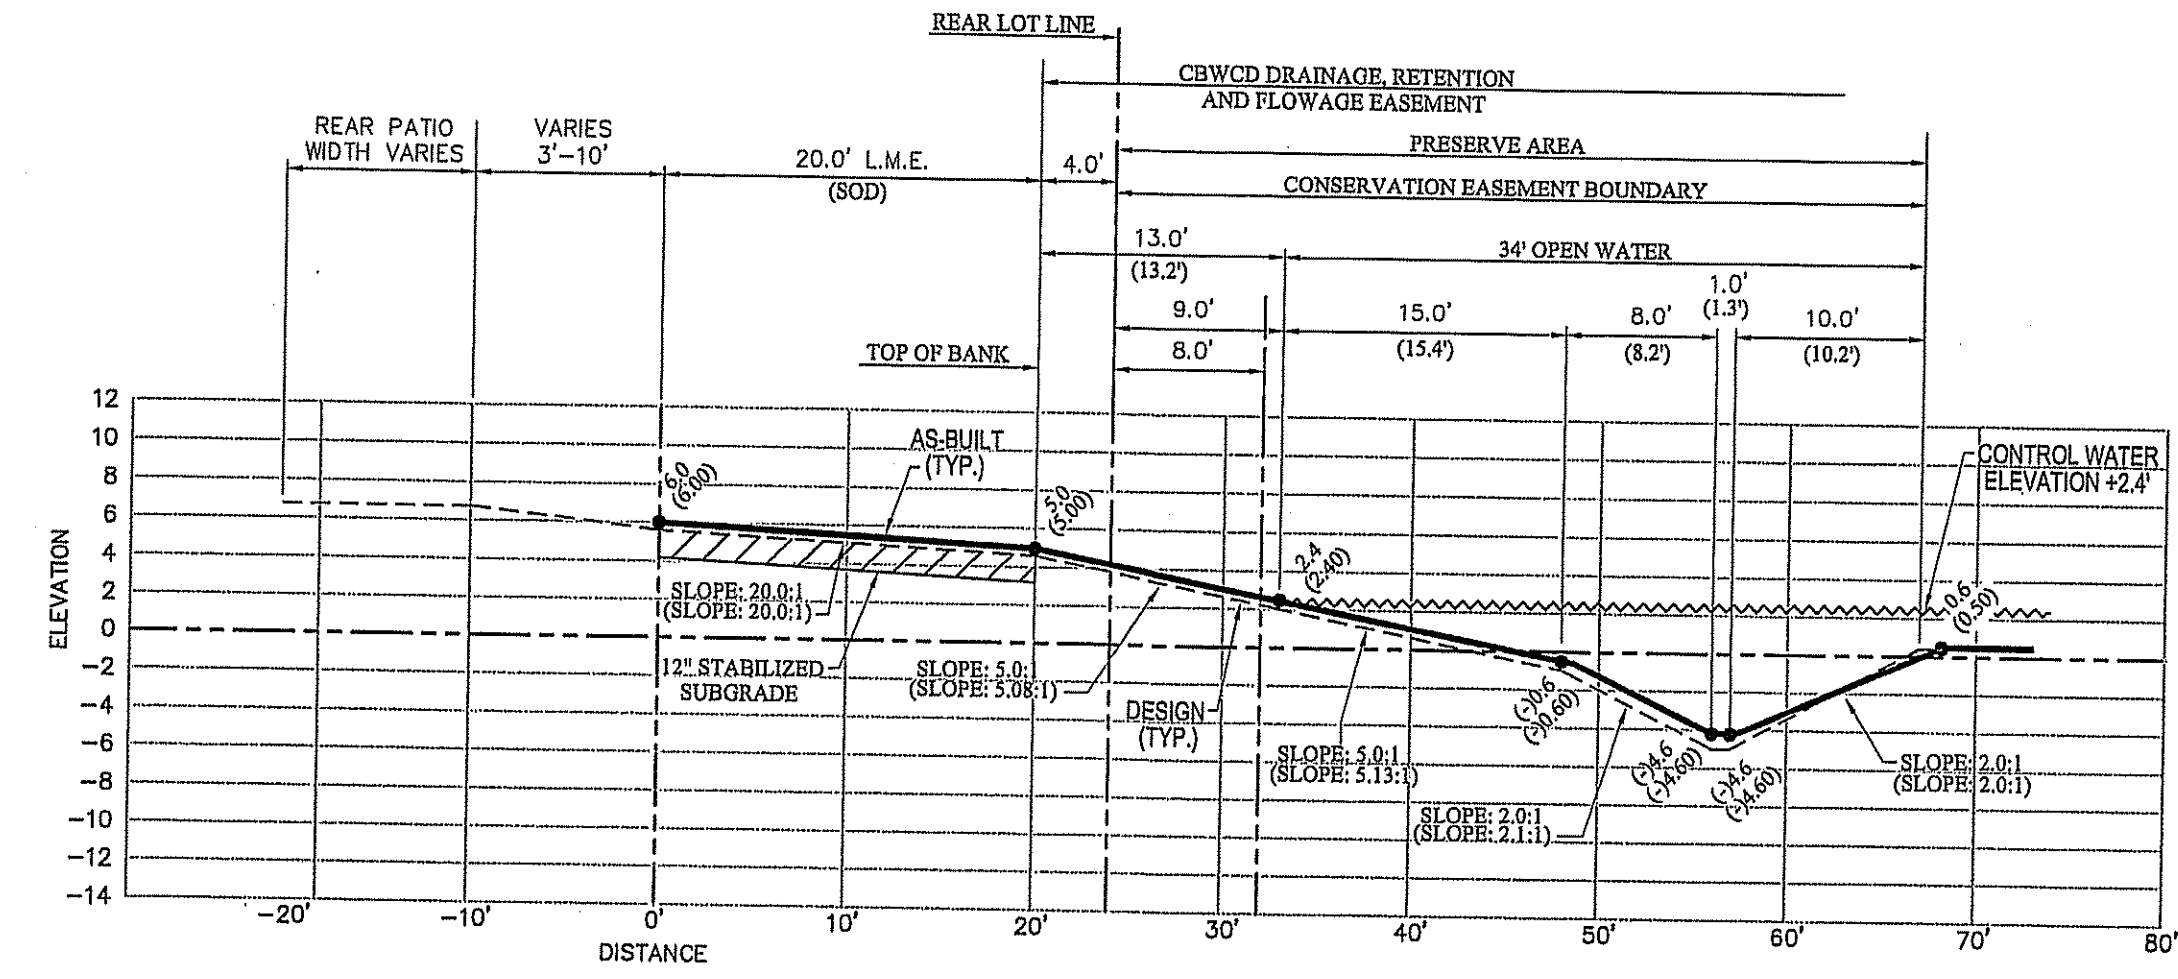


SECTION No. 35

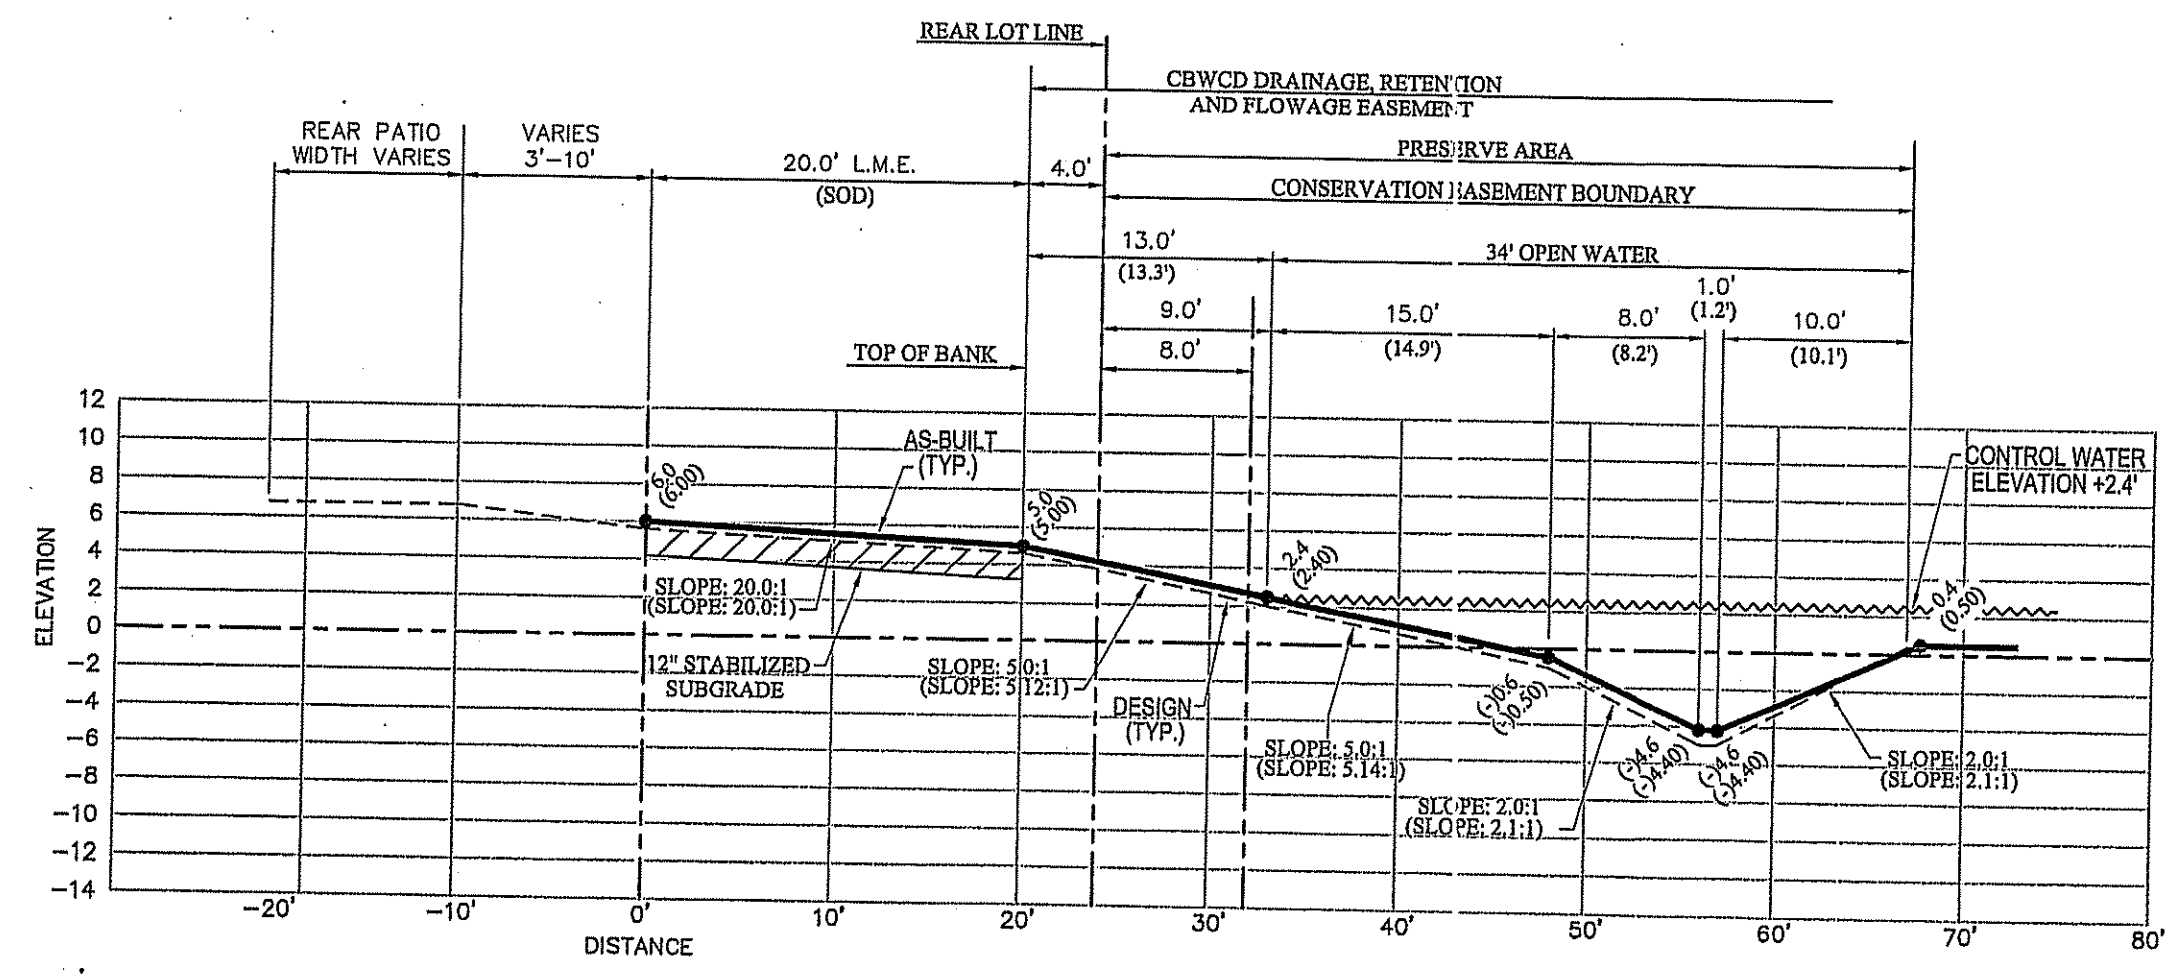


SECTION No. 36

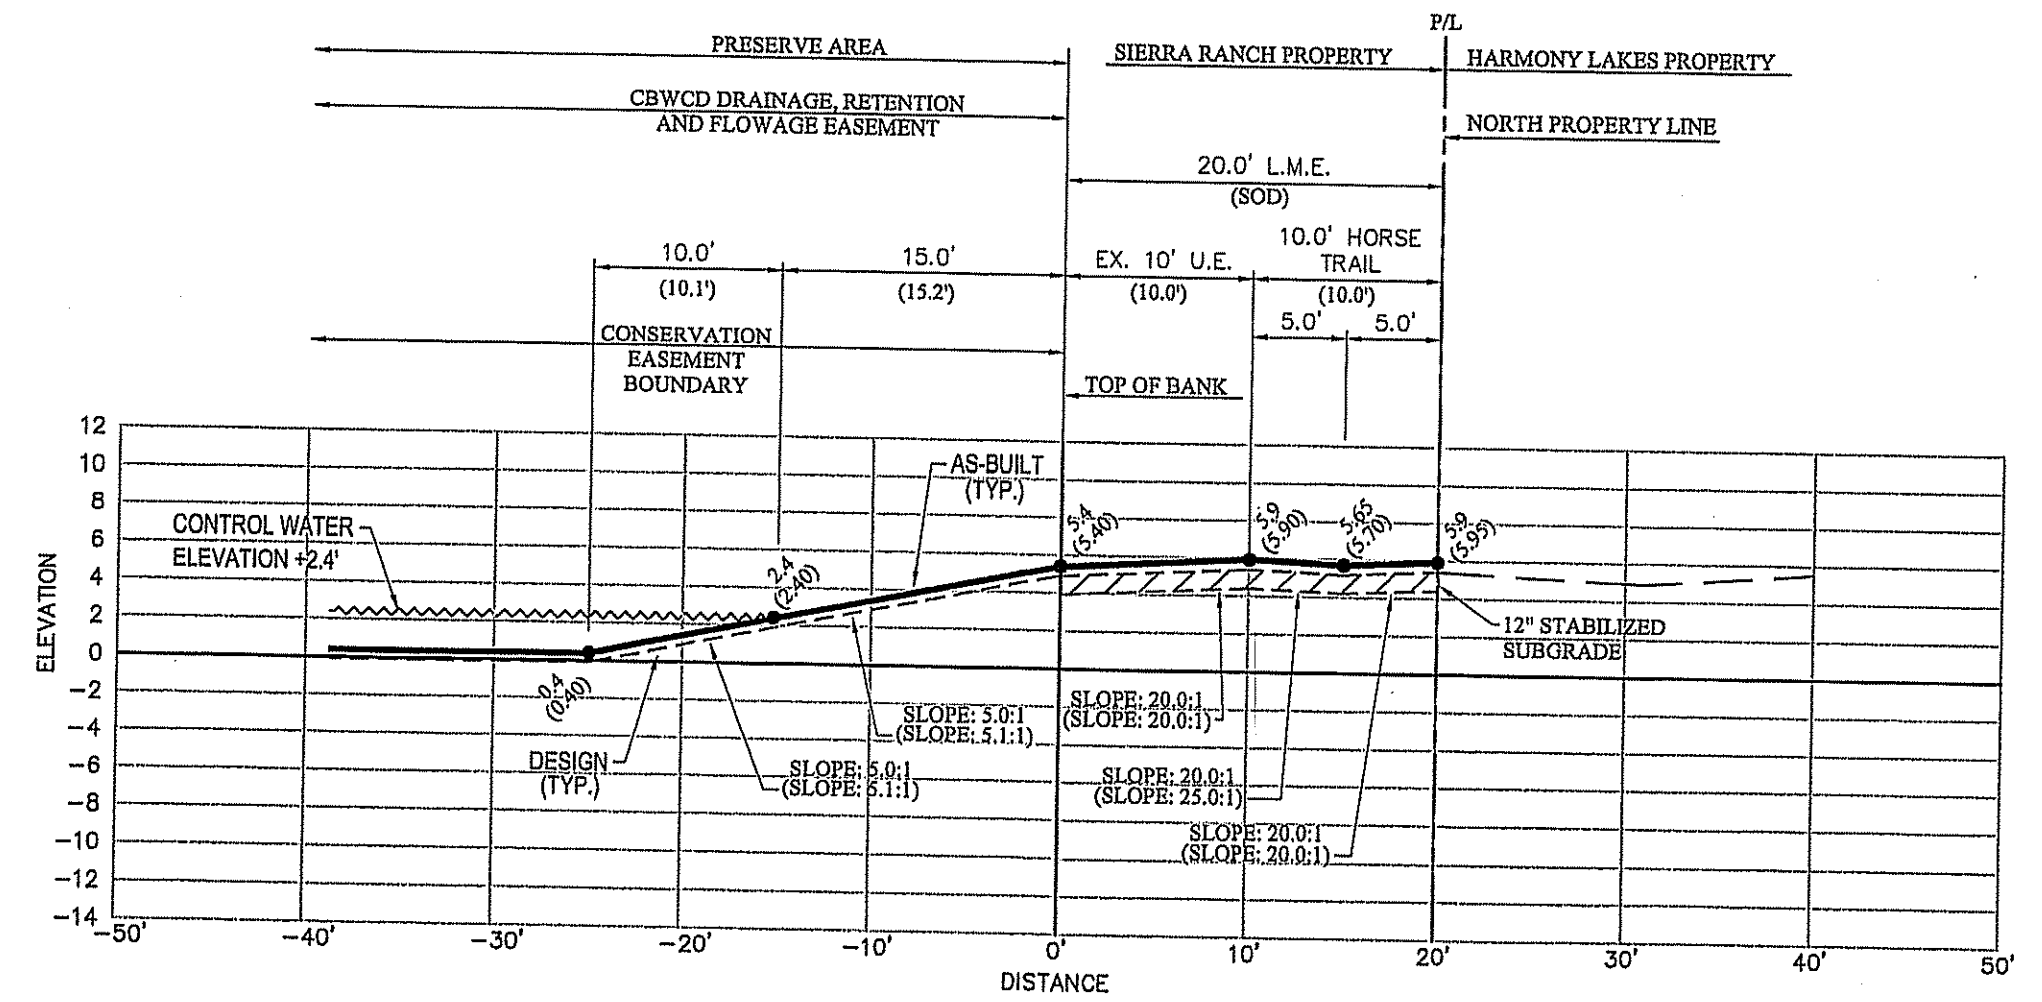

SECTION No. 37
NORTH PROPERTY LINE

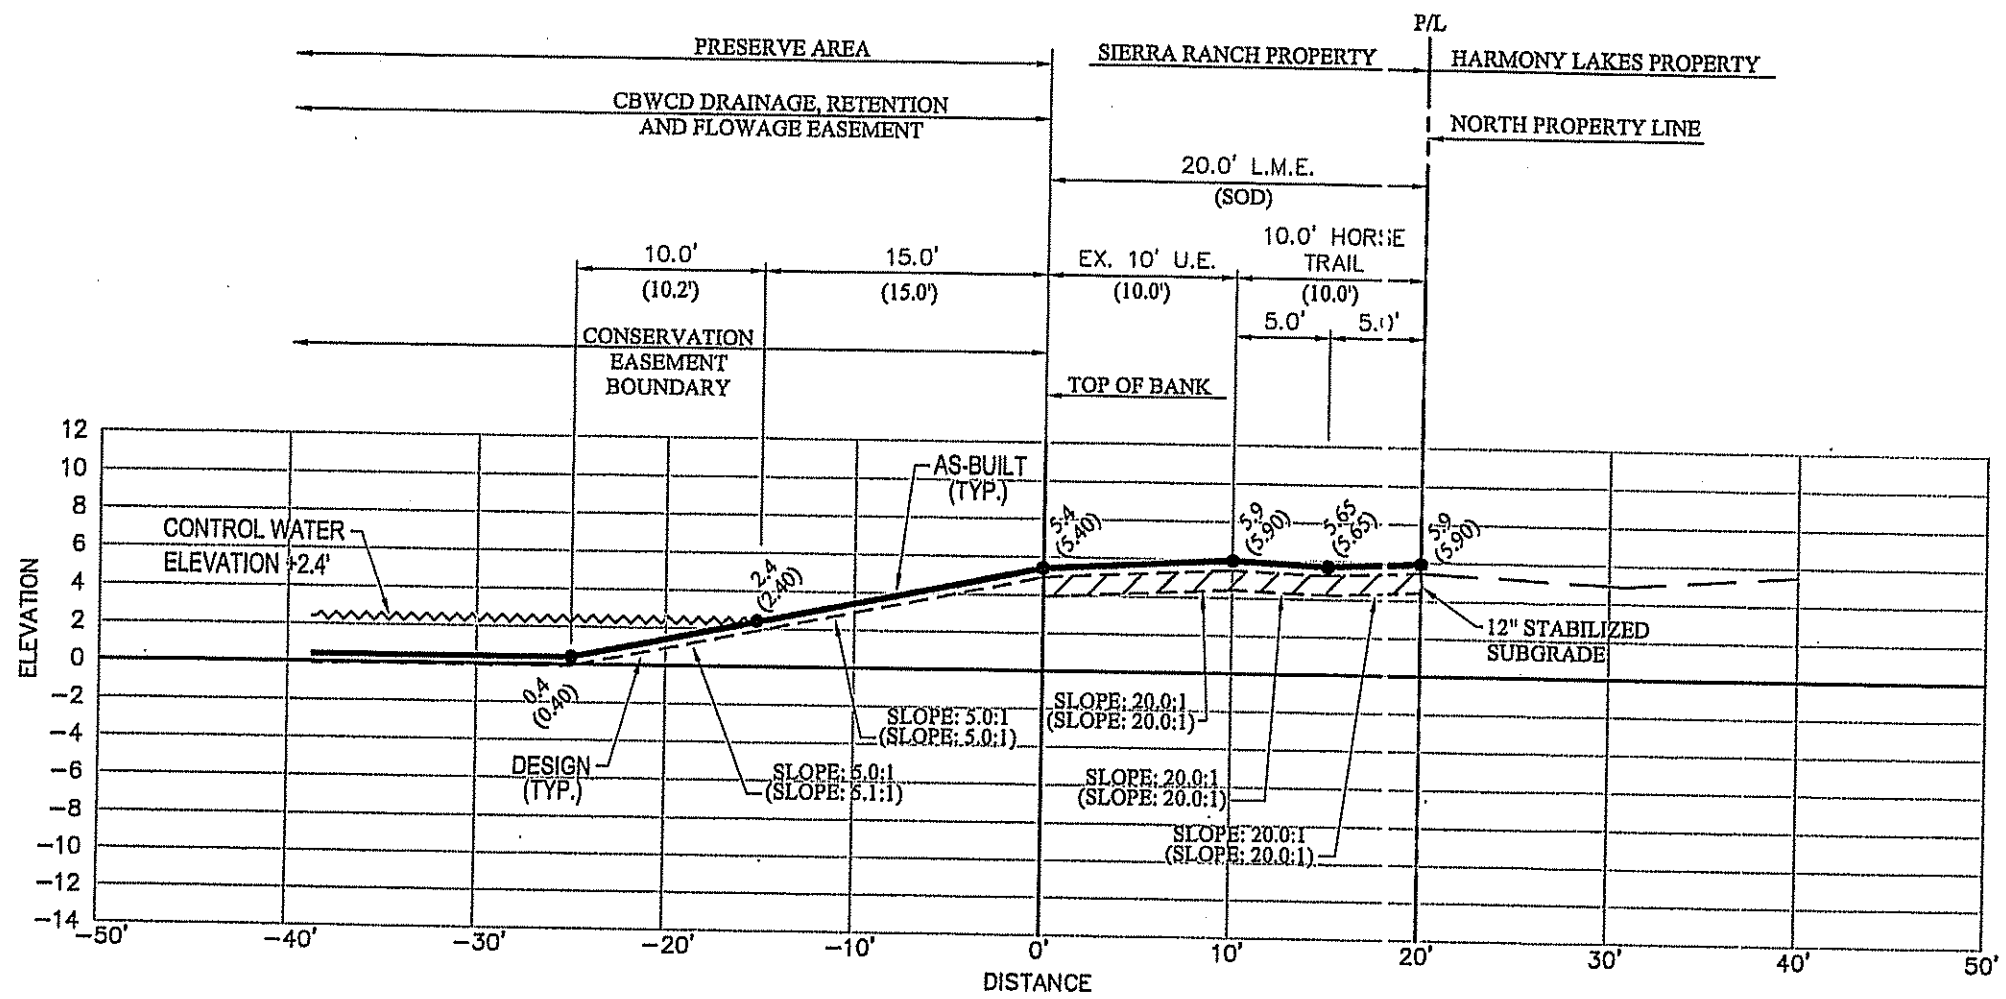

SECTION No. 38
NORTH PROPERTY LINE

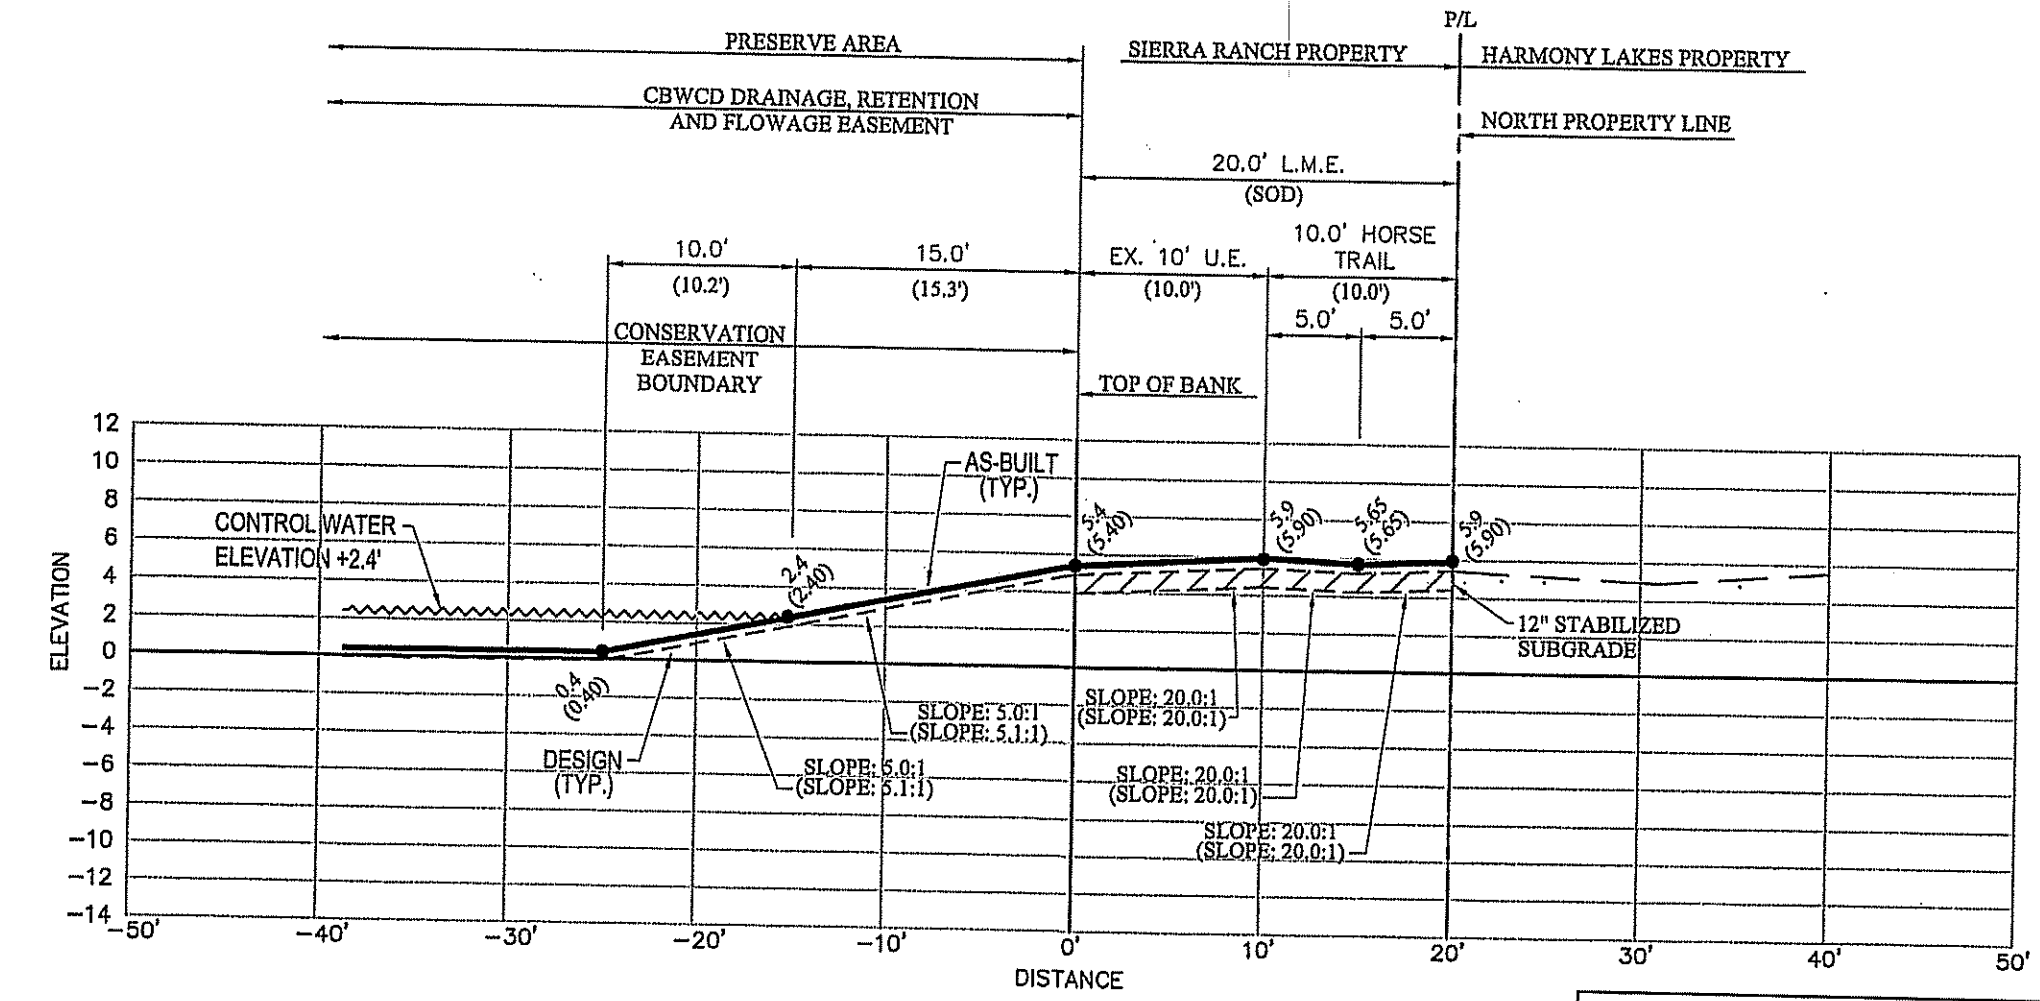

SECTION No. 39
NORTH PROPERTY LINE

Chad E. Edwards, State of Florida,
Professional Engineer, License No. 59306

This item has been digitally signed and sealed by
Chad E. Edwards, on the date indicated here.
Printed copies of this document are not
considered signed and sealed and the signature
must be verified on any electronic copies.

Digitally signed by
Chad Everett
Edwards
Date: 2022.10.27
09:28:25 -04'00'


AS-BUILT LEGEND:	
(15.2)	DENOTES AS-BUILT DISTANCE
(15.0)	DENOTES DESIGN DISTANCE
(15.0)	DENOTES AS-BUILT ELEVATION
(15.0)	DENOTES DESIGN ELEVATION
(SLOPE: 20.0:1)	DENOTES AS-BUILT SLOPE
(SLOPE: 20.0:1)	DENOTES DESIGN SLOPE
L.M.E.	DENOTES LAKE MAINTENANCE EASEMENT
---	DENOTES AS-BUILT LINE
---	DENOTES DESIGN LINE

NOTE:
THE AS-BUILT LINEWORK SHOWN HEREON IS A GRAPHICAL REPRESENTATION
AND MAY NOT BE DRAWN TO SCALE FOR CLARITY PURPOSES.


CERTIFICATE:
I HEREBY CERTIFY THAT THESE RECORD DRAWINGS FOR THE
FACILITY HAVE BEEN REVIEWED BY ME OR BY INDIVIDUAL(S)
UNDER MY DIRECT SUPERVISION FOR COMPLETENESS AND
ACCURACY, AND ARE TRUE AND CORRECT TO THE BEST OF MY
KNOWLEDGE AND BELIEF. THE FIELD WORK FOR THE AS-BUILT
DRAWINGS HAS BEEN DONE BY: Joseph L. Martin, P.S.M. #4368
10/20/2022

JOSEPH L. MARTIN
PROFESSIONAL SURVEYOR
& MAPPER
STATE OF FLORIDA
PSM# 4368


THIS DOCUMENT CONSISTS OF 18 SHEETS AND EACH
SHEET SHALL NOT BE CONSIDERED VALID WITHOUT
SHEET 1.

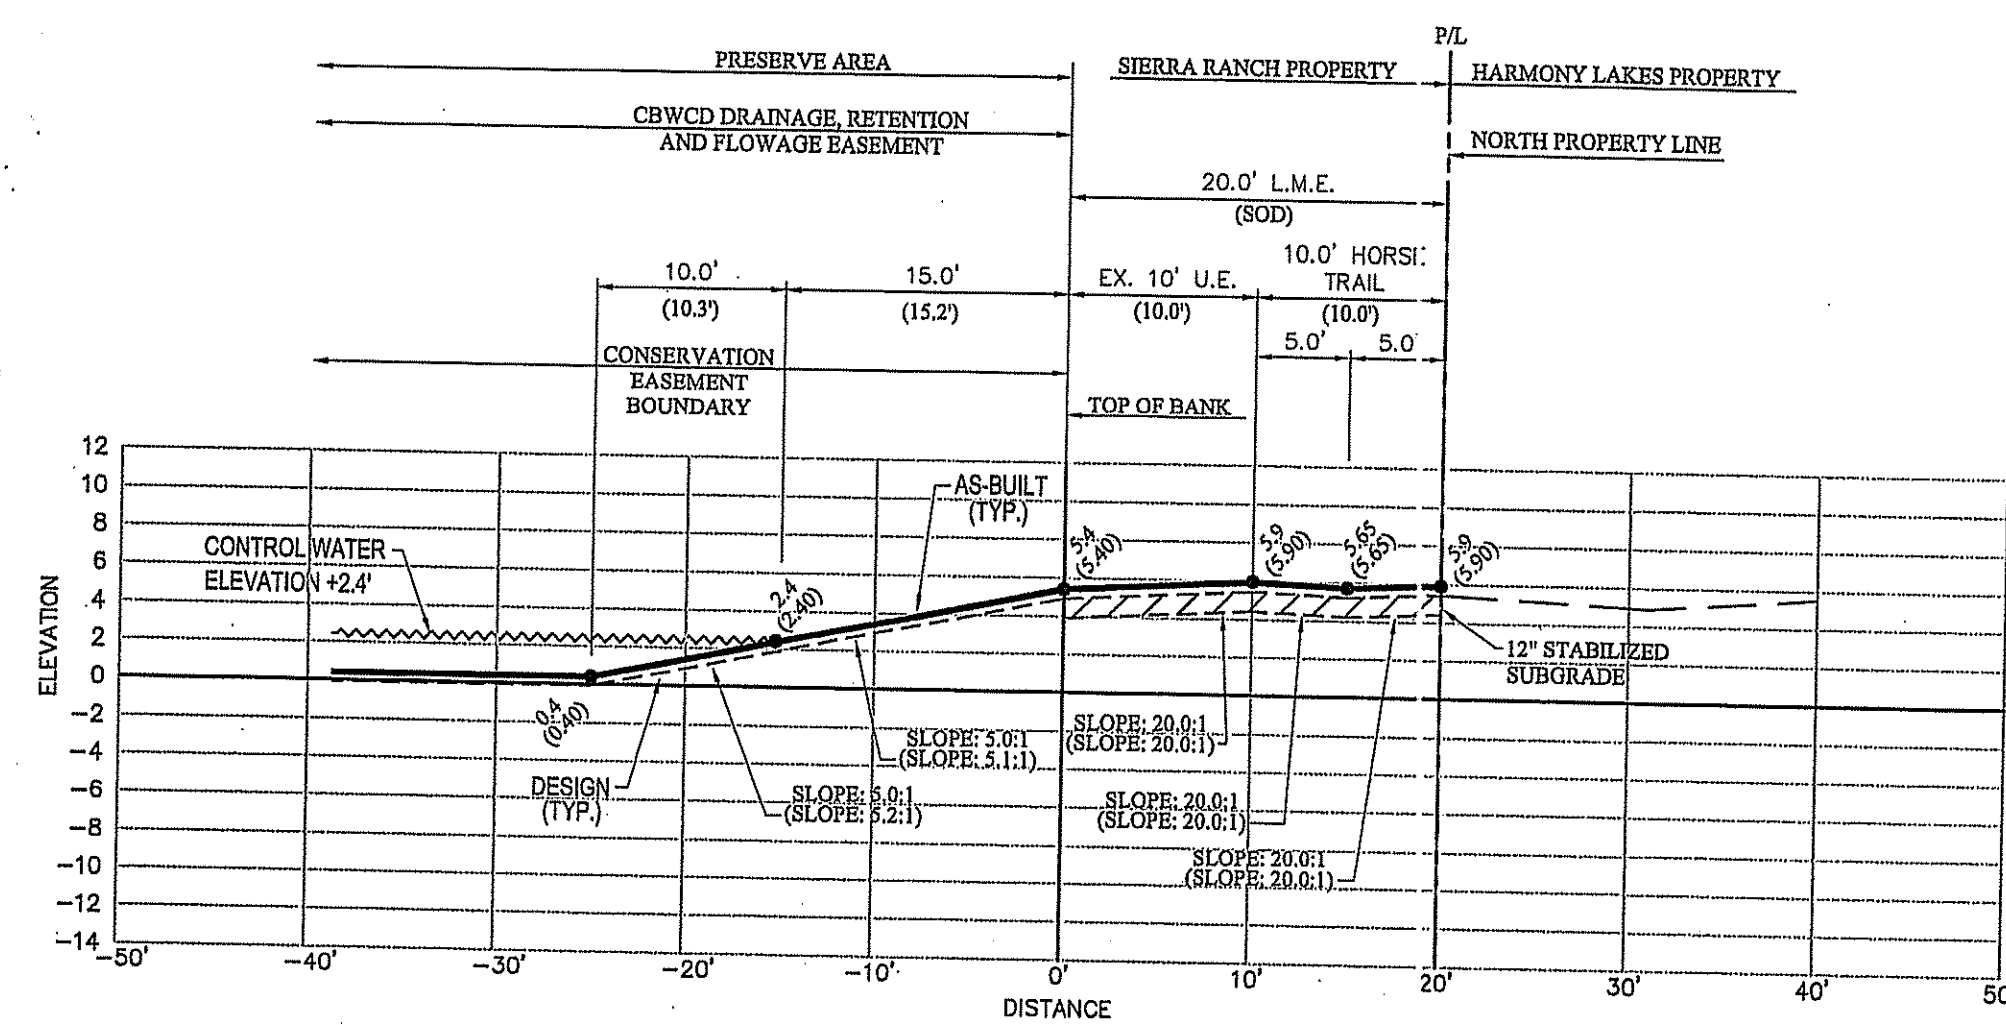


SECTION No. 40
NORTH PROPERTY LINE

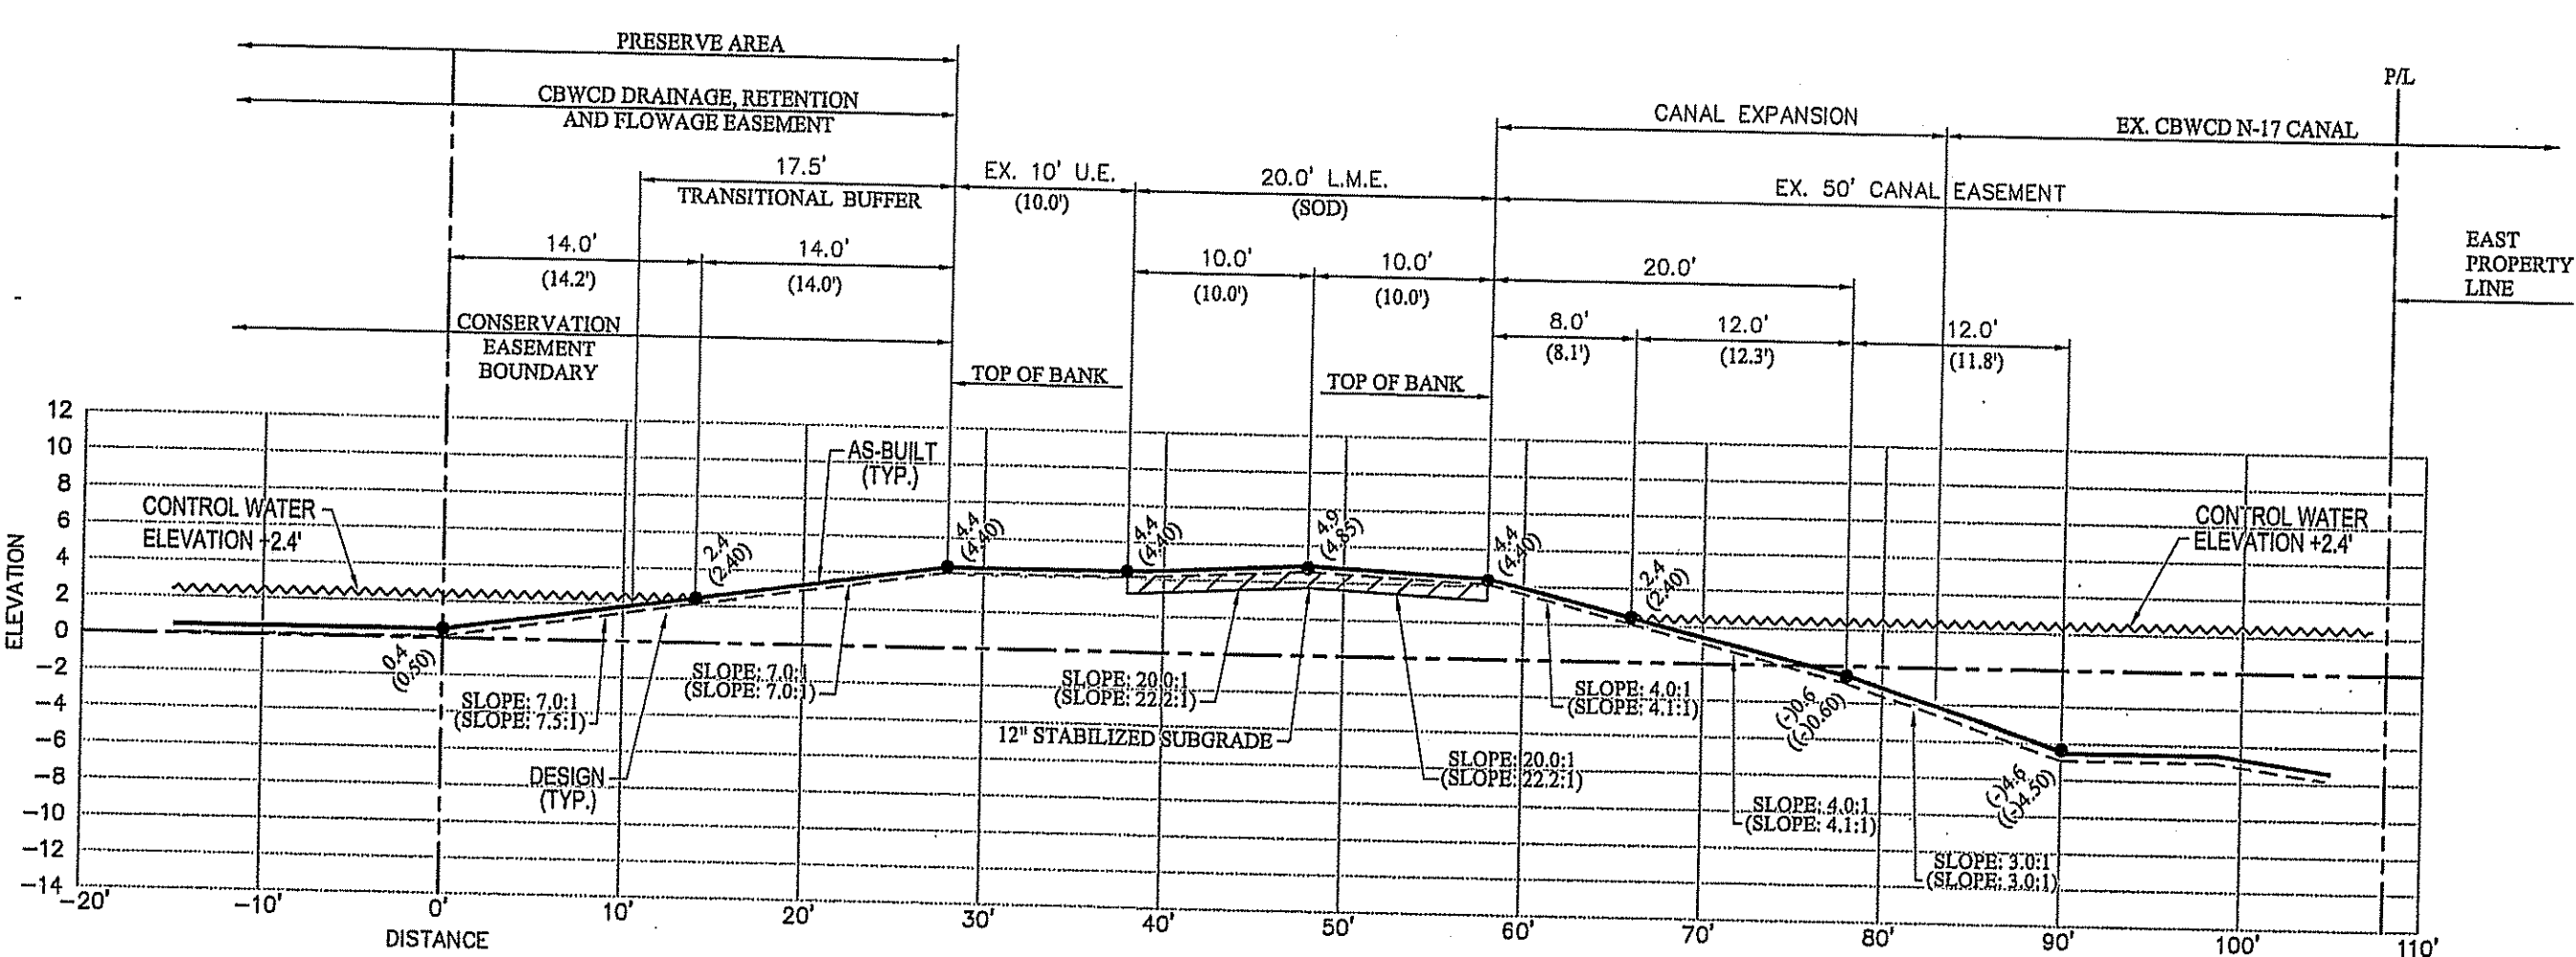


SECTION No. 41
EAST PROPERTY LINE

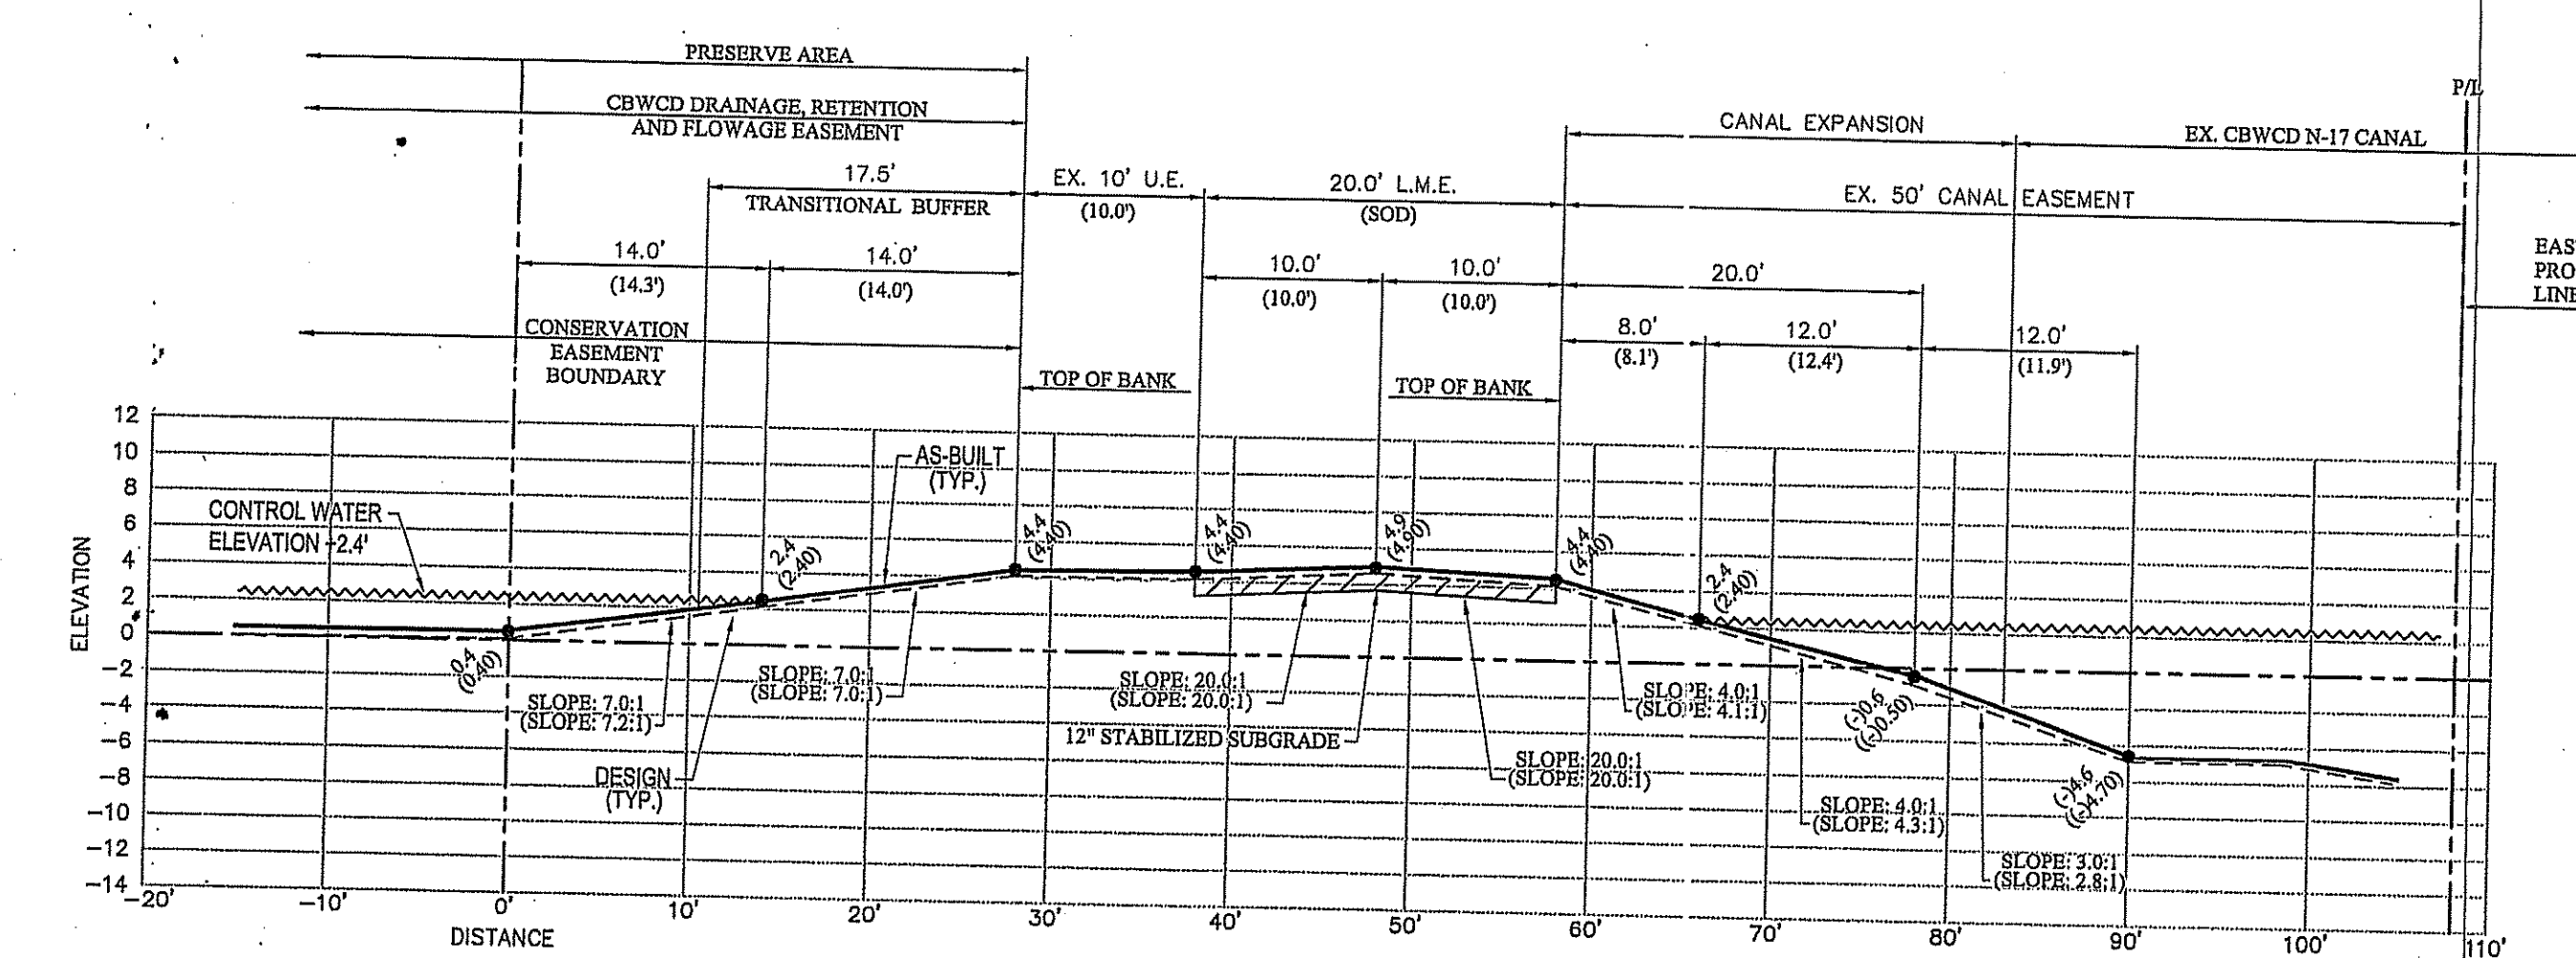


SECTION No. 42
EAST PROPERTY LINE

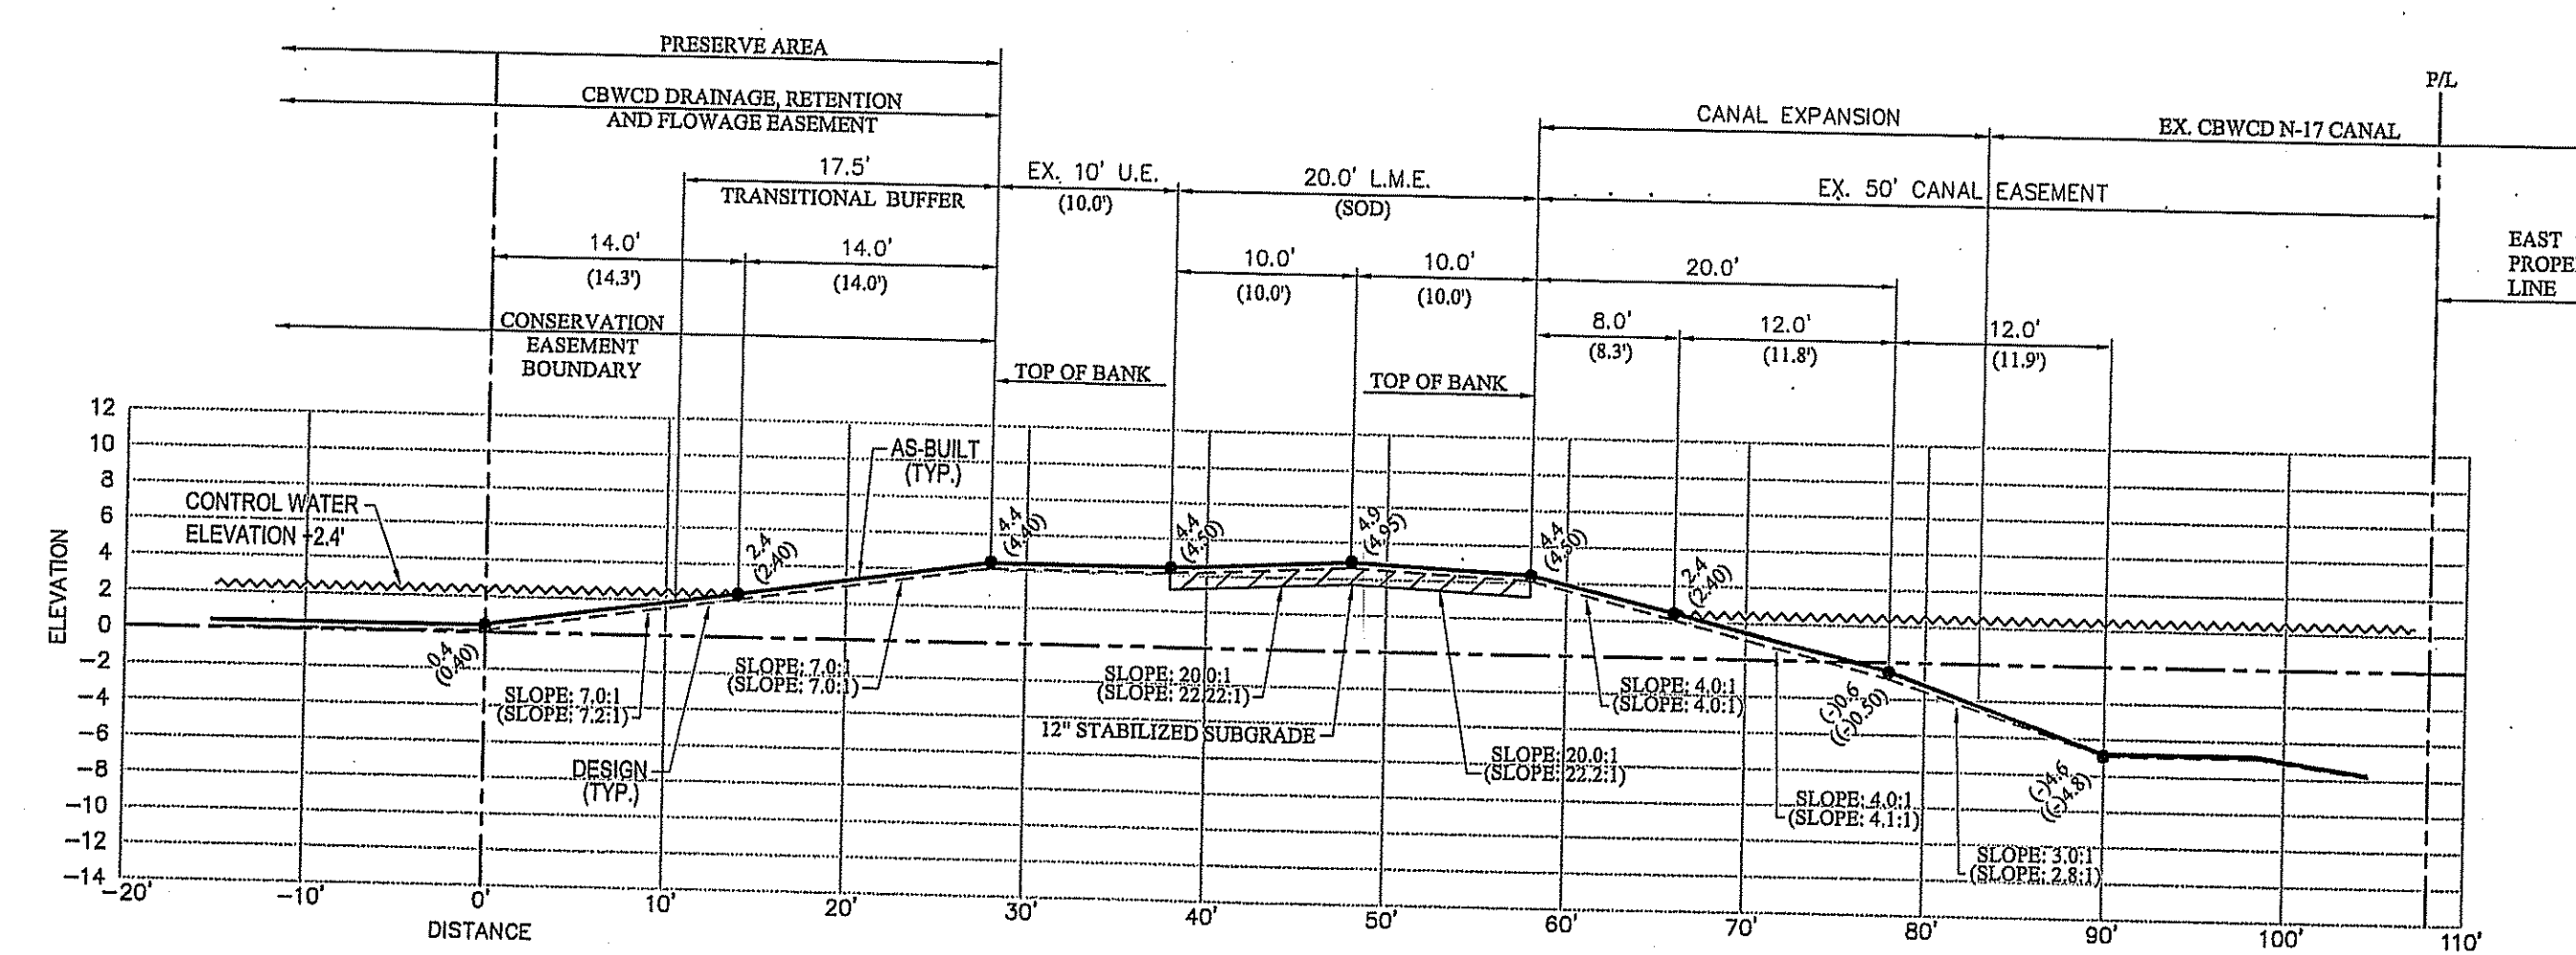

SECTION No. 43
EAST PROPERTY LINE

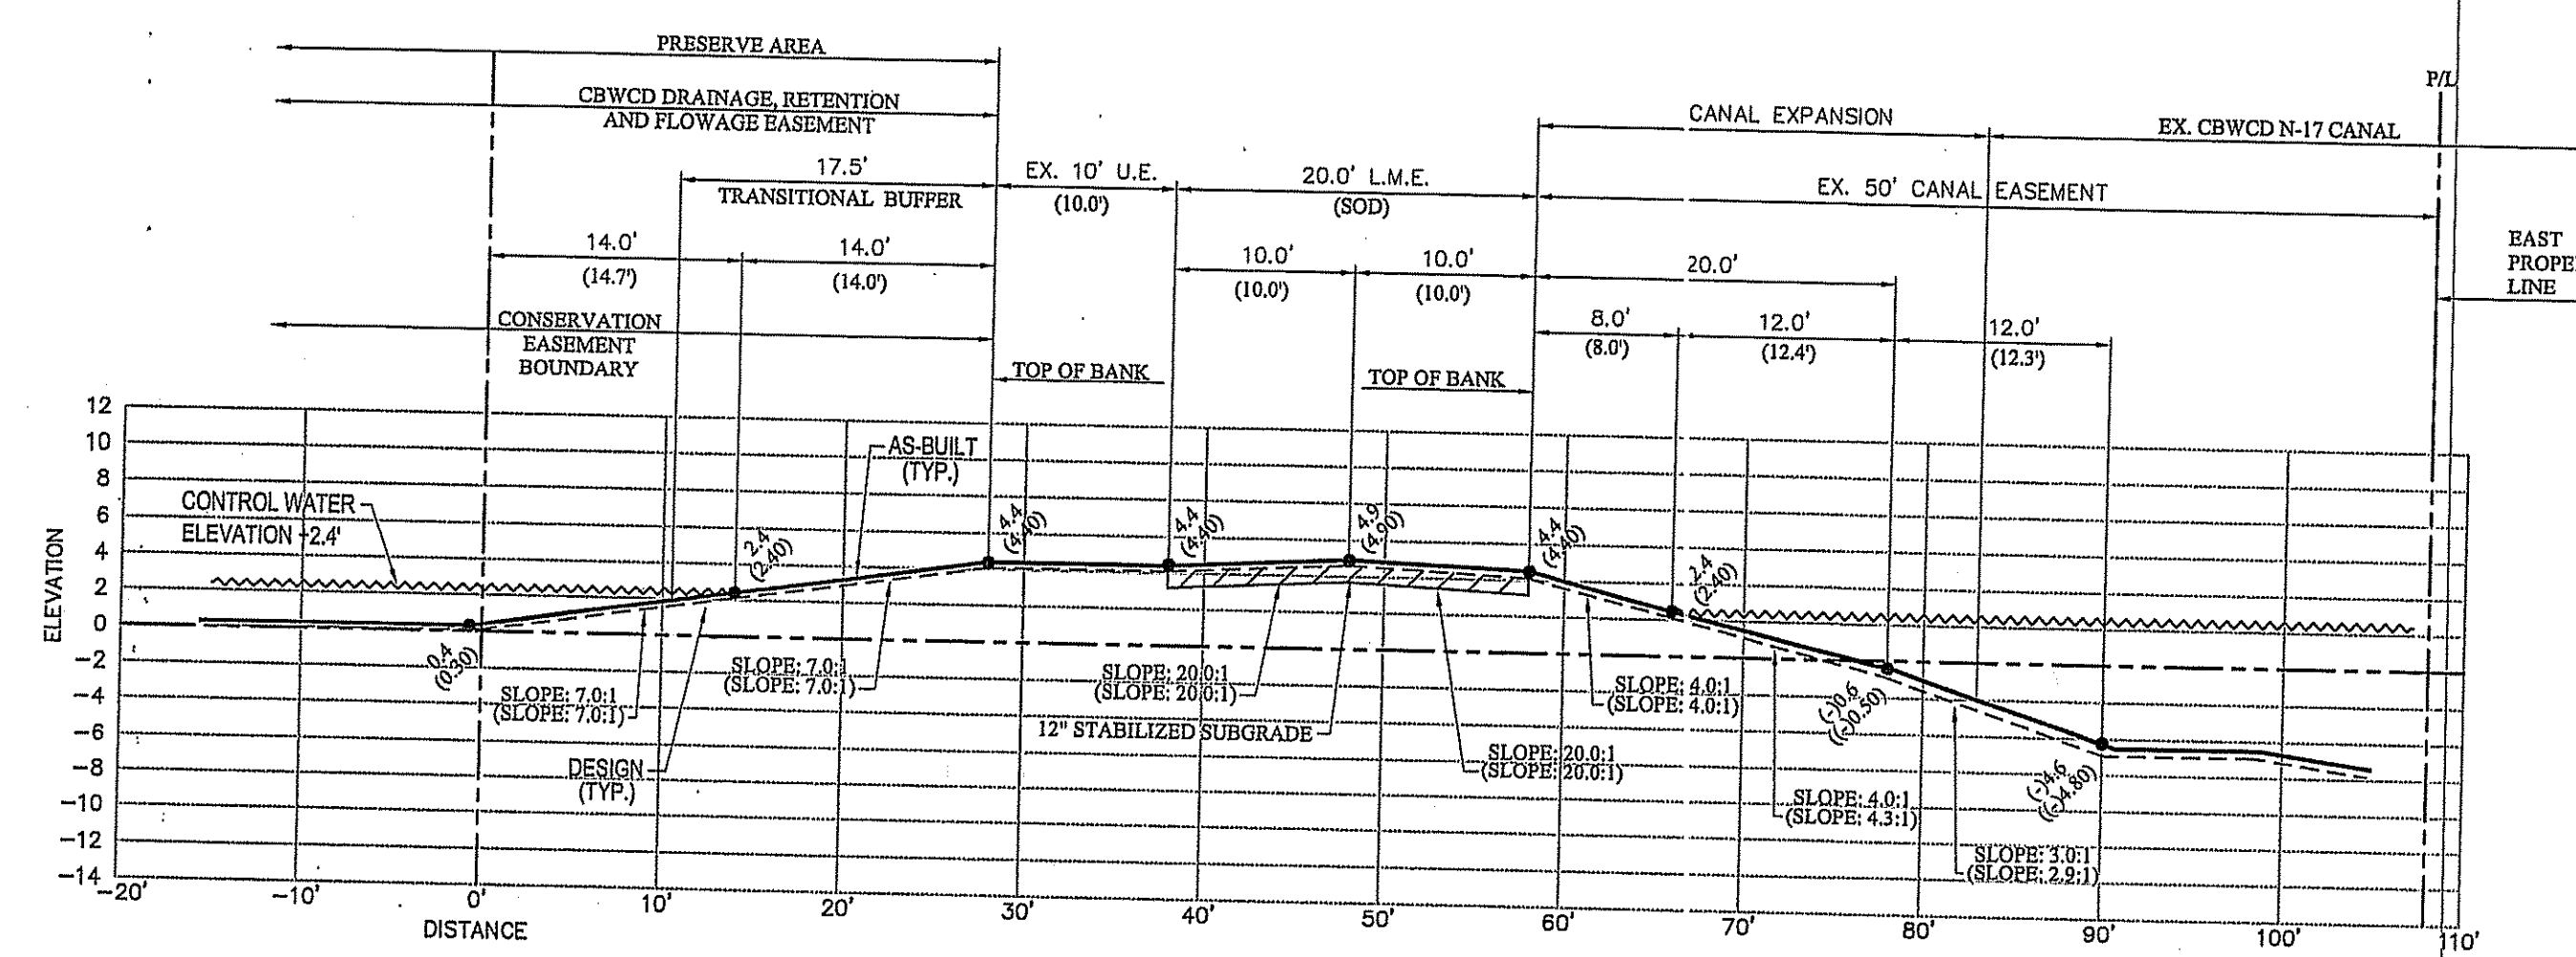

SECTION No. 44
EAST PROPERTY LINE

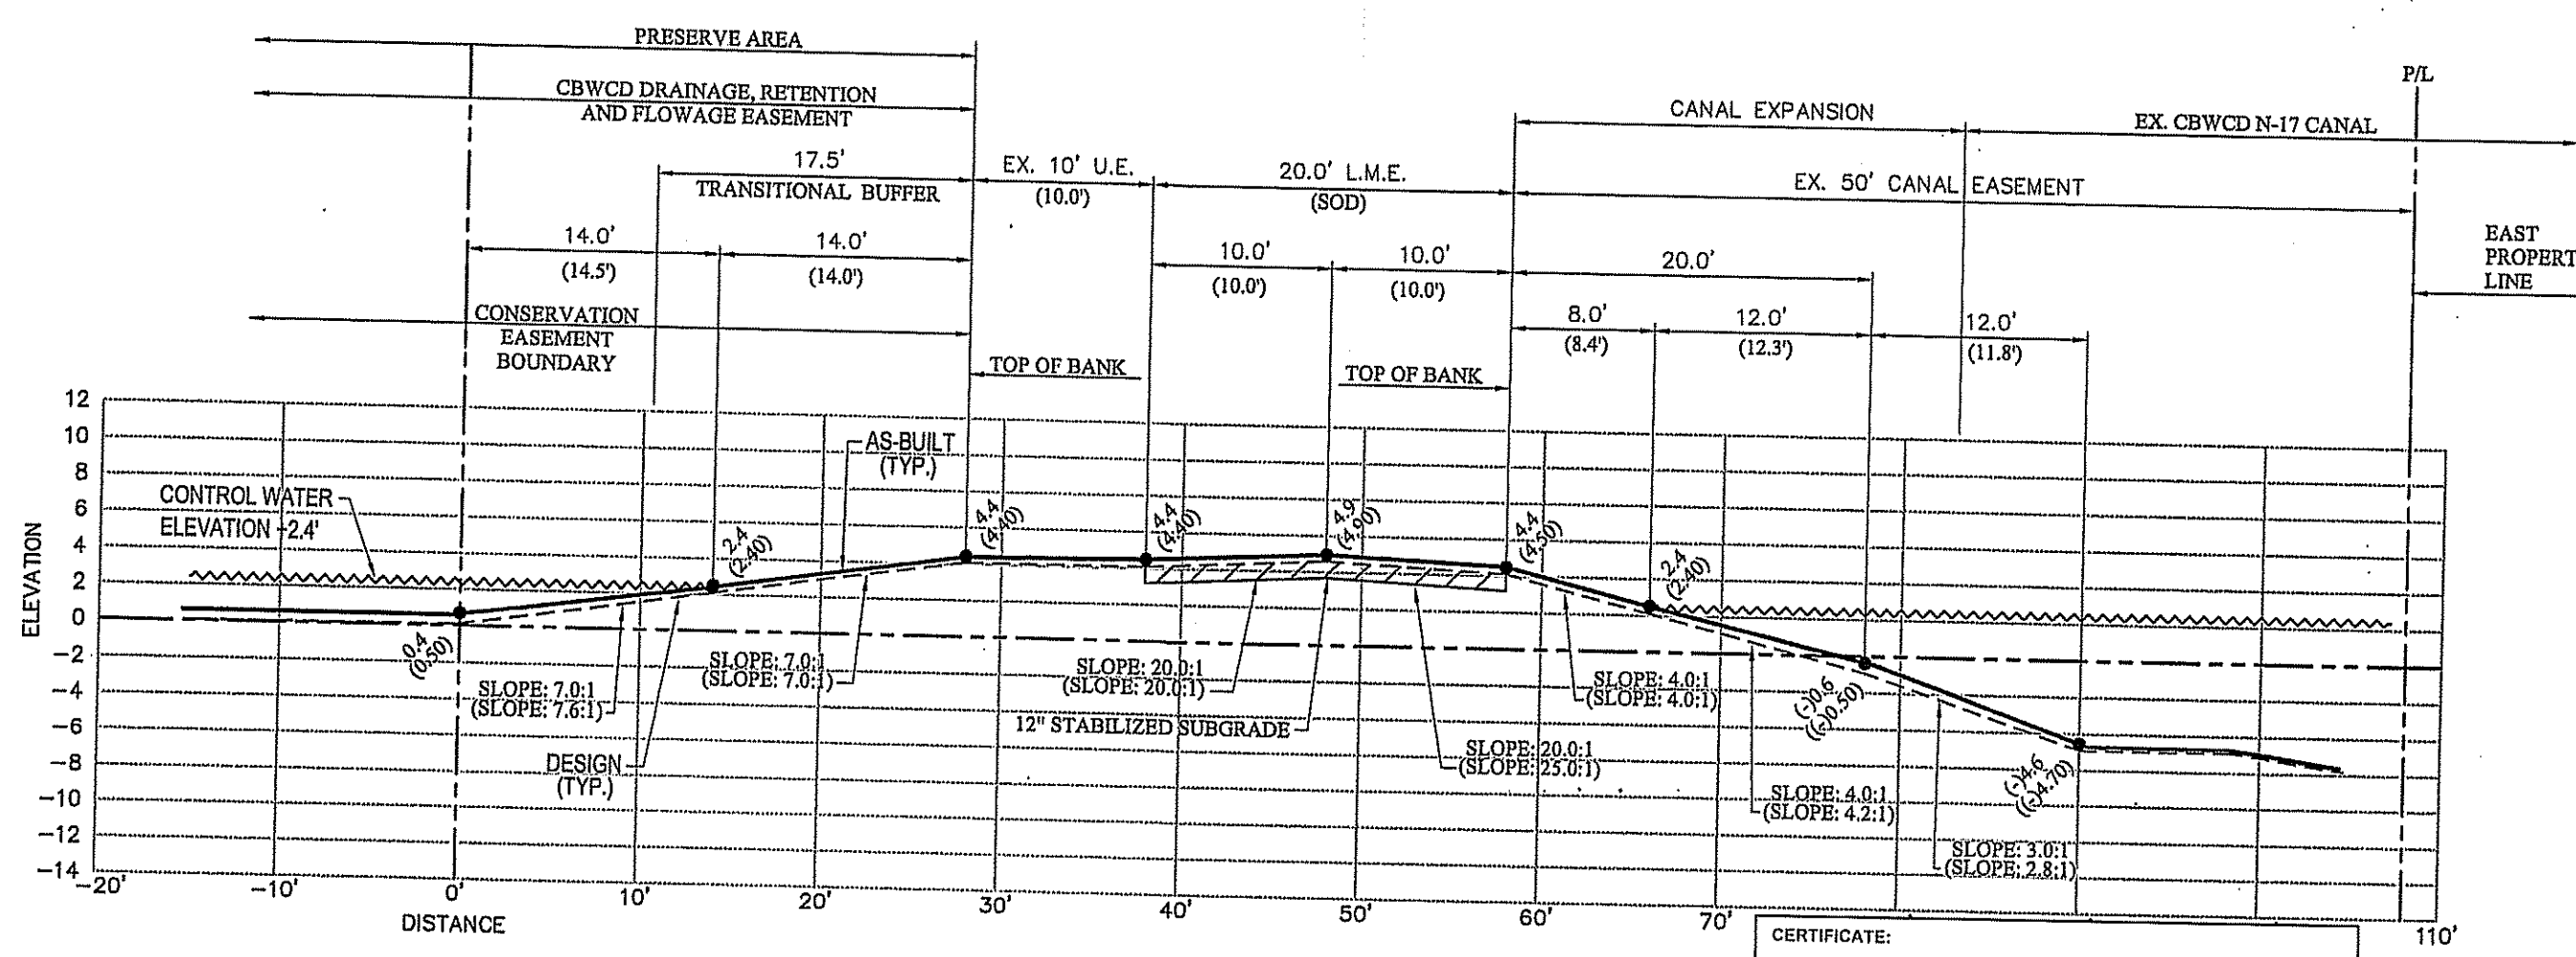

SECTION No. 45
EAST PROPERTY LINE

AS-BUILT LEGEND:

(15.2)	DENOTES AS-BUILT DISTANCE
15.0'	DENOTES DESIGN DISTANCE
(5.5)	DENOTES AS-BUILT ELEVATION
5.5	DENOTES DESIGN ELEVATION
(SLOPE: 20.0:1)	DENOTES AS-BUILT SLOPE
SLOPE: 20.0:1	DENOTES DESIGN SLOPE
L.M.E.	DENOTES LAKE MAINTENANCE EASEMENT
————	DENOTES AS-BUILT LINE
-----	DENOTES DESIGN LINE

NOTE:
THE AS-BUILT LINEWORK SHOWN HEREON IS A GRAPHICAL REPRESENTATION AND MAY NOT BE DRAWN TO SCALE FOR CLARITY PURPOSES.

THIS DOCUMENT CONSISTS OF 18 SHEETS AND EACH SHEET SHALL NOT BE CONSIDERED VALID WITHOUT SHEET 1.

Chad E. Edwards, State of Florida,
Professional Engineer, License No. 59306

This item has been digitally signed and sealed by
Chad E. Edwards, on the date indicated here.
Printed copies of this document are not
considered signed and sealed and the signature
must be verified on any electronic copies.

Chad Everett
Edwards

Digitally signed by Chad Everett
Edwards
Date: 2022.10.27 09:28:54 -04'00'


CERTIFICATE:
I HEREBY CERTIFY THAT THESE RECORD DRAWINGS FOR THE FACILITY HAVE BEEN REVIEWED BY ME OR BY INDIVIDUAL(S) UNDER MY DIRECT SUPERVISION FOR COMPLETENESS AND ADEQUACY, AND ARE TRUE AND CORRECT TO THE BEST OF MY KNOWLEDGE AND BELIEF. THE FIELD WORK FOR THE AS-BUILT DRAWINGS HAS BEEN DONE BY: J. MARTIN, P.E. 4368
10/20/2022

DATE: 12/10/2021 BY: JOSEPH L. MARTIN
PROFESSIONAL SURVEYOR & MAPPER
STATE OF FLORIDA
PSM# 4368


COUNTY-WIDE LAND SURVEYORS, INC.
LAND SURVEYORS - PLANNERS
14041 S.W. 143 COURT
MIAMI, FLORIDA 33186
PH: 305.232.2340
FX: 305.232.5386

SIERRA RANCH DAVIE, FL.		AS-BUILT CROSS SECTIONS		REVISION COMMENTS		BY	APP
PROJ. TYPE	1950 SOUTH HIATUS ROAD	DATE	05-18-21	REVISION PER ENGINEER'S COMMENTS	L.A.	J.M.	J.M.
PROJ. LOC.	SEC. 18, TWP. 50S, RGE. 41E	DATE	11-8-21	REVISED TO ADD SECTIONS FROM 16 TO 36	L.A.	J.M.	J.M.
SECTION		DATE	12-8-21	REVISED TO ADD SECTIONS FROM 37 TO 125	L.A.	G.B.	G.B.
		DATE	12-10-21	REVISED PER ENGINEER'S COMMENTS	L.A.	G.B.	G.B.


SCALE:	H:1"=10' / V:1"=10'
SURVEYOR:	COUNTY-WIDE
DRAWN BY:	LESLEY
CHECKED BY:	G.B.
AS-BUILT:	PRESERVE AREA
DATE:	04/14/2021
PREPARED BY:	2019-043
SHEET NO.:	2019-043

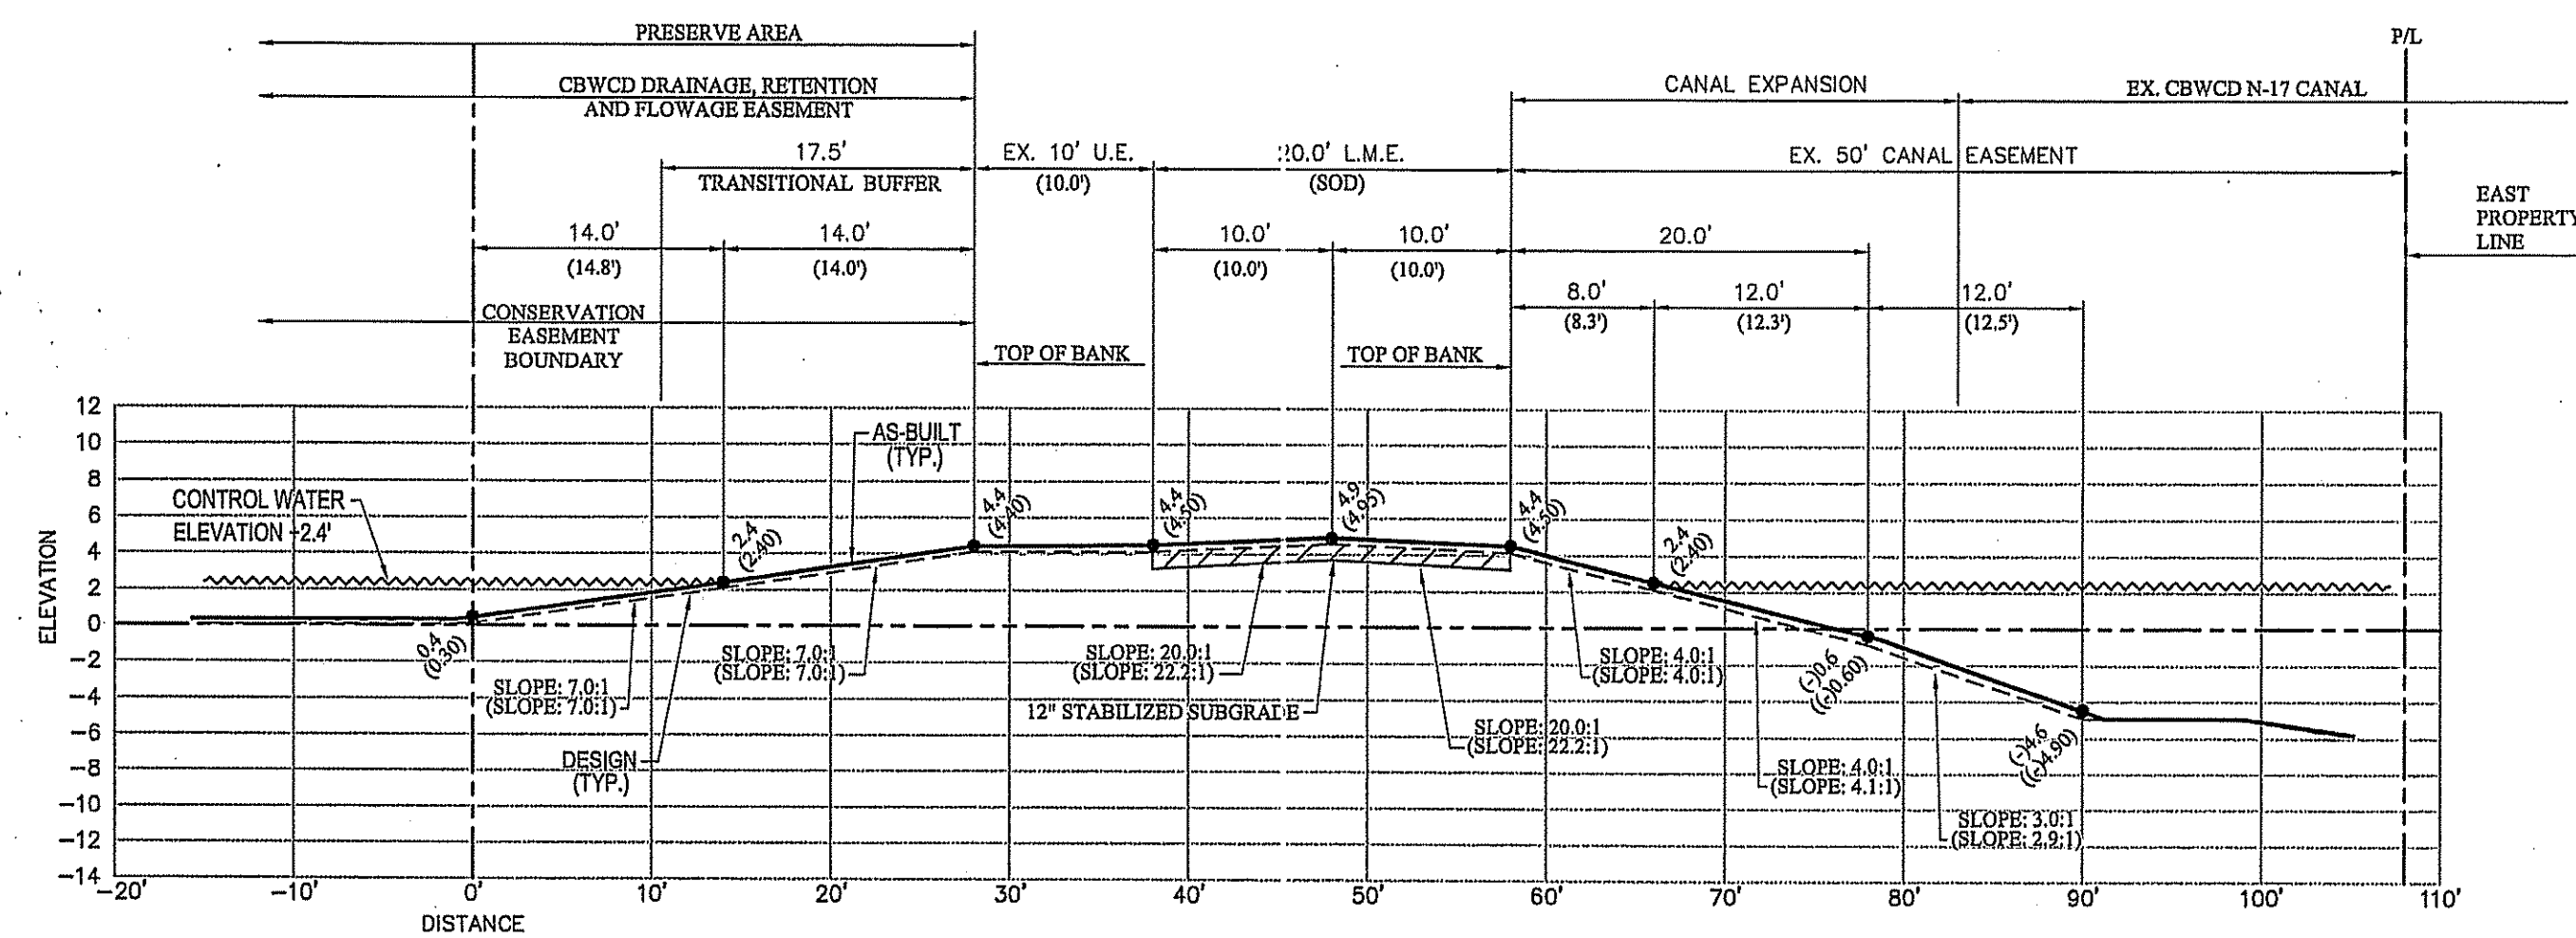


SECTION No. 46

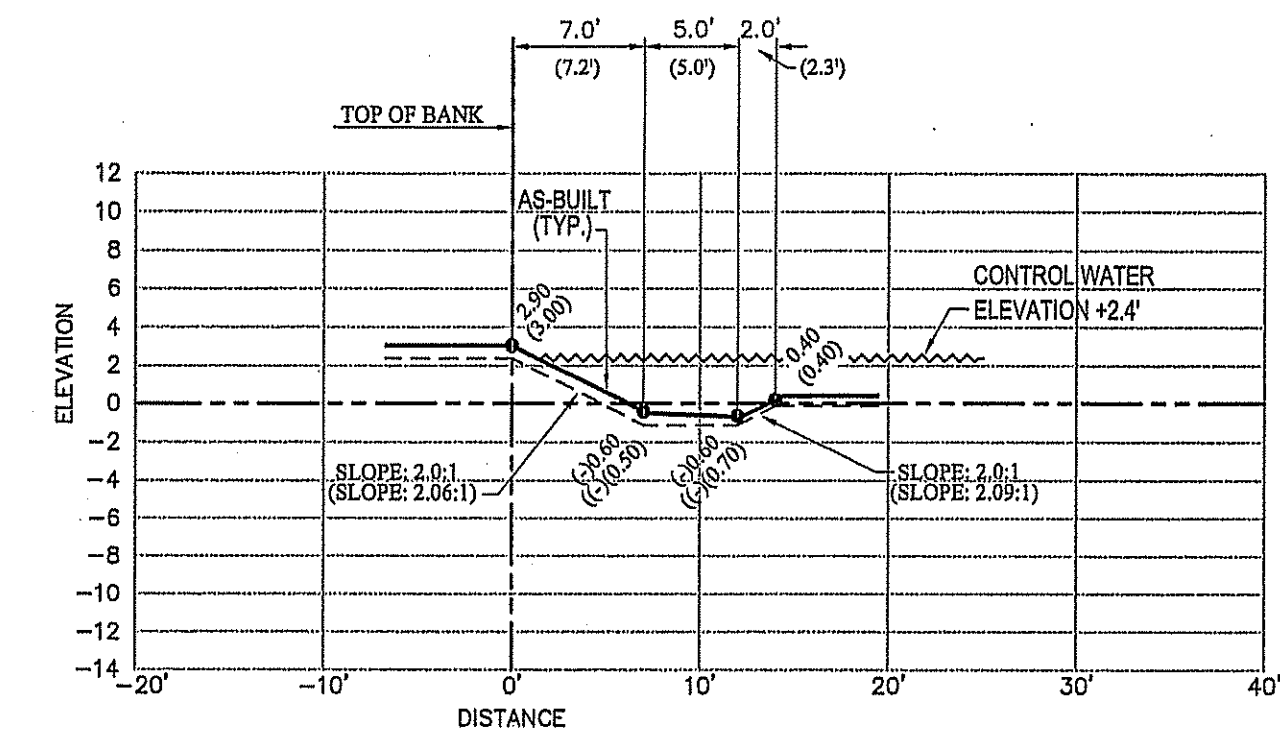


SECTION No. 47
HYDRIC ISLAND

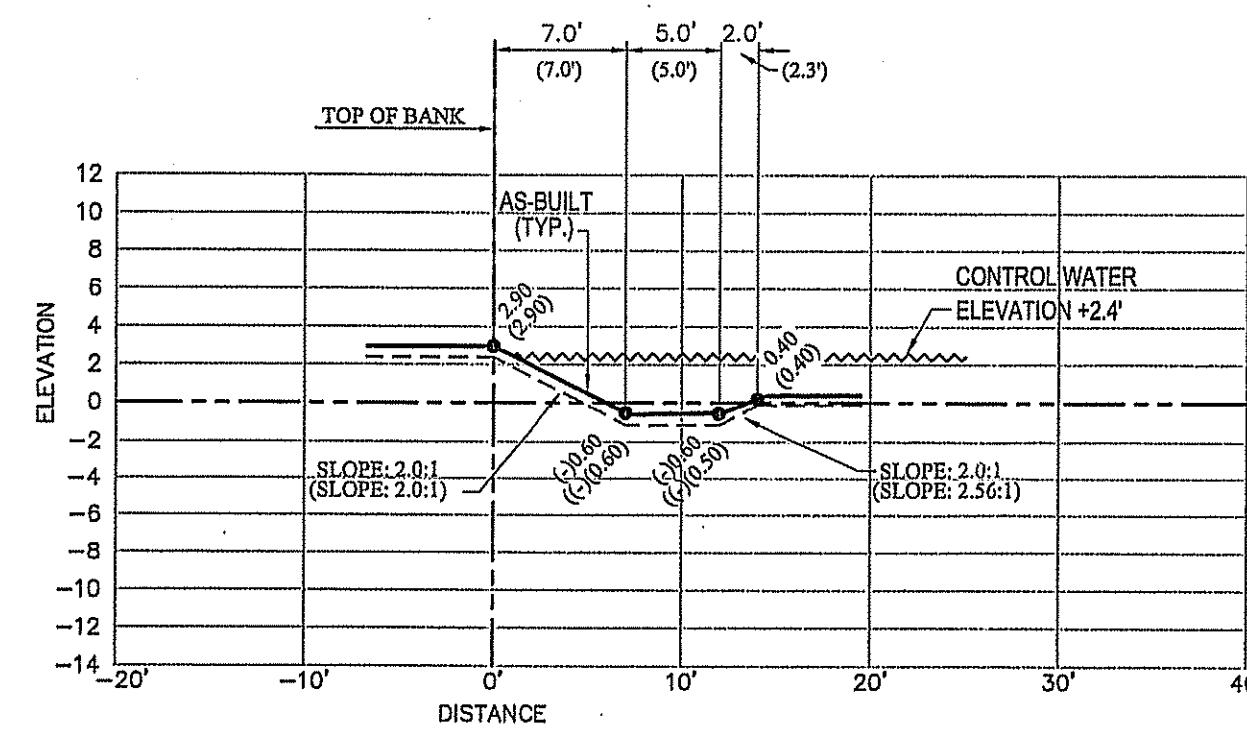


SECTION No. 48
HYDRIC ISLAND

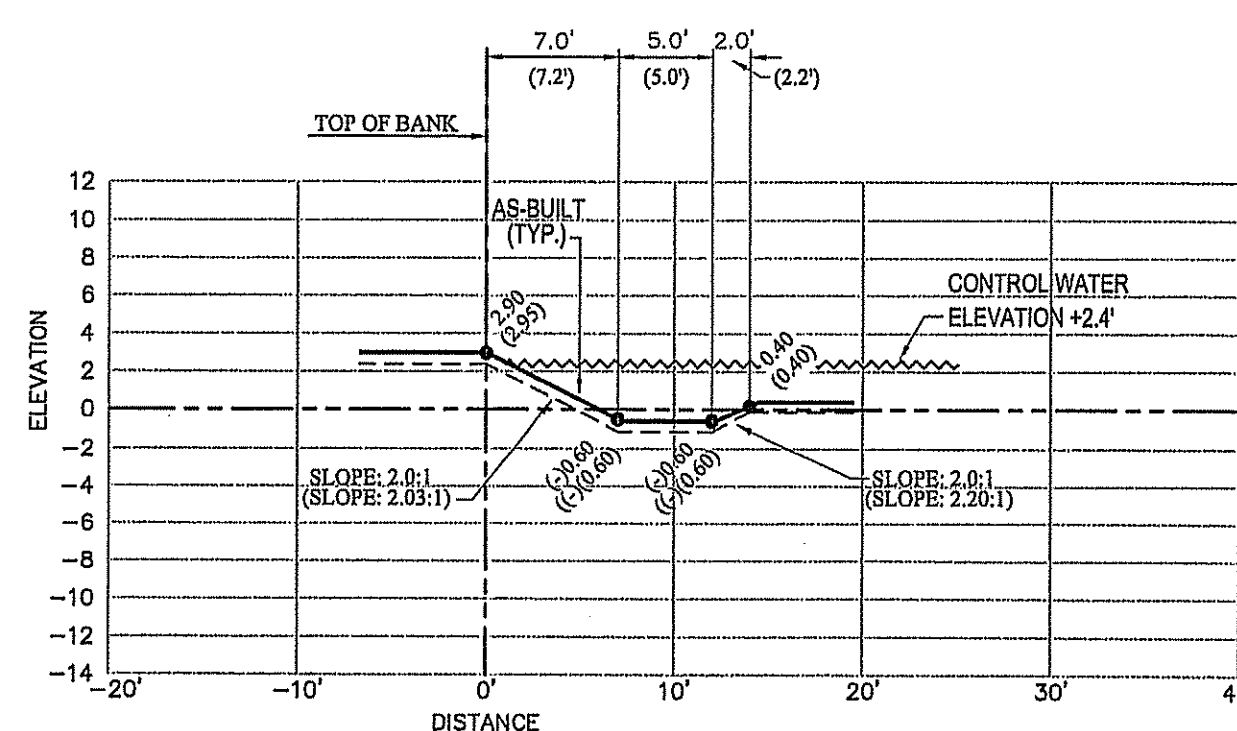


SECTION No. 49
HYDRIC ISLAND

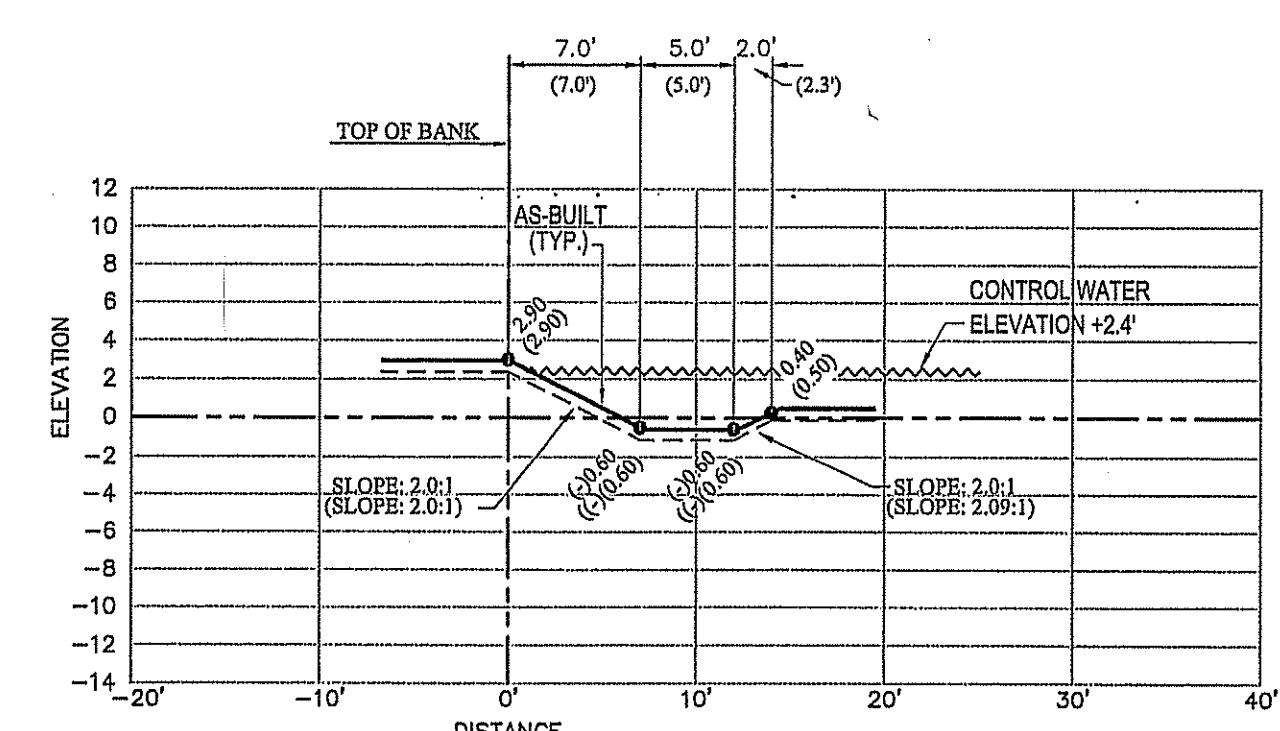


SECTION No. 50
HYDRIC ISLAND

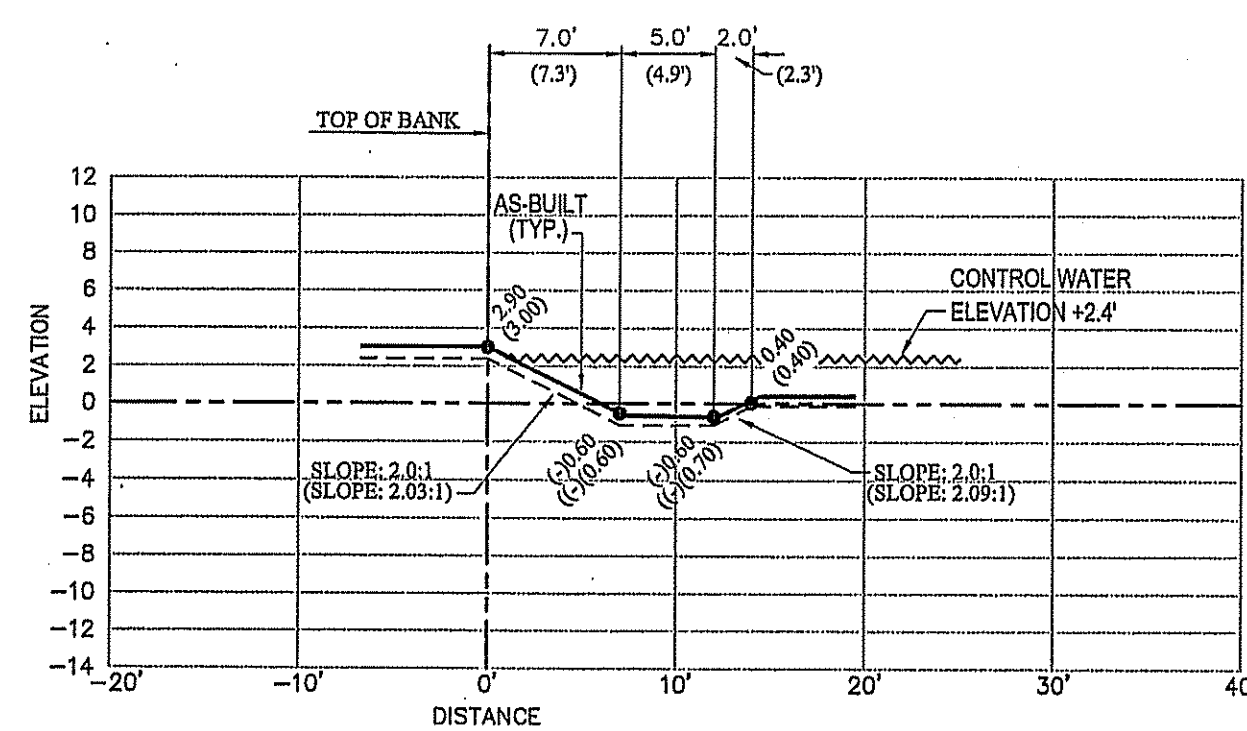

SECTION No. 51
HYDRIC ISLAND

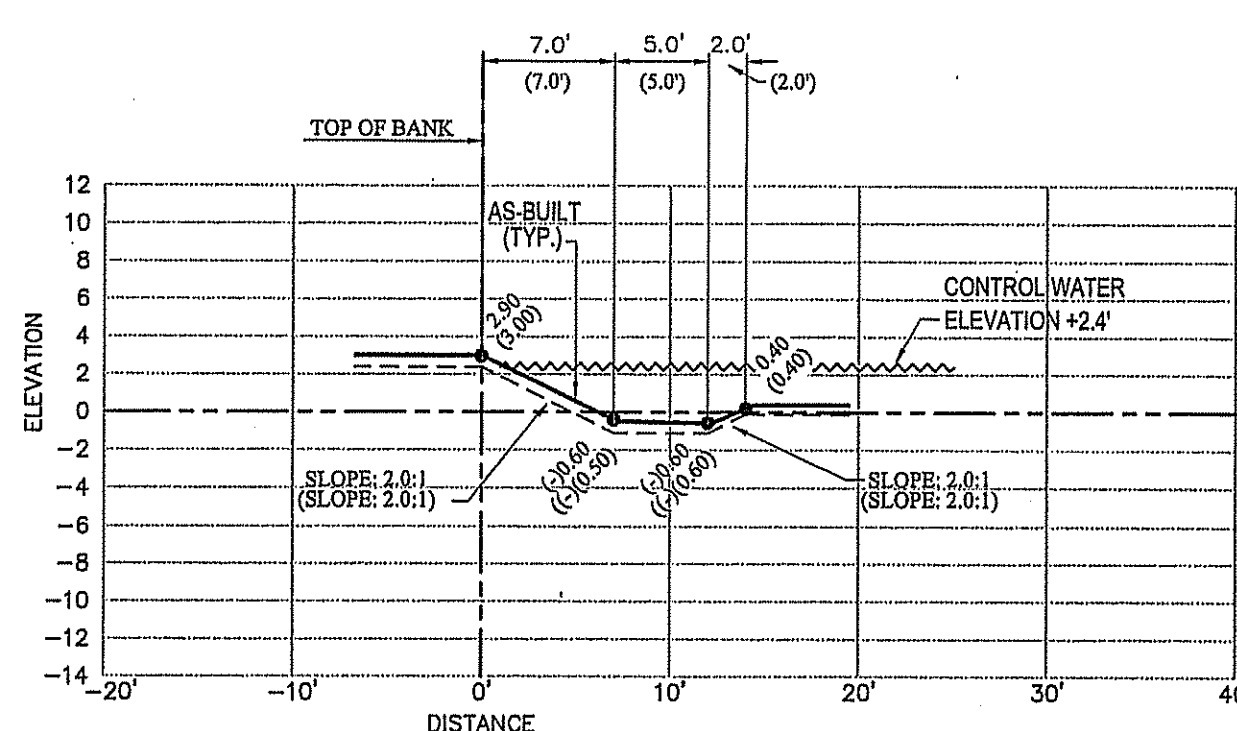

SECTION No. 52
HYDRIC ISLAND

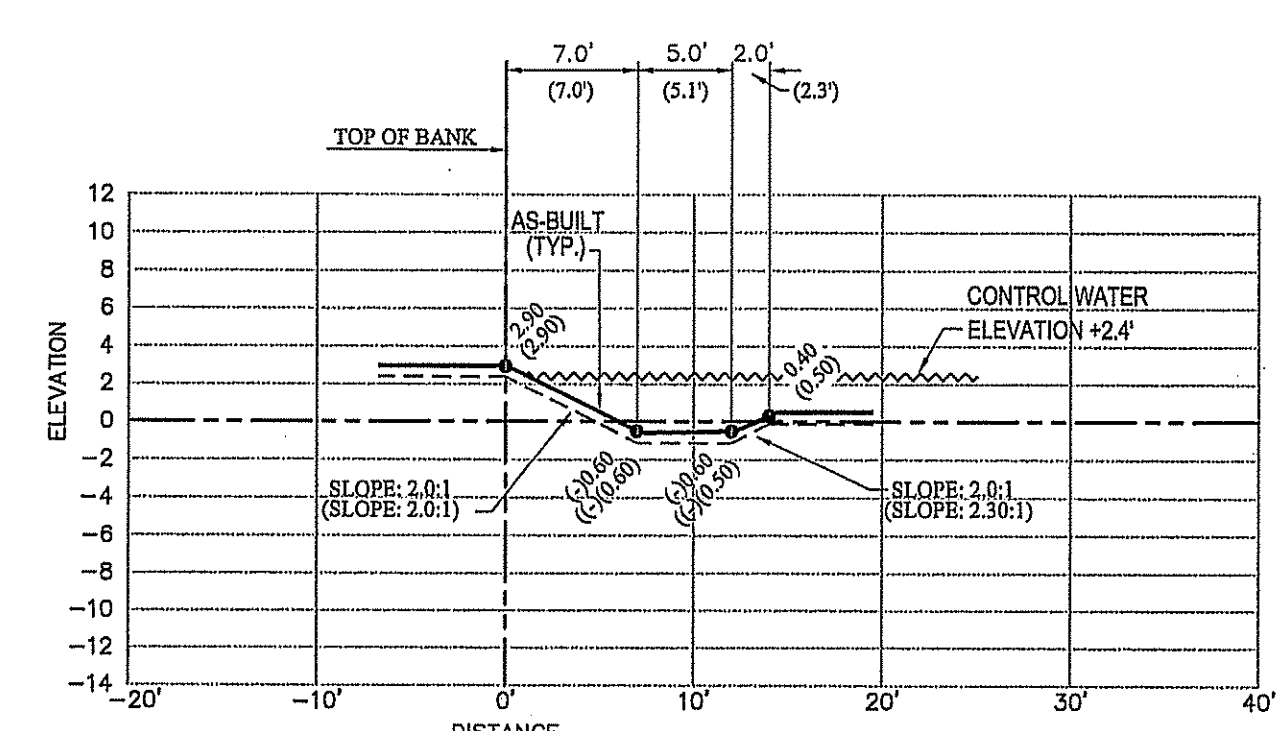

SECTION No. 53
HYDRIC ISLAND

AS-BUILT LEGEND:

- (15.2) DENOTES AS-BUILT DISTANCE
- 15.0' DENOTES DESIGN DISTANCE
- 4.5 DENOTES AS-BUILT ELEVATION
- 4.0 DENOTES DESIGN ELEVATION
- (SLOPE: 20.2:1) DENOTES AS-BUILT SLOPE
- SLOPE: 20.0:1 DENOTES DESIGN SLOPE
- L.M.E. DENOTES LAKE MAINTENANCE EASEMENT
- DENOTES AS-BUILT LINE
- - - - - DENOTES DESIGN LINE

NOTE:
THE AS-BUILT LINEWORK SHOWN HEREON IS A GRAPHICAL REPRESENTATION AND MAY NOT BE DRAWN TO SCALE FOR CLARITY PURPOSES.

CERTIFICATE:
I HEREBY CERTIFY THAT THESE RECORD DRAWINGS FOR THE FACILITY HAVE BEEN REVIEWED BY ME OR BY INDIVIDUAL(S) UNDER MY DIRECT SUPERVISION FOR COMPLETENESS AND ADEQUACY, AND ARE TRUE AND CORRECT TO THE BEST OF MY KNOWLEDGE AND BELIEF. THE FIELD WORK FOR THE AS-BUILT DRAWINGS HAS BEEN DONE BY: Joseph L. Martin, P.S.M. #4368
10/20/2022

DATE: 12/10/2021

BY: JOSEPH L. MARTIN
PROFESSIONAL SURVEYOR
& MAPPER - P.S.M. #4368
STATE OF FLORIDA

THIS DOCUMENT CONSISTS OF 18 SHEETS AND EACH SHEET SHALL NOT BE CONSIDERED VALID WITHOUT SHEET 1.

**SIERRA RANCH
DAVIE, FL**

AS-BUILT CROSS SECTIONS
1950 SOUTH HIATUS ROAD
SEC. 18, TWP. 50S, RGE. 41E

PROJ. TYPE: AS-BUILT CROSS SECTIONS
PROJ. LOC.: 1950 SOUTH HIATUS ROAD
SECTION: SEC. 18, TWP. 50S, RGE. 41E
DATE: 04/14/2021
DRE PROJECT No.: 2019-043
SHEET No.: 10 of 18


REVISION COMMENTS
DATE
BY APP
L.A. J.M.
L.A. J.M.
L.A. J.M.
L.A. G.B.


REVISION COMMENTS
DATE
BY APP
L.A. J.M.
L.A. J.M.
L.A. J.M.
L.A. G.B.

REVISION COMMENTS
DATE
BY APP
L.A. J.M.
L.A. J.M.
L.A. J.M.
L.A. G.B.


REVISION COMMENTS
DATE
BY APP
L.A. J.M.
L.A. J.M.
L.A. J.M.
L.A. G.B.

10 of 18

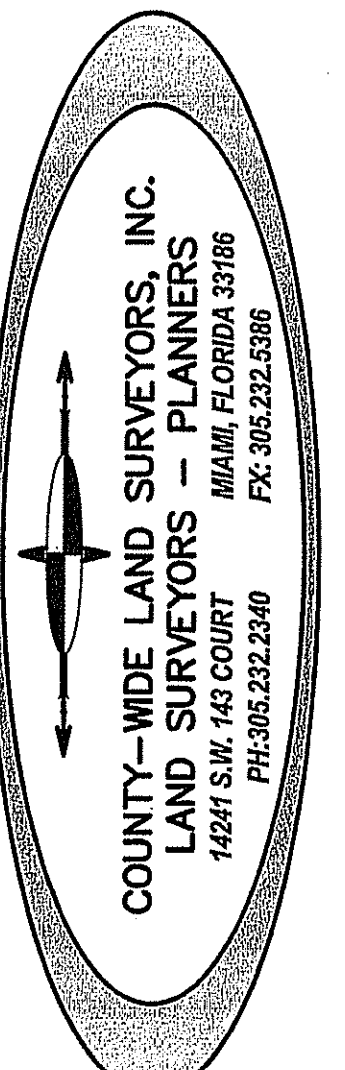


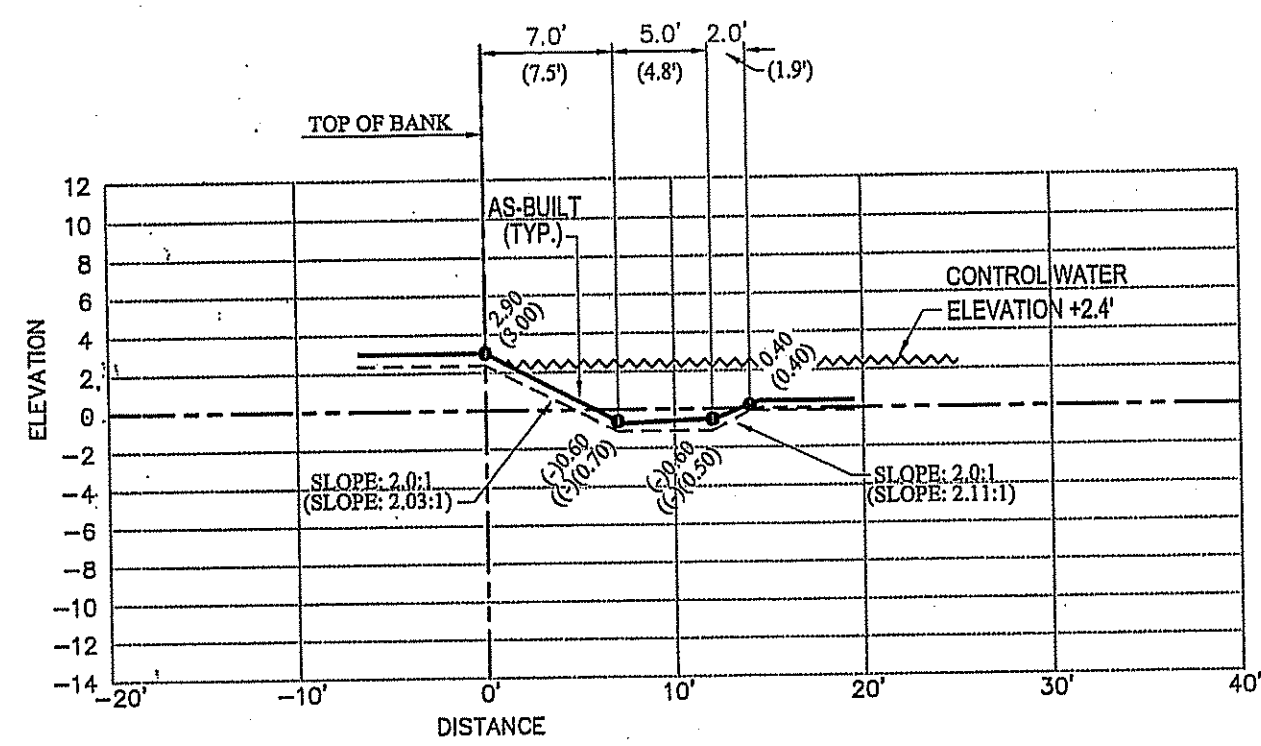


SECTION No. 54
HYDRIC ISLAND

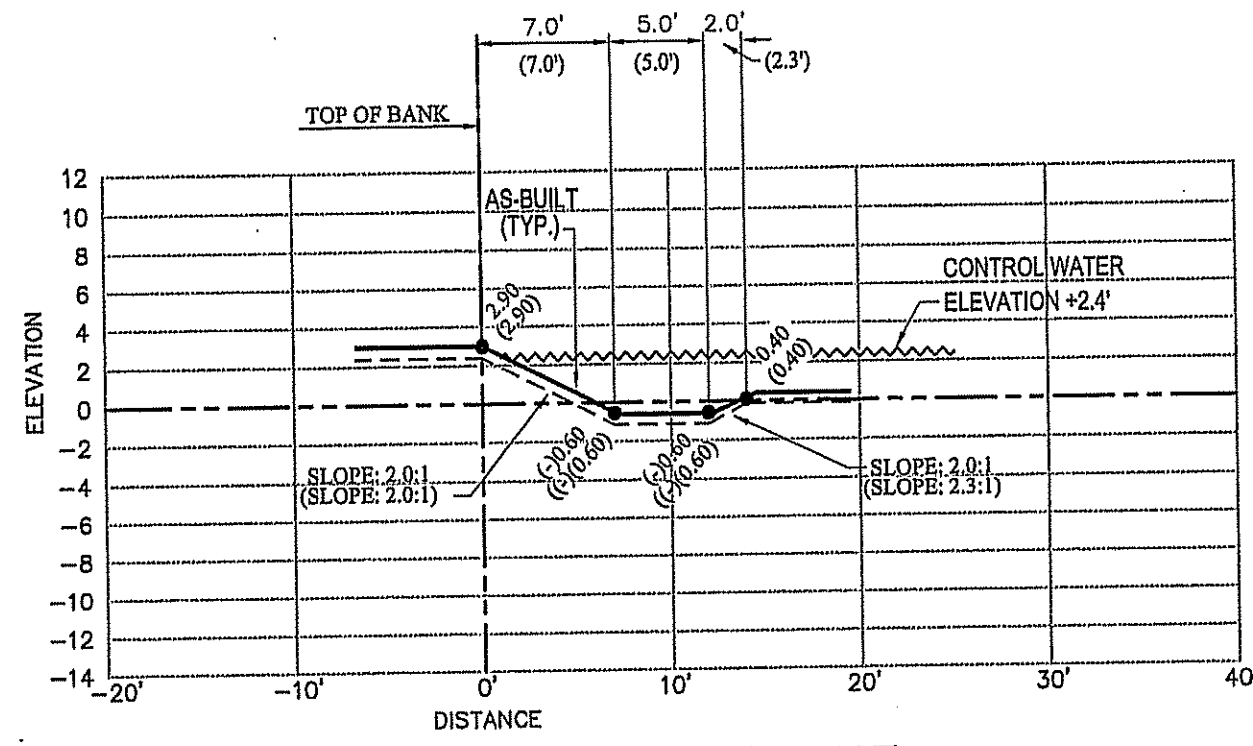


SECTION No. 55
HYDRIC ISLAND

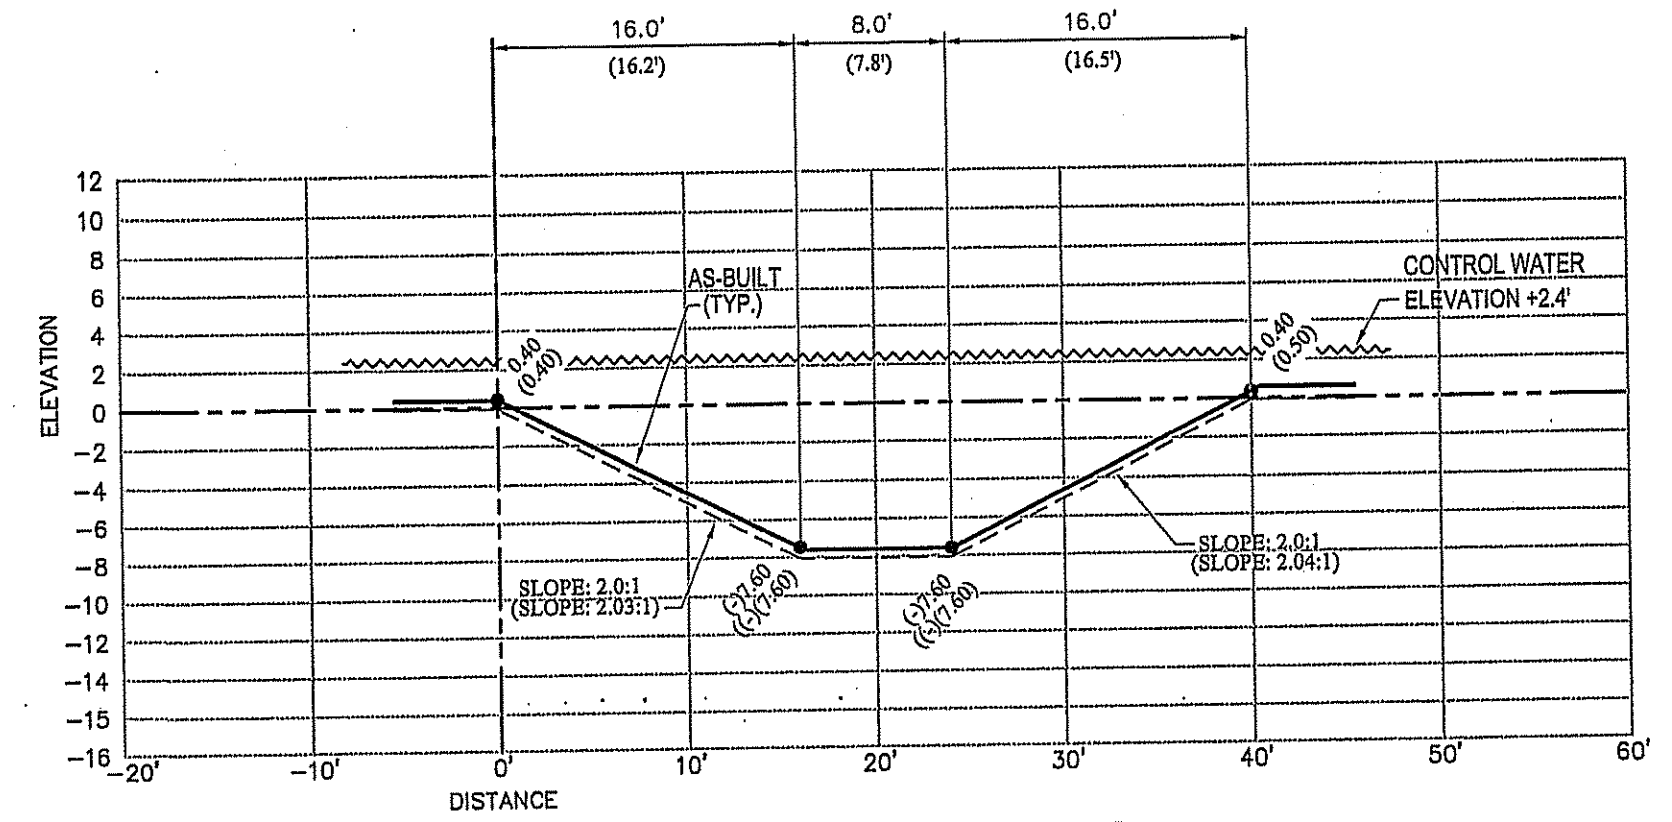


SECTION No. 56
40' CHANNEL

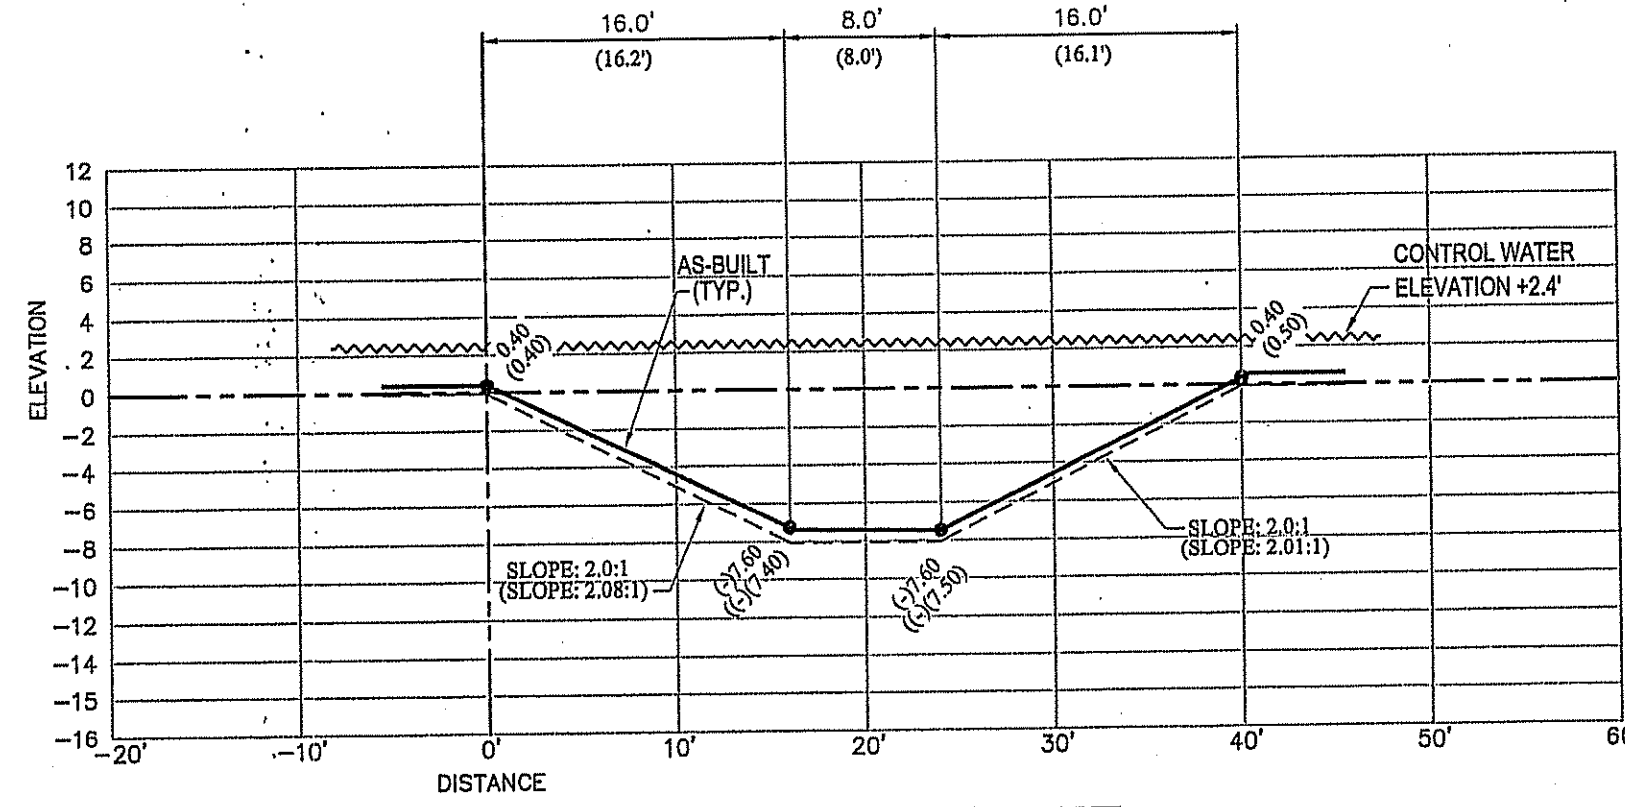


SECTION No. 57
40' CHANNEL

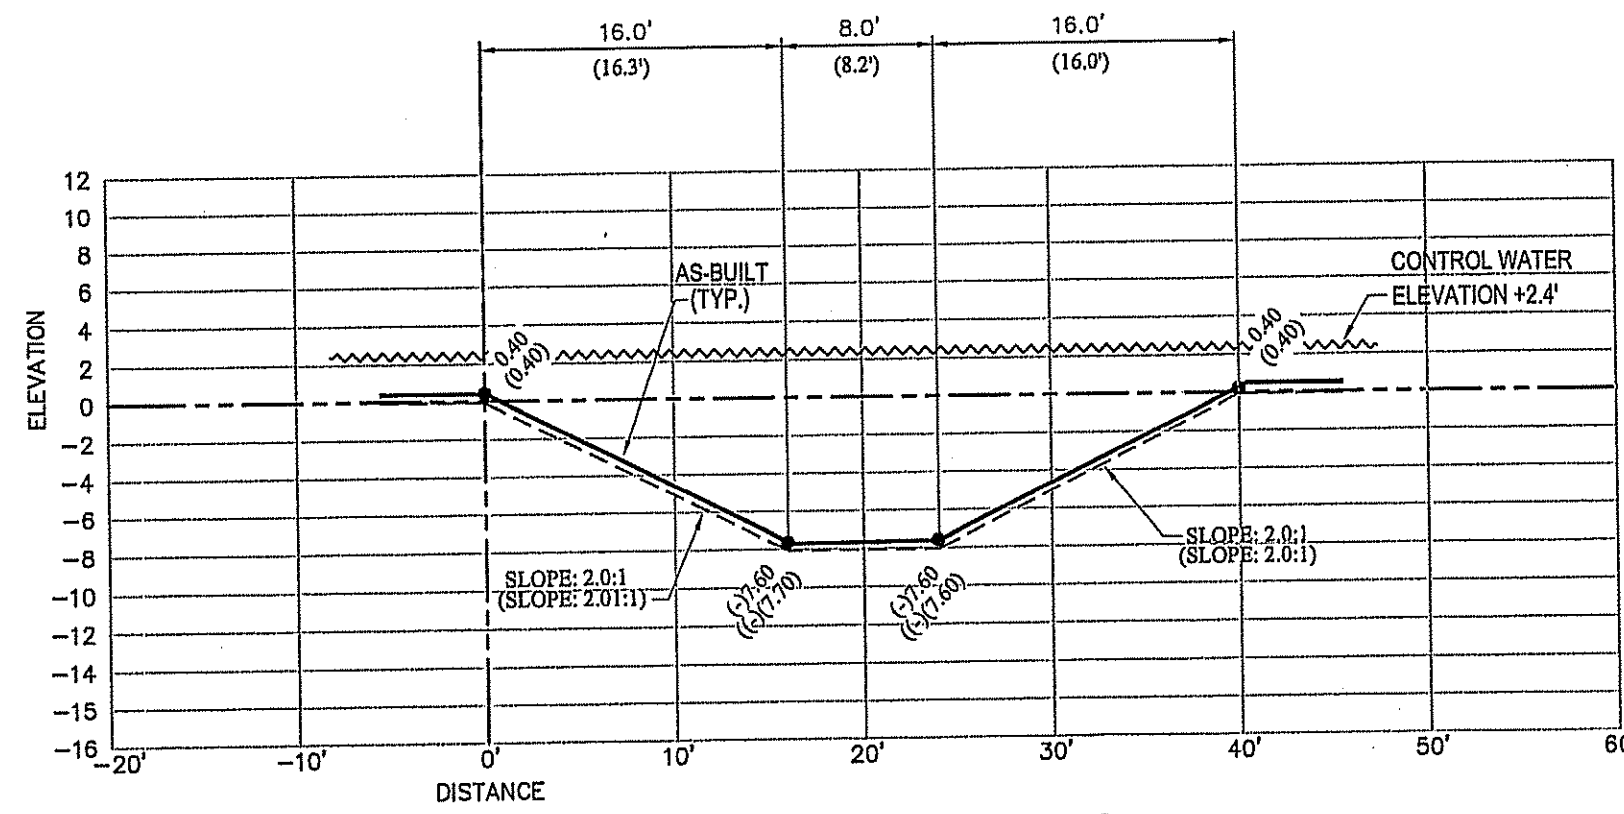


SECTION No. 58
40' CHANNEL

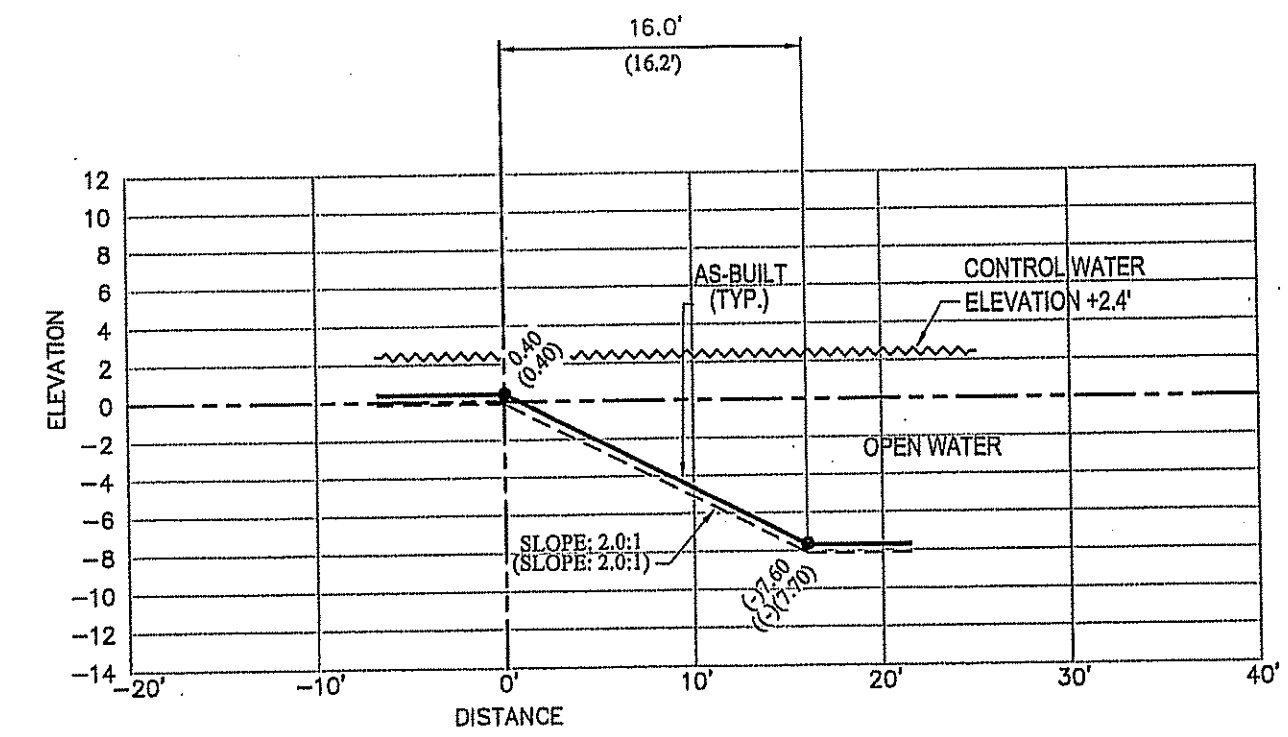


SECTION No. 59
OPEN WATER

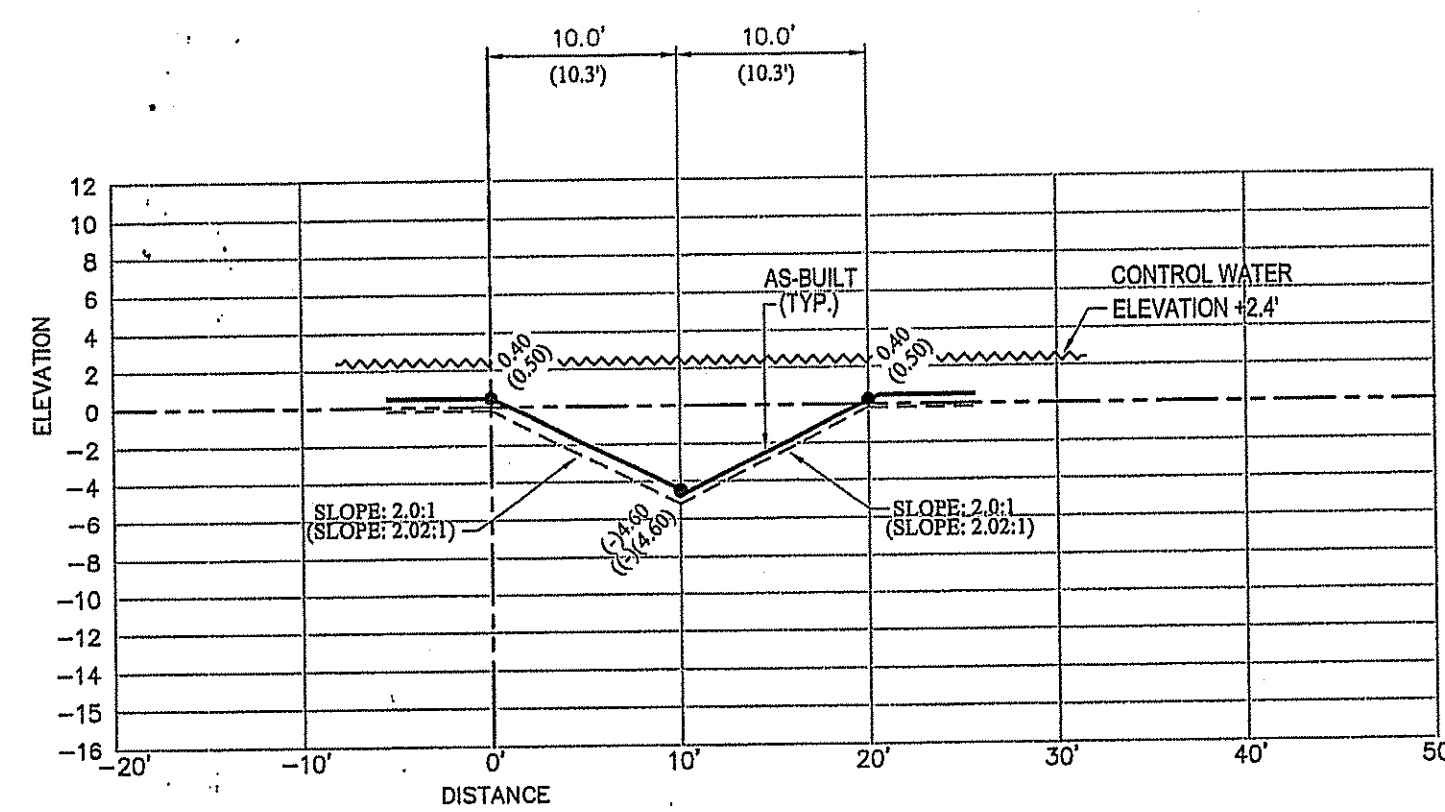

SECTION No. 60
20' CHANNEL

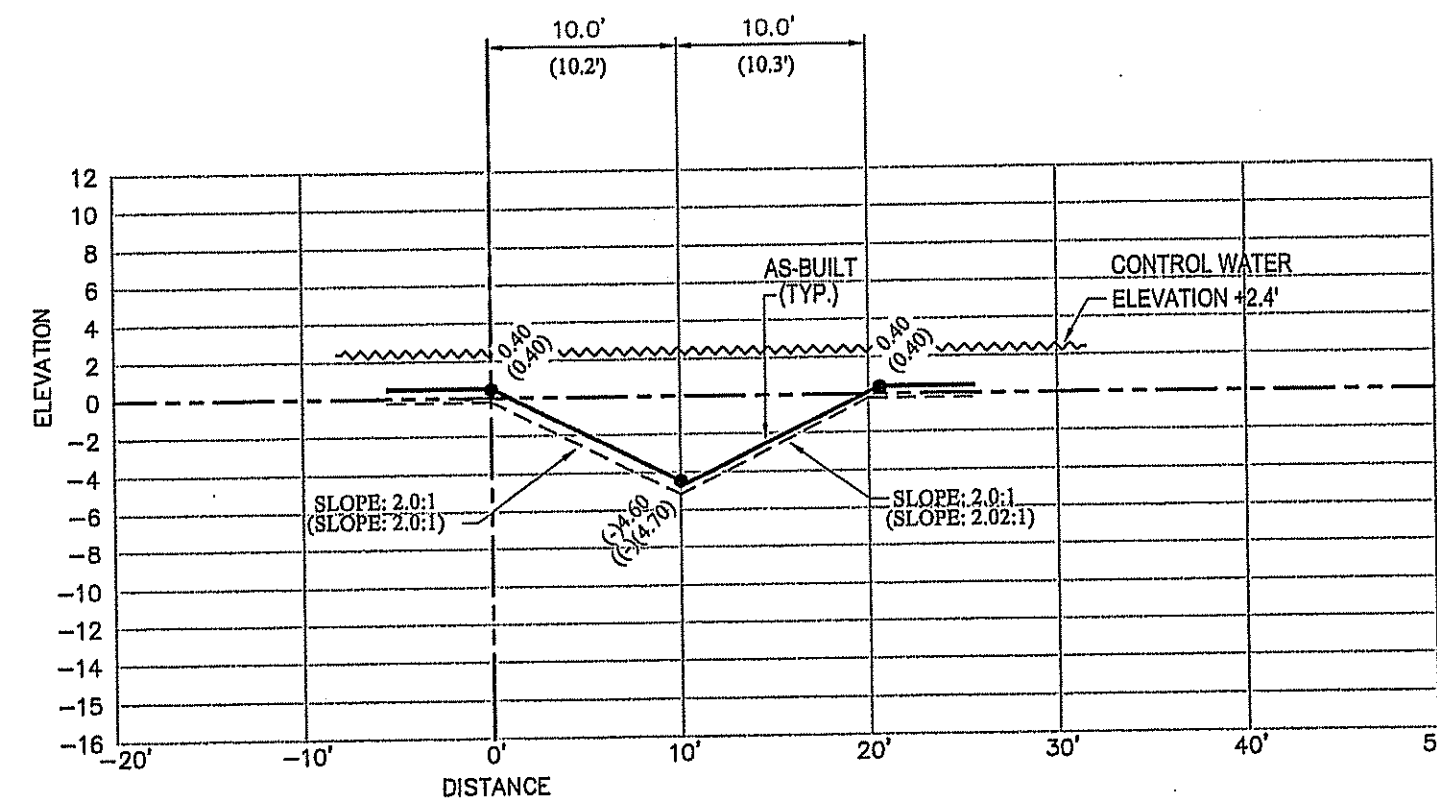

SECTION No. 61
20' CHANNEL

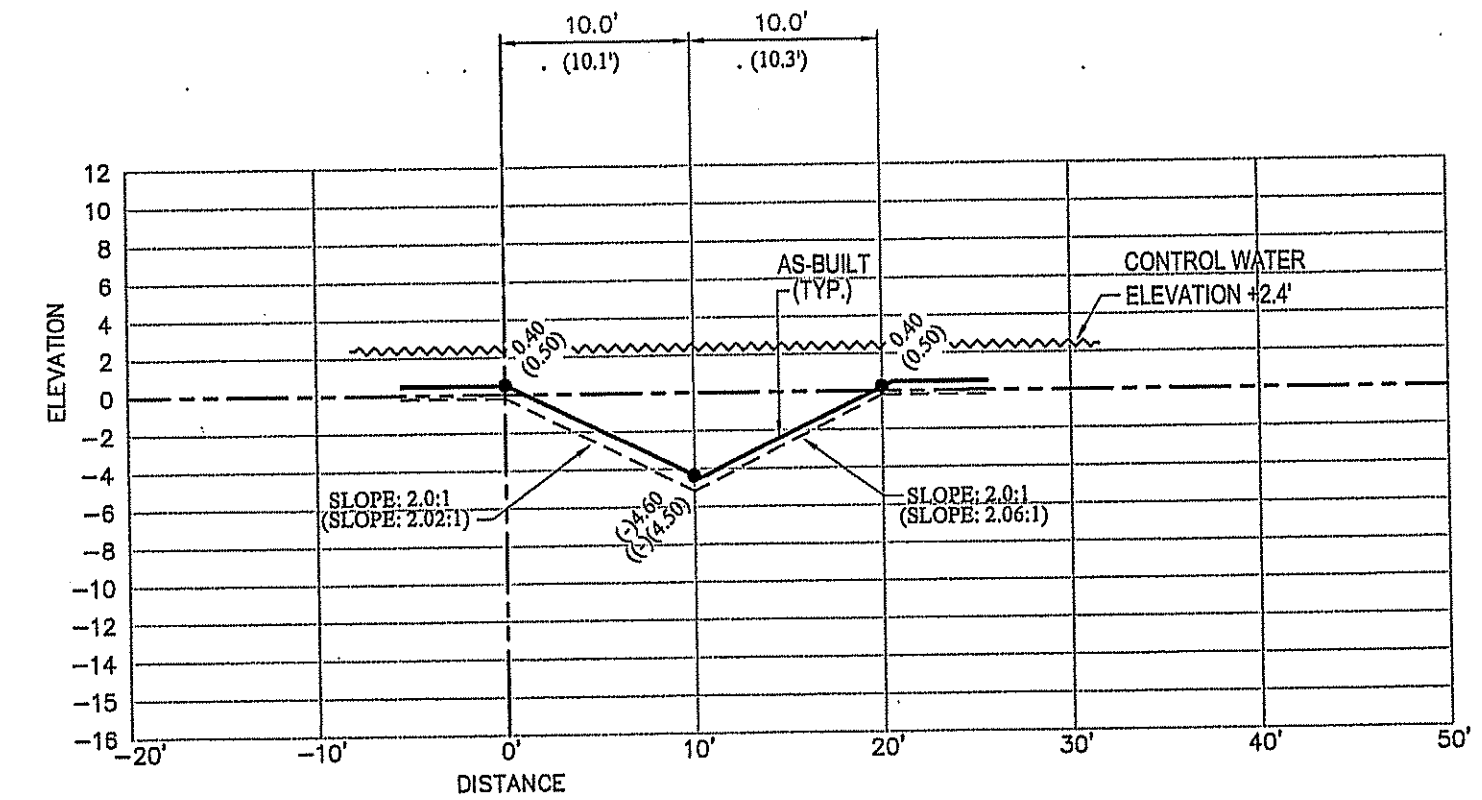

SECTION No. 62
20' CHANNEL

Chad E. Edwards, State of Florida,
Professional Engineer, License No. 59308.

This item has been digitally signed and sealed by
Chad E. Edwards, on the date indicated here.
Printed copies of this document are not
considered signed and sealed and the signature
must be verified on any electronic copies.

Digitally signed by
Chad Everett
Edwards
Date: 2022.10.27
09:29:46 -04'00'

AS-BUILT LEGEND:

- (15.2) DENOTES AS-BUILT DISTANCE
- (15.0) DENOTES DESIGN DISTANCE
- (5) DENOTES AS-BUILT ELEVATION
- (5) DENOTES DESIGN ELEVATION
- (SLOPE: 2.0:1) DENOTES AS-BUILT SLOPE
- (SLOPE: 2.0:1) DENOTES DESIGN SLOPE
- L.M.E. DENOTES LAKE MAINTENANCE BASEMENT
- DENOTES AS-BUILT LINE
- DENOTES DESIGN LINE

NOTE:

THE AS-BUILT LINEWORK SHOWN HEREON IS A GRAPHICAL REPRESENTATION
AND MAY NOT BE DRAWN TO SCALE FOR CLARITY PURPOSES.


THIS DOCUMENT CONSISTS OF 18 SHEETS AND EACH
SHEET SHALL NOT BE CONSIDERED VALID WITHOUT
SHEET 1.


DATE: 12/10/2021 BY:

JOSEPH L. MARTIN
PROFESSIONAL SURVEYOR
& MAPPER PS/MF 4368
STATE OF FLORIDA

PROJ. TYPE	DATE	REVISION COMMENTS	BY	APP
AS-BUILT CROSS SECTIONS	05-18-21	REVISED PER ENGINEER'S COMMENTS	L.A.	J.M.
1950 SOUTH HIATUS ROAD	11-8-21	REVISED TO ADD SECTIONS FROM 16 TO 36	L.A.	J.M.
SEC. 18, TWP. 50S, RGE. 41E	12-8-21	REVISED TO ADD SECTIONS FROM 37 TO 125	L.A.	G.B.
	12-10-21	REVISED PER ENGINEER'S COMMENTS	L.A.	G.B.

SCALE:	H:1"=10' / V:1"=10'
SURVEYOR:	COUNTY-WIDE
DRAWN BY:	LESLEY
CHECKED BY:	G.B.
AS-BUILT:	PRESERVE AREA
DATE:	04/14/2021
PREL. PROJECT No:	2019-043
SHEET No:	11 of 18

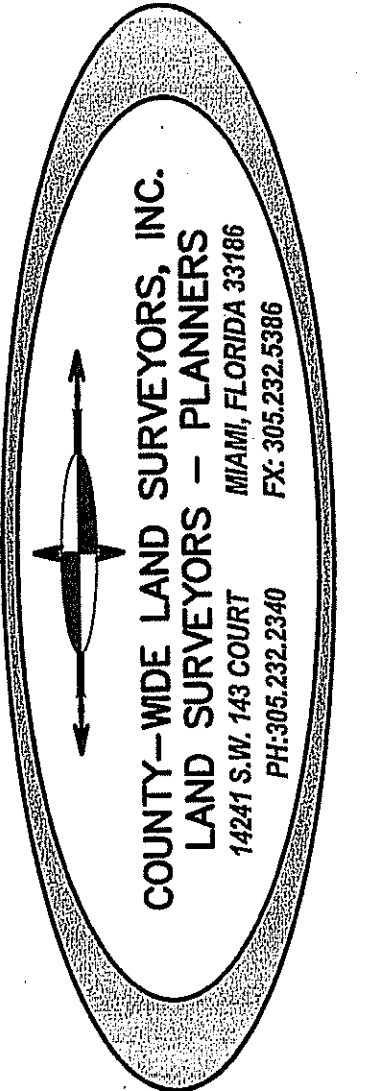


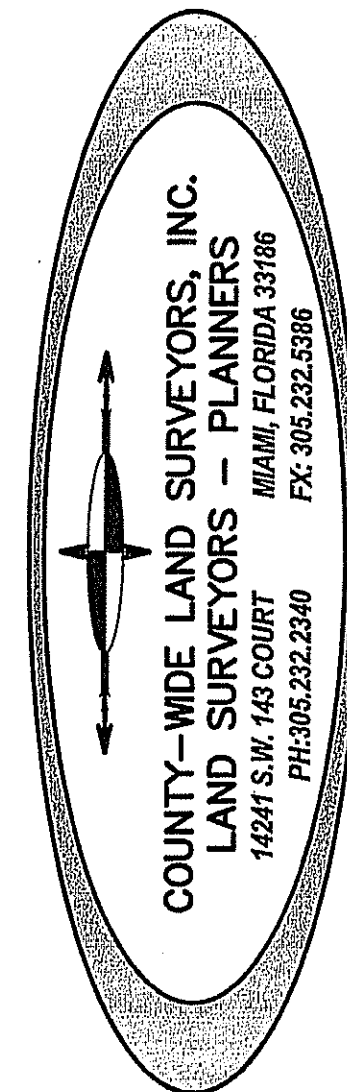


SIERRA RANCH
DAVIE, FL.

BY	APP	REVISION COMMENTS	DATE	AS-BUILT CROSS SECTIONS
L.A.	J.M.	REVISED PER ENGINEER'S COMMENTS	05-18-21	1950 SOUTH HIATUS ROAD
L.A.	J.M.	REVISED TO ADD SECTIONS FROM 16 TO 36	11-8-21	SEC. 18, TWP. 50S, RGE. 41E
L.A.	J.M.	REVISED TO ADD SECTIONS FROM 37 TO 125	12-8-21	
L.A.	G.B.	REVISED PER ENGINEER'S COMMENTS	12-10-21	


SCALE:	H:1"=10' / V:1"=10'
SURVEYOR:	COUNTY-WIDE
DRAWN BY:	LESLEY
CHECKED BY:	G.B.
AS-BUILT:	PRESERVE AREA
DATE:	04/14/2021
DRE PROJECT NO:	2019-043
SHEET NO:	

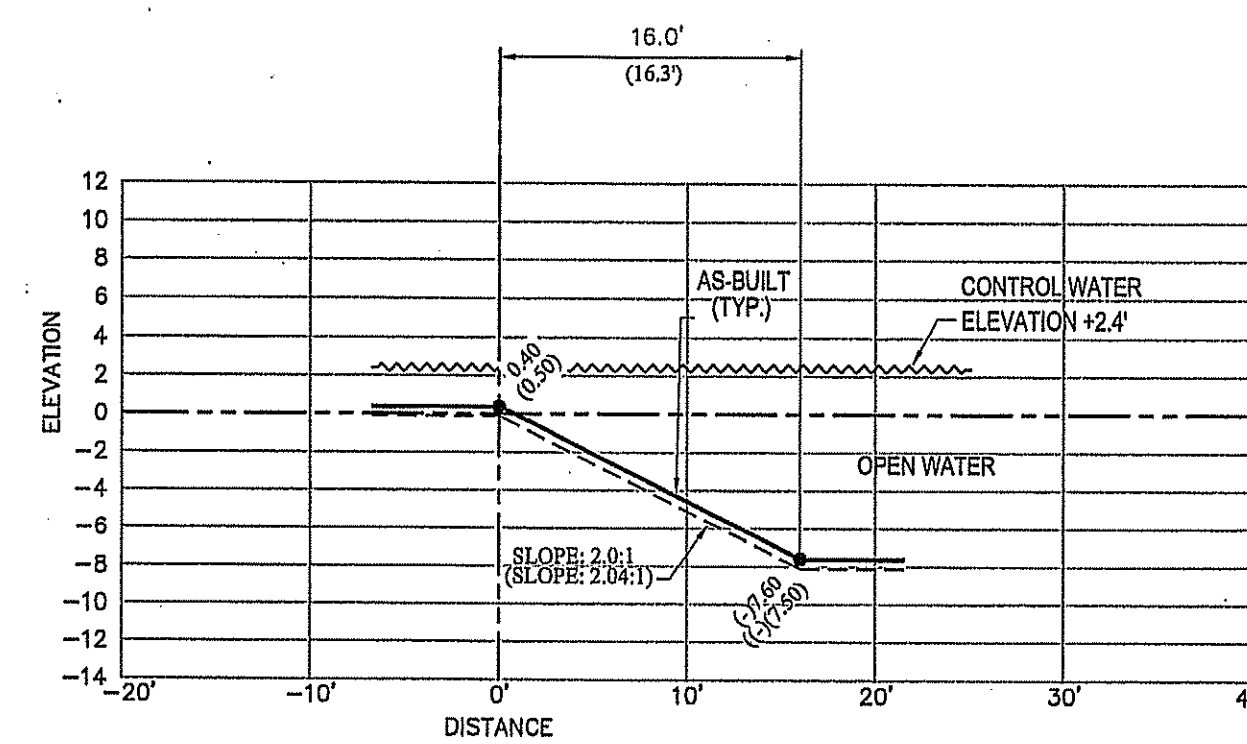


SECTION No. 63
OPEN WATER

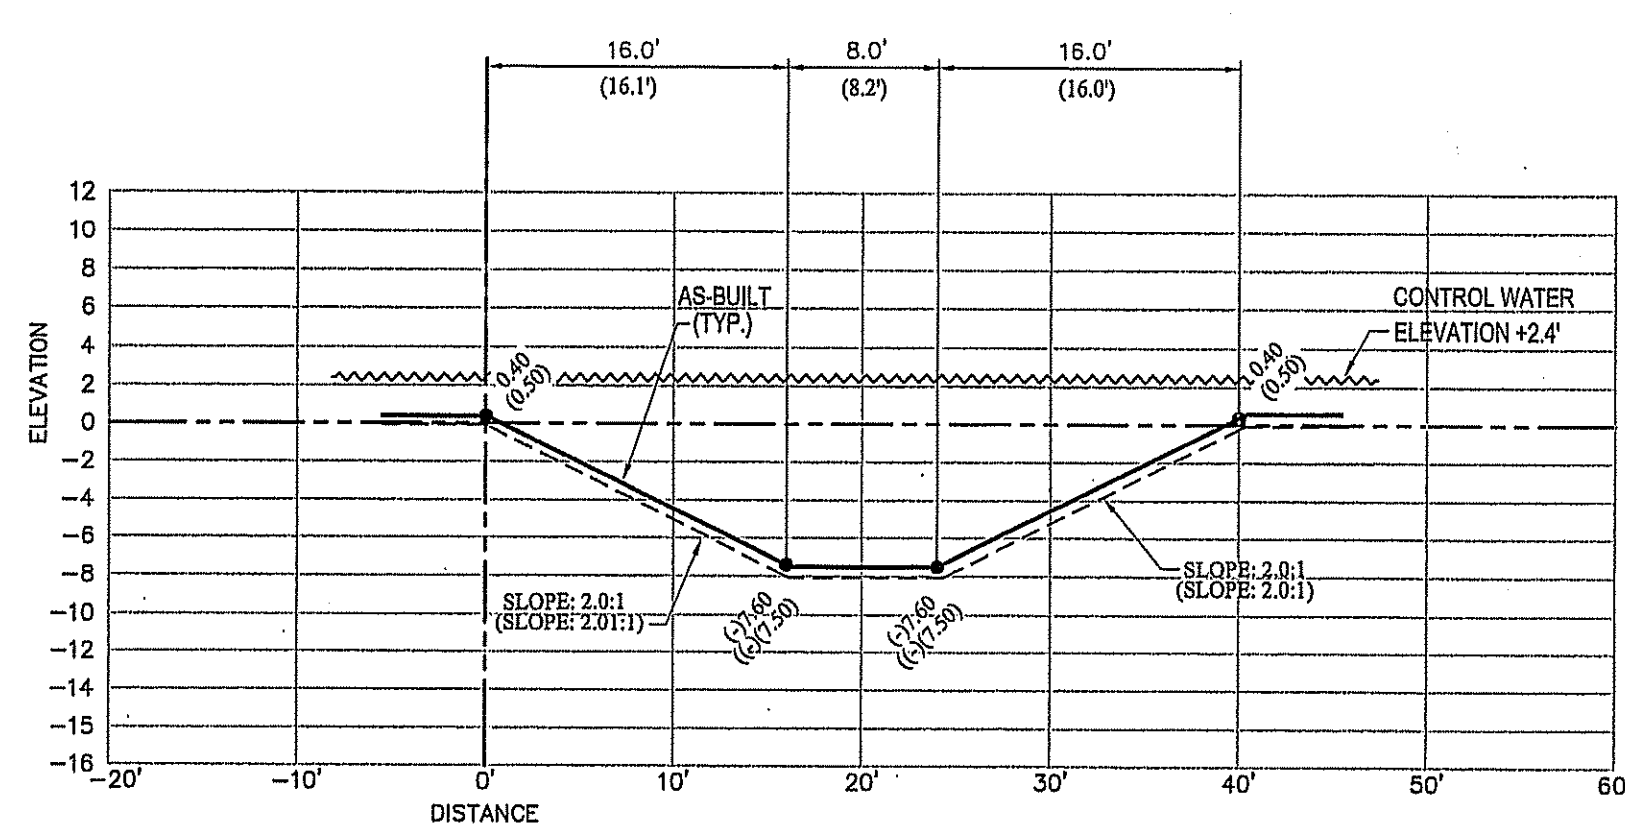


SECTION No. 64
40' CHANNEL

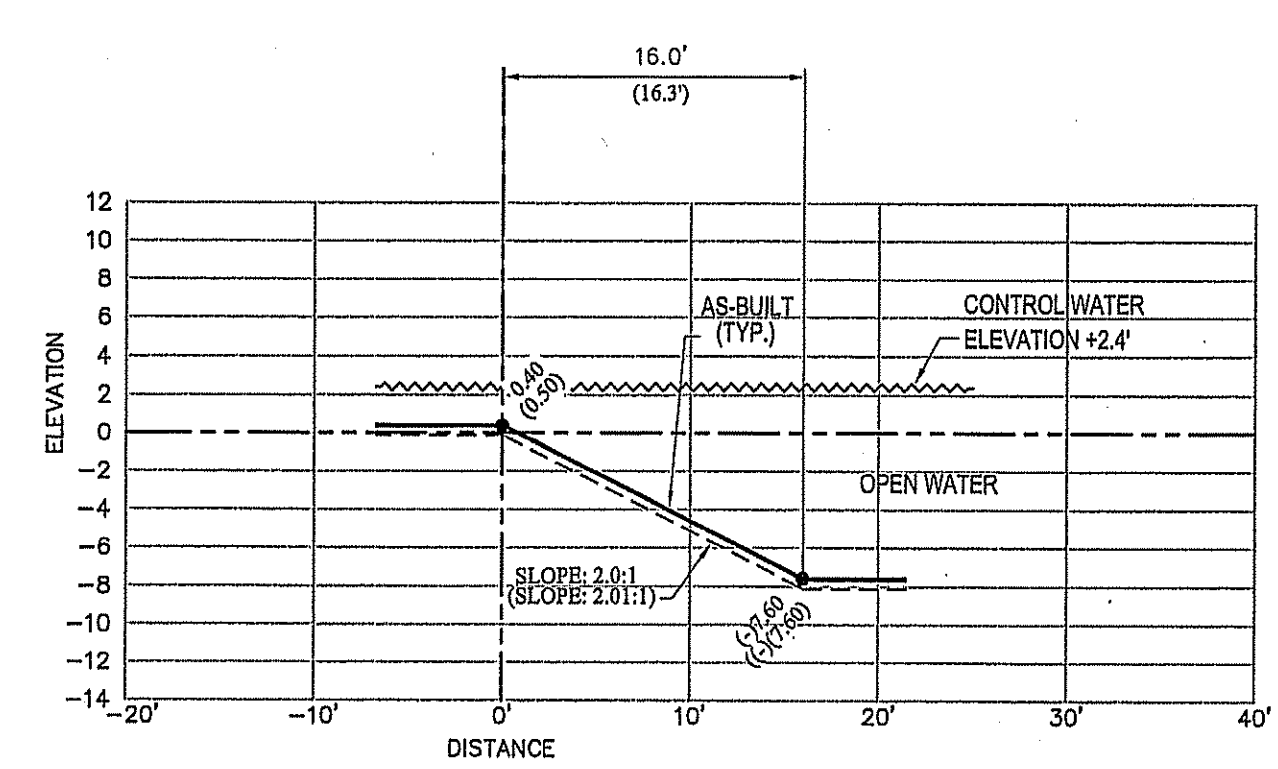


SECTION No. 65
OPEN WATER

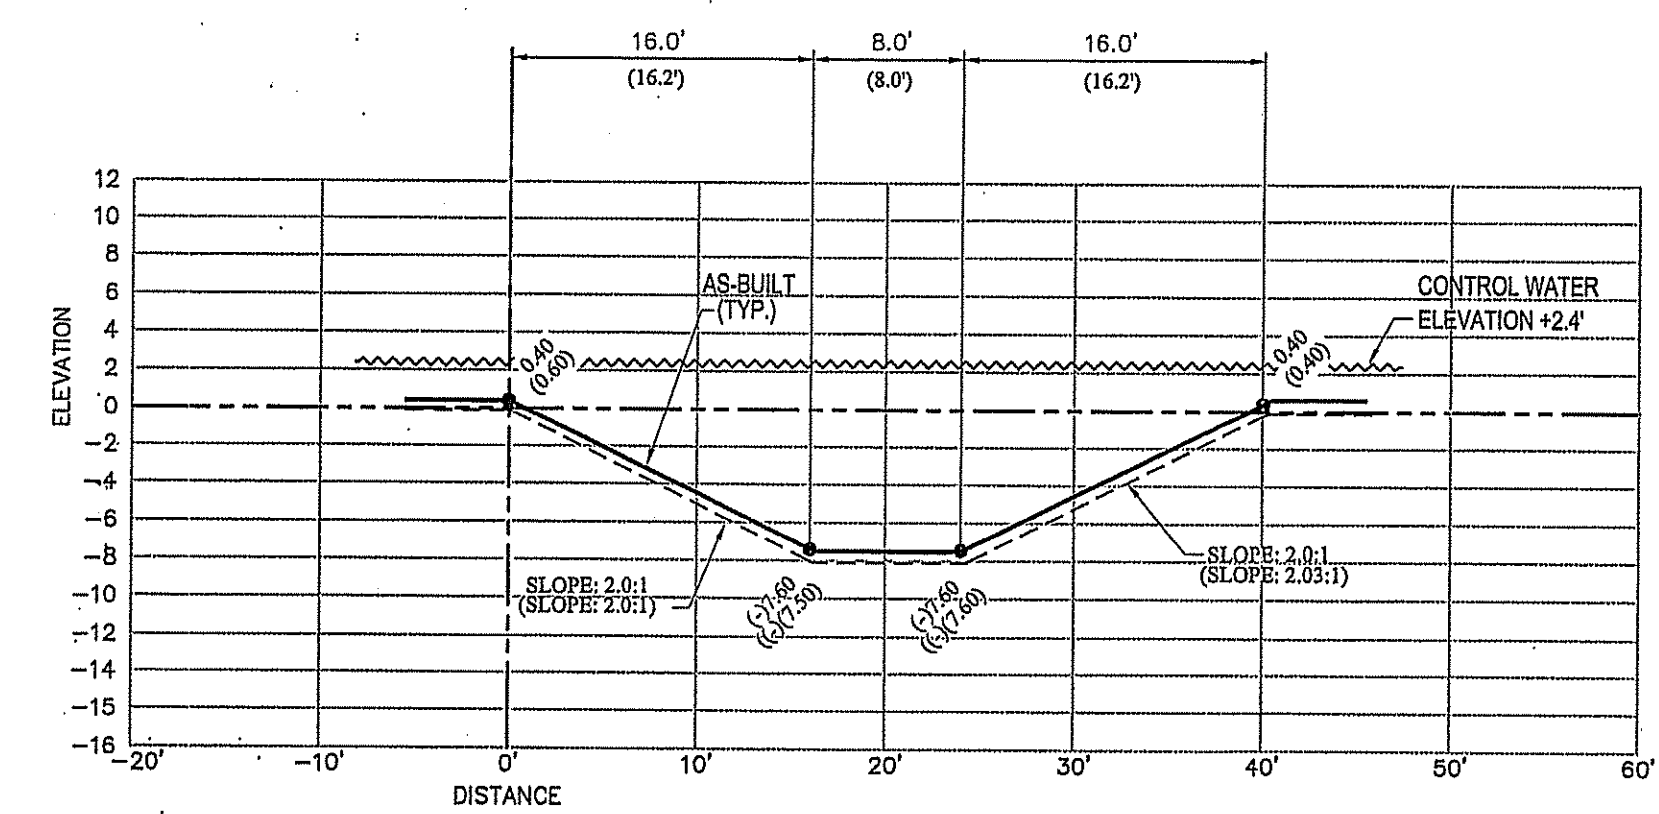


SECTION No. 66
40' CHANNEL

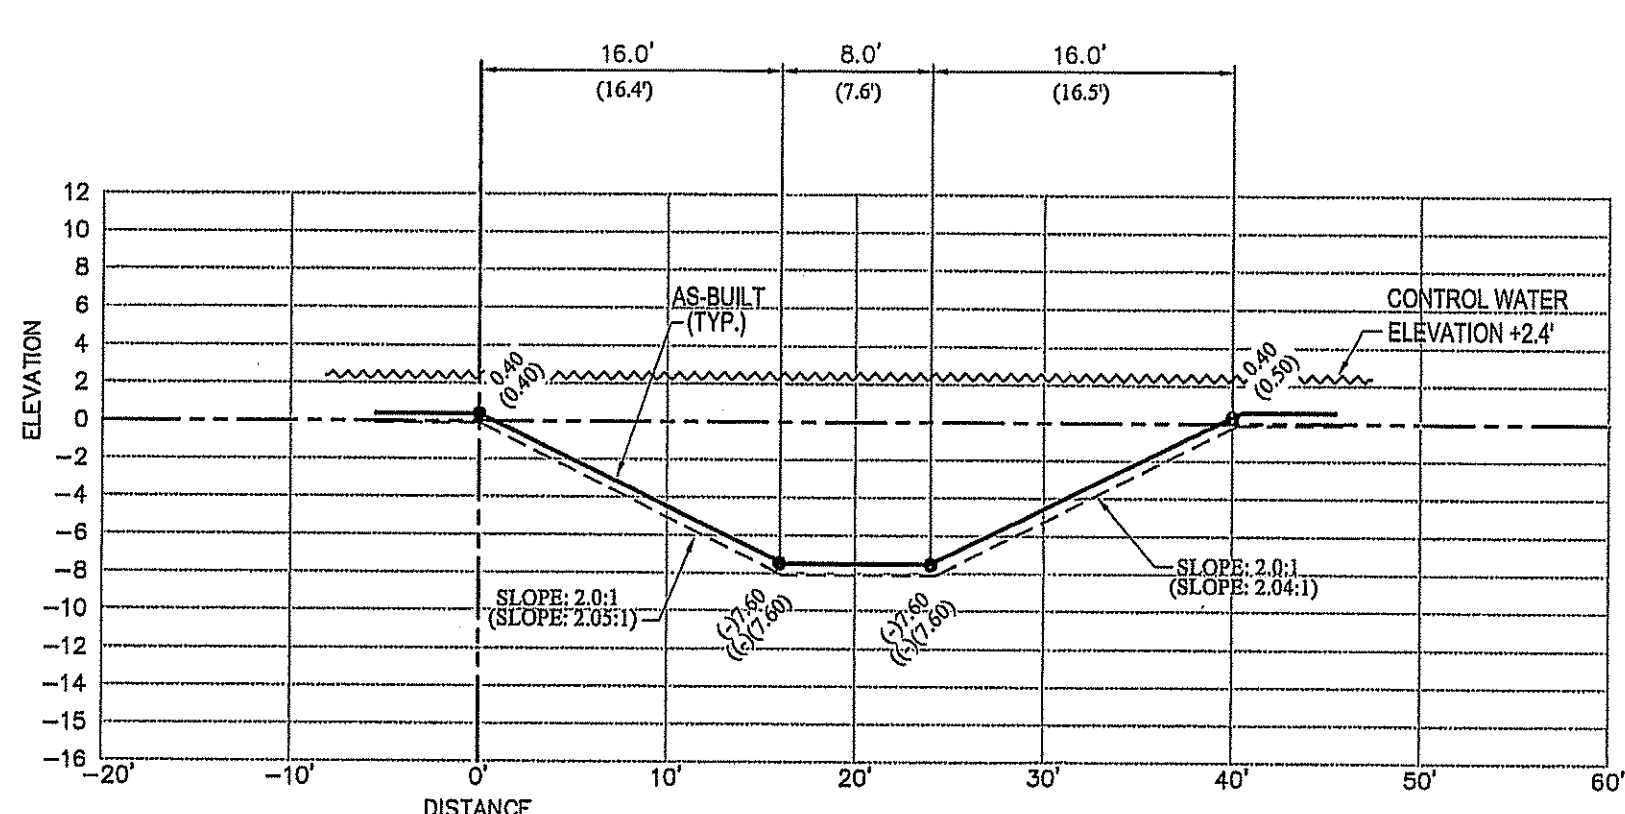


SECTION No. 67
40' CHANNEL

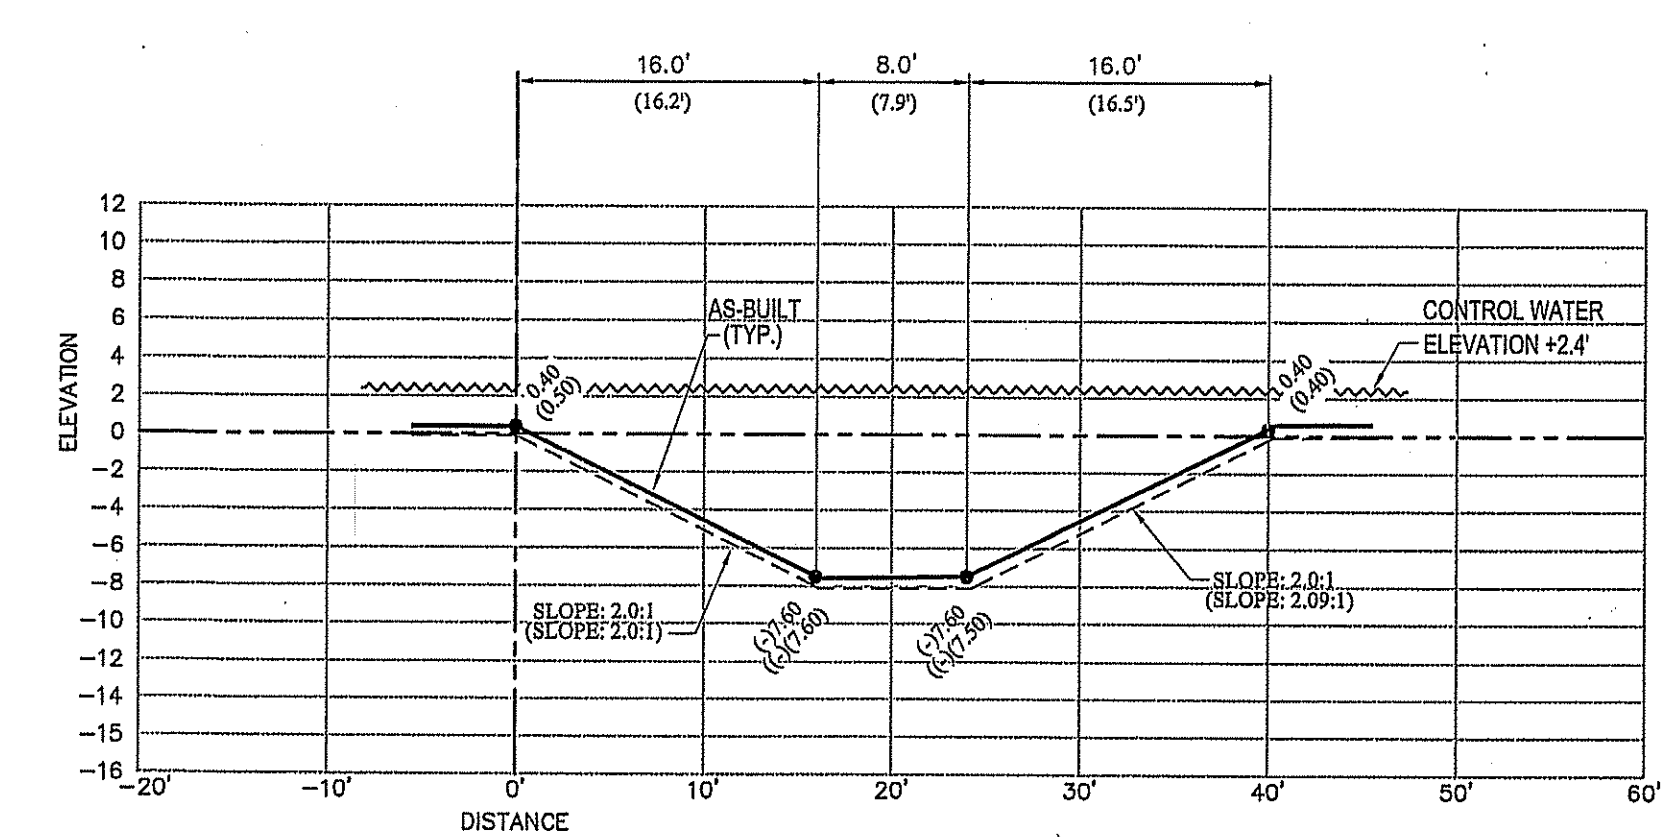


SECTION No. 68
40' CHANNEL

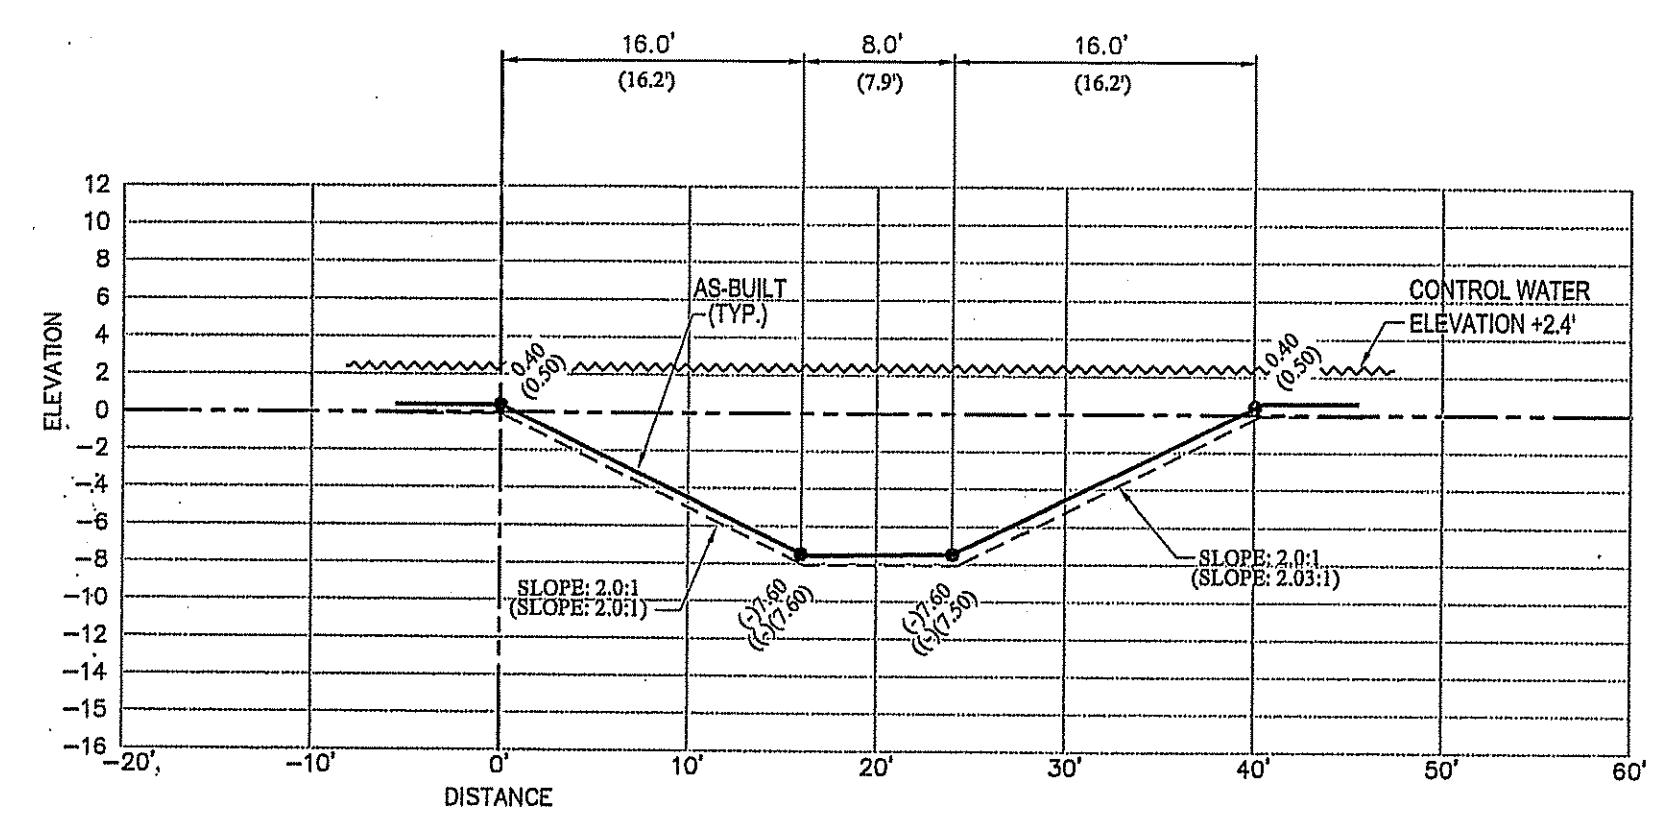

SECTION No. 69

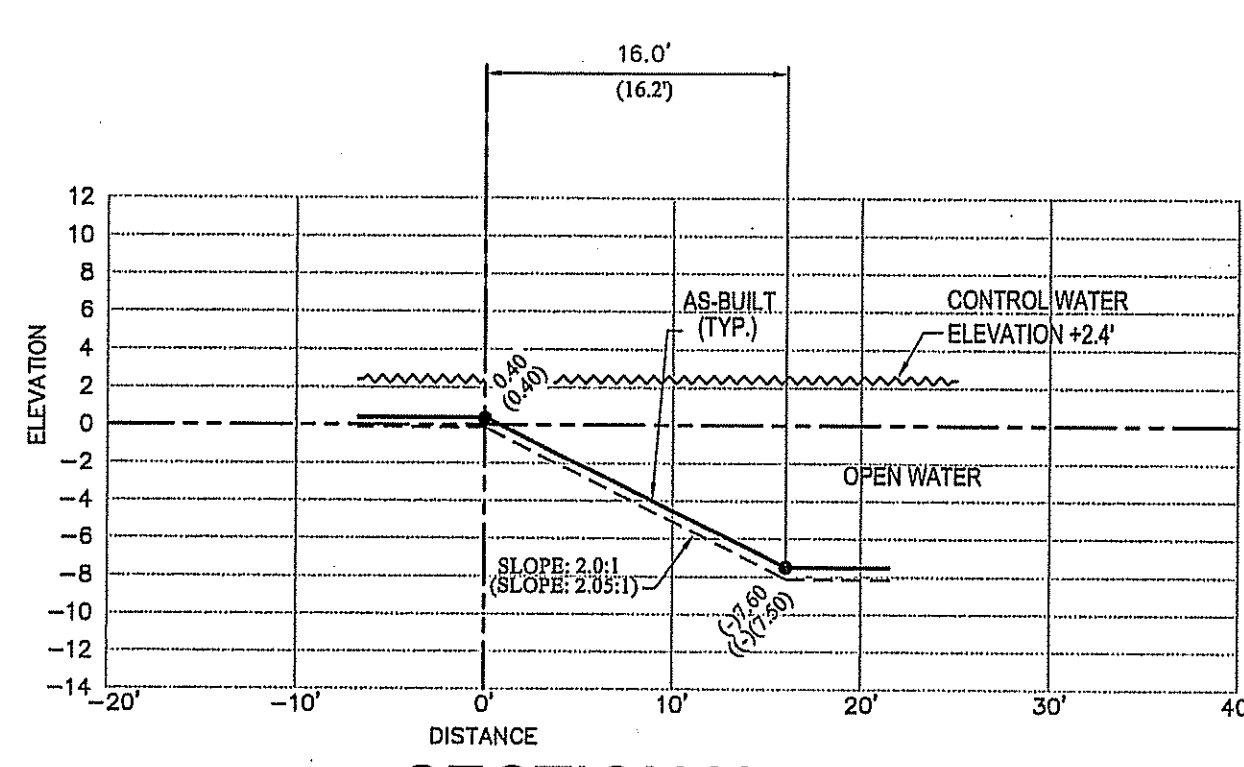

SECTION No. 70
OPEN WATER

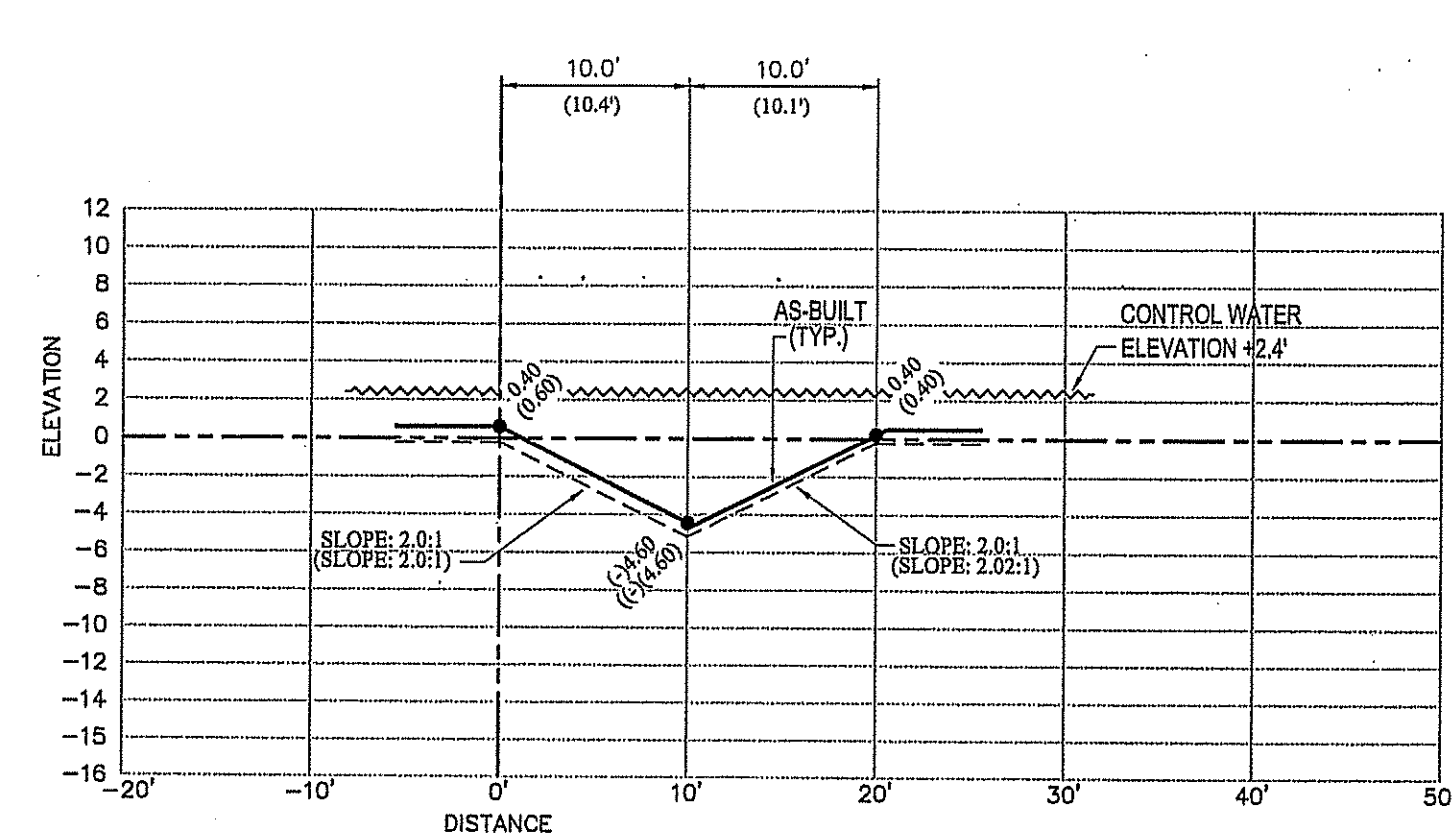

SECTION No. 71

Chad E. Edwards, State of Florida,
Professional Engineer, License No. 59306

This item has been digitally signed and sealed by
Chad E. Edwards, on the date indicated here.
Printed copies of this document are not
considered signed and sealed and the signature
must be verified on any electronic copies.

Chad Everett Edwards
Digitally signed by Chad
Everett Edwards
Date: 2022.10.27
09:30:14 -04'00'

AS-BUILT LEGEND:


- (15.2) DENOTES AS-BUILT DISTANCE
- 15.0' DENOTES DESIGN DISTANCE
- 6.9 DENOTES AS-BUILT ELEVATION
- 6.9 DENOTES DESIGN ELEVATION
- (SLOPE: 2.0:1) DENOTES AS-BUILT SLOPE
- SLOPE: 2.0:1 DENOTES DESIGN SLOPE
- L.M.E. DENOTES LAKE MAINTENANCE EASEMENT
- DENOTES AS-BUILT LINE
- DENOTES DESIGN LINE

NOTE:
THE AS-BUILT LINEWORK SHOWN HEREON IS A GRAPHICAL REPRESENTATION
AND MAY NOT BE DRAWN TO SCALE FOR CLARITY PURPOSES.


THIS DOCUMENT CONSISTS OF 18 SHEETS AND EACH
SHEET SHALL NOT BE CONSIDERED VALID WITHOUT
SHEET 1.

DATE: 12/10/2021


JOSEPH L. MARTIN
PROFESSIONAL SURVEYOR
& MAPPER P.S.M.# 4368
STATE OF FLORIDA

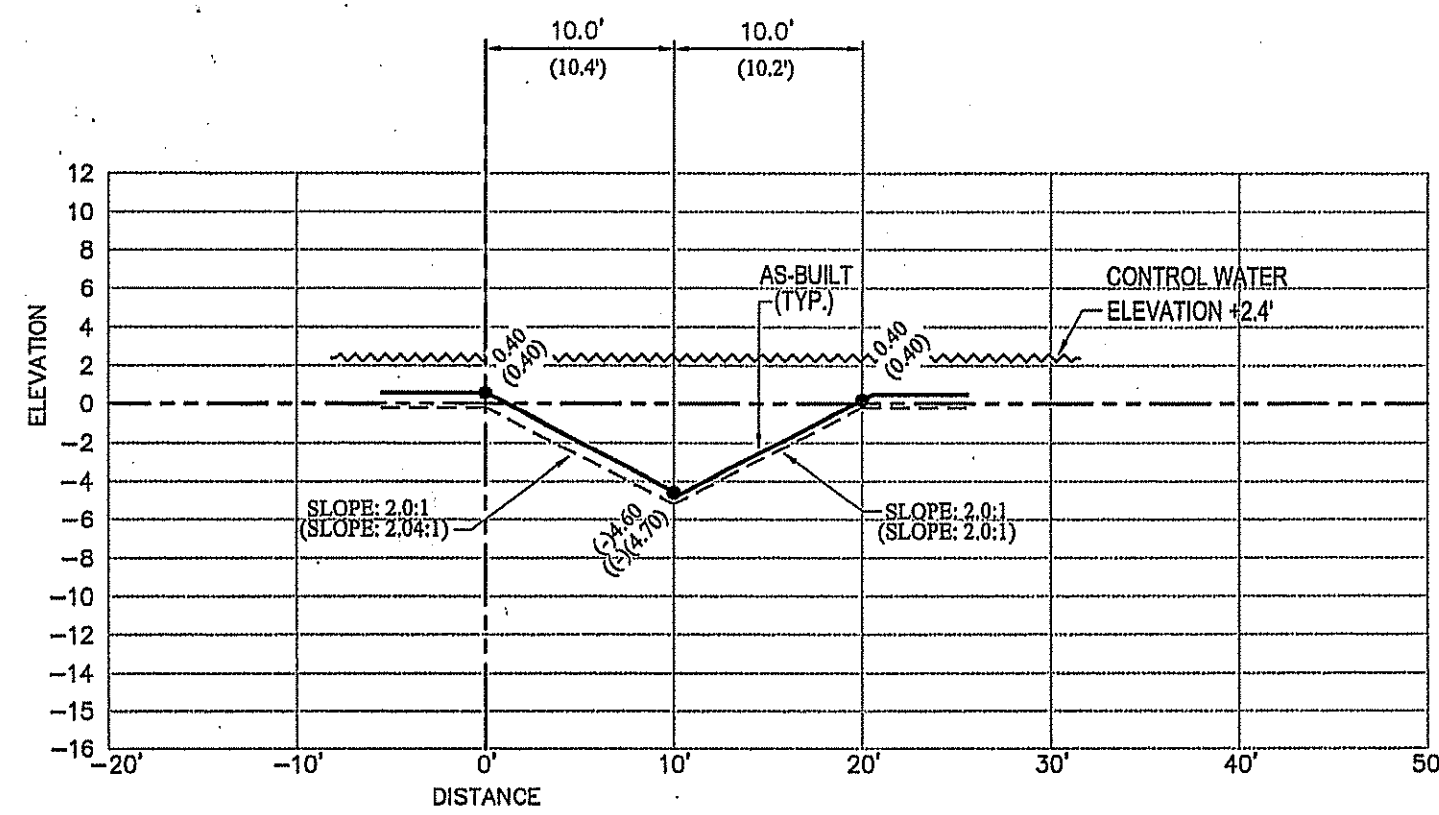


SECTION No. 72
20' CHANNEL

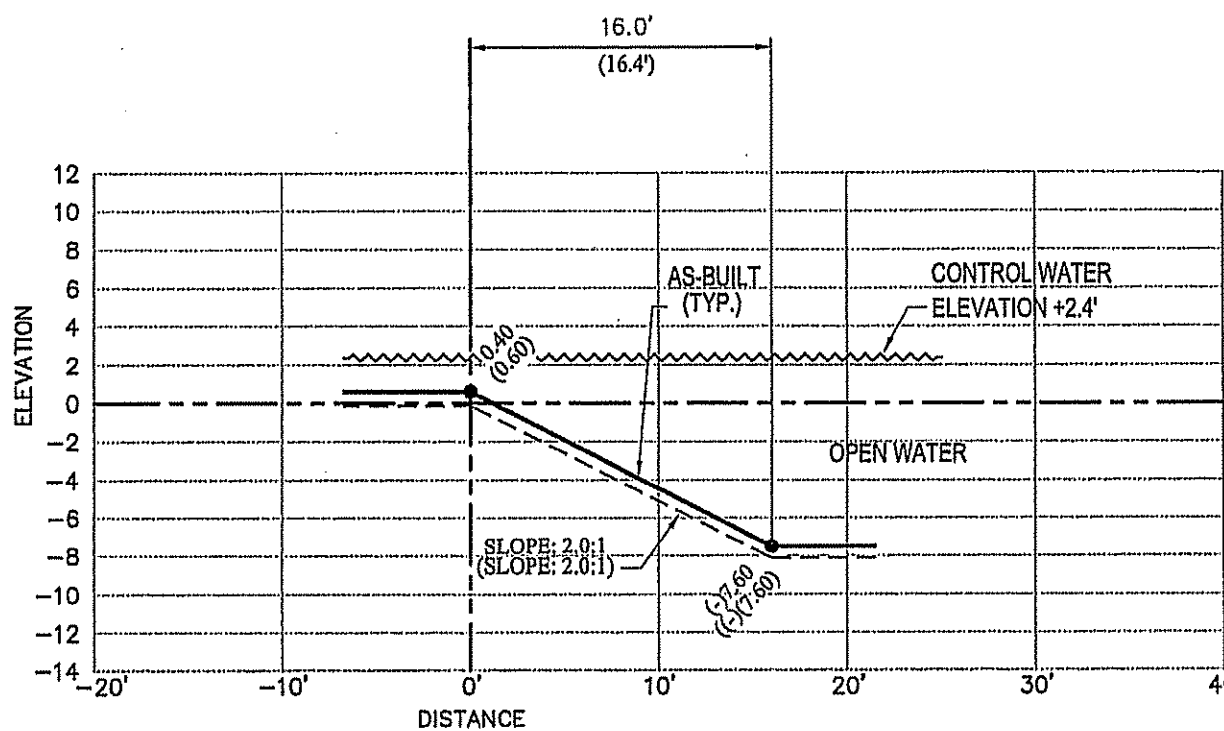


SECTION No. 73
OPEN WATER

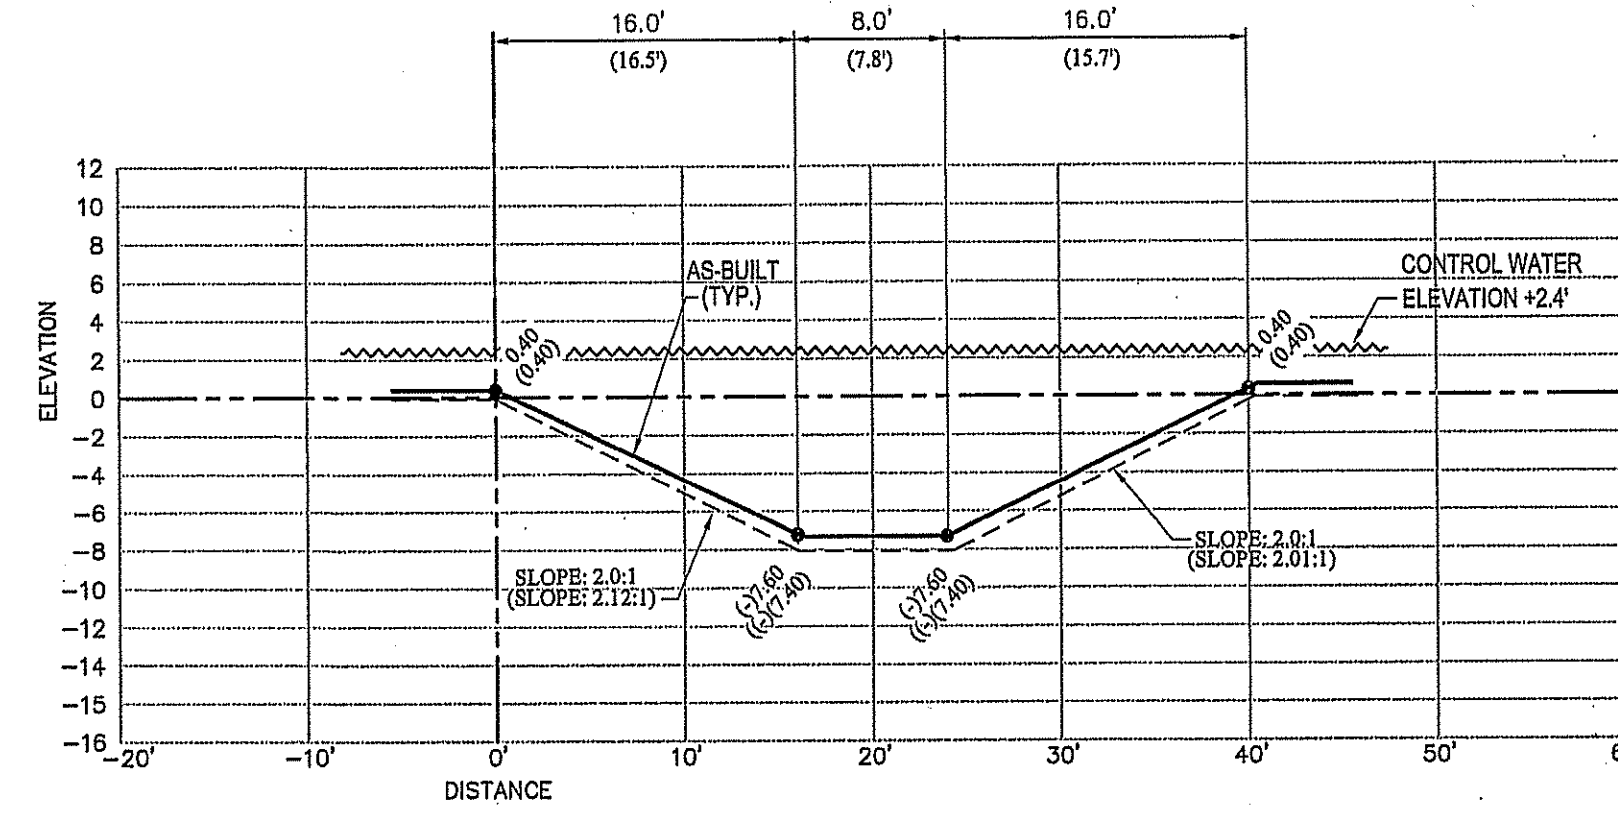


SECTION No. 74
40' CHANNEL

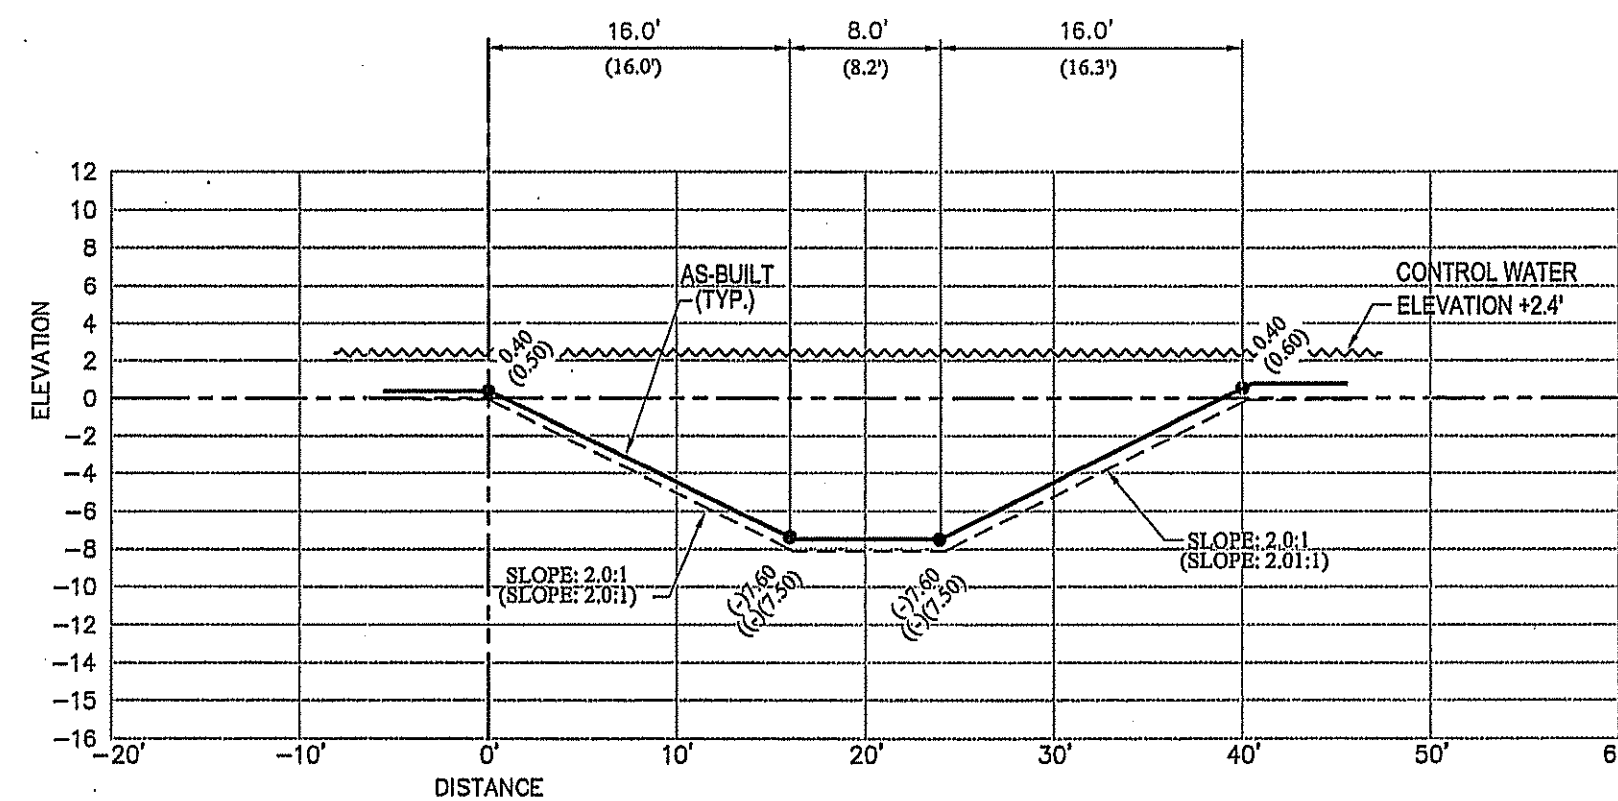


SECTION No. 75
40' CHANNEL

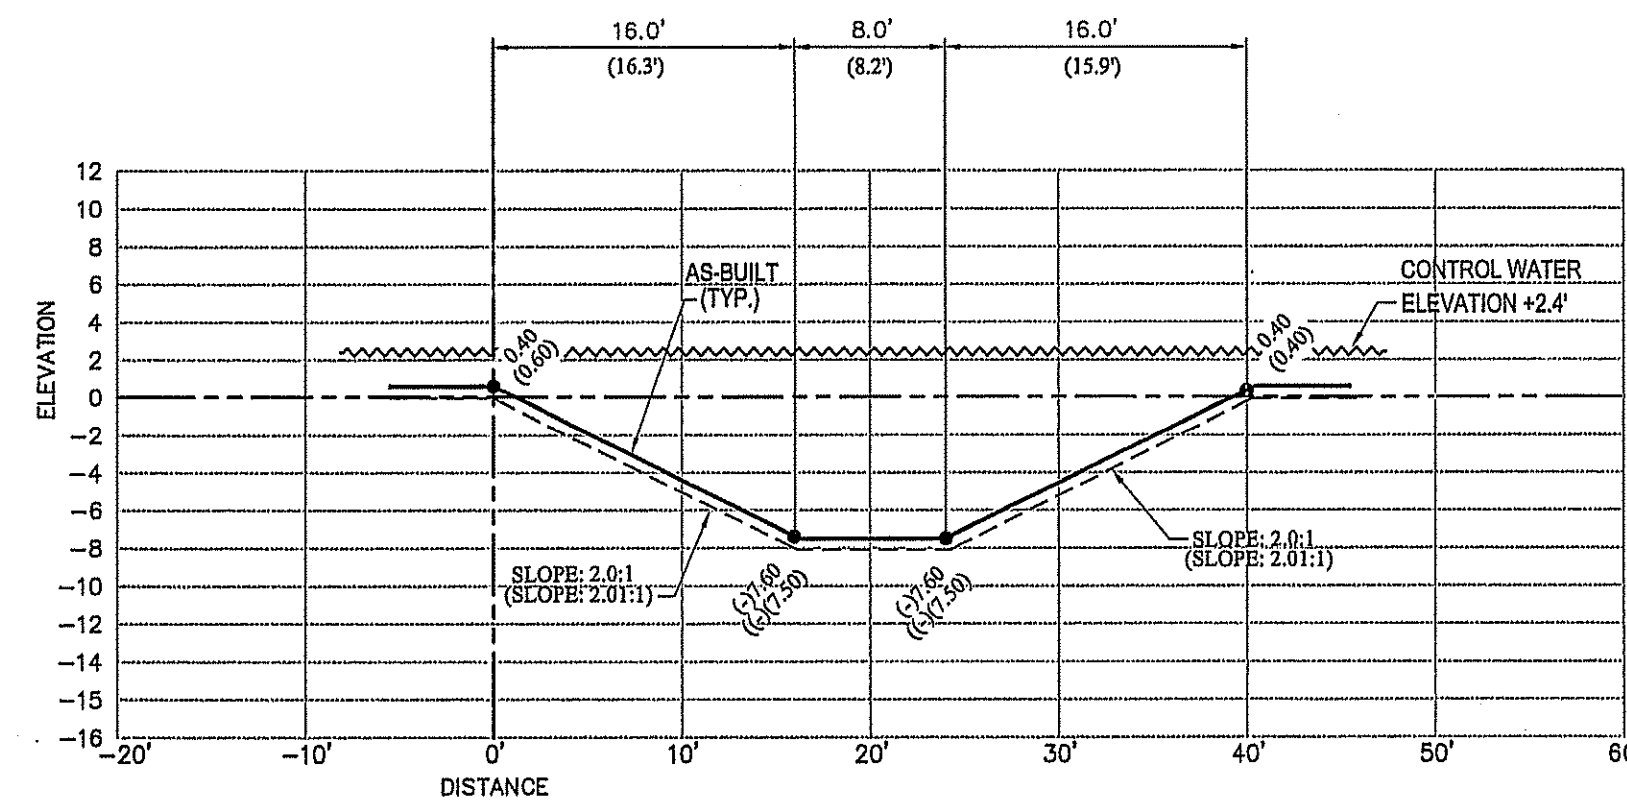


SECTION No. 76
40' CHANNEL

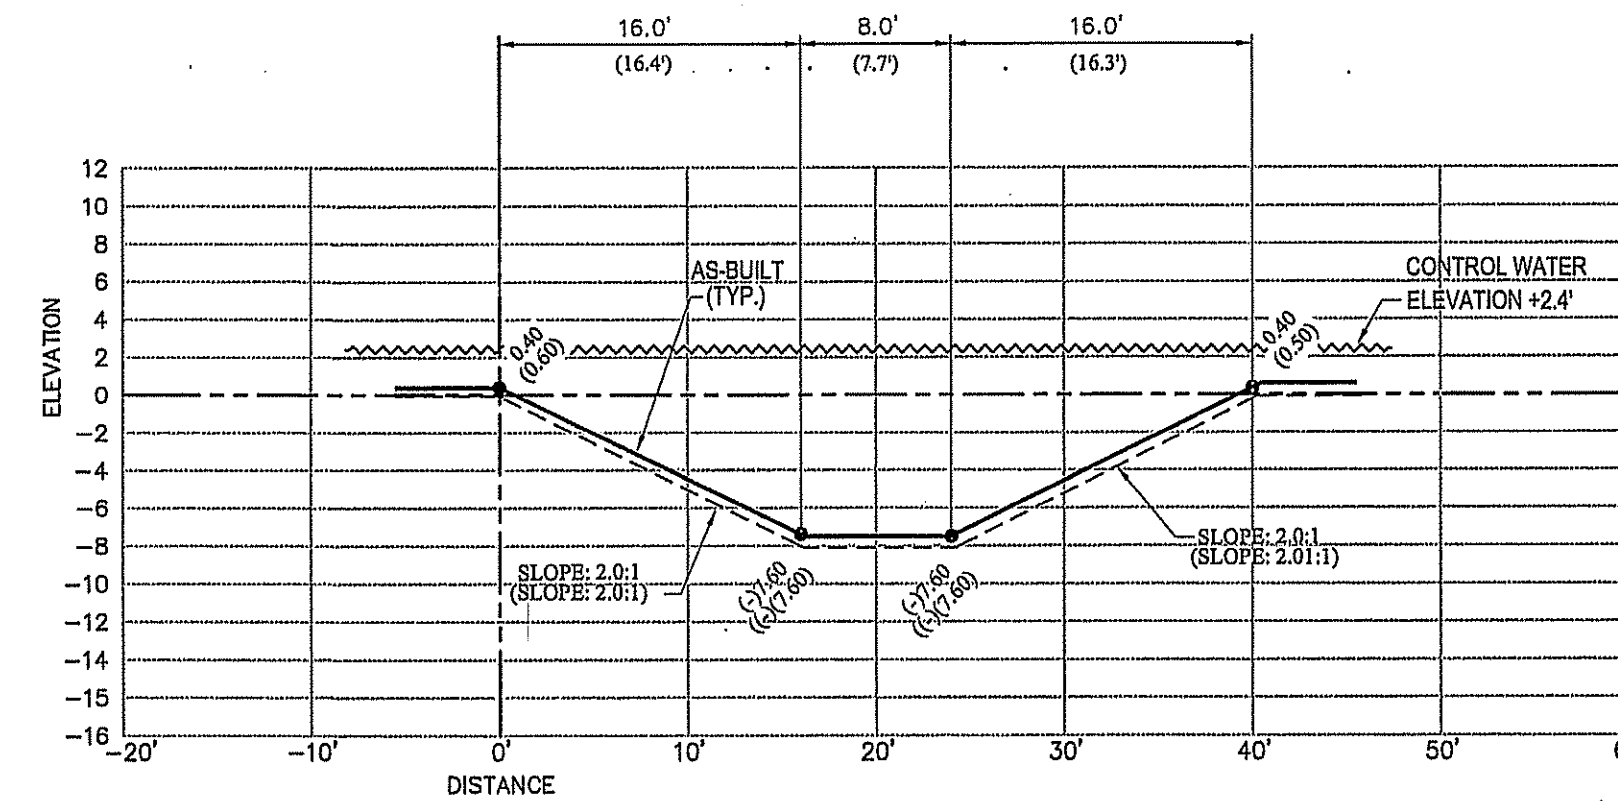


SECTION No. 77
40' CHANNEL

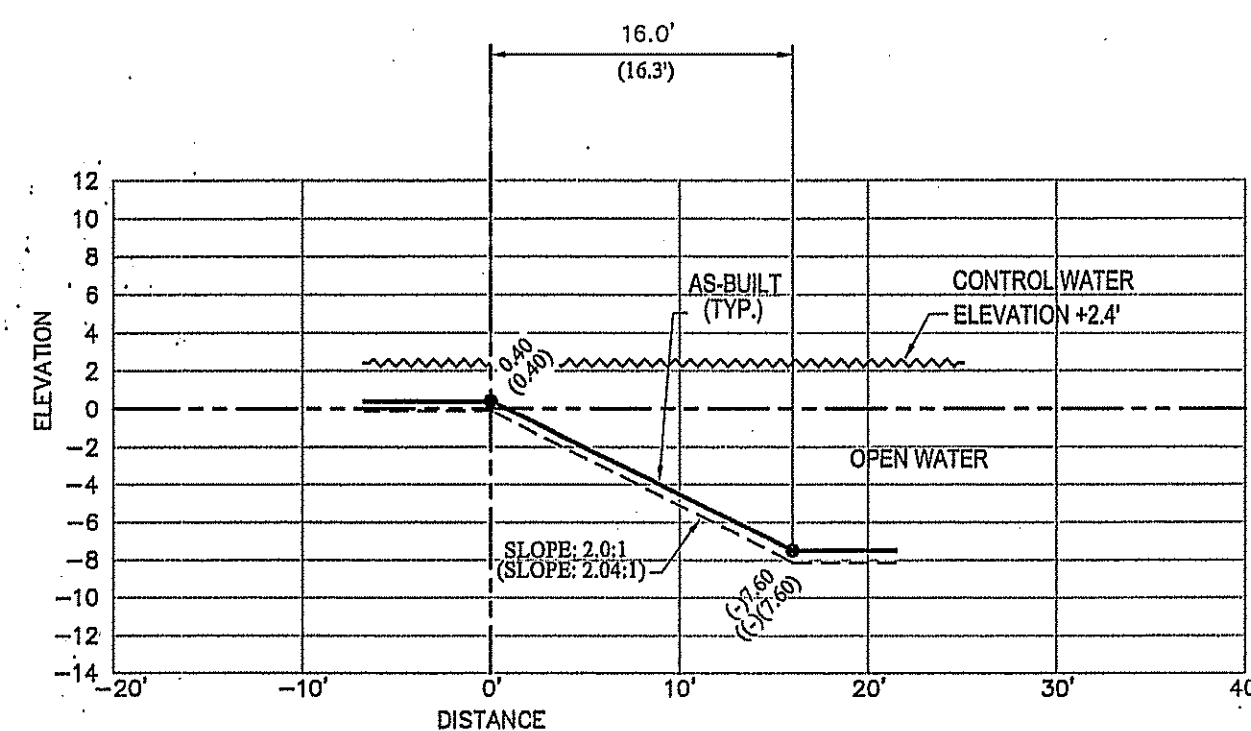

SECTION No. 78
OPEN WATER

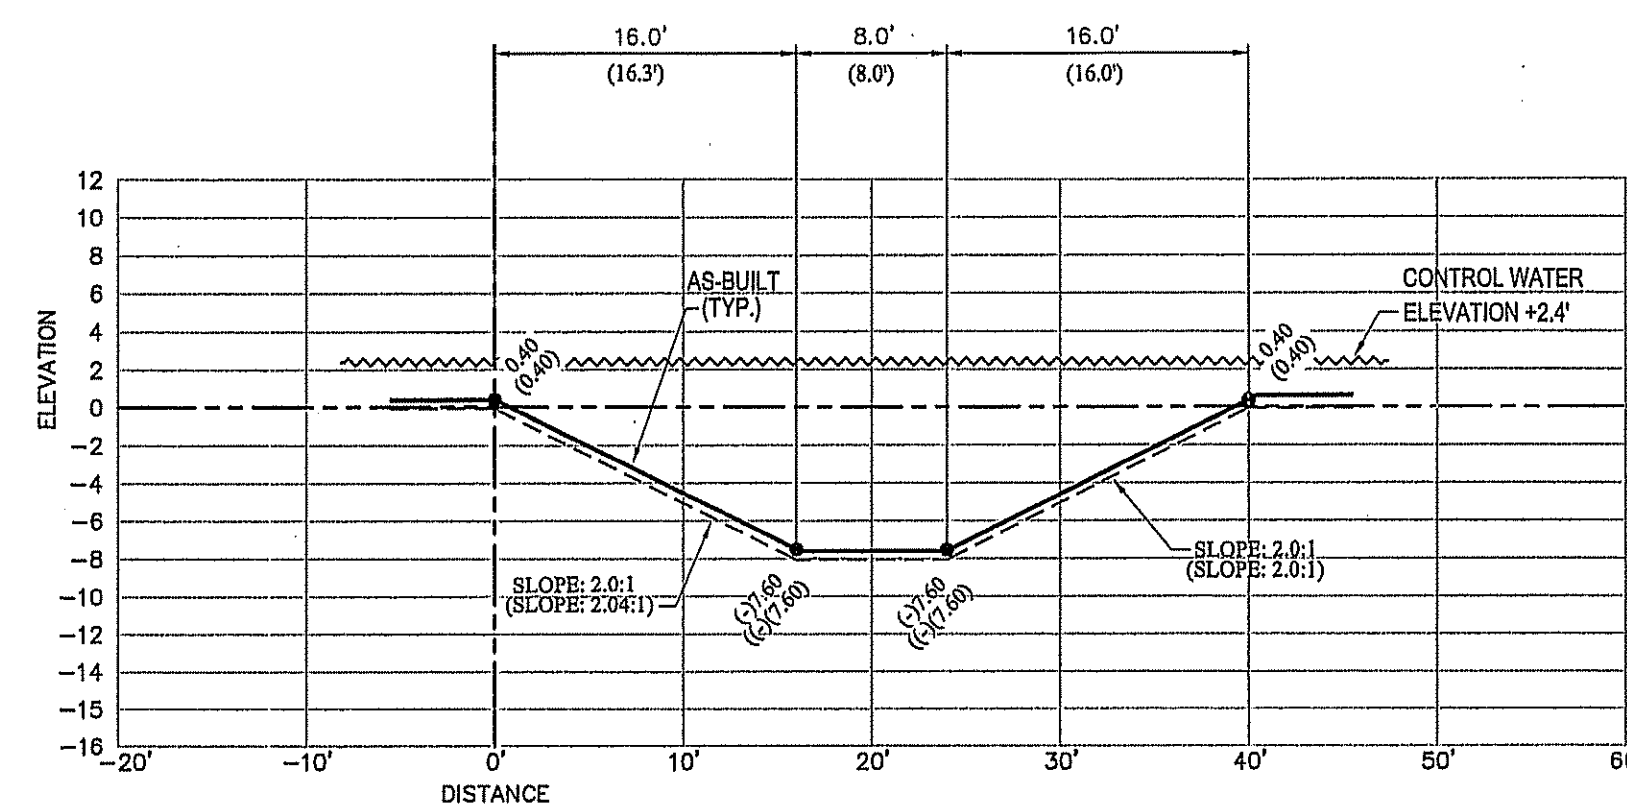

SECTION No. 79
40' CHANNEL

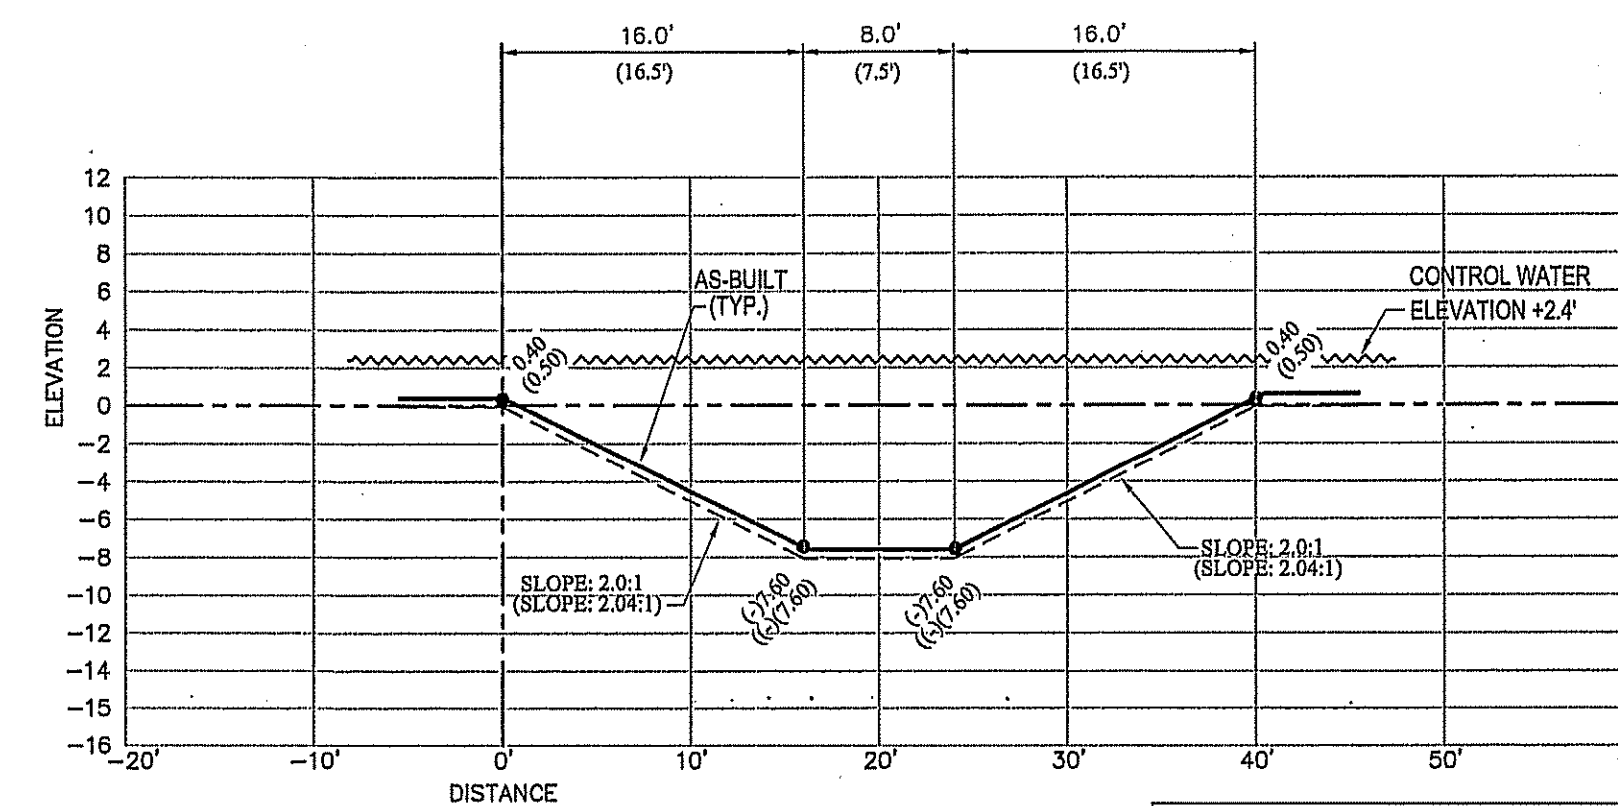

SECTION No. 80
40' CHANNEL

Chad E. Edwards, State of Florida,
Professional Engineer, License No. 59306

This item has been digitally signed and sealed by
Chad E. Edwards, on the date indicated here.
Printed copies of this document are not
considered signed and sealed and the signature
must be verified on any electronic copies.

Chad Everett
Edwards
Digitally signed by
Chad Everett Edwards
Date: 2022.10.27
09:30:45 -04'00'

AS-BUILT LEGEND:

- (15.2) DENOTES AS-BUILT DISTANCE
- 15.2 DENOTES DESIGN DISTANCE
- (5) DENOTES AS-BUILT ELEVATION
- 5 DENOTES DESIGN ELEVATION
- (SLOPE 2.0:1) DENOTES AS-BUILT SLOPE
- SLOPE 2.0:1 DENOTES DESIGN SLOPE
- L.M.E. DENOTES LAKE MAINTENANCE EASEMENT
- DENOTES AS-BUILT LINE
- DENOTES DESIGN LINE

NOTE:
THE AS-BUILT LINEWORK SHOWN HEREON IS A GRAPHICAL REPRESENTATION
AND MAY NOT BE DRAWN TO SCALE FOR CLARITY PURPOSES.

THIS DOCUMENT CONSISTS OF 18 SHEETS AND EACH
SHEET SHALL NOT BE CONSIDERED VALID WITHOUT
SHEET 1.


CERTIFICATE:
I HEREBY CERTIFY THAT THESE RECORD DRAWINGS FOR THE
FACILITY HAVE BEEN REVIEWED BY ME OR BY INDIVIDUAL(S)
UNDER MY DIRECT SUPERVISION FOR COMPLETENESS AND
ADEQUACY, AND ARE TRUE AND CORRECT TO THE BEST OF MY
KNOWLEDGE AND BELIEF. THE FIELD WORK FOR THE AS-BUILT
DRAWINGS HAS BEEN DONE BY: Joseph L. Martin, P.S.M. #4368
10/20/2022

JOSEPH L. MARTIN
Professional Engineer
License Number 4368
STATE OF FLORIDA
Professional Engineer
P.S.M. #4368
DATE: 12/10/2021 BY:

SIERRA RANCH
DAVIE, FL.

PROJ. TYPE	AS-BUILT CROSS SECTIONS
PROJ. LOC:	1950 SOUTH HIATUS ROAD
SECTION:	SEC. 18, TWP. 50S. RGE. 41E
DATE	04/14/2021
ORE PROJECT No:	2019-043
SHEET No:	13 of 18

REVISION COMMENTS	DATE	BY	APP
REVISED PER ENGINEER'S COMMENTS	05-18-21	L.A.	J.M.
REVISED TO ADD SECTIONS FROM 16 TO 36	11-8-21	L.A.	J.M.
REVISED TO ADD SECTIONS FROM 37 TO 125	12-8-21	L.A.	G.B.
REVISED PER ENGINEER'S COMMENTS	12-10-21	L.A.	G.B.

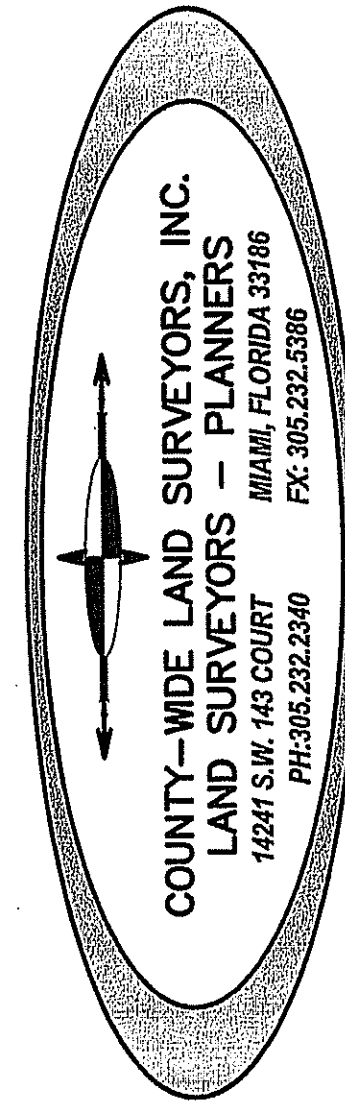



JOSEPH L. MARTIN
PROFESSIONAL SURVEYOR
& MAPPER PSM# 4368
STATE OF FLORIDA

Chad Everett Edwards Digitally signed by Chad Everett Edwards
Date: 2022.10.27 09:31:19 -04'00'

	DENOTES AS-BUILT DISTANCE
	DENOTES DESIGN DISTANCE
	DENOTES AS-BUILT ELEVATION
	DENOTES DESIGN ELEVATION
	DENOTES AS-BUILT SLOPE
	DENOTES DESIGN SLOPE
	DENOTES LAKE MAINTENANCE EASEMENT
	DENOTES AS-BUILT LINE
	DENOTES DESIGN LINE


THIS DOCUMENT CONSISTS OF 18 SHEETS AND EACH SHEET SHALL NOT BE CONSIDERED VALID WITHOUT SHEET 1.


SIERRA RANCH
DAVIE, FL.

TRAIL TYPE	AS-BUILT CROSS SECTIONS	DATE	REVISION COMMENTS	BY	APP
TRAIL LOG:	1950 SOUTH HIATUS ROAD	05-18-21	REVISED PER ENGINEER'S COMMENTS	L.A.	J.M.
SECTION:	SEC. 18, TWP. 50S, RGE. 41E	11-8-21	REVISED TO ADD SECTIONS FROM 16 TO 36	L.A.	J.M.
		12-8-21	REVISED TO ADD SECTIONS FROM 37 TO 125	L.A.	G.B.
		12-10-21	REVISED DEP ENGINEER'S COMMENTS	L.A.	G.D.


SCALE:	1" = 10'	V: 1" = 10'
SURVEYOR:	COUNTY-WIDE	
DRAWN BY:	LESLY	
CHECKED BY:	G.B.	
AS-BUILT:	PRESERVE AREA	
DATE:	04/14/2021	
ORE PROJECT No:	2019-043	

14 of 18

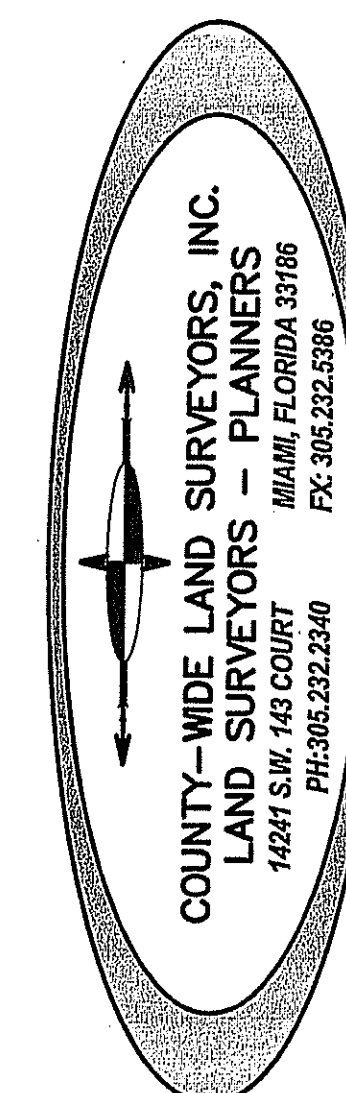


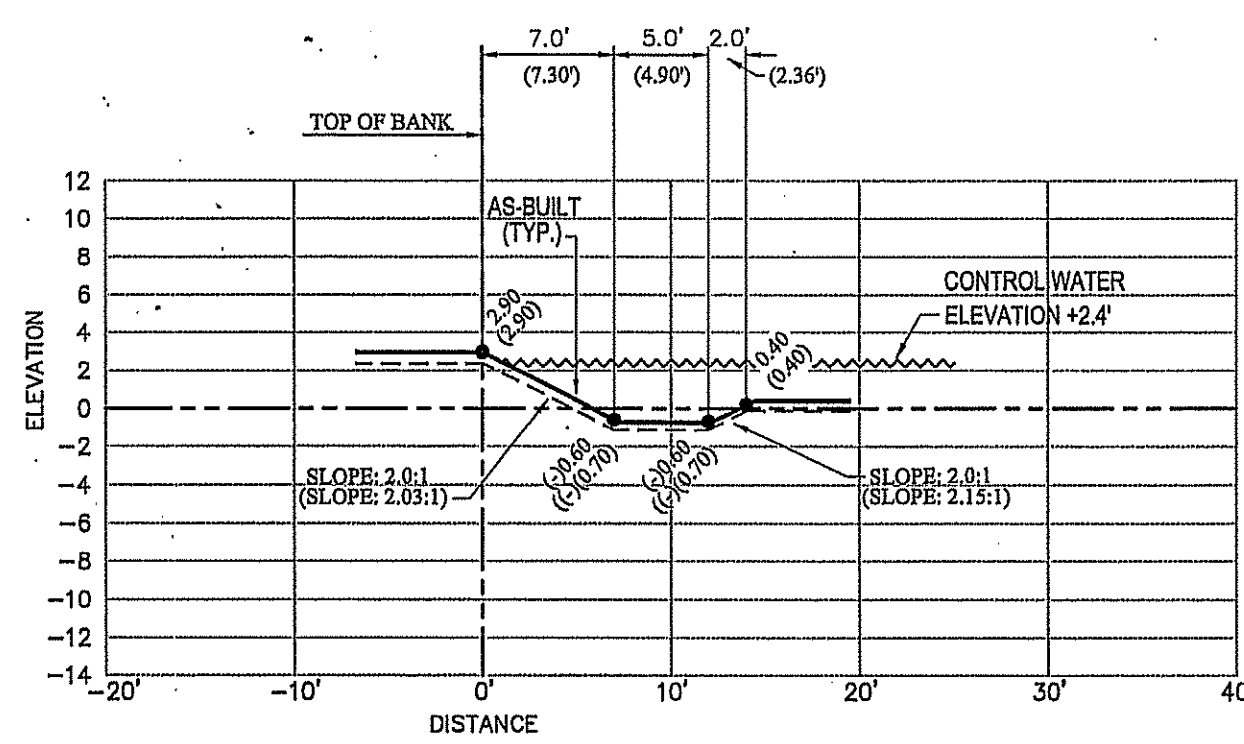


SECTION No. 90
HYDRIC ISLAND

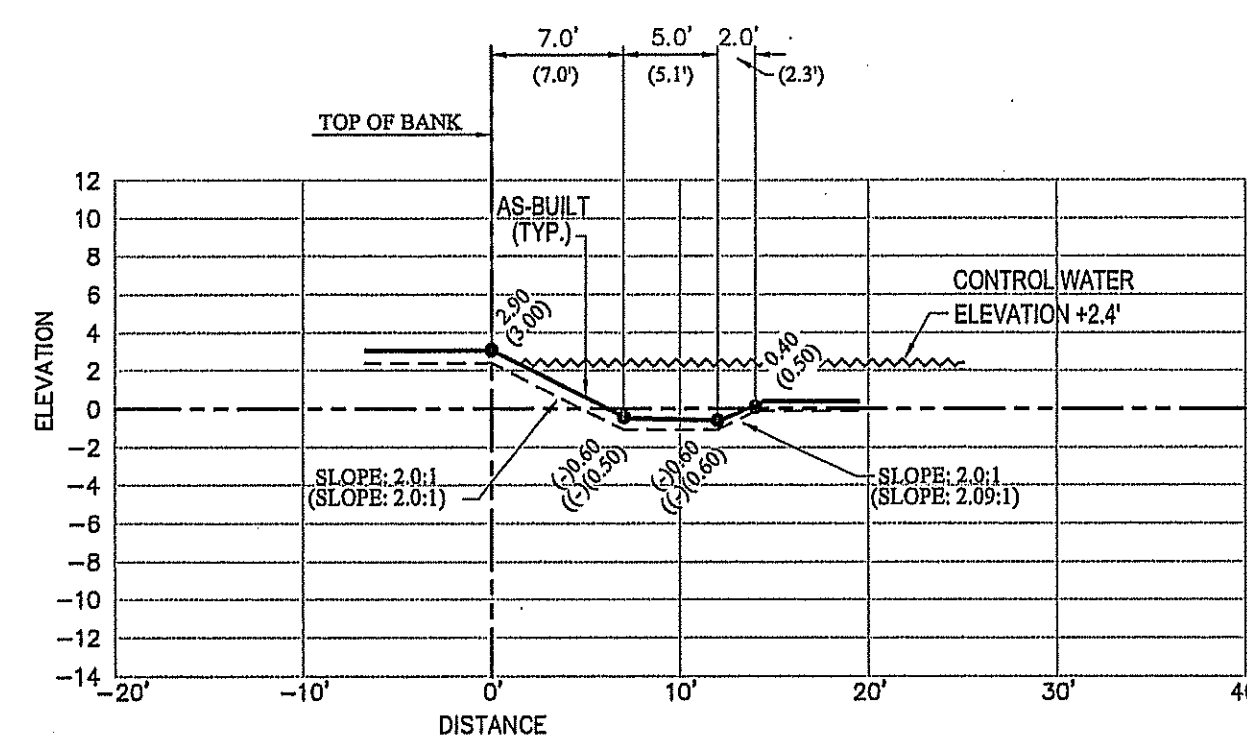


SECTION No. 91
HYDRIC ISLAND

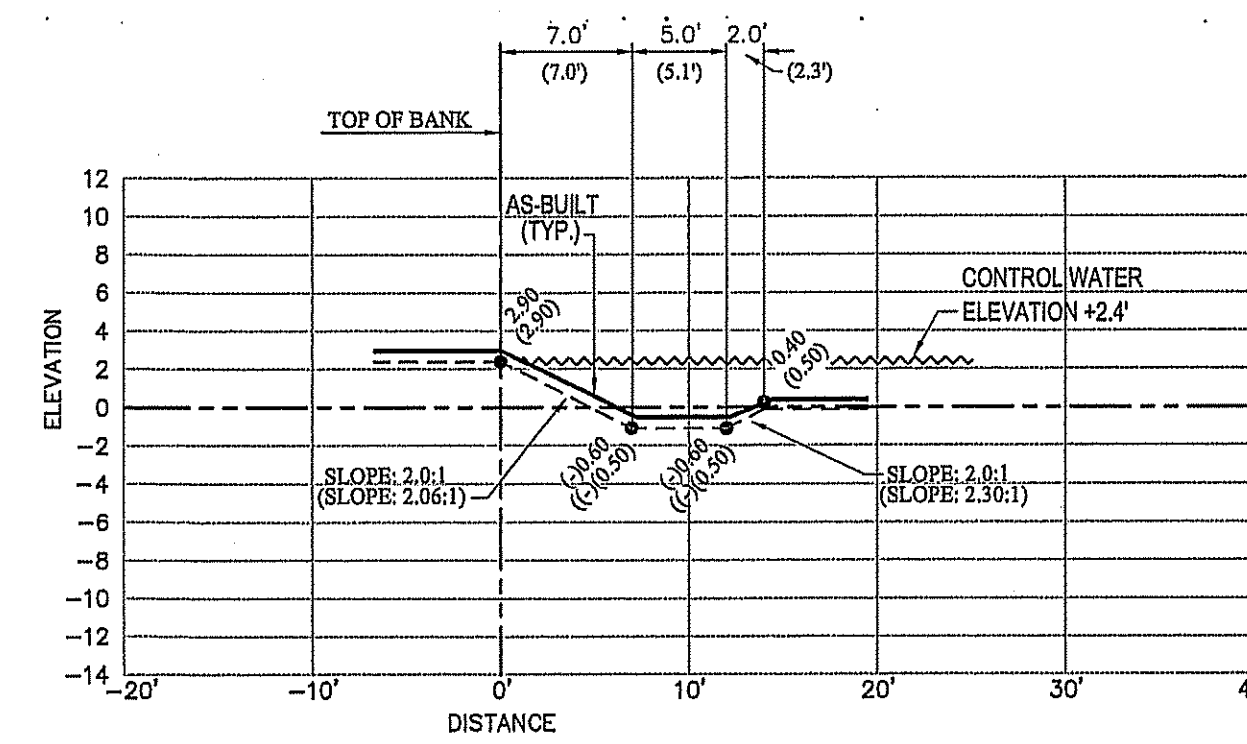


SECTION No. 92
HYDRIC ISLAND

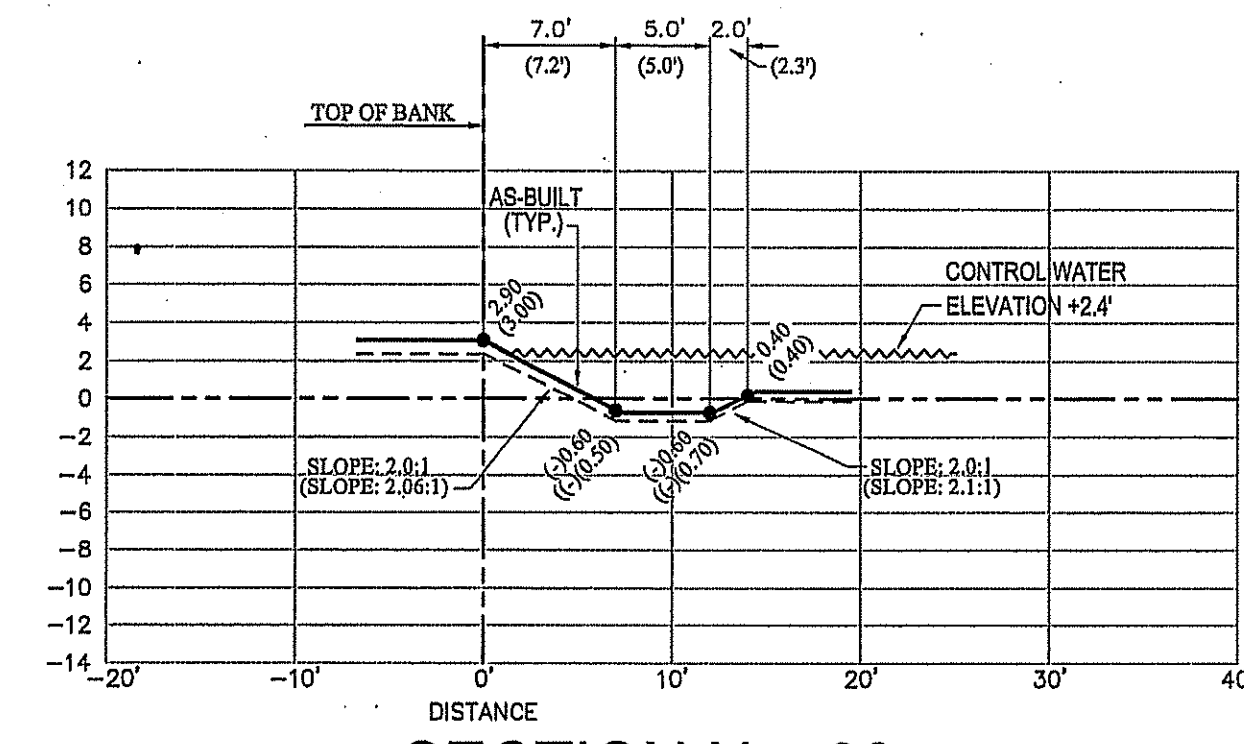


SECTION No. 93
HYDRIC ISLAND

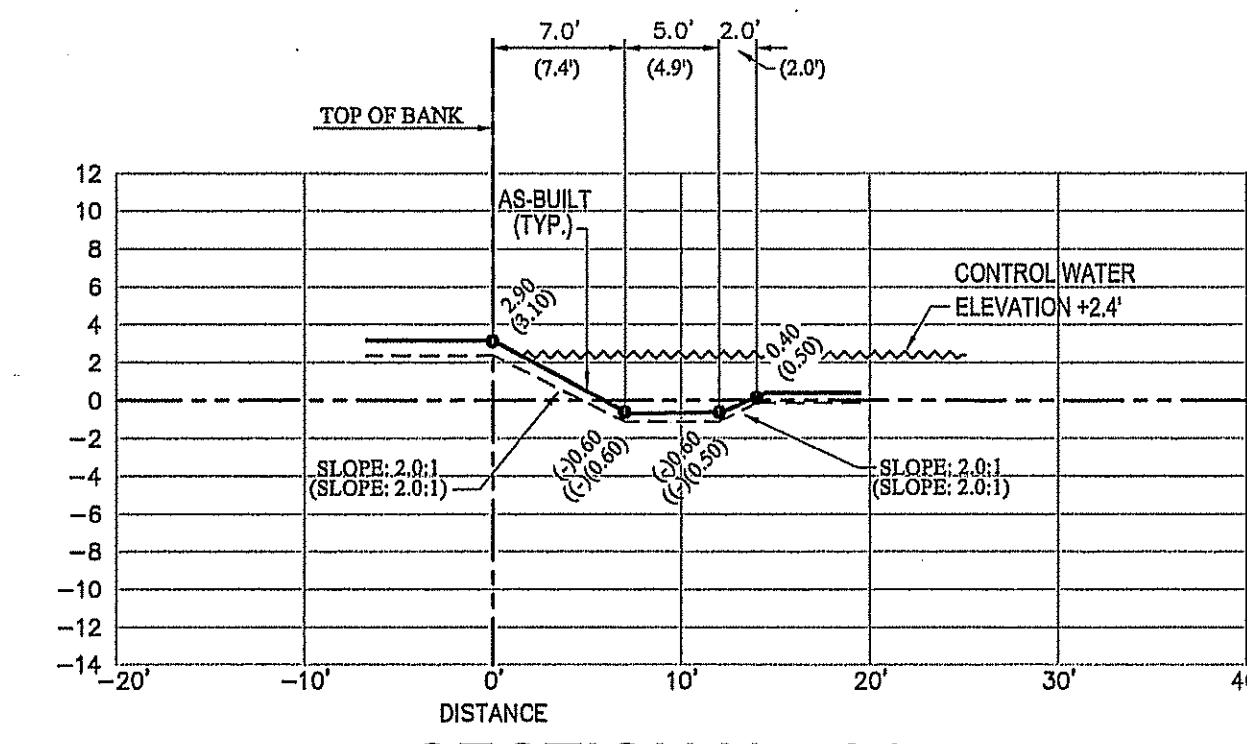


SECTION No. 94
HYDRIC ISLAND

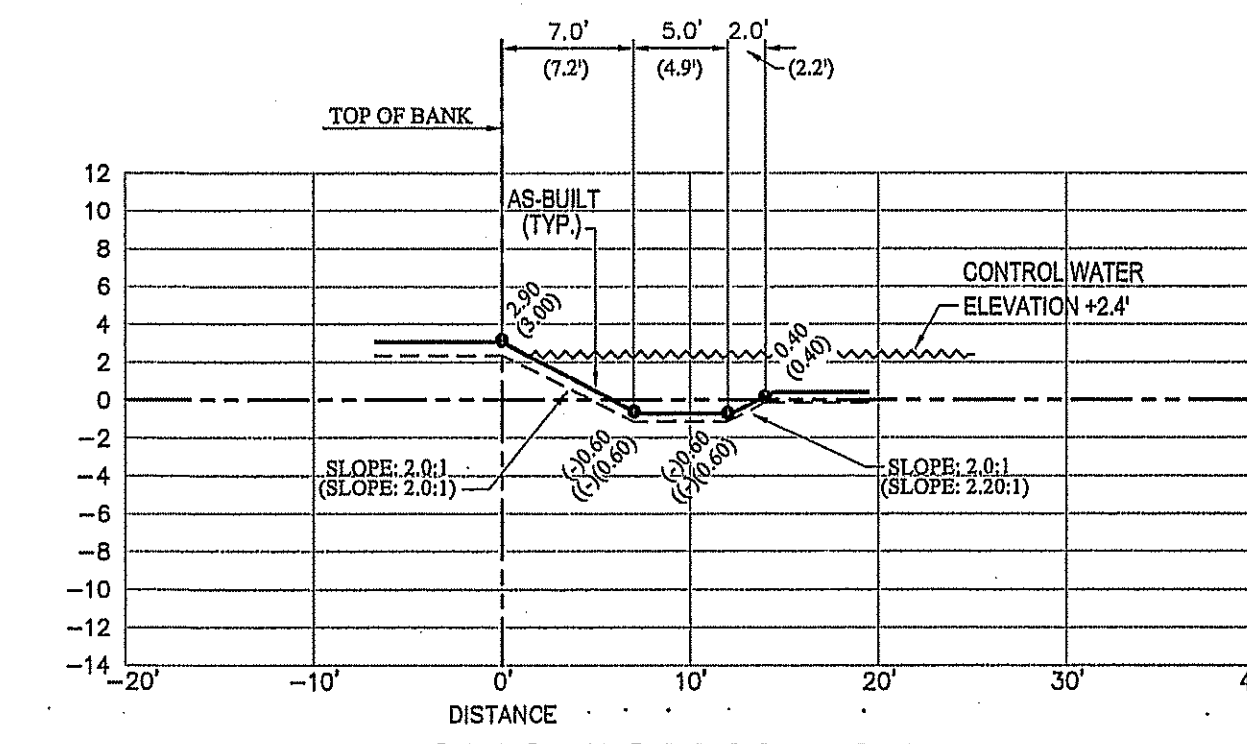


SECTION No. 95
HYDRIC ISLAND

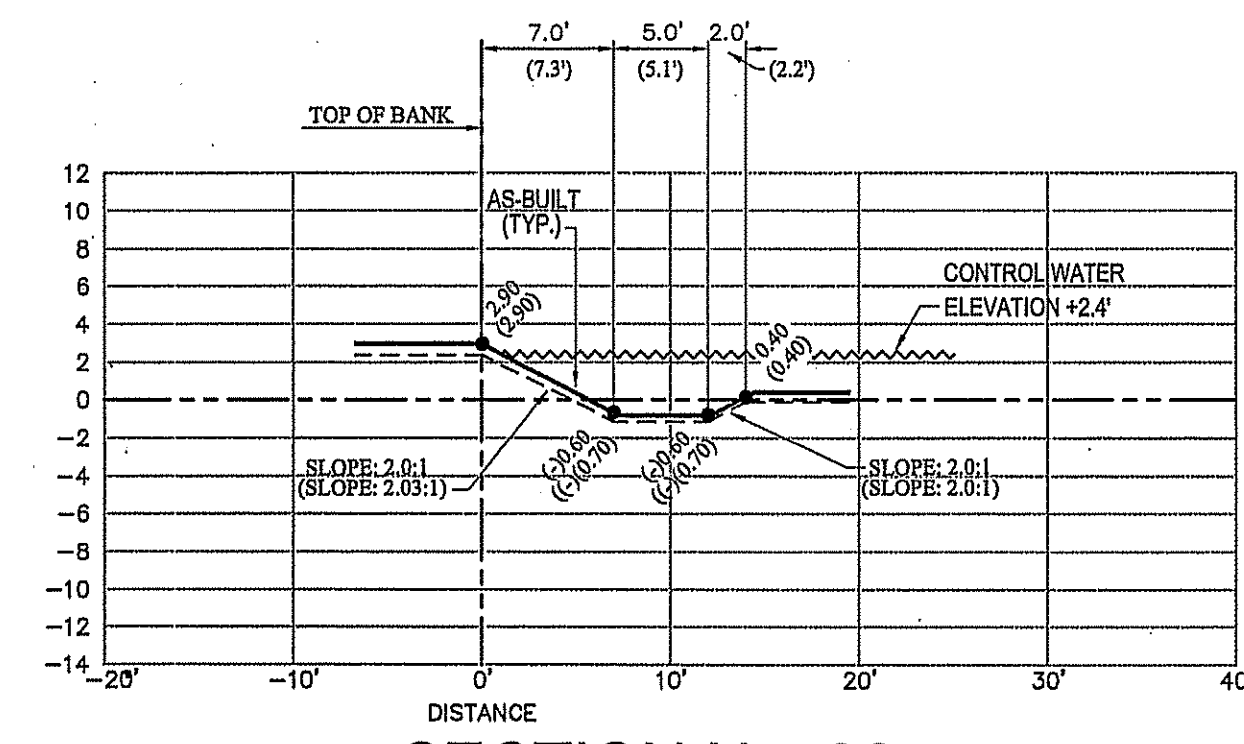

SECTION No. 96
HYDRIC ISLAND

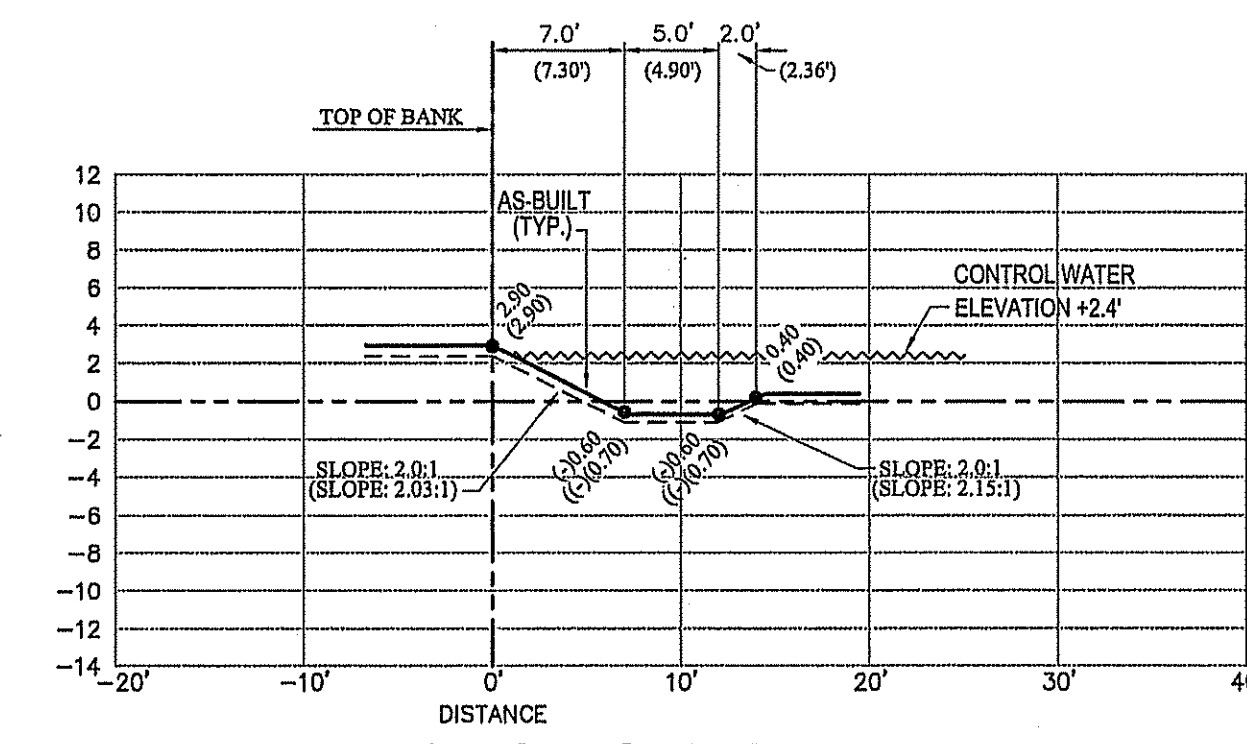

SECTION No. 97
HYDRIC ISLAND

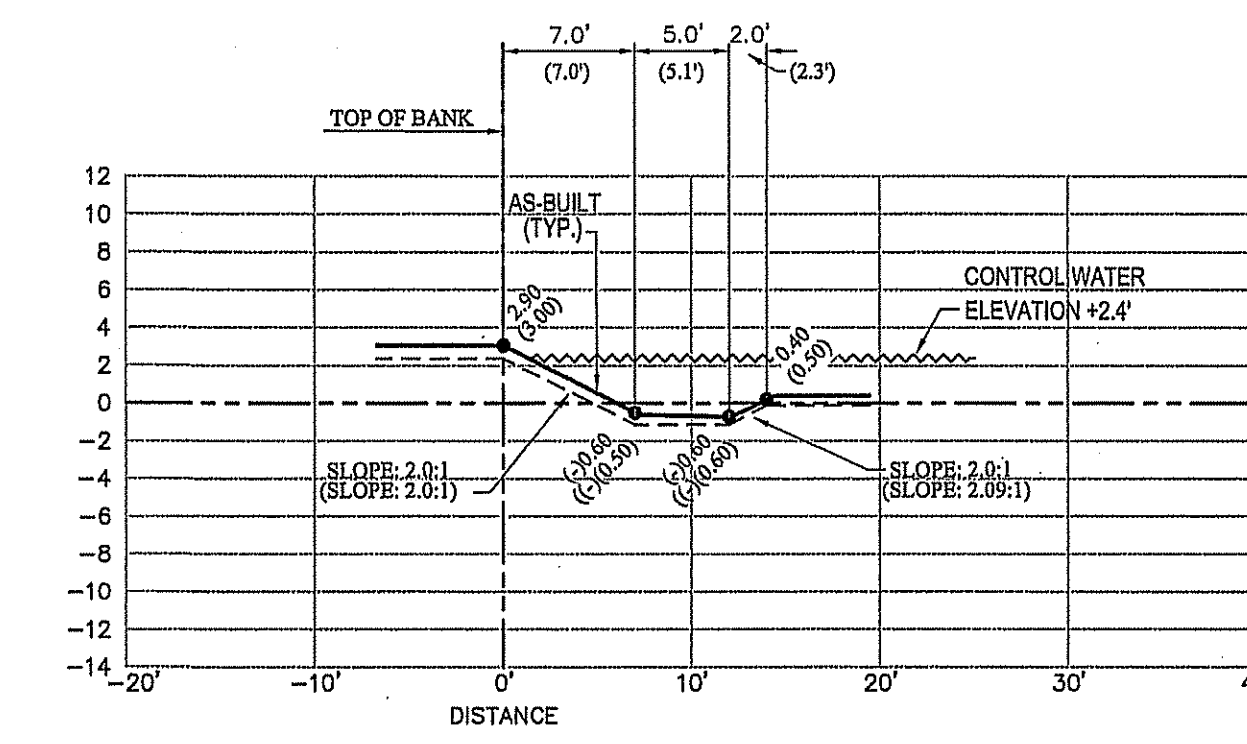

SECTION No. 98
HYDRIC ISLAND

Chad E. Edwards, State of Florida,
Professional Engineer, License No. 59306.

This item has been digitally signed and sealed by
Chad E. Edwards on the date indicated here.
Printed copies of this document are not
considered signed and sealed and the signature
must be verified on any electronic copies.

Chad Everett
Edwards
Digitally signed by
Chad Everett Edwards
Date: 2022.10.27
09:31:56 -04'00'


AS-BUILT LEGEND:

- (15.2) DENOTES AS-BUILT DISTANCE
- 15.0' DENOTES DESIGN DISTANCE
- 6.9 DENOTES AS-BUILT ELEVATION
- 6.9 DENOTES DESIGN ELEVATION
- (SLOPE 20.2:1) DENOTES AS-BUILT SLOPE
- SLOPE 20.0:1 DENOTES DESIGN SLOPE
- L.M.E. DENOTES LAKE MAINTENANCE EASEMENT
- DENOTES AS-BUILT LINE
- DENOTES DESIGN LINE

NOTE:
THE AS-BUILT LINEWORK SHOWN HEREON IS A GRAPHICAL REPRESENTATION
AND MAY NOT BE DRAWN TO SCALE FOR CLARITY PURPOSES.

THIS DOCUMENT CONSISTS OF 18 SHEETS AND EACH
SHEET SHALL NOT BE CONSIDERED VALID WITHOUT
SHEET 1.

CERTIFICATE:
I HEREBY CERTIFY THAT THESE RECORD DRAWINGS FOR THE
FACILITY HAVE BEEN REVIEWED BY ME OR BY INDIVIDUAL(S)
UNDER MY DIRECT SUPERVISION FOR COMPLETENESS AND
ADEQUACY, AND ARE TRUE AND CORRECT TO THE BEST OF MY
KNOWLEDGE AND BELIEF. THE FIELD WORK FOR THE AS-BUILT
DRAWINGS HAS BEEN DONE BY: Joseph L. Martin, P.S.M. #4368
10/20/2022

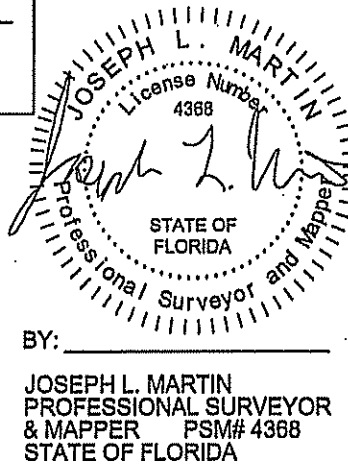


DATE: 12/10/2021 BY:

JOSEPH L. MARTIN
PROFESSIONAL SURVEYOR
& MAPPER P.S.M. #4368
STATE OF FLORIDA


SIERRA RANCH
DAVIE, FL.

PROJ. TYPE	AS-BUILT CROSS SECTIONS	DATE	REVISION COMMENTS	BY	APP
PROJ. LOC:	1950 SOUTH HIATUS ROAD	05-18-21	REVISED PER ENGINEER'S COMMENTS	L.A.	J.M.
SECTION:	SEC. 18, TWP. 50S. RGE. 41E	11-8-21	REVISED TO ADD SECTIONS FROM 16 TO 36	L.A.	J.M.
		12-8-21	REVISED TO ADD SECTIONS FROM 37 TO 125	L.A.	G.B.
		12-10-21	REVISED PER ENGINEER'S COMMENTS	L.A.	G.B.


SCALE:	H:1"=10' / V:1"=10'
SURVEYOR:	COUNTY-WIDE
DRAWN BY:	LESLEY
CHECKED BY:	G.B.
AS-BUILT:	PRESERVE AREA
DATE:	04/14/2021
PROJ. NO.:	2019-043
SHEET NO.:	15 of 18

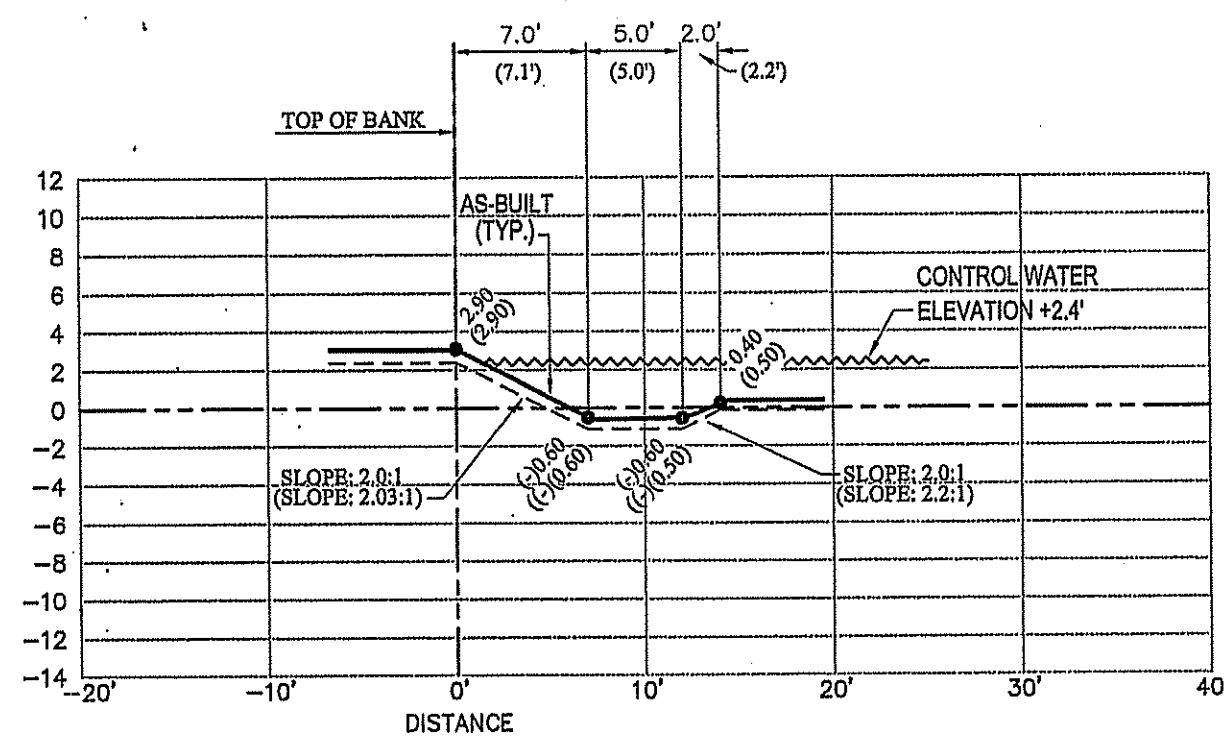


SECTION No. 99
HYDRIC ISLAND

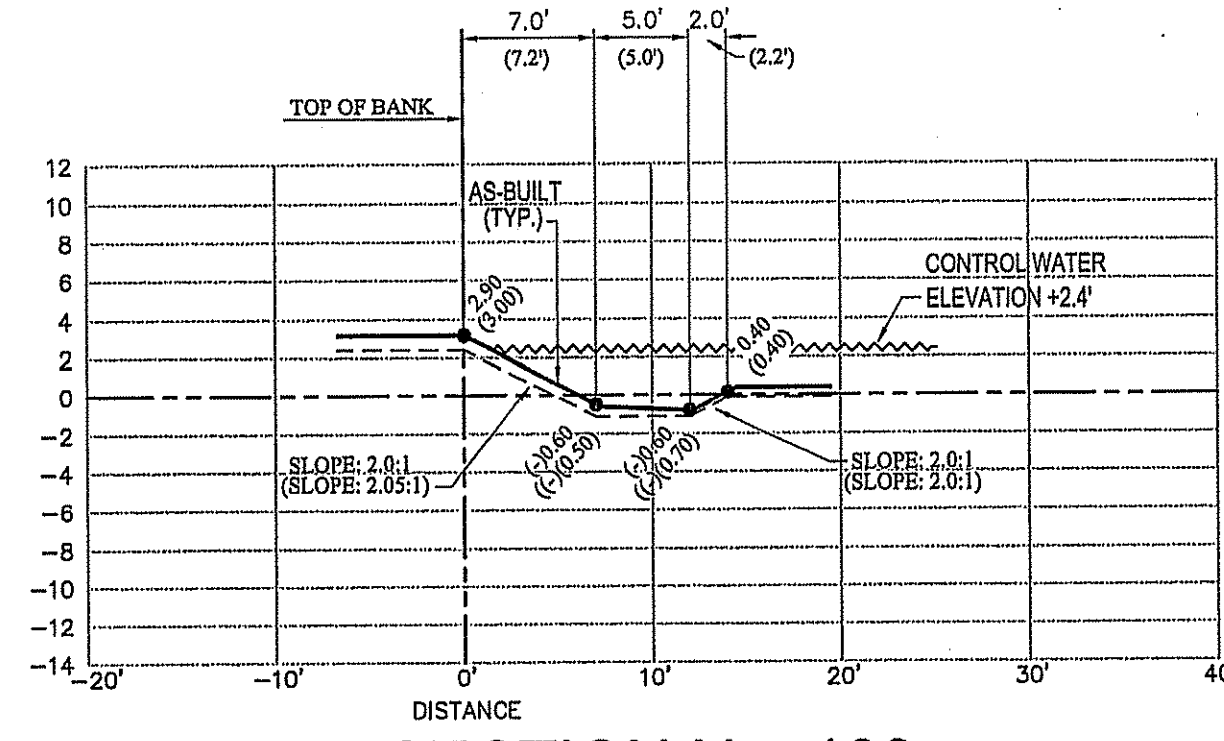


SECTION No. 100
HYDRIC ISLAND

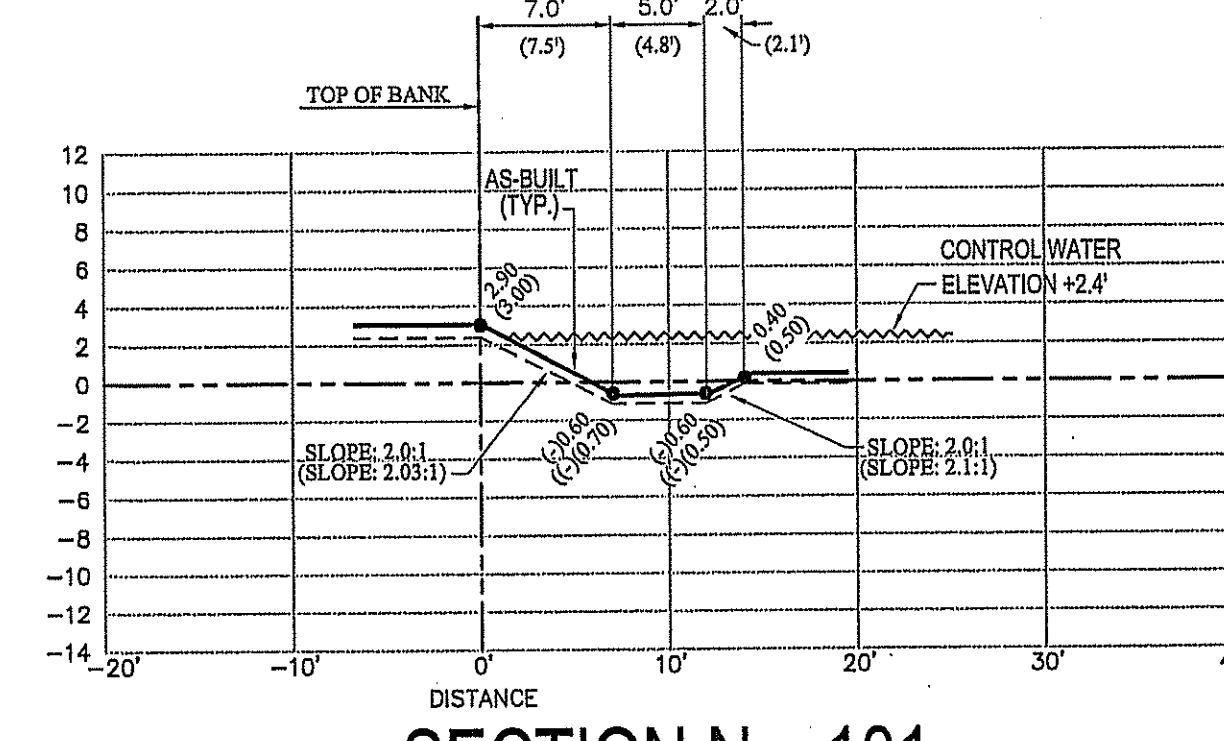


SECTION No. 101
HYDRIC ISLAND

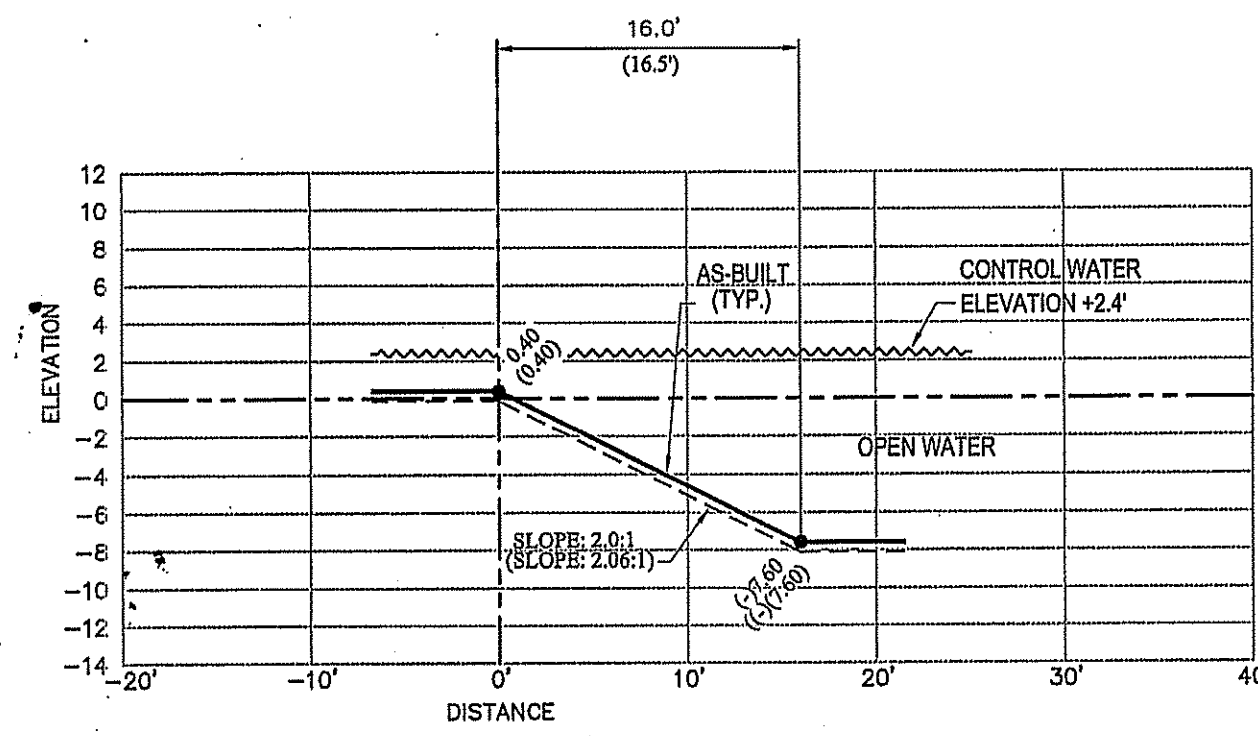


SECTION No. 102
OPEN WATER

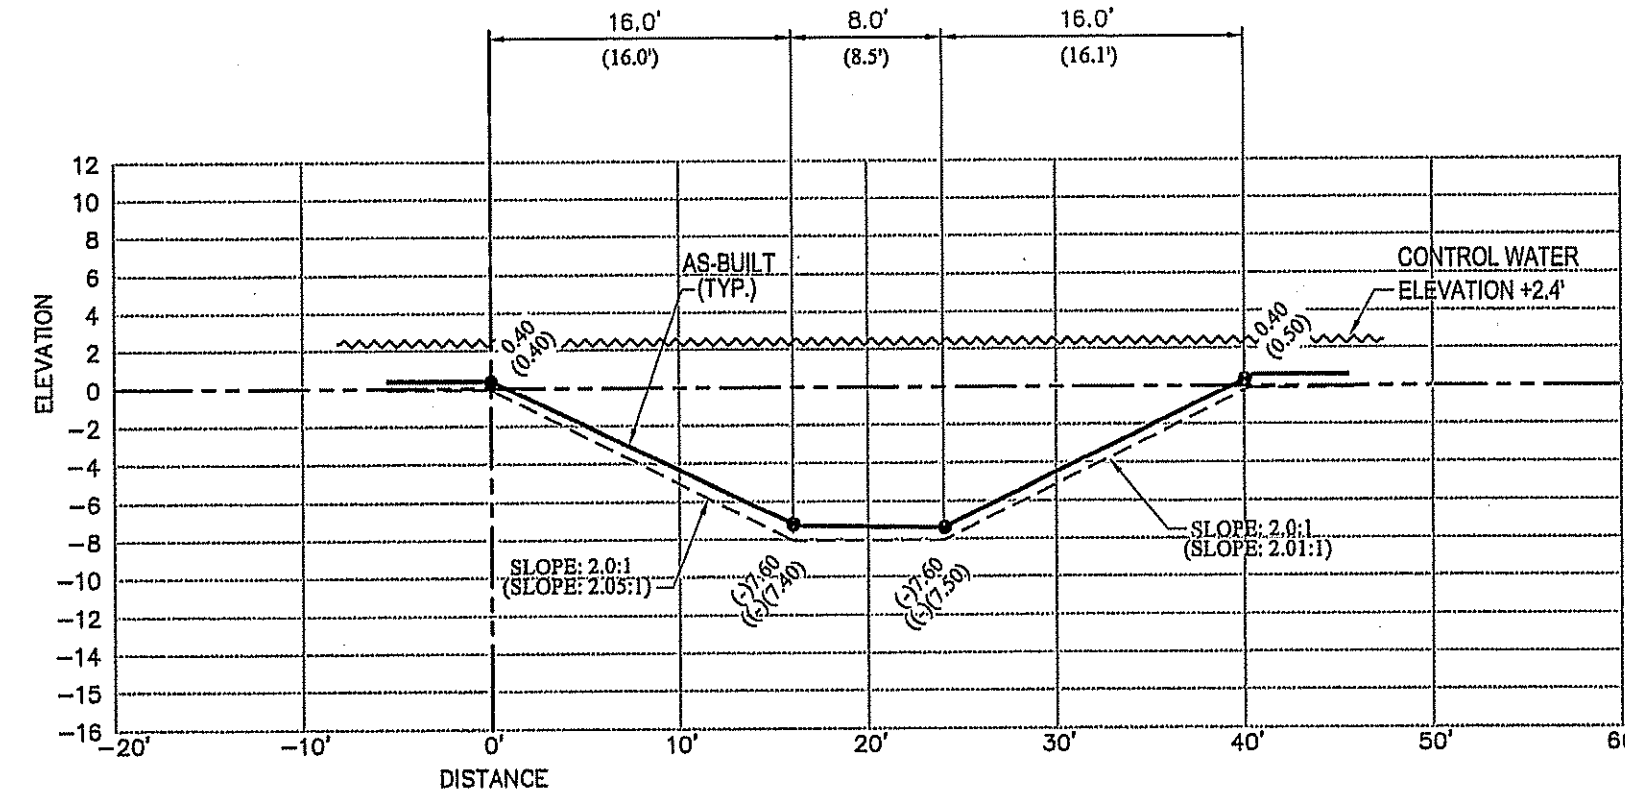


SECTION No. 103
40' CHANNEL

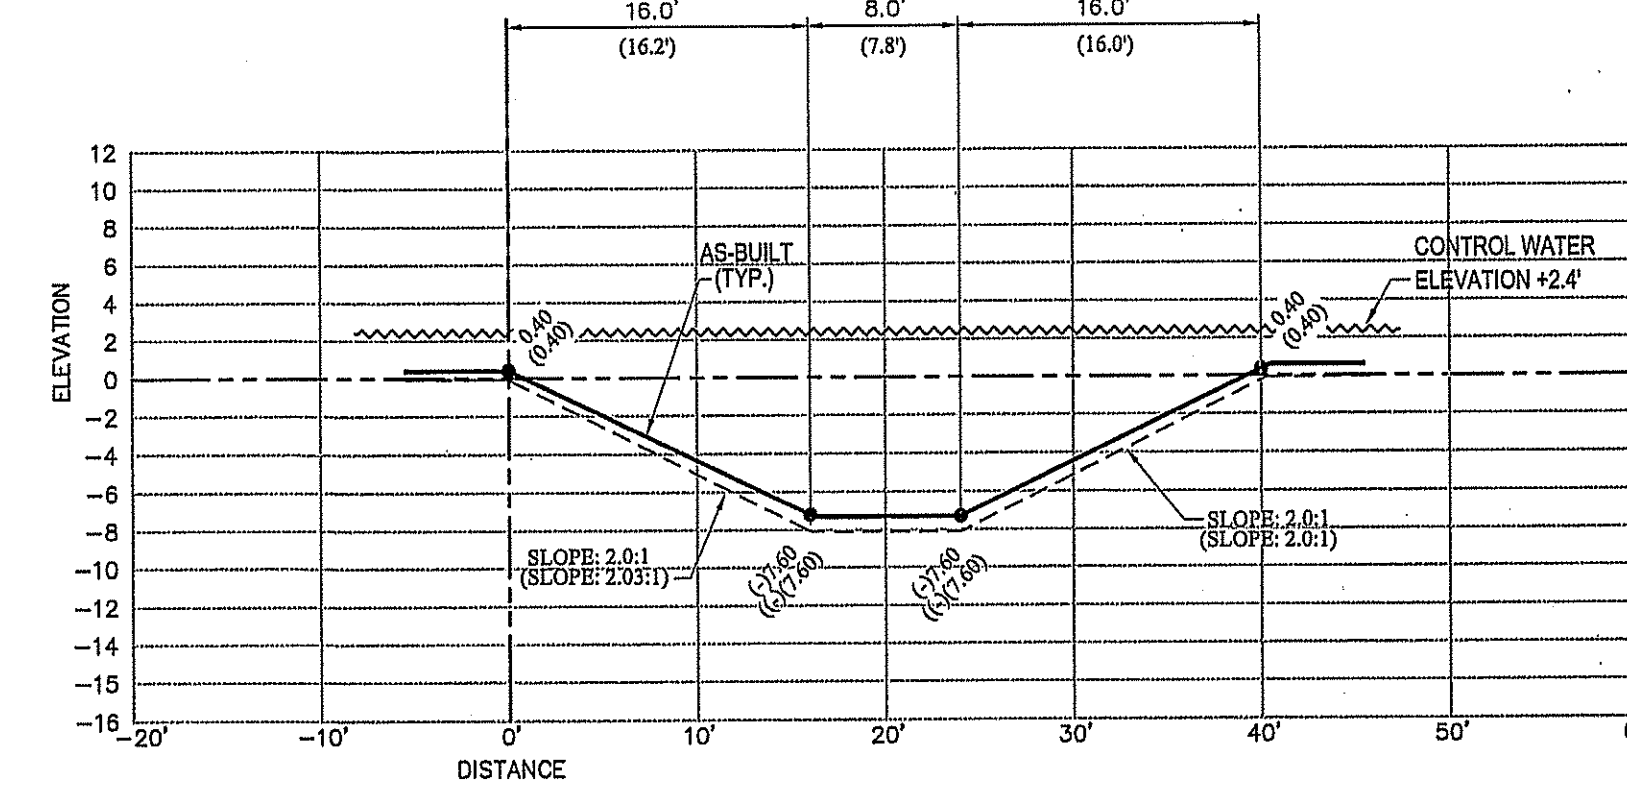


SECTION No. 104
40' CHANNEL

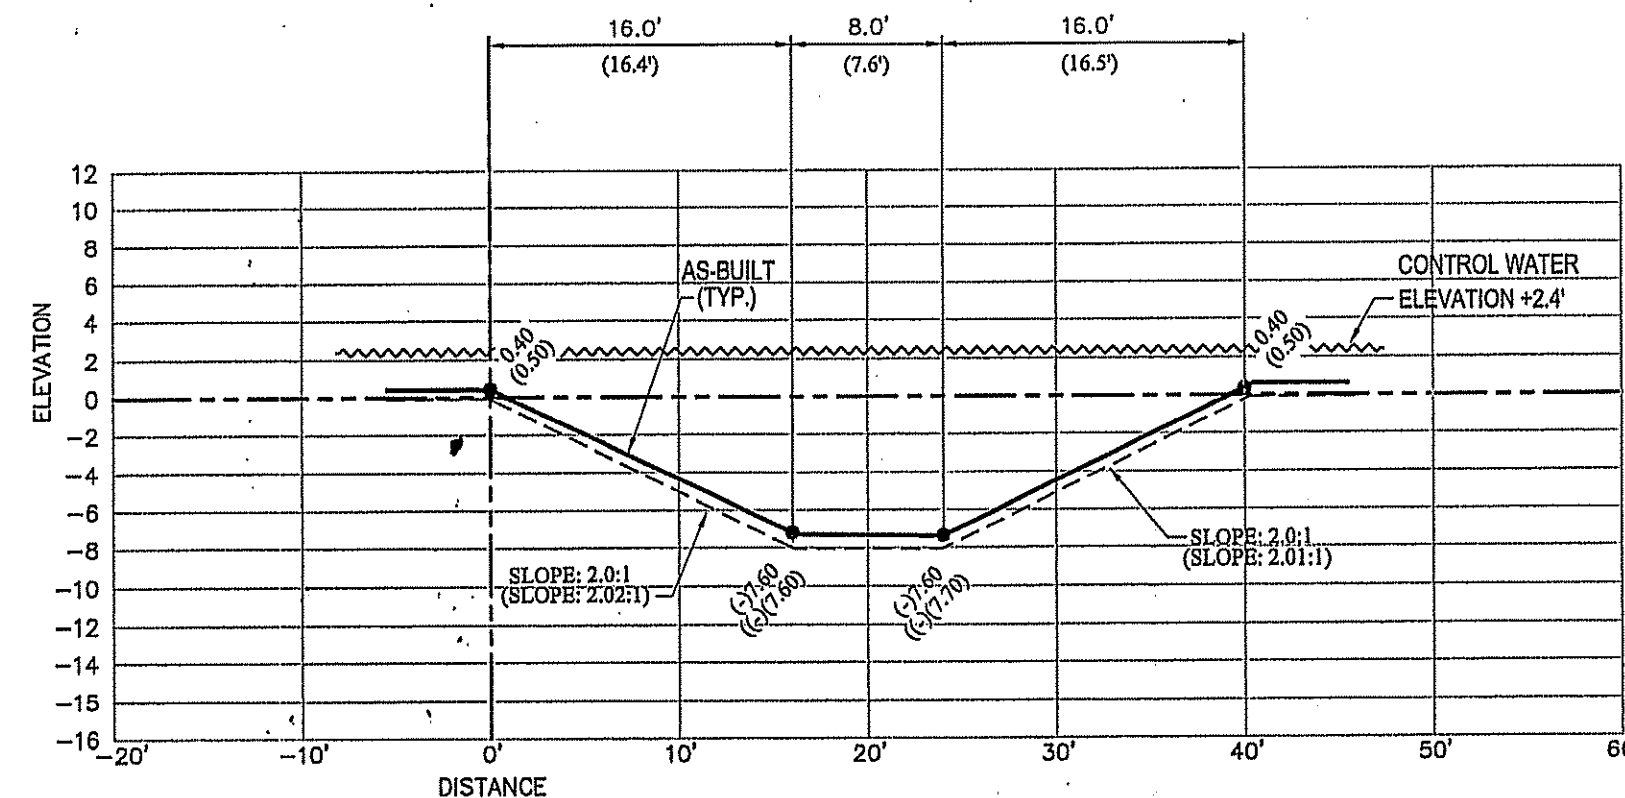

SECTION No. 105
40' CHANNEL

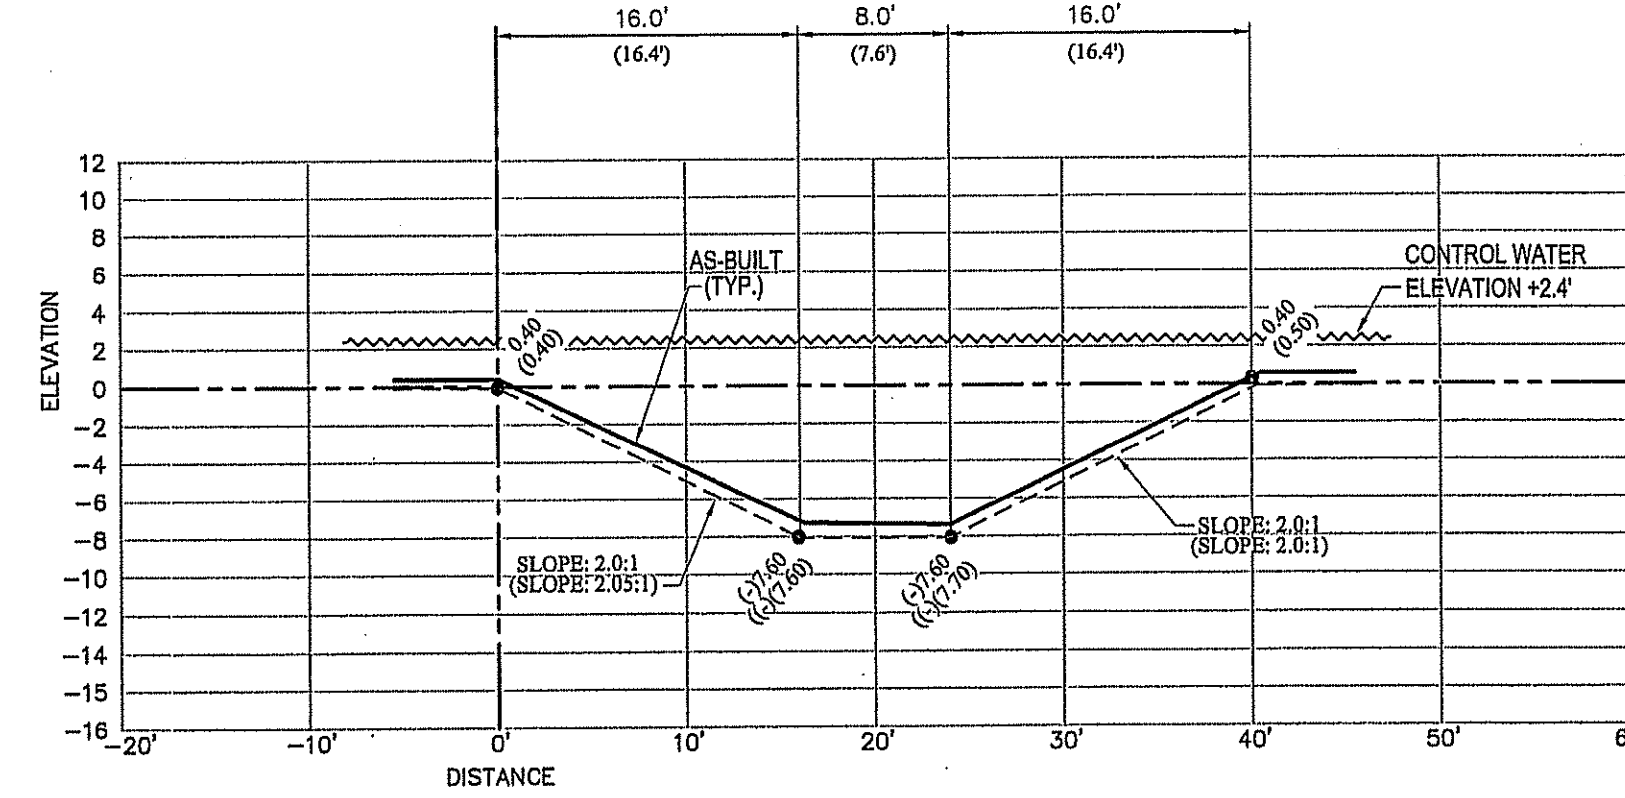

SECTION No. 106
40' CHANNEL

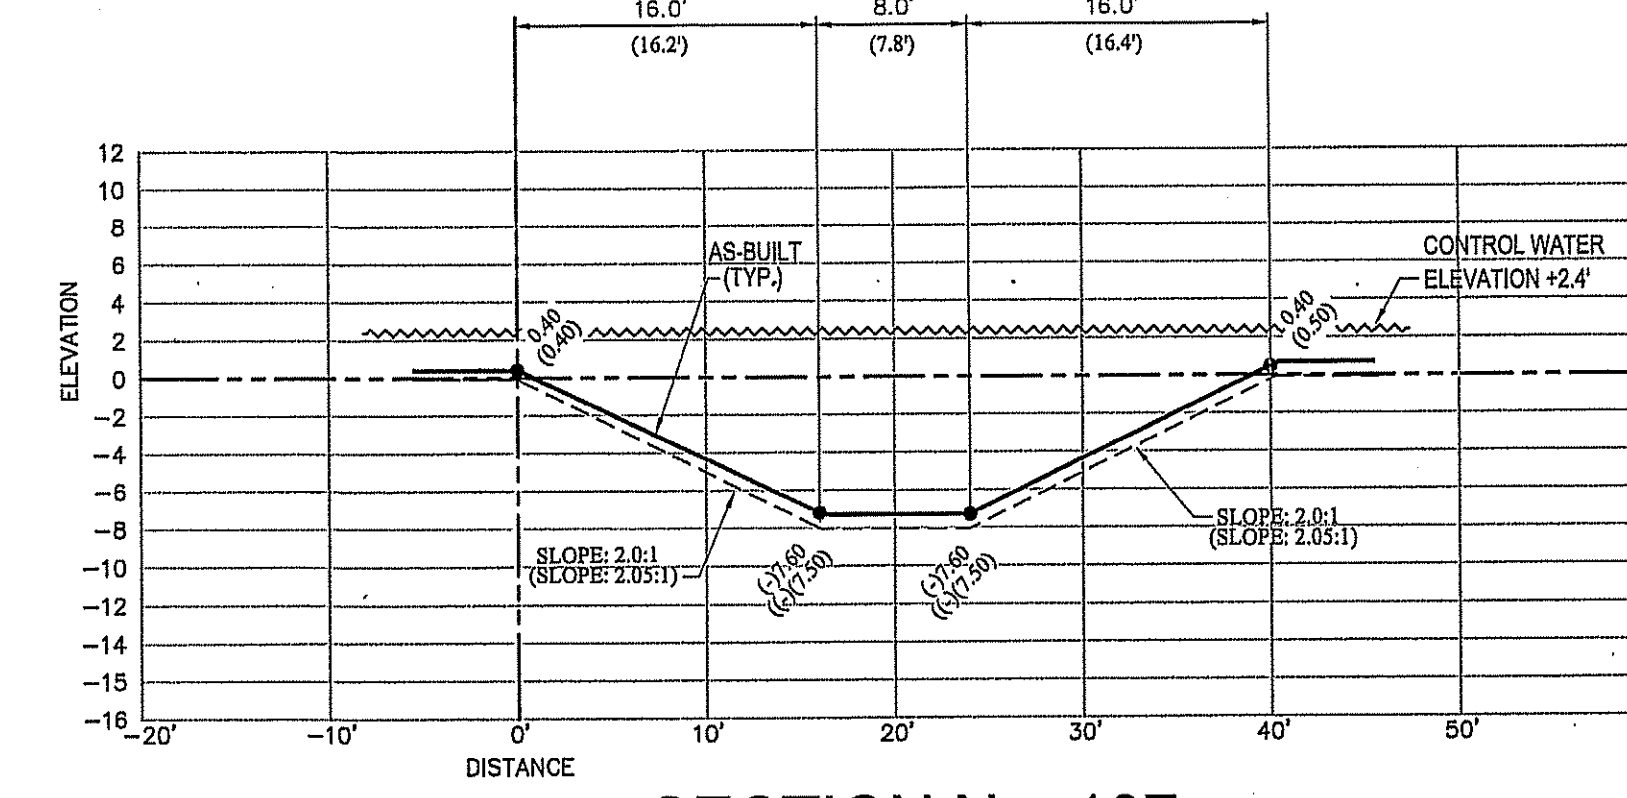

SECTION No. 107
40' CHANNEL

AS-BUILT LEGEND:

- (15.2) DENOTES AS-BUILT DISTANCE
- 15.0' DENOTES DESIGN DISTANCE
- (5.0) DENOTES AS-BUILT ELEVATION
- 5.0 DENOTES DESIGN ELEVATION
- (SLOPE 2.0:1) DENOTES AS-BUILT SLOPE
- SLOPE 2.0:1 DENOTES DESIGN SLOPE
- L.M.E. DENOTES LAKE MAINTENANCE EASEMENT
- DENOTES AS-BUILT LINE
- DENOTES DESIGN LINE

Chad E. Edwards, State of Florida,
Professional Engineer, License No. 59306


This item has been digitally signed and sealed by
Chad E. Edwards, on the date indicated here.
Printed copies of this document are not
considered signed and sealed and the signature
must be verified on any electronic copies.

Chad Everett Edwards
Digitally signed by
Chad Everett Edwards
Date: 2022.10.27
09:34:15 -04'00'

NOTE:
THE AS-BUILT LINEWORK SHOWN HEREON IS A GRAPHICAL REPRESENTATION
AND MAY NOT BE DRAWN TO SCALE FOR CLARITY PURPOSES.


THIS DOCUMENT CONSISTS OF 18 SHEETS AND EACH
SHEET SHALL NOT BE CONSIDERED VALID WITHOUT
SHEET 1.

CERTIFICATE:
I HEREBY CERTIFY THAT THESE RECORD DRAWINGS FOR THE
FACILITY HAVE BEEN REVIEWED BY ME OR BY INDIVIDUALS
UNDER MY DIRECT SUPERVISION FOR COMPLETENESS AND
ADEQUACY, AND ARE TRUE AND CORRECT TO THE BEST OF MY
KNOWLEDGE AND BELIEF. THE FIELD WORK FOR THE AS-BUILT
DRAWINGS HAS BEEN DONE BY: Joseph L. Martin, P.S.M. #4368
10/20/2022

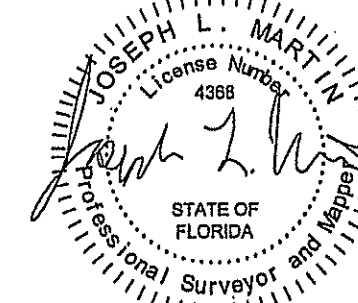

DATE: 12/10/2021 BY:


JOSEPH L. MARTIN
PROFESSIONAL SURVEYOR
& MAPPER PSM# 4368
STATE OF FLORIDA

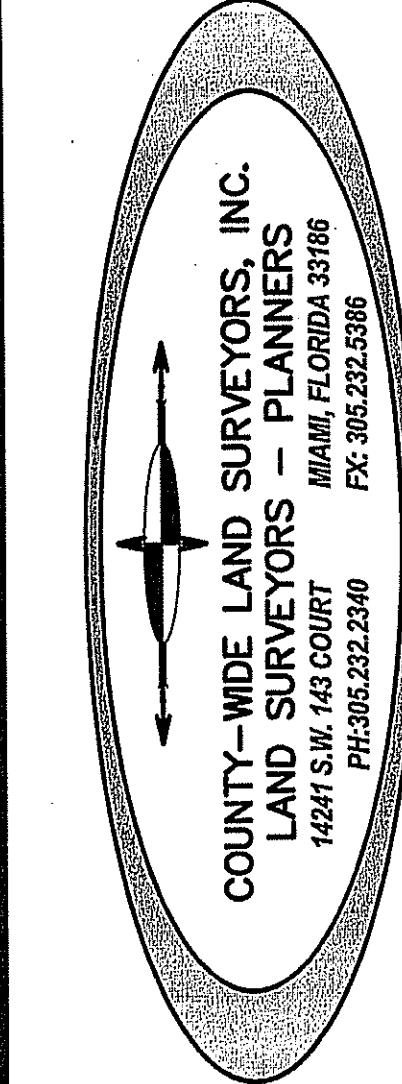


SIERRA RANCH
DAVIE, FL.

PROJ. TYPE	DATE	REVISION COMMENTS	BY	APP
AS-BUILT CROSS SECTIONS	05-18-21	REVISED PER ENGINEER'S COMMENTS	L.A.	J.M.
1950 SOUTH HIATUS ROAD	11-9-21	REVISED TO ADD SECTIONS FROM 16 TO 36	L.A.	J.M.
SEC. 18, TWP. 50S, RGE. 41E	12-9-21	REVISED TO ADD SECTIONS FROM 37 TO 125	L.A.	G.B.
	12-10-21	REVISED PER ENGINEER'S COMMENTS	L.A.	G.B.


SCALE:	H:1"=10' / V:1"=10'
SURVEYOR:	COUNTY-WIDE
DRAWN BY:	LESLEY
CHECKED BY:	G.B.
AS-BUILT:	PRESERVE AREA
DATE:	04/14/2021
DRE PROJECT No:	2019-043
SHEET No:	16 of 18

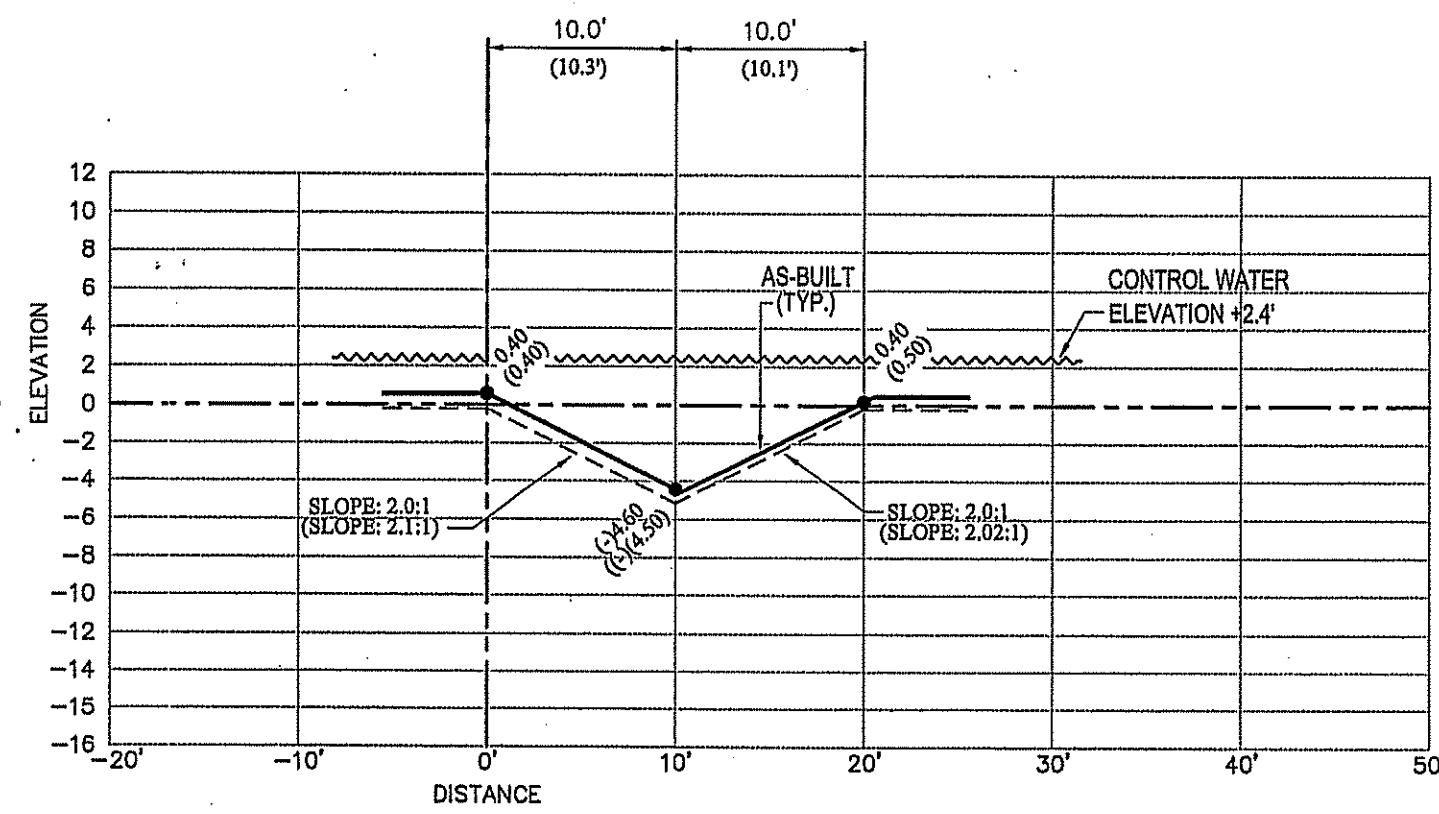


SECTION No. 108
20' CHANNEL

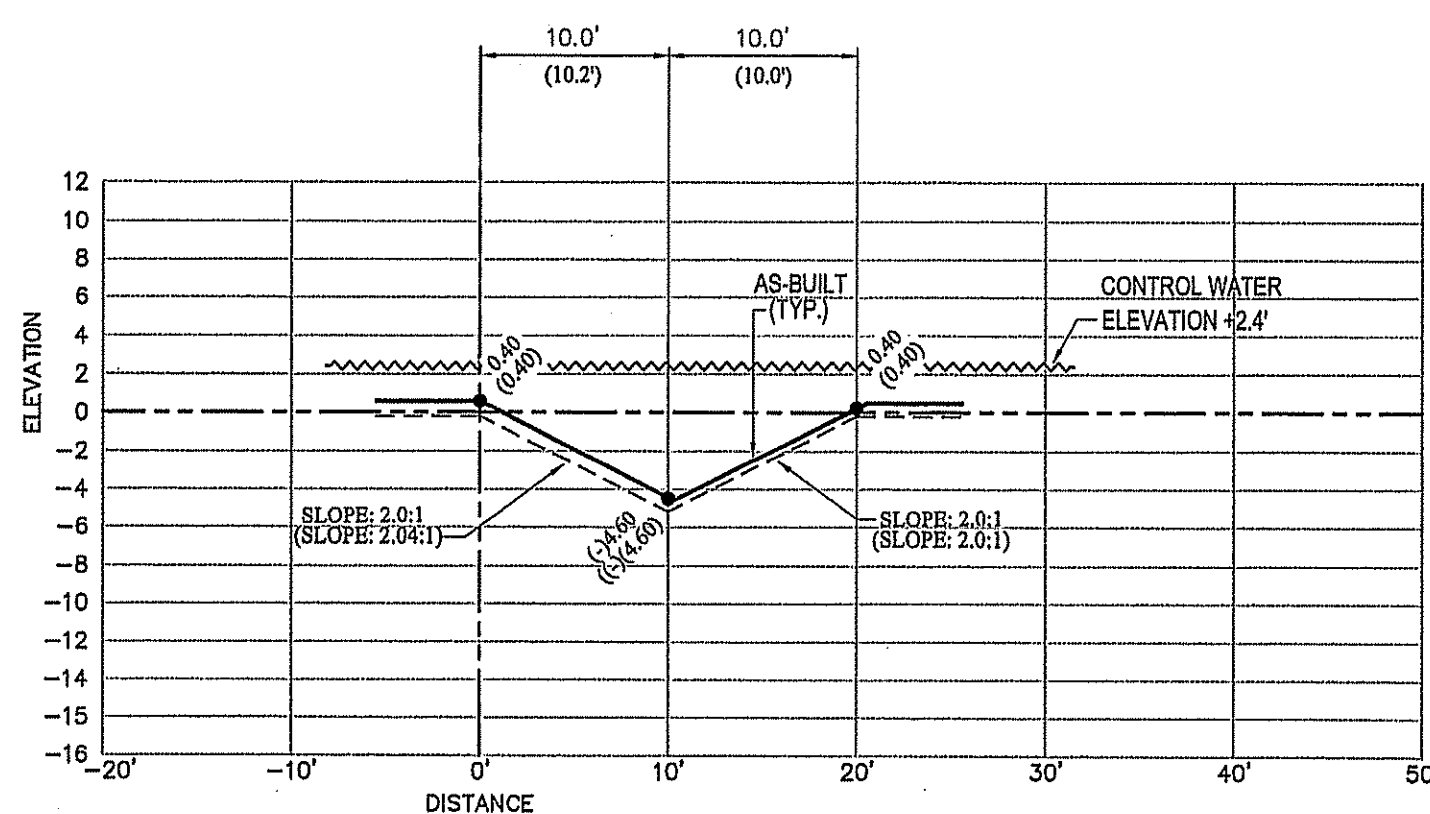


SECTION No. 109
20' CHANNEL

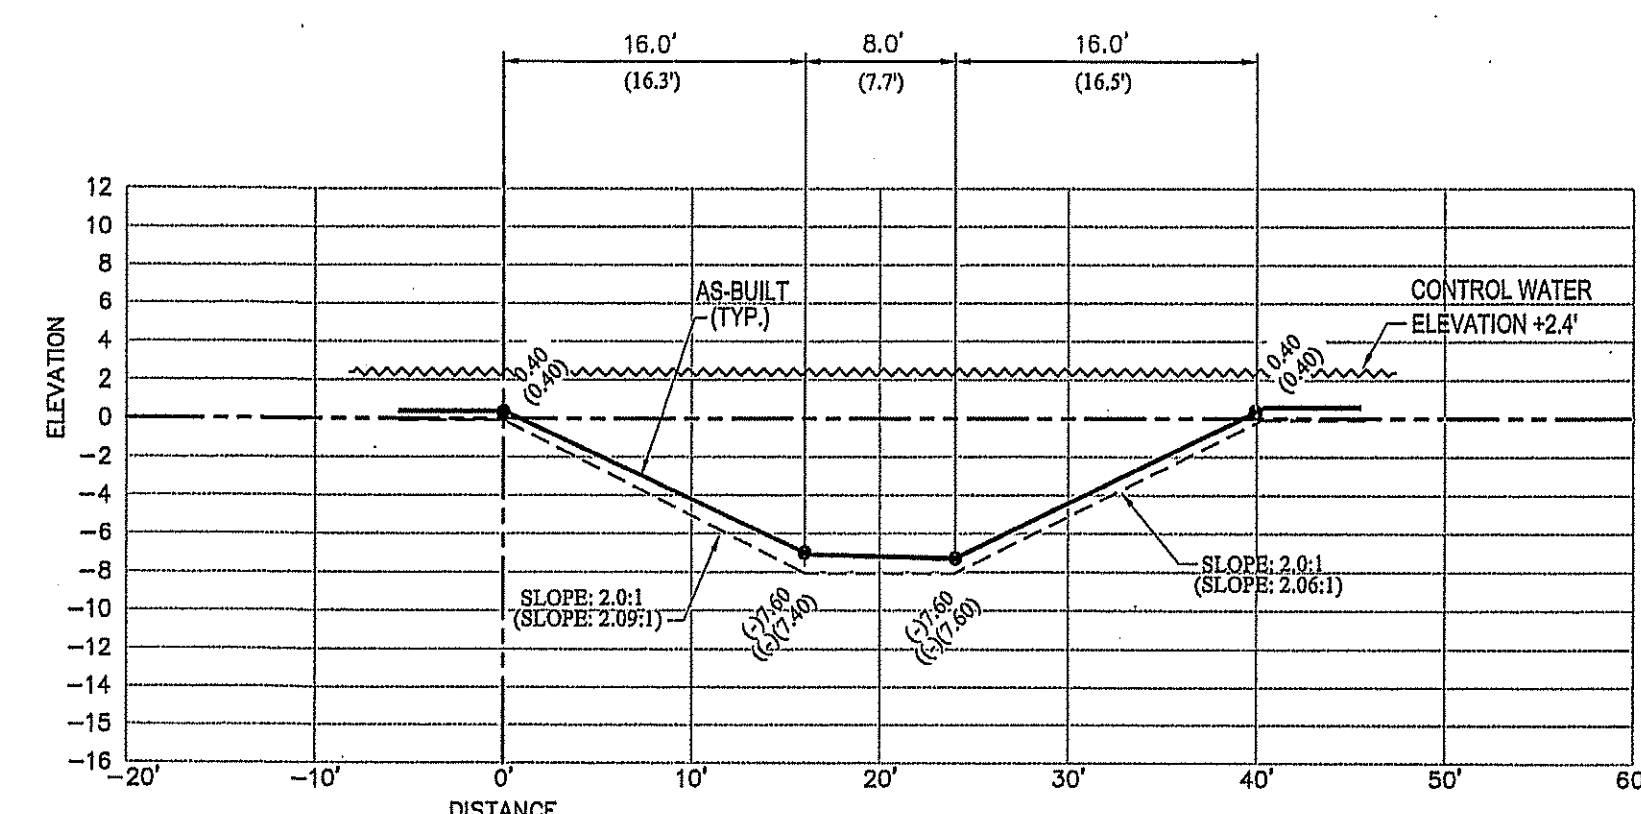


SECTION No. 110
40' CHANNEL

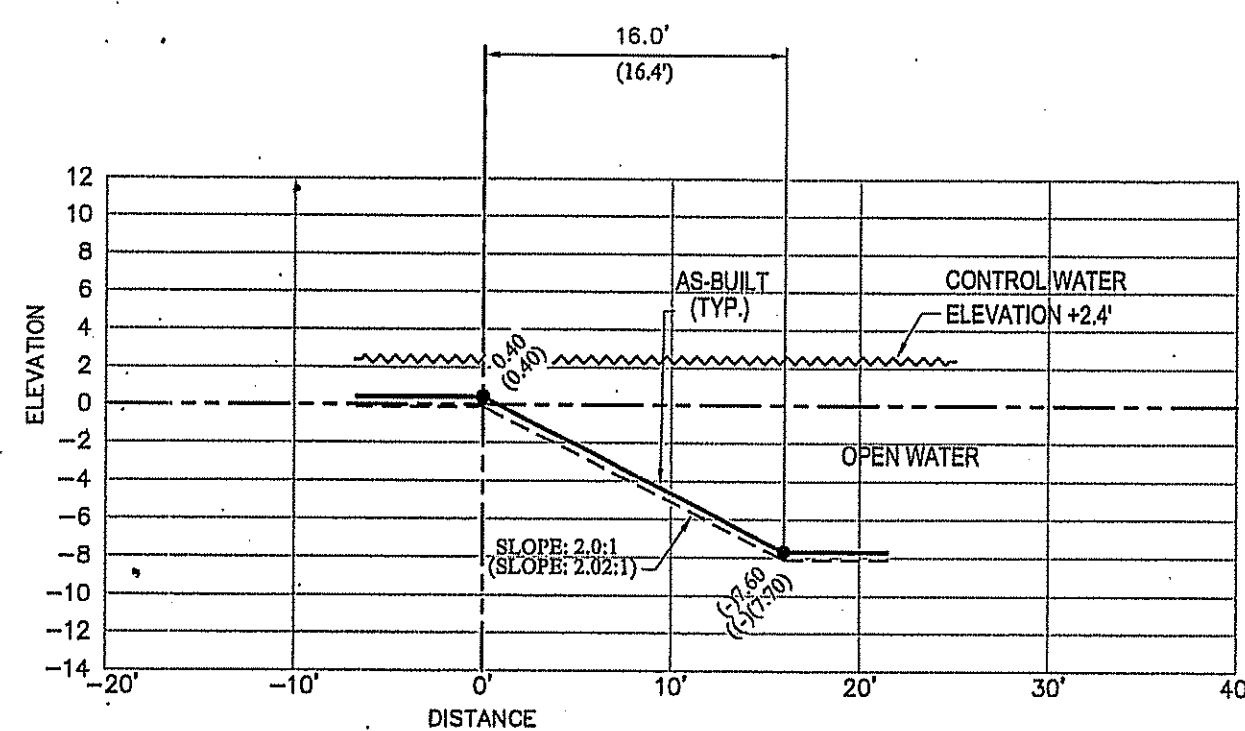


SECTION No. 111
OPEN WATER

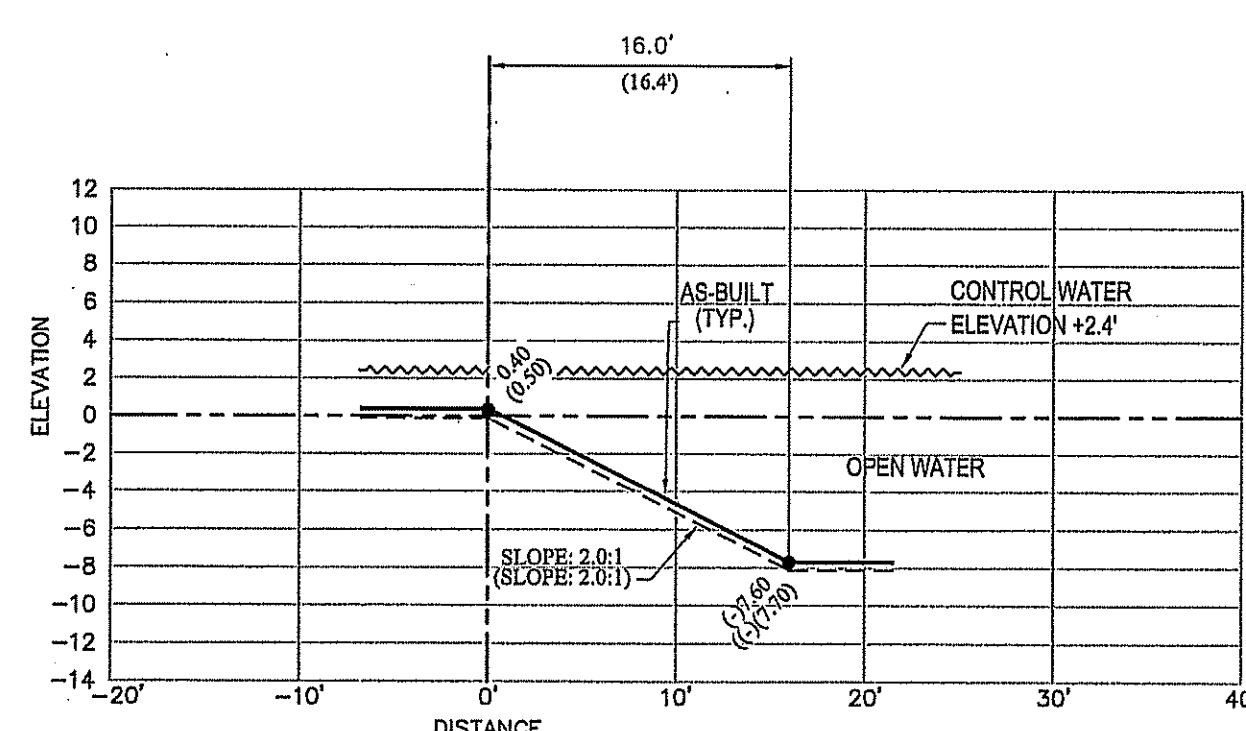


SECTION No. 112
OPEN WATER

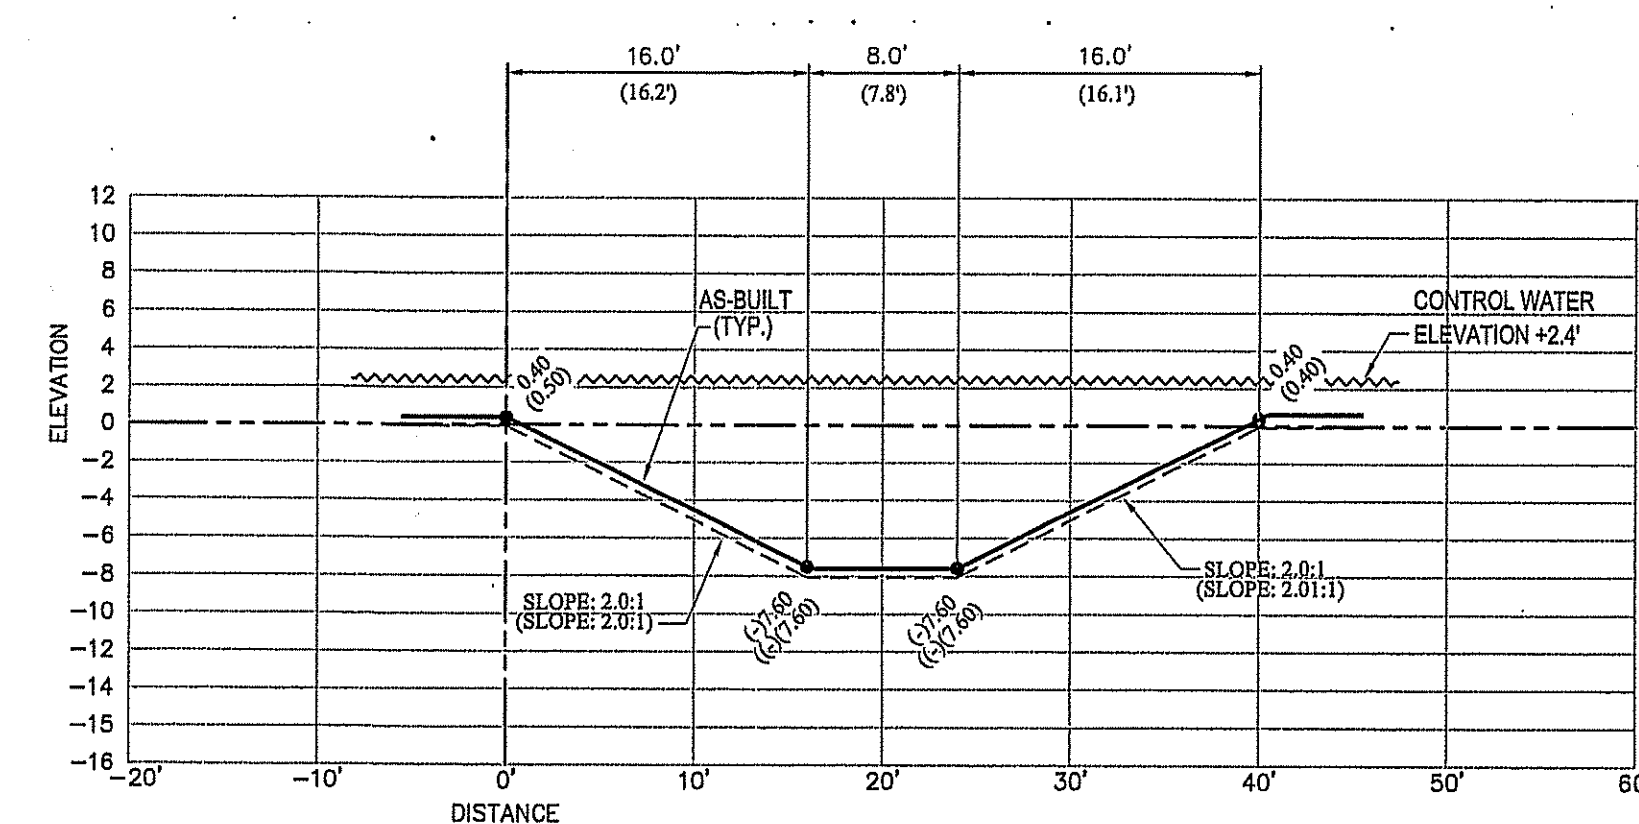


SECTION No. 113
40' CHANNEL

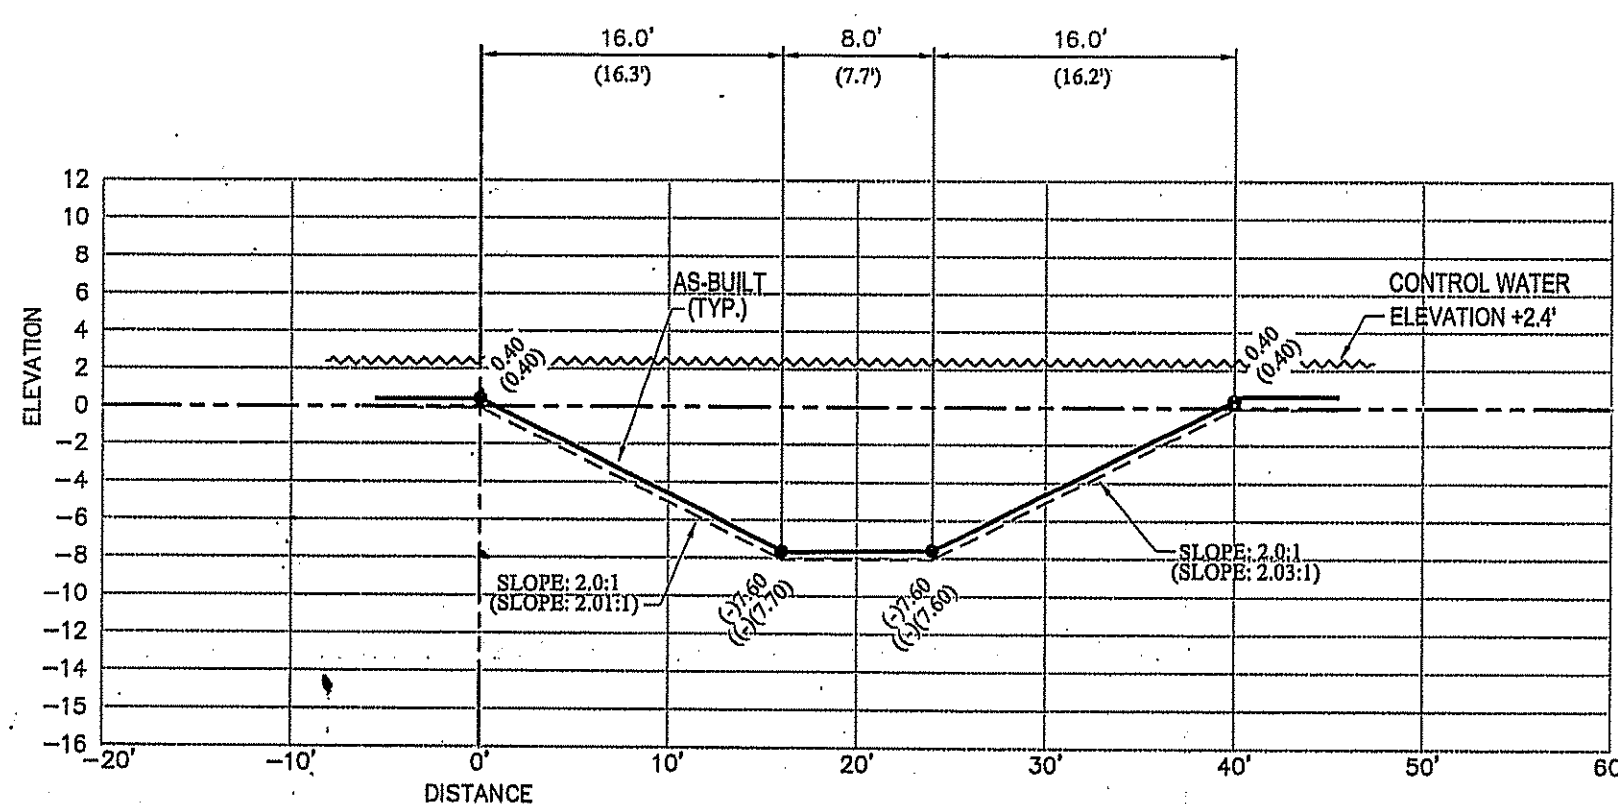

SECTION No. 114
40' CHANNEL

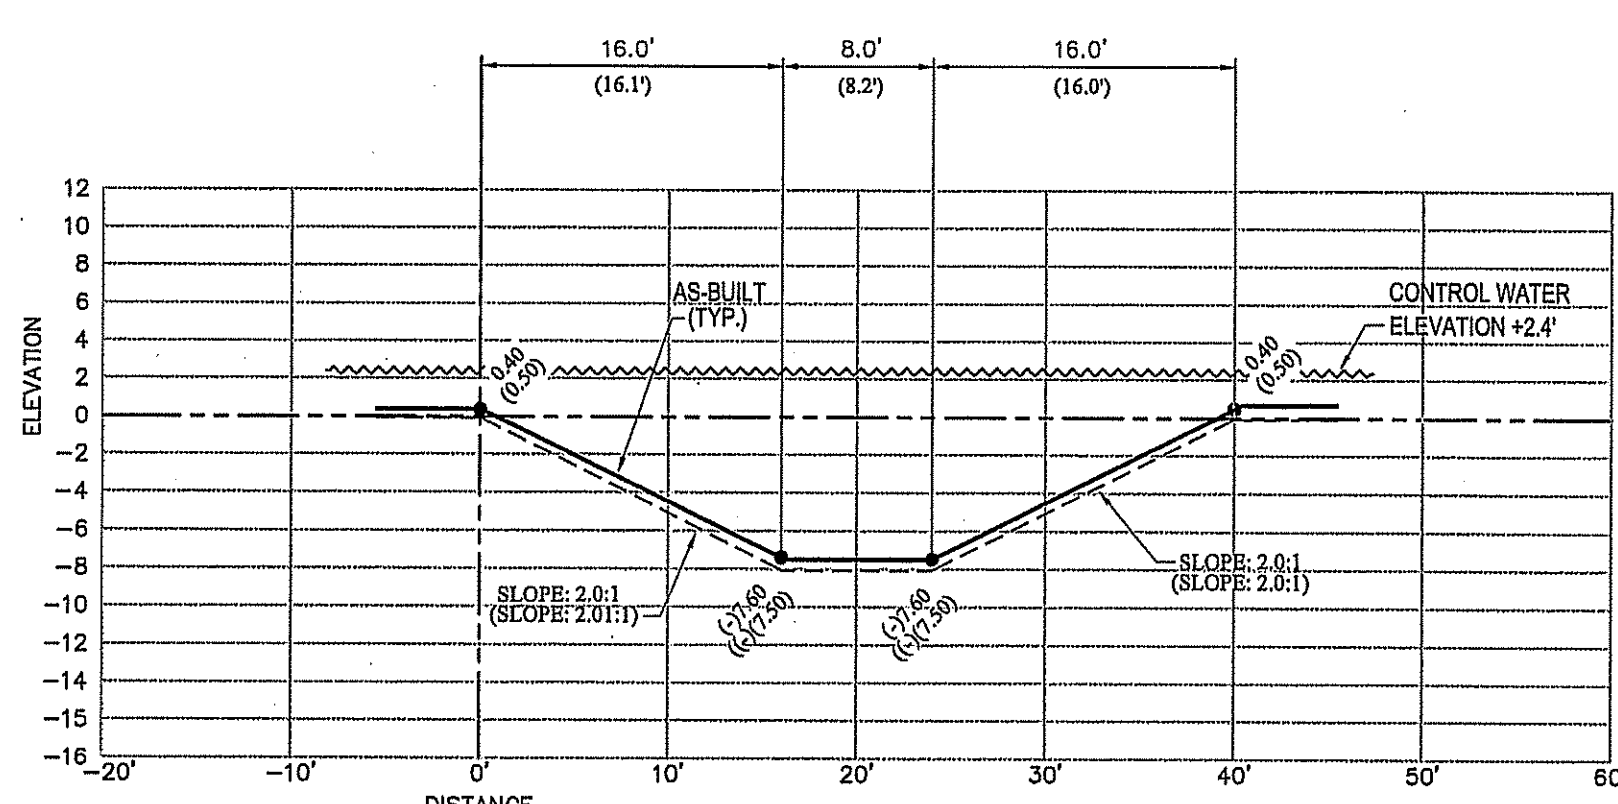

SECTION No. 115
40' CHANNEL

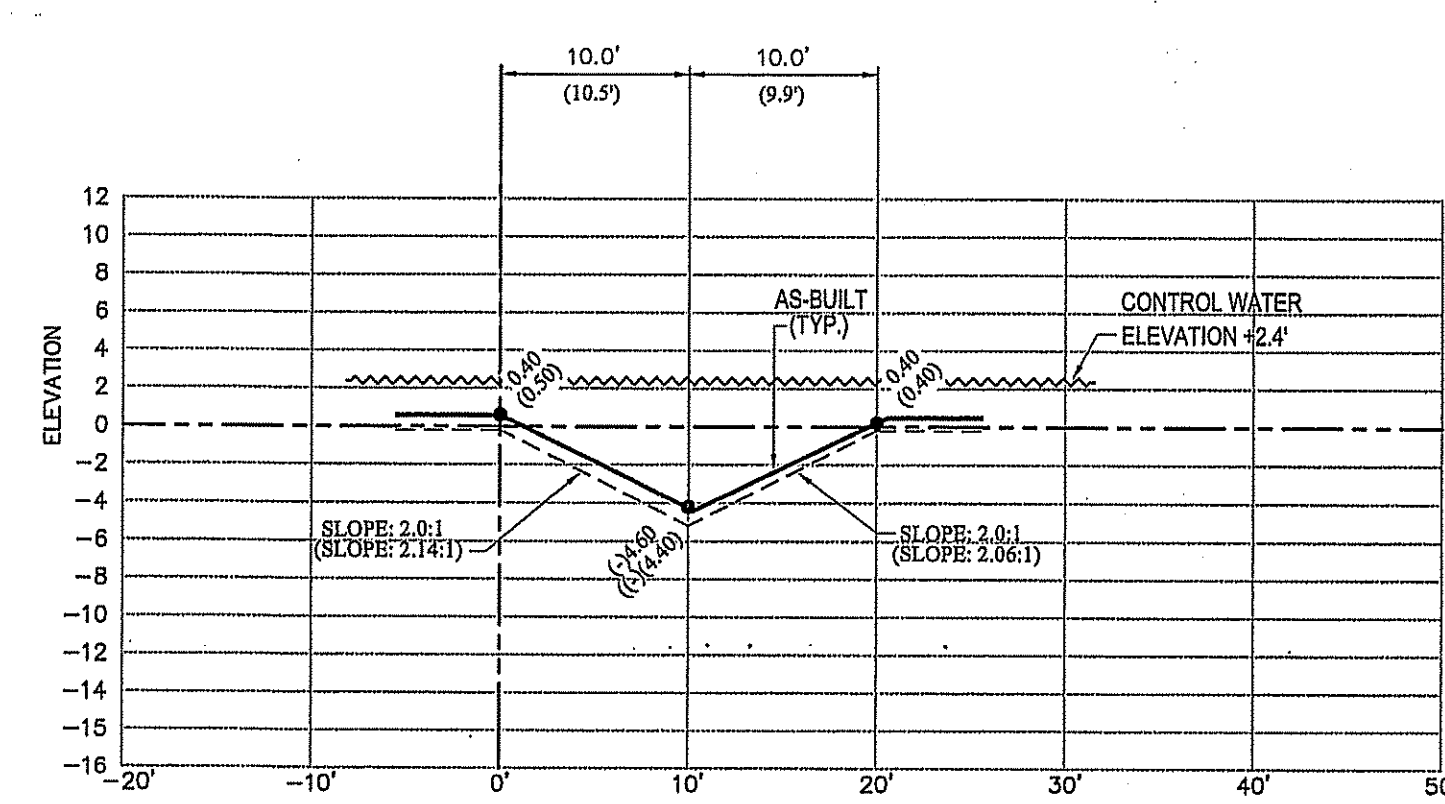

SECTION No. 116
20' CHANNEL

Chad E. Edwards, State of Florida,
Professional Engineer, License No. 59306.

This item has been digitally signed and sealed by
Chad E. Edwards, on the date indicated here.
Printed copies of this document are not
considered signed and sealed and the signature
must be verified on any electronic copies.

Chad Everett Edwards
Digitally signed by
Chad Everett Edwards
Date: 2022.10.27
09:34:54 -04'00'

AS-BUILT LEGEND:

- (15.2) DENOTES AS-BUILT DISTANCE
- (15.0) DENOTES DESIGN DISTANCE
- (5) DENOTES AS-BUILT ELEVATION
- (5) DENOTES DESIGN ELEVATION
- (SLOPE: 2.0:1) DENOTES AS-BUILT SLOPE
- SLOPE: 2.0:1 DENOTES DESIGN SLOPE
- L.M.E. DENOTES LAKE MAINTENANCE EASEMENT
- DENOTES AS-BUILT LINE
- DENOTES DESIGN LINE

NOTE:
THE AS-BUILT LINEWORK SHOWN HEREON IS A GRAPHICAL REPRESENTATION
AND MAY NOT BE DRAWN TO SCALE FOR CLARITY PURPOSES.

THIS DOCUMENT CONSISTS OF 18 SHEETS AND EACH
SHEET SHALL NOT BE CONSIDERED VALID WITHOUT
SHEET 1.

CERTIFICATE:
I HEREBY CERTIFY THAT THESE RECORD DRAWINGS FOR THE
FACILITY HAVE BEEN REVIEWED BY ME OR BY INDIVIDUAL(S)
UNDER MY DIRECT SUPERVISION FOR COMPLETENESS AND
ADEQUACY, AND ARE TRUE AND CORRECT TO THE BEST OF MY
KNOWLEDGE AND BELIEF. THE FIELD WORK FOR THE AS-BUILT
DRAWINGS HAS BEEN DONE BY: Joseph L. Martin, P.E., S.M., A.S.P.

DATE: 12/10/2021


BY:
JOSEPH L. MARTIN
PROFESSIONAL SURVEYOR
& MAPPER
PSM# 4368
STATE OF FLORIDA










SIERRA RANCH
DAVIE, FL.

AS-BUILT CROSS SECTIONS
1950 SOUTH HIATUS ROAD
SEC. 18, TWP. 50S, RGE. 41E

SCALE: H:1"=10' / V:1"=10'
SURVEYOR: COUNTY-WIDE
DRAWN BY: LESLY
CHECKED BY: G.B.
AS-BUILT: PRESERVE AREA
DATE: 04/14/2021
DRE PROJECT No: 2019-043
SHEET No: 17 of 18

REVISION COMMENTS	DATE	BY	APP
REVISED PER ENGINEER'S COMMENTS	05-18-21	L.A. J.M.	J.M.
REVISED TO ADD SECTIONS FROM 16 TO 36	11-8-21	L.A. J.M.	J.M.
REVISED TO ADD SECTIONS FROM 37 TO 125	12-8-21	L.A. G.B.	G.B.
REVISED PER ENGINEER'S COMMENTS	12-10-21	L.A. G.B.	G.B.

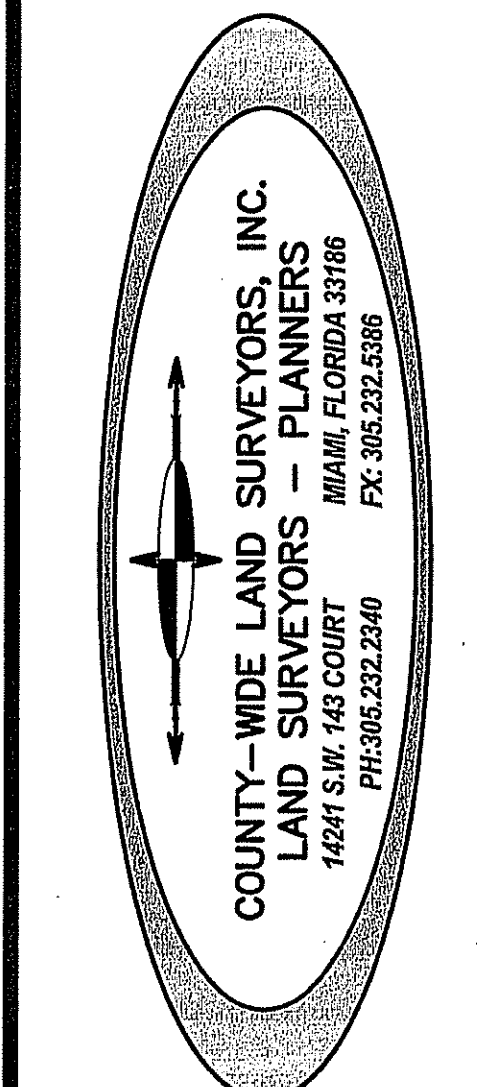

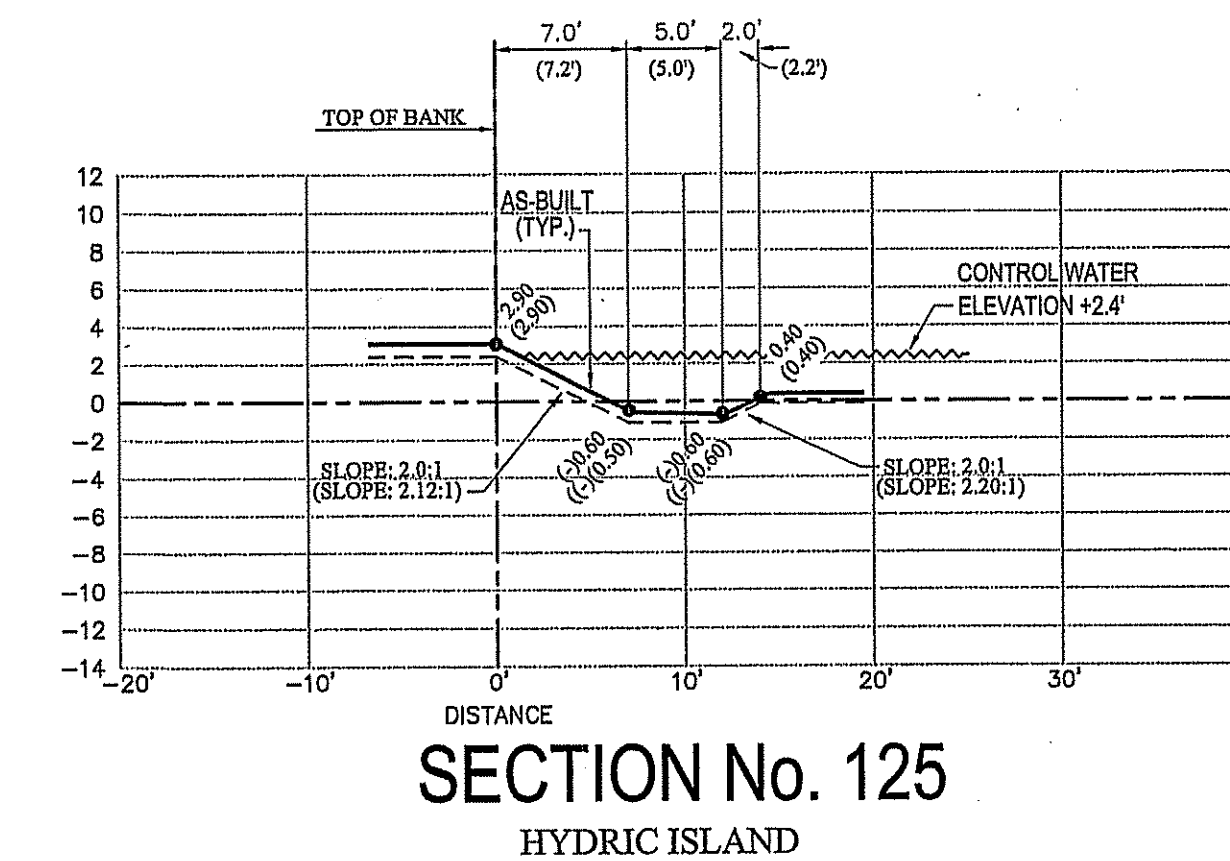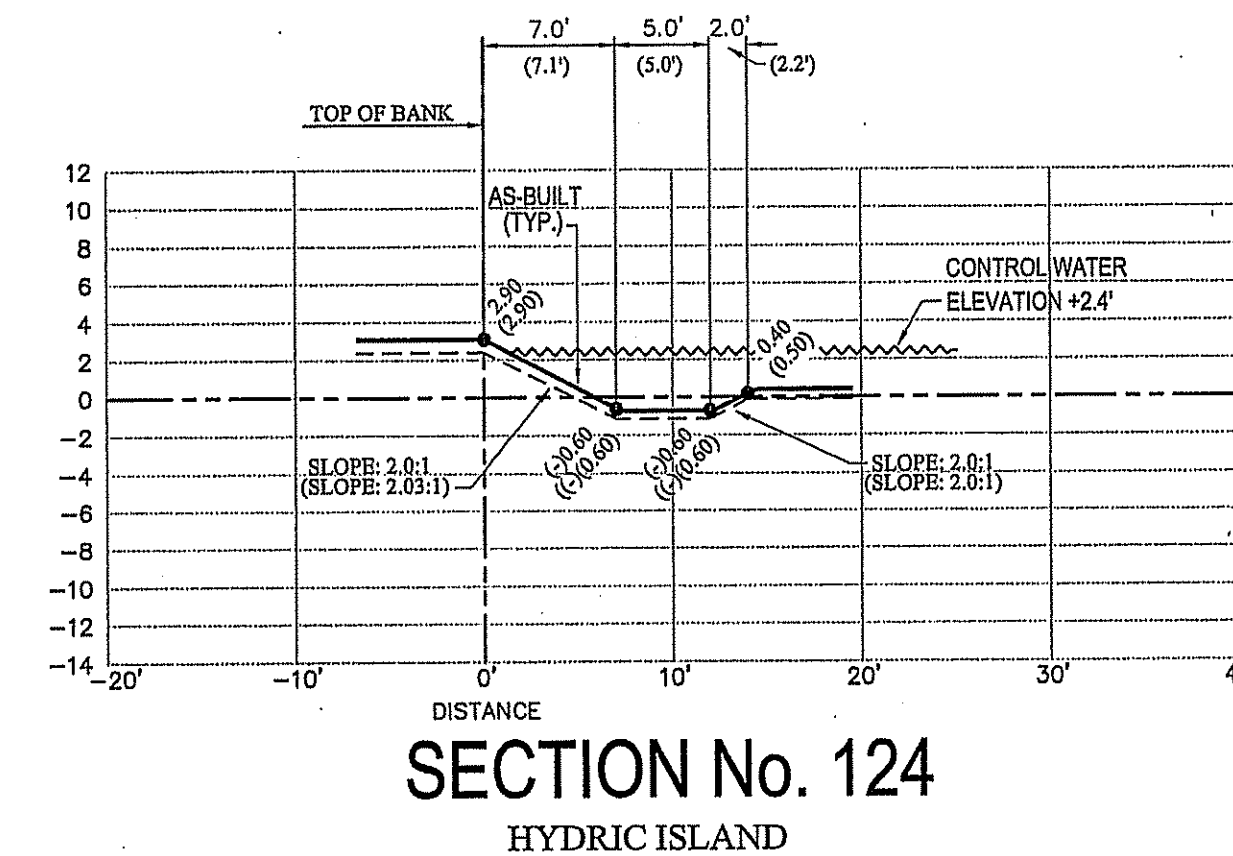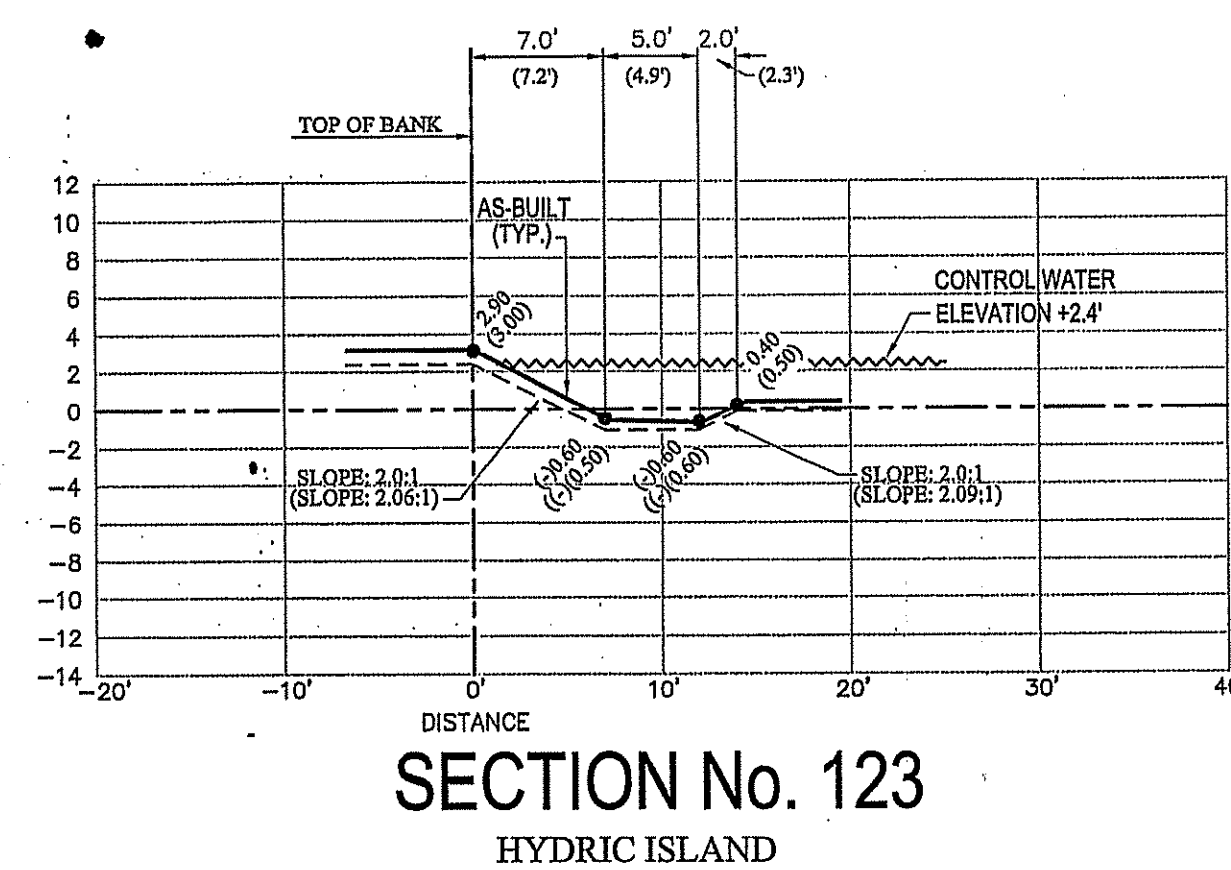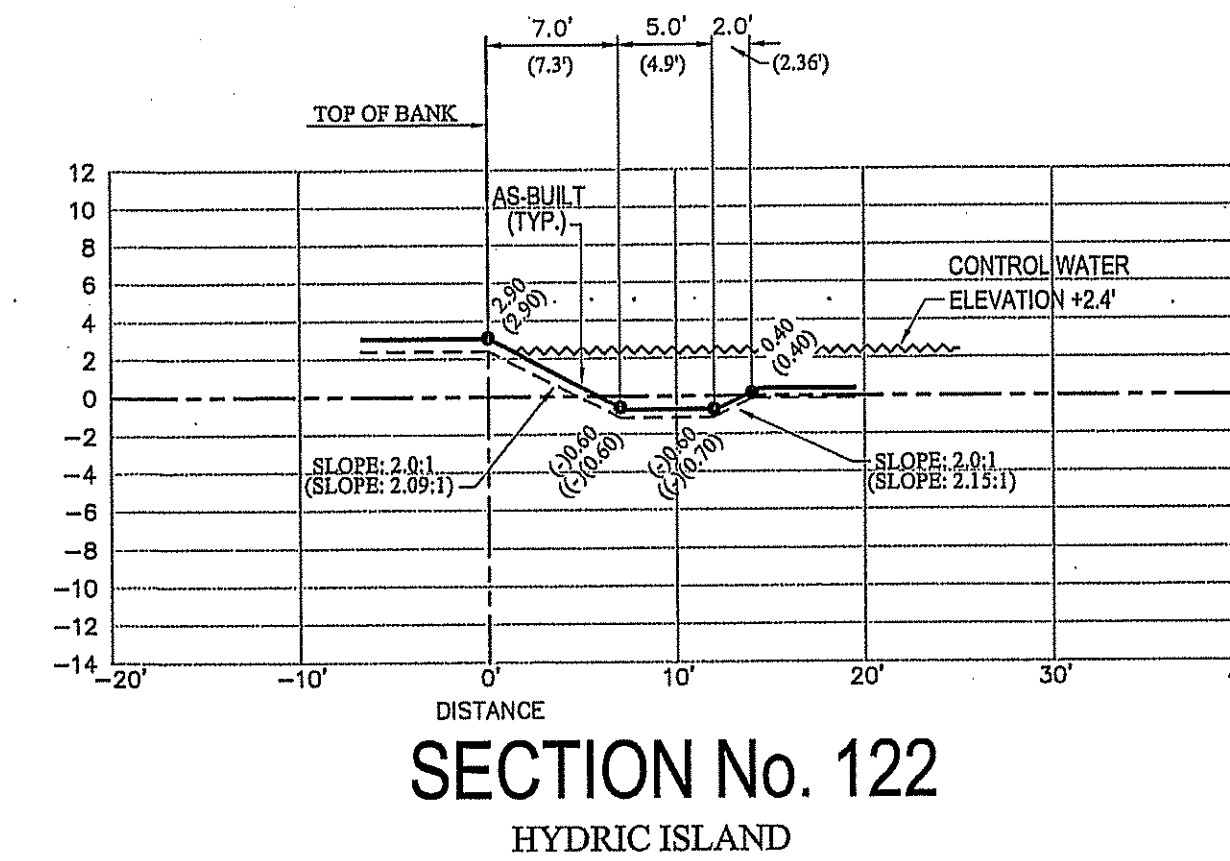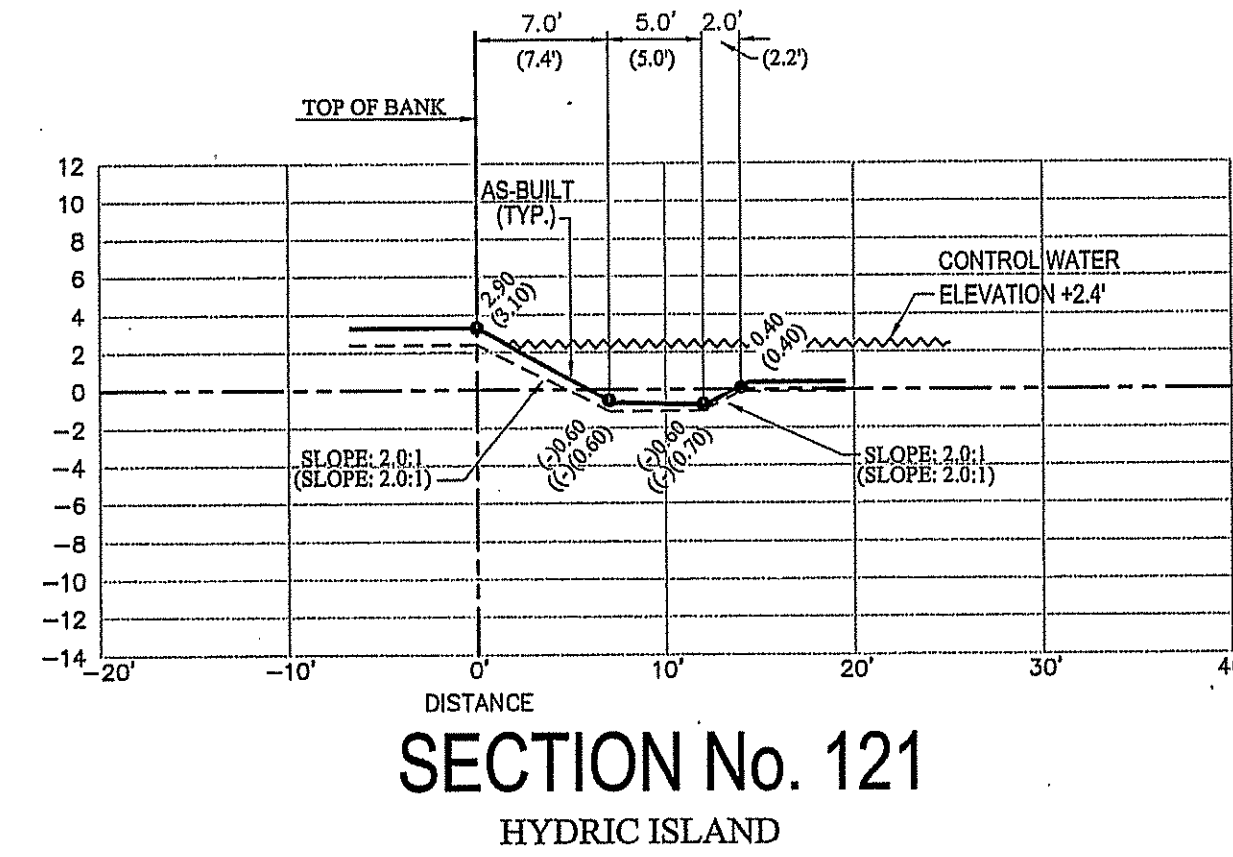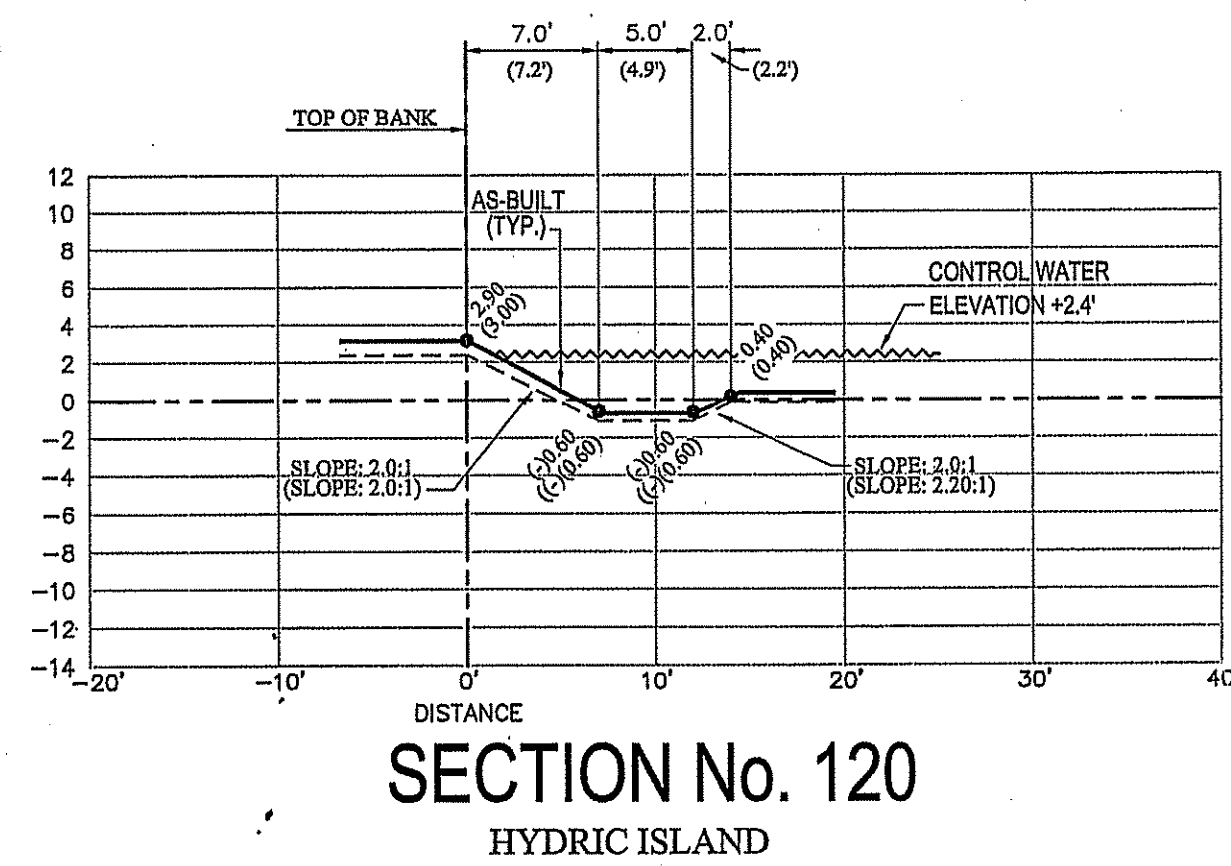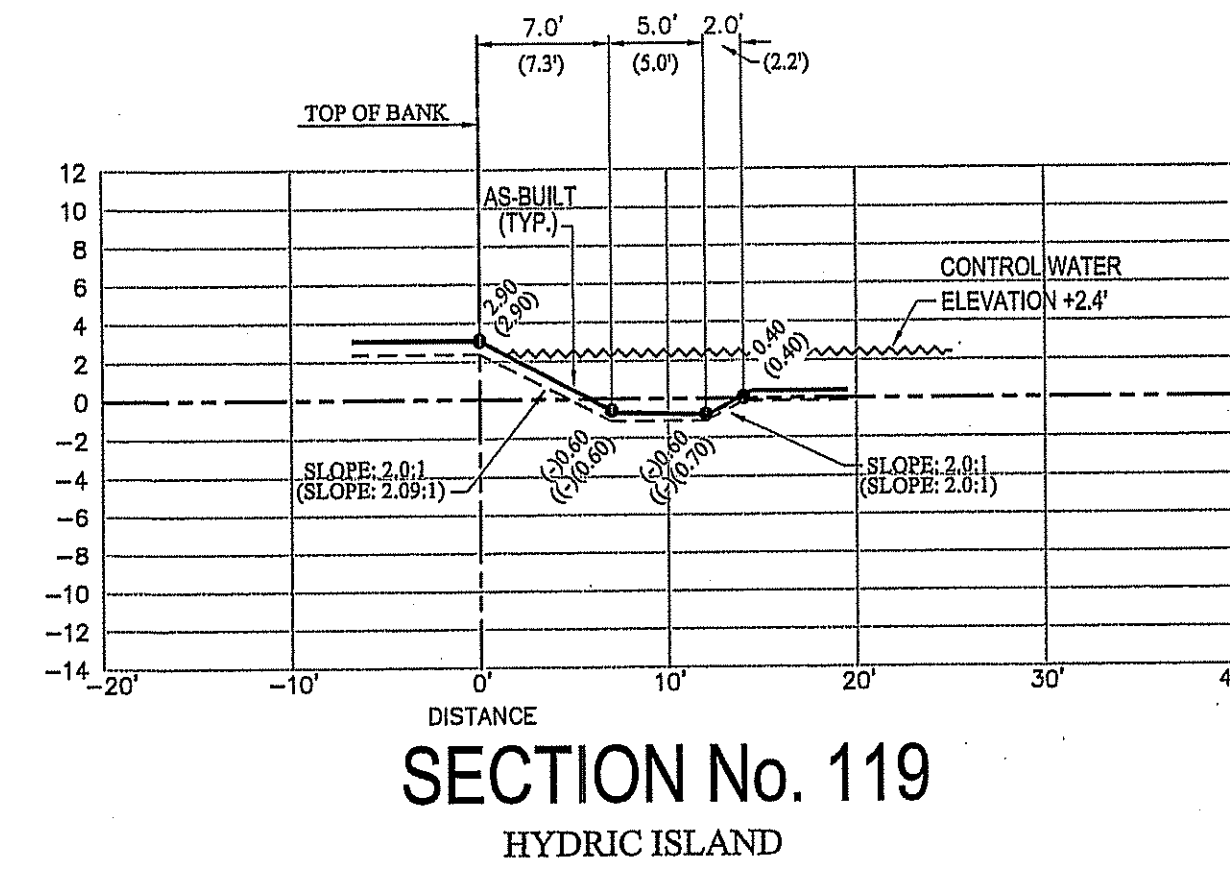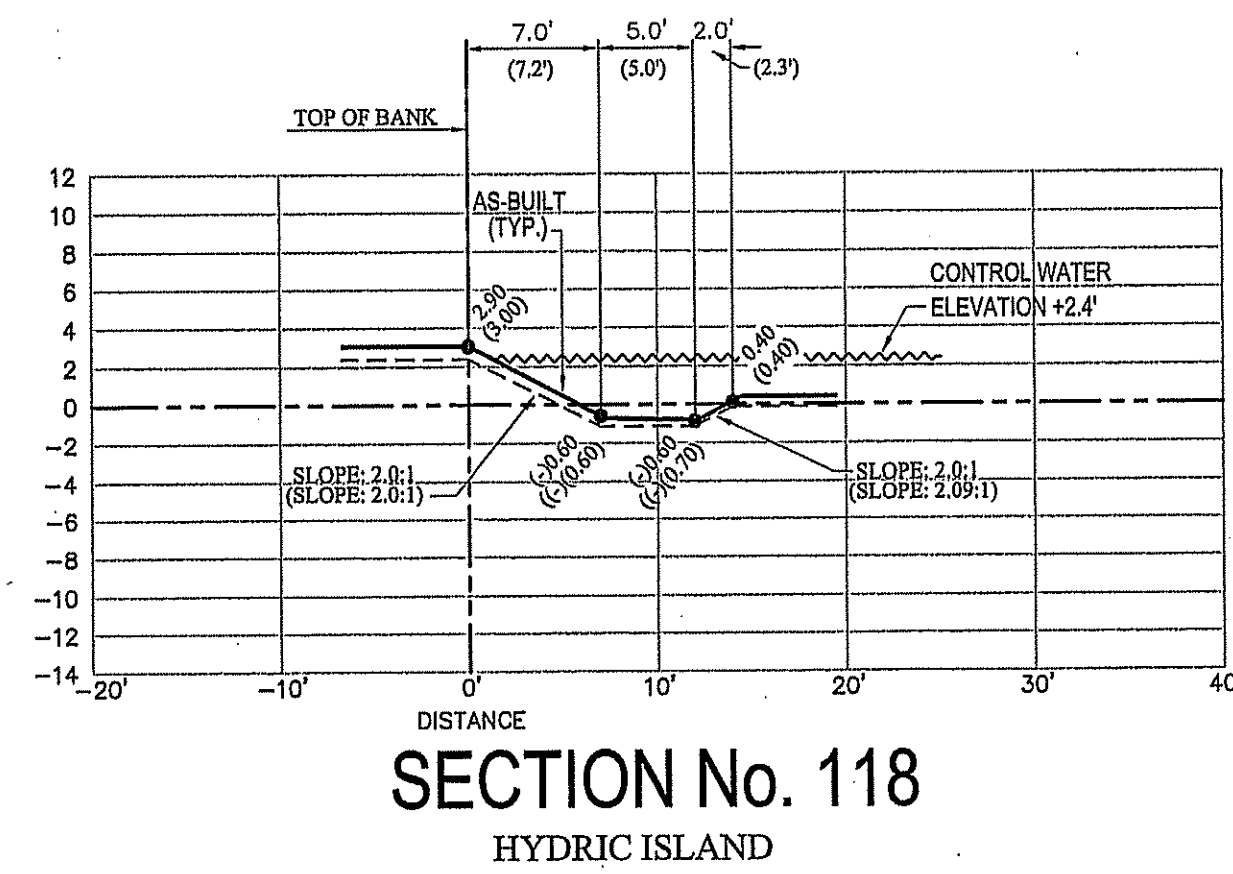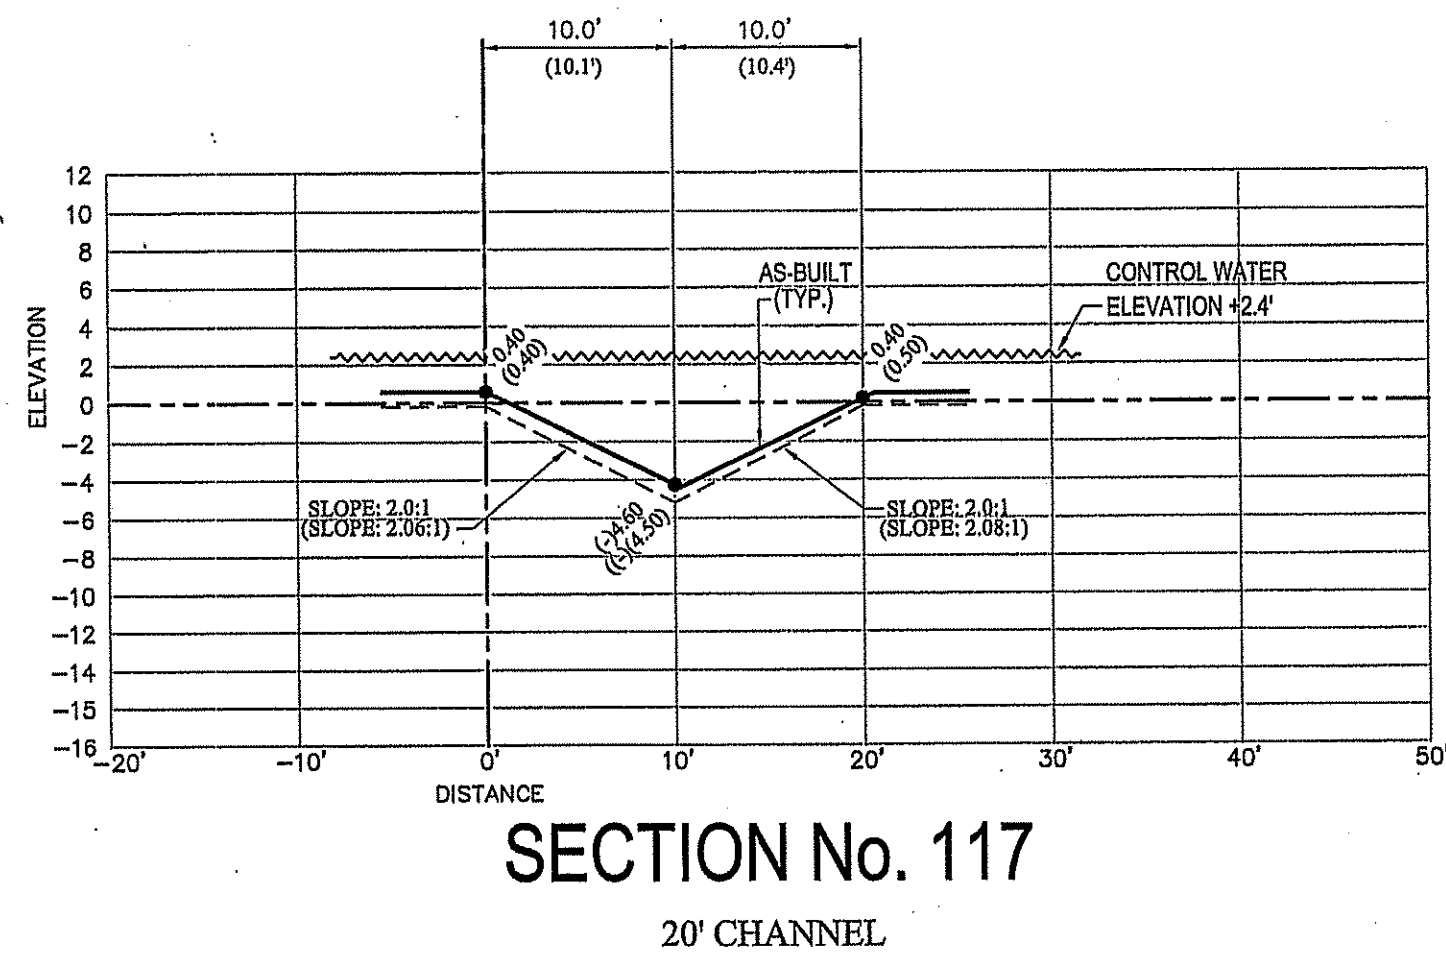

Chad E. Edwards, State of Florida,
Professional Engineer, License No. 59306

This item has been digitally signed and sealed by
Chad E. Edwards, on the date indicated here.
Printed copies of this document are not
considered signed and sealed and the signature
must be verified on any electronic copies.

Chad Everett
Edwards
Digitally signed by
Chad Everett Edwards
Date: 2022.10.27
09:35:31 -04'00'

AS-BUILT LEGEND:


- (15.2) DENOTES AS-BUILT DISTANCE
- 15.0' DENOTES DESIGN DISTANCE
- 5.0' DENOTES AS-BUILT ELEVATION
- 5.0' DENOTES DESIGN ELEVATION
- (SLOPE: 2.0:1) DENOTES AS-BUILT SLOPE
- SLOPE: 2.0:1 DENOTES DESIGN SLOPE
- L.M.E. DENOTES LAKE MAINTENANCE EASEMENT
- DENOTES AS-BUILT LINE
- DENOTES DESIGN LINE

NOTE:
THE AS-BUILT LINEWORK SHOWN HEREON IS A GRAPHICAL REPRESENTATION
AND MAY NOT BE DRAWN TO SCALE FOR CLARITY PURPOSES.

THIS DOCUMENT CONSISTS OF 18 SHEETS AND EACH
SHEET SHALL NOT BE CONSIDERED VALID WITHOUT
SHEET 1.

CERTIFICATE:
I HEREBY CERTIFY THAT THESE RECORD DRAWINGS FOR THE
FACILITY HAVE BEEN REVIEWED BY ME OR BY INDIVIDUAL(S)
UNDER MY DIRECT SUPERVISION FOR COMPLETENESS AND
ADEQUACY, AND ARE TRUE AND CORRECT TO THE BEST OF MY
KNOWLEDGE AND BELIEF. THE FIELD WORK FOR THE AS-BUILT
DRAWINGS HAS BEEN DONE BY: Joseph L. Martin, P.S.M. #4358
10/20/2022

DATE: 12/10/2021 BY:

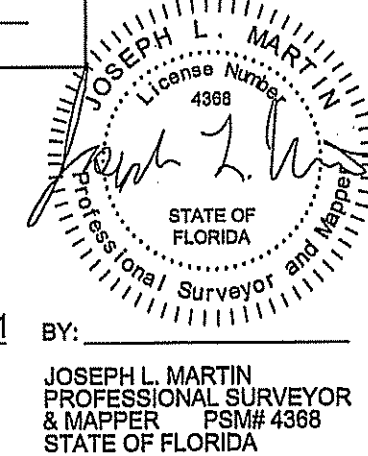

SIERRA RANCH
DAVIE, FL.

PROJ. TYPE	DATE	REVISION COMMENTS	BY	APP
AS-BUILT CROSS SECTIONS	05-18-21	REVISED PER ENGINEER'S COMMENTS	L.A.	J.M.
1950 SOUTH HIATUS ROAD	11-9-21	REVISED TO ADD SECTIONS FROM 16 TO 36	L.A.	J.M.
SEC. 18, TWP. 50S, RGE. 41E	12-8-21	REVISED TO ADD SECTIONS FROM 37 TO 125	L.A.	G.B.
	12-10-21	REVISED PER ENGINEER'S COMMENTS	L.A.	G.B.

SCALE: H:1"=10' / V:1"=10'
SURVEYOR: COUNTY-WIDE
DRAWN BY: LESLY
CHECKED BY: G.B.
AS-BUILT: PRESERVE AREA
DATE: 04/14/2021
DRE PROJECT No: 2019-043
SHEET No: 18 of 18

