




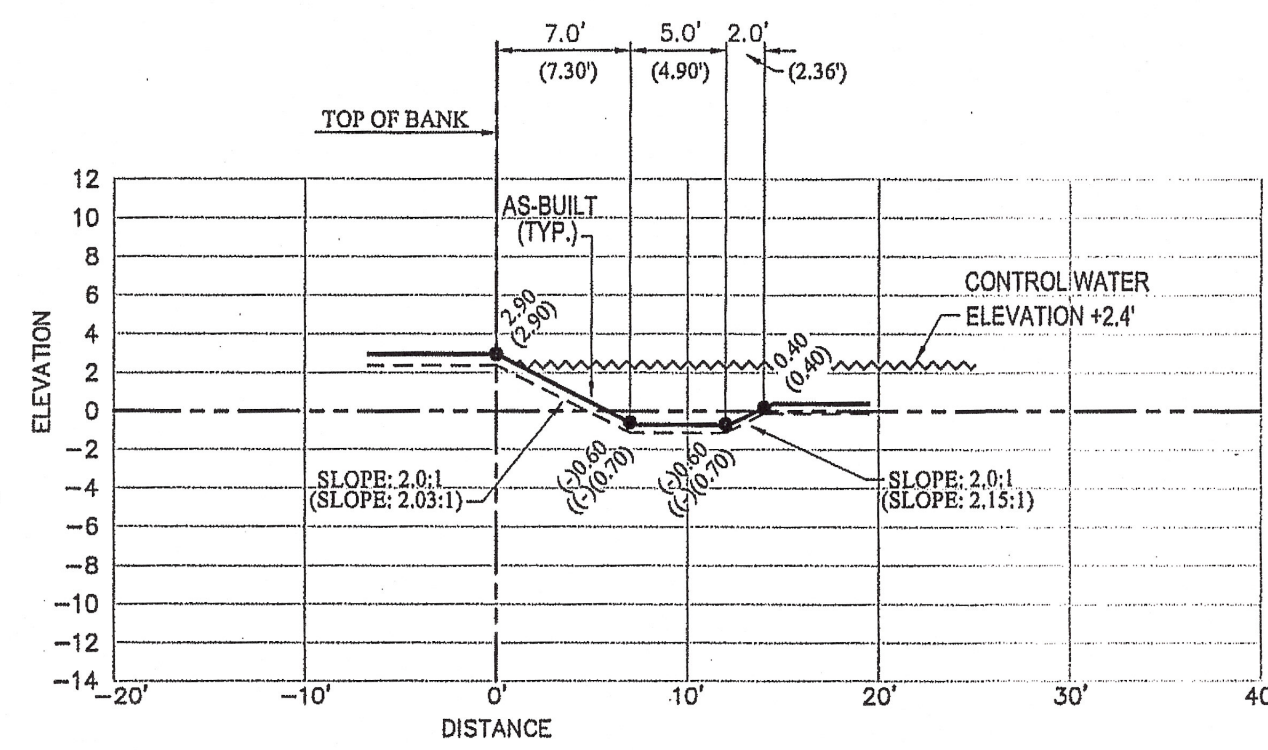


SECTION No. 90
HYDRIC ISLAND

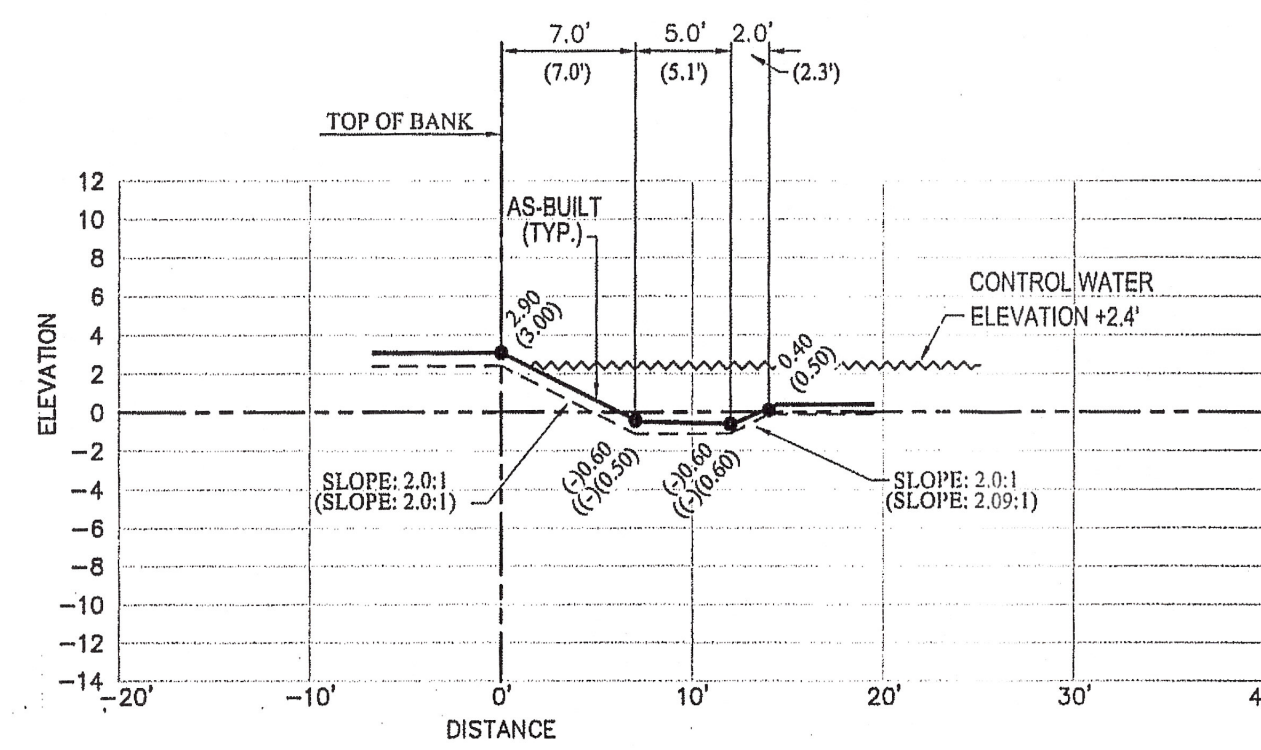


SECTION No. 91
HYDRIC ISLAND

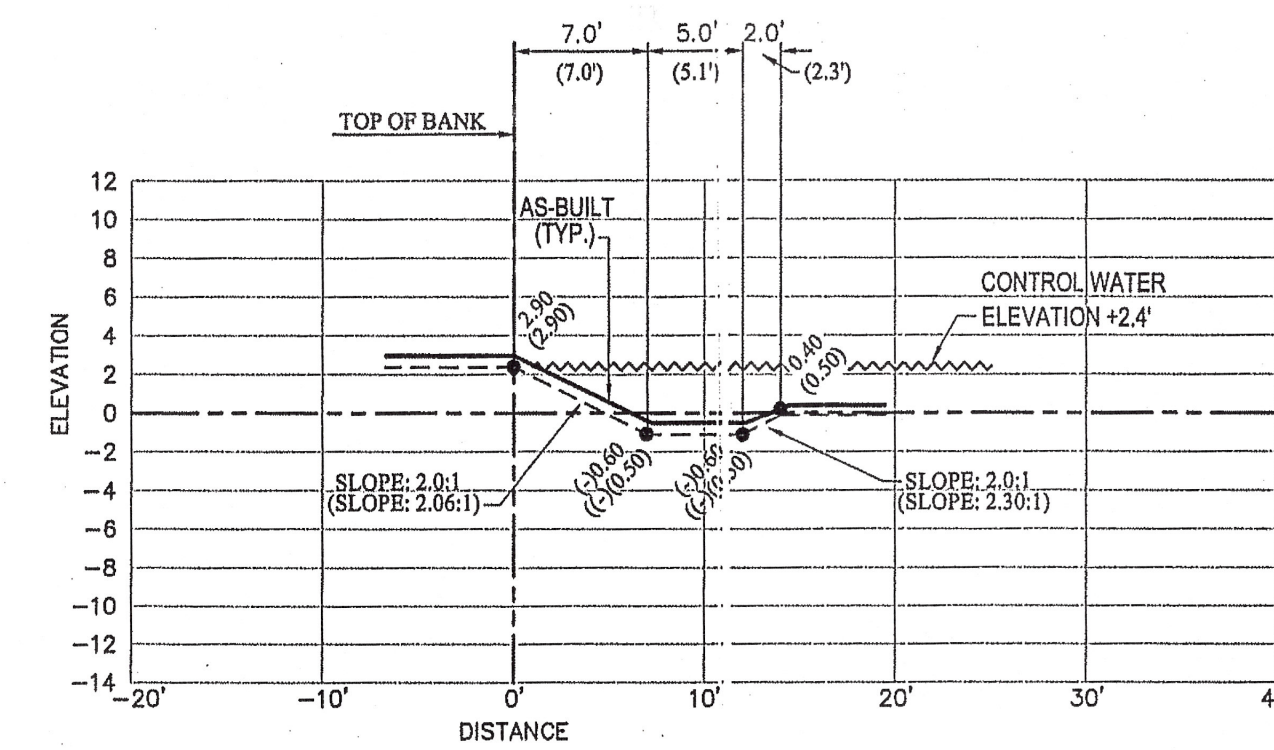


SECTION No. 92
HYDRIC ISLAND

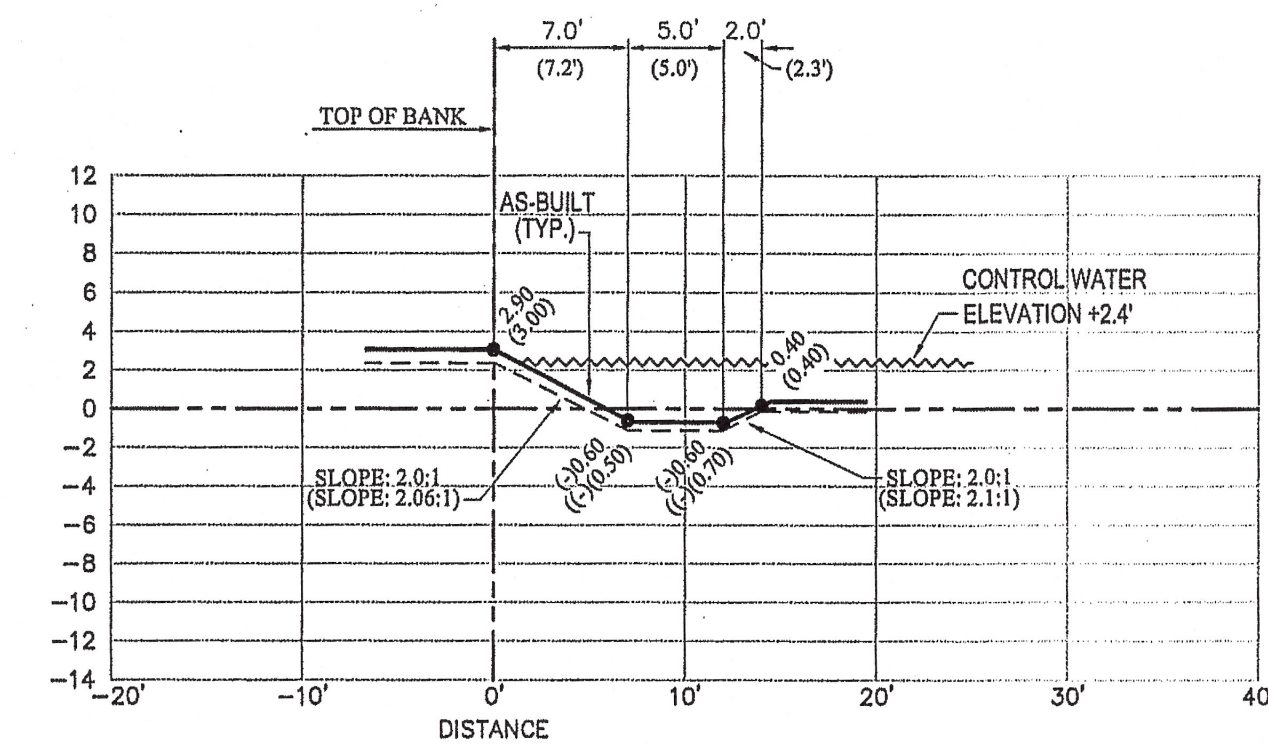


SECTION No. 93
HYDRIC ISLAND

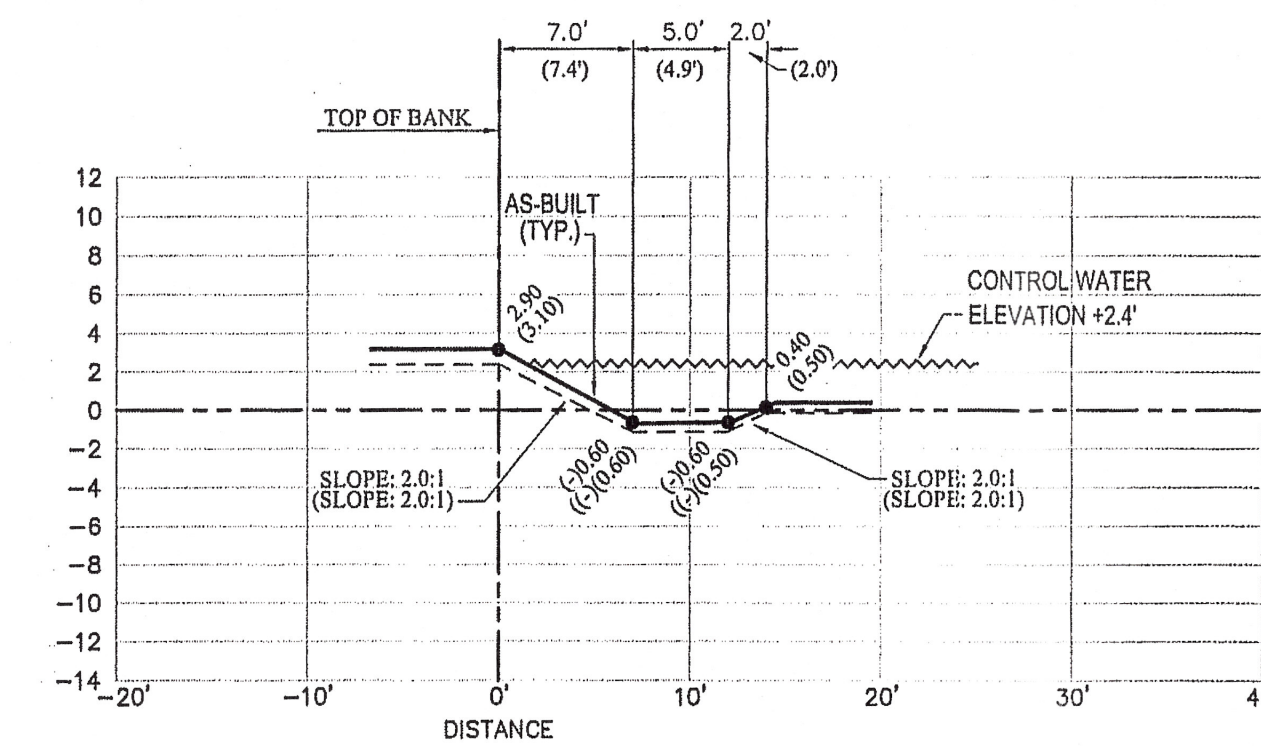


SECTION No. 94
HYDRIC ISLAND

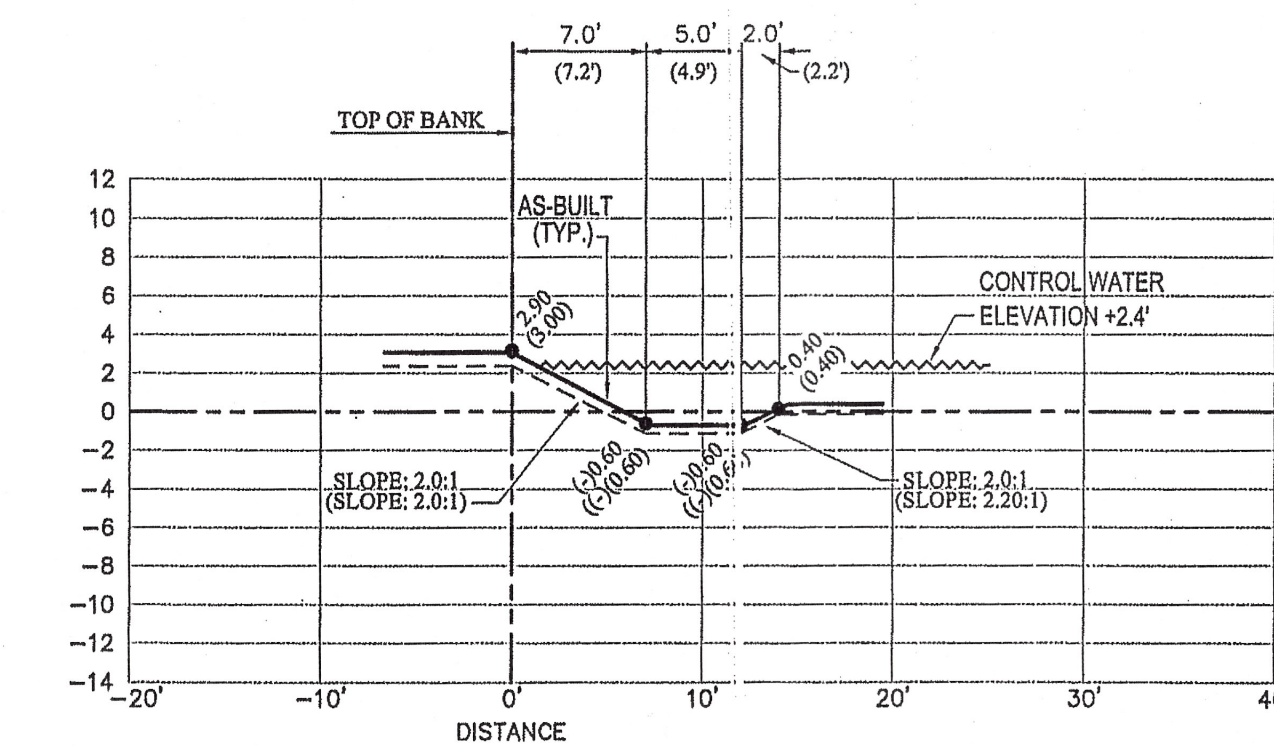


SECTION No. 95
HYDRIC ISLAND

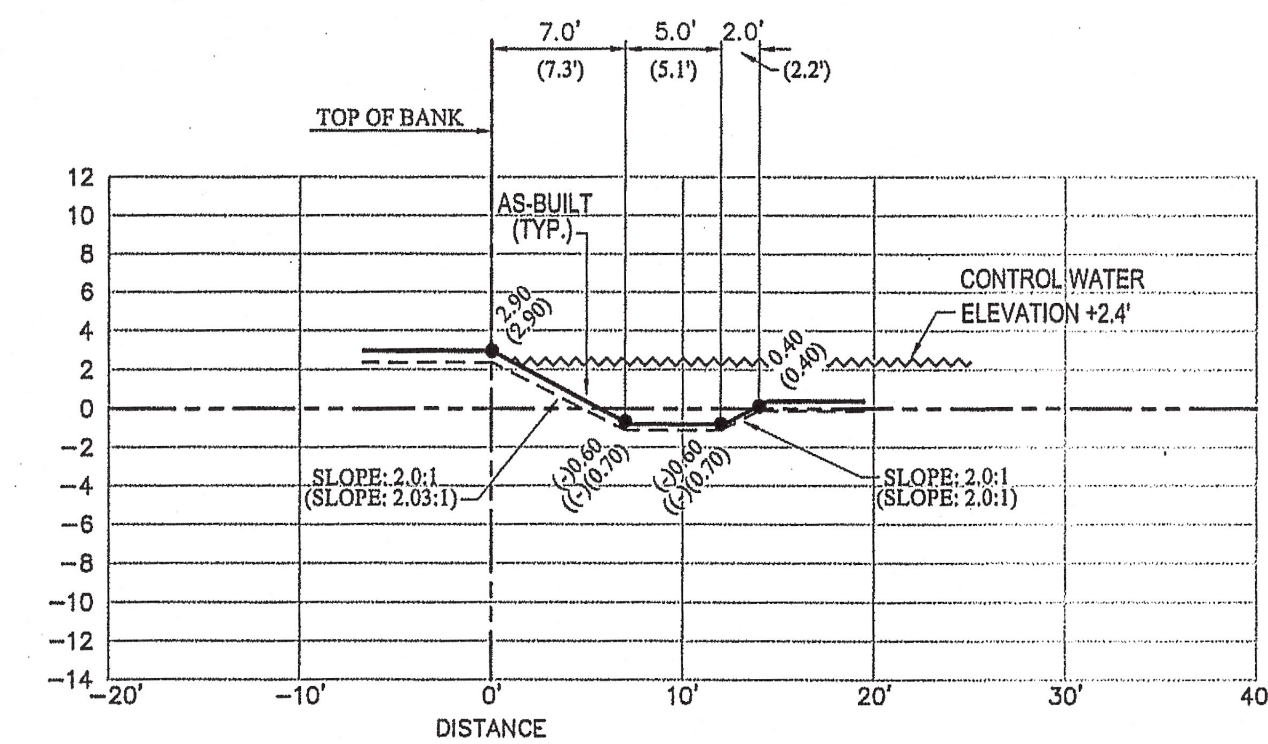

SECTION No. 96
HYDRIC ISLAND

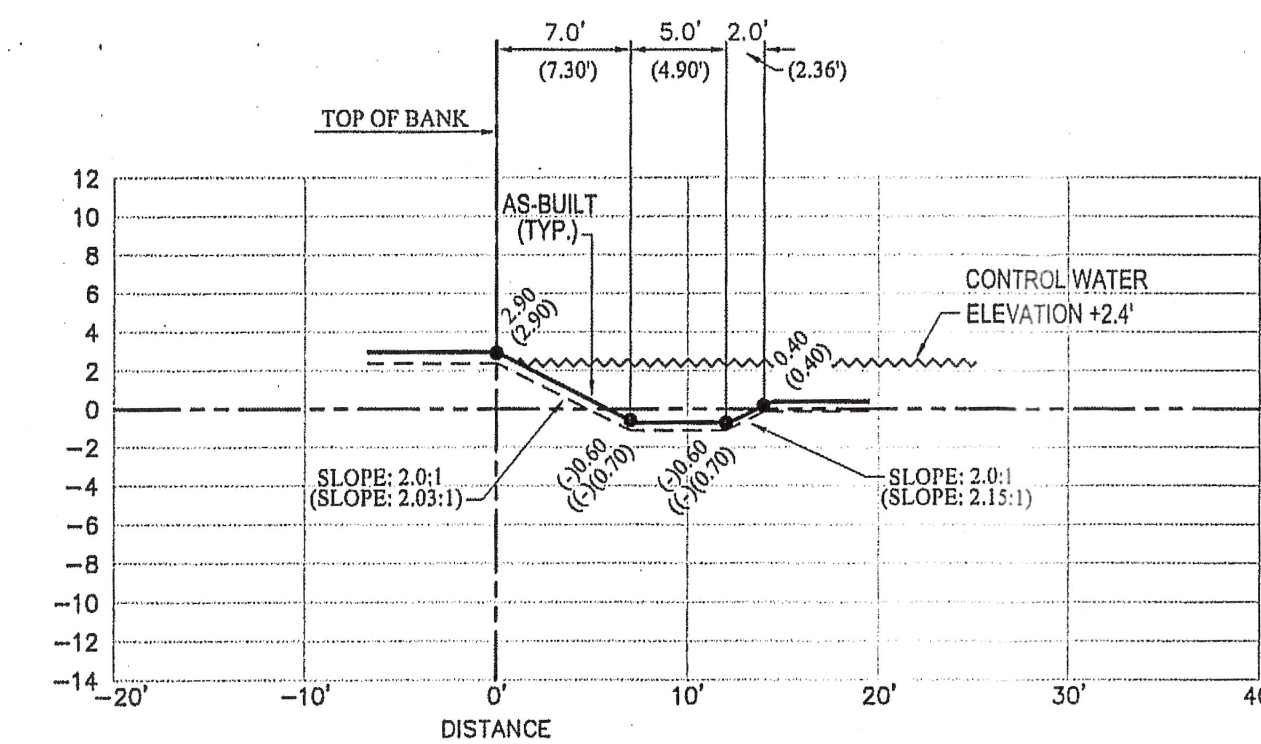

SECTION No. 97
HYDRIC ISLAND

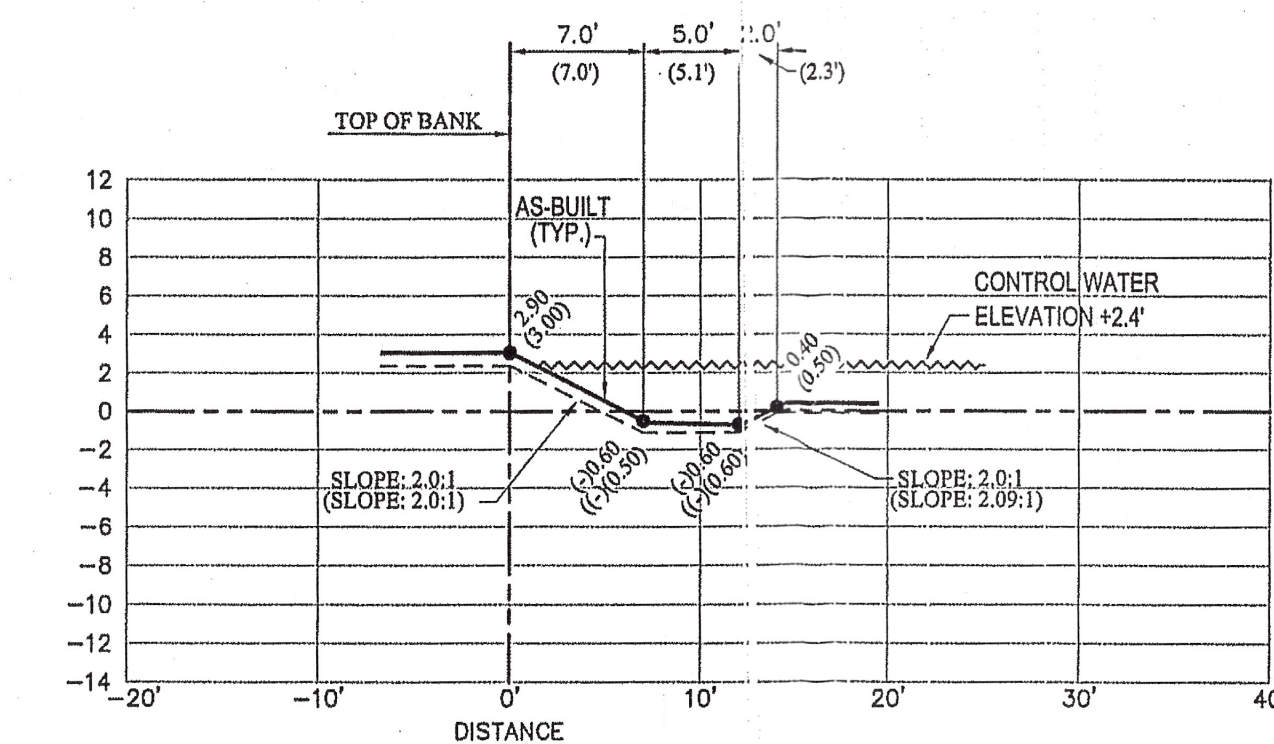


SECTION No. 98
HYDRIC ISLAND

AS-BUILT LEGEND:

- (15.2) DENOTES AS-BUILT DISTANCE
- 15.0 DENOTES DESIGN DISTANCE
- (5.5) DENOTES AS-BUILT ELEVATION
- 5.5 DENOTES DESIGN ELEVATION
- (SLOPE: 20.2:1) DENOTES AS-BUILT SLOPE
- SLOPE: 20.0:1 DENOTES DESIGN SLOPE
- L.M.E. DENOTES LAKE MAINTENANCE EASEMENT
- DENOTES AS-BUILT LINE
- DENOTES DESIGN LINE

NOTE:
THE AS-BUILT LINWORK SHOWN HEREON IS A GRAPHICAL REPRESENTATION
AND MAY NOT BE DRAWN TO SCALE FOR CLARITY PURPOSES.

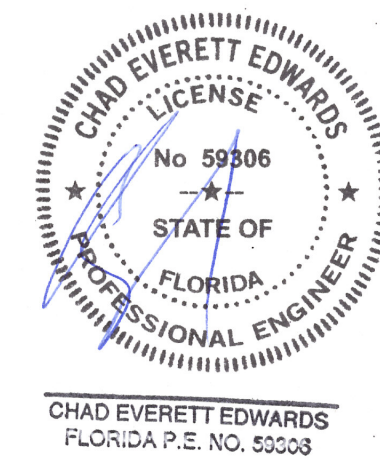


AUG 16 2023

DATE: 7/25/23


BY: JOSEPH L. MARTIN
PROFESSIONAL SURVEYOR &
MAPPER No 4368
STATE OF FLORIDA

NOT VALID WITHOUT THE SIGNATURE AND THE ORIGINAL RAISED SEAL OF A FLORIDA LICENSED SURVEYOR AND MAPPER.

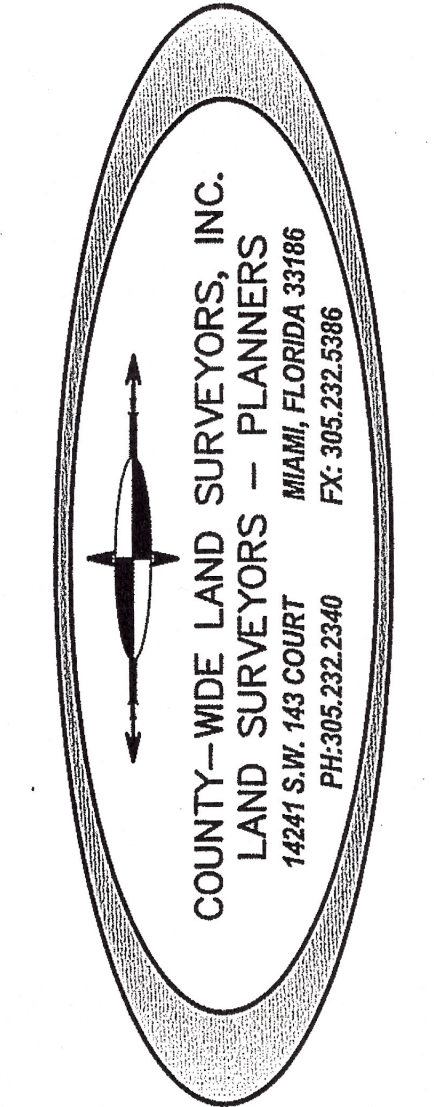


PROJ. TYPE	AS-BUILT CROSS SECTIONS	DATE	REVISION COMMENTS	BY	APP
1950 SOUTH HIATUS ROAD	05-18-21	REVISED PER ENGINEER'S COMMENTS	L.A.	J.M.	
SEC. 18, TWP. 50S. RGE. 41E	11-8-21	REVISED TO ADD SECTIONS FROM 16 TO 36	L.A.	J.M.	
	12-8-21	REVISED TO ADD SECTIONS FROM 37 TO 125	L.A.	G.B.	
	12-10-21	REVISED PER ENGINEER'S COMMENTS	L.A.	G.B.	


SCALE:	H:1"=10' / V:1"=10'
SURVEYOR:	COUNTY-WIDE
DRAWN BY:	LESLEY
CHECKED BY:	G.B.
AS-BUILT:	PRESERVE AREA
DATE:	04/14/2021
DRE PROJECT No:	2019-043
SHEET No:	

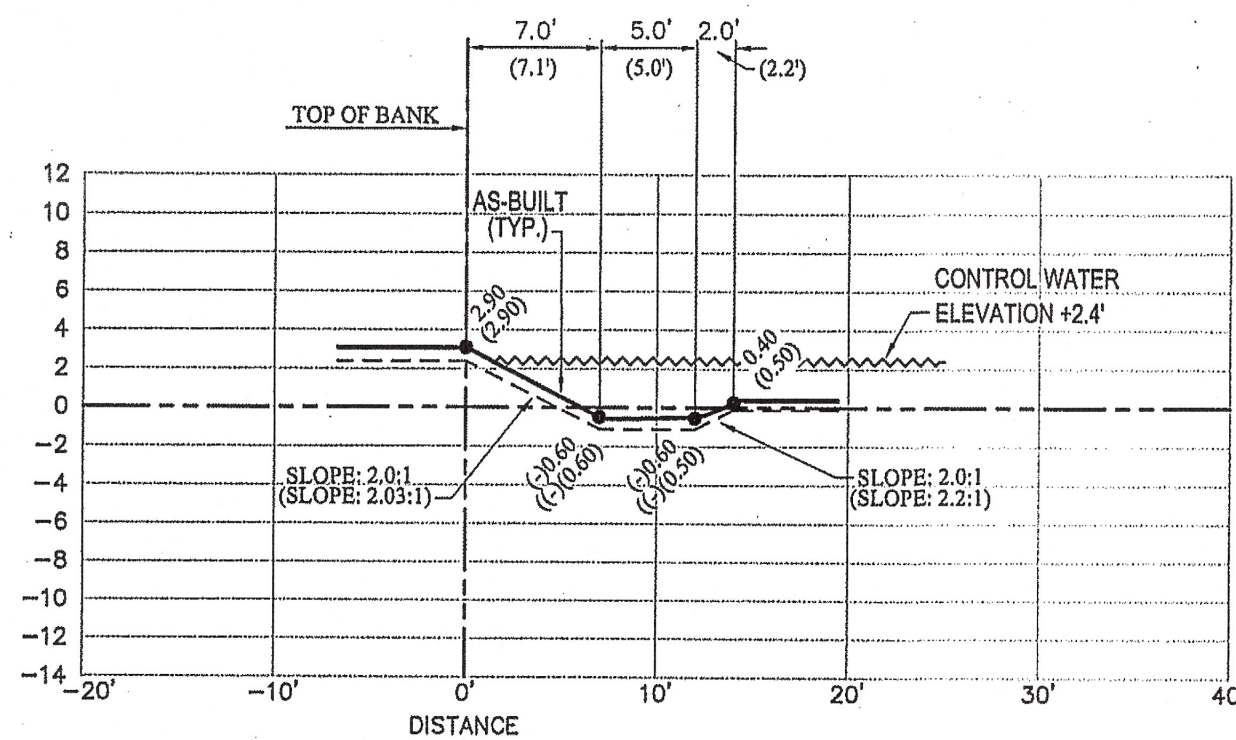


SECTION No. 99
HYDRIC ISLAND

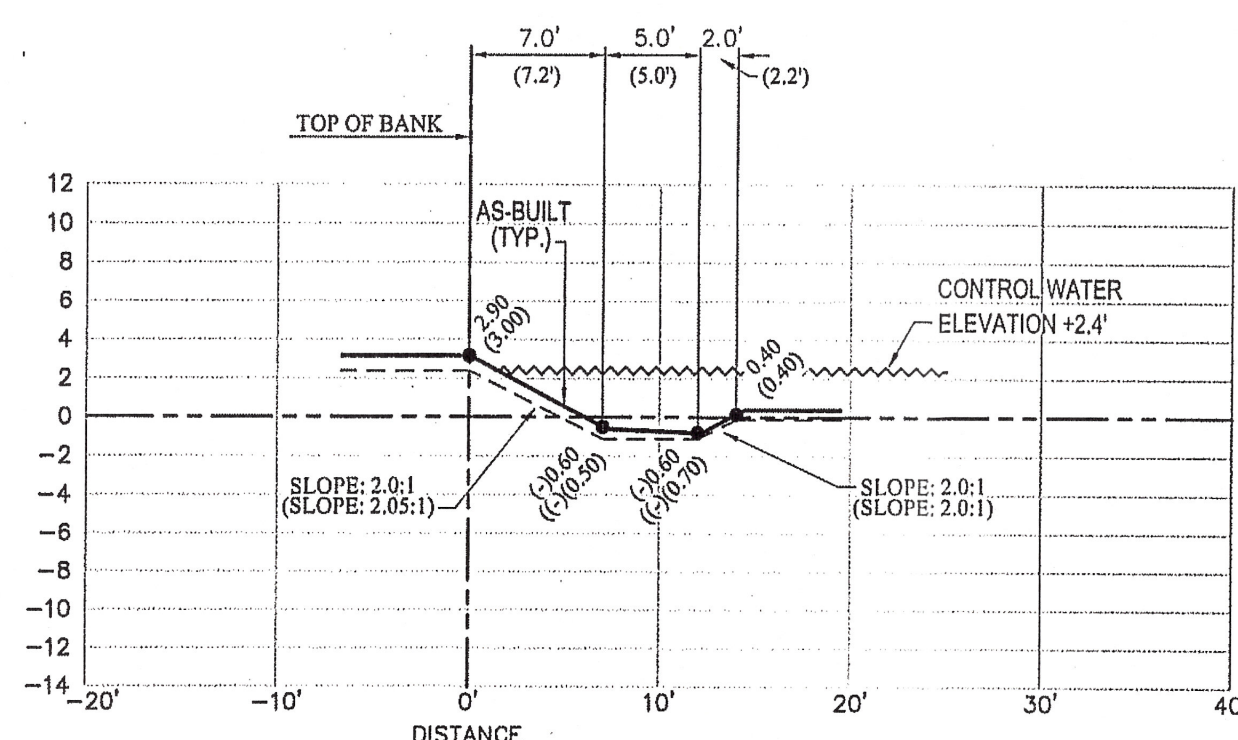


SECTION No. 100
HYDRIC ISLAND

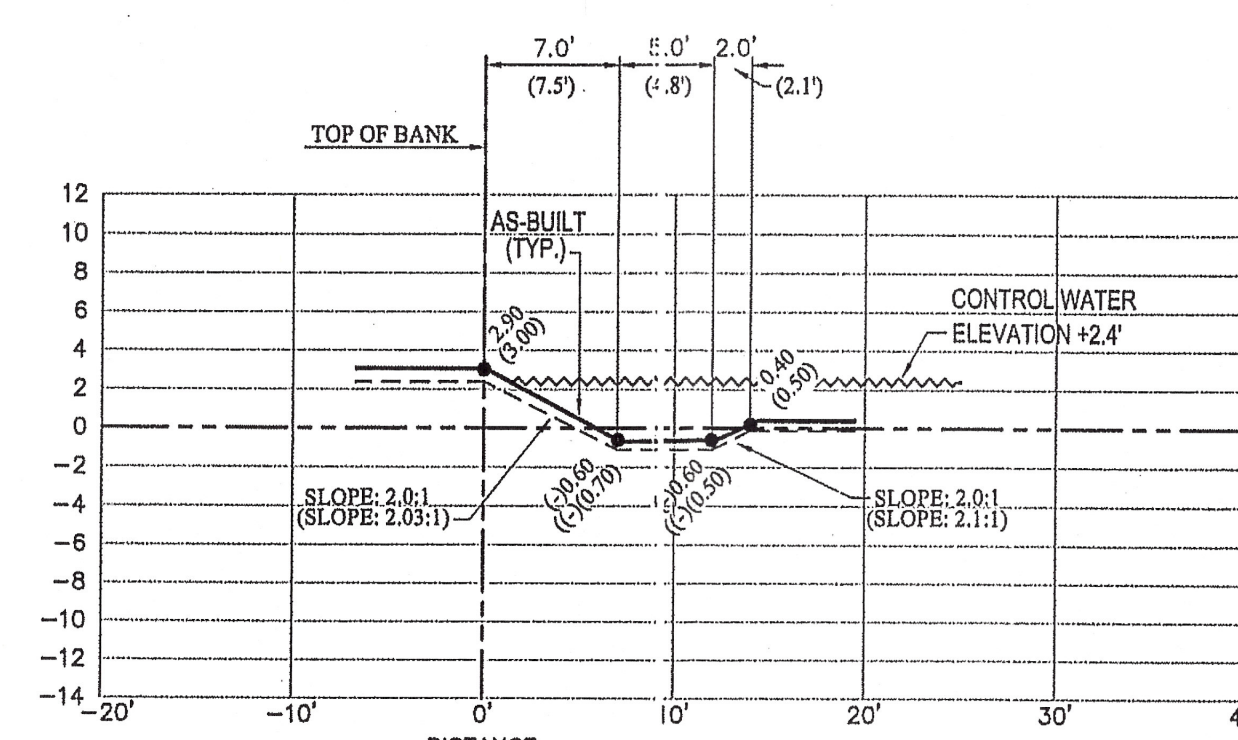


SECTION No. 101
HYDRIC ISLAND

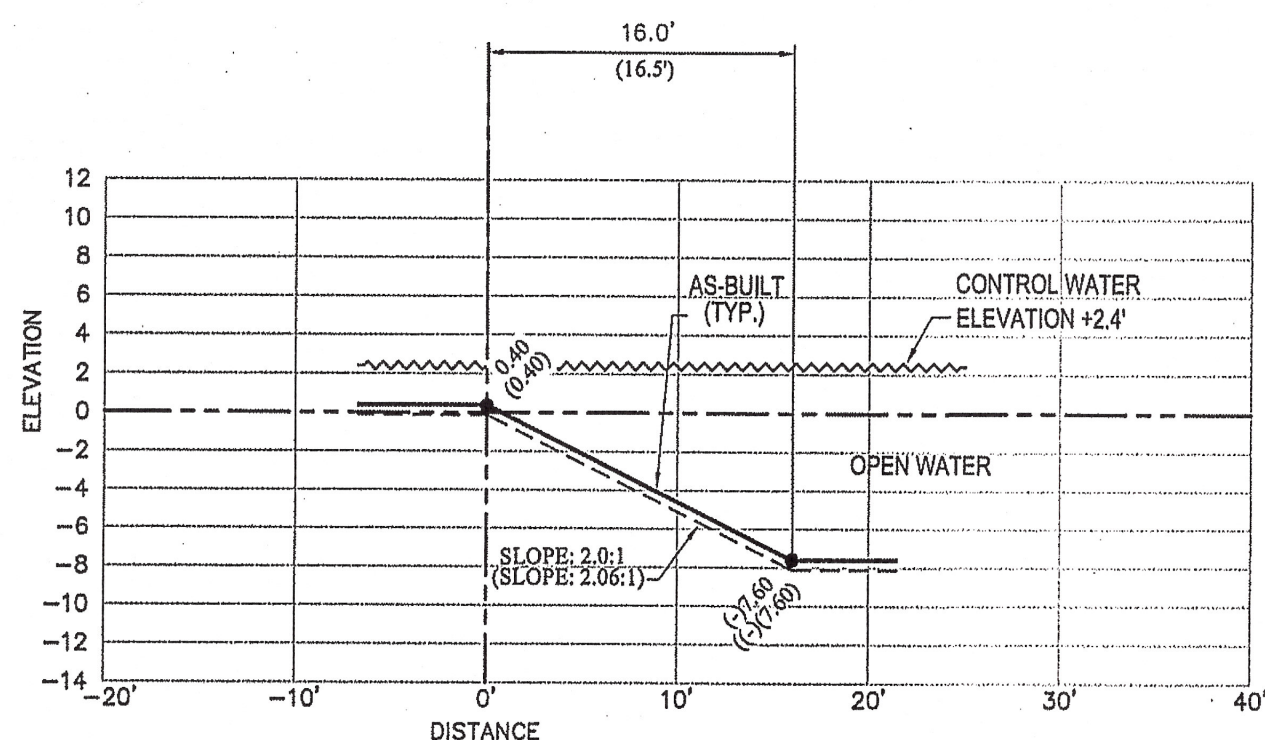


SECTION No. 102
OPEN WATER

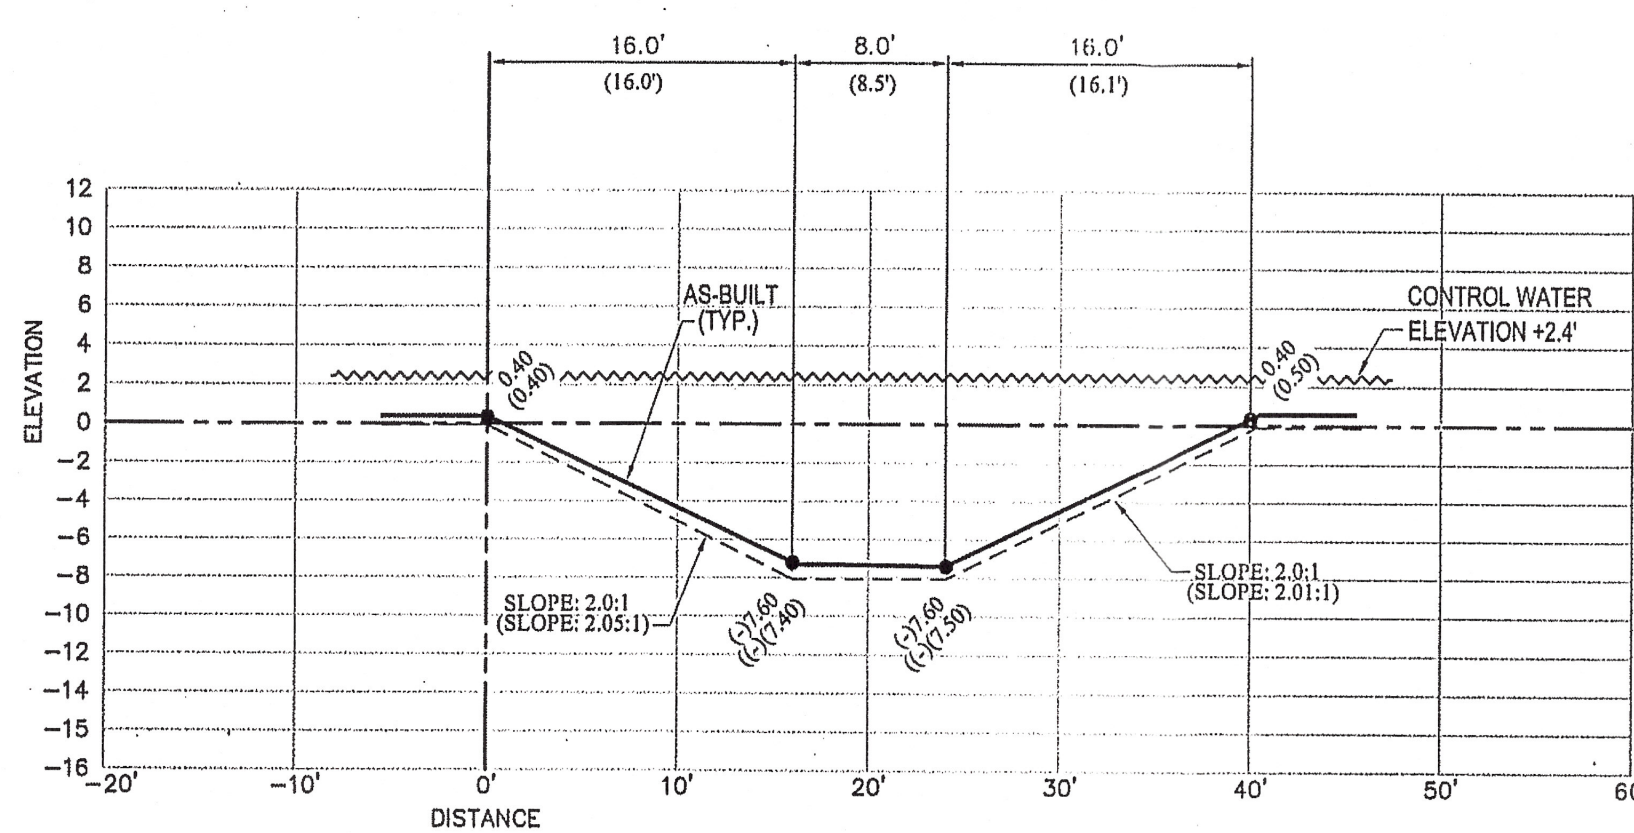


SECTION No. 103
40' CHANNEL

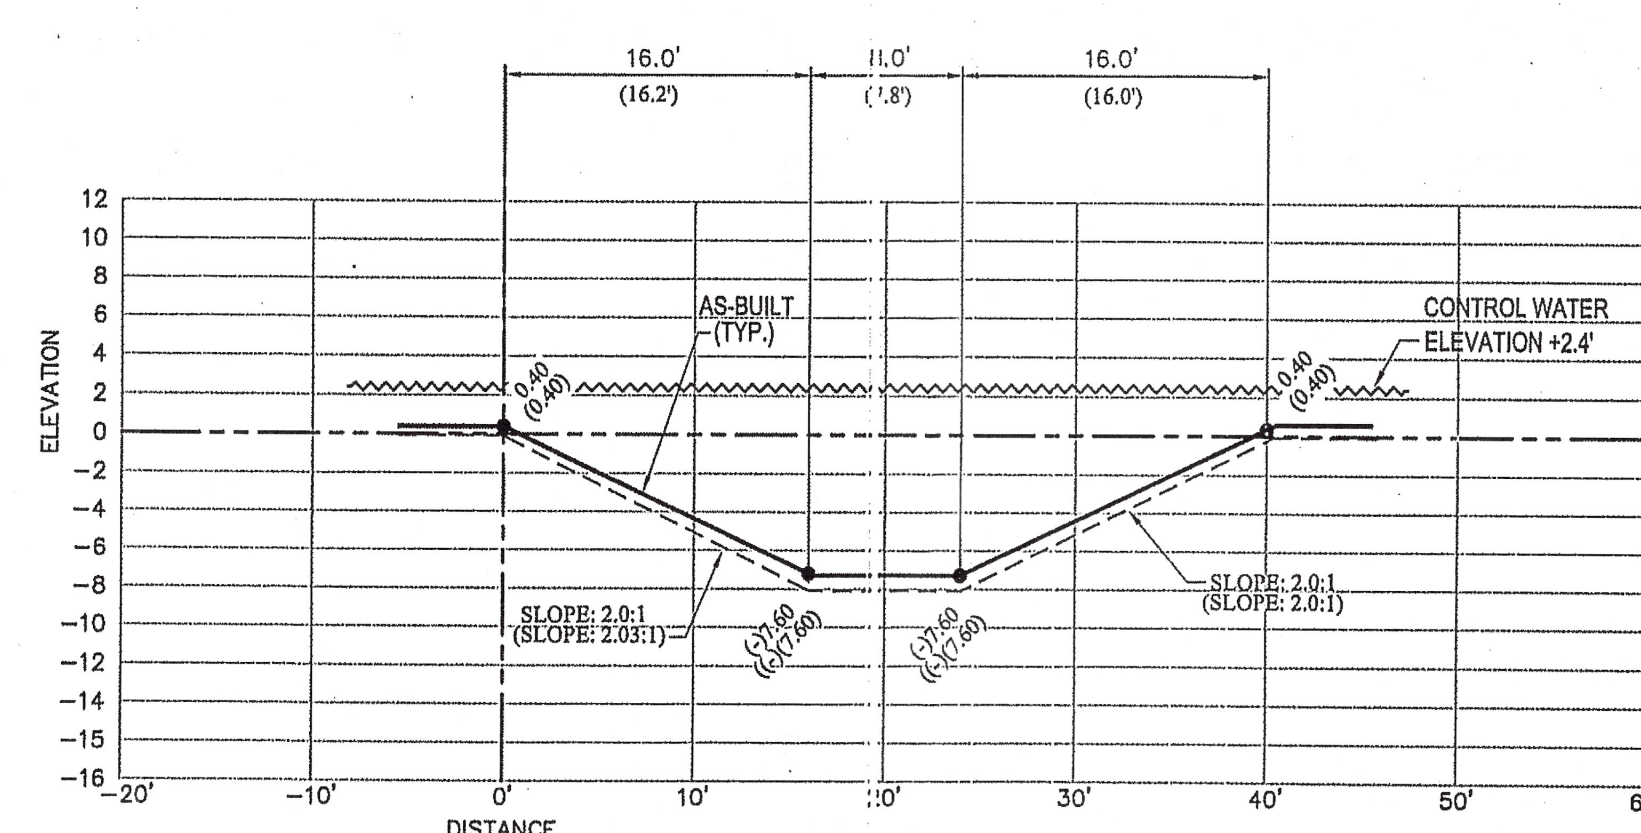


SECTION No. 104
40' CHANNEL

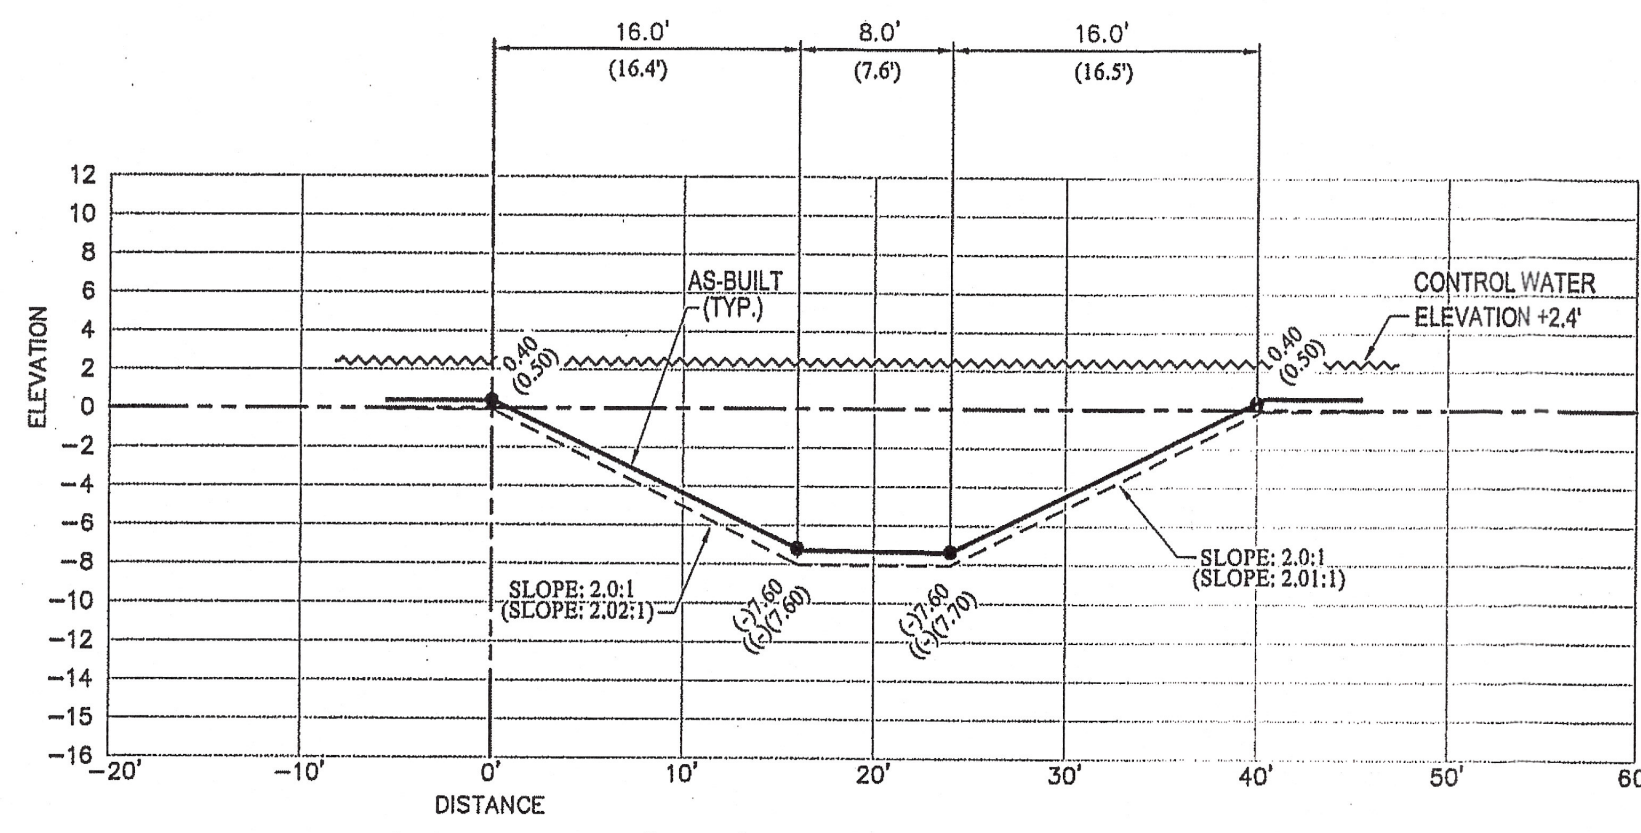

SECTION No. 105
40' CHANNEL

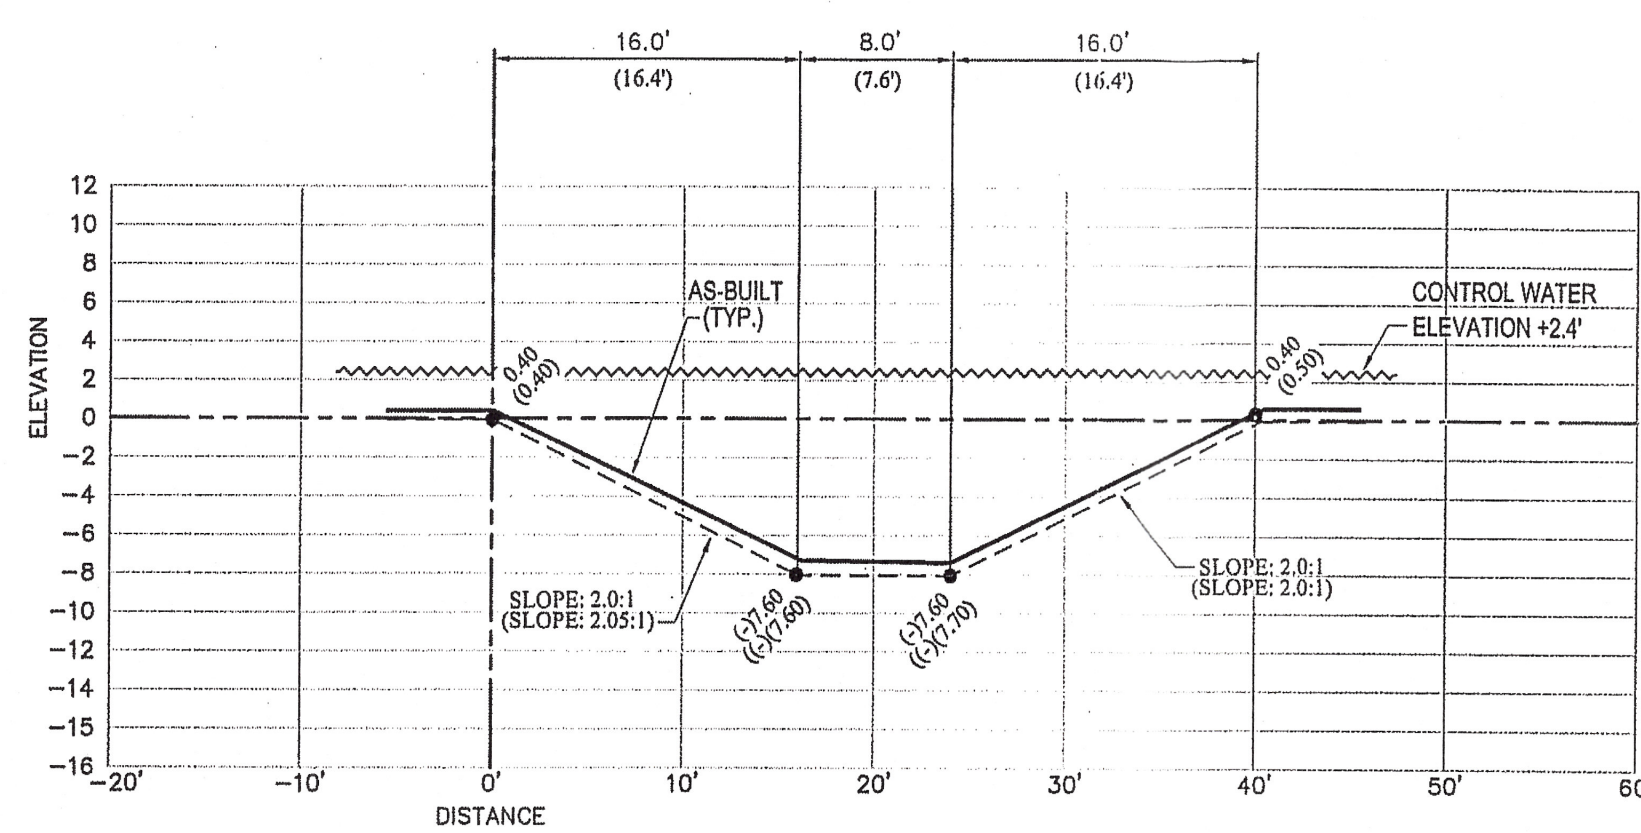

SECTION No. 106
40' CHANNEL

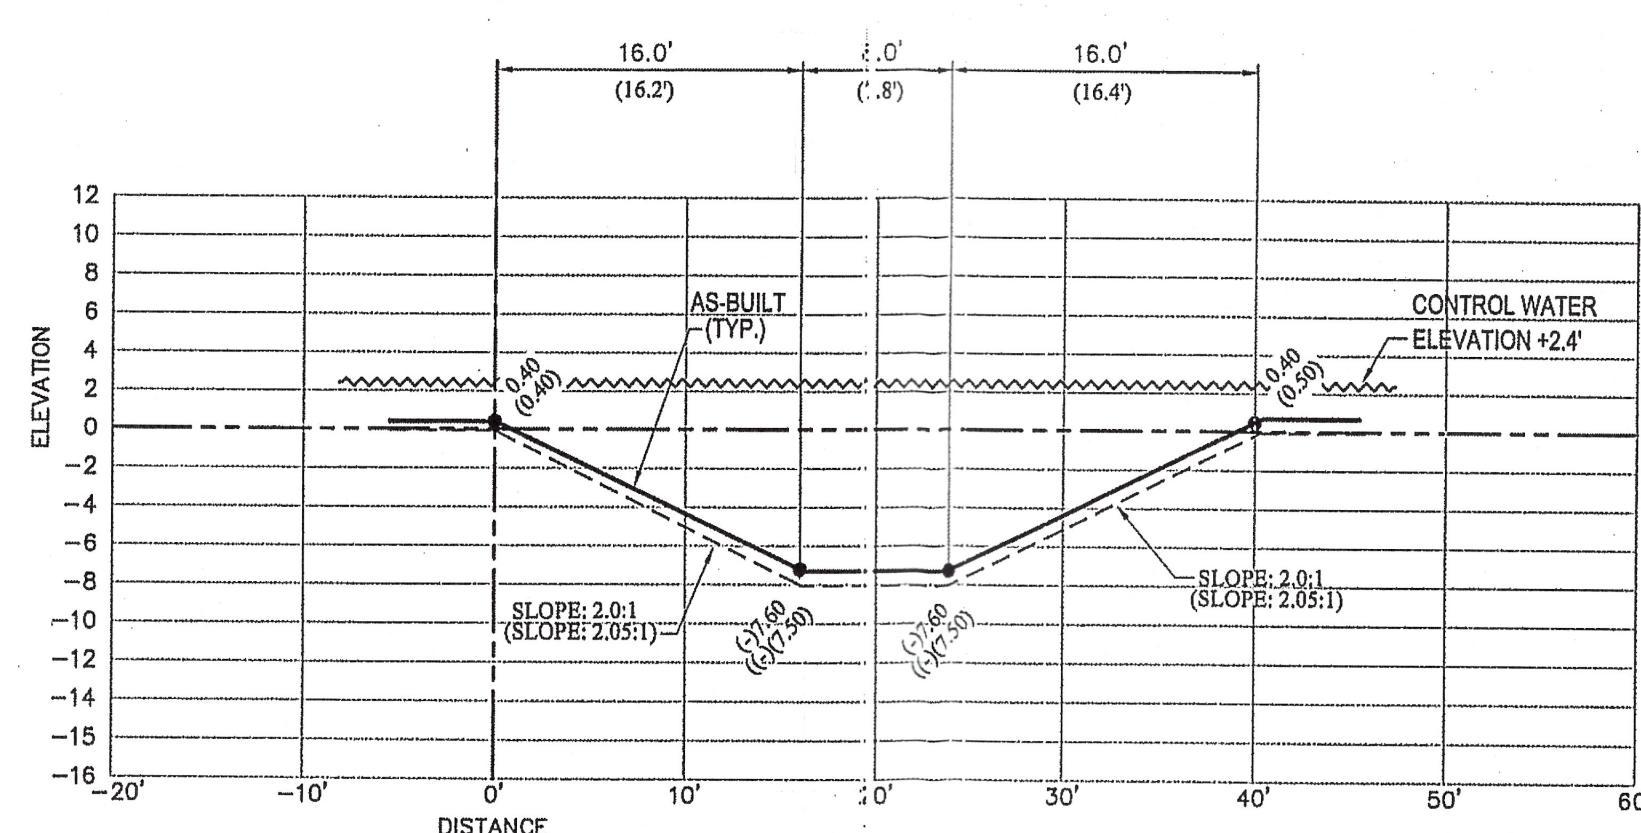


SECTION No. 107
40' CHANNEL

AS-BUILT LEGEND:

- (15.2) DENOTES AS-BUILT DISTANCE
- 15.0' DENOTES DESIGN DISTANCE
- (5.5) DENOTES AS-BUILT ELEVATION
- 5.5 DENOTES DESIGN ELEVATION
- (SLOPE: 20.2:1) DENOTES AS-BUILT SLOPE
- SLOPE: 20.0:1 DENOTES DESIGN SLOPE
- L.M.E. DENOTES LAKE MAINTENANCE EASEMENT
- DENOTES AS-BUILT LINE
- DENOTES DESIGN LINE

NOTE:
THE AS-BUILT LINEWORK SHOWN HEREON IS A GRAPHICAL REPRESENTATION
AND MAY NOT BE DRAWN TO SCALE FOR CLARITY PURPOSES.

DATE: 7/25/23 BY: JOSEPH L. MARTIN
PROFESSIONAL SURVEYOR &
MAPPER No. 4568
STATE OF FLORIDA

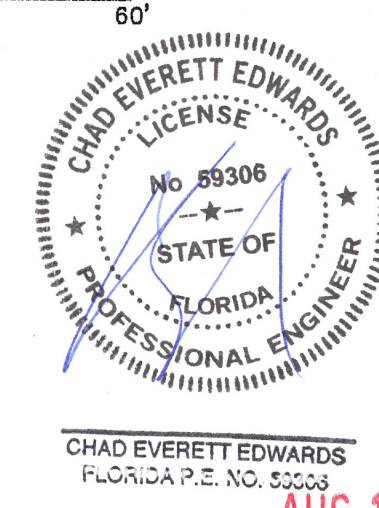

SIERRA RANCH
DAVIE, FL.

REVISION COMMENTS	DATE	BY	APP
REVISED PER ENGINEER'S COMMENTS	05-18-21	L.A.	J.M.
REVISED TO ADD SECTIONS FROM 16 TO 36	11-8-21	L.A.	J.M.
REVISED TO ADD SECTIONS FROM 37 TO 125	12-8-21	L.A.	J.M.
REVISED PER ENGINEER'S COMMENTS	12-10-21	L.A.	G.B.

SCALE:	H:1"=10' / V:1"=10'
SURVEYOR:	COUNTY-WIDE
DRAWN BY:	LESLEY
CHECKED BY:	G.B.
AS-BUILT:	PRESERVE AREA
DATE:	04/14/2021
DRE PROJECT No:	2019-043
SHEET No:	16 of 18

