



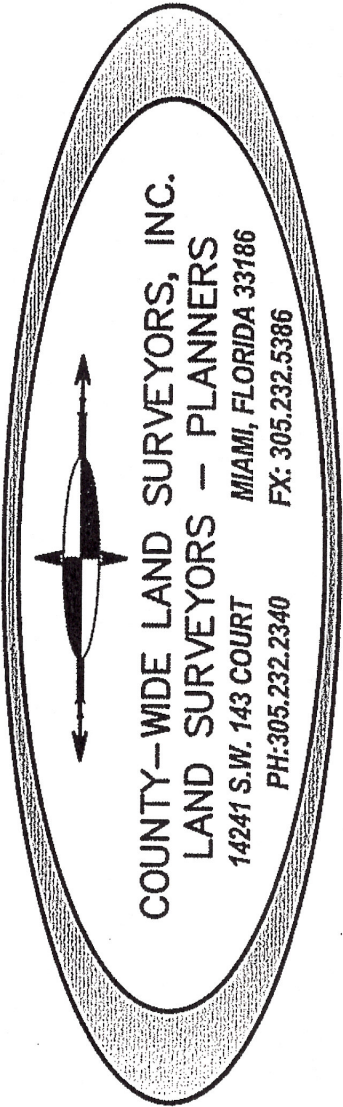


SIERRA RANCH
DAVIE, FL.


PROJ. TYPE	AS-BUILT CROSS SECTIONS	DATE	REVISION COMMENTS	BY	APP
PROJ. LOC.	1950 SOUTH HIATUS ROAD	05-18-21	REVISED PER ENGINEER'S COMMENTS	L.A.	J.M.
SECTION	SEC. 18, TWP. 50S, RGE. 41E	11-8-21	REVISED TO ADD SECTIONS FROM 16 TO 36	L.A.	J.M.
		12-8-21	REVISED TO ADD SECTIONS FROM 37 TO 125	L.A.	G.B.
		12-10-21	REVISED PER ENGINEER'S COMMENTS	L.A.	G.B.

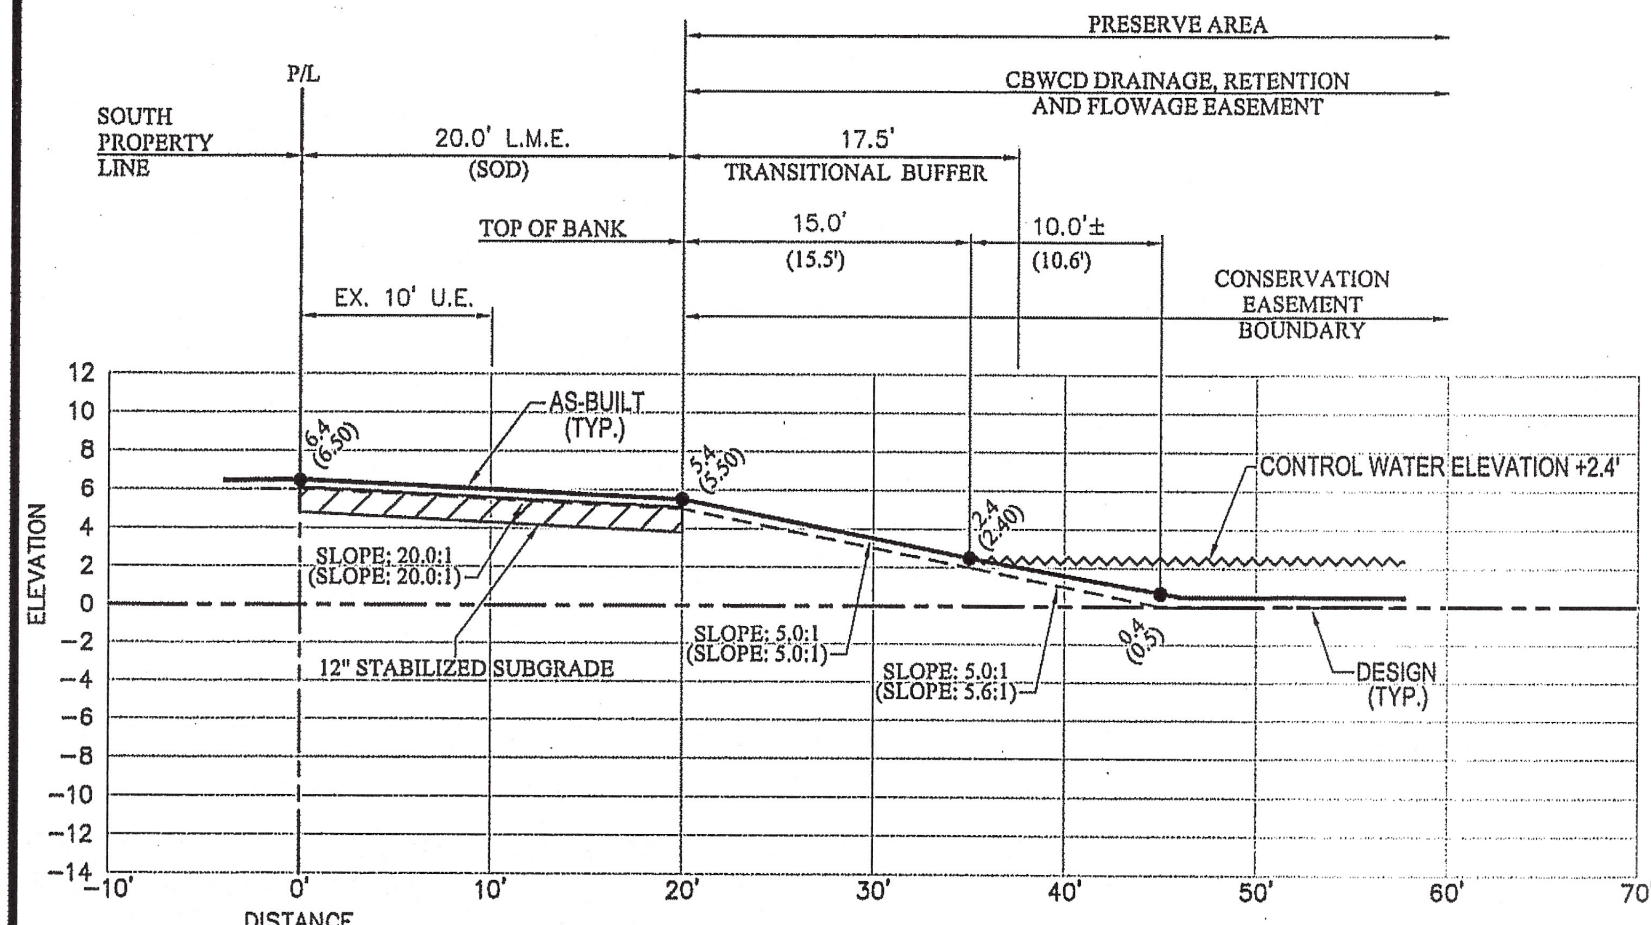


SECTION No. 1
SOUTH PROPERTY LINE

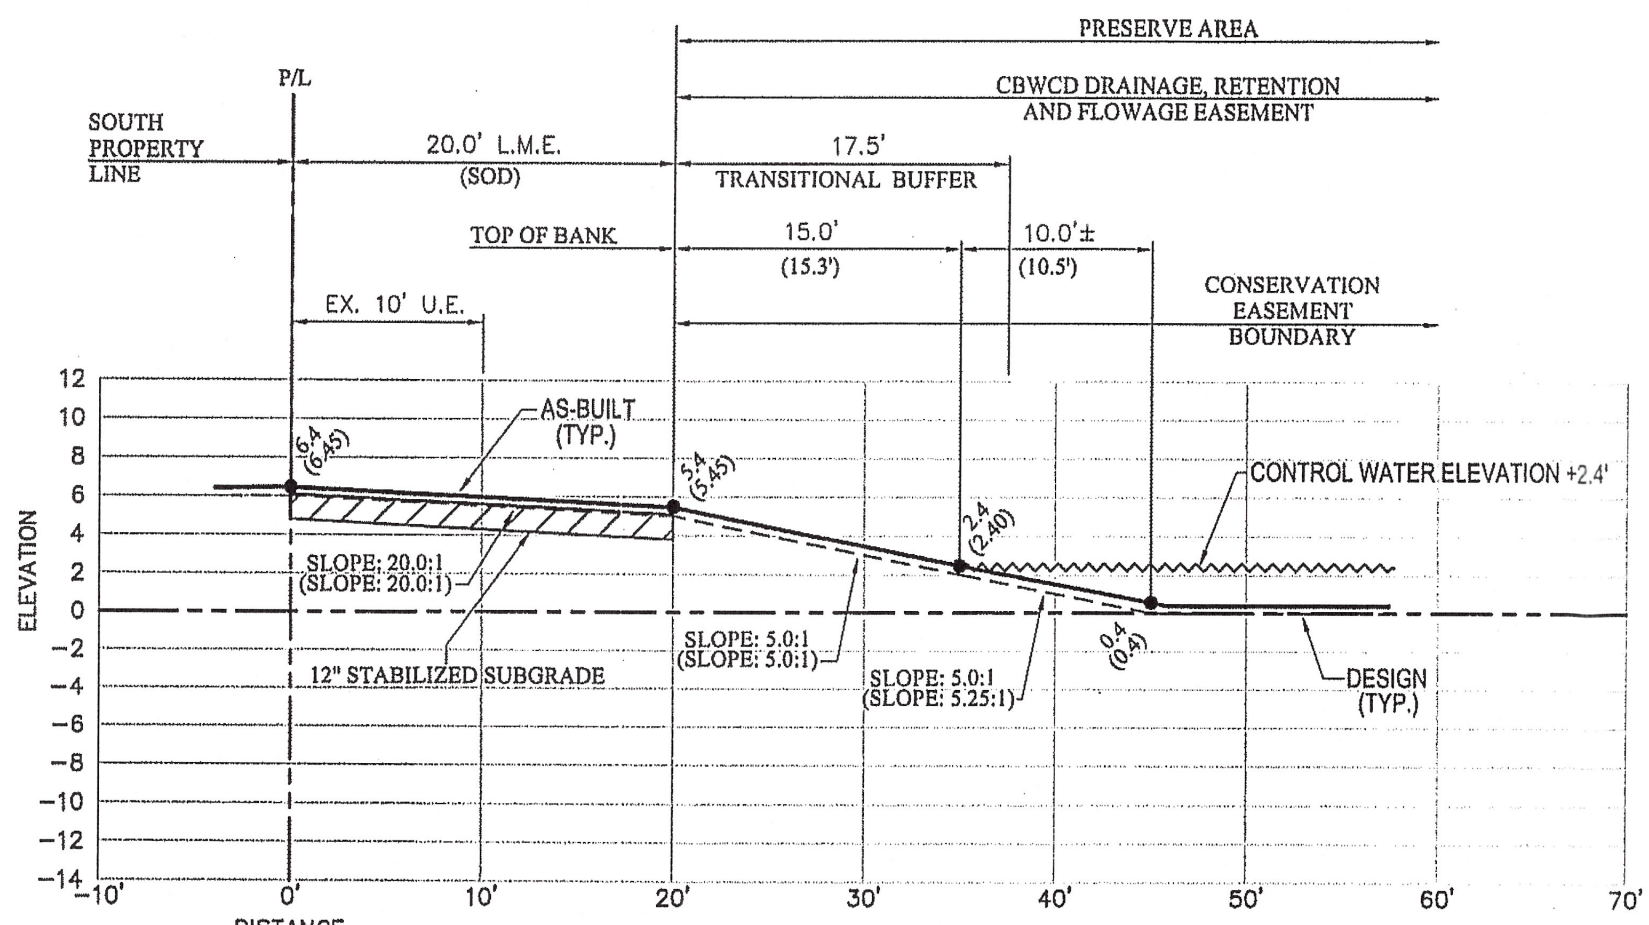


SECTION No. 2
SOUTH PROPERTY LINE

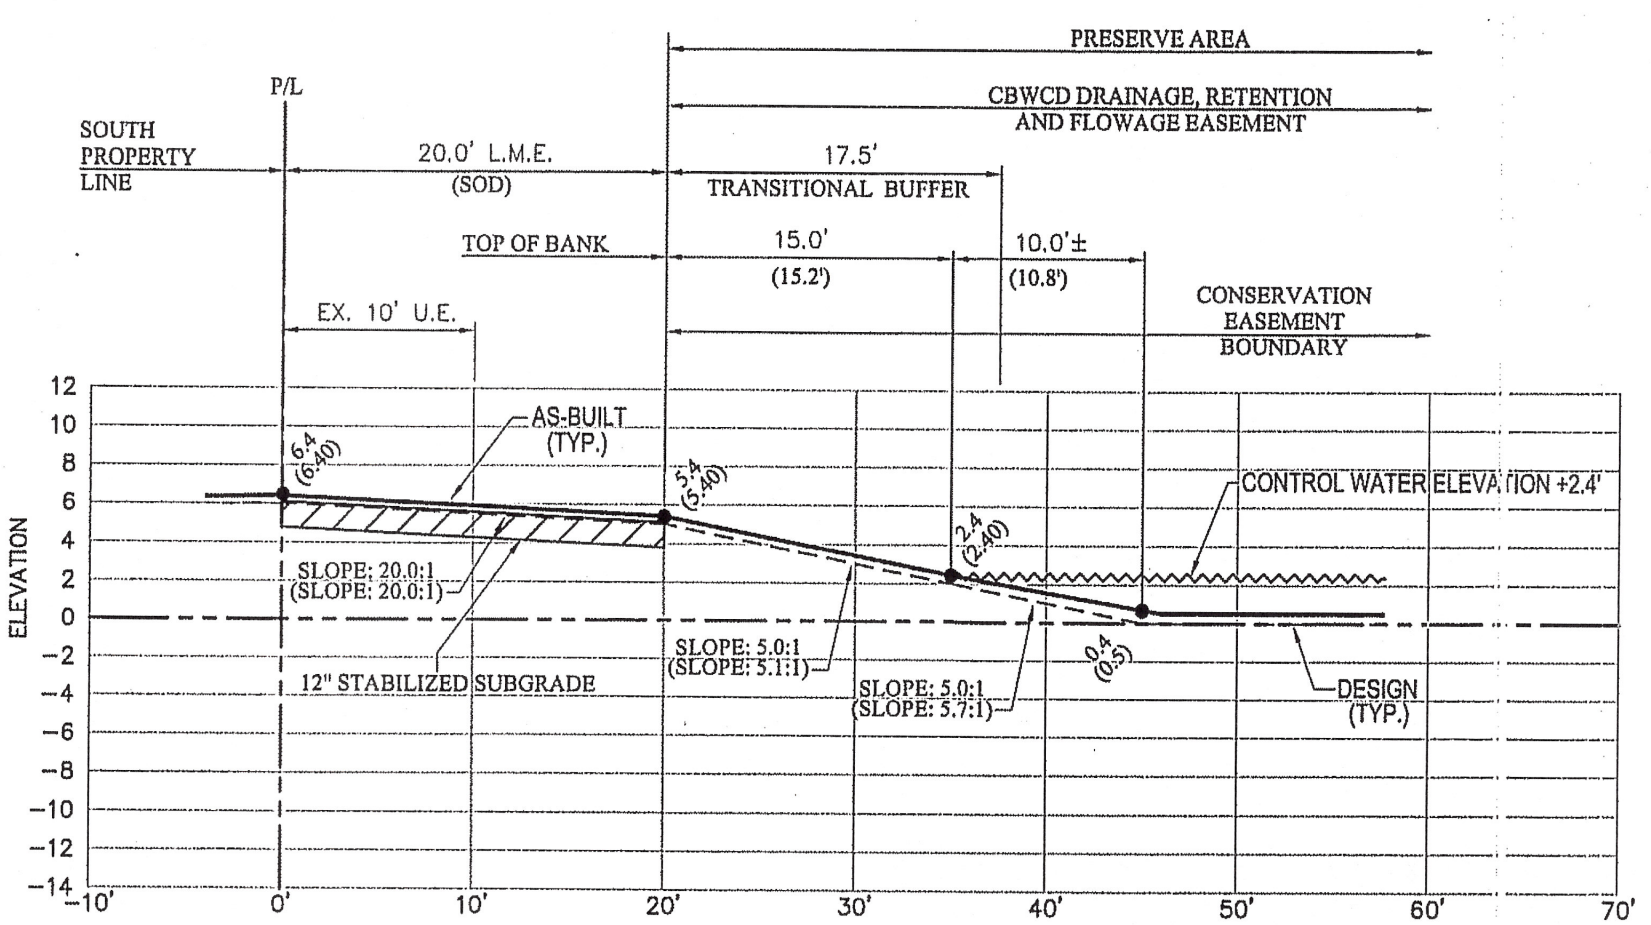


SECTION No. 3
SOUTH PROPERTY LINE

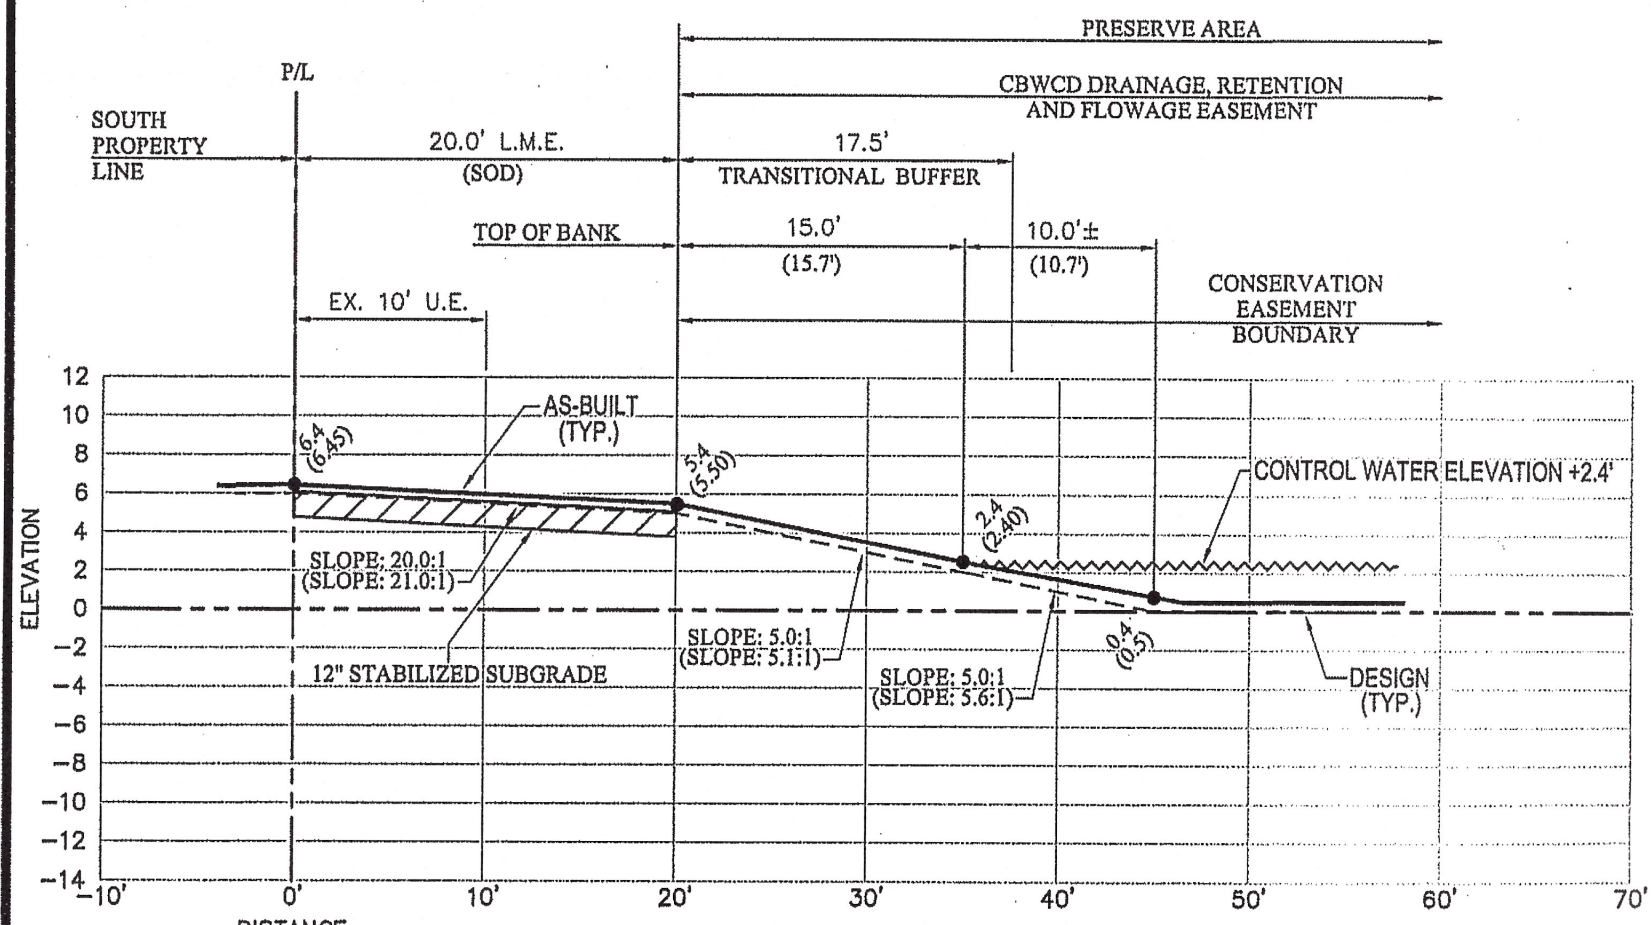


SECTION No. 4
SOUTH PROPERTY LINE

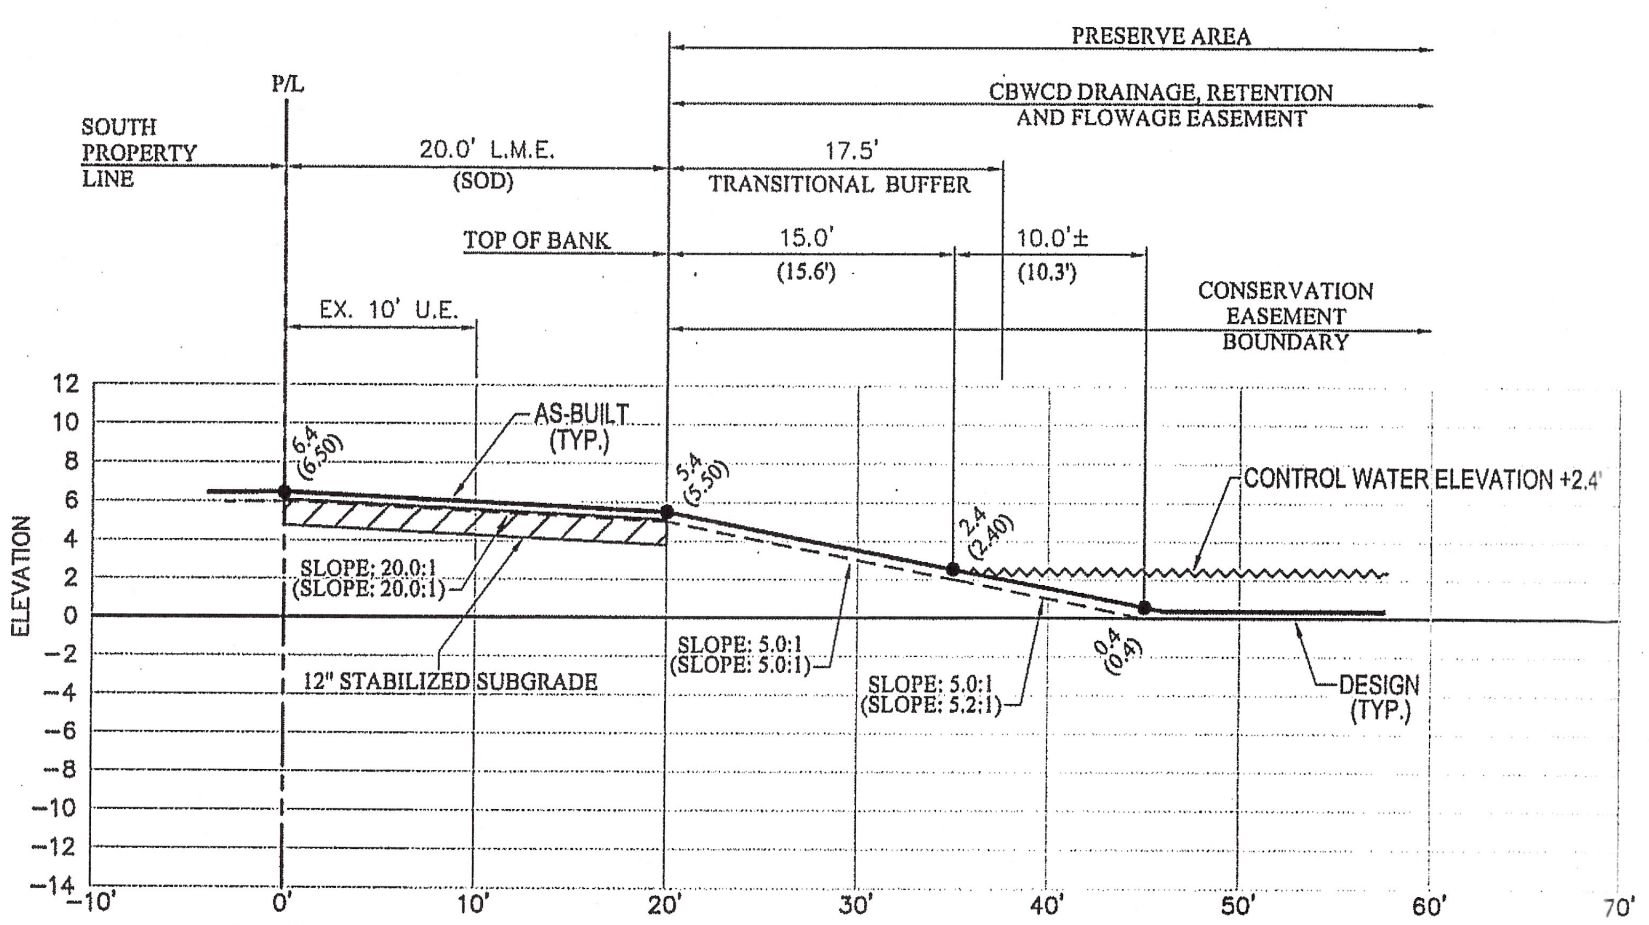


SECTION No. 5
SOUTH PROPERTY LINE

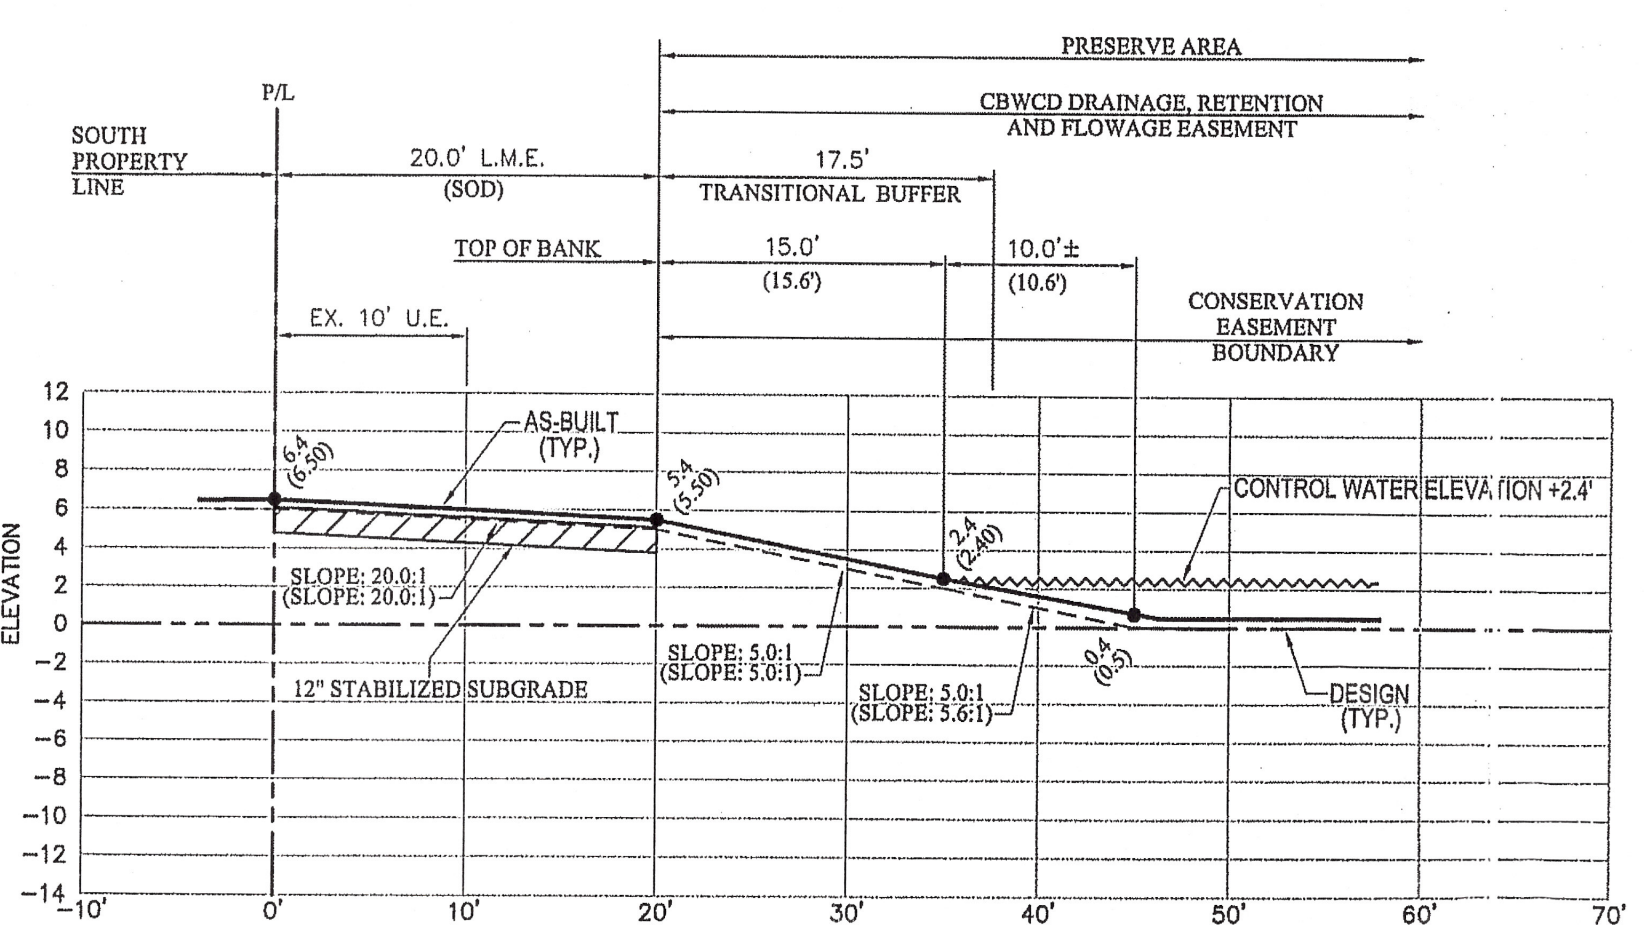


SECTION No. 6
SOUTH PROPERTY LINE

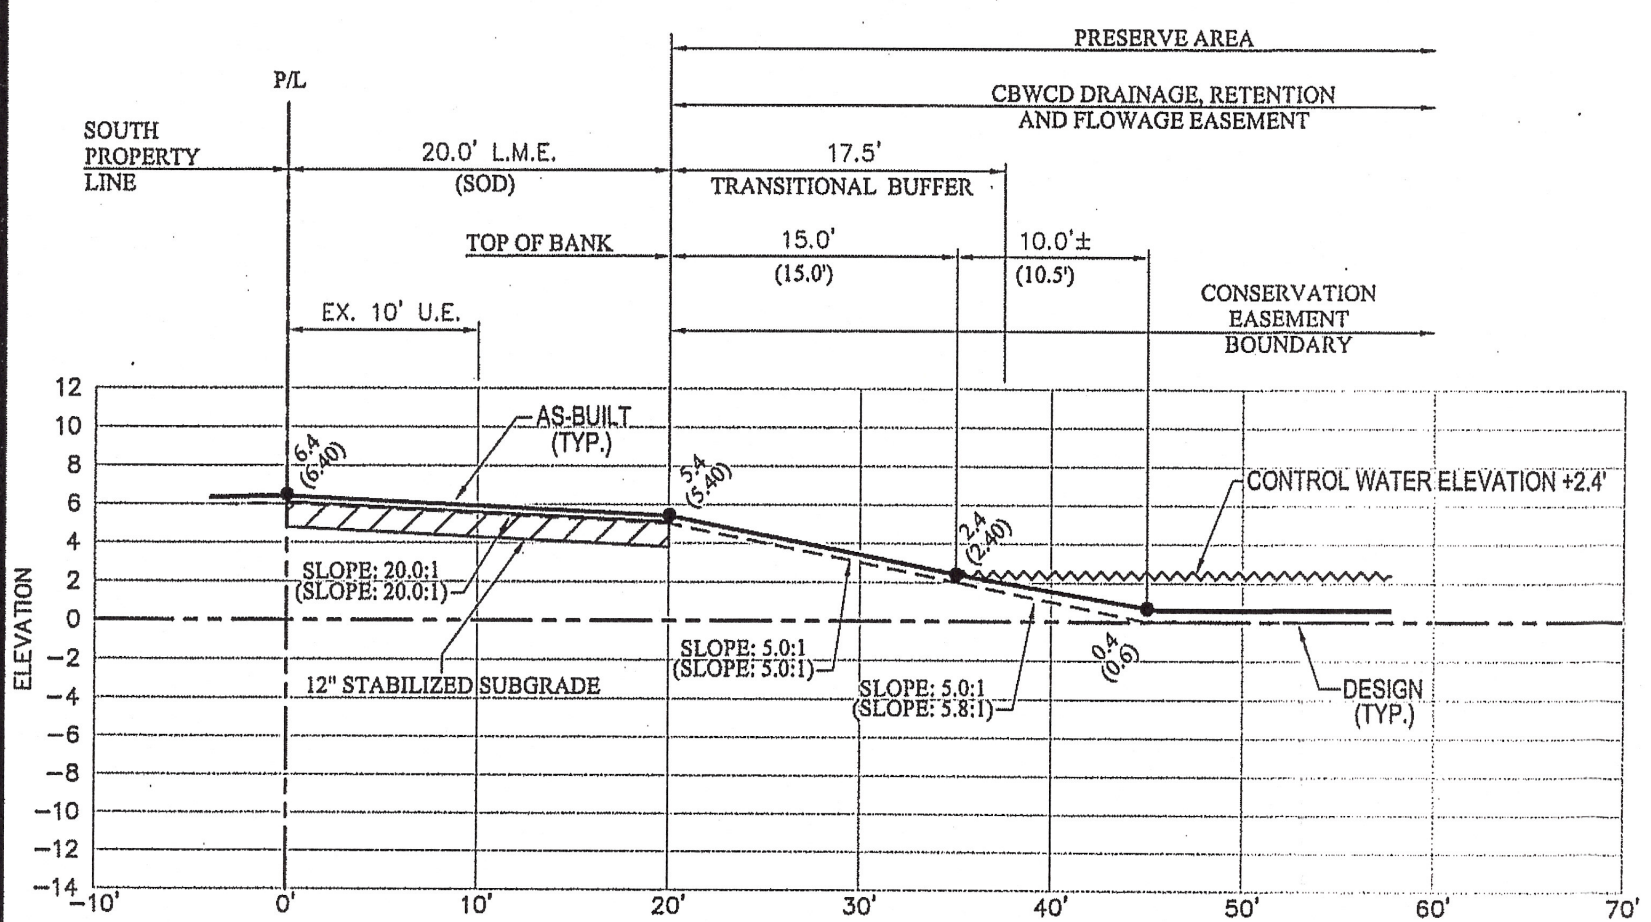

SECTION No. 7
SOUTH PROPERTY LINE

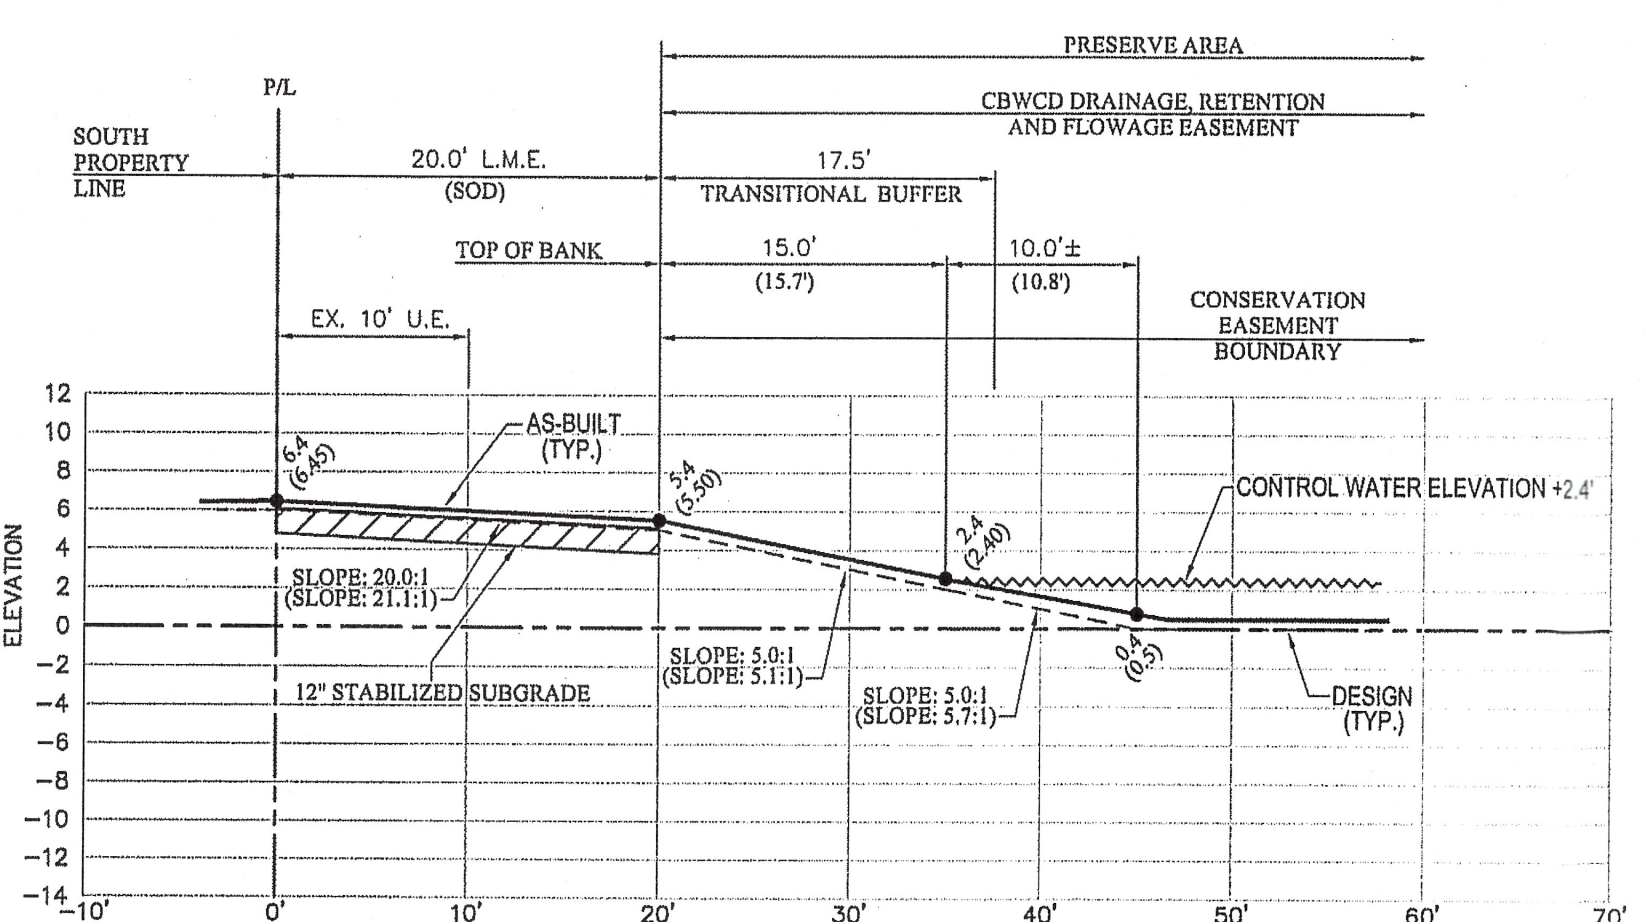

SECTION No. 8
SOUTH PROPERTY LINE

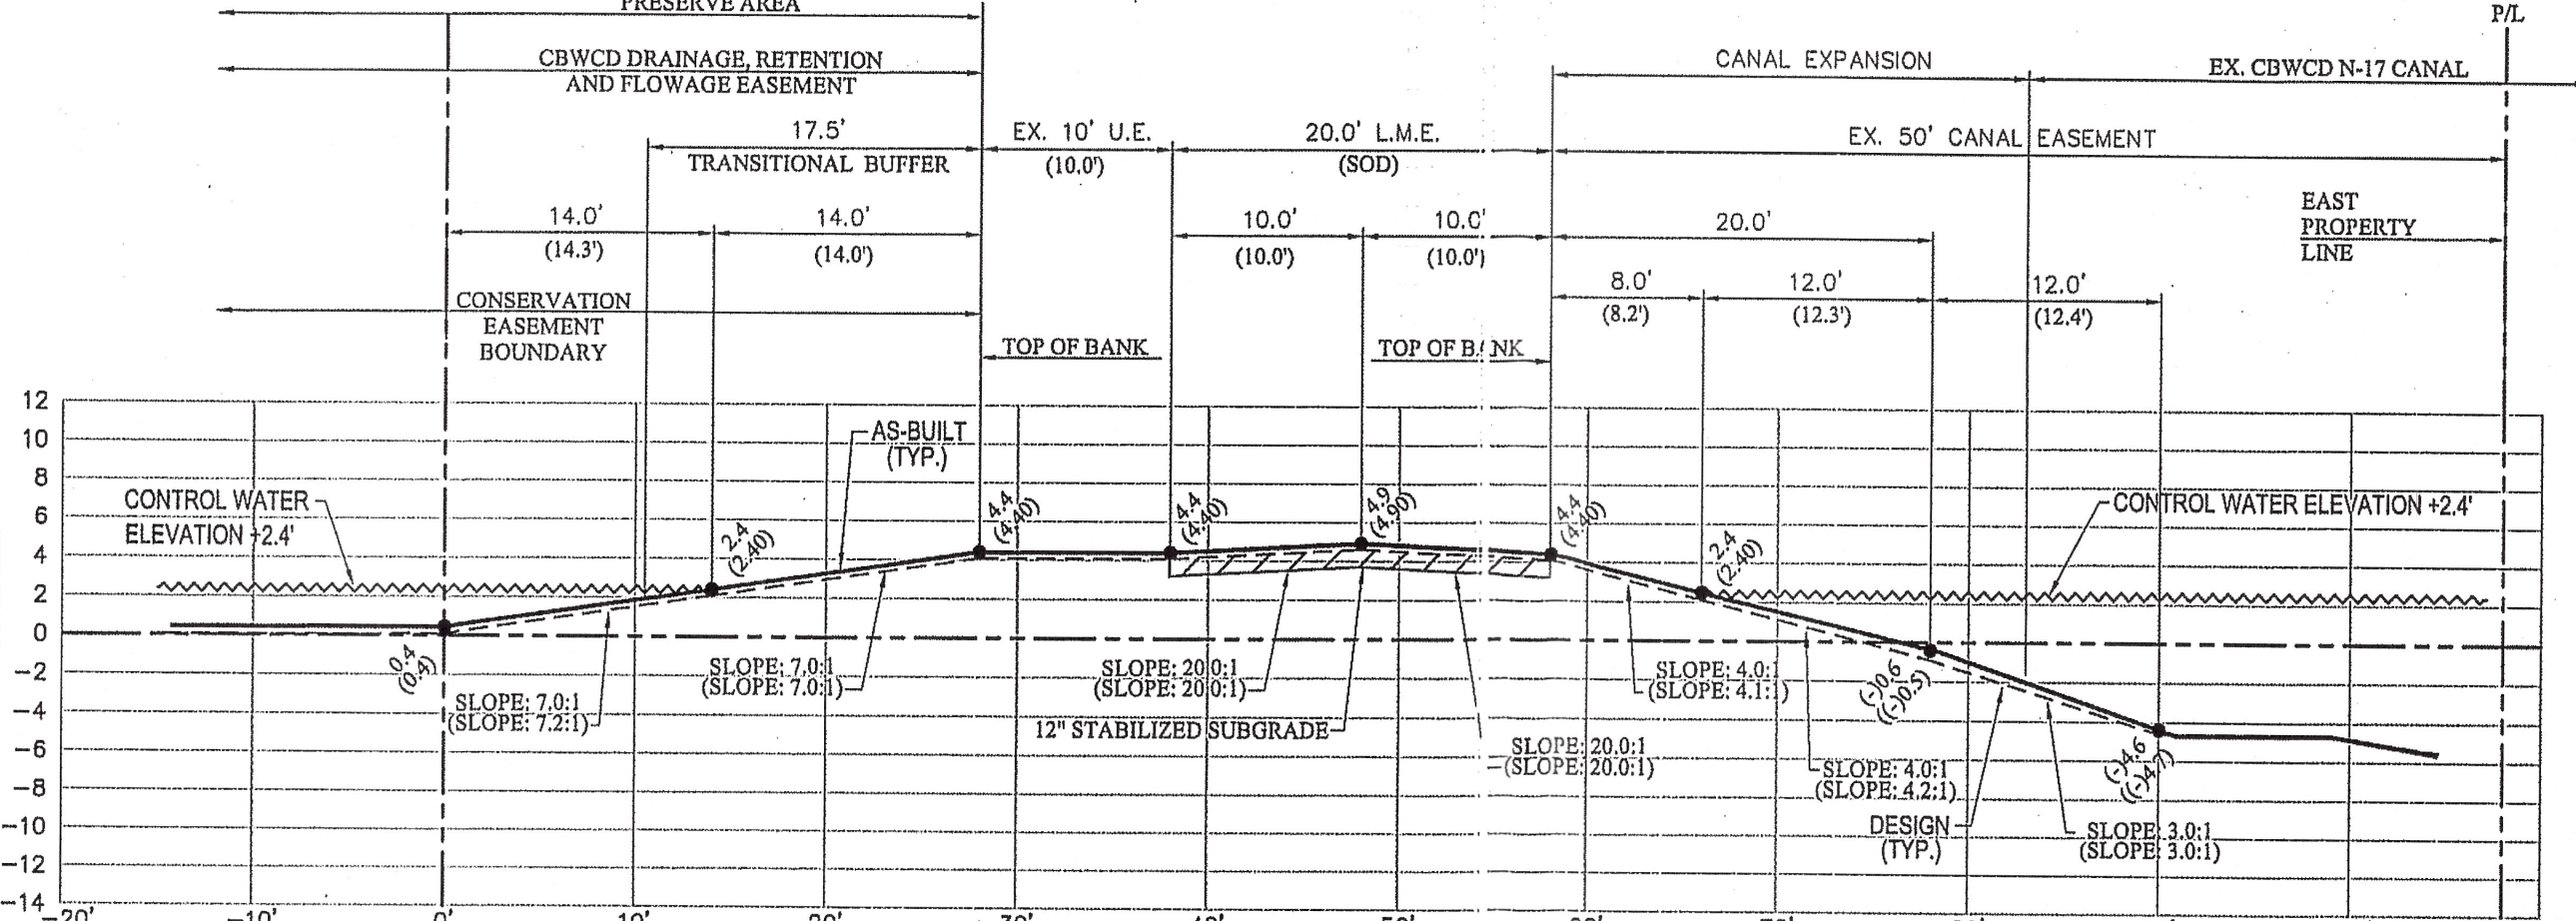


SECTION No. 9
EAST PROPERTY LINE

AS-BUILT LEGEND:

- (15.2) DENOTES AS-BUILT DISTANCE
- 15.0' DENOTES DESIGN DISTANCE
- 6.5 DENOTES AS-BUILT ELEVATION
- 6.5 DENOTES DESIGN ELEVATION
- (SLOPE: 20.0:1) DENOTES AS-BUILT SLOPE
- SLOPE: 20.0:1 DENOTES DESIGN SLOPE
- L.M.E. DENOTES LAKE MAINTENANCE EASEMENT
- DENOTES AS-BUILT LINE
- - - DENOTES DESIGN LINE

NOTE:
THE AS-BUILT LINEWORK SHOWN HEREON IS A GRAPHICAL REPRESENTATION AND MAY NOT BE DRAWN TO SCALE FOR CLARITY PURPOSES.

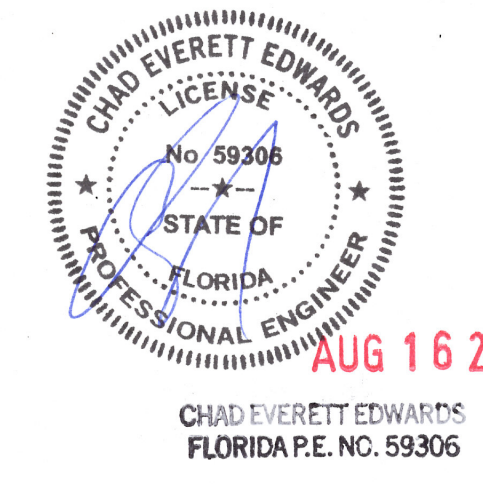

DATE: 7/25/23

BY: JOSEPH L. MARTIN
PROFESSIONAL SURVEYOR &
MAPPER No 4368
STATE OF FLORIDA

NOT VALID WITHOUT THE SIGNATURE AND THE ORIGINAL RAISED SEAL OF A FLORIDA LICENSED SURVEYOR AND MAPPER.

