


INTERMEDIATE PART PLAN

1/8" = 1'-0"

- 1.) SEE PLAN FOR TOP/UTILITY PLATFORM SLAB ELEVATION
- 2.) SEE S1102 FOR METAL FLOOR DECK FASTENING PATTERN, WHERE REQUIRED.
- 3.) SEE PLAN FOR SLAB THICKNESS AND FLOOR DECK SIZE.
REINFORCE ALL NEW PLATFORM SLABS WITH 6x6 w2.9 x w2.9 WWM.
- 4.) ARCHITECTURAL BACKGROUND IS SHOWN FOR REFERENCE ONLY.
REFER TO ARCHITECTURAL DRAWINGS FOR EXACT LOCATIONS OF WALLS.
- 5.) REFER TO ARCHITECTURAL DRAWINGS FOR ELEVATION OF ALL LINTELS.
- 6.) CONTRACTOR SHALL PROVIDE TEMPORARY SHORING AS REQUIRED FOR NEW COMPOSITE DECK SPANS GREATER THAN 10'-6"
- 7.) LOCATE ALL WALLS AND MASONRY OPENINGS PER ARCHITECTURAL DRAWINGS.
WHERE REQUIRED, SEE S1102 FOR ALL NEW CMU LINTELS.
- 8.) NO FABRICATION OR ERECTION SHALL COMMENCE PRIOR TO THE APPROVAL OF ALL STRUCTURAL STEEL SHOP DRAWINGS BY THE ENGINEER OF RECORD.
- 9.) COORDINATE AND VERIFY ALL DECK EDGE LOCATIONS AND DIMENSIONS WITH ARCHITECTURAL DRAWINGS.
- 10.) REFERENCE ARCHITECTURAL AND PLUMBING DRAWINGS FOR COORDINATION OF SLOPED FLOORS AT FLOOR DRAINS, AND DEPRESSED FLOOR SLAB LOCATIONS.

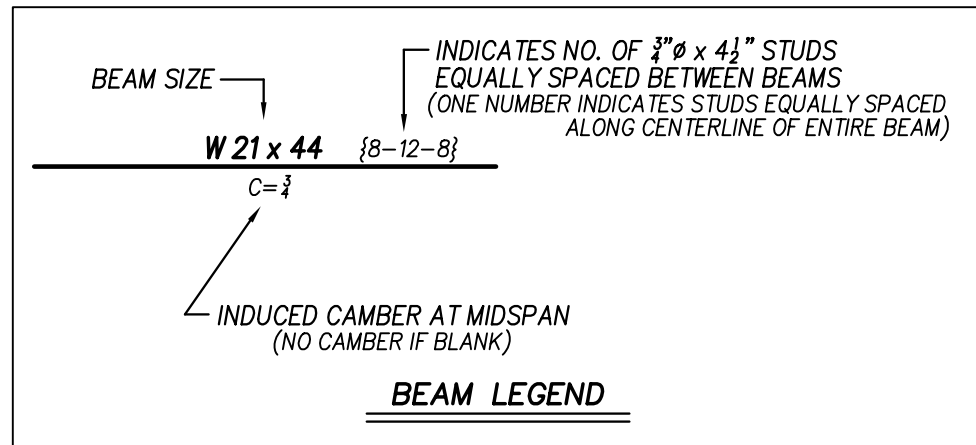

| No. | Date | Revision |
|-----|---------|---------------------------------------|
| 1 | 3/13/25 | REVISED PER DPM 03 OF REVIEW COMMENTS |

Hite associates
ARCHITECTURE / ENGINEERING / TECHNOLOGY
2600 Meridian Drive / Greenville, NC 27838 / tel (252) 757-0333

NC LIC C-10249
QED
QUINN ENGINEERING & DESIGN
REGISTERED PROFESSIONAL ENGINEER
SINCE 1991
BRUCE L. QUINN
ENGINEER
26 FEB 2025

NEW CTE BUILDING FOR
NEW BERTIE HIGH SCHOOL
716 US 13 NORTH / NCDPS UNIT 080 - SCHOOL 312
WINDSOR / BERTIE COUNTY / NORTH CAROLINA

Project No. **22351**
Date: 26 FEB 2025
Drawing no. **S 104**