

NOTES

Design information taken from Reuby & Stagg drawing no. MPR-RAS-AC-01-GA-S-000111 rev C1 "Aspen Court First Floor Plan".

MSL survey information shown in colour.

Grid origin and orientation are related to OS taken from ECE WESTWORKS drawing number MPR-ECE-AC-XX-GA-A-001050 Rev. C02 Aspen Court - Grid Setting Out Plan "

MSL survey information has been related to design by best fit graphical methods. Refer to MSL drawing No MPR-MSL-AC-01-SU-G-200001 - "Validation Survey".

MSL survey information has been extracted from 3D point cloud data. Accuracy typically ±5mm.

Linetype Legend

- Slab (external face)
- Column Top
- Column Bottom

Deviations LEGEND

<p>Column</p> <p>5' → Top of column</p> <p>6' → Bottom of column</p>	Distance and directions of surveyed columns away from design. Values are shown in mm.
<p>6' → Slab (OUT)</p> <p>0' → Slab (IN)</p>	Distance and directions of surveyed slab In and Out from design. Values are shown in mm.
<p>Red squares</p>	Discrepancies greater than 10mm

NO	REV	DATE	DESCRIPTION	BY	CHK	APP
S2	P01	10/01/2022	Final Issue - FOR INFORMATION	MSL	SA	

ALL REVISIONS


MAIN CONTRACTOR

Main Contractor

CLIENT LOGO

Client

KEY PLAN

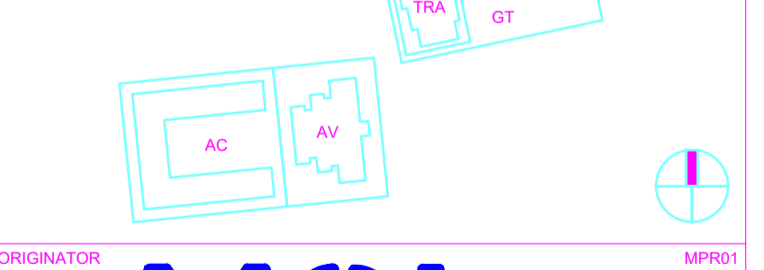

PROJECT NAME

Project title

DRAWING TITLE

First Floor As-Built Survey Slab and Columns

SCALE @ A1

1 : 100

MODEL FILE NAME - REVISION

MPR-MSL-AC-01-SU-G-200002 - P01

FIRST ISSUE DATE

10/01/2022

PROJECT STAGE

Stage 5

STATUS CODE

S2 - Suitable for information

PROJECT	ORIGINATOR	VOLUME	LEVEL	TYPE	ROLE	NUMBER	REV
MPR	MSL	AC	01	SU	G	200002	P01