


Notes

-All encoder and Decoder sets are Kramer brands

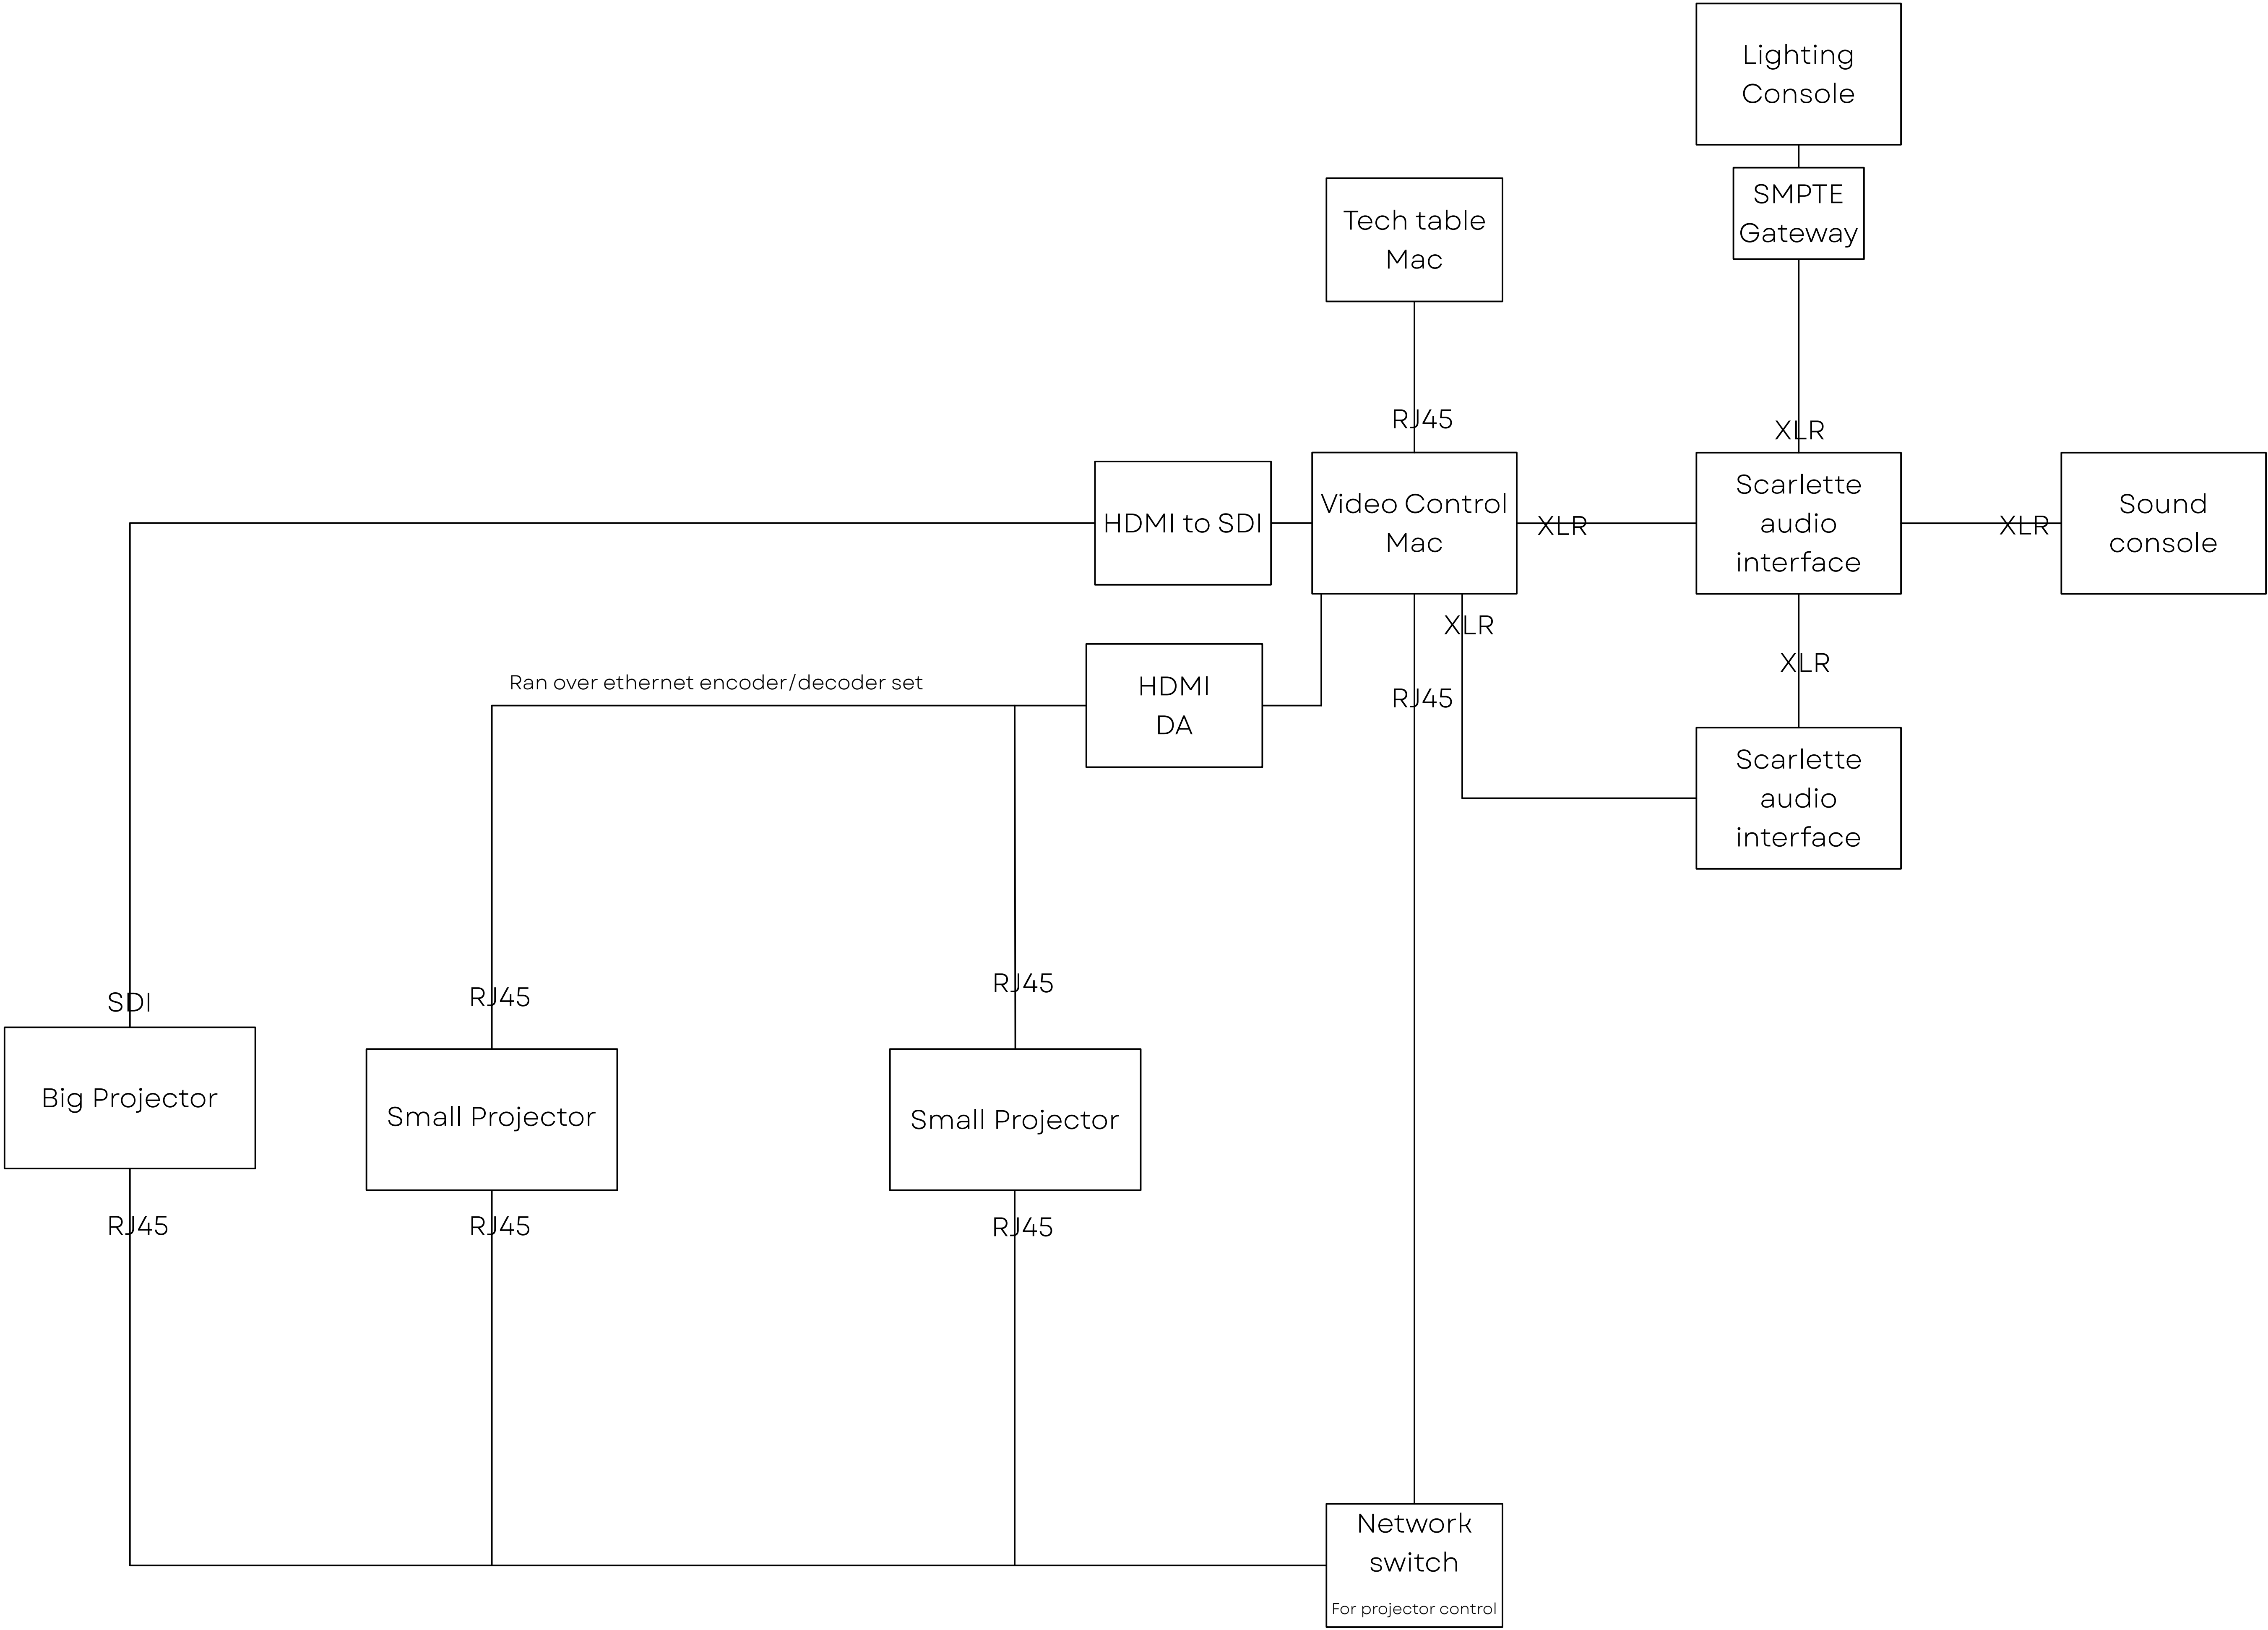

Olive Branch

Lighting/Projection Designer:  
Max Rosenfeld  
Sound Designer: Phoebe Albro

B	5/12/25	As built
A	5/12/25	Initial build

Signal Line Diagram
2 of 2
Scale 1/2"= 1'