

|                 |               |
|-----------------|---------------|
| P 319-320       | 35590.2 SQ FT |
| P 320-321       | 36926.8 SQ FT |
| P 321-322       | 38441.1 SQ FT |
| P 322-323       | 41731.9 SQ FT |
| P 323-324       | 22129.8 SQ FT |
| P 324-325       | 21375.1 SQ FT |
| P 325-326       | 20309.6 SQ FT |
| P 326-327       | 20476.7 SQ FT |
| P 327-328       | 30837.2 SQ FT |
| P 328-329       | 22563.7 SQ FT |
| P 329-330       | 16995.6 SQ FT |
| P 330-331       | 18381.3 SQ FT |
| P 331-332       | 9383.1 SQ FT  |
| P 332-333       | 9219.5 SQ FT  |
| P 333-334       | 7898.1 SQ FT  |
| P 334-335       | 3352.6 SQ FT  |
| P 335-336       | 1861.0 SQ FT  |
| P 336-337       | 1770.7 SQ FT  |
| P 337-338       | 1776.1 SQ FT  |
| P 338-339       | 1879.1 SQ FT  |
| P 339-340       | 2285.2 SQ FT  |
| P 340-341       | 4935.4 SQ FT  |
| P 318-319       | 988.0 SQ FT   |
| P 317-318       | 694.0 SQ FT   |
| P 317-319       | 4746.2 SQ FT  |
| P 322.83-322.83 | 8377.2 SQ FT  |
| P 316-317       | 3766.8 SQ FT  |
| P 317-318       | 8664.4 SQ FT  |
| P 318-319       | 33685.6 SQ FT |
| P 319-320       | 36578.1 SQ FT |
| P 320-321       | 35879.1 SQ FT |
| P 321-322       | 36218.5 SQ FT |
| P 322-323       | 33507.9 SQ FT |
| P 323-324       | 35803.9 SQ FT |
| P 324-325       | 21244.0 SQ FT |
| P 325-326       | 17019.9 SQ FT |
| P 326-327       | 14104.6 SQ FT |
| P 327-328       | 15753.2 SQ FT |
| P 328-329       | 22677.4 SQ FT |
| P 329-330       | 39195.3 SQ FT |
| P 330-331       | 47301.7 SQ FT |
| P 331-332       | 10954.2 SQ FT |
| P 332-333       | 11459.7 SQ FT |
| P 333-334       | 6877.7 SQ FT  |
| P 334-335       | 8999.0 SQ FT  |
| P 335-336       | 3091.9 SQ FT  |
| P 336-337       | 3000.2 SQ FT  |
| P 337-338       | 4663.2 SQ FT  |
| P 338-339       | 3856.0 SQ FT  |
| P 339-340       | 4767.5 SQ FT  |
| P 340-341       | 6641.1 SQ FT  |
| P 326-326       | 12.4 SQ FT    |






- (8" THK) CMU WALL (21' 10-1/2"H)
- TYPE P1, GWB INTERIOR WALL (10'H)
- TYPE P1, GWB INTERIOR WALL (11'H)
- TYPE P1, GWB INTERIOR WALL (13'6"H)
- TYPE P2, GWB INTERIOR WALL (15'6"H)
- TYPE P3, GWB INTERIOR WALL (15'6"H)
- TYPE P4, GWB INTERIOR FURRING WALL (15'6"H)
- TYPE P5, GWB INTERIOR WALL (3'H)
- (6") GWB EXTERIOR WALL (16'2"H)
- (6") GWB EXTERIOR WALL (4'H)
- (6") PARAPET WALL (5'6"H)
- (6") PARAPET WALL (8'4"H)
- (6") PWD EXTERIOR WALL (21' 10-1/2"H)
- (6") PWD EXTERIOR WALL (24'6"H)
- (2x4) (3/4") SOLID CORE PLYWOOD COUNTER WALL

- 230.8 FT
- 26.4 FT
- 47.7 FT
- 9.1 FT
- 224.5 FT
- 227.8 FT
- 234.9 FT
- 2.9 FT
- 155.2 FT
- 22.7 FT
- 91.4 FT
- 70.1 FT
- 14.3 FT
- 32.1 FT
- 86.9 FT


- PLAN NOTES
- STEEL COLUMN; REFER STRUCTURAL DRGS. PAINT TO MATCH ADJ. WALL.
  - ELECTRICAL PANELS; REFER ELECTRICAL DRGS.
  - PRE-FABRICATED COOLER WALLS, CEILING, FLOOR, DOORS AND RACKS. MAINTAIN 2" AIR SPACE BETWEEN COOLER AND ADJACENT WALLS PER MANUFACTURER'S SPECS. CONTRACTOR TO FIELD VERIFY DIMENSIONS.
  - MOP SINK; REFERENCE PLUMBING DRGS.
  - SHOWER FLOOR LOCATION- REFER PLUMBING DRGS.
  - DOWNSPOUT LOCATION- REFER ELEVATION SHEETS.
  - AWNINGS ABOVE- REFER ELEVATION & DETAIL SHEETS (A301 & A406)
  - EXTERIOR ROOF LADDER LOCATION.
  - EQUIPMENT MILLWORK- REFER EQUIPMENT/ MILLWORK PLAN & SCHEDULE. REFER (A202 & A602).
  - POS MILLWORK- REFER MILLWORK SCHEDULE. REFER A602.
  - BOOTH SEATING - REFER EQUIPMENT/ MILLWORK PLAN & SCHEDULE.
  - PATIO ROOF ABOVE- REFER ROOF PLAN, ELEVATIONS, SECTIONS & DETAILS.
  - FIRE EXTINGUISHER: #10 CLASS ABC WITH UL RATING 4A-60BC. SURFACE MOUNTED ON WALL WITH MANUFACTURER'S ALL STEEL WALL BRACKET. J.L INDUSTRIES INC. (COSMIC 10E) OR APPROVED EQUAL WITH INSPECTION TAG AS REQUIRED BY LOCAL CODES.

- PARTITION TYPES:
- P1 ONE LAYER 5/8" GYP. BD. ON EACH SIDE OF 3-5/8" MTL STUDS @ 16" O.C. EXTEND TO 1'-0" ABOVE CEILING LEVEL. SECURE PARTITION TO ROOF STRUCTURE ABOVE.
  - P2 ONE LAYER 5/8" GYP. BD. EACH SIDE OF 3-5/8" METAL STUDS @ 16" O.C. W/ SOUND BATT INSULATION. EXTEND TO BOTTOM OF ROOF STRUCTURE.
  - P3 ONE LAYER 5/8" GYP. BD. EACH SIDE OF 6" METAL STUDS @ 16" O.C. W/ SOUND BATT INSULATION. EXTEND TO THE BOTTOM OF ROOF DECK.
  - P4 ONE LAYER OF 5/8" GYP. BD. ON FINISHED SIDE OF 3-5/8" FURRING METAL STUDS.
  - P5 ONE LAYER 5/8" GYP. BD. ON EACH SIDE OF 3-5/8" MTL STUDS @ 16" O.C. TO 3'-0" A.F.F.

GENERAL PARTITION NOTES:  
NOTE: USE 5/8" CEMENT BD. IN LIEU OF GYP. BD. IN ALL WET LOCATIONS.

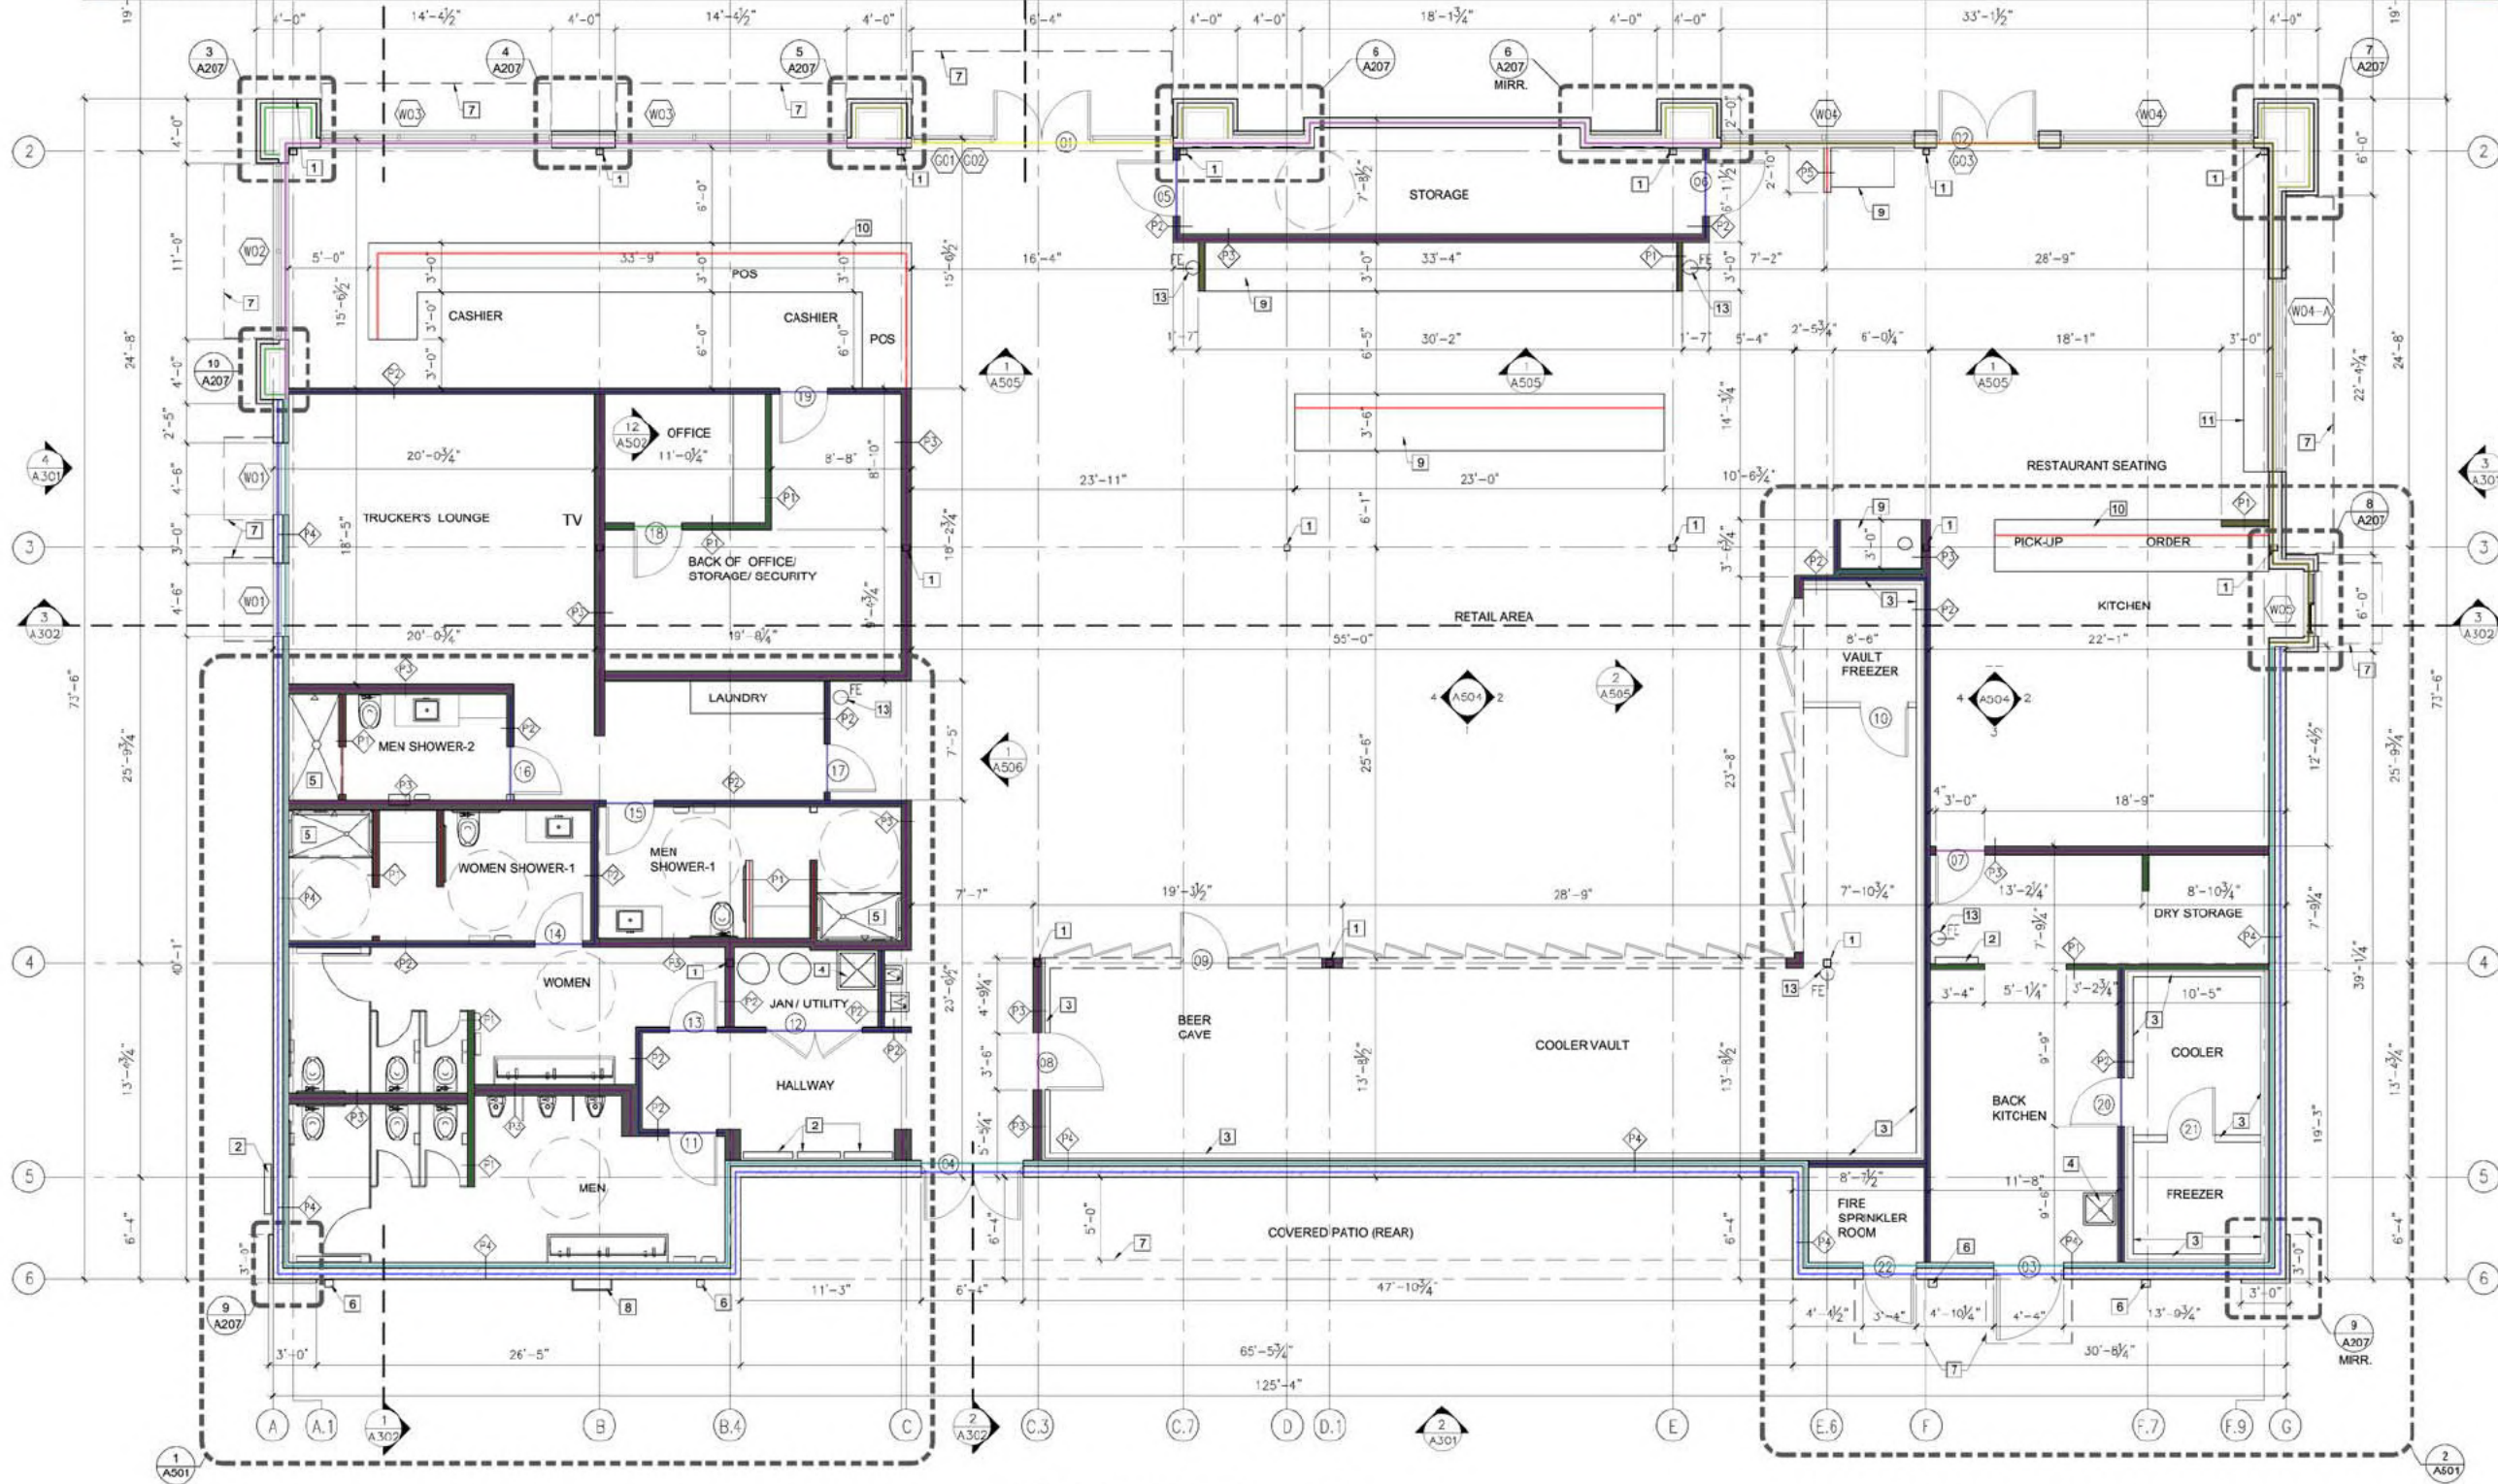

1 FLOOR PLAN  
A201 SCALE: 3/16"=1'-0"

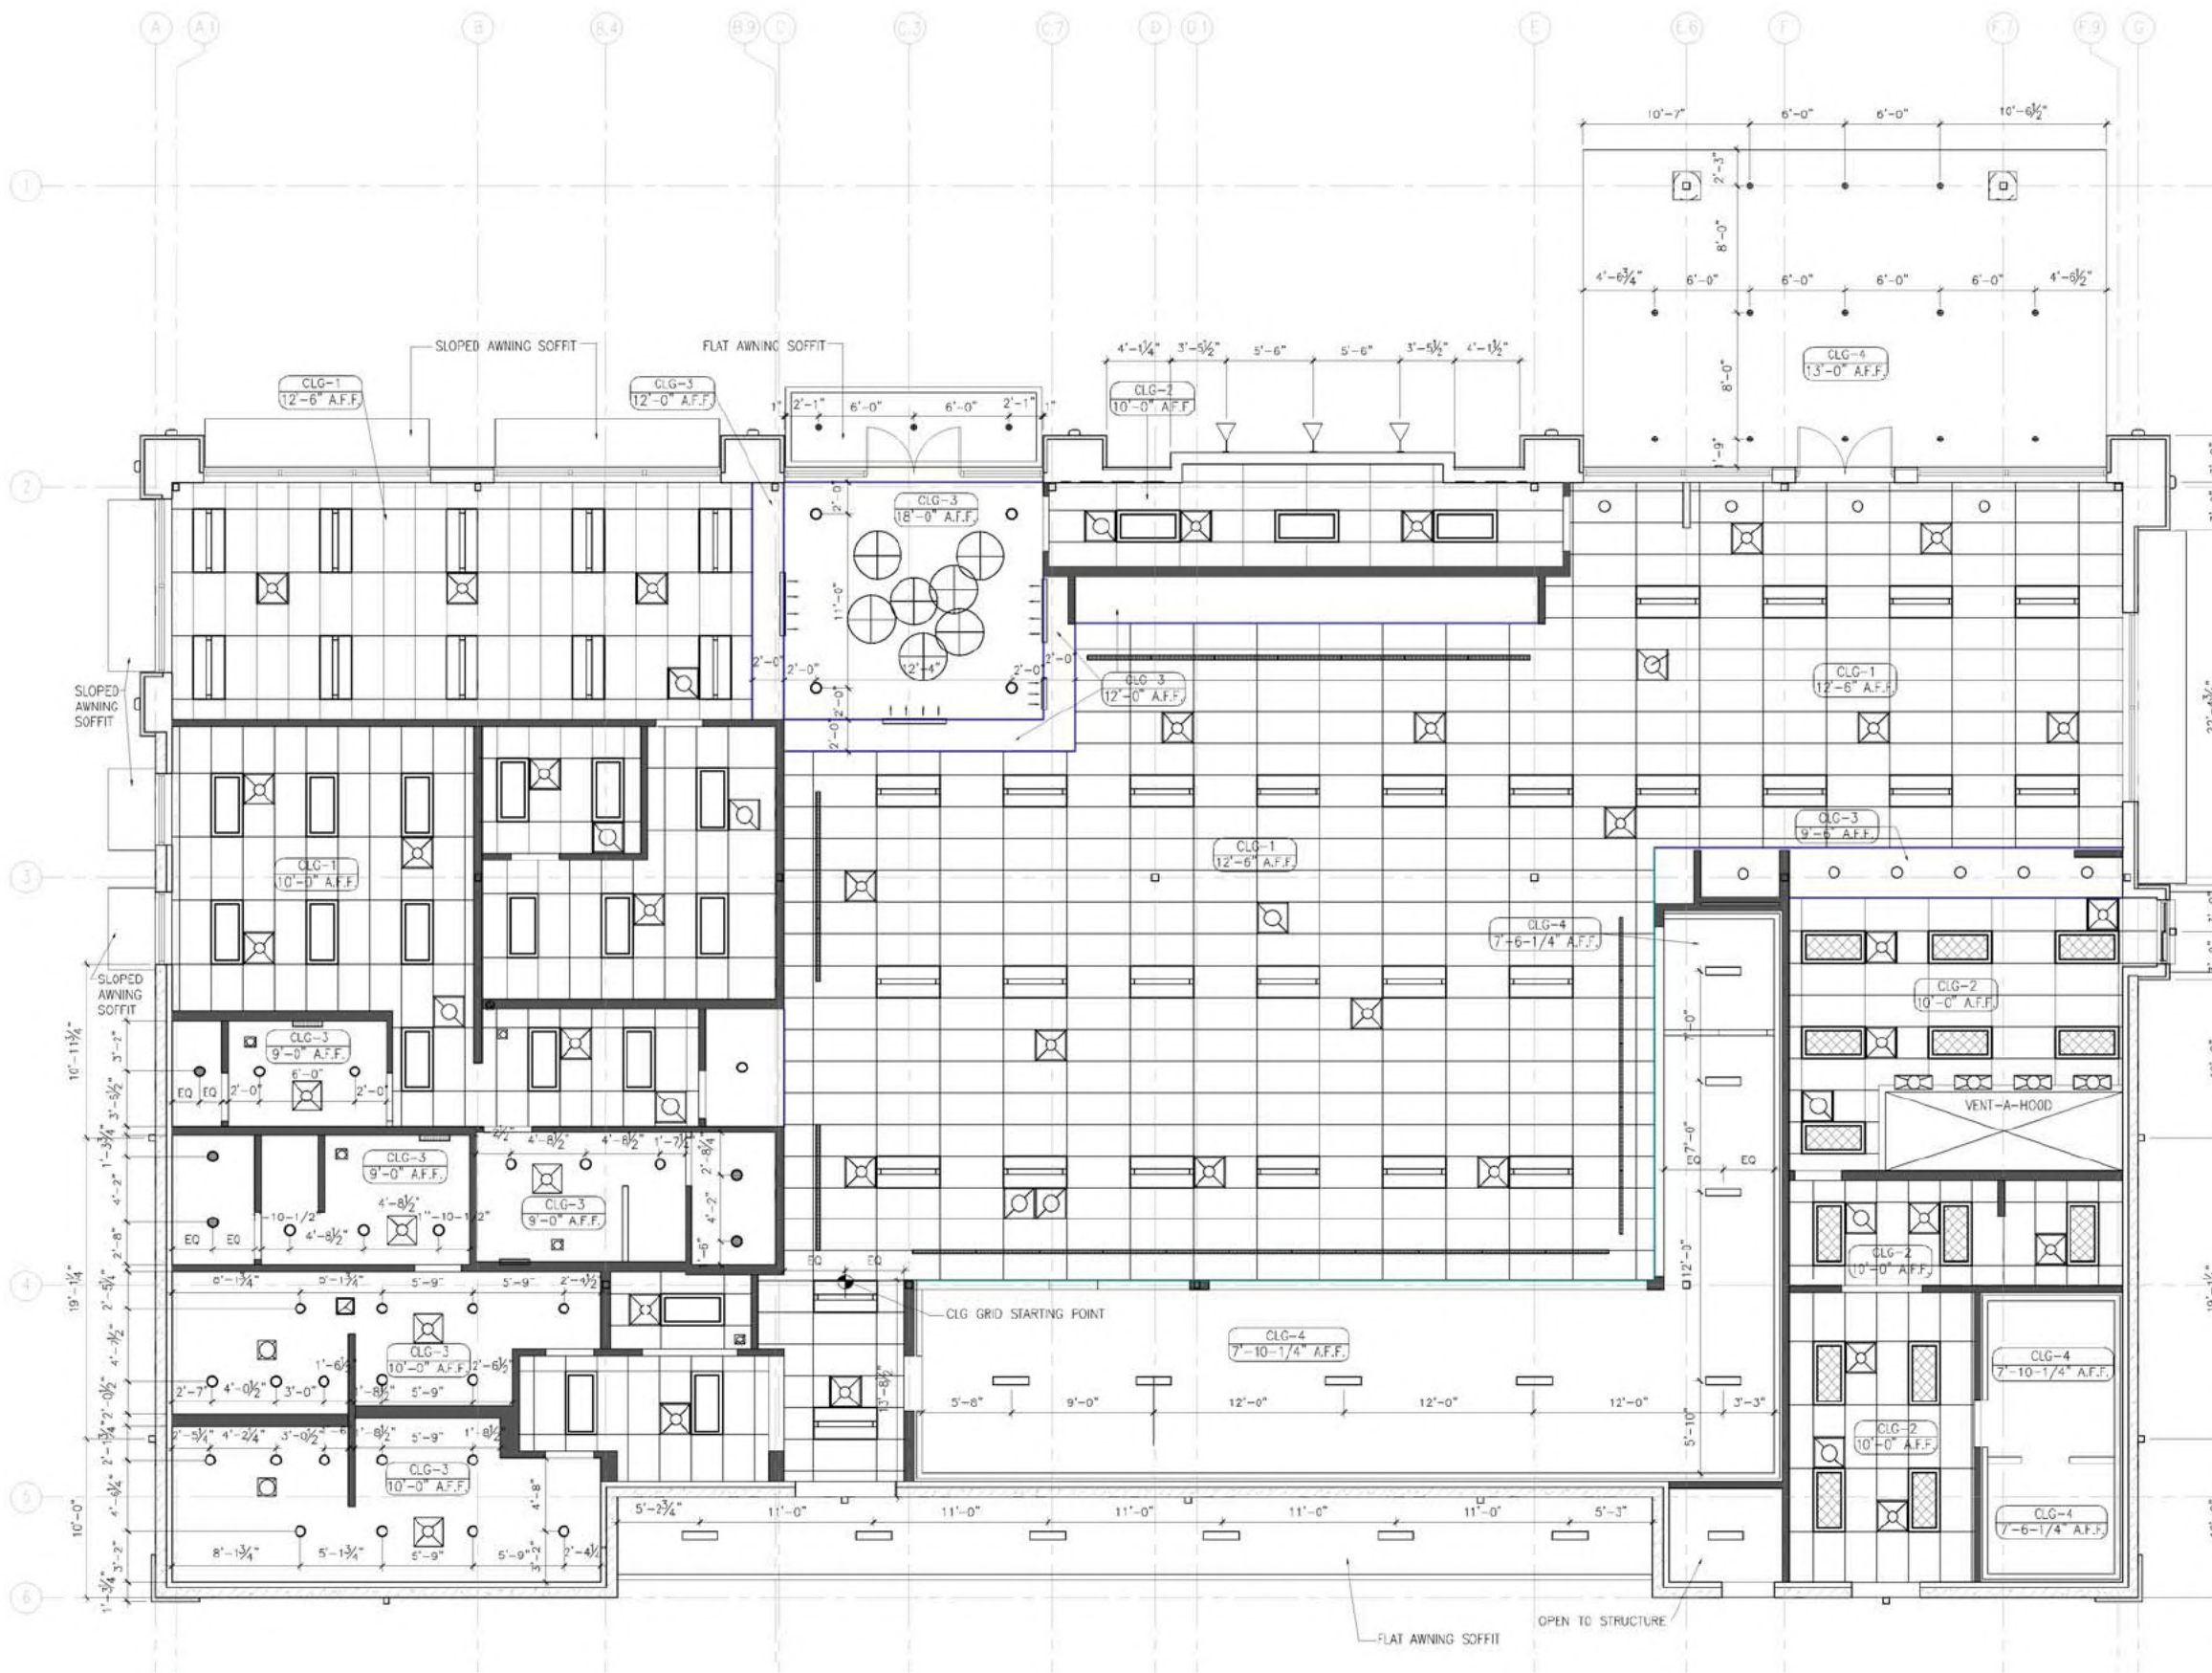

| CEILING PLAN LEGEND |                                                                                                          |
|---------------------|----------------------------------------------------------------------------------------------------------|
| SYMBOL              | DESCRIPTION AND MOUNTING HEIGHT                                                                          |
| ○                   | RECESSED CAN LIGHT FIXTURES                                                                              |
| ●                   | RECESSED CAN LIGHT FIXTURES FOR SHOWERS                                                                  |
| ⊕                   | DECORATIVE CHANDELIER<br>INSTALL BOTTOM OF FIXTURE AT 10'-0" A.F.F.                                      |
| ▭                   | RECESSED 2X4 LIGHT FIXTURE FOR RETAIL AREA                                                               |
| ▭                   | RECESSED 2X4 LIGHT FIXTURE FOR BACK AREAS                                                                |
| ▭                   | RECESSED 2X4 LIGHT FIXTURE FOR KITCHEN AREA                                                              |
| —                   | SPOT FIXTURES FOR GRAPHICS                                                                               |
| —                   | UTILITY LIGHT FOR COOLERS/<br>EXTERIOR SURFACE MOUNTED LIGHT<br>SURFACE MOUNTED LIGHT FOR SPRINKLER ROOM |
| —                   | VANITY LIGHT                                                                                             |
| •                   | EXTERIOR RECESSED LIGHT                                                                                  |
| —                   | EXTERIOR WALL SCONCE                                                                                     |
| —                   | EXTERIOR WALL MOUNTED BRACKET FIXTURE                                                                    |
| ⊕                   | NEW CEILING HVAC SUPPLY DIFFUSER                                                                         |
| ⊕                   | NEW CEILING HVAC RETURN DIFFUSER                                                                         |
| —                   | NEW CEILING GRID AND 2'X4'<br>VINYL COATED ACOUSTICAL CEILING TILES                                      |
| —                   | NEW GYPSUM BOARD CEILING                                                                                 |
| —                   | CUSTOM FREEZER/ COOLER CEILING<br>UNLESS NOTED OTHERWISE.                                                |

NOTE:  
REFER TO MEP DRAWINGS FOR ALL LIGHTING FIXTURES  
CONTACT: TOM HALVERSON  
@ ARCHITECTURAL LIGHTING ALLIANCE  
PHONE# (817) 863-0603  
(214) 658-9000


(3-5/8") GWB BULKHEAD WALL (3'9"H)  
(3-5/8") GWB BULKHEAD WALL (4'6"H)

CEILING PLAN



185.7 FT  
74.3 FT


SHEET NO.  
A203  
10 OF 33

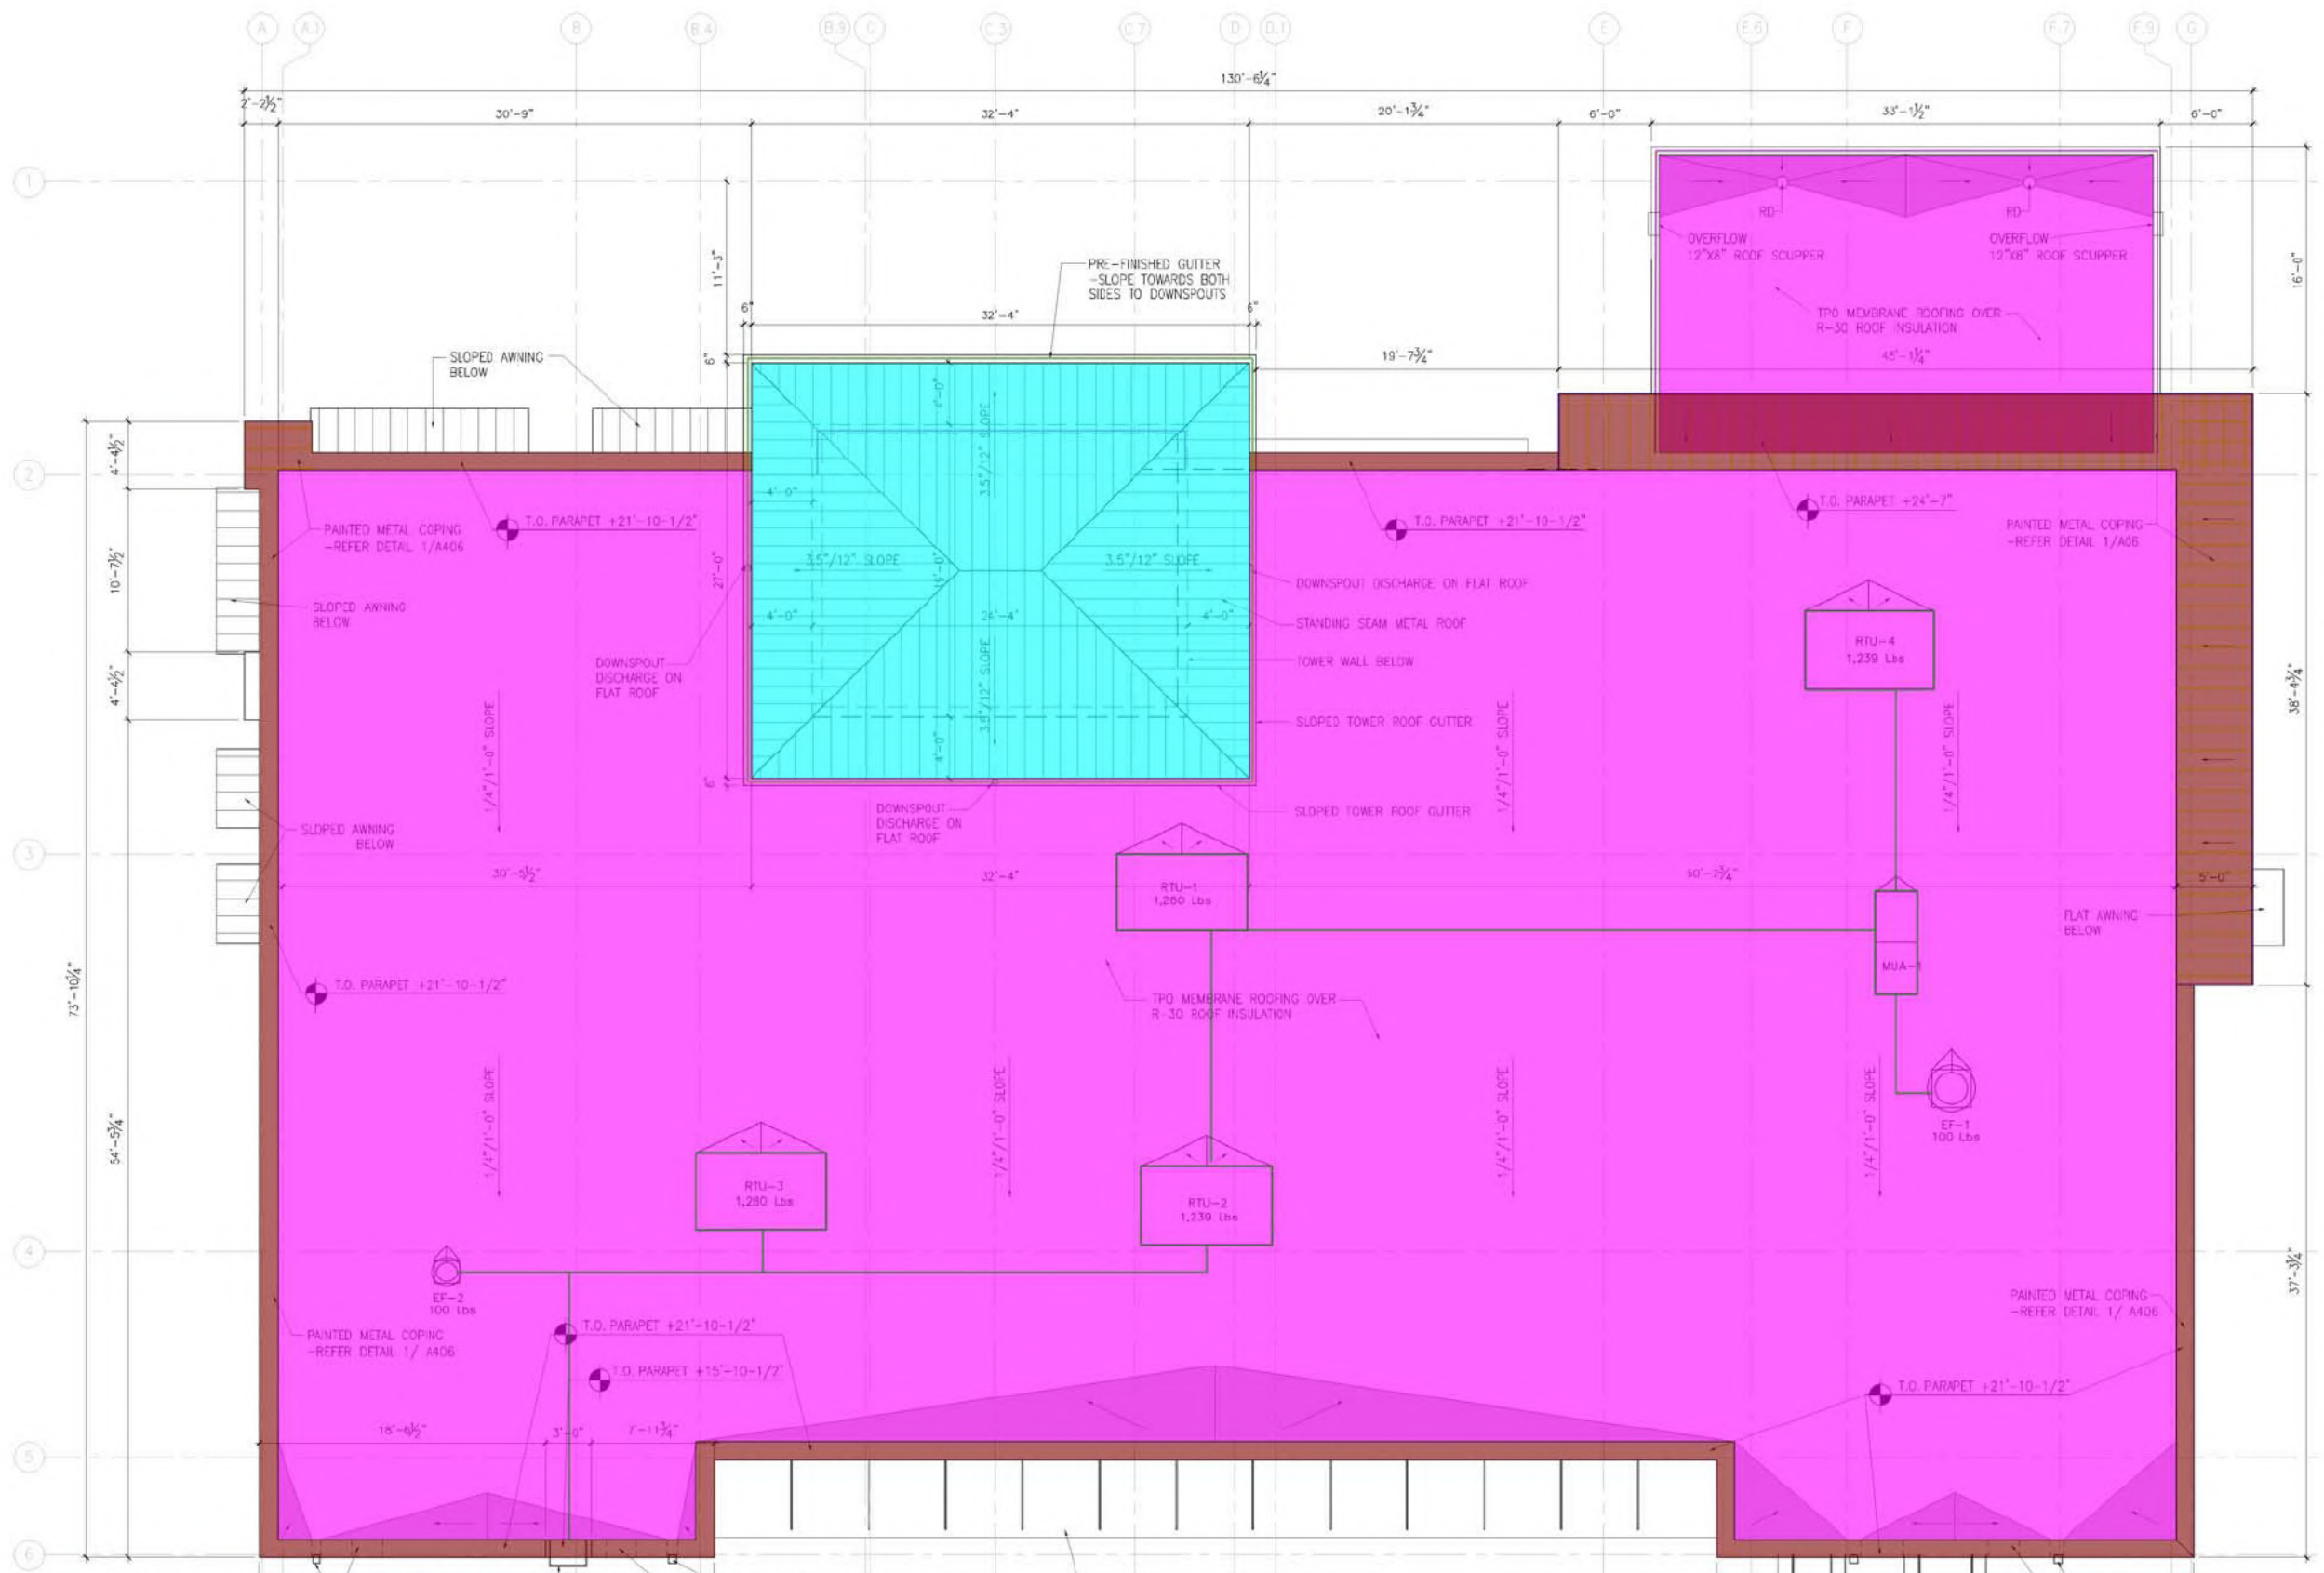

- ROOF GENERAL NOTES
1. PROVIDE TAPERED INSULATION CRICKETS ( SHOWN SHADEDS) FOR PROPER DRAINAGE AT ALL ROOF TOP EQUIPMENT, PENETRATIONS OR AS INDICATED FOR POSITIVE DRAINAGE. MINIMUM 1/4" / 1'-0".
  2. ALL EQUIPMENT ON ROOF TO BE MOUNTED ON CURB AND SHALL BE PROPERLY FLASHED PER EQUIPMENT MANUFACTURER'S GUIDELINES.
  3. ALL ROOF TOP MECHANICAL, PLUMBING AND ELECTRICAL TO HAVE PHONOLIC LABELS.
  4. TPO MEMBRANE ROOFING TO BE EQUAL TO GAF EVERGAUD. FINAL SELECTION TO MADE BY OWNER BASED ON ROOF WARRANTIES AS REQUIRED.
  5. PROVIDE MIN. 30" WIDE ROOF PADS CONTINUOUS FROM ROOF LADDER TO EVERY RTU LOCATION.
  6. ALL AWNINGS ARE BY MAPES AWNING COMPANY. SUBMIT SHOP DRAWINGS FOR REVIEW AND SUBMIT COLOR SWATCHES FOR APPROVAL BEFORE FABRICATION.
  7. REFER TO MECHANICAL SHEETS FOR ALL ROOF TOP UNITS AND OTHER PLUMBING PENETRATIONS.

(6") GWB EXTERIOR WALL (11'6"H)  
 362S162-43 PARAPET WALL (3'6"H) W/ 362S162-43 2'4"L BRACE  
 600S162-43  
 600S162-43 (2'4"H)  
 TPO ROOFING  
 STANDING SEAM METAL ROOFING  
 METAL COPING  
 30"W ROOF PAD  
 PRE-FINISHED GUTTER

120.8 FT  
 101.3 FT  
 327.3 FT  
 93.4 FT  
 8,117.9 SQ FT  
 908.7 SQ FT  
 754.1 SQ FT  
 275.1 FT  
 120.8 FT

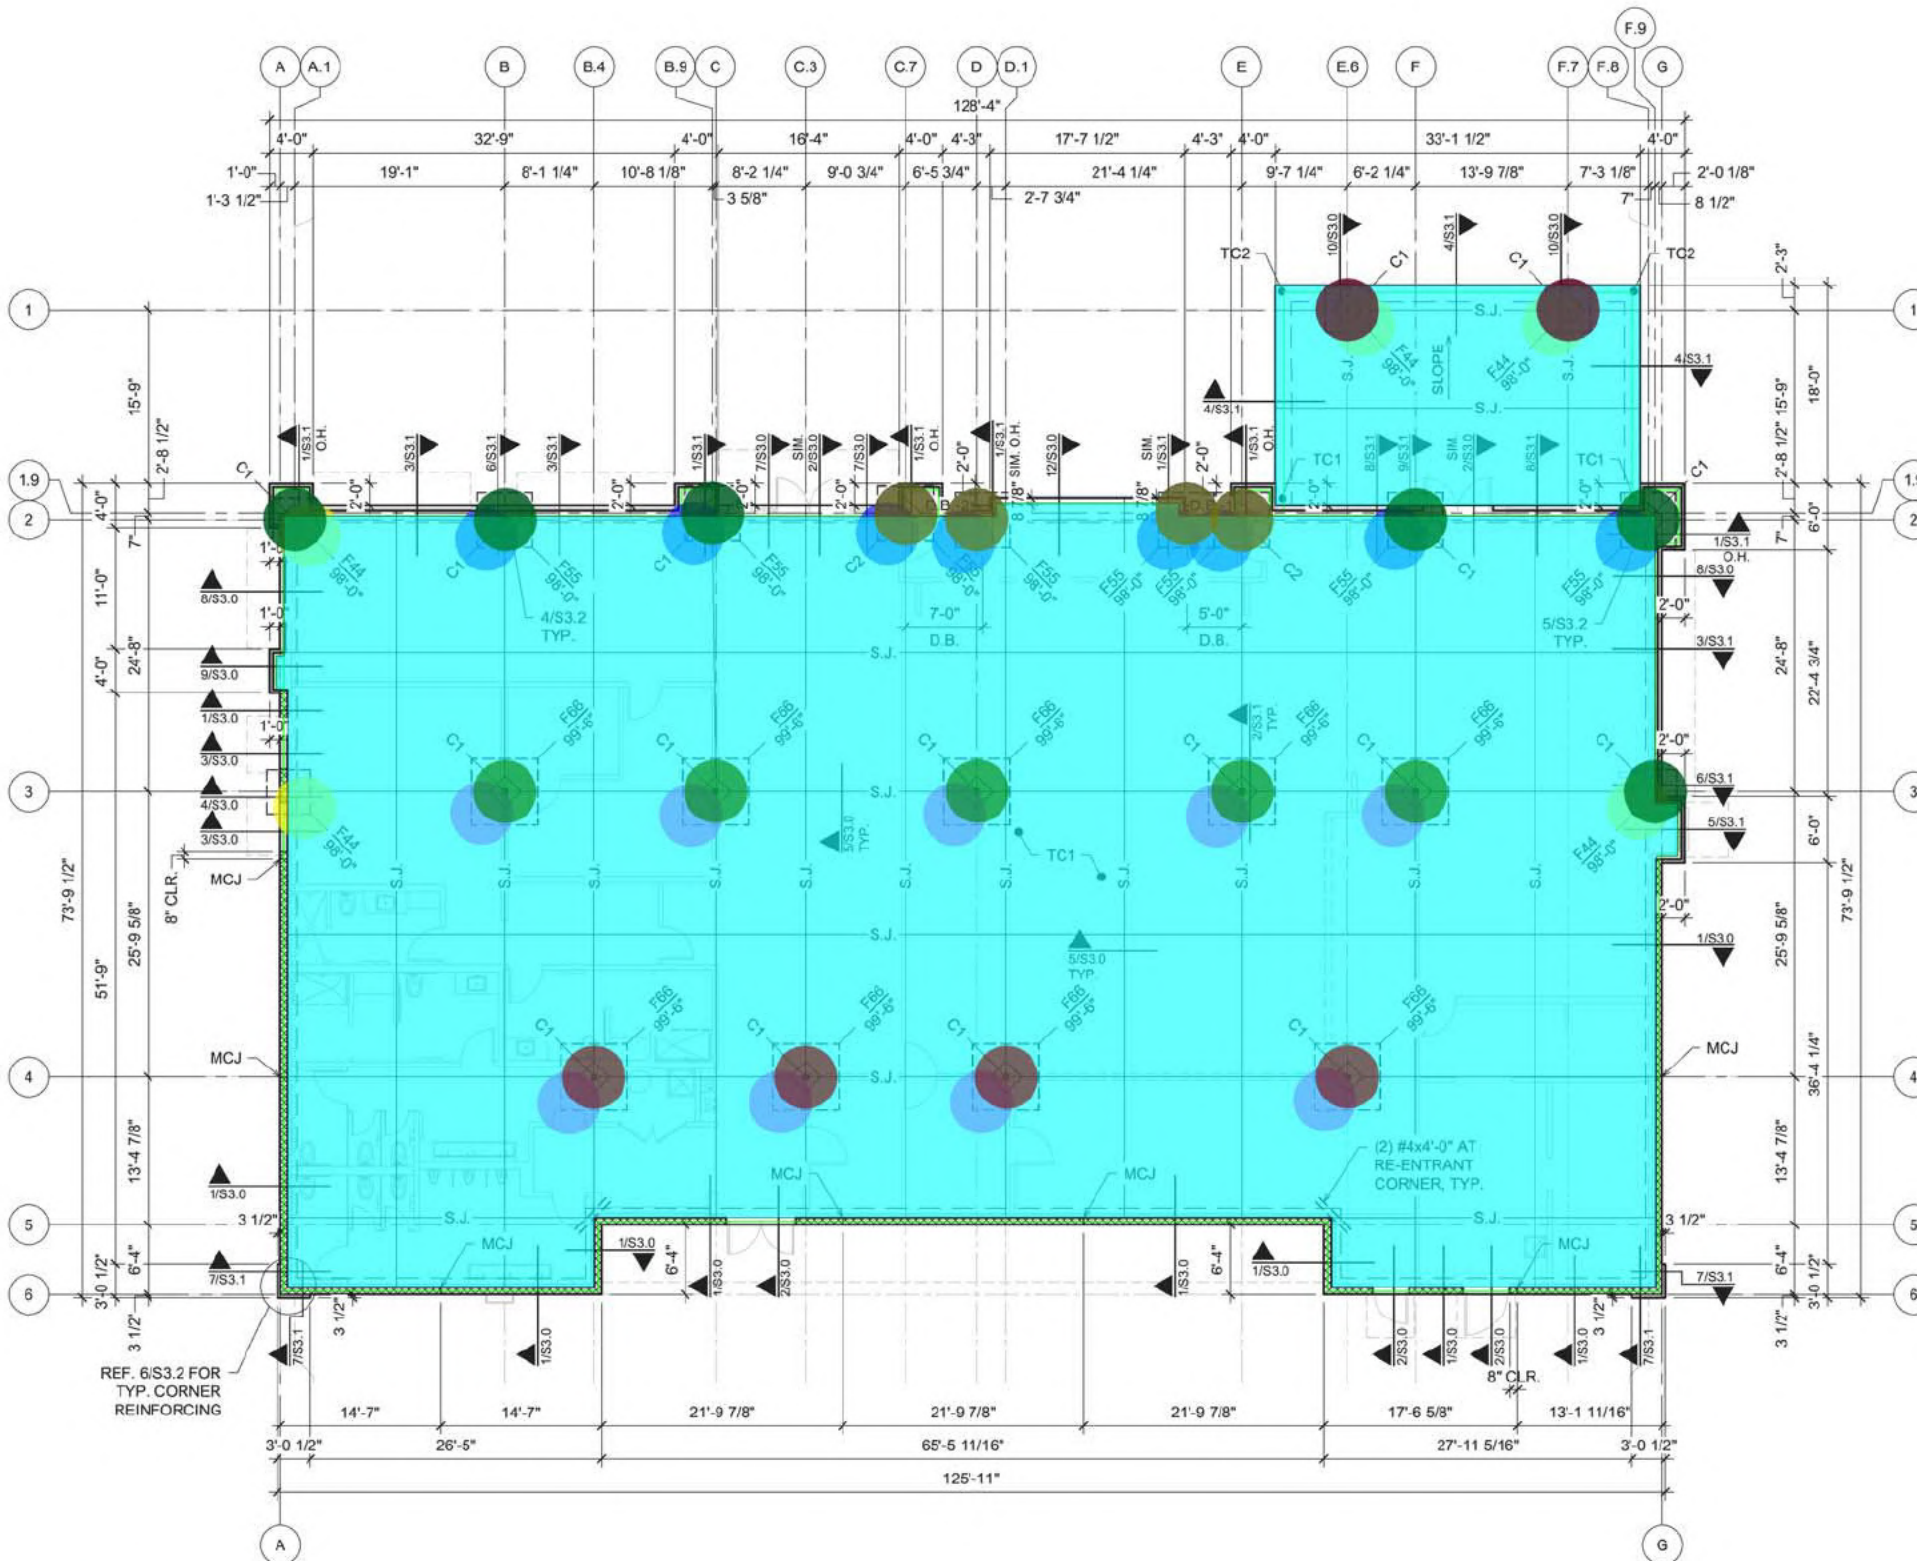

# 1 FOUNDATION PLAN

SCALE: 1/8" = 1'-0"

## FOUNDATION PLAN NOTES:

- COORDINATE ALL DIMENSIONS WITH ARCHITECTURAL PLANS AND DETAILS.
- REFERENCE SHEET S1.0 FOR GENERAL NOTES.
- CONCRETE SLAB SHALL BE 5" CONCRETE WITH #3 REBAR AT 18" O.C. EACH WAY, CENTERED IN SLAB.
- FX FOOTING MARK, REFER TO SCHEDULE 98'-0" TOP OF FOOTING ELEVATION
- 'DB-X' DENOTES DIAGONAL BRACE LOCATIONS. REFER TO 7/S3.2 OR 8/S3.2 FOR DETAILS.
- REFER TO 6/S3.0 FOR CONSTRUCTION JOINT IF FOUNDATION WILL BE MADE IN MORE THAN ONE POUR.
- REFER TO 11/S3.0 FOR TYPICAL "MCJ" DETAIL.

## FOOTING SCHEDULE

| MARK | LENGTH x WIDTH | DEPTH | REINFORCING     |
|------|----------------|-------|-----------------|
| F44  | 4'-0" x 4'-0"  | 1'-0" | (5) #5 EACH WAY |
| F55  | 5'-0" x 5'-0"  | 1'-0" | (6) #5 EACH WAY |
| F66  | 6'-0" x 6'-0"  | 1'-2" | (6) #5 EACH WAY |

## T.O. CONC. (TC) SCHEDULE

| MARK | ELEVATION            | NOTES |
|------|----------------------|-------|
| TC1  | T.O. CONC. = 100'-0" | N/A   |
| TC2  | T.O. CONC. = 99'-7"  | N/A   |

## COLUMN SCHEDULE

| MARK | SIZE                | BASE PLATE |
|------|---------------------|------------|
| C1   | HSS5x5x1/4 (13'9"H) | BP-1       |
| C2   | HSS5x5x3/8 (15'6"H) | BP-2       |

REFER TO S3.2 FOR BASE PLATES (BP-X).

Digitally signed  
by Nathaniel  
Shaffer  
Date:  
2021.06.07  
14:02:54-05'00'

- (1'6"Wx2'H) GRADE BEAM
- (4' SQ.x1'H) CONCRETE FOOTING PAD
- (5' SQ.x1'H) CONCRETE FOOTING PAD
- (6' SQ.x1'2"H) CONCRETE FOOTING PAD
- (1' SQ.x2'H) CONCRETE PIER
- (5" THK) SLAB ON GRADE
- HSS5x5x1/4 (13'9"H)
- HSS5x5x1/4 (15'6"H)
- HSS5x5x3/8 (15'6"H)

528.6 FT  
5.0  
8.0  
9.0  
12.0  
8,942.2 SQ FT  
6.0  
11.0  
4.0

SHEET NO.

S2.0

OF



# 1 ROOF FRAMING PLAN

SCALE: 1/8" = 1'-0"

## ROOF FRAMING PLAN NOTES:

- COORDINATE ALL DIMENSIONS WITH ARCHITECTURAL PLANS AND DETAILS.
- REFERENCE SHEET S1.0 FOR GENERAL NOTES.
- ROOF DECK SHALL BE VULCRAFT 1.5B 22 GA. W/ #12 SCREW AT 36/7 PATTERN AND (8) #10 SIDE LAP SCREW. AT REAR USE VULCRAFT 1.5B 22 GA. W/ #12 SCREW AT 36/4 PATTERN AND NO SIDE LAP SCREW.
- REFER TO PLAN FOR BOTTOM OF DECK (BMD) ELEVATIONS.
- REFER TO 1/S4.4 FOR METAL STUD HEADER SCHEDULE.
- REFER TO 2/S4.4, 3/S4.4, & 4/S4.4 FOR ROOF TOP UNITS (RTU). DESIGN JOISTS FOR ADDITIONAL LOADS SHOWN ON PLAN.
- REFER TO 5/S4.2 FOR LOOSE LINTEL SCHEDULE.
- (DB-X) INDICATES DIAGONAL BRACE. REFER TO 7/S3.2 & 8/S3.2 FOR DIAGONAL BRACE DETAIL.
- ADDITIONAL LOAD AT KCS JOIST UNDER TOWER WALL:


9.1. LL = 330 PLF ; DL = 440 PLF.

Digitally signed  
by Nathaniel  
Shaffer  
Date:  
2021.06.07  
14:03:01-05'00'

- HSS8x6x5/16
- HSS12x6x1/4
- HSS18x6x1/4
- W14x22
- W16x26
- W16x31
- 12K1 STEEL JOISTS
- 14K1 STEEL JOISTS
- 16K2 STEEL JOISTS
- 20KCS5 STEEL JOISTS
- L4x4x1/4
- L6x6x5/16 1'L
- 1.5B 22 GA. VULCRAFT ROOF DECK
- HSS6x4x3/8 (7'L)

|               |  |
|---------------|--|
| 15.0 FT       |  |
| 53.7 FT       |  |
| 41.2 FT       |  |
| 303.8 FT      |  |
| 110.5 FT      |  |
| 86.2 FT       |  |
| 157.8 FT      |  |
| 314.8 FT      |  |
| 886.2 FT      |  |
| 49.4 FT       |  |
| 509.1 FT      |  |
| 20.0          |  |
| 8,937.6 SQ FT |  |
| 2.0           |  |

SHEET NO.  
S2.1  
OF

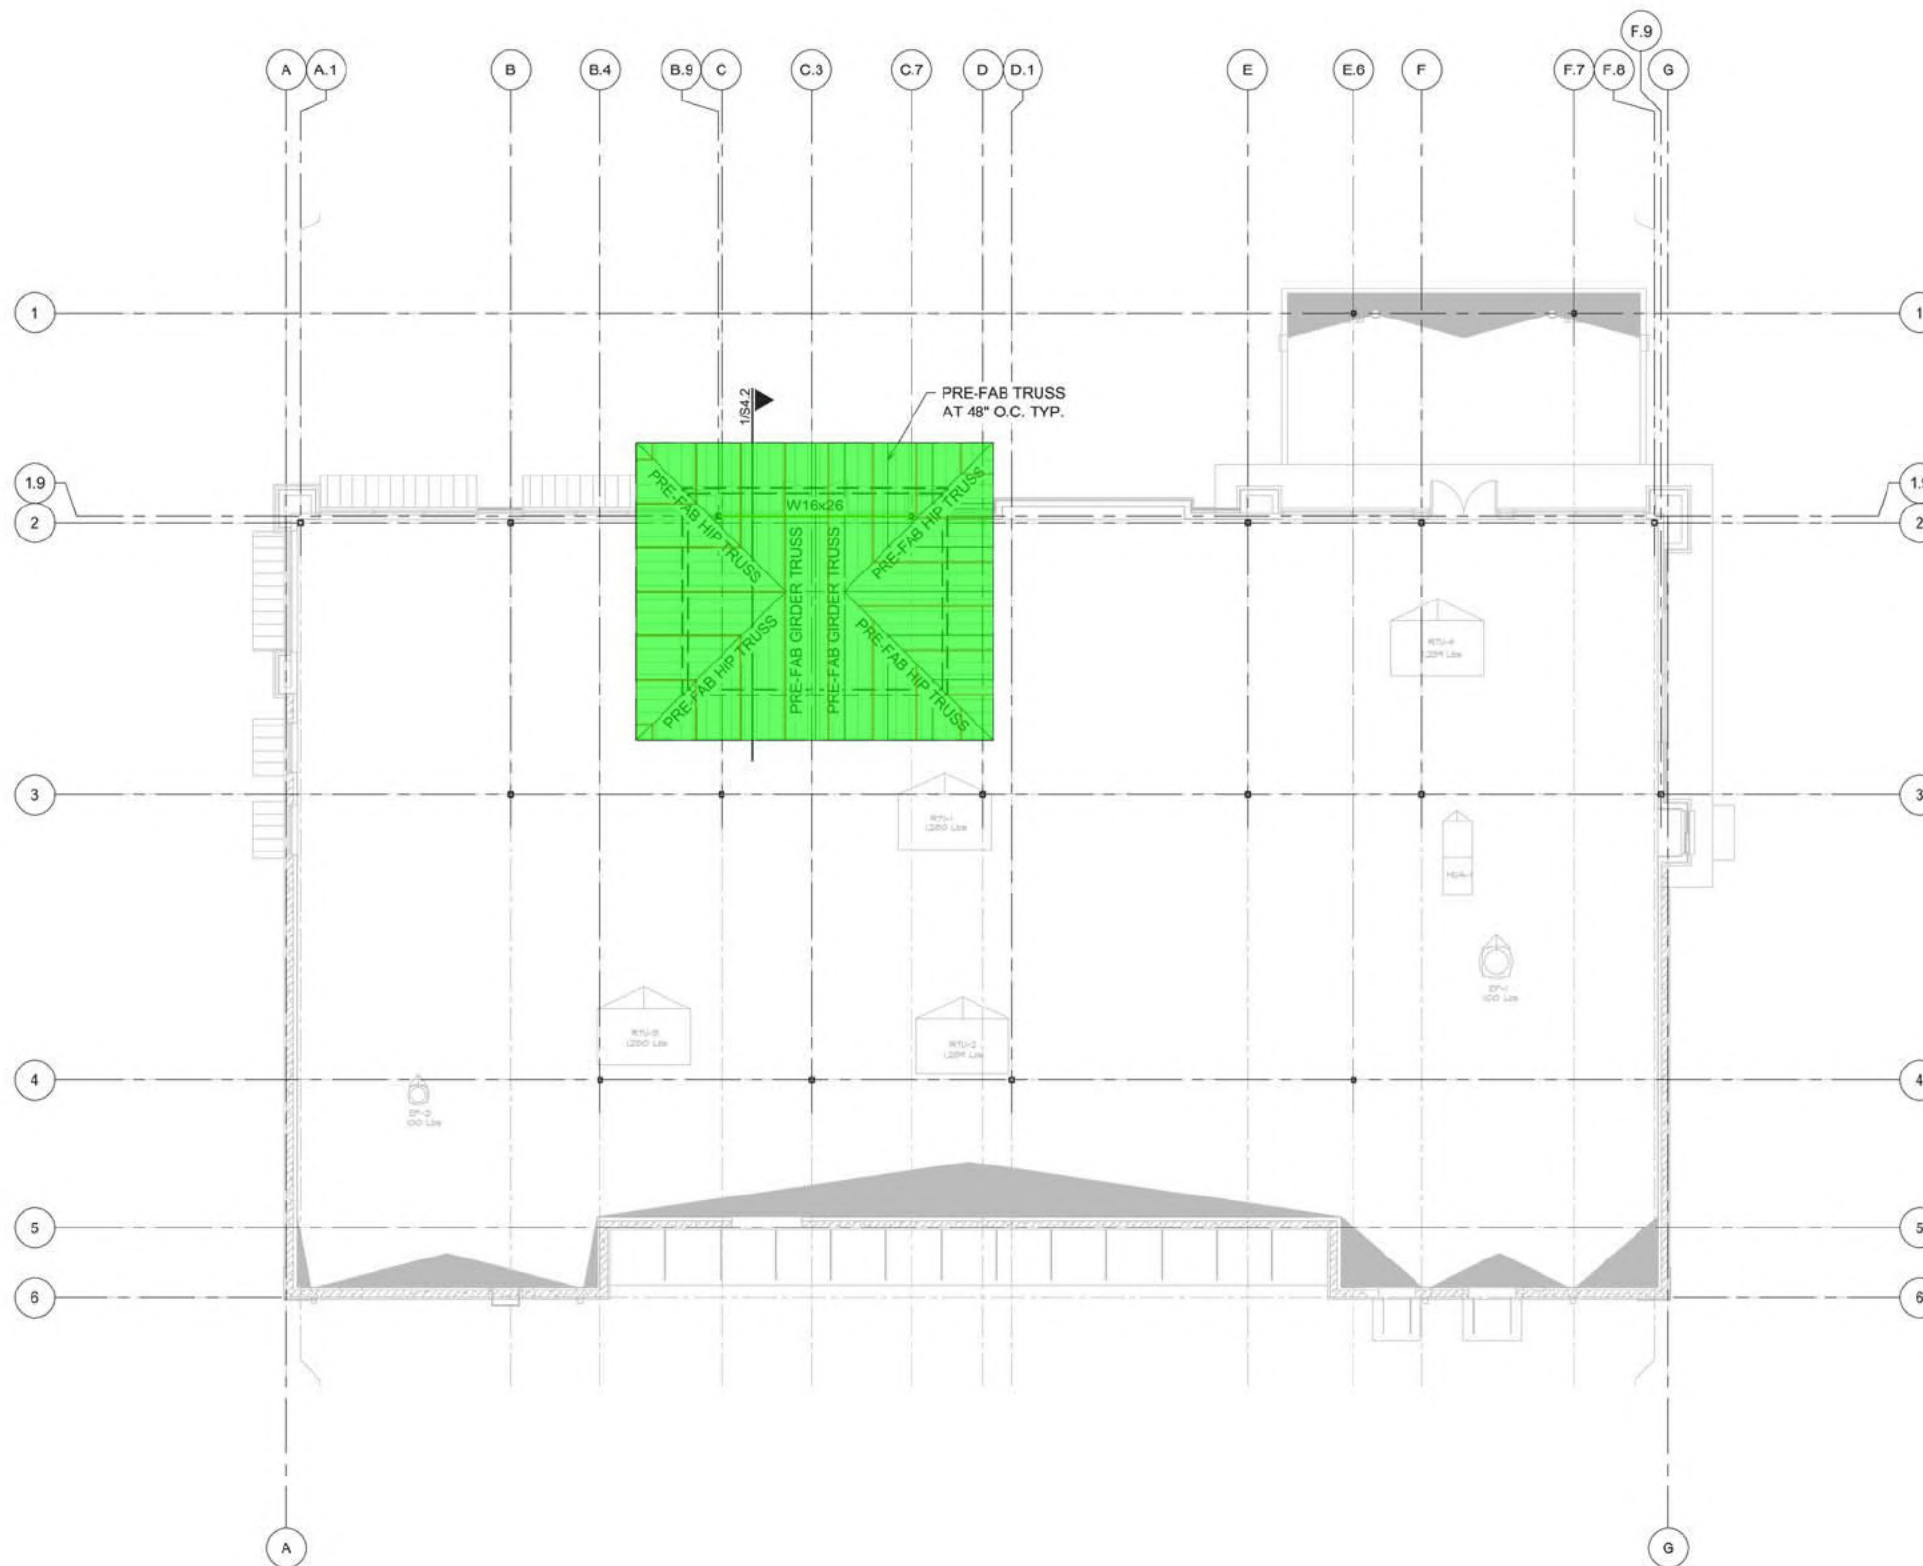

# 1 HIGH ROOF FRAMING PLAN

SCALE: 1/8" = 1'-0"

## HIGH ROOF FRAMING PLAN NOTES:

- COORDINATE ALL DIMENSIONS WITH ARCHITECTURAL PLANS AND DETAILS.
- REFERENCE SHEET S1.0 FOR GENERAL NOTES.
- TOWER ROOF DECK SHALL BE VULCRAFT 1.5B 22 GA. W/ #12 SCREW AT 36/4 PATTERN & (0) #10 SIDE LAP SCREWS.


Digitally signed  
by Nathaniel  
Shaffer  
Date:  
2021.06.07  
14:03:08-05'00'

W16x26  
PRE-FAB ROOF TRUSS  
1.5B 22 GA. VULCRAFT ROOF DECK

17.6 FT  
219.9 FT  
911.7 SQ FT

LALONDE  
ENGINEERING, INC.  
CONSULTING STRUCTURAL  
ENGINEERS  
6617 REED BLVD ROAD  
FORT WORTH, TX 76116  
PHONE: 817-327-6546  
FAX: 817-328-1520  
COW P-7978


SHEET NO.  
S2.2  
OF

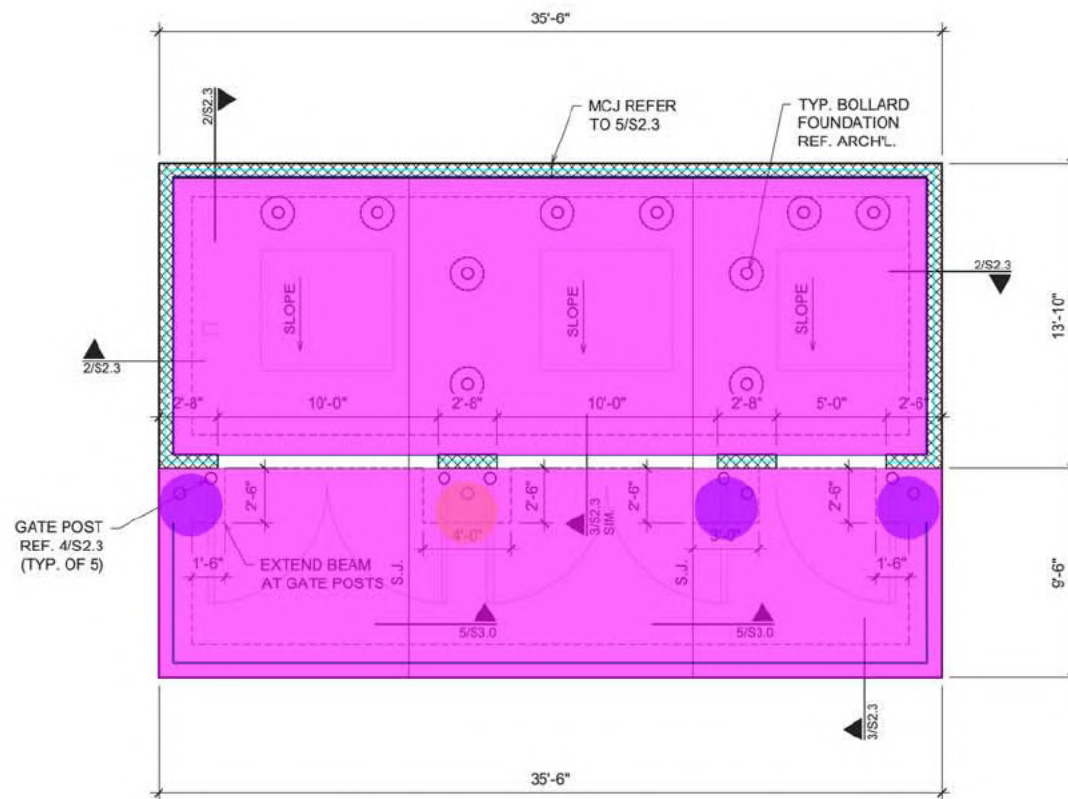


1 DUMPSTER FOUNDATION PLAN  
SCALE: 1/4" = 1'-0"

FOUNDATION PLAN NOTES:


1. COORDINATE ALL DIMENSIONS WITH ARCHITECTURAL PLANS AND DETAILS.
2. REFERENCE CIVIL FOR ALL SIDEWALKS AND STOOPS.
3. REFERENCE SHEET S1.0 FOR GENERAL NOTES.
4. SLAB SHALL BE 7" CONCRETE REINFORCED WITH #4 AT 18" O.C.E.W. CENTERED IN SLAB.
5. SLOPE DUMPSTER FOUNDATION 1/4 INCH PER FOOT.

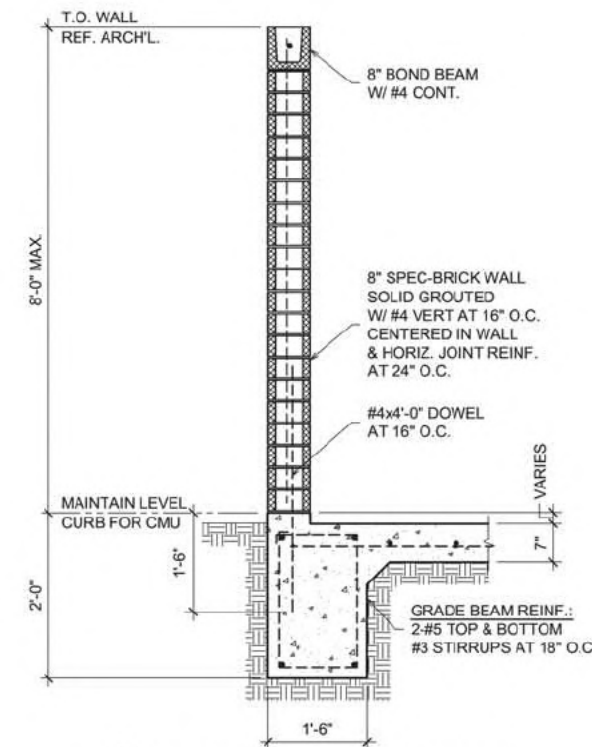


2 DUMPSTER PAD WALL SECTION  
SCALE: 3/4" = 1'-0"

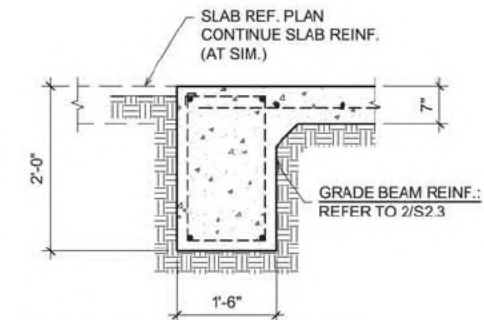

3 DUMPSTER EDGE SECTION  
SCALE: 3/4" = 1'-0"

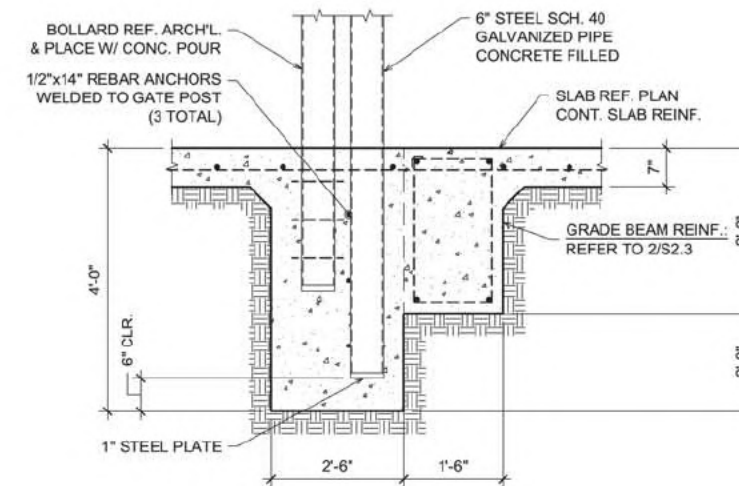

4 DUMPSTER PAD WALL SECTION AT GATE POST  
SCALE: 3/4" = 1'-0"

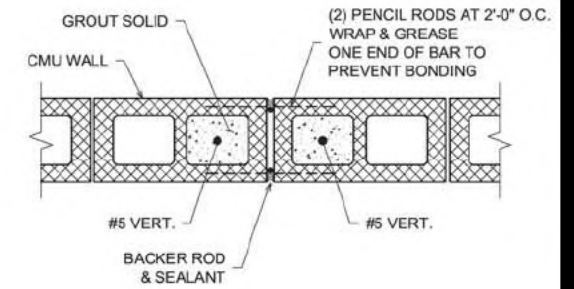


5 TYPICAL CMU CONTROL JOINT  
SCALE: 1 1/2" = 1'-0"

- (DP) (1'6"Wx2'H) GRADE BEAM
- (DP) (2'6"Wx4'Lx4'H) CONCRETE FOOTING PAD
- (DP) (2'6"Wx3'Lx4'H) CONCRETE FOOTING PAD
- (DP) (7" THK) DUMPSTER CONCRETE PAD
- (DP) (8" THK) CMU WALL (8'H)

Digitally signed  
by Nathaniel  
Shaffer  
Date:  
2021.06.07  
14:03:16-05'00'

140.4 FT  
1.0  
3.0  
767.3 SQ FT  
71.3 FT


SHEET NO.  
S2.3  
OF

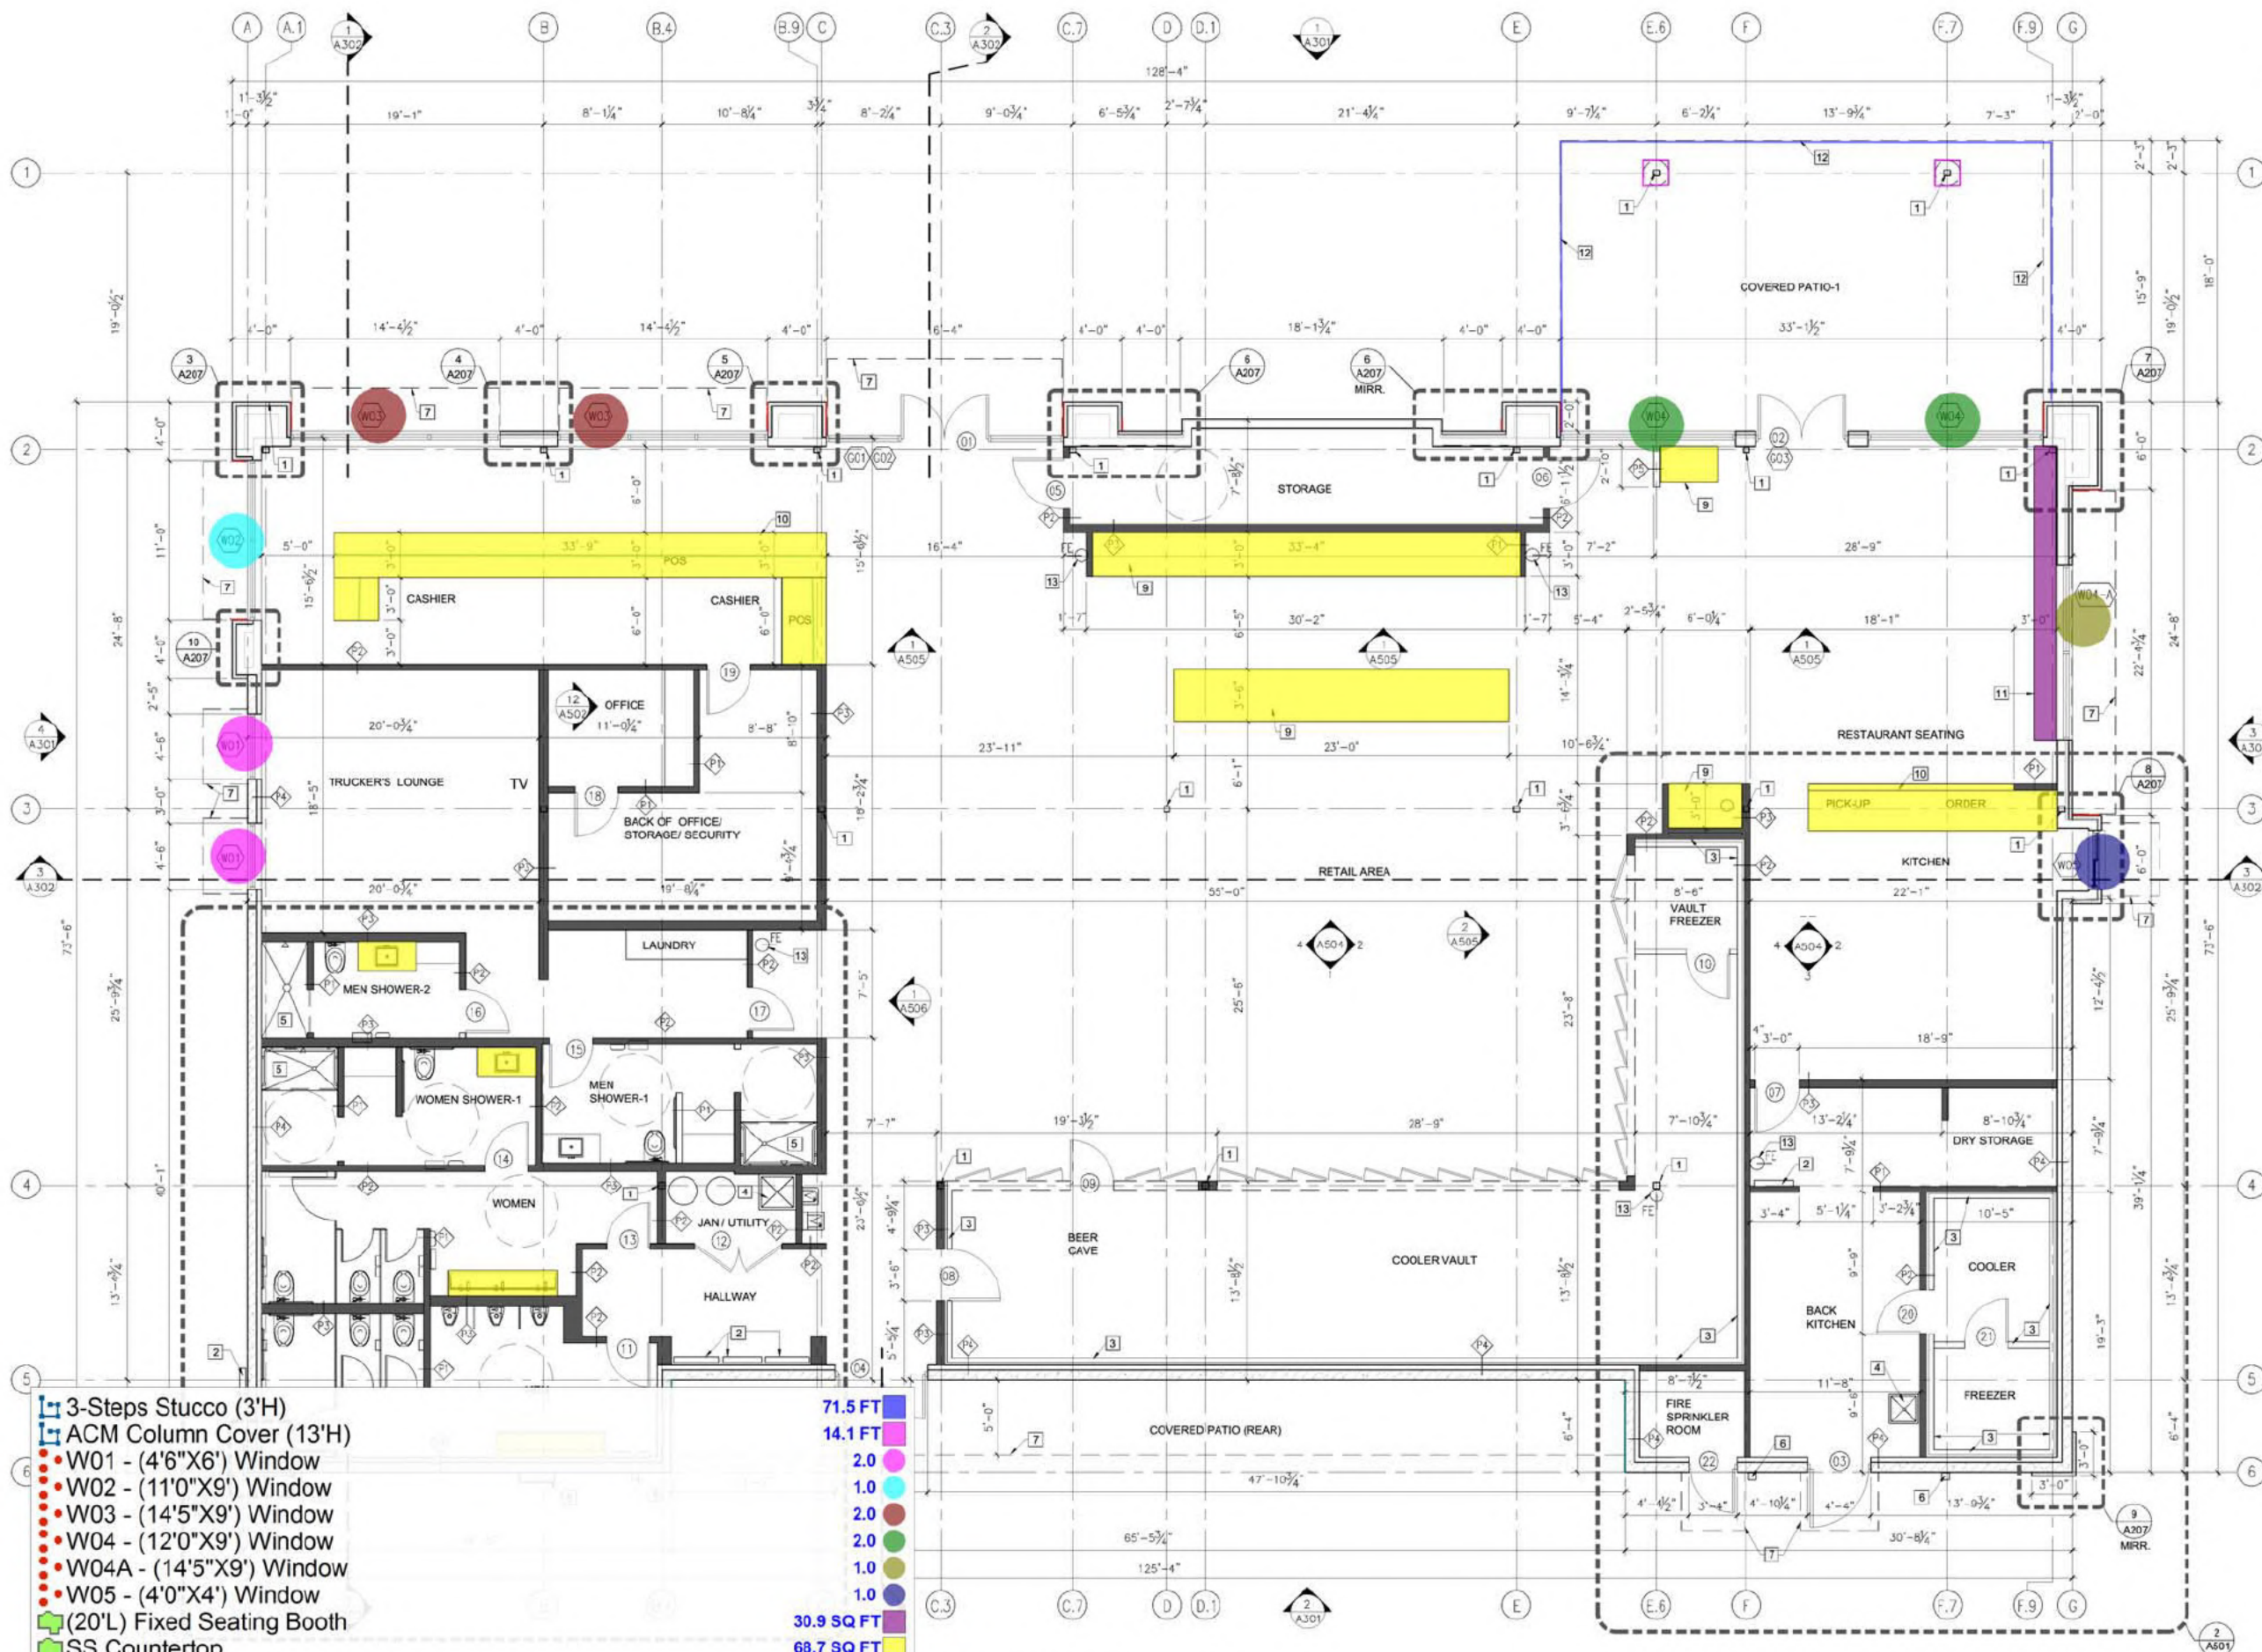

- PLAN NOTES**
- STEEL COLUMN; REFER STRUCTURAL DRGS. PAINT TO MATCH ADJ. WALL.
  - ELECTRICAL PANELS; REFER ELECTRICAL DRGS.
  - PRE-FABRICATED COOLER WALLS, CEILING, FLOOR, DOORS AND RACKS. MAINTAIN 2" AIR SPACE BETWEEN COOLER AND ADJACENT WALLS PER MANUFACTURER'S SPECS. CONTRACTOR TO FIELD VERIFY DIMENSIONS.
  - MOP SINK; REFERENCE PLUMBING DRGS.
  - SHOWER FLOOR LOCATION- REFER PLUMBING DRGS.
  - DOWNSPOUT LOCATION- REFER ELEVATION SHEETS.
  - AWNINGS ABOVE- REFER ELEVATION & DETAIL SHEETS (A301 & A406)
  - EXTERIOR ROOF LADDER LOCATION.
  - EQUIPMENT MILLWORK- REFER EQUIPMENT/ MILLWORK PLAN & SCHEDULE. REFER (A202 & A602).
  - POS MILLWORK- REFER MILLWORK SCHEDULE. REFER A602.
  - BOOTH SEATING - REFER EQUIPMENT/ MILLWORK PLAN & SCHEDULE.
  - PATIO ROOF ABOVE- REFER ROOF PLAN, ELEVATIONS, SECTIONS & DETAILS.
  - FIRE EXTINGUISHER: #10 CLASS ABC WITH UL RATING 4A-60BC. SURFACE MOUNTED ON WALL WITH MANUFACTURER'S ALL STEEL WALL BRACKET. J.I. INDUSTRIES INC. (COSMIC 10E) OR APPROVED EQUAL WITH INSPECTION TAG AS REQUIRED BY LOCAL CODES.

- PARTITION TYPES:**
- ONE LAYER 5/8" GYP. BD. ON EACH SIDE OF 3-5/8" MTL STUDS @ 16" O.C. EXTEND TO 1'-0" ABOVE CEILING LEVEL. SECURE PARTITION TO ROOF STRUCTURE ABOVE.
  - ONE LAYER 5/8" GYP. BD. EACH SIDE OF 3-5/8" METAL STUDS @ 16" O.C. W/ SOUND BATT INSULATION. EXTEND TO BOTTOM OF ROOF STRUCTURE.
  - ONE LAYER 5/8" GYP. BD. EACH SIDE OF 6" METAL STUDS @ 16" O.C. W/ SOUND BATT INSULATION. EXTEND TO THE BOTTOM OF ROOF DECK.
  - ONE LAYER OF 5/8" GYP. BD. ON FINISHED SIDE OF 3-5/8" FURRING METAL STUDS.
  - ONE LAYER 5/8" GYP. BD. ON EACH SIDE OF 3-5/8" MTL STUDS @ 16" O.C. TO 3'-0" A.F.F.

**GENERAL PARTITION NOTES:**  
 NOTE: USE 5/8" CEMENT BD. IN LIEU OF GYP. BD. IN ALL WET LOCATIONS.

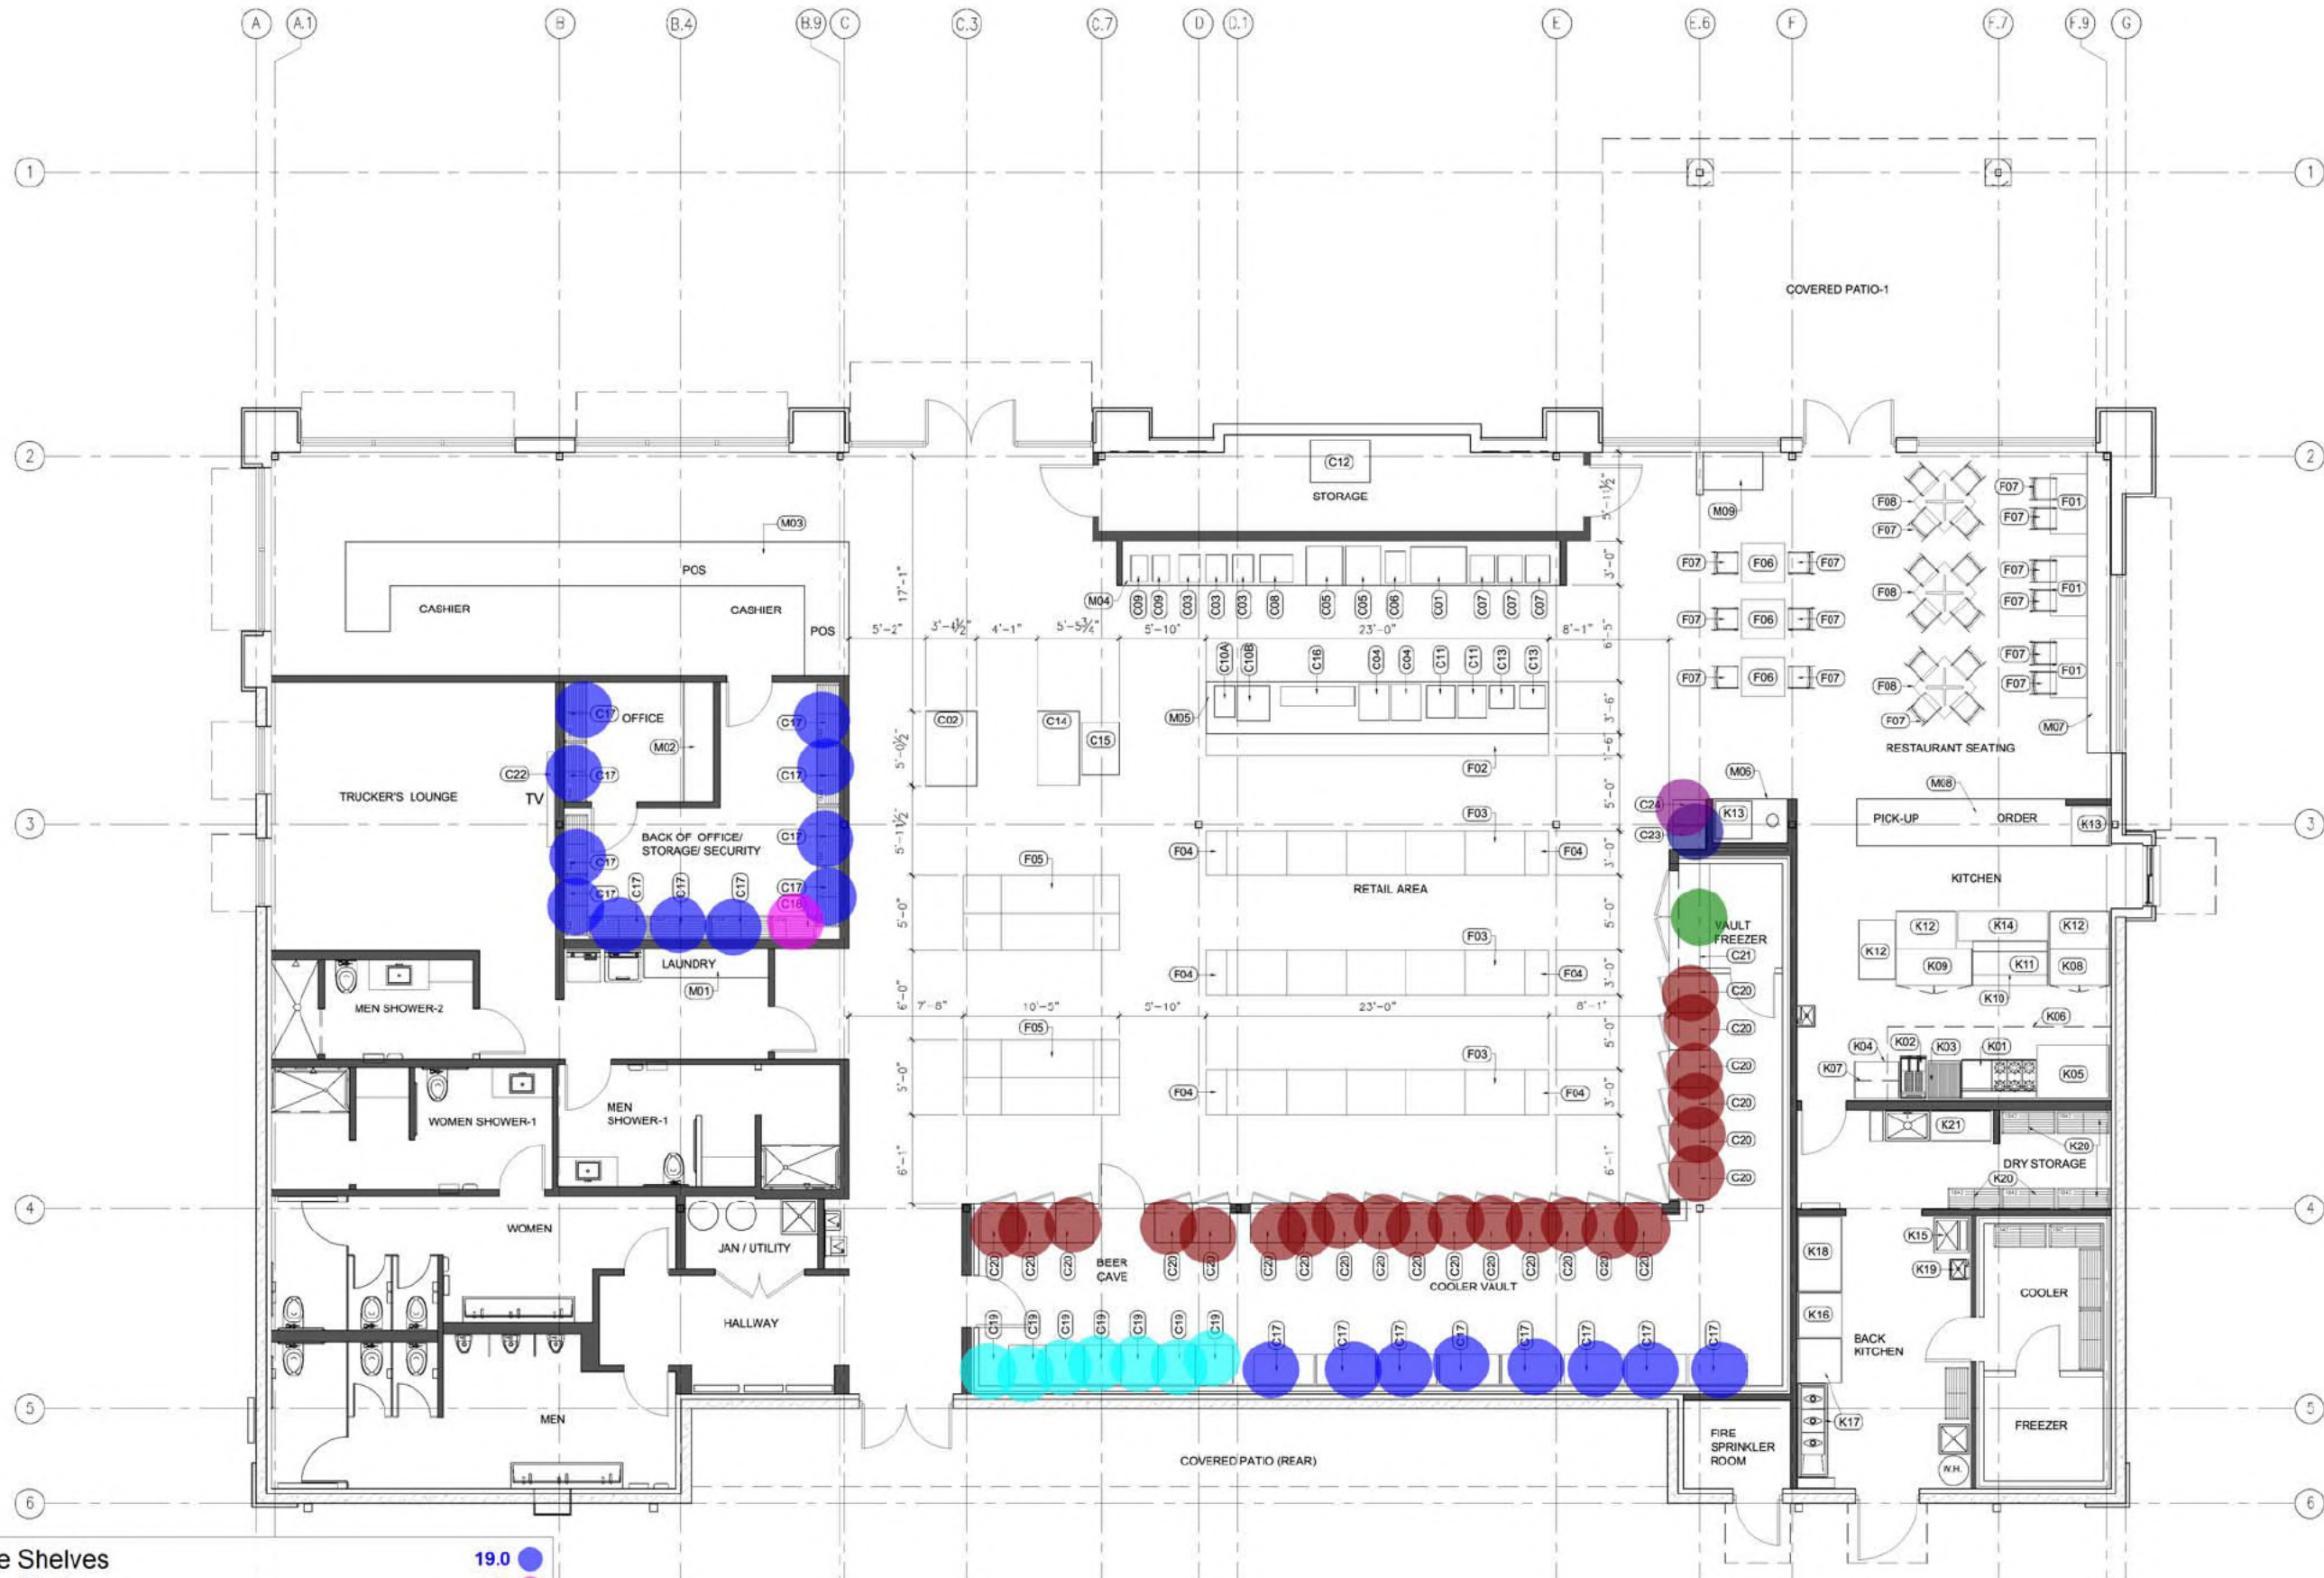


- 48" Storage Shelves
- 36" Storage Shelves
- 30"x30" Shelves
- Reach-In Pre-Fab Coolers
- Reach-In Pre-Fab Freezer
- ATM Machine
- Lottery Machine

- 19.0
- 1.0
- 7.0
- 22.0
- 1.0
- 1.0
- 1.0

1 EQUIPMENT/ MILLWORK/ FURNITURE PLAN  
A202 SCALE: 3/16"=1'-0"



NOTE: REFER TO SHEET A602 FOR EQUIPMENT, MILLWORK AND FIXTURE SCHEDULE

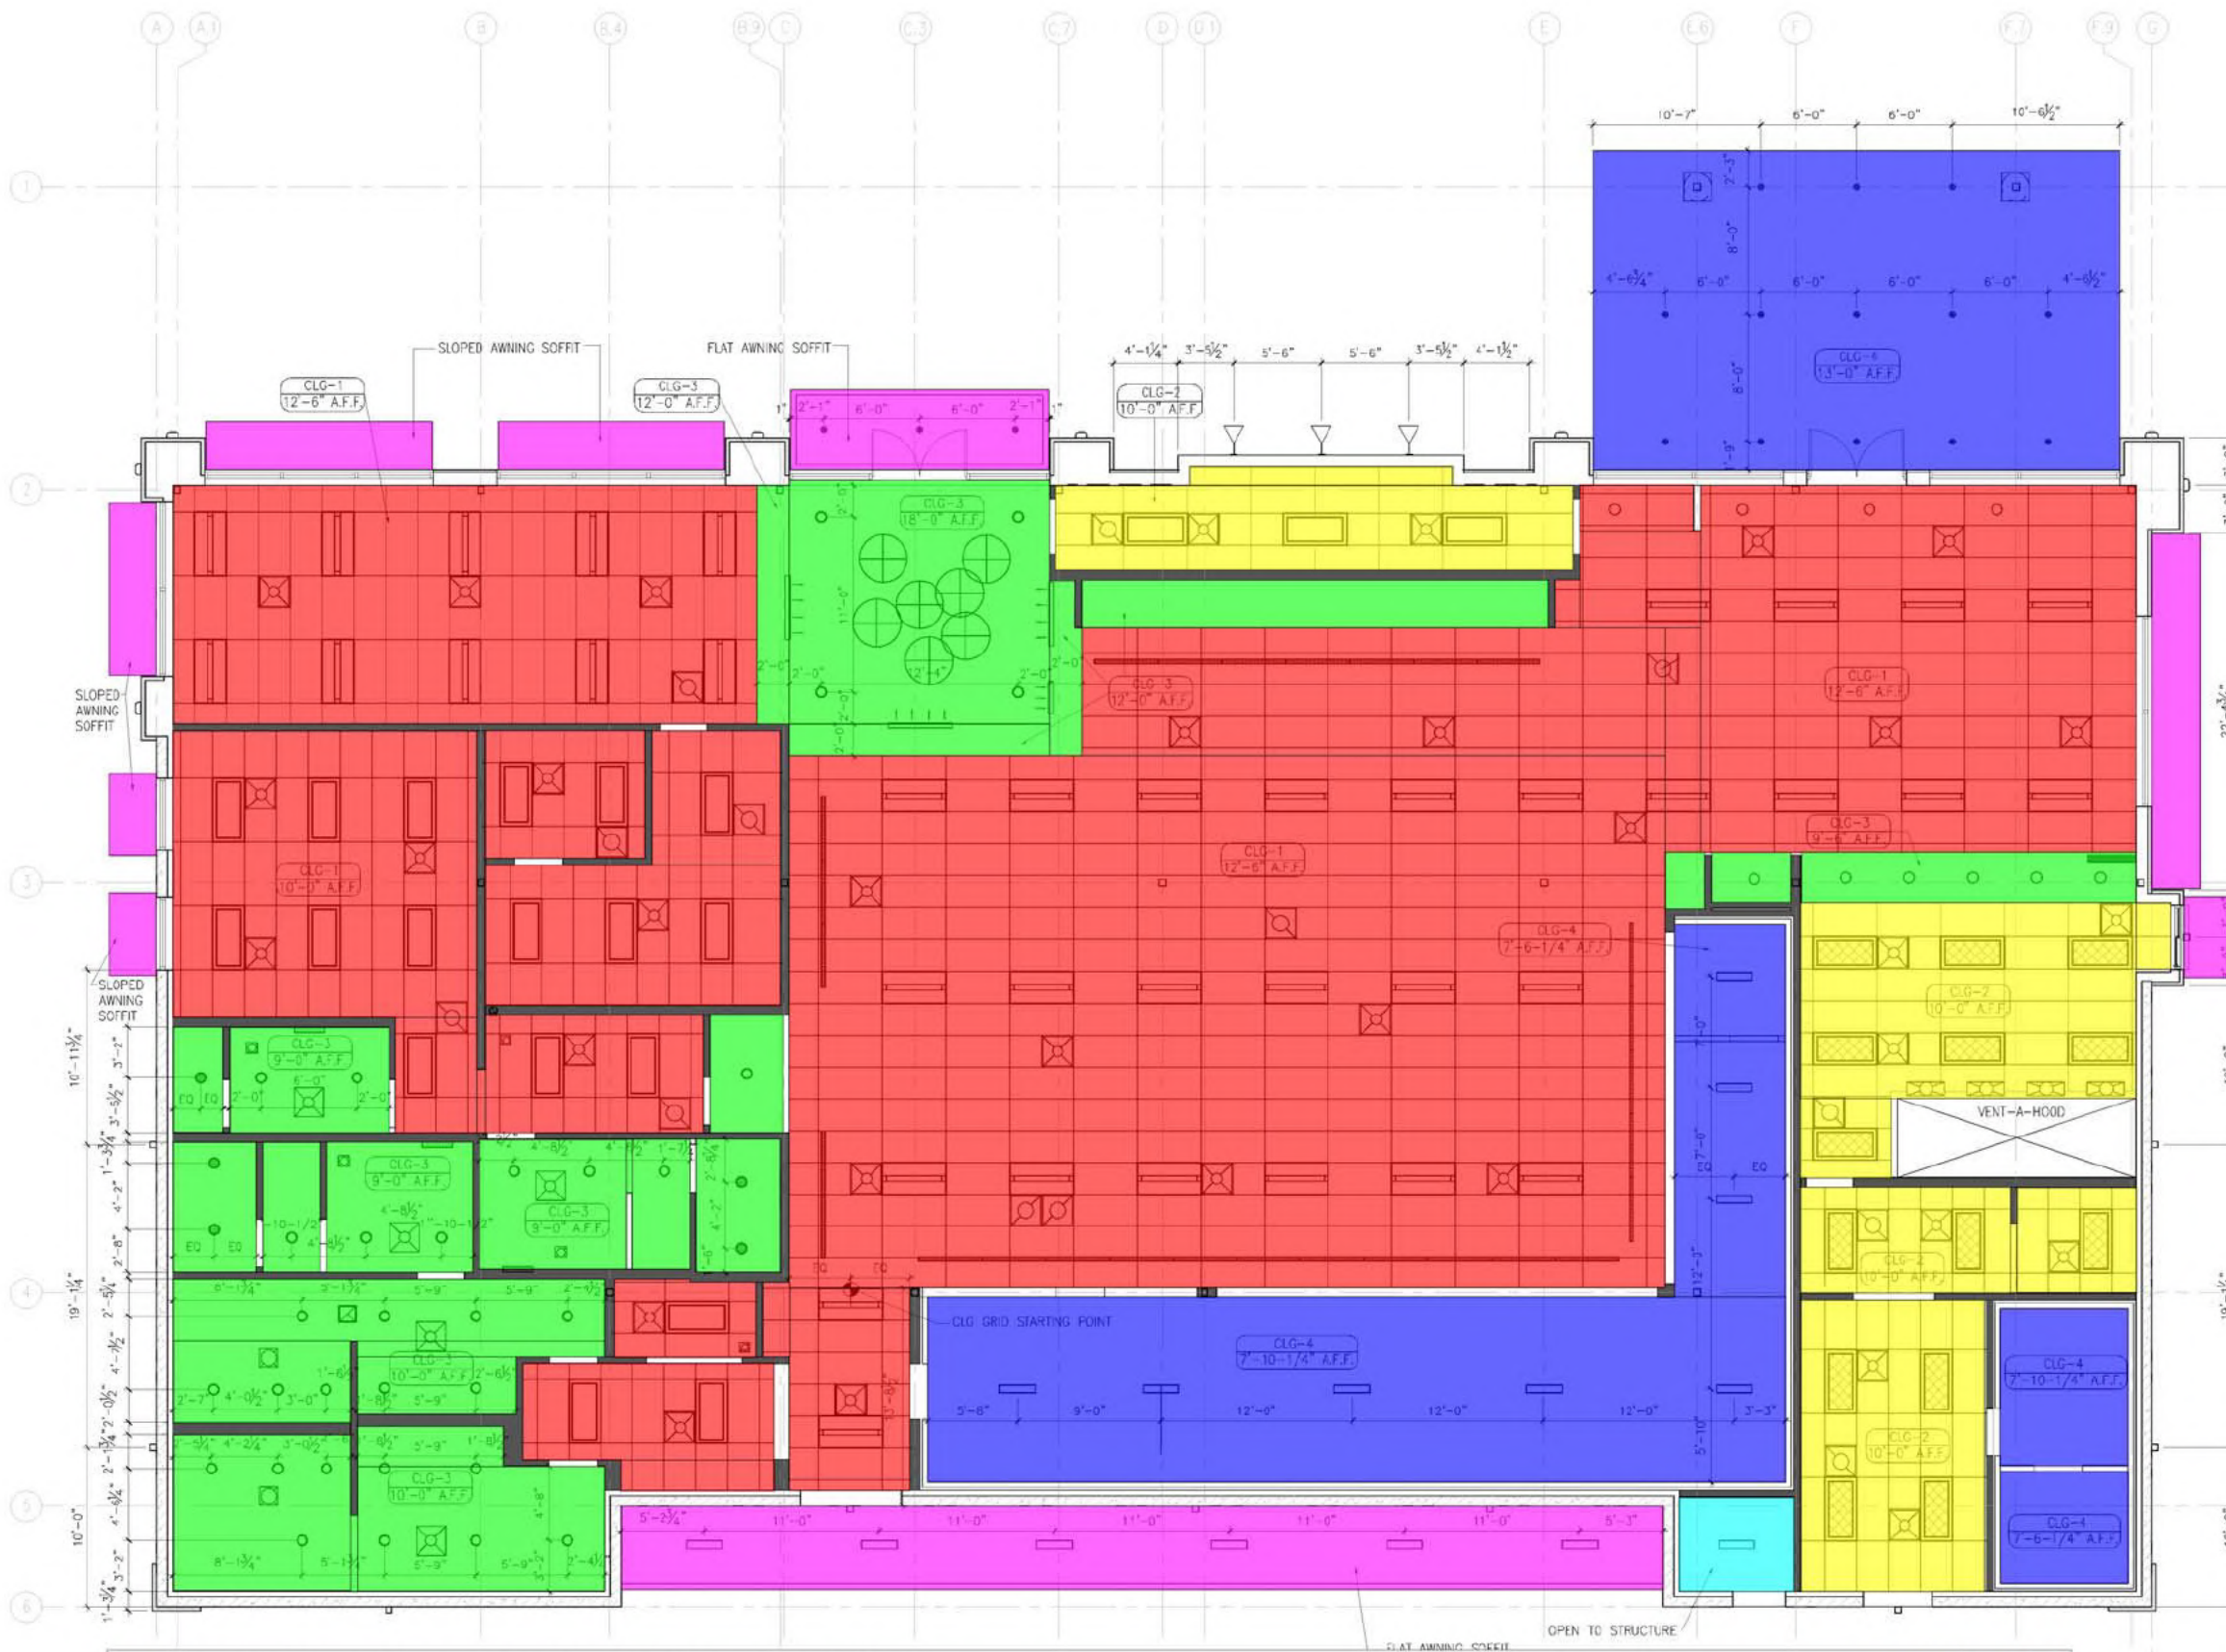


| CEILING PLAN LEGEND |                                                                                                          |
|---------------------|----------------------------------------------------------------------------------------------------------|
| SYMBOL              | DESCRIPTION AND MOUNTING HEIGHT                                                                          |
| ○                   | RECESSED CAN LIGHT FIXTURES                                                                              |
| ●                   | RECESSED CAN LIGHT FIXTURES FOR SHOWERS                                                                  |
| ⊕                   | DECORATIVE CHANDELIER<br>INSTALL BOTTOM OF FIXTURE AT 10'-0" A.F.F.                                      |
| ▭                   | RECESSED 2X4 LIGHT FIXTURE FOR RETAIL AREA                                                               |
| ▭                   | RECESSED 2X4 LIGHT FIXTURE FOR BACK AREAS                                                                |
| ▭                   | RECESSED 2X4 LIGHT FIXTURE FOR KITCHEN AREA                                                              |
| —                   | SPOT FIXTURES FOR GRAPHICS                                                                               |
| —                   | UTILITY LIGHT FOR COOLERS/<br>EXTERIOR SURFACE MOUNTED LIGHT<br>SURFACE MOUNTED LIGHT FOR SPRINKLER ROOM |
| —                   | VANITY LIGHT                                                                                             |
| •                   | EXTERIOR RECESSED LIGHT                                                                                  |
| —                   | EXTERIOR WALL SCONCE                                                                                     |
| —                   | EXTERIOR WALL MOUNTED BRACKET FIXTURE                                                                    |
| ⊗                   | NEW CEILING HVAC SUPPLY DIFFUSER                                                                         |
| ⊙                   | NEW CEILING HVAC RETURN DIFFUSER                                                                         |
| —                   | NEW CEILING GRID AND 2'X4'<br>VINYL COATED ACOUSTICAL CEILING TILES                                      |
| —                   | NEW GYPSUM BOARD CEILING                                                                                 |
| —                   | CUSTOM FREEZER/ COOLER CEILING<br>UNLESS NOTED OTHERWISE.                                                |

NOTE:  
REFER TO MEP DRAWINGS FOR ALL LIGHTING FIXTURES  
CONTACT: TOM HALVERSON  
@ ARCHITECTURAL LIGHTING ALLIANCE  
PHONE# (817) 863-0603  
(214) 658-9000


- CLG-1 - 24x48 dune second look (#2712) - Armstrong
- CLG-3 - 24x48 high washability - Georgian (#793) - Arm Strong
- CLG-2 - GWB Ceiling
- CLG-4 - Custom Cooler/Freezer Ceiling - Amerikooler
- AWNING
- EXPOSED STRUCTURE PAINT

4,479.8 SQ FT  
1,404.5 SQ FT  
841.0 SQ FT  
1,592.8 SQ FT  
658.5 SQ FT  
42.8 SQ FT



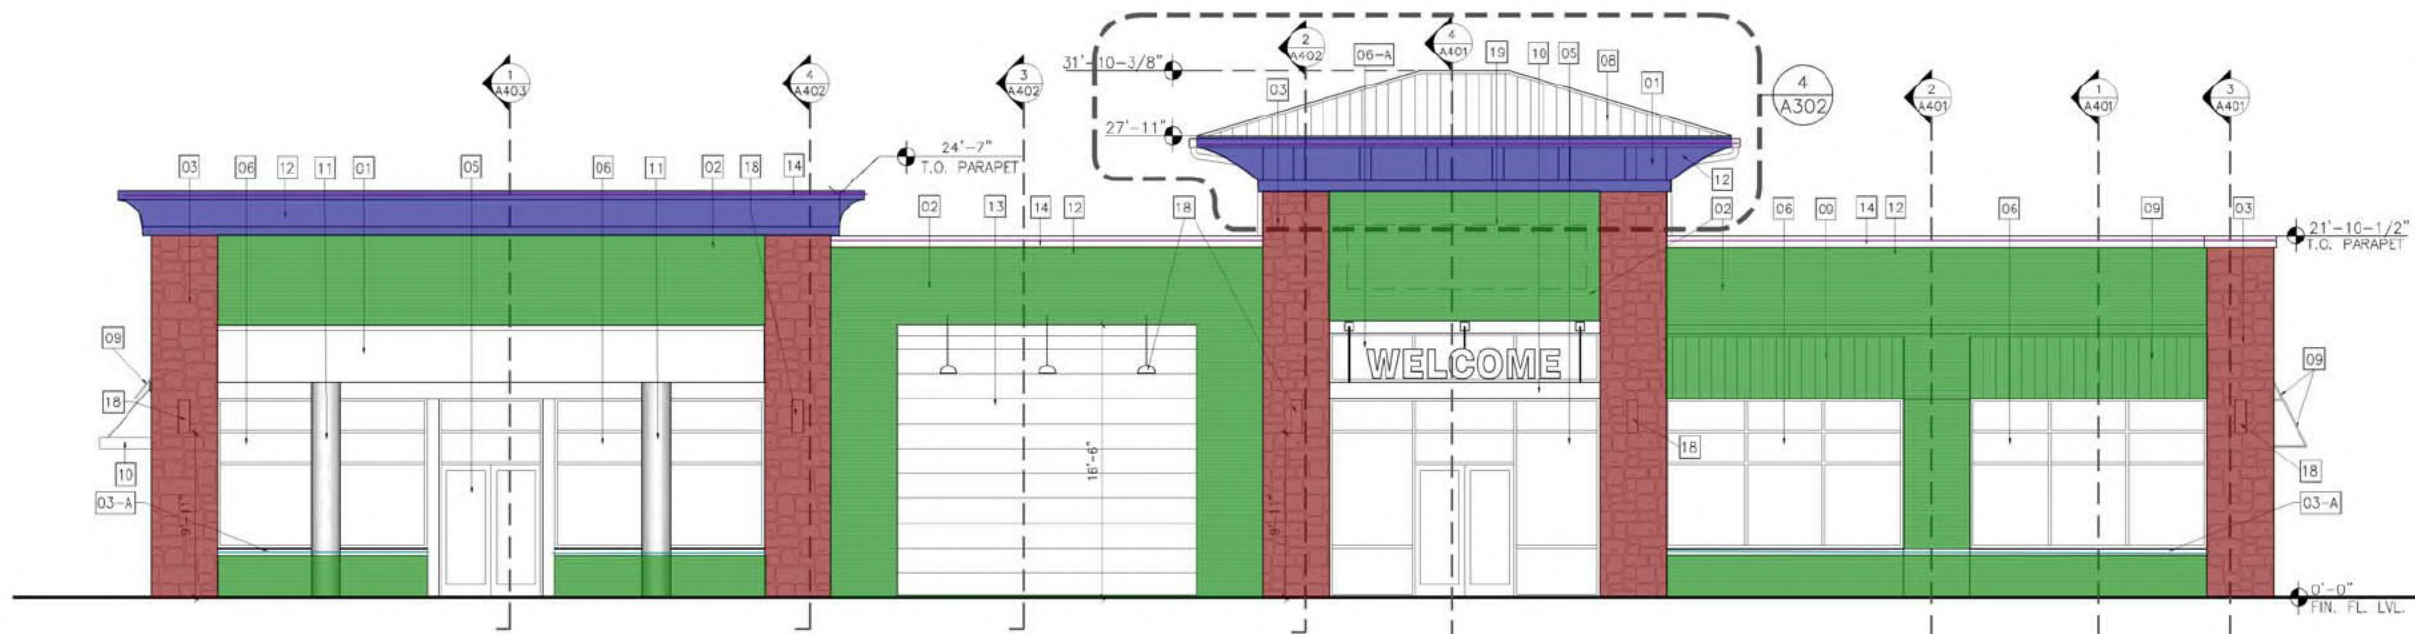

1 NORTH ELEVATION  
A301  
SCALE: 3/16"=1'-0"

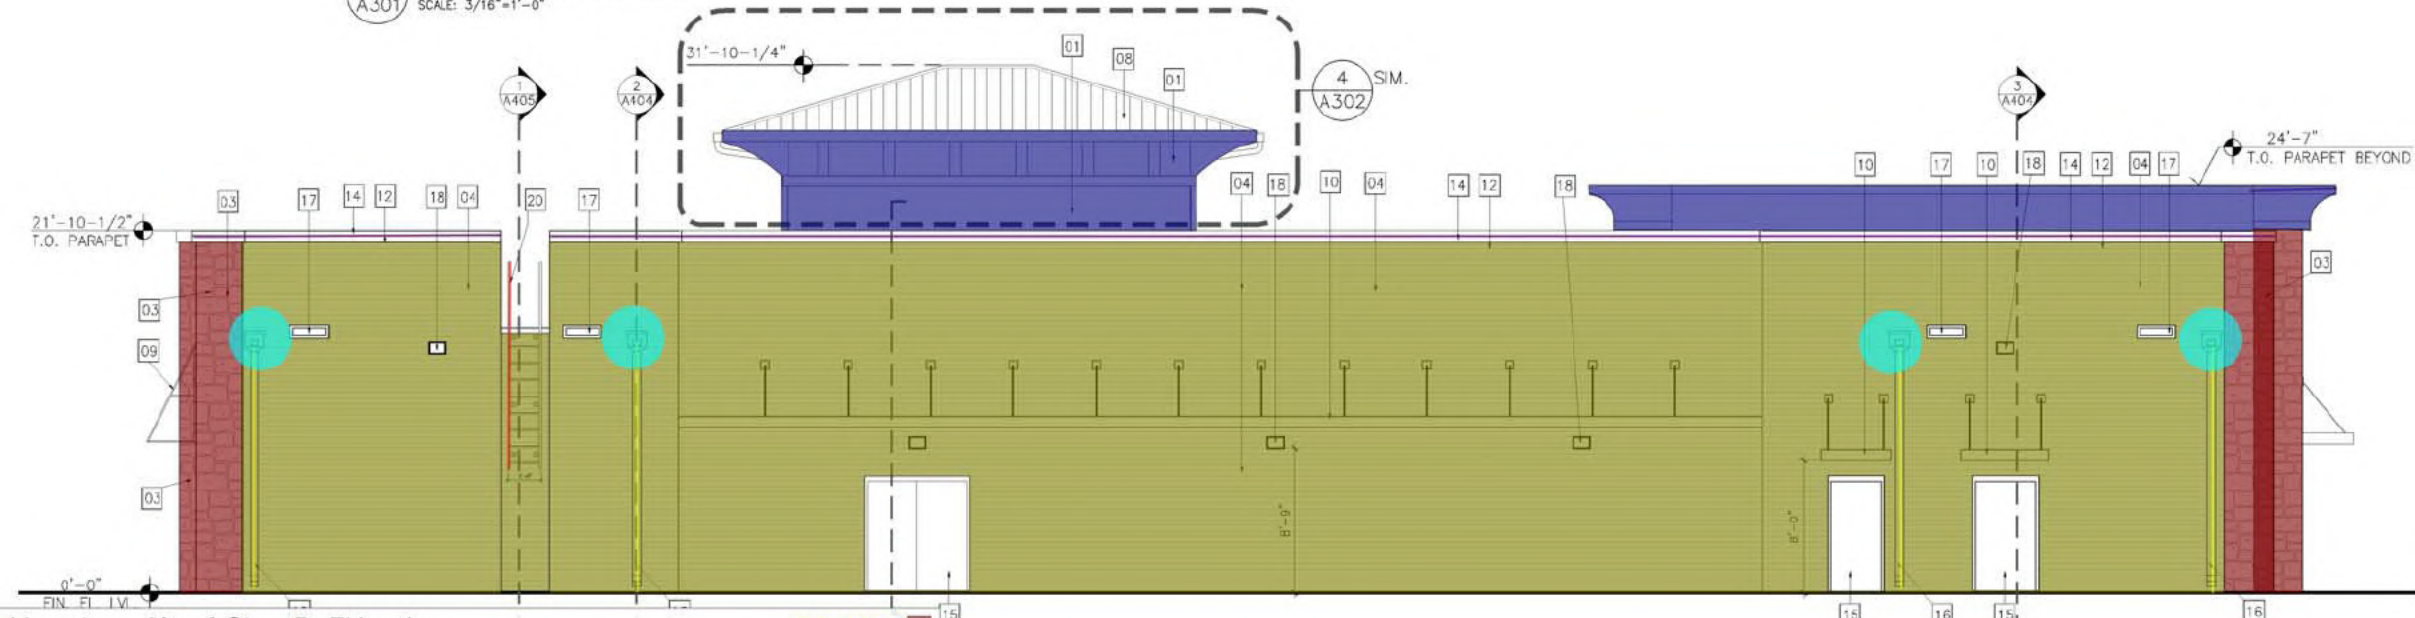


3 EAST ELEVATION  
A301  
SCALE: 3/16"=1'-0"

- Lime stone - Manuf. Stone By Eldorado
- Acme Brick - King Size - CloudCroft
- Spec-Brick by Concrete Products Group. - 4"x16" face w/ 8" Depth
- EIFS
- Prefinished Metal Coping
- stone cap - Stone By Laticrete
- Exterior Mtd Roof Ladder
- Downspout
- 12"X8" Scupper

- 1,233.7 SQ FT
- 2,601.2 SQ FT
- 3,192.2 SQ FT
- 773.3 SQ FT
- 447.7 FT
- 92.1 FT
- 12.6 FT
- 59.0 FT
- 4.0


5 MIRR.  
A302

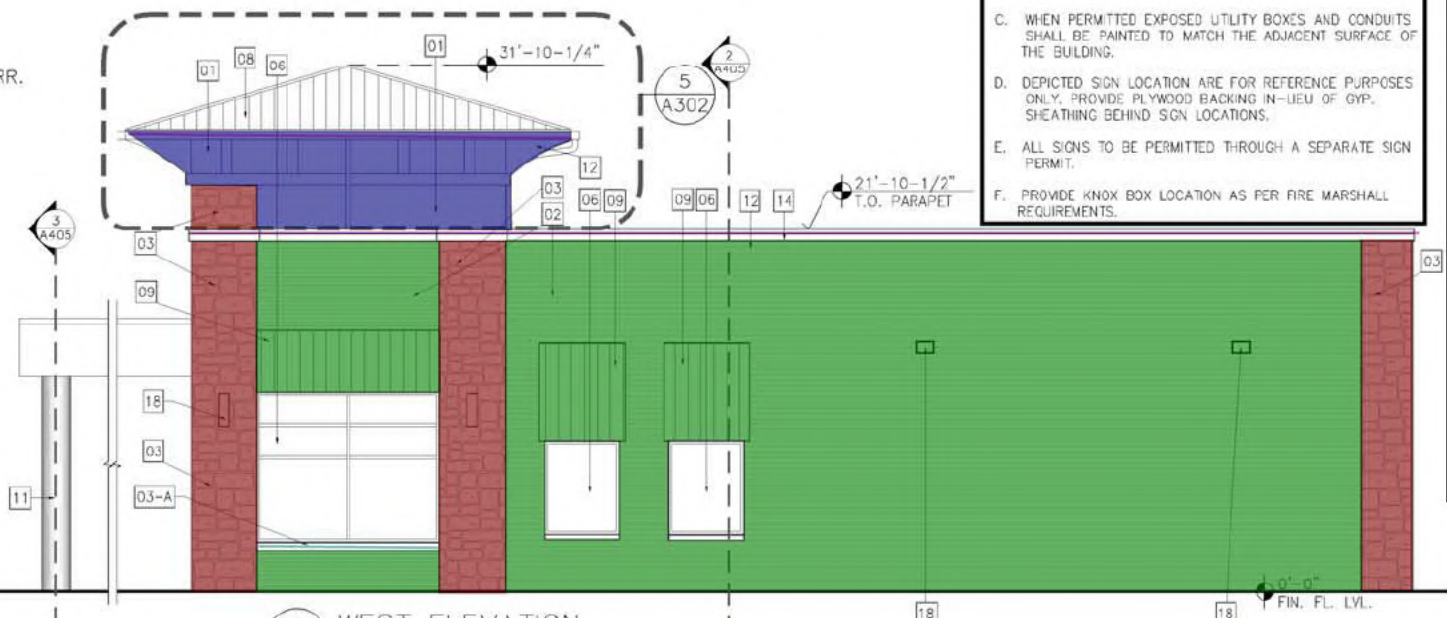

4 WEST ELEVATION  
A301  
SCALE: 3/16"=1'-0"


| ELEVATION MATERIAL KEY |                                                                                                                                                                                             |
|------------------------|---------------------------------------------------------------------------------------------------------------------------------------------------------------------------------------------|
| 01                     | 3 STEP STUCCO<br>COLOR: EQUAL TO SHERWIN WILLIAMS                                                                                                                                           |
| 02                     | ACME BRICK- KING SIZE<br>COLOR: CLOUDCROFT                                                                                                                                                  |
| 02-A                   | GROUT COLOR FOR BRICK BY LATICRETE<br>COLOR: #90 LIGHT PEWTER                                                                                                                               |
| 03                     | MANUFACTURED STONE BY EL DARADO<br>TYPE: LIME STONE<br>COLOR: YORK                                                                                                                          |
| 03-A                   | GROUT COLOR FOR STONE BY LATICRETE<br>COLOR: #59 ESPRESSO                                                                                                                                   |
| 03-A                   | EL DARADO WATERTABLE/ SILL PIECE<br>COLOR:                                                                                                                                                  |
| 04                     | SPEC-BRICK BY CONCRETE PRODUCTS GROUP<br>COLOR: CHESAPEAKE BLEND<br>4"x16" FACE WITH 8" DEPTH<br>USE INTEGRAL WATER REPELLENT IN UNITS & MORTAR<br>PER NOMA GUIDELINES FOR HALF HIGH UNITS  |
| 05                     | ALUMINUM STOREFRONT BY KAWNEER TR-FAB 451<br>OR EQUAL, COLOR: BRONZE                                                                                                                        |
| 06                     | ALUMINUM STOREFRONT WINDOWS<br>BY KAWNEER TR-FAB 451<br>OR EQUAL, COLOR: BRONZE<br>WITH 1" INSULATED GUARDIAN SUNGUARD<br>SNX51/23 CLEAR-CLEAR GLASS WITH<br>U- VALUE (0.29) S.H.G.C (0.23) |
| 06-A                   | 06 WITH SPANDREL GLASS                                                                                                                                                                      |
| 07                     | DRIVE THRU WINDOW BY QUICK SERV<br>PER SCHEDULE                                                                                                                                             |
| 08                     | STANDING SEAM METAL ROOFING<br>MANUFACTURER: MBCI<br>PRODUCT: SUPERLOK<br>COLOR: SERIES 300 - SILVER METALLIC                                                                               |
| 09                     | SLOPED METAL AWNING W/ STANDING SEAM PANEL<br>COLOR:                                                                                                                                        |
| 10                     | FLAT METAL AWNING W/ HANG RODS<br>COLOR:                                                                                                                                                    |
| 11                     | ACM ROUND METAL COLUMN COVER BY NORTH CLAD<br>COLOR: TBD                                                                                                                                    |
| 12                     | EIFS FINISH OVER FOAM SHAPED TRIM REFER DETAILS<br>COLOR:                                                                                                                                   |
| 13                     | NICHIHA ARCHITECTURAL BLOCK PANEL<br>COLOR: TUSCAN                                                                                                                                          |
| 14                     | PREFINISHED METAL COPING<br>COLOR: MBCI SILVER METALLIC                                                                                                                                     |
| 15                     | INSULATED HOLLOW METAL DOOR PER SCHEDULE<br>COLOR:                                                                                                                                          |
| 16                     | 6" SQ. DOWNSPOUT (TYPICAL)<br>COLOR: PAINTED TO MATCH ADJACENT BRICK                                                                                                                        |
| 17                     | 12"x8" OVERFLOW ROOF SCUPPER (TYPICAL)<br>COLOR: PAINTED TO MATCH ADJ. BRICK                                                                                                                |
| 18                     | EXTERIOR LIGHT FIXTURES- REFER ELECTRICAL DRGS<br>MOUNTING HT. AS SHOWN ON ELEVATIONS                                                                                                       |
| 19                     | SIGN LOCATION SHOWN AS DASHED                                                                                                                                                               |
| 20                     | EXTERIOR MOUNTED ROOF LADDER                                                                                                                                                                |
| 21                     | GUTTER & DOWNSPOUT FOR SLOPED TOWER ROOF                                                                                                                                                    |

- NOTES
- INSTALLATION OF EVERY BUILDING MATERIAL SHALL BE PER ITS MANUFACTURER'S LATEST SPECIFICATIONS AND INSTALLATION GUIDELINES.
  - USE TYVEK COMMERCIAL WRAP FOR WEATHER BARRIER OR EQUAL.
  - WHEN PERMITTED EXPOSED UTILITY BOXES AND CONDUITS SHALL BE PAINTED TO MATCH THE ADJACENT SURFACE OF THE BUILDING.
  - DEPICTED SIGN LOCATION ARE FOR REFERENCE PURPOSES ONLY. PROVIDE PLYWOOD BACKING IN-UEU OF GYP. SHEATHING BEHIND SIGN LOCATIONS.
  - ALL SIGNS TO BE PERMITTED THROUGH A SEPARATE SIGN PERMIT.
  - PROVIDE KNOX BOX LOCATION AS PER FIRE MARSHALL REQUIREMENTS.

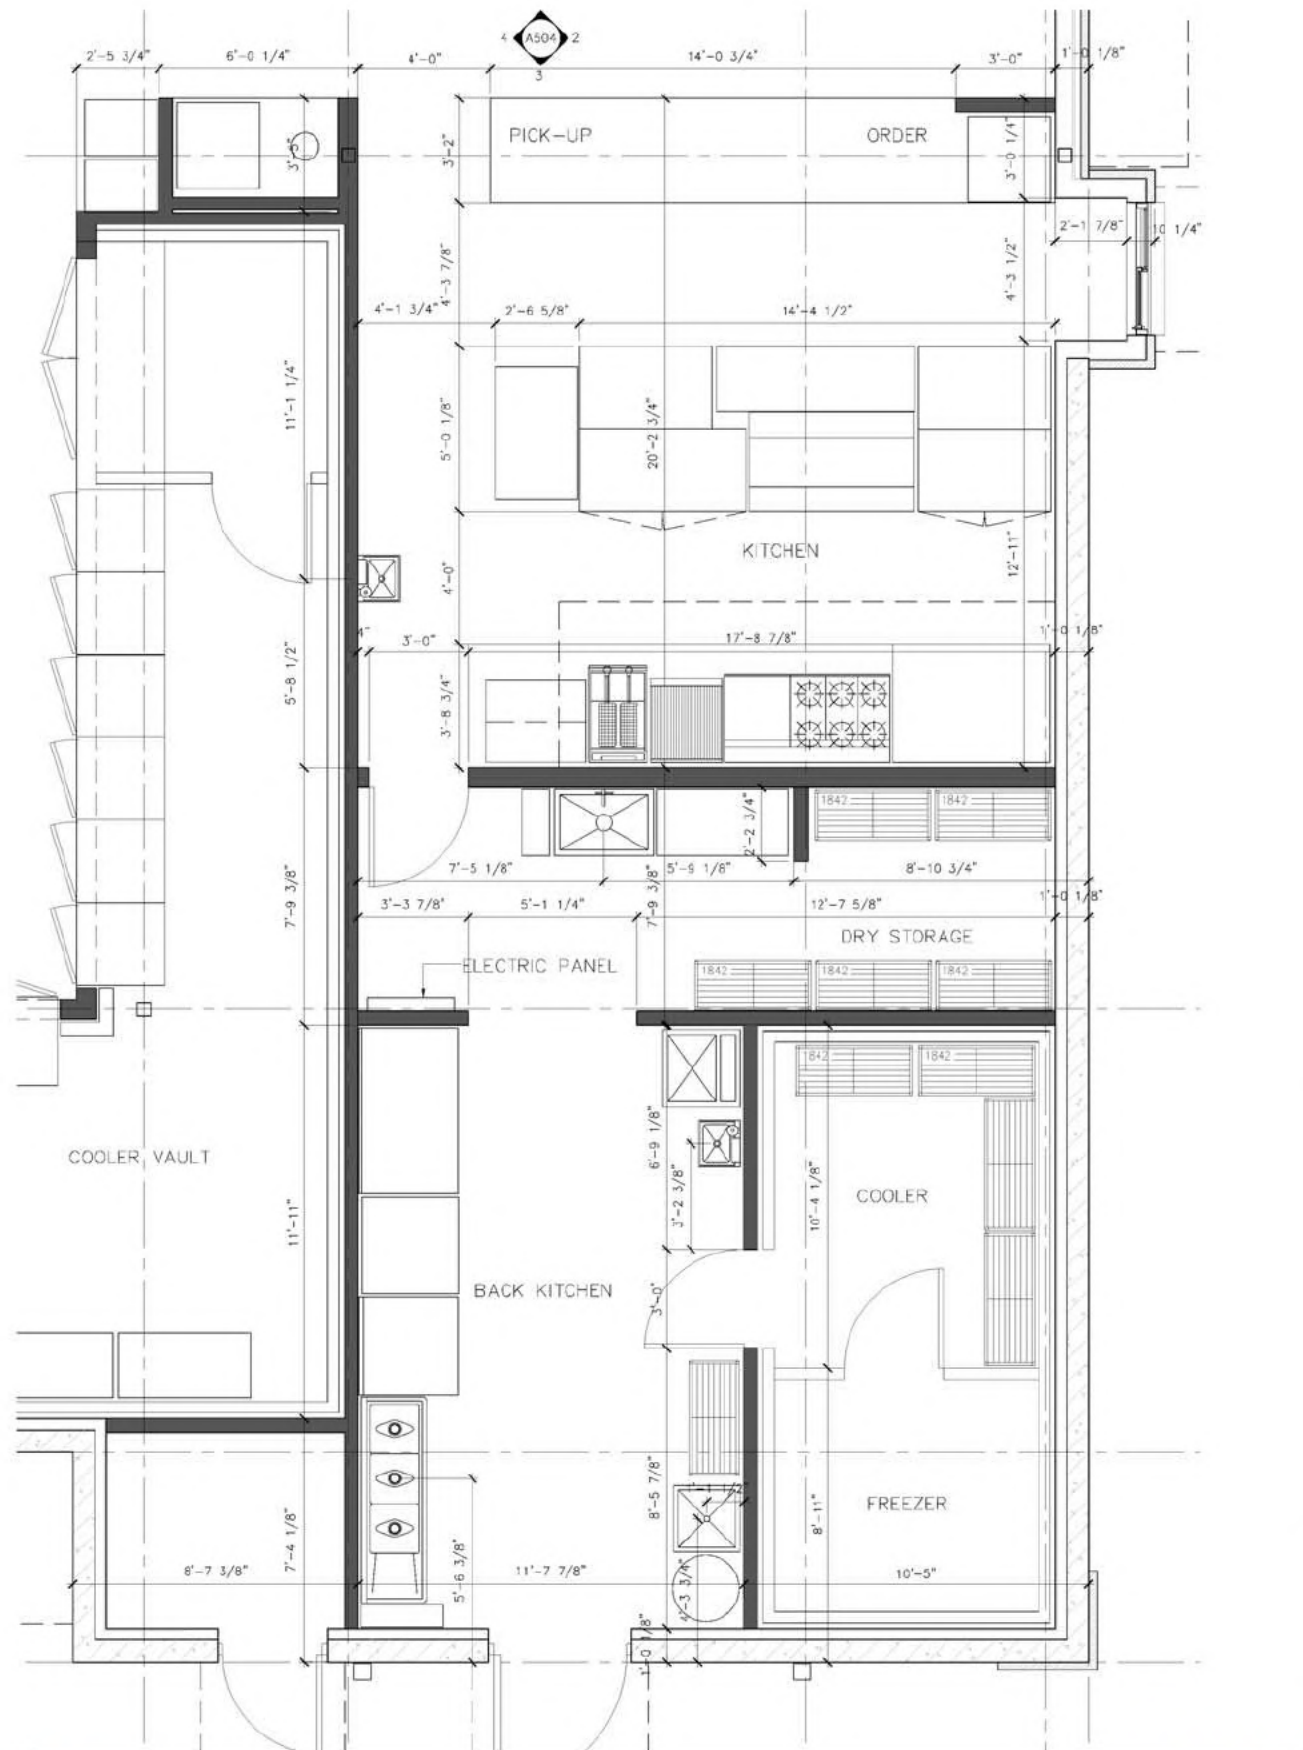

-  Toilet Partition
-  Urinal Screen
-  WT-2 - Wall Tile (9'h)
-  SS Countertop

41.1 FT  
3.0 FT  
54.9 FT  
16.7 SQ FT

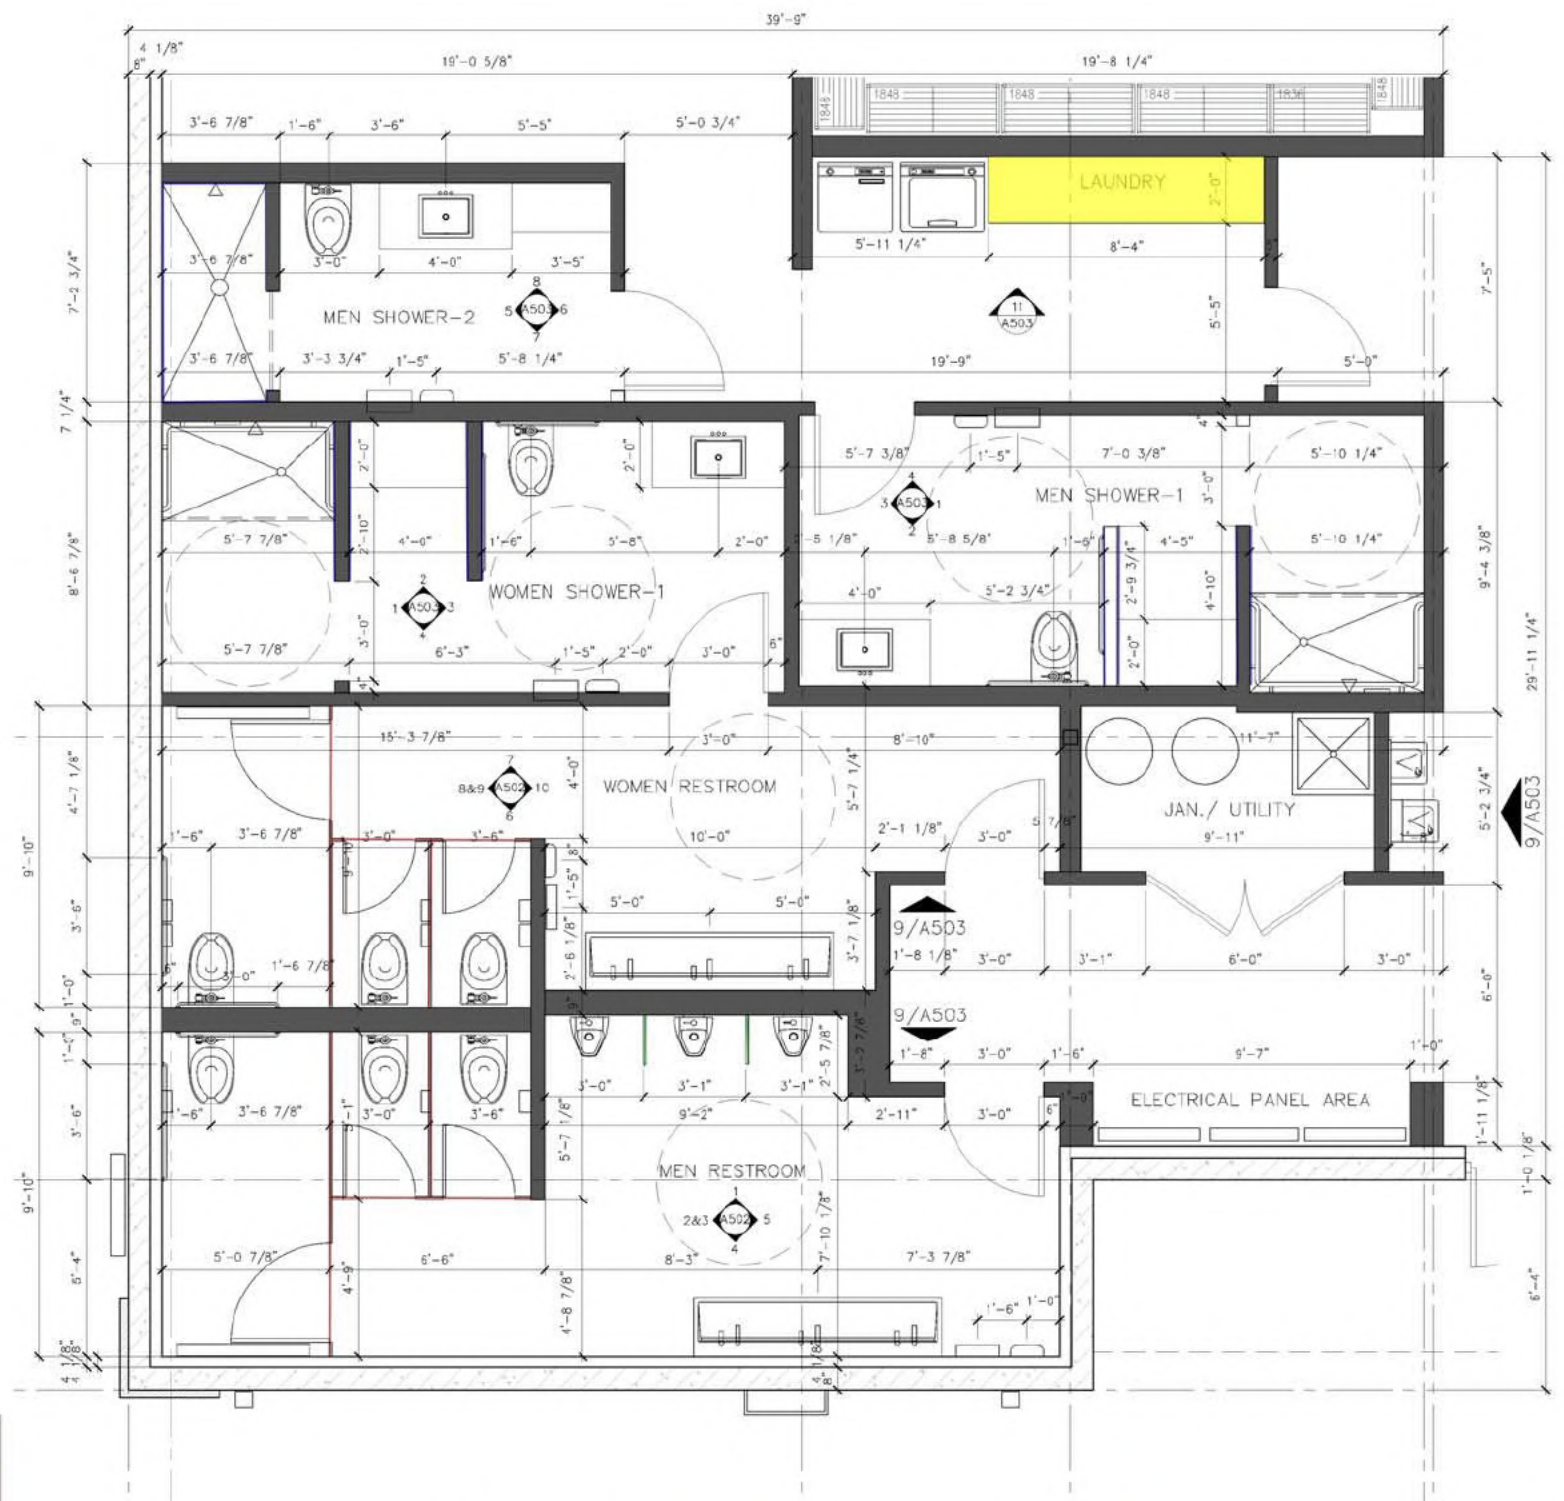

1 ENLARGED RESTROOM/ SHOWER PLAN  
A501 SCALE: 3/8"=1'-0"

NOTE: REFER TO TAS REFERENCE SHEETS A004 & A005 & FOR GUIDELINES TO COMPLIANT INSTALLATIONS

| RESTROOM ACCESSORIES SCHEDULE |                                                                |                  |                                                                 |                                          |
|-------------------------------|----------------------------------------------------------------|------------------|-----------------------------------------------------------------|------------------------------------------|
| MARK                          | ITEM DESCRIPTION                                               | MANUFACTURER     | MODEL NO.                                                       | REMARKS                                  |
| A                             | 36" GRAB BAR - BACK                                            | BRADLEY          | 8120-001360                                                     | TOP OF GRAB BAR MOUNTING 3'-0" A.F.F.    |
| B                             | 42" GRAB BAR - SIDE                                            | BRADLEY          | 8120-001420                                                     | TOP OF GRAB BAR MOUNTING 3'-0" A.F.F.    |
| C                             | MIRROR CHANNEL FRAME 24" X 48"                                 | BRADLEY          | 781-024480                                                      | BOT. OF MIRROR 40" MAX A.F.F.            |
| D                             | HAND DRYER, SENSOR, SS, SURFACE MOUNTED                        | BRADLEY          | 2902-287400                                                     | DISPENSER OPENING 48" MAX. A.F.F.        |
| E                             | AUTOMATIC L.Q. SOAP DISPENSER (27 OZ)                          | BRADLEY          | 6400-110000                                                     |                                          |
| F                             | DUAL SURFACE MOUNTED TOILET TISSUE DISPENSER                   | BRADLEY          | 5402-000000                                                     | TISSUE DISPENSING HT 2'-0" A.F.F.        |
| G                             | RECESSED PAPER TOWEL & WASTE DISPENSER, 16 GALLON              | BRADLEY          | 234-000000                                                      | DISPENSER HEIGHT 48" MAX. A.F.F.         |
| H                             | SURFACE MOUNT SANITARY NAPKIN DISPOSAL W/ COVER                | BRADLEY          | 4781-110000                                                     | TOP OF DISPENSER 31" MAX. A.F.F.         |
| I                             | FLOOR MOUNTED-OVERHEAD BRACED TOILET PARTITIONS                | SENTINEL BRADMAR | SERIES 400; CANYON GRANITE-M244                                 |                                          |
| J                             | URINAL SCREEN                                                  | SENTINEL BRADMAR | SERIES 400; CANYON GRANITE-M244                                 |                                          |
| K                             | BABY CHANGER, RECTANGULAR, CREAM                               | BRADLEY          | 9632-000000                                                     | CHANGING SURFACE TO BE 28" TO 32" A.F.F. |
| L                             | ADA SHOWER & CONTROLS                                          | BRADLEY          | 1C-EF-ES1-B24-DV                                                | CONTROLS @ 48" MAX. A.F.F.               |
| M                             | SHOWERS & CONTROLS                                             | BRADLEY          | 1C-EF-ES1                                                       |                                          |
| N                             | ADA SHOWER GRAB BARS                                           | BRADLEY          | MODEL-800 SERIES                                                | CONFIGURATION STYLE = 060                |
| O                             | SHOWER CURTAIN RODS                                            | BRADLEY          | MODEL-9538 SERIES ( 36" / 60")                                  | INSTALL @ 7'-0" MAX. A.F.F.              |
| P                             | SURFACE MOUNT, FOLDED PAPER TOWEL DISPENSER                    | BRADLEY          | 250-150000                                                      | TOP OF DISPENSER AT 54" A.F.F.           |
| Q                             | INTEGRATED TRIPLE LAVATORY WITH FAUCETS & SOAP DISPENSERS      | BRADLEY          | LVA03 MYKONS WITH ZEN SERIES SOAP AND FAUCET IN POLISHED CHROME |                                          |
| R                             | UNDERMOUNT RECTANGULAR LAVATORY WITH SILESTONE (SS) COUNTERTOP |                  |                                                                 |                                          |


NOTE:  
1. COORDINATE WITH OWNER FOR FINAL PLUMBING FIXTURE & ACCESSORY SELECTIONS AND PURCHASE.  
2. CONTACT : Yong Clark ( Business Development Manager) M 913-293-9108; E-MAIL: Yong.Clark@bradleycorp.com




1 MEN RESTROOM ELEV  
A502 SCALE: 3/8"=1'-0"

2 MEN RESTROOM ELEV  
A502 SCALE: 3/8"=1'-0"


3 MEN RESTROOM ELEV  
A502 SCALE: 3/8"=1'-0"

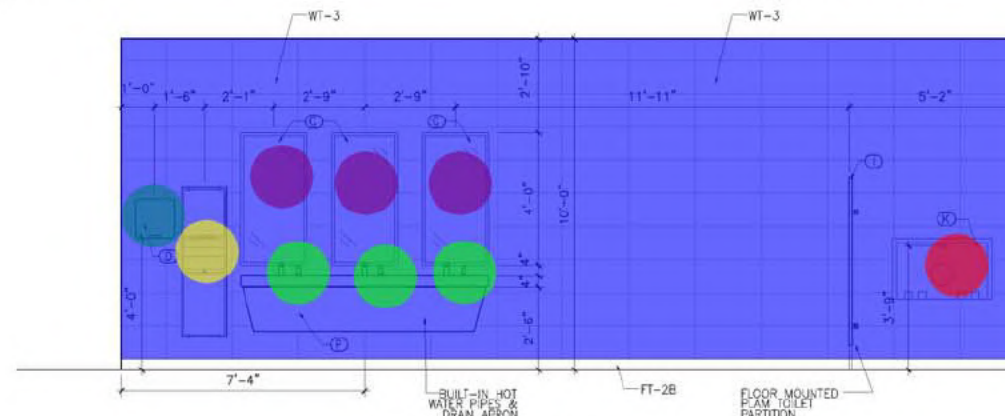


4 MEN RESTROOM ELEV  
A502 SCALE: 3/8"=1'-0"

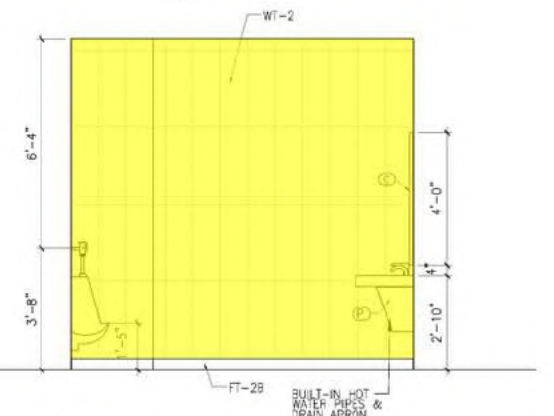


5 MEN RESTROOM ELEV  
A502 SCALE: 3/8"=1'-0"

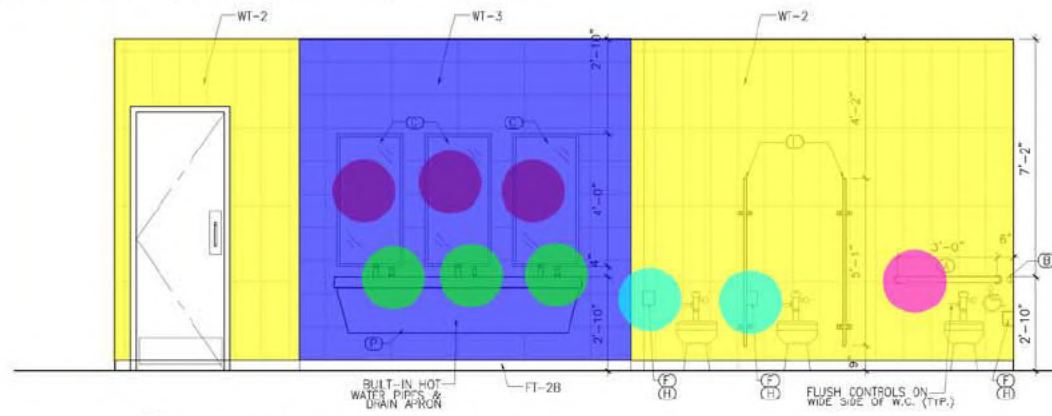


6 WOMEN RESTROOM ELEV  
A502 SCALE: 3/8"=1'-0"

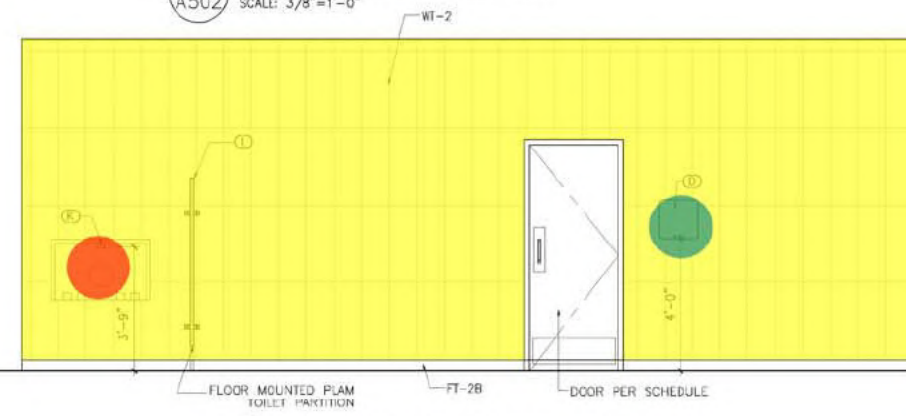

7 WOMEN RESTROOM ELEV  
A502 SCALE: 3/8"=1'-0"

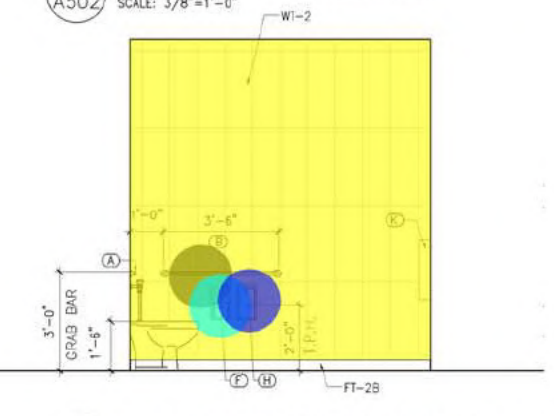

8 WOMEN RESTROOM ELEV  
A502 SCALE: 3/8"=1'-0"

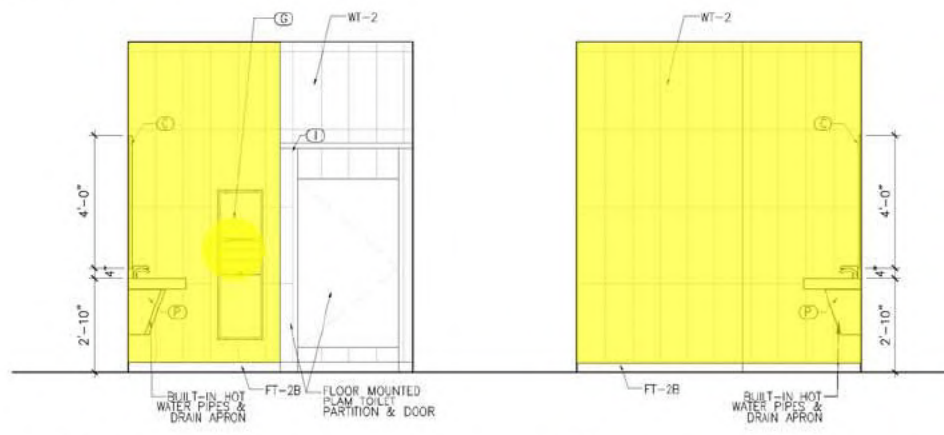

9 WOMEN RESTROOM ELEV  
A502 SCALE: 3/8"=1'-0"



10 WOMEN RESTROOM ELEV  
A502 SCALE: 3/8"=1'-0"

- WT-2 - Wall Tile - Dimens breeze Blanco - 2 (Polished (10x28) - Floor & De... 1,088.7 SQ FT
- WT-3 - Wall Tile - Soho MulBerry-2 Polished (12x24) - Floor & Decore 360.6 SQ FT
- A - Acc - 36" Grab Bar - Bradley - 8120-001360 2.0
- F - Acc - Dual SurfaceMtd Toilet Tissue Dispenser - Bradley - 5402-000000 6.0
- B - Acc - 42" Grab Bar - Bradley - 8120-001420 2.0
- C - Acc - Mirror Channel Frame 24x48 - Bradley - 781-024480 6.0
- D - Acc - HAnd Dryer - Bradley - 2902-287400 2.0
- K - Acc - Baby Changer - Bradley - 9632-000000 2.0
- Soap Dispenser 6.0
- G - Acc - Recessed Paper Towel & Waster Dispenser - Bradley - 234-000000 2.0
- H - Acc - Surface Mtd Sanitary Napkin Disposal w/ Cover - Bradley - 4781-110000 1.0


SHEET NO.






A502

25 OF 33

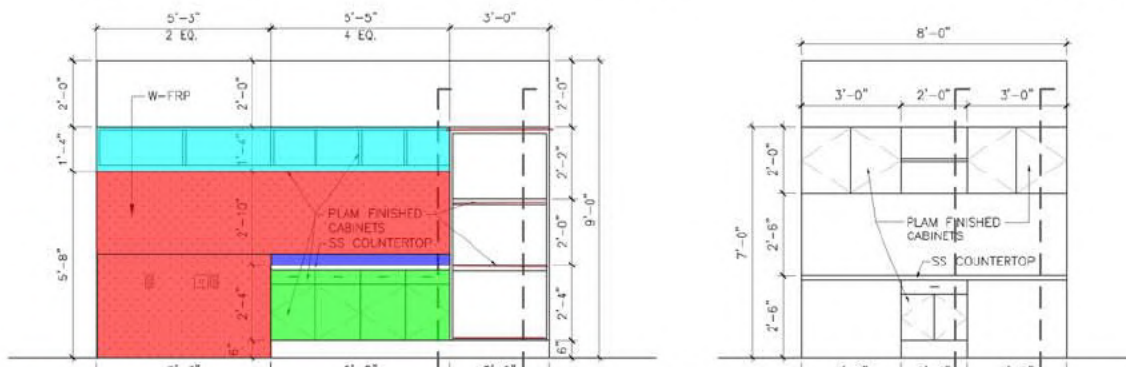
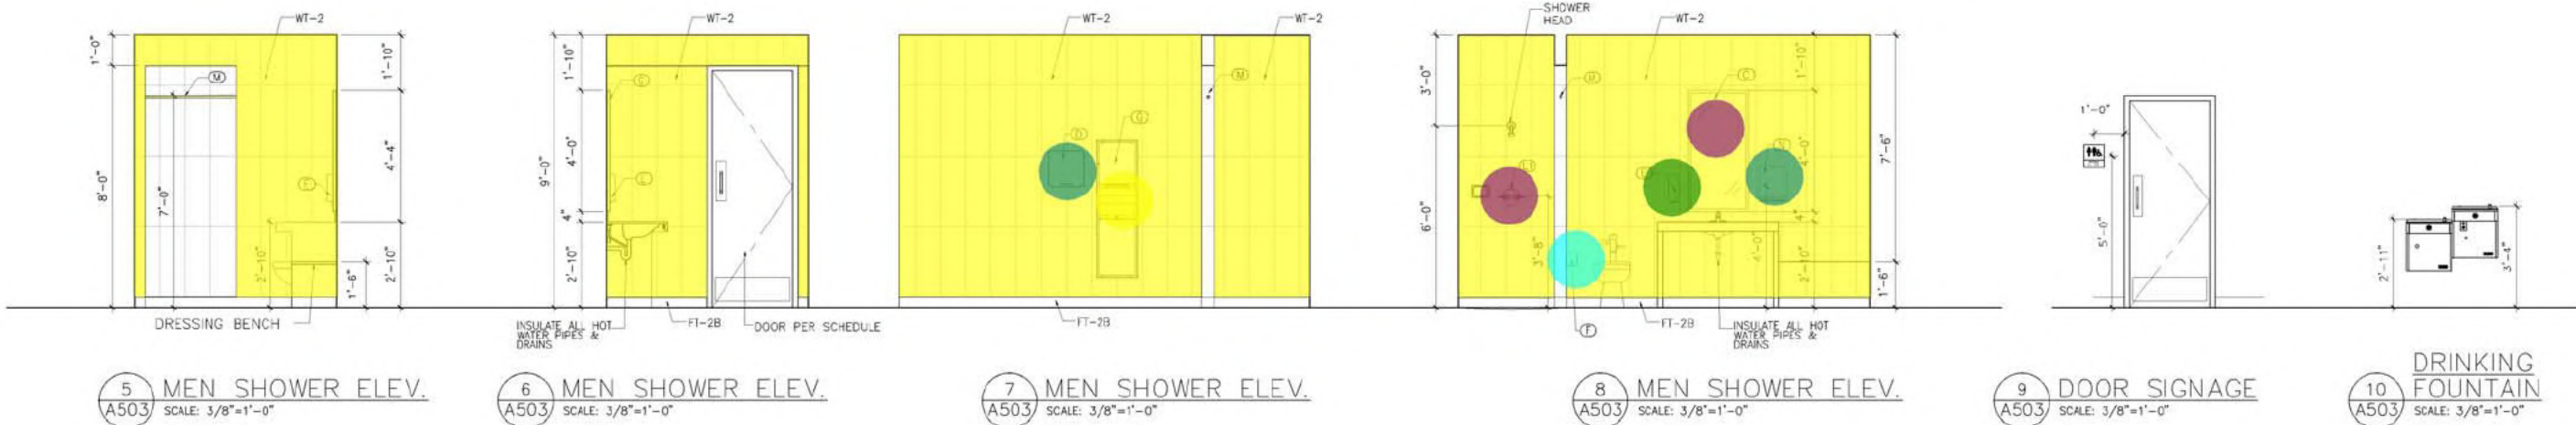


- WT-2 - Wall Tile - Dimens breeze Blanco - 2 (Polished (10x28) - Floor & Decor
- L2 - Acc - ADA Shower Grab bar - Bradley - Model-800 Series
- L - Acc - ADA Shower Controls - Bradley - 1C-EF-ES1-B24-DV
- A - Acc - 36" Grab Bar - Bradley - 8120-001360
- C - Acc - Mirror Channel Frame 24x48 - Bradley - 781-024480
- E - Acc - Auto. Liquid Soap Dispenser - Bradley - 6A00-110000
- D - Acc - HAnd Dryer - Bradley - 2902-287400
- G - Acc - Recessed Paper Towel & Waster Dispenser - Bradley - 234-000000
- B - Acc - 42" Grab Bar - Bradley - 8120-001420
- F - Acc - Dual SurfaceMtd Toilet Tissue Dispenser - Bradley - 5402-000000
- H - Acc - Surface Mtd Sanitary Napkin Disposal w/ Cover - Bradley - 4781-110000
- M - Acc - Shower Curtain - Bradley - Model-9538 Series
- L1 - Acc - Shower & Controls - Bradley - 1C-EF-ES1
- N - Acc - Surface Mtd Folded Paper Towel Disp. - Bradley - 250-150000
- W-FRP - 151 Light Grey - Martile
- Plam base Cabinet - Belair-8234 - Wilsonart
- SS Countertop Backsplash
- Plam Wall Cabinet - Belair-8234 - Wilsonart
- (2'D) Plam Shelving
- Quartz Countertop

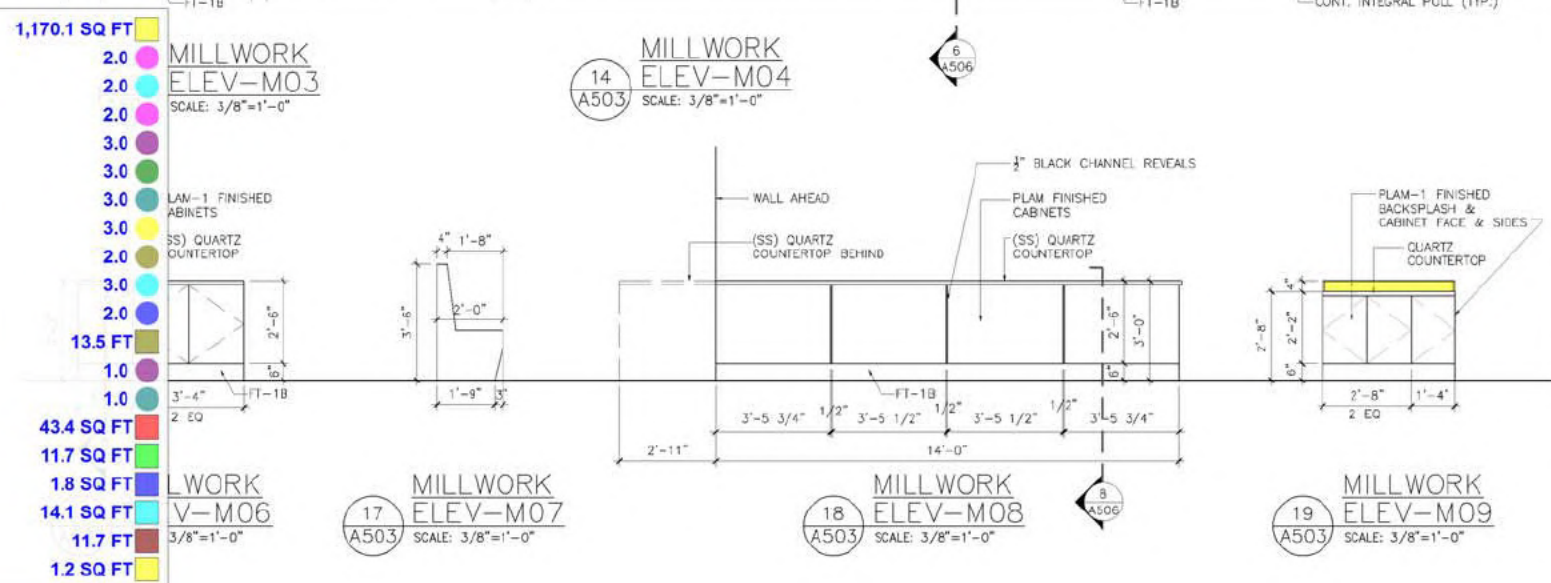

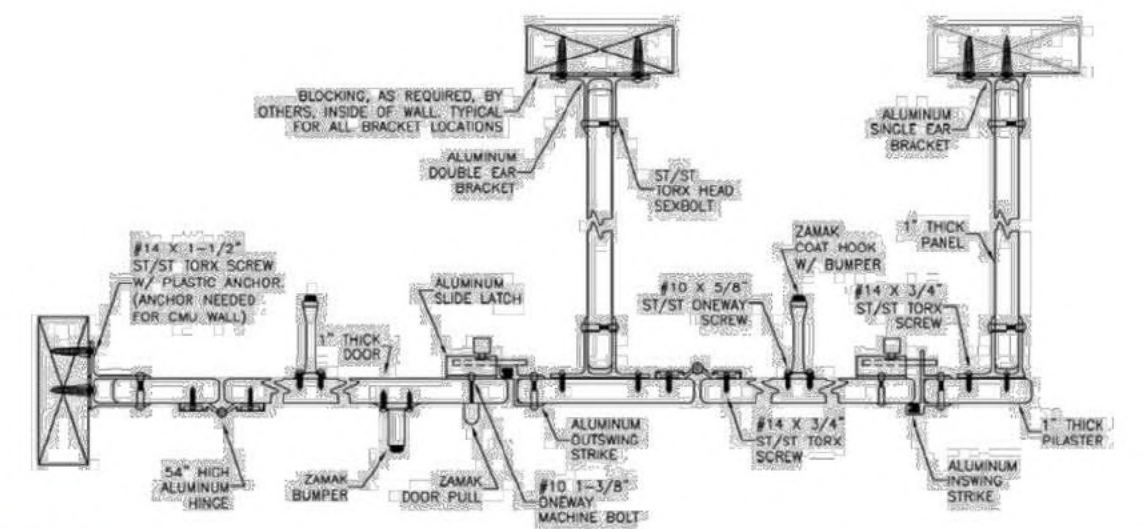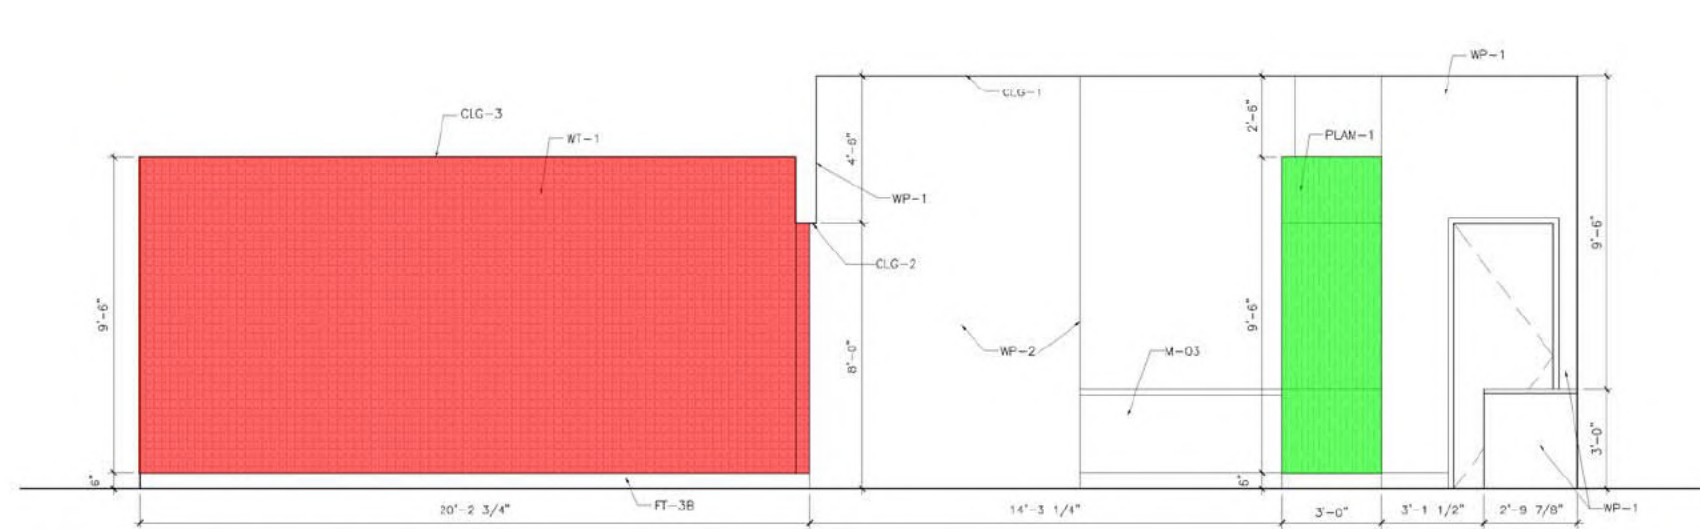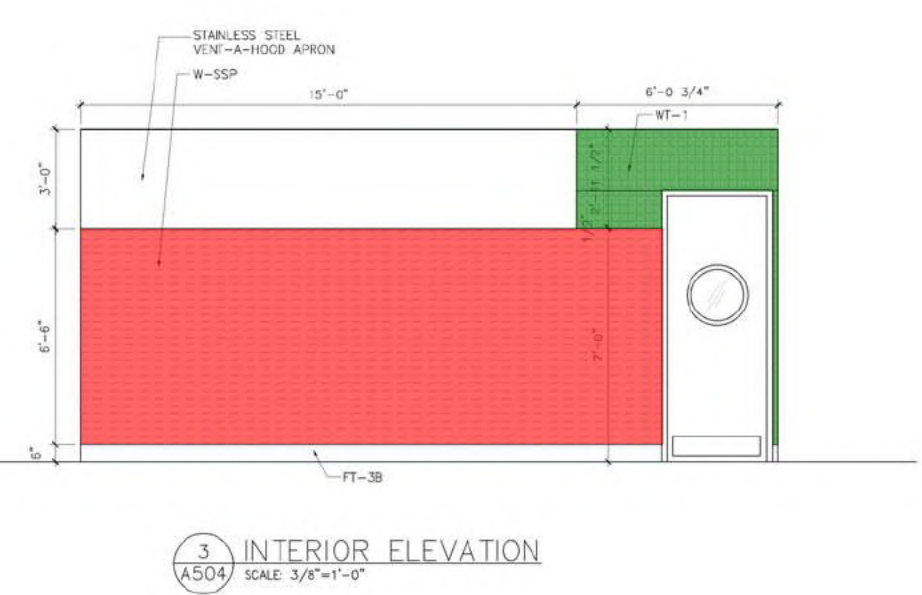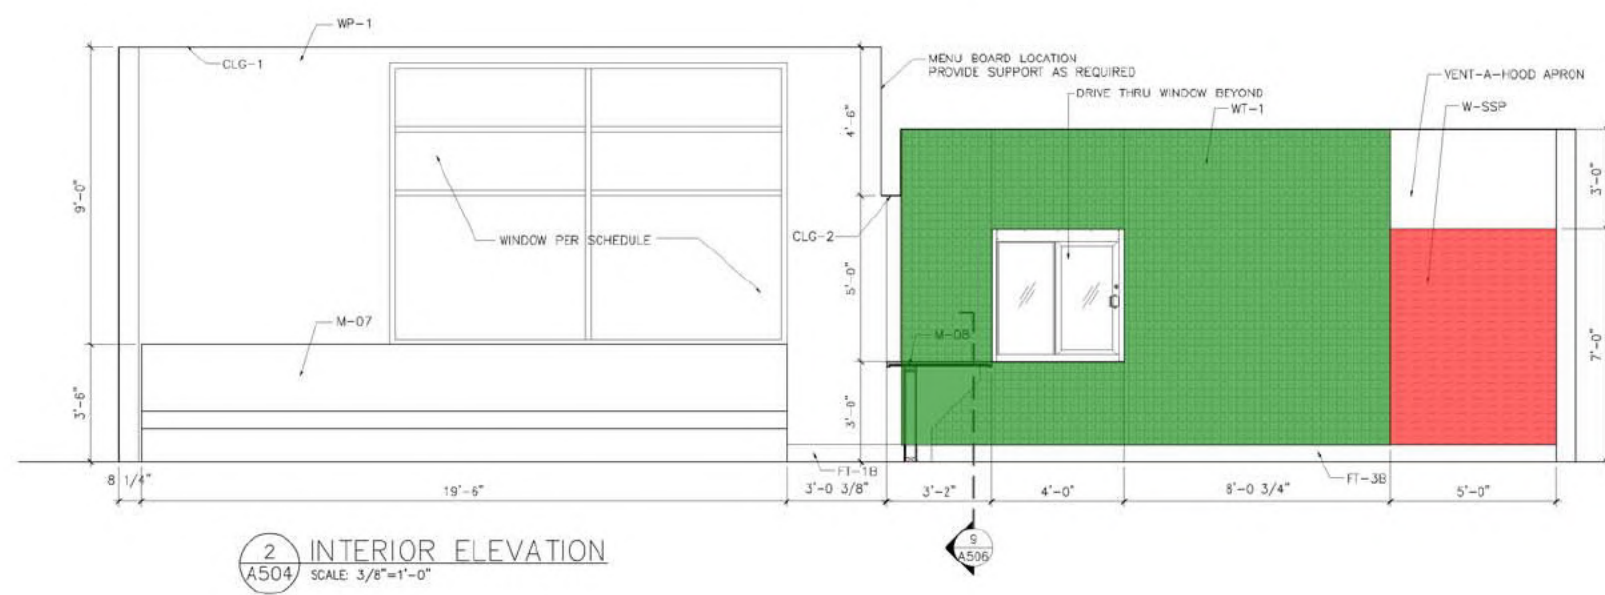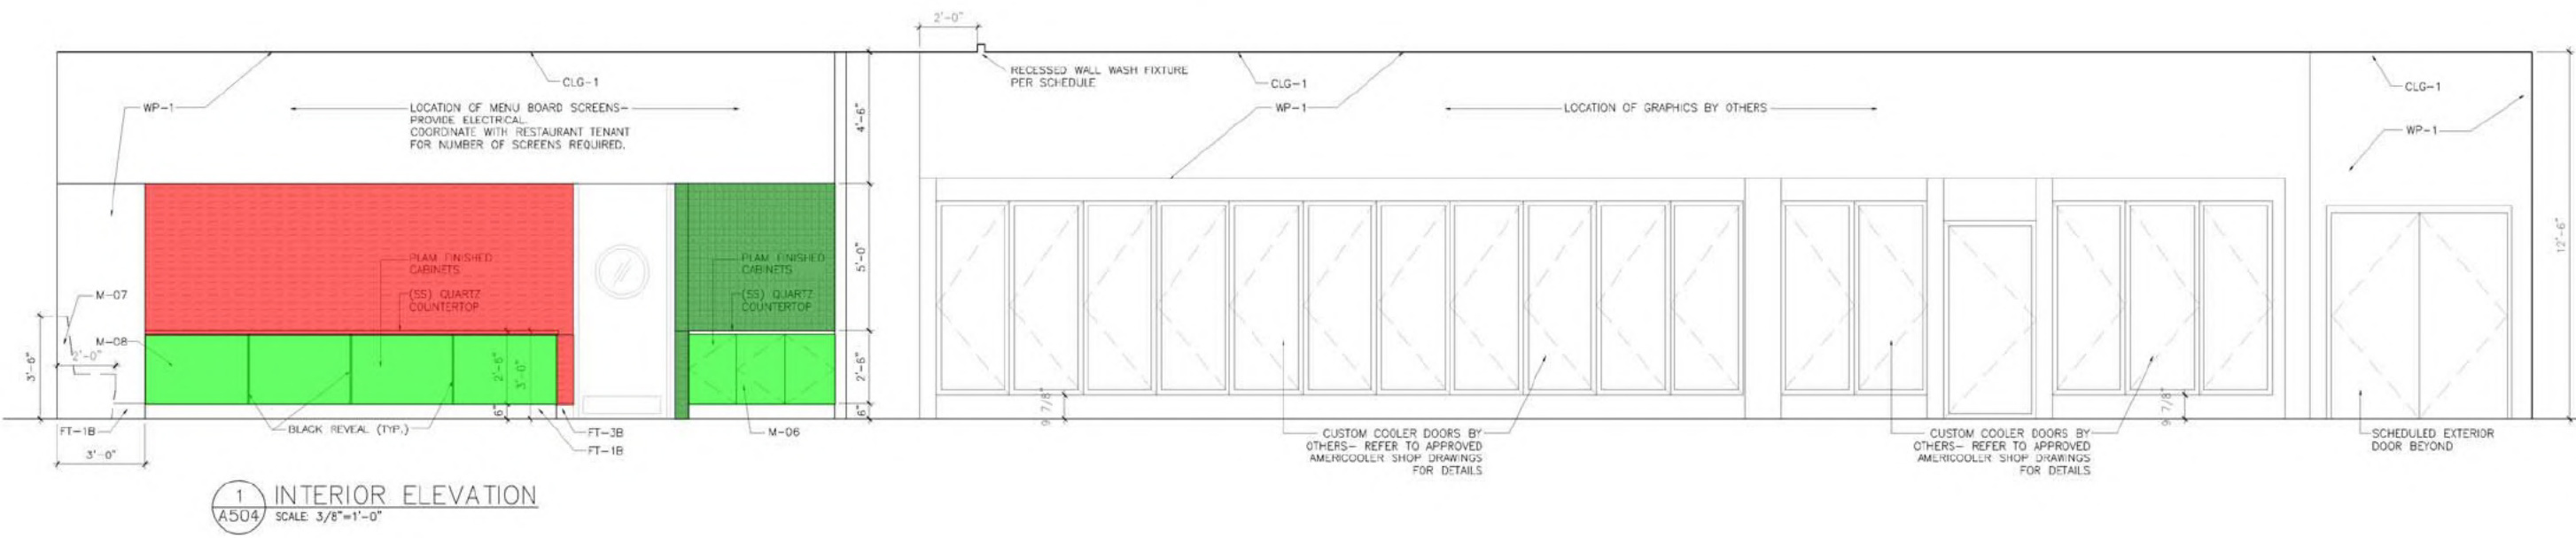

|                                                                               |             |
|-------------------------------------------------------------------------------|-------------|
| W-SSP - Wall Panel                                                            | 416.5 SQ FT |
| WT-1 - Wall Tile - Floor & Decore - Festival - Bright White Ice Beveled (3x6) | 169.0 SQ FT |
| P-Lam - Wall Panel - Belair-8234 - Wilsonart                                  | 28.7 SQ FT  |
| Plam base Cabinet - Belair-8234 - Wilsonart                                   | 45.4 SQ FT  |

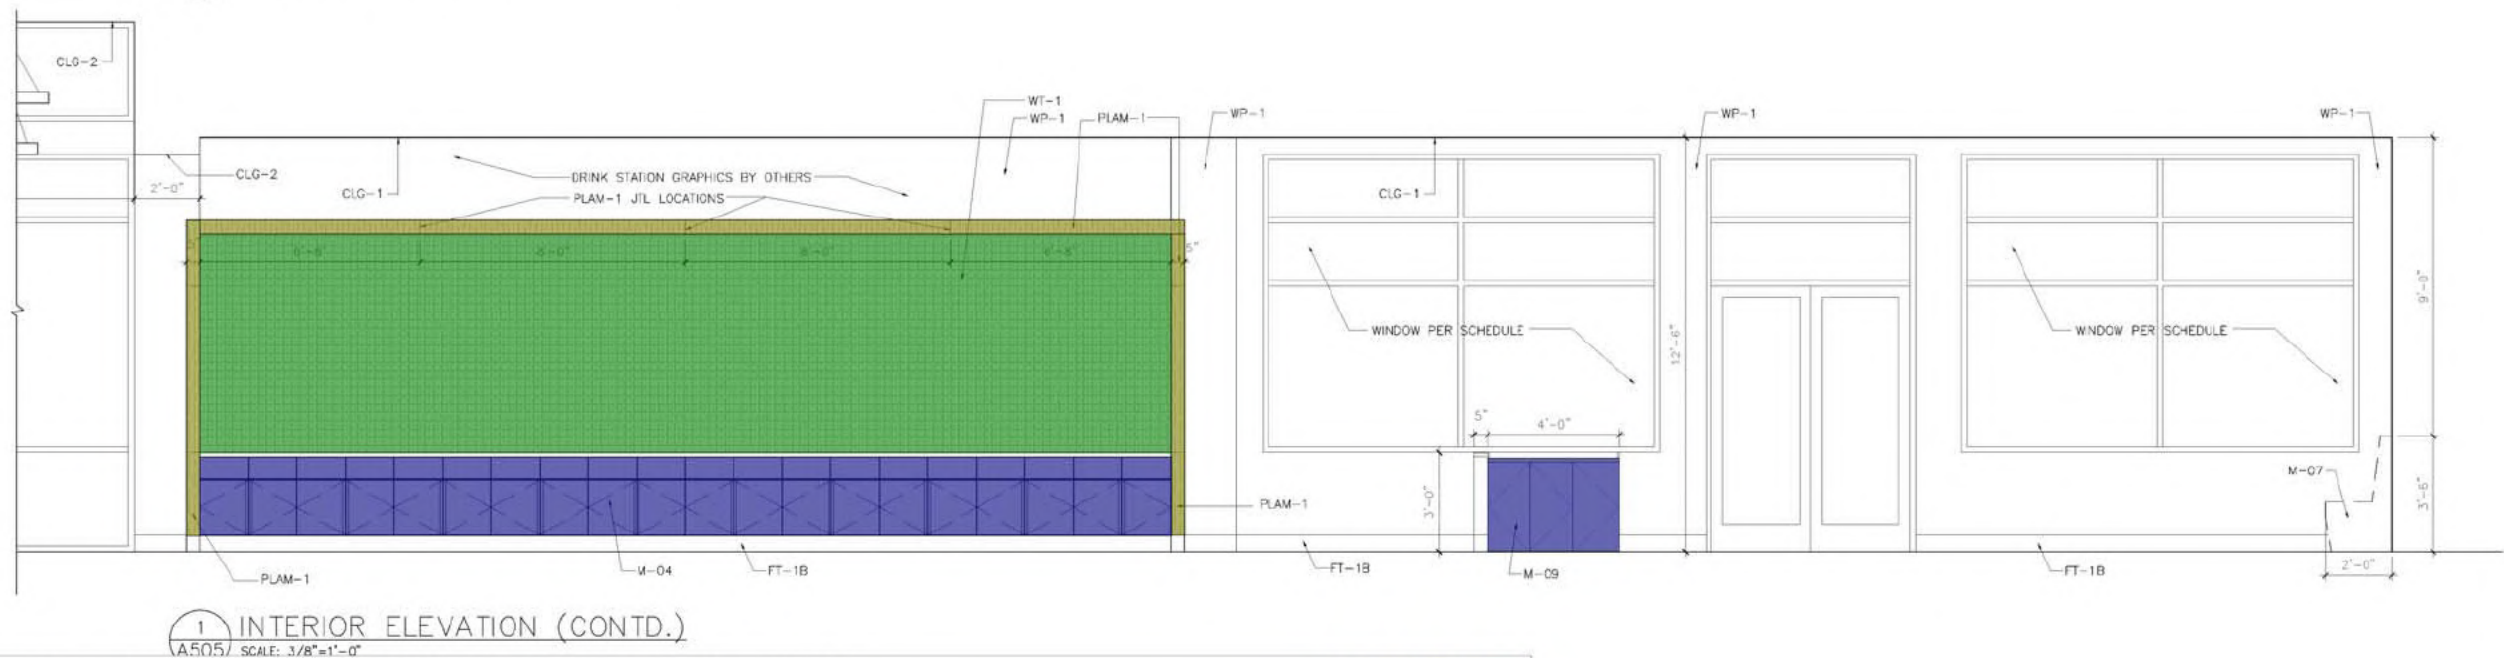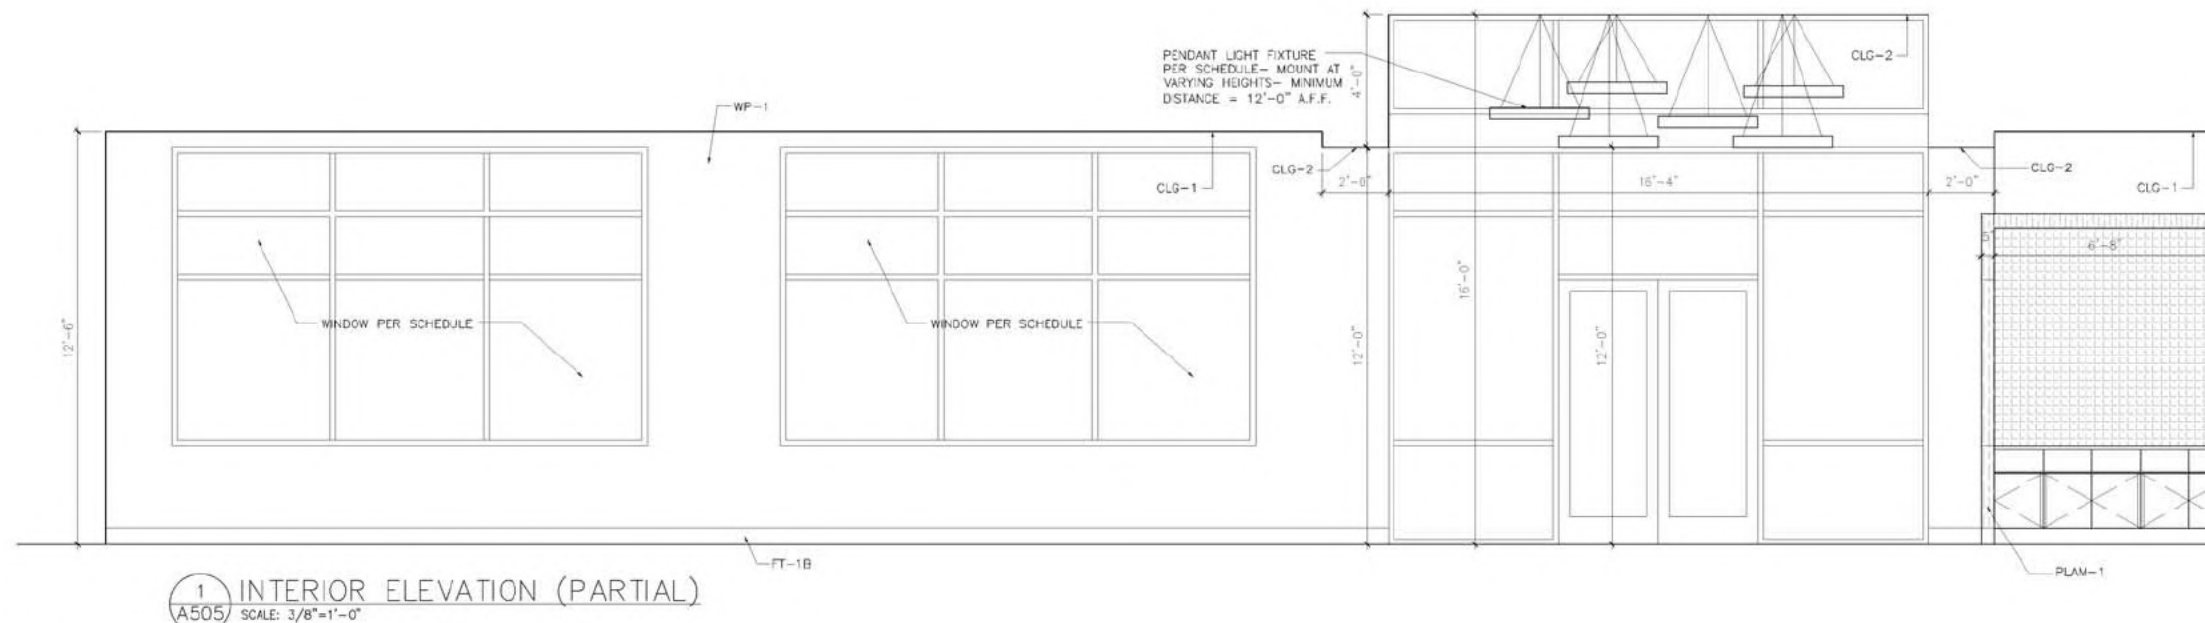


- WT-1 - Wall Tile - Floor & Decore - Festival - Bright White Ice Beveled (3x6)
- P-Lam - Wall JTL Location - Belair-8234 - Wilsonart
- Base Cabinet - Belair-8234 - Wilsonart
- (20'L) Fixed Seating Booth


193.6 SQ FT

20.4 SQ FT


81.6 SQ FT

67.8 SQ FT

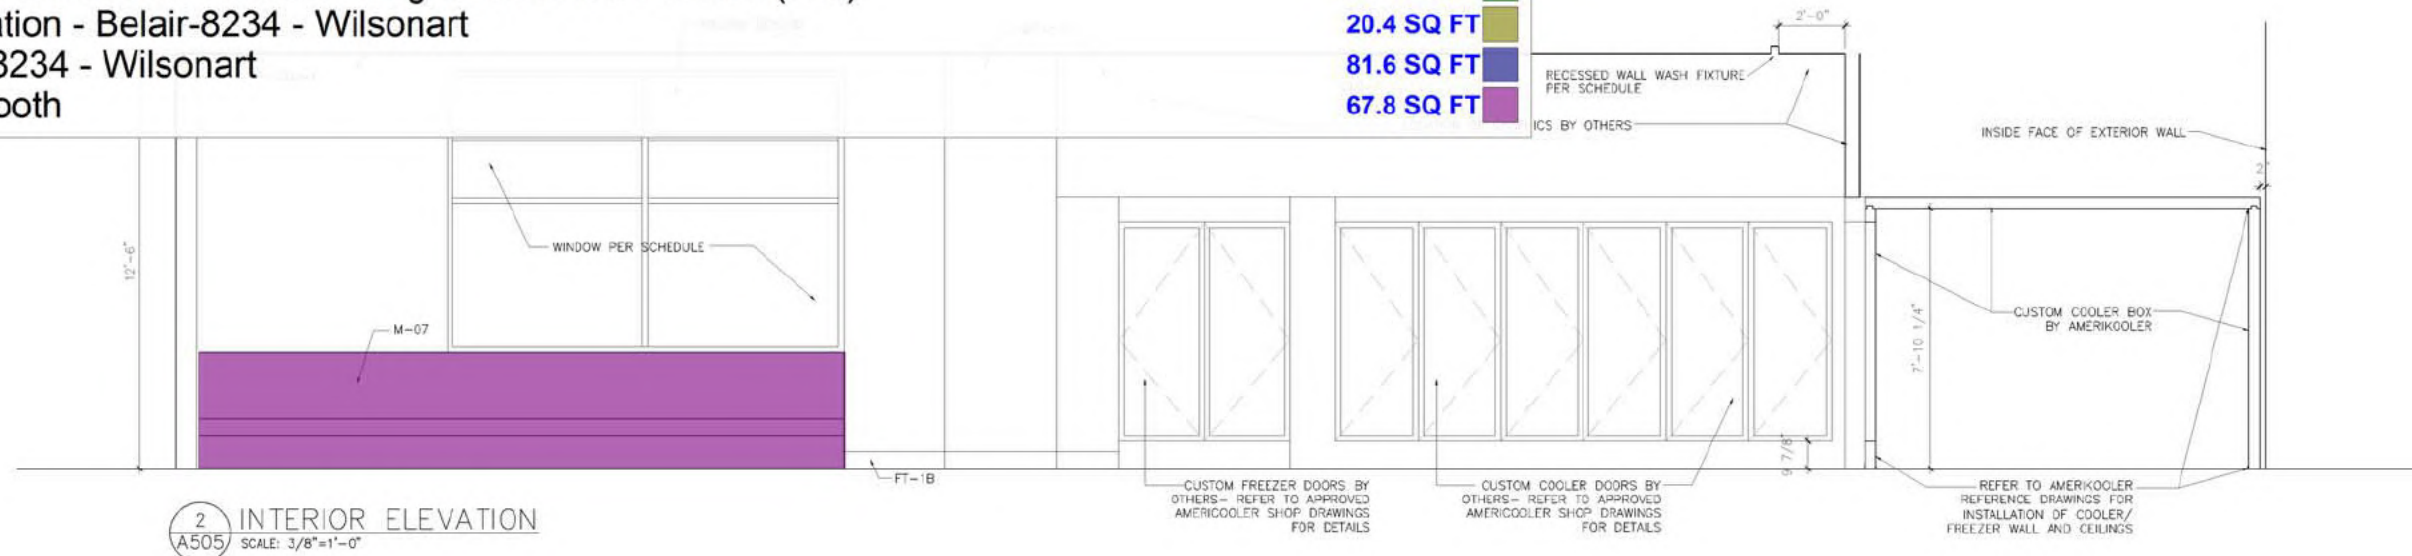


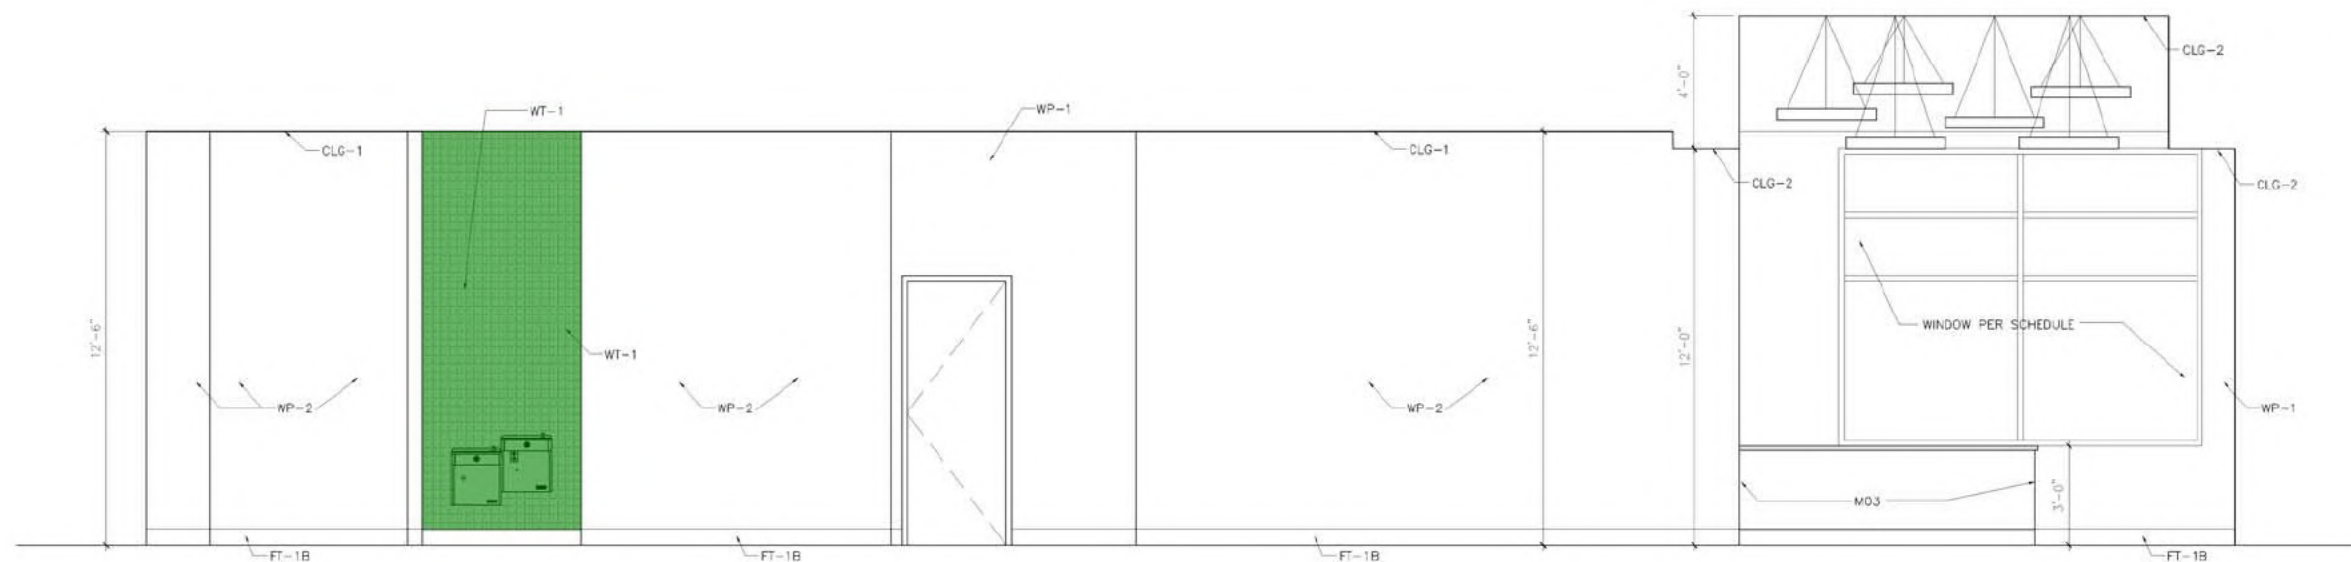



1 INT. ELEVATION  
A506 SCALE: 3/8"=1'-0"

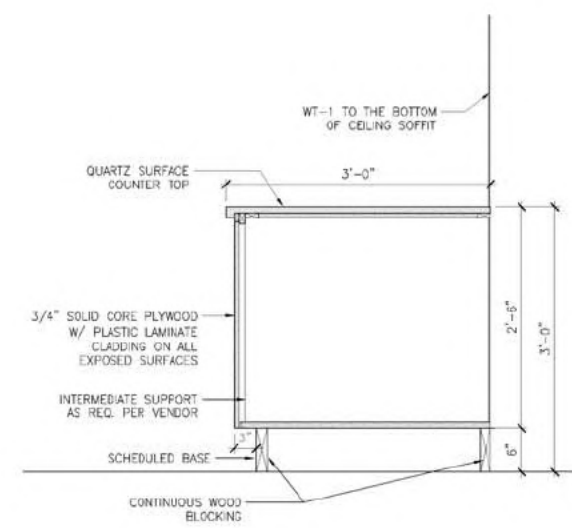


6 DETAIL-M04 & M06  
A506 SCALE: 1"=1'-0"

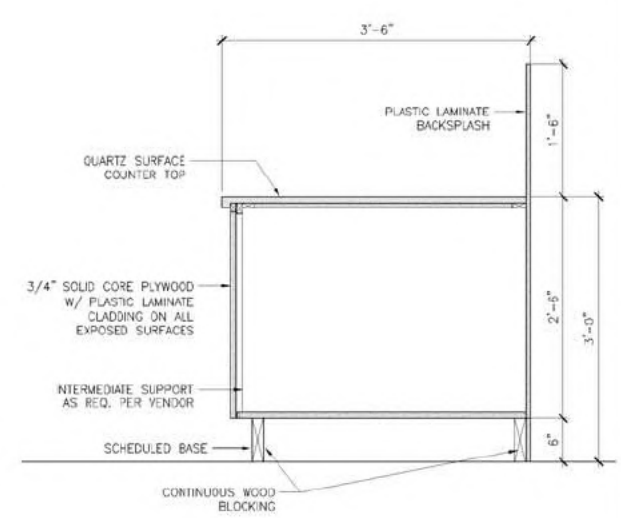

7 DETAIL-M05  
A506 SCALE: 1"=1'-0"

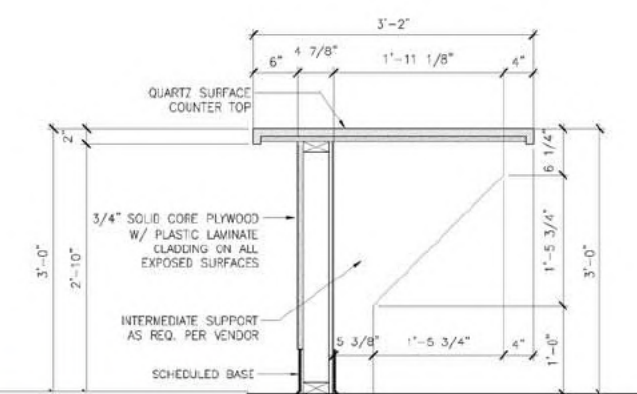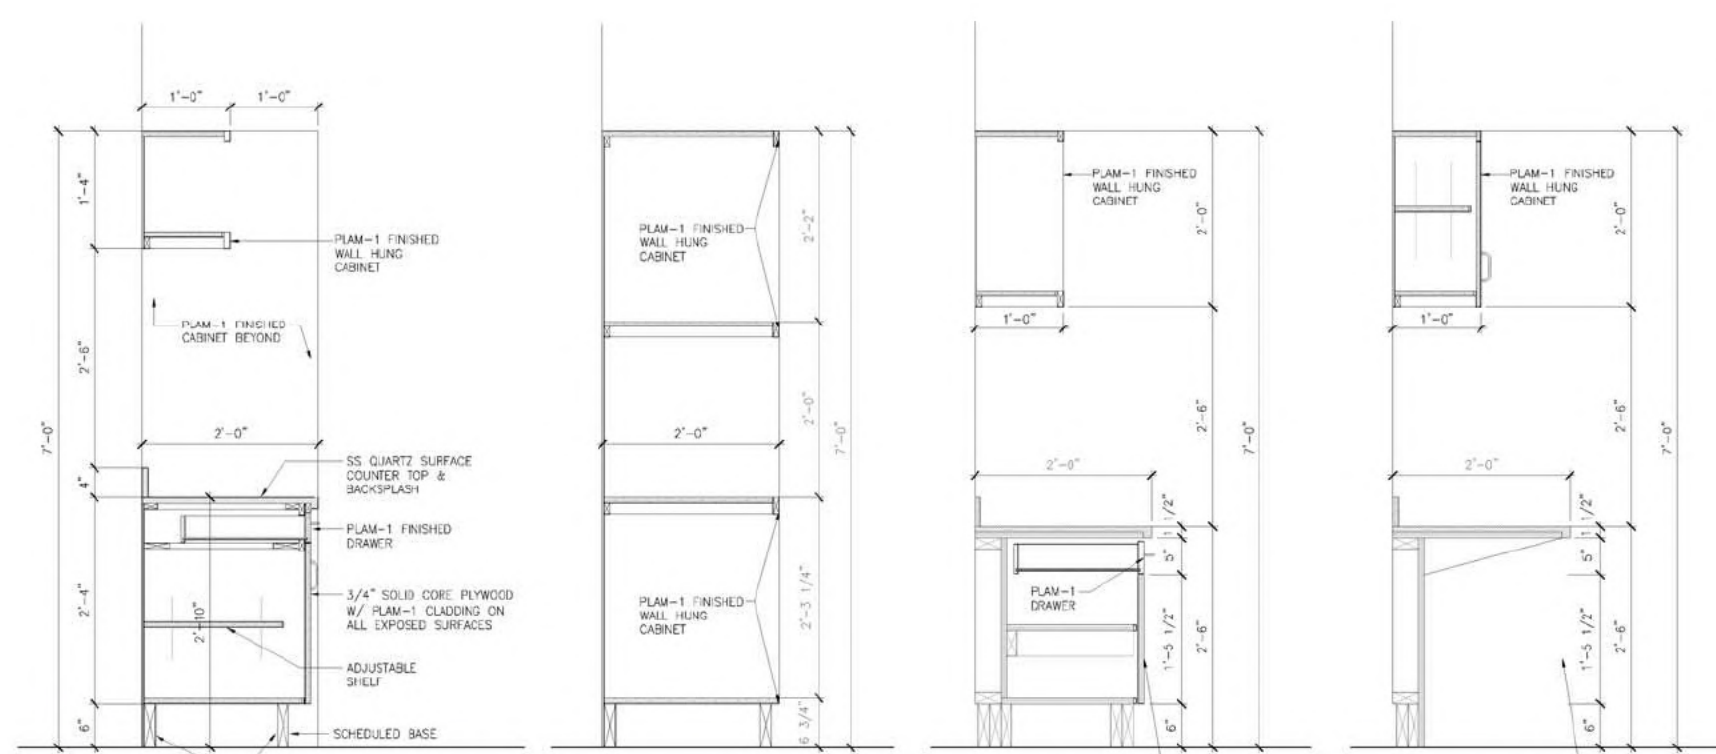

8 DETAIL-M08  
A506 SCALE: 1"=1'-0"

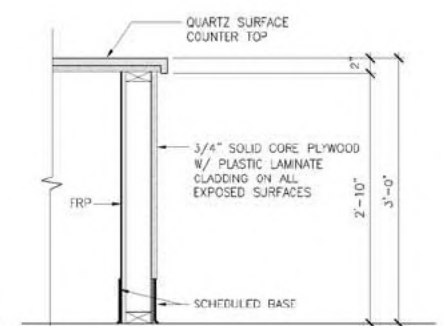

9 DETAIL-M08  
A506 SCALE: 1"=1'-0"


WT-1 - Wall Tile - Floor & Decore - Festival - Bright White Ice Beveled (3x6) 57.8 SQ FT

A506 SCALE: 1"=1'-0"

A506 SCALE: 1"=1'-0"

A506 SCALE: 1"=1'-0"

A506 SCALE: 1"=1'-0"

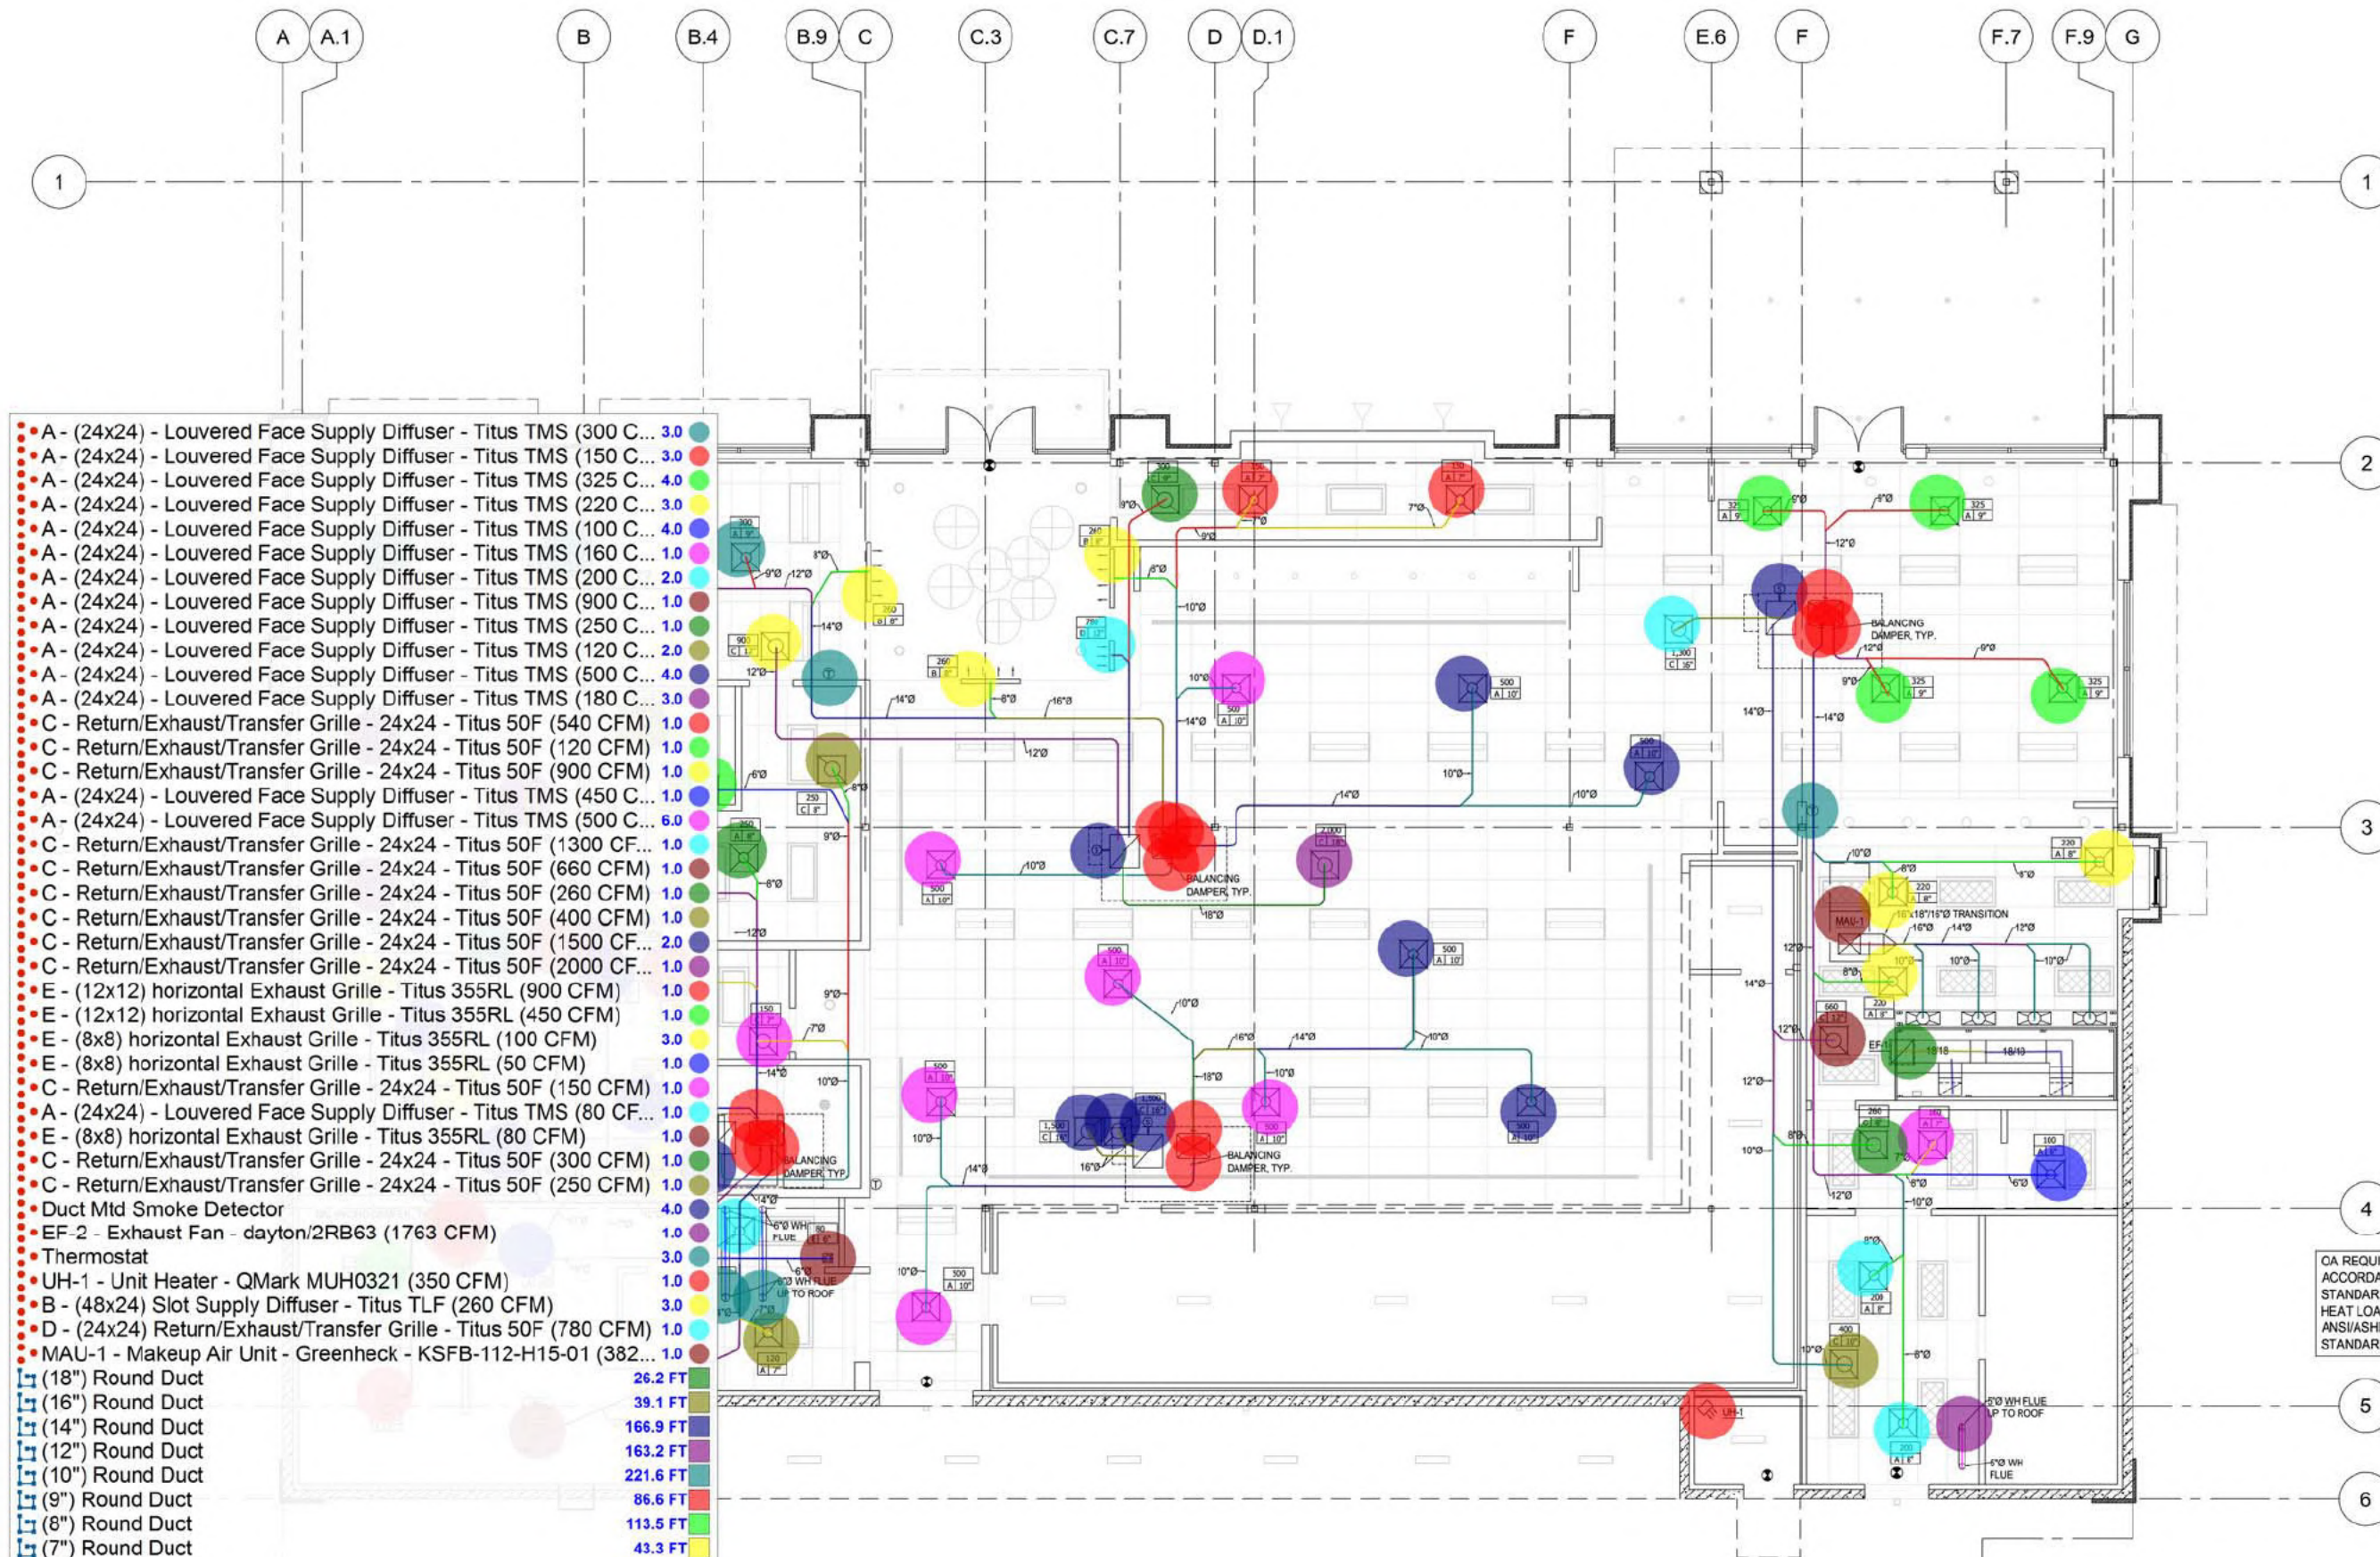

- A - (24x24) - Louvered Face Supply Diffuser - Titus TMS (300 C... 3.0
- A - (24x24) - Louvered Face Supply Diffuser - Titus TMS (150 C... 3.0
- A - (24x24) - Louvered Face Supply Diffuser - Titus TMS (325 C... 4.0
- A - (24x24) - Louvered Face Supply Diffuser - Titus TMS (220 C... 3.0
- A - (24x24) - Louvered Face Supply Diffuser - Titus TMS (100 C... 4.0
- A - (24x24) - Louvered Face Supply Diffuser - Titus TMS (160 C... 1.0
- A - (24x24) - Louvered Face Supply Diffuser - Titus TMS (200 C... 2.0
- A - (24x24) - Louvered Face Supply Diffuser - Titus TMS (900 C... 1.0
- A - (24x24) - Louvered Face Supply Diffuser - Titus TMS (250 C... 1.0
- A - (24x24) - Louvered Face Supply Diffuser - Titus TMS (120 C... 2.0
- A - (24x24) - Louvered Face Supply Diffuser - Titus TMS (500 C... 4.0
- A - (24x24) - Louvered Face Supply Diffuser - Titus TMS (180 C... 3.0
- C - Return/Exhaust/Transfer Grille - 24x24 - Titus 50F (540 CFM) 1.0
- C - Return/Exhaust/Transfer Grille - 24x24 - Titus 50F (120 CFM) 1.0
- C - Return/Exhaust/Transfer Grille - 24x24 - Titus 50F (900 CFM) 1.0
- A - (24x24) - Louvered Face Supply Diffuser - Titus TMS (450 C... 1.0
- A - (24x24) - Louvered Face Supply Diffuser - Titus TMS (500 C... 6.0
- C - Return/Exhaust/Transfer Grille - 24x24 - Titus 50F (1300 CF... 1.0
- C - Return/Exhaust/Transfer Grille - 24x24 - Titus 50F (660 CFM) 1.0
- C - Return/Exhaust/Transfer Grille - 24x24 - Titus 50F (260 CFM) 1.0
- C - Return/Exhaust/Transfer Grille - 24x24 - Titus 50F (400 CFM) 1.0
- C - Return/Exhaust/Transfer Grille - 24x24 - Titus 50F (1500 CF... 2.0
- C - Return/Exhaust/Transfer Grille - 24x24 - Titus 50F (2000 CF... 1.0
- E - (12x12) horizontal Exhaust Grille - Titus 355RL (900 CFM) 1.0
- E - (12x12) horizontal Exhaust Grille - Titus 355RL (450 CFM) 1.0
- E - (8x8) horizontal Exhaust Grille - Titus 355RL (100 CFM) 3.0
- E - (8x8) horizontal Exhaust Grille - Titus 355RL (50 CFM) 1.0
- C - Return/Exhaust/Transfer Grille - 24x24 - Titus 50F (150 CFM) 1.0
- A - (24x24) - Louvered Face Supply Diffuser - Titus TMS (80 CF... 1.0
- E - (8x8) horizontal Exhaust Grille - Titus 355RL (80 CFM) 1.0
- C - Return/Exhaust/Transfer Grille - 24x24 - Titus 50F (300 CFM) 1.0
- C - Return/Exhaust/Transfer Grille - 24x24 - Titus 50F (250 CFM) 1.0
- Duct Mtd Smoke Detector 4.0
- EF-2 - Exhaust Fan - dayton/2RB63 (1763 CFM) 1.0
- Thermostat 3.0
- UH-1 - Unit Heater - QMark MUH0321 (350 CFM) 1.0
- B - (48x24) Slot Supply Diffuser - Titus TLF (260 CFM) 3.0
- D - (24x24) Return/Exhaust/Transfer Grille - Titus 50F (780 CFM) 1.0
- MAU-1 - Makeup Air Unit - Greenheck - KSFB-112-H15-01 (382... 1.0
- (18") Round Duct 26.2 FT
- (16") Round Duct 39.1 FT
- (14") Round Duct 166.9 FT
- (12") Round Duct 163.2 FT
- (10") Round Duct 221.6 FT
- (9") Round Duct 86.6 FT
- (8") Round Duct 113.5 FT
- (7") Round Duct 43.3 FT
- (6") Round Duct 110.2 FT
- (5") Round Duct 16.7 FT
- (16x18) Metal Duct 3.9 FT
- EF-1 - Exhaust Fan - Cube-180-15 (3820 CFM) 1.0
- (18x18) Metal Duct 6.0 FT
- (18x10) Metal Duct 10.6 FT
- (5") Round Duct (10'h) 2.0
- (6") Round Duct (10'h) 2.0
- Balancing Damper 15.0

1 HVAC PLAN  
M1.0 SCALE: 3/16"=1'-0"

ELLIOTT STOVALL, LLC  
2000 WANDA WAY  
ARLINGTON, TX 76011



SCALE AS NOTED.  
DO NOT SCALE DRAWINGS-USE DISPLAYED MEASUREMENTS.  
DRAWINGS ARE DIAGRAMMED FOR CLARITY. CONTRACTOR TO VERIFY EXISTING CONDITIONS PRIOR TO CONSTRUCTION.  
ALL DIFFERENCES BETWEEN THE DRAWINGS & ACTUAL CONDITIONS ARE TO BE REPORTED TO THE ARCHITECT/ENGINEER PRIOR TO BIDDING.  
ANY DESIGN IN THE DRAWINGS THAT DEPART FROM STANDARD CONSTRUCTION PRACTICES ARE TO BE VERIFIED PRIOR TO CONSTRUCTION. FAILURE TO DO SO SHALL RELIEVE DESIGNER OF ANY RESPONSIBILITY.

- 2-1/2" Backflow Device
- FPHB
- Double GCO
- GCO
- Gas Meter
- Water Closet - Madera - American Standard
- Urinal - American Standard - Washbrook
- Double Lavatory - Kohler - Verticity
- Lavatory - Bradley - Verge LVA
- Shower - EQUA FLO
- MOP Sink - Mustee - 1RLN4
- Drinking Fountain - Elkay - EMABFTL8LC
- WH-1 - Water Heater - AO SMITH/ BTR-154 (81 GAL.)
- WH-2 - Water Heater - AO SMITH/ BTR-154 (81 GAL.)
- FD - Floor Drain
- HD - Hub Drain
- Cleanout
- Laundry Sink
- Washer/ Dryer
- FS - Floor Sink
- WH-3 - Water Heater - AO SMITH/ BTR-154 (81 GAL.)
- 1/2" Cold water pipe
- 3/4" Cold water pipe
- 3" Sanitary pipe
- 4" Sanitary pipe
- 2" Sanitary pipe
- 1-1/2" Sanitary pipe
- 6" Sanitary pipe
- Grease Interceptor 1250 Gal.
- Sample box
- 4" Vent pipe
- 2" Vent pipe
- 1-1/2" Vent pipe
- 1" Cold water pipe
- 1/2" Hot water pipe
- 3/4" Hot water pipe
- 2-1/2" Cold water pipe
- 1-1/2" Cold water pipe
- 2" Cold water pipe
- 1" Hot water pipe
- 1-1/2" Hot water pipe
- 1" Gas pipe
- 3/4" Gas pipe


- 1.0
- 5.0
- 4.0
- 2.0
- 1.0
- 9.0
- 3.0
- 2.0
- 3.0
- 3.0
- 1.0
- 1.0
- 17.0
- 1.0
- 22.0
- 1.0
- 1.0
- 1.0
- 6.0
- 1.0
- 94.7 FT
- 82.4 FT
- 184.6 FT
- 66.9 FT
- 140.4 FT
- 24.2 FT
- 12.8 FT
- 1.0
- 1.0
- 14.0 FT
- 38.3 FT
- 19.1 FT
- 86.4 FT
- 56.6 FT
- 49.7 FT
- 95.3 FT
- 37.0 FT
- 38.5 FT
- 20.0 FT
- 35.5 FT
- 7.2 FT
- 6.2 FT

NOTES  
 1. RTU CONDENSATE DRAINS ARE TO BE DISCHARGED TO MOP SINK.  
 2. T&P DRAINS TO DISCHARGE TO MOP SINK.  
 3. PROVIDE TRAP PRIMERS FOR ALL FLOOR DRAINS.

1 PLUMBING PLAN  
 SCALE: 3/16"=1'-0"

ELLIOTT STOVALL, LLC  
 2000 WANDA WAY  
 ARLINGTON, TX 76011  
 F-19938  
 THE SEAL APPEARING ON THIS DOCUMENT WAS AUTHORIZED BY ELLIOTT STOVALL, P.E. 82774 ON 5/31/21  
*Elliott Stovall*

SCALE AS NOTED.  
 DO NOT SCALE DRAWINGS-USE DISPLAYED MEASUREMENTS.  
 DRAWINGS ARE DIAGRAMMED FOR CLARITY. CONTRACTOR TO VERIFY EXISTING CONDITIONS PRIOR TO CONSTRUCTION.  
 ALL DIFFERENCES BETWEEN THE DRAWINGS & ACTUAL CONDITIONS ARE TO BE REPORTED TO THE ARCHITECT/ENGINEER PRIOR TO BIDDING.  
 ANY DESIGN IN THE DRAWINGS THAT DEPART FROM STANDARD CONSTRUCTION PRACTICES ARE TO BE VERIFIED PRIOR TO CONSTRUCTION. FAILURE TO DO SO SHALL RELIEVE DESIGNER OF ANY RESPONSIBILITY.

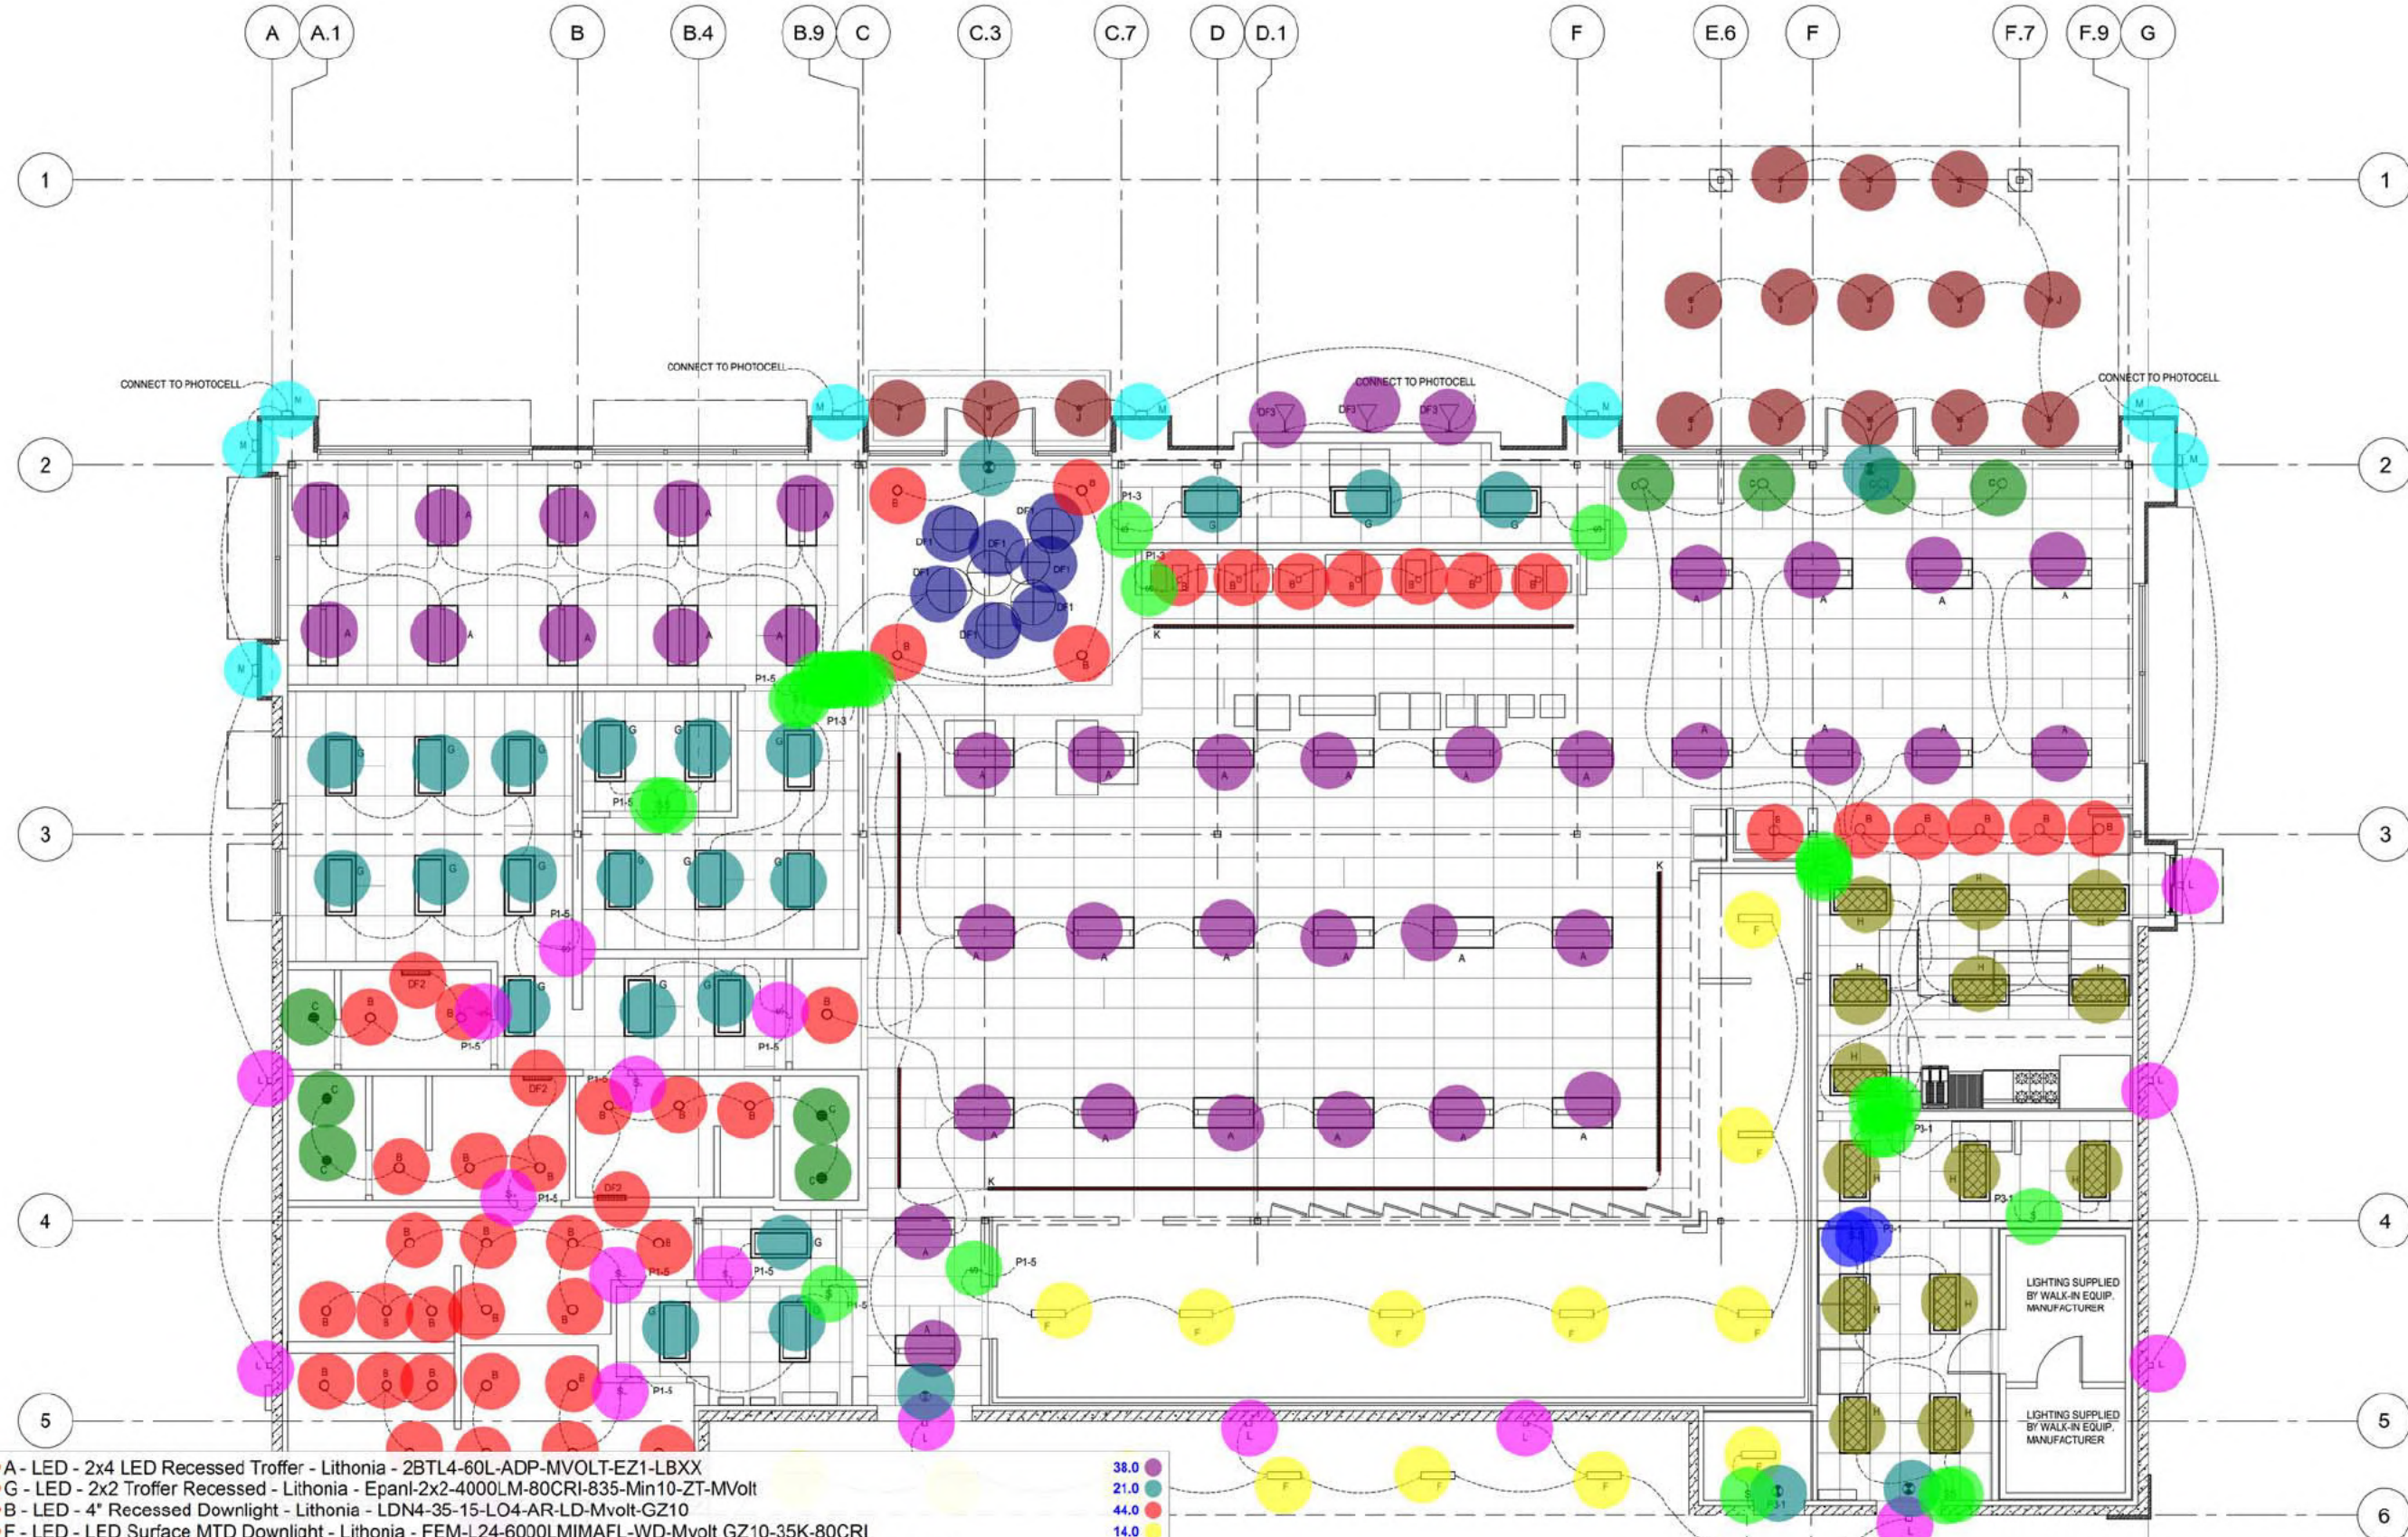

- A - LED - 2x4 LED Recessed Troffer - Lithonia - 2BTL4-60L-ADP-MVOLT-EZ1-LBXX
- G - LED - 2x2 Troffer Recessed - Lithonia - Epanl-2x2-4000LM-80CRI-835-Min10-ZT-MVOLT
- B - LED - 4" Recessed Downlight - Lithonia - LDN4-35-15-LO4-AR-LD-MVOLT-GZ10
- F - LED - LED Surface MTD Downlight - Lithonia - FEM-L24-6000LMIMAF-LD-MVOLT-GZ10-35K-80CRI
- L - LED - 7" Depthx9"H Aperture LED Wall Pack - Lithonia - WDGE1 LED-P2-35K-80CRI-VW-MVOLT-Mounting-Finish
- M - LED - LED Wall Sconce - Bruck - EXT-6UD-30K-90-36-UNV-Finish
- J - LED - 4" LED Recessed Round Downlight - Lithonia - LDN4-30-15-LO4-AR-LD-MVOLT-GZ10
- C - LED - 4" Recessed Round Downlight - Gotham - EVO4SH-40-15-DFR-SOL-MVOLT-EZ10
- H - LED - 2x4 LED Recessed Troffer - Lithonia - 2GTL4-48L-Inverted Lens-MVOLT-EZ1-LP835-ABC
- DF1 - LED - LED Decorative Ring Pendant - 36" Dia - GLighting - GL-2738-V-Finish-Hanger
- DF3 - LED - LED Decorative Wall Mtd - HI Lite - H-13115-91-HL-A-91-9W-LED2-30-WBCM-1
- Exit Sign
- DF2 - LED - LED Wall Mtd Vanity Sconce, 26.75"W, 2.25" tall - Oxygen - 3-575-24-MVOLT - Finish-35
- Single Pole Switch
- K - LED - LED Linear Recessed Wall Washer, 2" Aperture - Mark Lighting - SL2L-QS-LOP-4'-FLP-TG-80CRI-CCT-800LMF-WW-MIN...
- Three Pole Switch
- Motor Rated Switch
- K - LED

38.0  
21.0  
44.0  
14.0  
10.0  
8.0  
16.0  
9.0  
14.0  
7.0  
3.0  
5.0  
3.0  
28.0  
0.0  
2.0  
8.0  
112.1 FT

PLAN

ELLIOTT STOVALL, LLC  
2000 WANDA WAY  
ARLINGTON, TX 76011



SCALE AS NOTED.

DO NOT SCALE DRAWINGS-USE DISPLAYED MEASUREMENTS.

DRAWINGS ARE DIAGRAMMED FOR CLARITY. CONTRACTOR TO VERIFY EXISTING CONDITIONS PRIOR TO CONSTRUCTION.

ALL DIFFERENCES BETWEEN THE DRAWINGS & ACTUAL CONDITIONS ARE TO BE REPORTED TO THE ARCHITECT/ENGINEER PRIOR TO BIDDING

ANY DESIGN IN THE DRAWINGS THAT DEPART FROM STANDARD CONSTRUCTION PRACTICES ARE TO BE VERIFIED PRIOR TO CONSTRUCTION. FAILURE TO DO SO SHALL RELIEVE DESIGNER OF ANY RESPONSIBILITY.



- Duplex Receptacle
- Data outlet
- GFI Duplex Receptacle
- Special Receptacle
- Tele/Data Outlet

- 56.0
- 6.0
- 25.0
- 8.0
- 4.0

E3.0 SCALE: 3/16"=1'-0"

ELLIOTT STOVALL, LLC  
2000 WANDA WAY  
ARLINGTON, TX 76001



SCALE AS NOTED.

DO NOT SCALE DRAWINGS-USE DISPLAYED MEASUREMENTS.

DRAWINGS ARE DIAGRAMMED FOR CLARITY. CONTRACTOR TO VERIFY EXISTING CONDITIONS PRIOR TO CONSTRUCTION.

ALL DIFFERENCES BETWEEN THE DRAWINGS & ACTUAL CONDITIONS ARE TO BE REPORTED TO THE ARCHITECT/ENGINEER PRIOR TO BIDDING.

ANY DESIGN IN THE DRAWINGS THAT DEPART FROM STANDARD CONSTRUCTION PRACTICES ARE TO BE VERIFIED PRIOR TO CONSTRUCTION. FAILURE TO DO SO SHALL RELIEVE DESIGNER OF ANY RESPONSIBILITY.