

**SECOND AMENDMENT
(ADDING THIRD PHASE) TO
DECLARATION OF CONDOMINIUM
FOR**

**The Village at
Murphy's Crossing
Condominium**

200600030120
Filed for Record in
DELAWARE COUNTY, OHIO
ANDREW D BRENNER
08-23-2006 At 02:09 pm.
DECLAR AMEN 64.00
DR Book 732 Page 360 - 364 **A**

EXPANDING THE CONDOMINIUM

Todd A Hanks

Delaware County Auditor

by: Tracy Blaine

This instrument prepared by

Kenton L. Kuehnle
Allen, Kuehnle & Stovall, LLP
21 West Broad Street
Columbus, Ohio 43215

AMENDMENT TO DECLARATION

This Amendment to the Declaration of Condominium for The Village at Murphy's Crossing Condominium, ("the Condominium"), expanding and submitting additional property to the condominium is made as of this 9th day of August, 2006.

Background

CCBI Murphy's X, LLC, an Ohio limited liability company, ("Declarant"), is the owner in fee simple of all the real property hereinafter described and the improvements thereon and appurtenances thereto.

The Declarant has submitted certain property to the provisions of Section 5311 of the Ohio Revised Code by the filing of a Declaration of Condominium (the "Declaration") of The Village at Murphy's Crossing. The Declaration is recorded in Official Record Volume 601 Page 1529, and the drawings are recorded in Cabinet 3, Slide 551, all of the Delaware County, Ohio Records.

The Declarant, pursuant to Article XVIII of the Declaration, reserved the right to expand the Condominium property by amending the Declaration to add the property (described in Exhibit C of the Declaration as the "Additional Property"), and improvements thereon and appurtenances thereto, to the original condominium. By this instrument, the Declarant is adding the property described in Exhibit A to this Amendment to the Condominium.

Declaration

Declarant, the sole owner of the Additional Property, hereby submits the portion of the Additional Property described on Exhibit A to this Amendment, to the provisions of Chapter 5311 of the Ohio Revised Code, and hereby amends the Declaration of Condominium as follows:

1. Definitions. All terms used herein shall have the same meanings as those terms are defined in the Declaration.
2. Additional Property Added. A legal description of the property being added to the Condominium is attached hereto as "Exhibit A" and incorporated herein by this reference.
3. Name. The Condominium, as expended hereby, shall continue to be named "The Village at Murphy's Crossing Condominium".
4. Purposes. The purposes of the Condominium shall continue to be as set forth in the Declaration (encompassing the additional property added hereby).

5. Improvements Description. The property being added by this amendment consists of one tract of land, on which is situated 1 residential buildings containing 4 Units. Improvements on such property are compatible in terms of quality of construction, principal materials used, and architectural style and design to the improvements now a part of the Condominium Property.

6. Units.

a. Unit Designation. The Units added to the Condominium are designated on the drawings filed simultaneously herewith, by a unit number which is referenced on the drawings filed herewith. The Units added in this phase are designated as "Unit K-43", "Unit K-51", "Unit K-59" and "Unit K-270." A listing of the proper Unit designations for all Units in the Condominium is attached as Exhibit B.

b. Composition of Units. Each Unit added hereby consists of the space in the building designated on the drawings filed simultaneously herewith, including and excluding, as appropriate, those same items as are described and defined in the description of Units in the Declaration.

c. Unit Locations. The location of each Unit added hereby is shown on the Drawings filed simultaneously herewith.

7. Common and Limited Common Elements.

a. Common Elements. All of the property described in Exhibit A, including all of the land and all improvements thereon and appurtenances thereto, except those portions labeled or described herein or in the amendment to the Drawings filed herewith as a part of a Unit, are Common Elements.

b. Limited Common Elements. Those portions of the Common Elements that are added hereby that are labeled or designated "LCE" or "limited common elements" on the Drawings filed herewith, are Limited Common Elements. These Limited Common Elements are reserved for the exclusive use of the Units which those improvements are designed to serve, in accordance with the provisions of the Declaration and as designated on the Drawings.

c. Undivided Ownership of Common Elements. The undivided interest in the Common Elements appurtenant to all Units in the Condominium as expanded hereby, and as thereby allocated and reallocated, are shown in the attached Exhibit B, and are all equal to one/twentieth (1/20th). The Common Elements shall be owned by the Unit owners as tenants in common, and ownership thereof shall remain undivided. No Unit owner may waive or release any rights in the Common Elements. Further, the undivided interest in the Common Elements of a Unit shall not be separated from the Unit to which it appertains.

8. Effects of Expansion. Upon the filing for record of this Amendment to the Declaration adding the property described in Exhibit A to the Condominium Property:

- a. the property shall hereafter be subject to all of the terms and provisions of the Declaration, to the same extent and with the same effect as if that property had been initially part of the Condominium Property, that is, the rights, easements, covenants, restrictions and assessment plan shall run with and will and bind such property in the same manner, to the same extent, and with the same force and effect as the terms of the Declaration apply to the original Condominium Property;
- b. the owner or owners of Units within such property shall thereupon become members of the Condominium Association, to the same extent, with the same effect, subject to the same obligations, and imbued with the same rights, as all other members; and
- c. in all other respects, all of the provisions of the Declaration shall include and apply to such property, and to the owners, mortgagees and lessees of Units thereon, with equal meaning and of like force and effect.

Drawings, as required by the Ohio Revised Code, are filed herewith showing the information required with respect to the property added by this amendment.


IN WITNESS WHEREOF, this amendment has been executed on behalf of the Declarant on this 9th day of August, 2006.

CCBI Murphy's X, LLC
By [Signature]
Paolo Cugini, authorized member

STATE OF OHIO
COUNTY OF FRANKLIN, SS:

Before me, a notary public, personally appeared Paolo Cugini, authorized member of CCBI Murphy's X, LLC, an Ohio limited liability company, the Declarant in the foregoing instrument, who acknowledged the execution of this instrument to be the signatory's free act and deed, on behalf of the Declarant, for the uses and purposes set forth herein.

In Witness whereof, I have hereunto set my name this 9th day of August 2006.

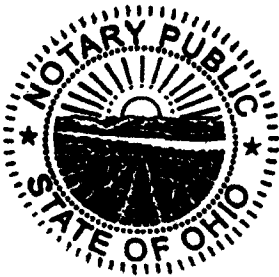

SANDRA K. SARTORI
Notary Public, State of Ohio
My Commission Expires
05-24-09


Sandra K. Sartori
Notary Public

Exhibit B

<u>Unit</u>	<u>Address</u>	<u>Bed- rooms(1)</u>	<u>Baths</u>	<u>Square Footage</u>	
				<u>Living Area</u>	<u>Basement or crawl space</u>
A-127	127 Murphy's Crossing Drive	4	3	2,387	952
A-133	133 Murphy's Crossing Drive	2	2½	2,322	1,236
A-139	139 Murphy's Crossing Drive	3	3	2,247	952
B-104	104 Murphy's Crossing Drive	4	3	2,387	952
B-110	110 Murphy's Crossing Drive	2	2½	2,322	1,236
B-116	116 Murphy's Crossing Drive	3	3	2,247	952
B-122	122 Murphy's Crossing Drive	2	2½	2,096	988
C-119	119 Murphy's Crossing Drive	4	3	2,387	952
C-125	125 Murphy's Crossing Drive	2	2½	2,322	1,236
D-97	97 Murphy's Crossing Drive	4	3	2,387	952
D-103	103 Murphy's Crossing Drive	2	2½	2,096	988
D-109	109 Murphy's Crossing Drive	2	2½	2,092	1,034
E-92	92 Murphy's Crossing Drive	3	2½	2,413	1,491
E-245	245 Murphy's Green	3	2½	2,319	1,422
E-253	253 Murphy's Green	4	2½	2,411	1,545
E-261	261 Murphy's Green	4	2½	2,411	1,236
*	K-43 43 Murphy's View Place	3	2½	2,540	1,556
*	K-51 51 Murphy's View Place	4	3	2,539	1,571
*	K-59 59 Murphy's View Place	3	2½	2,487	1,549
*	K-270 270 Murphy's Green	4	3	2,539	1,571

(1) Some Units Contain a loft and bonus room (some bonus rooms are unfinished)

* Unit added by this amendment

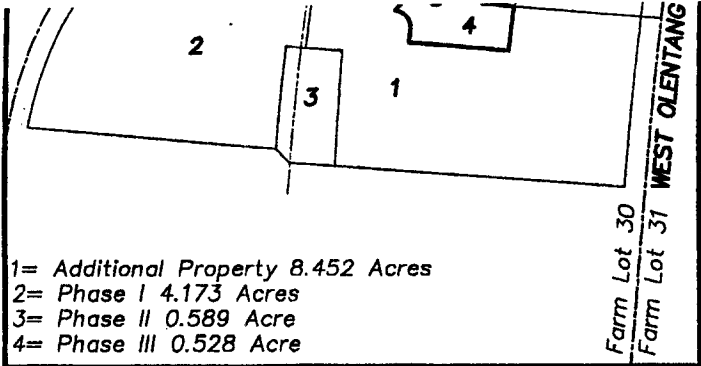

SITE MAP
NOT TO SCALE

All areas not designated by Unit Designation are Common Elements.

Situated in the State of Ohio, County of Delaware, City of Powell, being in Farm Lot 30, Quarter Township 4, Township 3, Range 19, United States Military Lands, containing 0.528 acre of land, more or less, said 0.528 acre being part of that 13.742 acre tract of land described in the deed to CCBI Murphy's X, LLC, of record in Official Record Volume 560, Page 783, Recorder's Office, Delaware County, Ohio.

The bearings given in this plat are based on the bearing of S82°21'56"E for the centerline of West Olentangy Street as it is delineated upon the recorded plat of Murphy's Park Section 1, Cabinet 2, Slides 647A, 647B and 647C, Recorder's Office, Delaware County, Ohio.


Easement Reference
1) O.R.V. 469, P. 1029 Columbus Southern Power Company 10' wide easement centered on electric cable as installed
2) O.R.V. 480, P. 486 Columbia Gas of Ohio 10' wide easement centered on pipeline as installed

BAUER, DAVIDSON & MERCHANT, INC.
I certify that this drawing, consisting of 1 sheet, accurately reflects the location of improvements and recorded easements of Murphy's Crossing Condominium Phase III Second Amendment.
BAUER, DAVIDSON & MERCHANT, INC.
CONSULTING ENGINEERS

BY *Gatis Erenpreiss* 8-11-2006
Gatis Erenpreiss
Professional Surveyor No. 5572

ROBERT LOUIS FIORITA
I certify that these drawings, consisting of sheets 2 through —, accurately shows each building of Murphy's Crossing Condominium Phase III Second Amendment, as constructed.



ROBERT LOUIS FIORITA
Robert Louis Fiorita 8-21-06
Robert Louis Fiorita
Registered Architect No. 9138

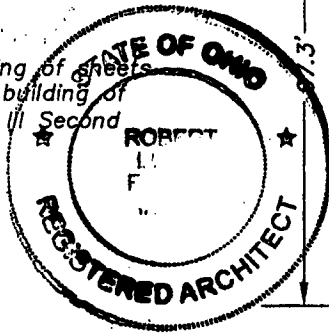


1 inch = VOL 0732 PAGE 0364A

- LEGEND
- = 3/4-Inch (I.D.) Iron Pipe Set (with plastic cap in top marked B.D.M. #1)
 - 51 = Unit Designation (Typical)
 - (K) = Building Designation
 - [Hatched Box] = Limited Common Elements

The Village of Murphy Park Condominium Association and Rockford Homes
1.173 Ac. Storm Water Drainage Easement
O.R.V. 381, P. 1281

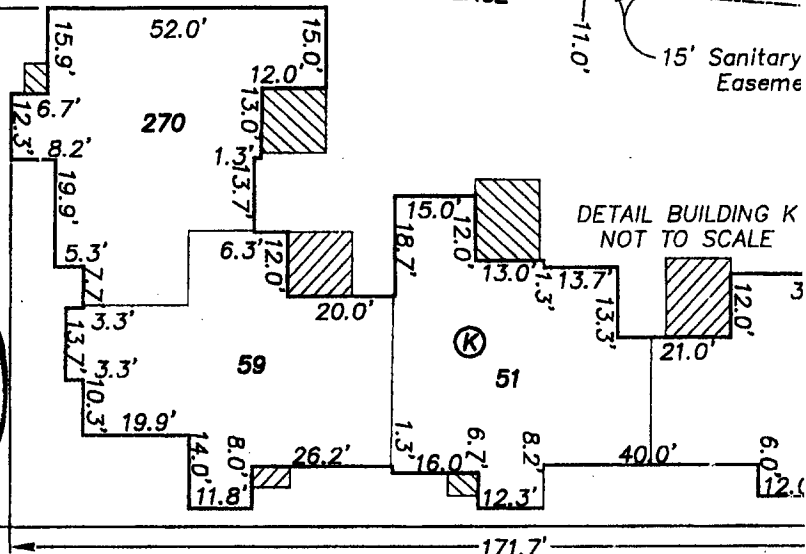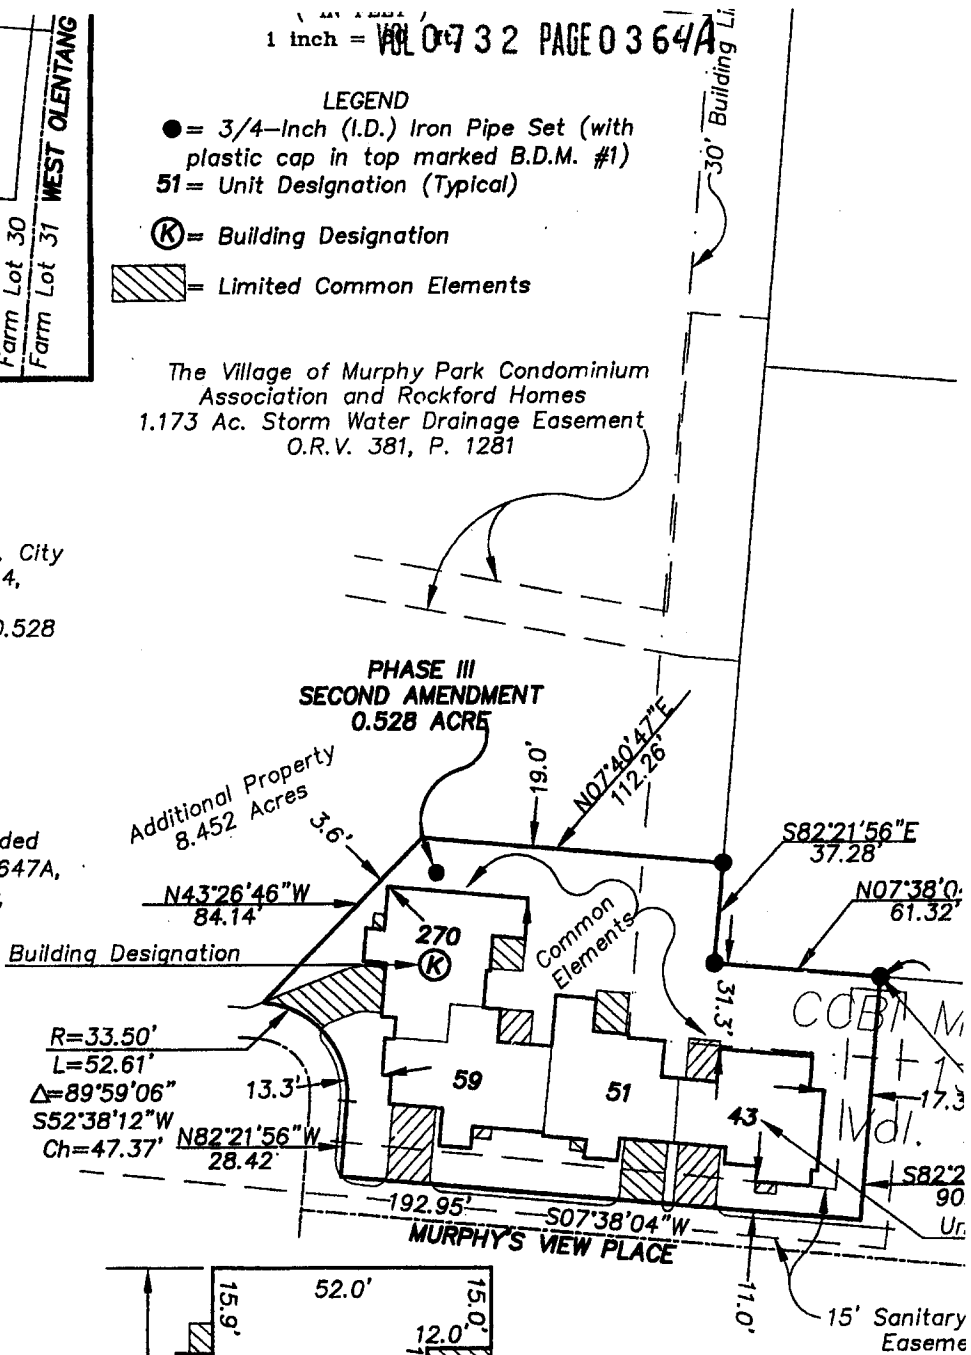

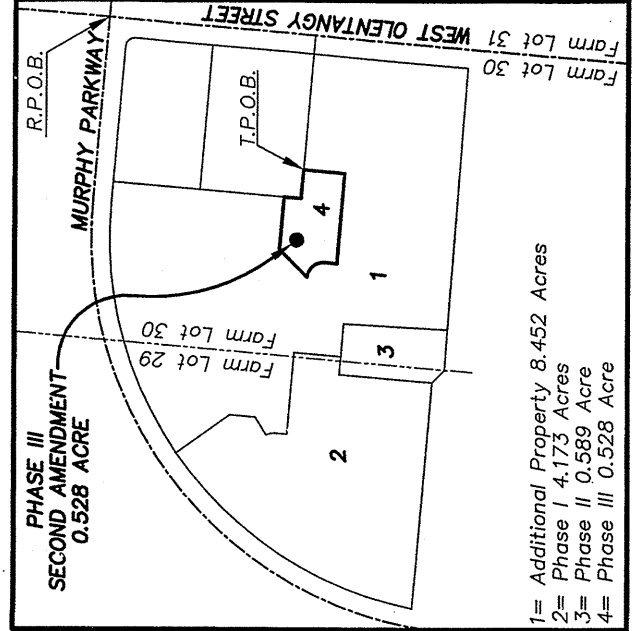

SITE MAP
NOT TO SCALE

All areas not designated by Unit Designation are Common Elements.

Situated in the State of Ohio, County of Delaware, City of Powell, being in Farm Lot 30, Quarter Township 4, Township 3, Range 19, United States Military Lands, containing 0.528 acre of land, more or less, said 0.528 acre being part of that 13.742 acre tract of land described in the deed to CCBI Murphy's X, LLC, of record in Official Record Volume 560, Page 783, Recorder's Office, Delaware County, Ohio.

The bearings given in this plat are based on the bearing of S82°21'56"E for the centerline of West Olenangy Street as it is delineated upon the recorded plat of Murphy's Park Section 1, Cabinet 2, Slides 647A, 647B and 647C, Recorder's Office, Delaware County, Ohio.


- Easement Reference
- 1) O.R.V. 469, P. 1029 Columbus Southern Power Company 10' wide easement centered on electric cable as installed
 - 2) O.R.V. 480, P. 486 Columbia Gas of Ohio 10' wide easement centered on pipeline as installed

BAUER, DAVIDSON & MERCHANT, INC.
I certify that this drawing, consisting of 1 sheet, accurately reflects the location of improvements and recorded easements of Murphy's Crossing Condominium Phase III Second Amendment.
BAUER, DAVIDSON & MERCHANT, INC.
CONSULTING ENGINEERS

BY *Robert Louis Fiorita* 8-11-2006
Gatis Erenpreis
Professional Surveyor No. 5572

ROBERT LOUIS FIORITA
I certify that these drawings, consisting of sheets 2 through 4, accurately shows each building of Murphy's Crossing Condominium Phase III Second Amendment, as constructed.
ROBERT LOUIS FIORITA

BY *Robert Louis Fiorita* 8-21-06
Robert Louis Fiorita
Registered Architect No. 9138

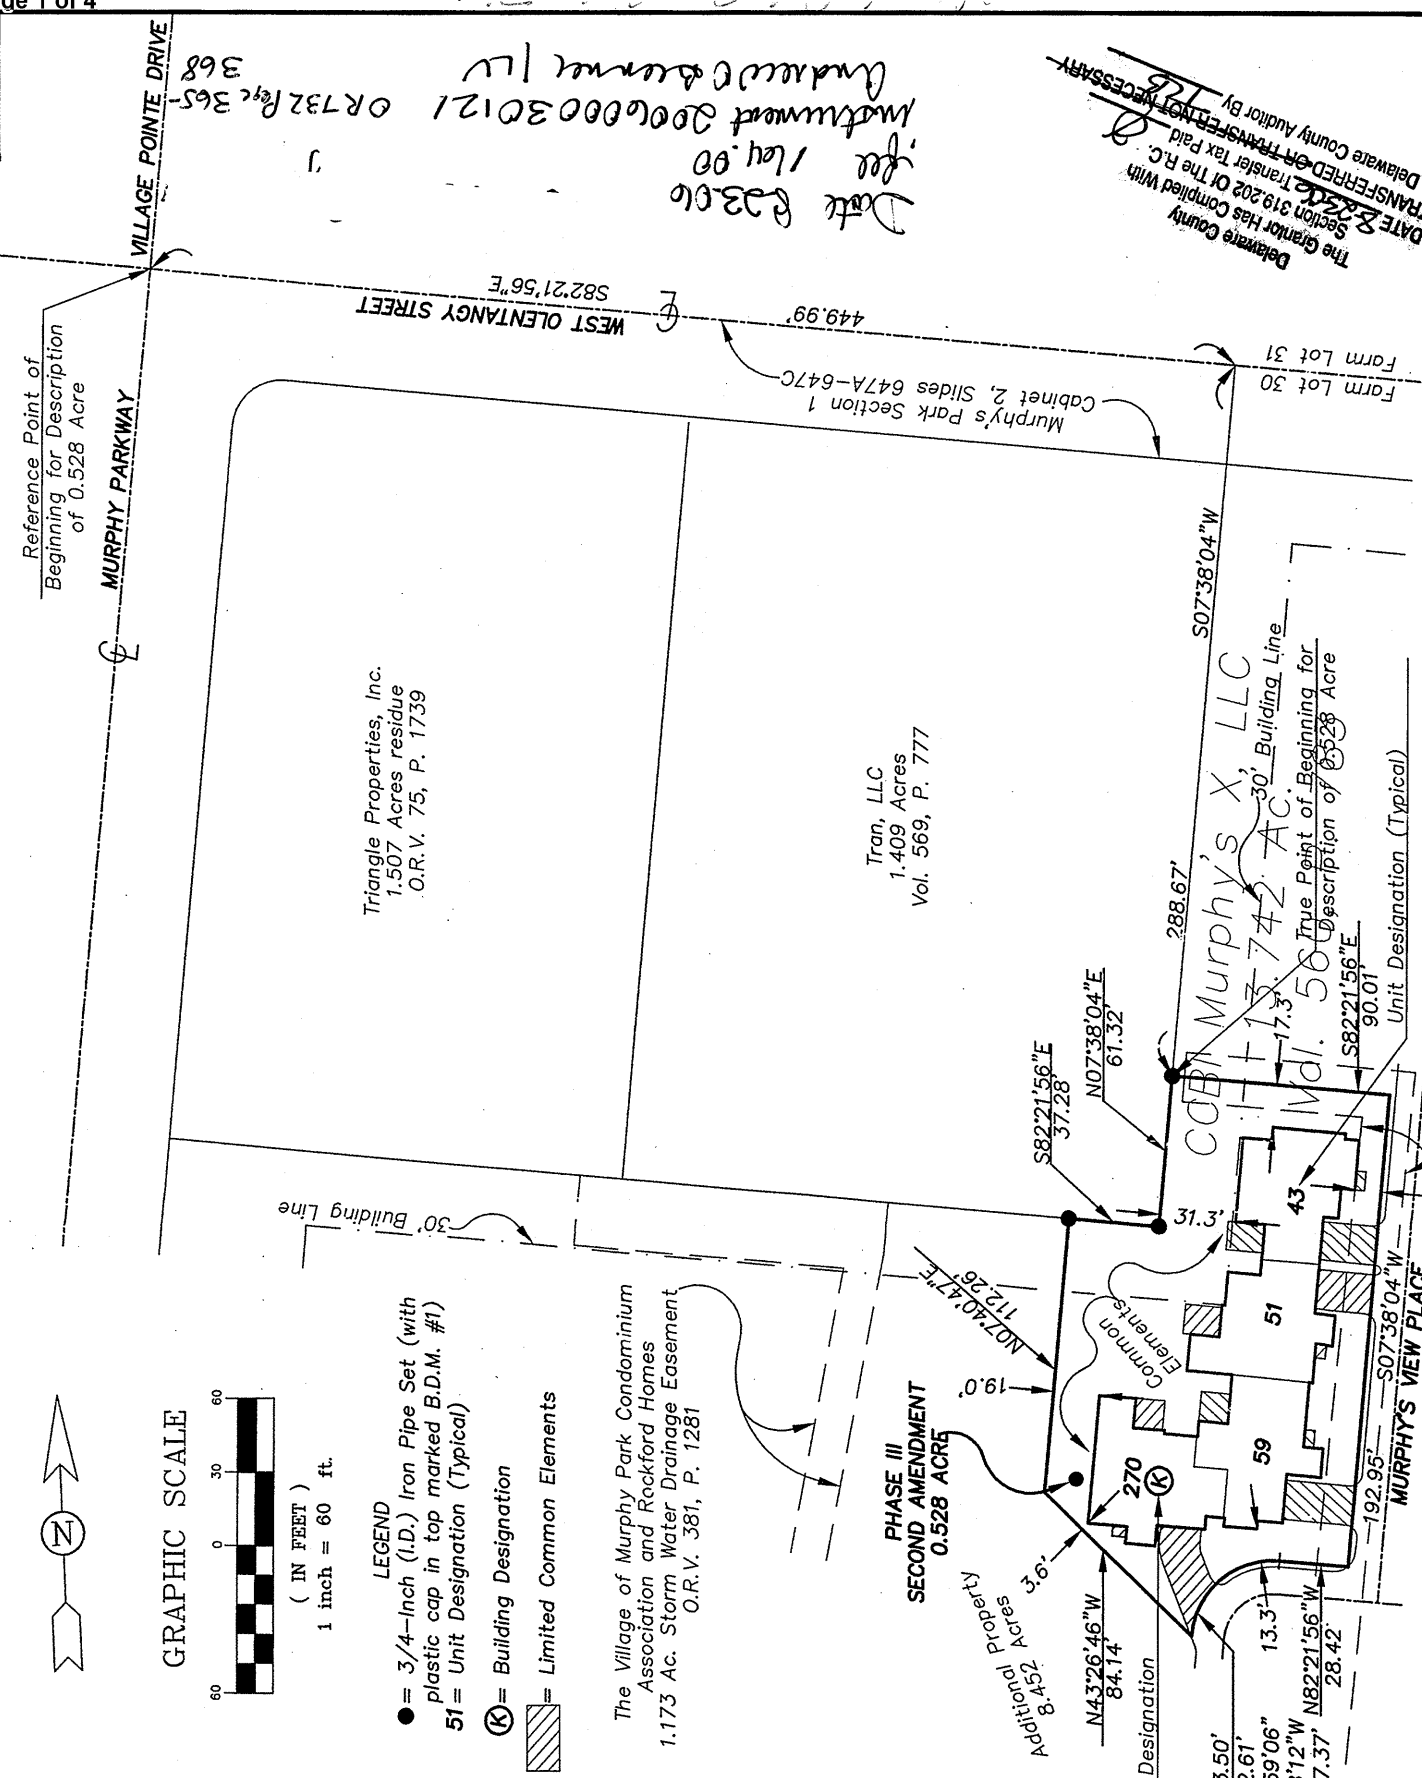

200600030121
Filed for Record in
DELAWARE COUNTY, OHIO
ANDREW D BRENNER
08-23-2006 At 02:09 PM
PLAT 164-00
DR Book 732 Page 365 - 368

DRAWINGS FOR MURPHY'S CROSSING CONDOMINIUM PHASE III SECOND AMENDMENT

BAUER, DAVIDSON & MERCHANT, INC.
Consulting Engineers
Order No. 885-05
Dwn 05\88505\8855phase3.dwg R 11/06 407

255 Green Meadows Drive S.
Westerville, Ohio 43081
(614) 846-3393

CONTRACTOR:
CUGINI & CAPOCCIA BUILDER INC.
165 GREEN MEADOWS DRIVE SOUTH
WESTERVILLE, OHIO 43081
PHONE: (614) 846-0082
FAX: (614) 846-0080

PROJECT NO.
8.9.2006
DATE
REL. FOR COMMENT


SCALE: VARIES

PLAT DRAWING
BUILDING "K"

SHEET NUMBER
A1

THE VILLAGE AT MURPHY'S CROSSING UNITS 37, 38, 39 & 40

OR 732 Page 366

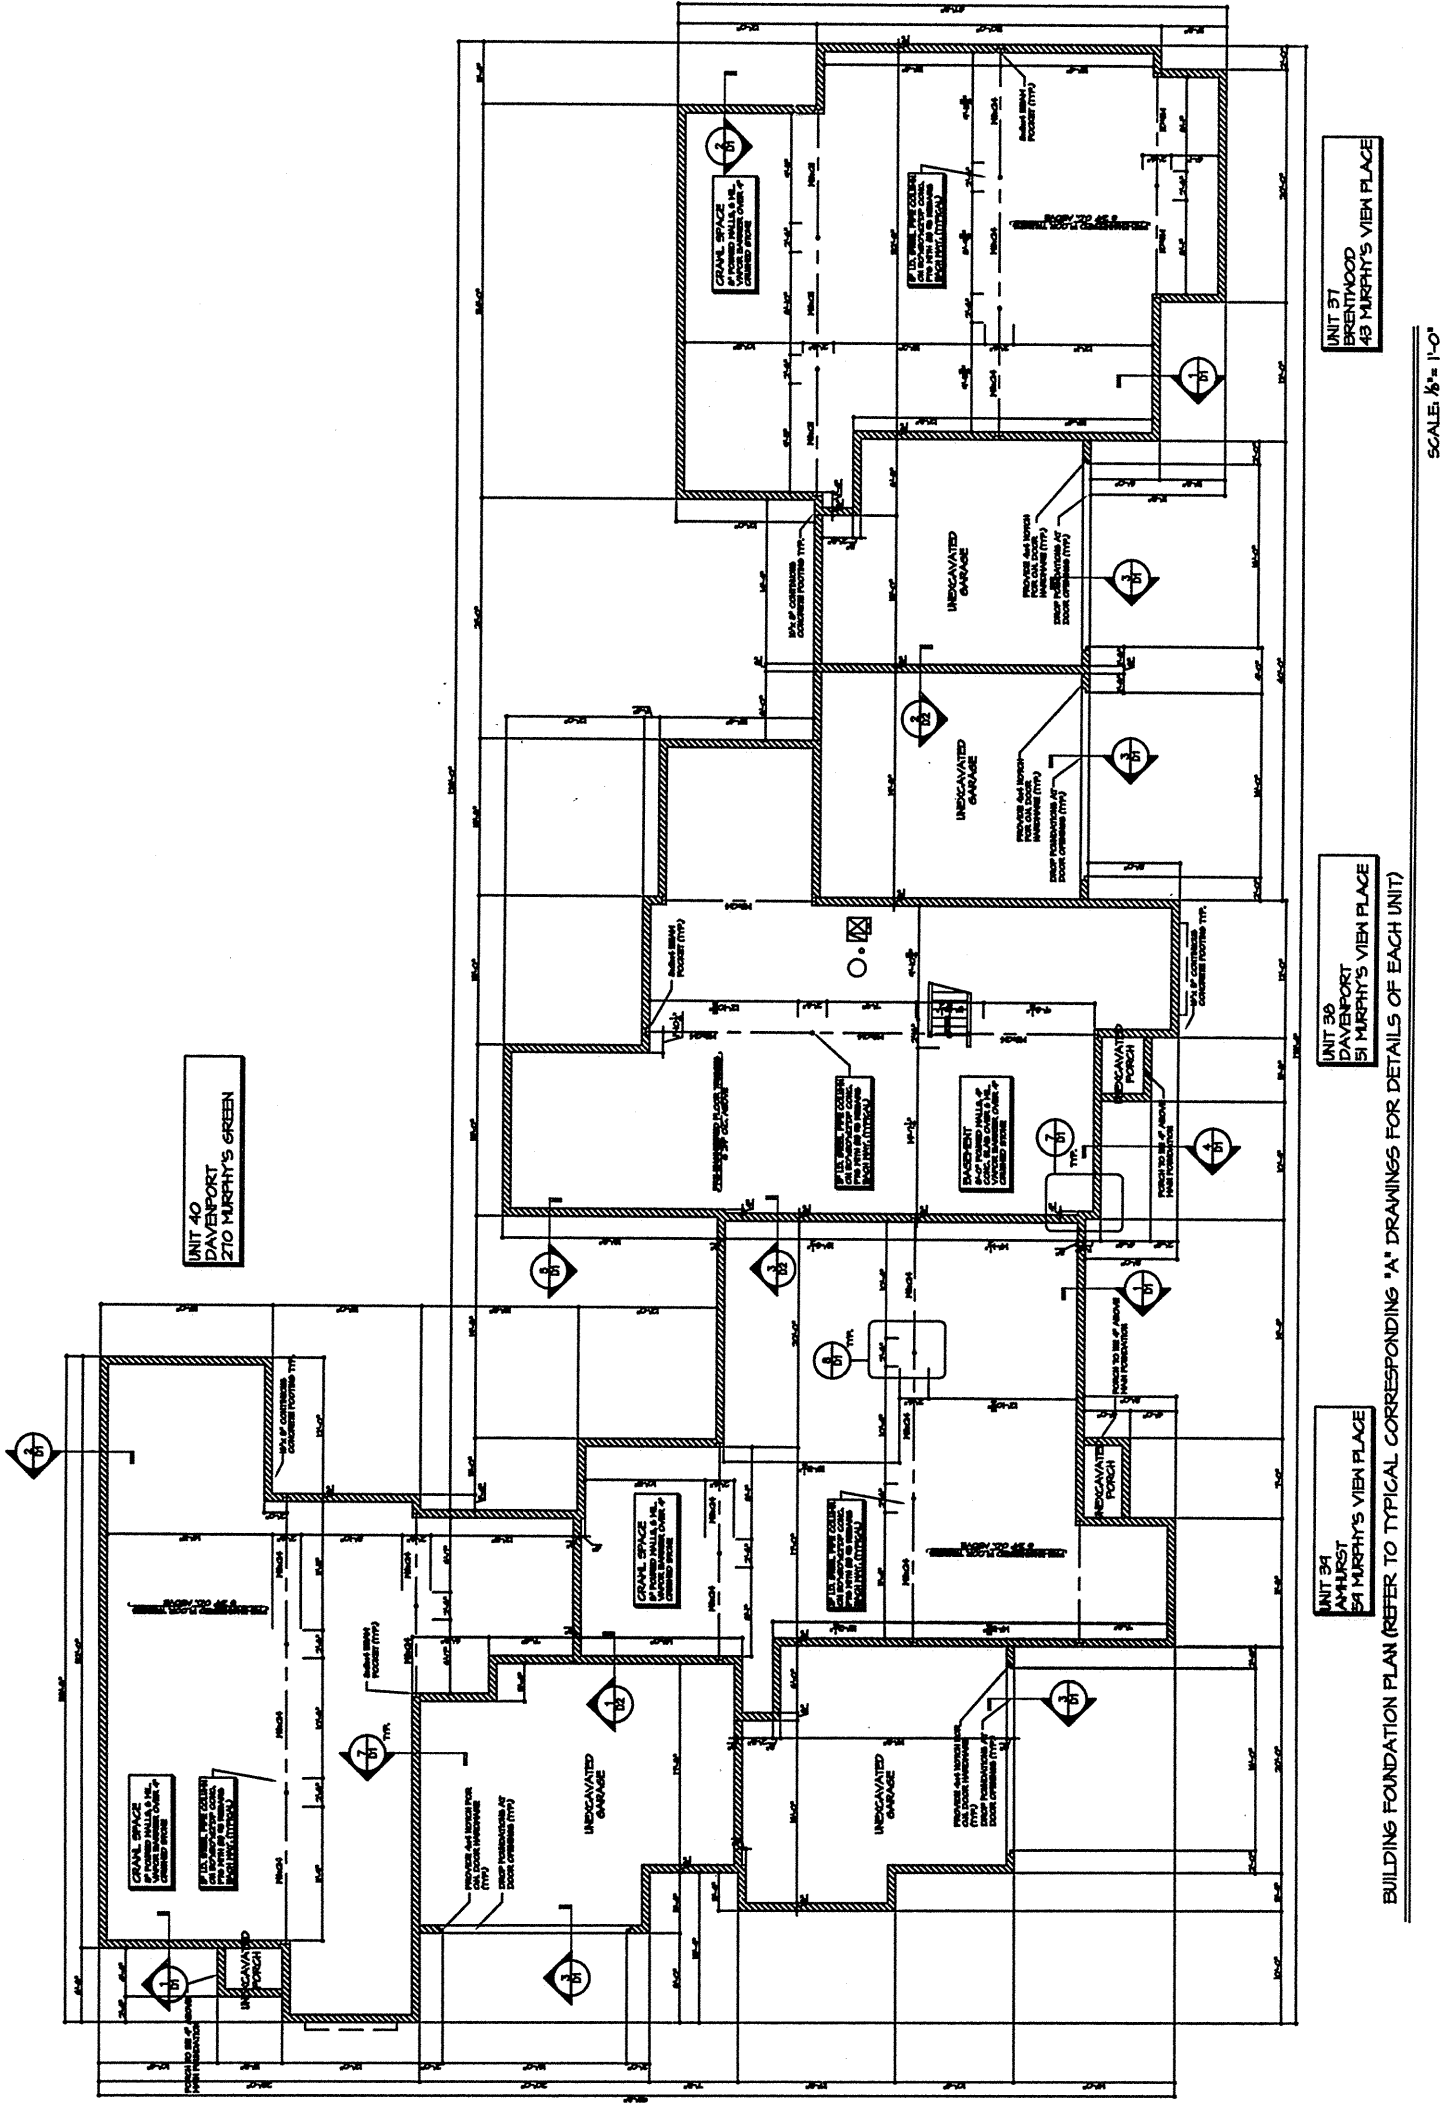

CONTRACTOR:
CUGINI & CAPOCCIA BUILDER INC.
166 GREEN MEADOWS DRIVE SOUTH
WESTERVILLE, OHIO 43081
PHONE: (614) 848-0082
FAX: (614) 848-0080

DATE:
9.9.2006
REL. FOR COMPL.

PROJECT NO.
261

PLAT DRAWING
BUILDING "K"


SCALE: 1/8" = 1'-0"

REVISION

A2
SHEET NUMBER

THE VILLAGE AT MURPHY'S CROSSING UNITS 37, 38, 39 & 40

OR 732 Page 367

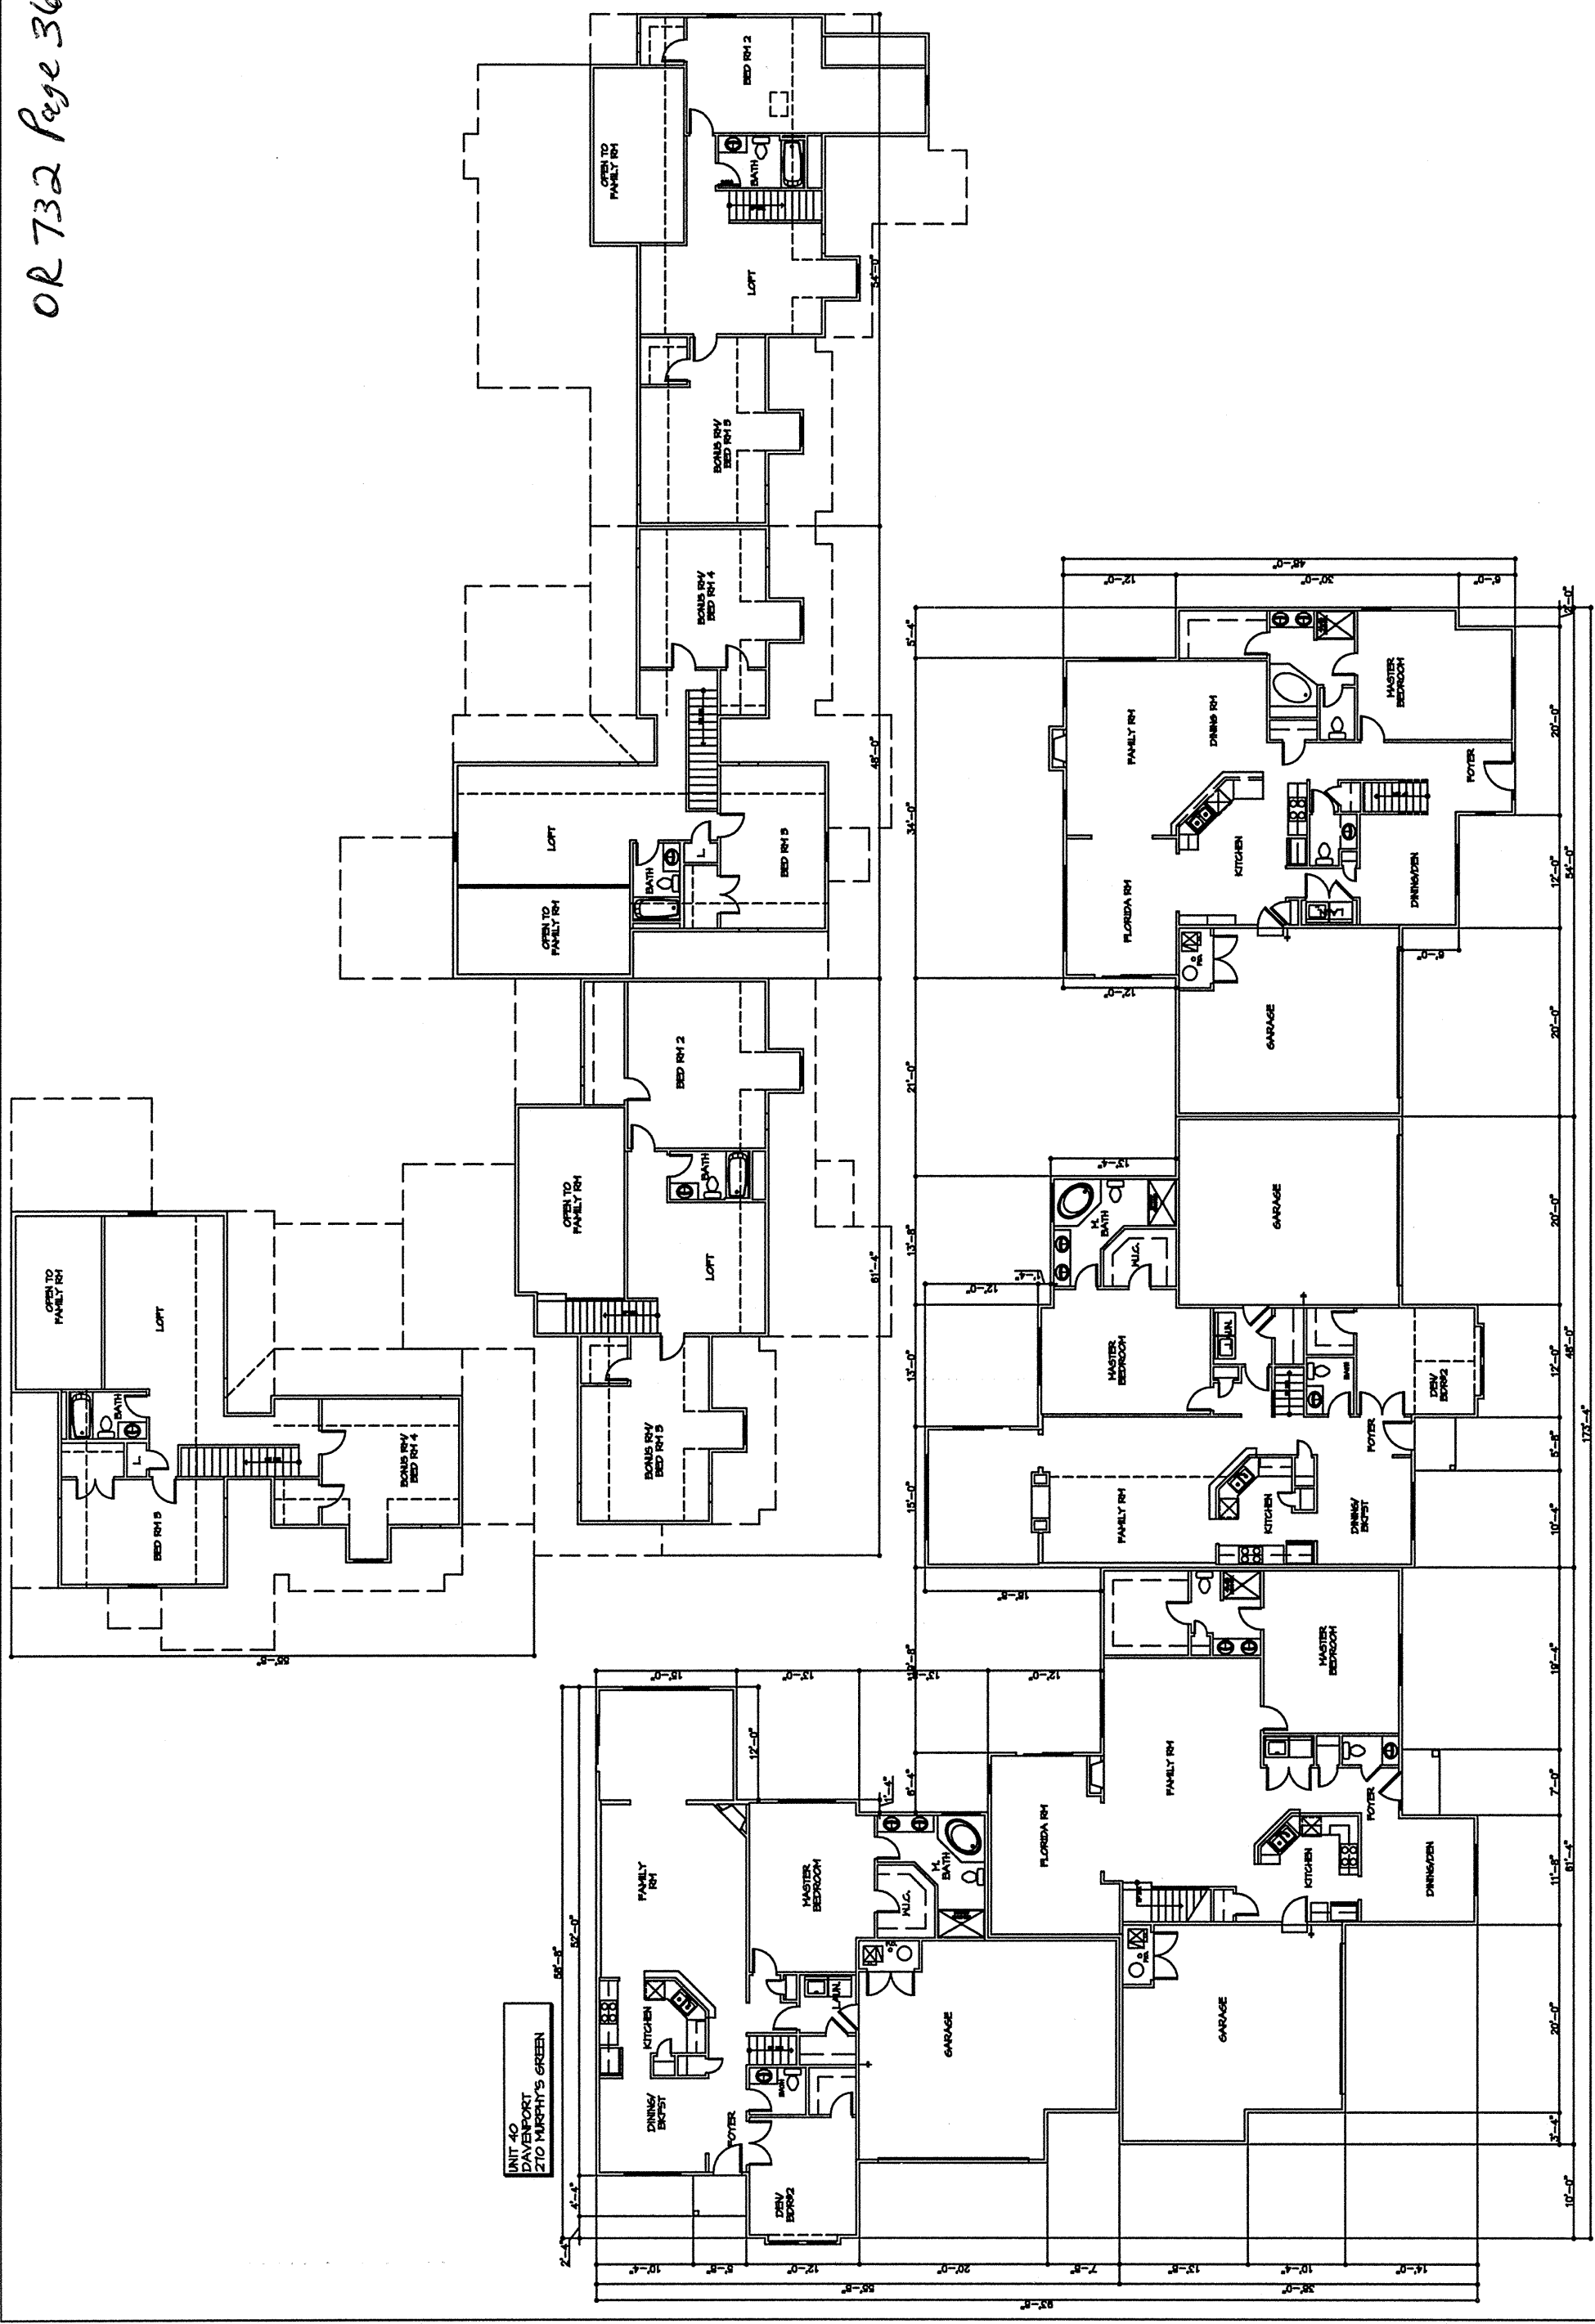

UNIT 37
BRENTWOOD
49 MURPHY'S VILLAGE

UNIT 38
DAVENPORT
51 MURPHY'S VILLAGE

UNIT 39
DAVENPORT
51 MURPHY'S VILLAGE

UNIT 40
DAVENPORT
270 MURPHY'S GREEN

SCALE: 1/8" = 1'-0"

BUILDING FIRST & SECOND FLOOR PLANS (REFER TO TYPICAL CORRESPONDING "A" DRAWINGS FOR DETAILS OF EACH UNIT)

CONTRACTOR:
165 GREEN MEADOWS DRIVE SOUTH
WESTERVILLE, OHIO 43081

CUGINI & CAPOCCIA BUILDER INC.
PHONE: (614) 848-0082
FAX: (614) 848-0082

PROJECT NO.
261

DATE
8.9.2006

IN. FOR COMMENT

SCALE: 1/8" = 1'-0"

PLAT DRAWING
BUILDING "K"

REVISION


SHEET NUMBER
A3

0 R 732 Page 368

UNIT 34
AMHERST
54 MURPHY'S VIEIN PLACE

UNIT 36
DAVENPORT
51 MURPHY'S VIEIN PLACE


UNIT 37
BRENTWOOD
40 MURPHY'S VIEIN PLACE

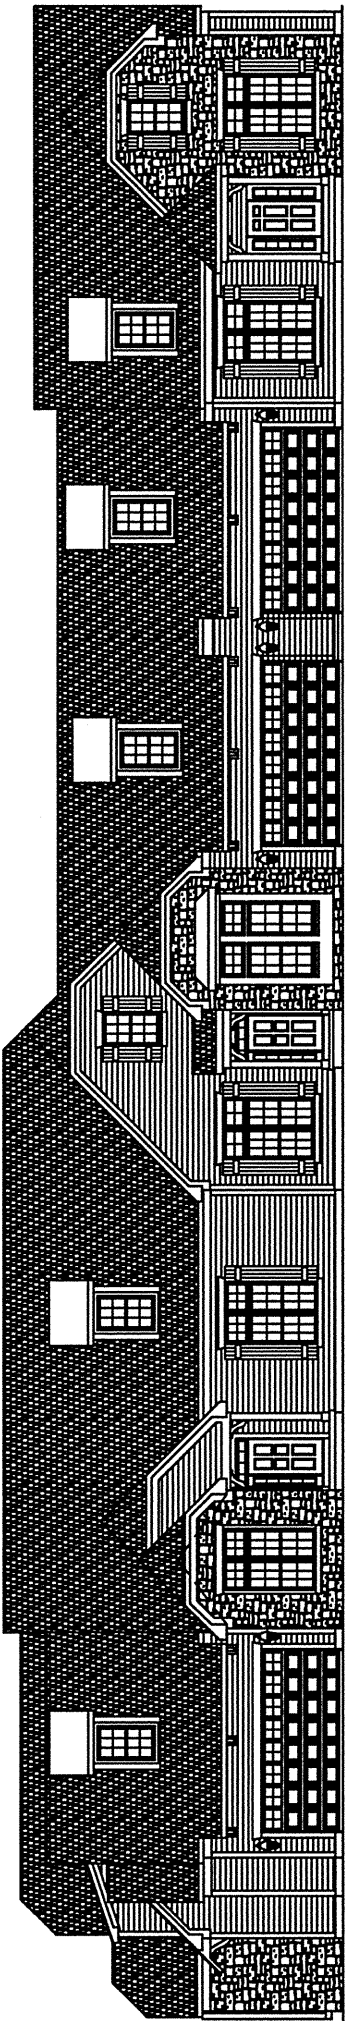

BUILDING FRONT ELEVATION (REFER TO TYPICAL CORRESPONDING "A" DRAWINGS FOR DETAILS OF EACH UNIT)

SCALE: 1/8" = 1'-0"


UNIT 38
AMHERST
54 MURPHY'S VIEIN PLACE

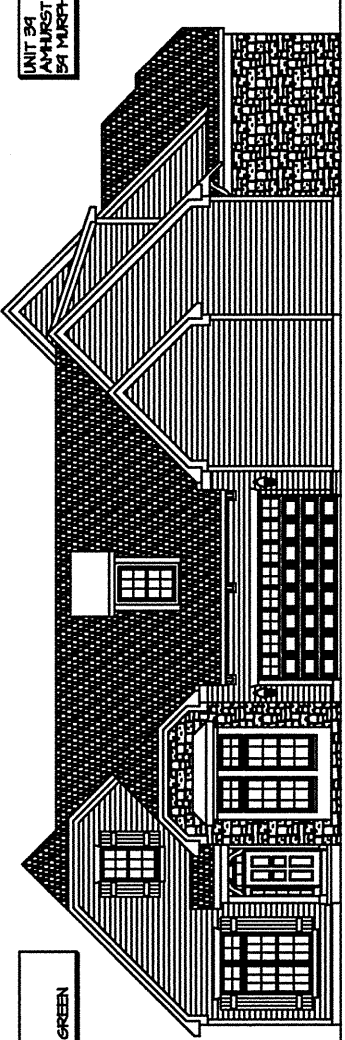

BUILDING FRONT ELEVATION (REFER TO TYPICAL CORRESPONDING "A" DRAWINGS FOR DETAILS OF EACH UNIT)

SCALE: 1/8" = 1'-0"


UNIT 40
DAVENPORT
270 MURPHY'S GREEN

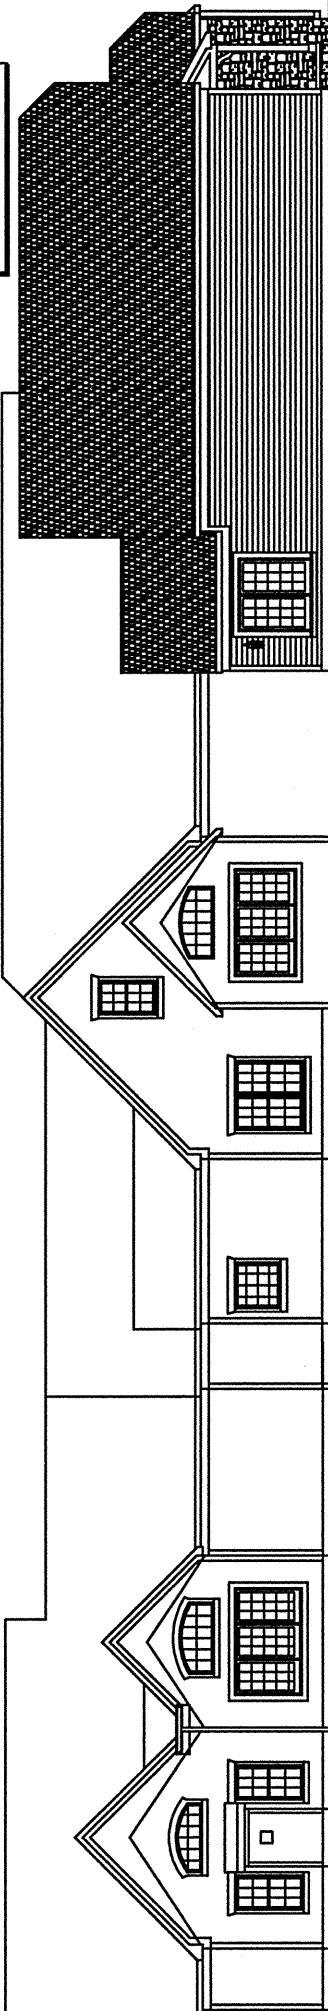

BUILDING FRONT ELEVATION (REFER TO TYPICAL CORRESPONDING "A" DRAWINGS FOR DETAILS OF EACH UNIT)

SCALE: 1/8" = 1'-0"


UNIT 37
BRENTWOOD
40 MURPHY'S VIEIN PLACE

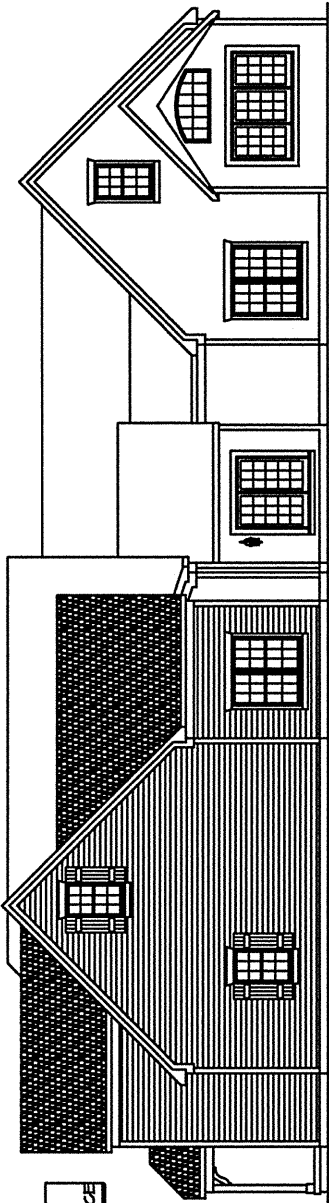

BUILDING FRONT ELEVATION (REFER TO TYPICAL CORRESPONDING "A" DRAWINGS FOR DETAILS OF EACH UNIT)

SCALE: 1/8" = 1'-0"


UNIT 38
AMHERST
54 MURPHY'S VIEIN PLACE

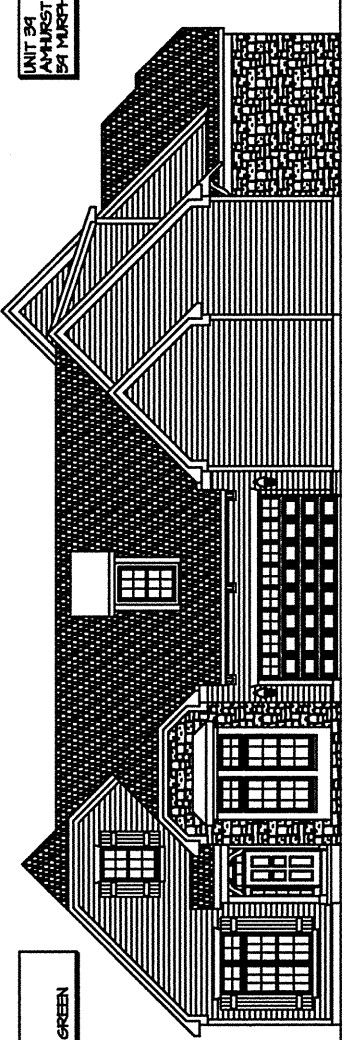

BUILDING BACK ELEVATION (REFER TO TYPICAL CORRESPONDING "A" DRAWINGS FOR DETAILS OF EACH UNIT)

SCALE: 1/8" = 1'-0"


UNIT 40
DAVENPORT
270 MURPHY'S GREEN

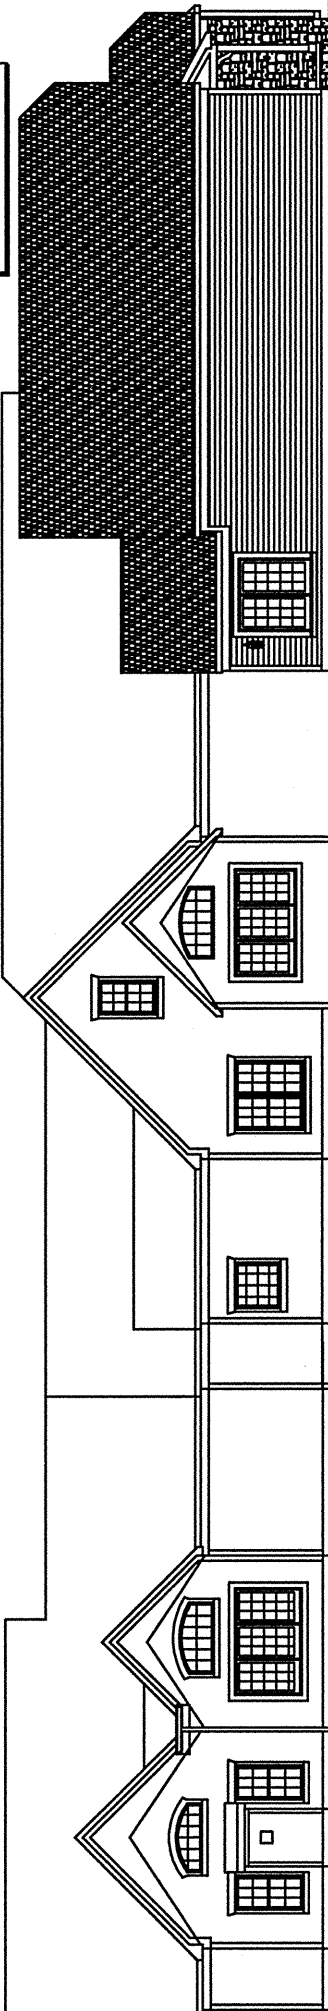

BUILDING BACK ELEVATION (REFER TO TYPICAL CORRESPONDING "A" DRAWINGS FOR DETAILS OF EACH UNIT)

SCALE: 1/8" = 1'-0"

UNIT 37
BRENTWOOD
40 MURPHY'S VIEIN PLACE

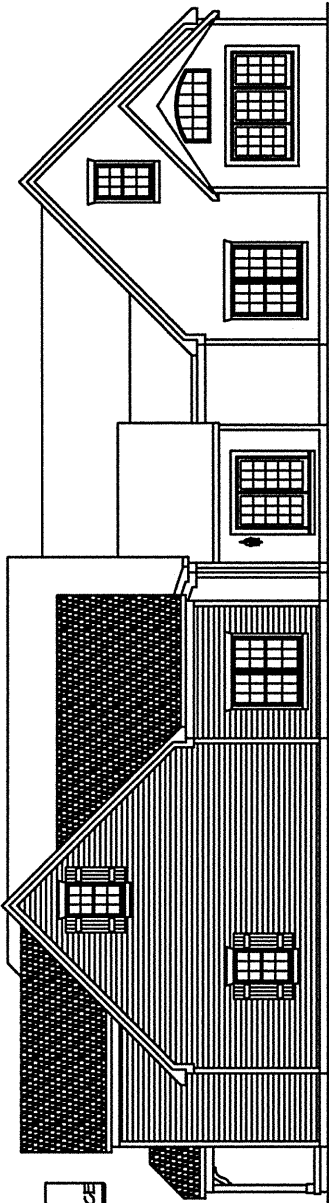

BUILDING BACK ELEVATION (REFER TO TYPICAL CORRESPONDING "A" DRAWINGS FOR DETAILS OF EACH UNIT)

SCALE: 1/8" = 1'-0"

NOTE:
SEE BASE PLANS FOR
SIZE & CORNICE DETAILS

NOTE:
GUTTERS & DOWNSPOUTS
ARE REQUIRED. COORD.
IN FIELD FOR EXACT
LOCATIONS. TIE INTO
UNDERGROUND DRAIN
LINES TO THE STREET
CURE