




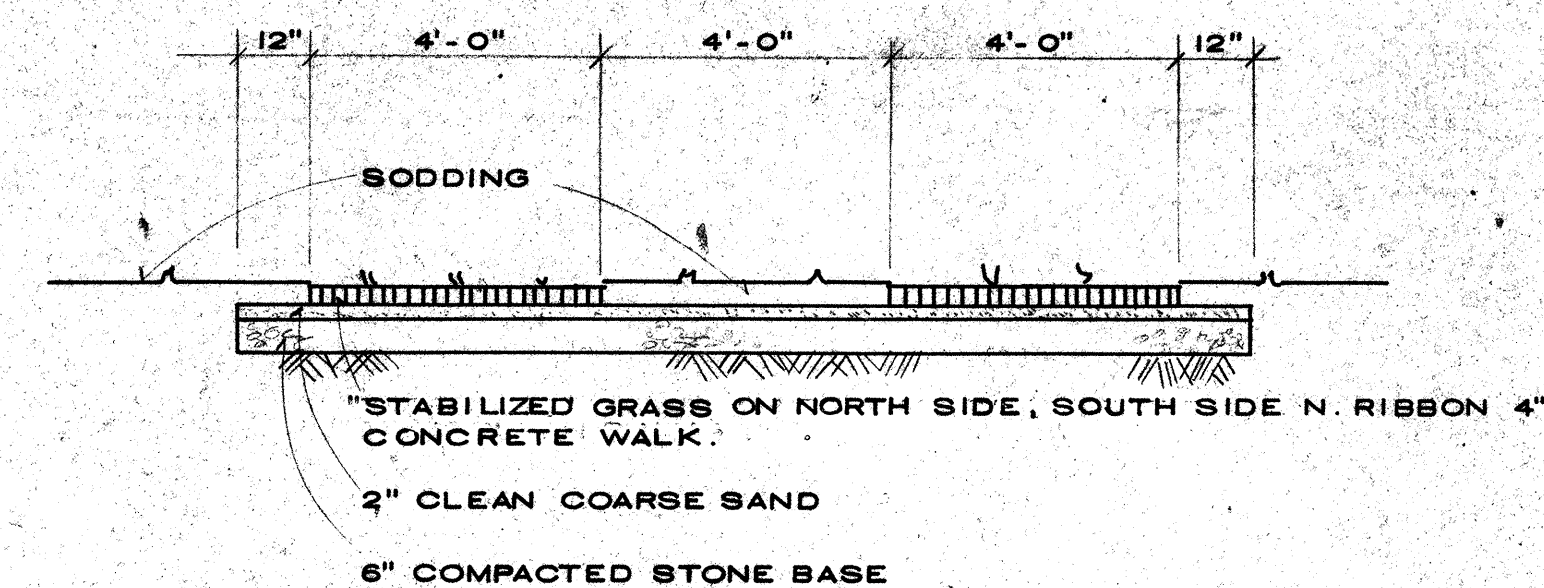

FIRE LANE DET /A4

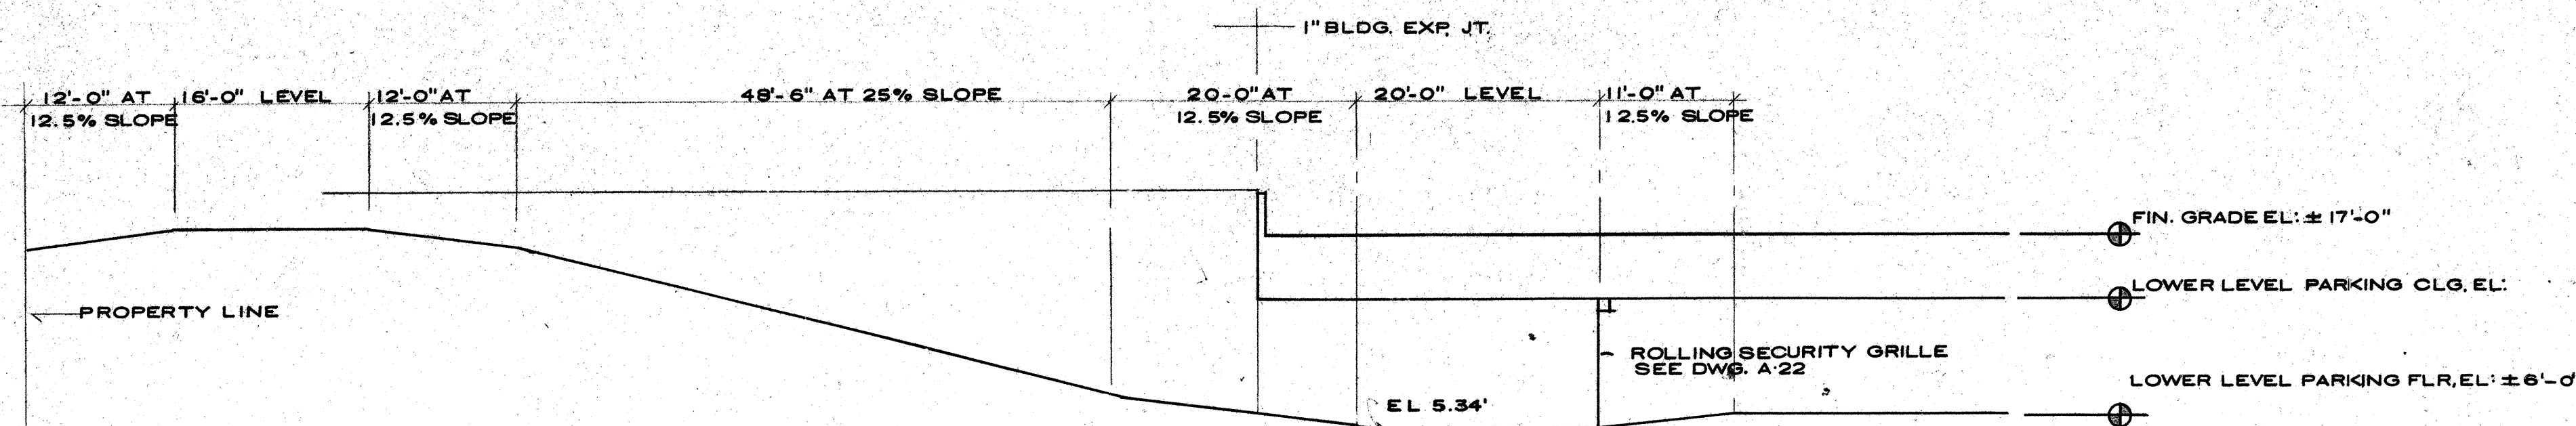

LOWER LEVEL PARKING - RAMP PROFILE

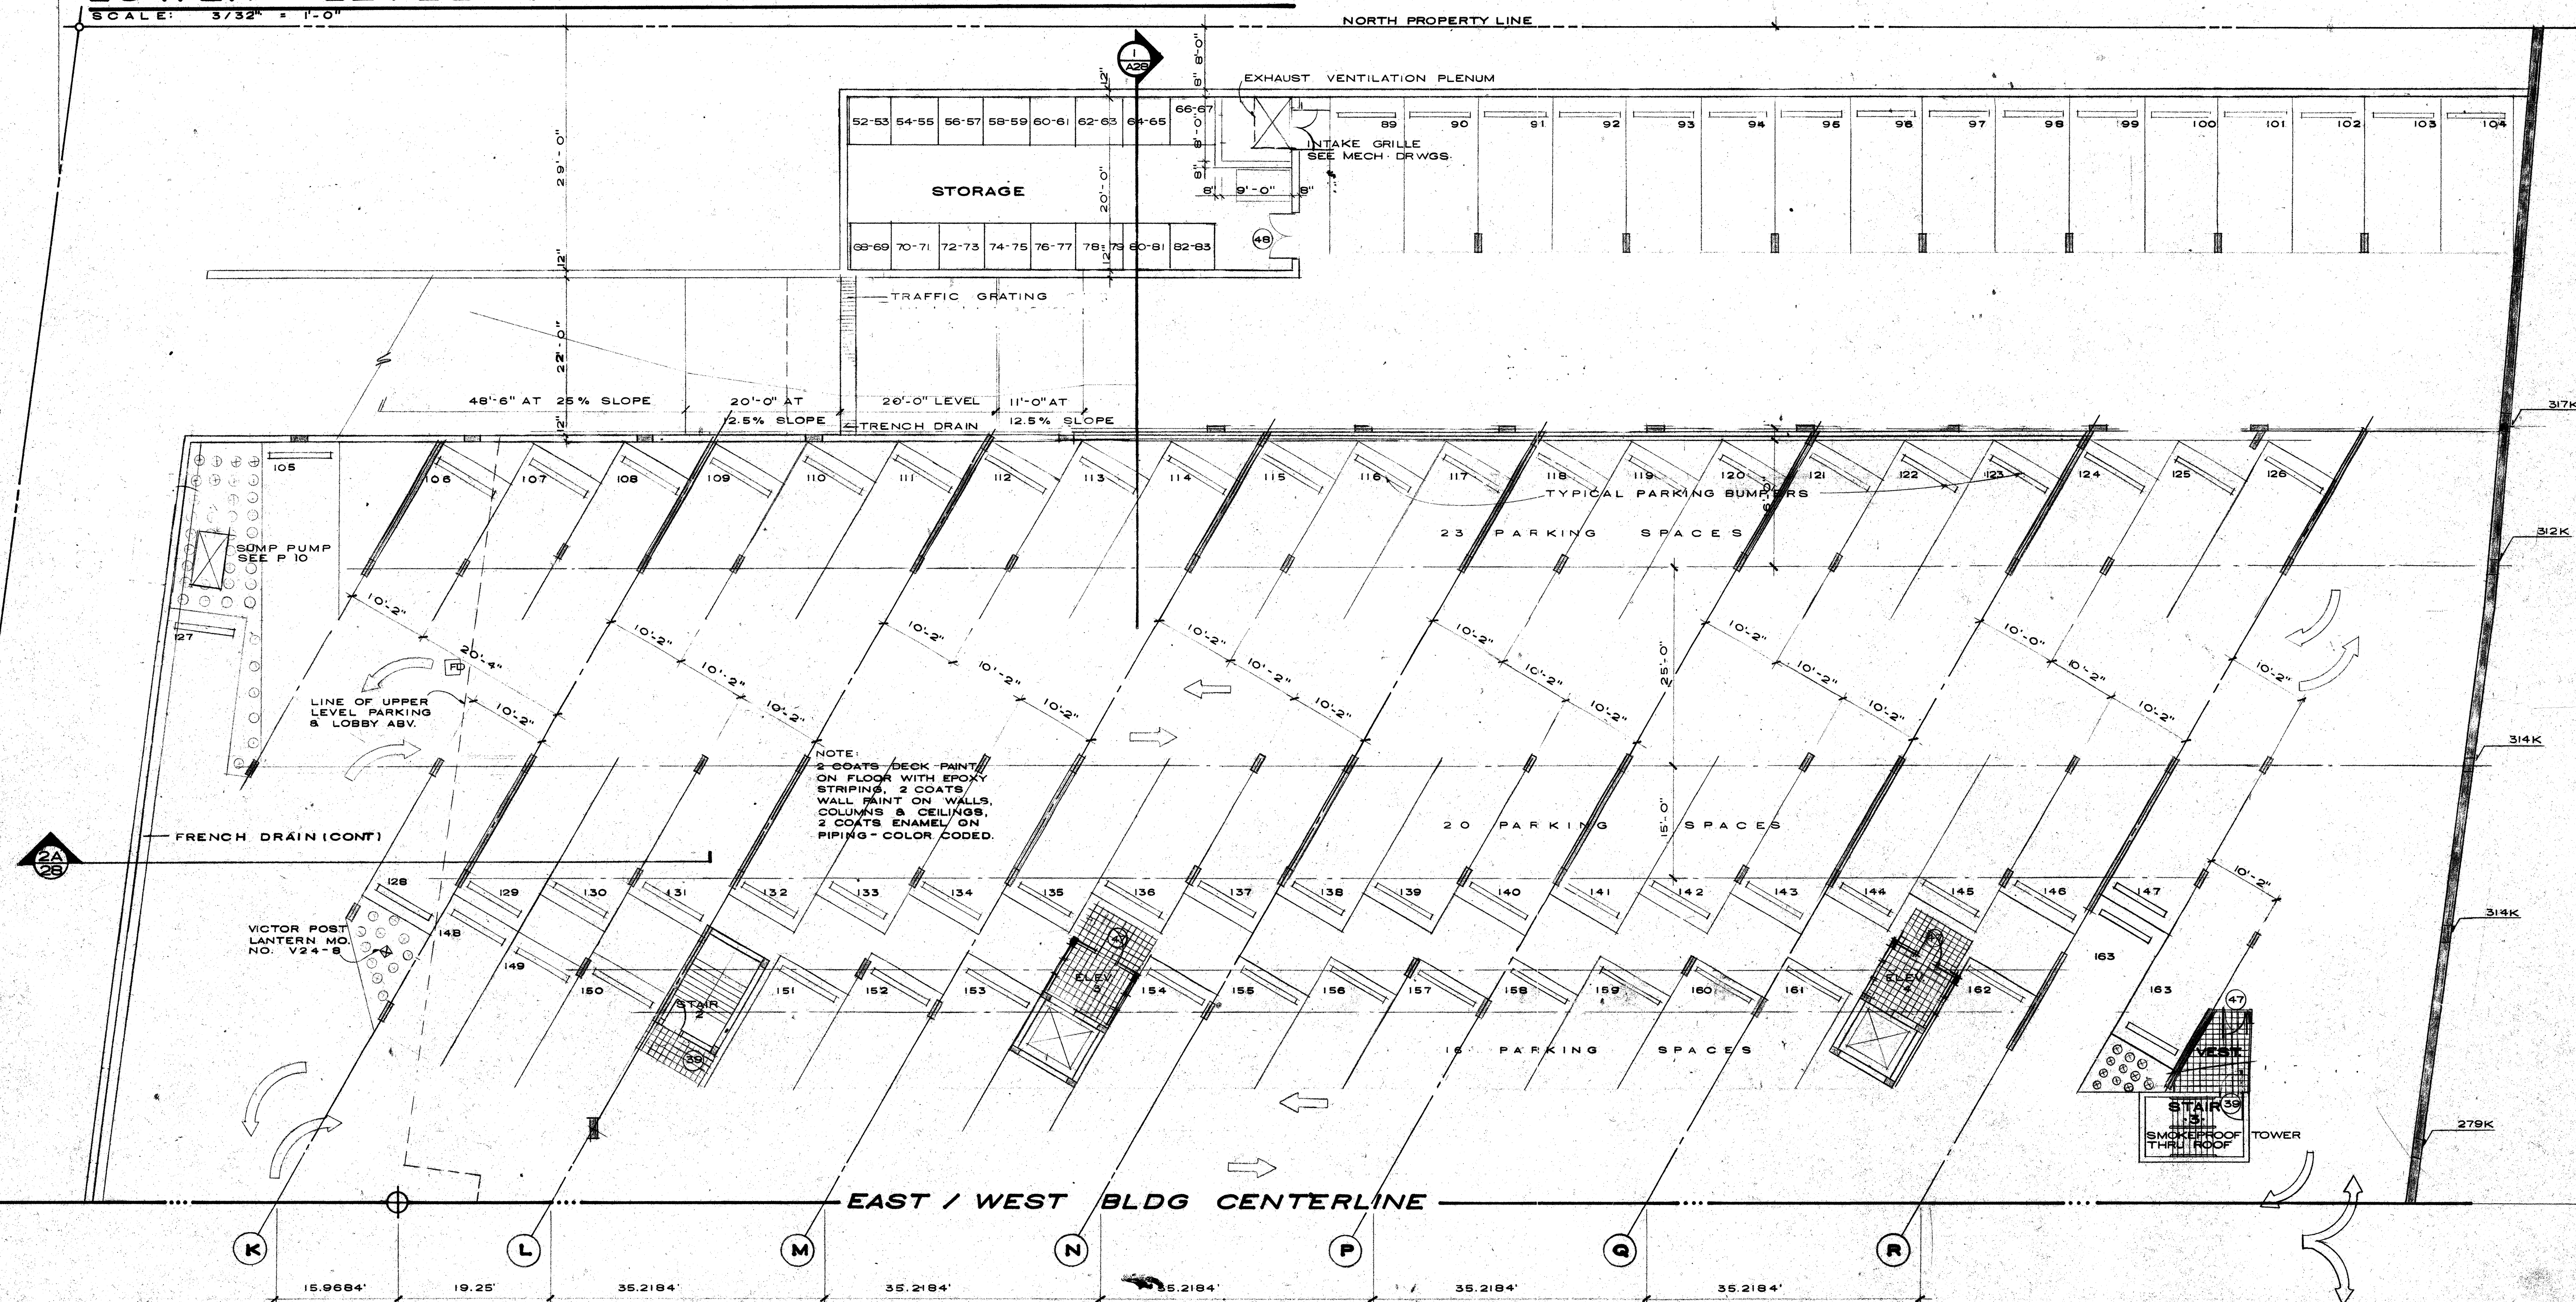

LOWER LEVEL PARKING PLAN / NORTH



L. M. Mayfield

R. WM. CLAYTON JR. ARCHITECT
1995 EAST OAKLAND PARK BLVD. FT. LAUDERDALE, FLA.

C. S. HOUHA CONSULTING ENGINEERS
3460 N.W. 9TH AVENUE OAKLAND PARK, FLA.

OVERLOOK CONDOMINIUM

LOWER LEVEL PARKING PLAN/NORTH

DRAWN BY: WPS
JOB NO. 8101
DATE: 8-12-81
REVISIONS: 6-11-81
8-30-81

ADD E. FRENCH DRAIN
OMIT DRAINS
ELEV.
AS BUILT 2-8-88
SHEET: **A4**

UJLT 2
T: A 4