


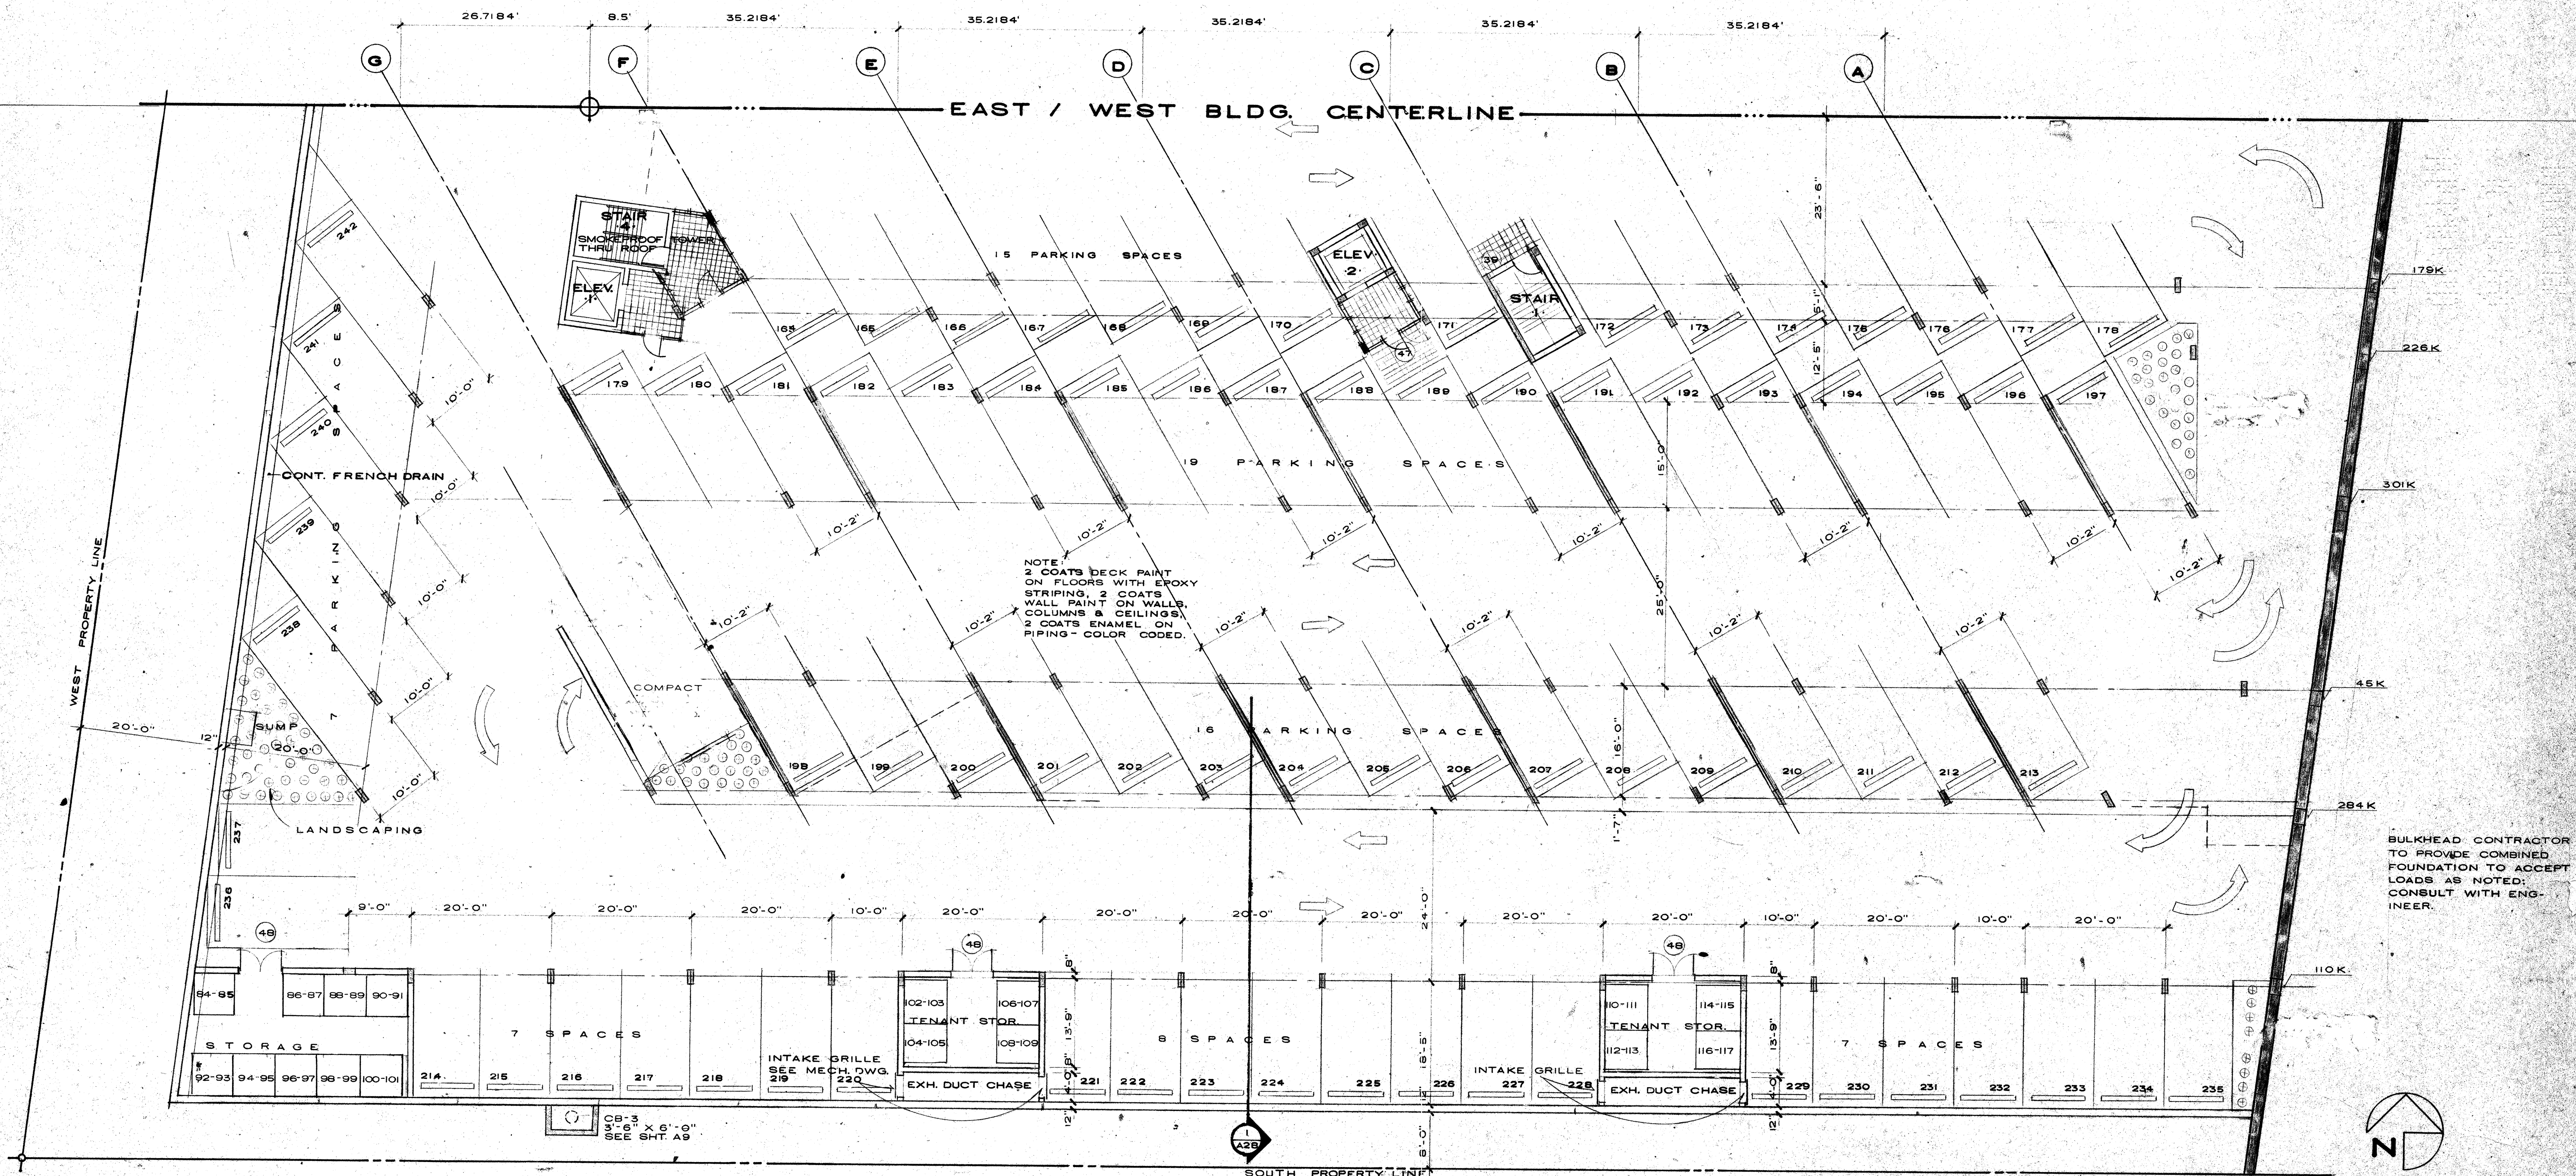

LOWER LEVEL PARKING PLAN / SOUTH

SCALE: 3/32" = 1'-0"

R. Wm. Clayton Jr.

R. WM. CLAYTON JR. ARCHITECT
1935 EAST OAKLAND PARK BLVD. FT. LAUDERDALE, FLA.
C. S. HOUHA CONSULTING ENGINEERS
3460 N.W. 9TH AVENUE OAKLAND PARK, FLA.

OVERLOOK CONDOMINIUM

**FOUNDATION PLAN
LOWER LEVEL PARKING**

DRAWN BY: WPS, ALP
JOB NO: 8101

DATE: 8-12-81
REVISIONS: 6-11-84
8-30-84
OMIT DRAINS
ADD E. FRENCH DRN
AS BUILT 2-8-85

SHEET: **A4A**