


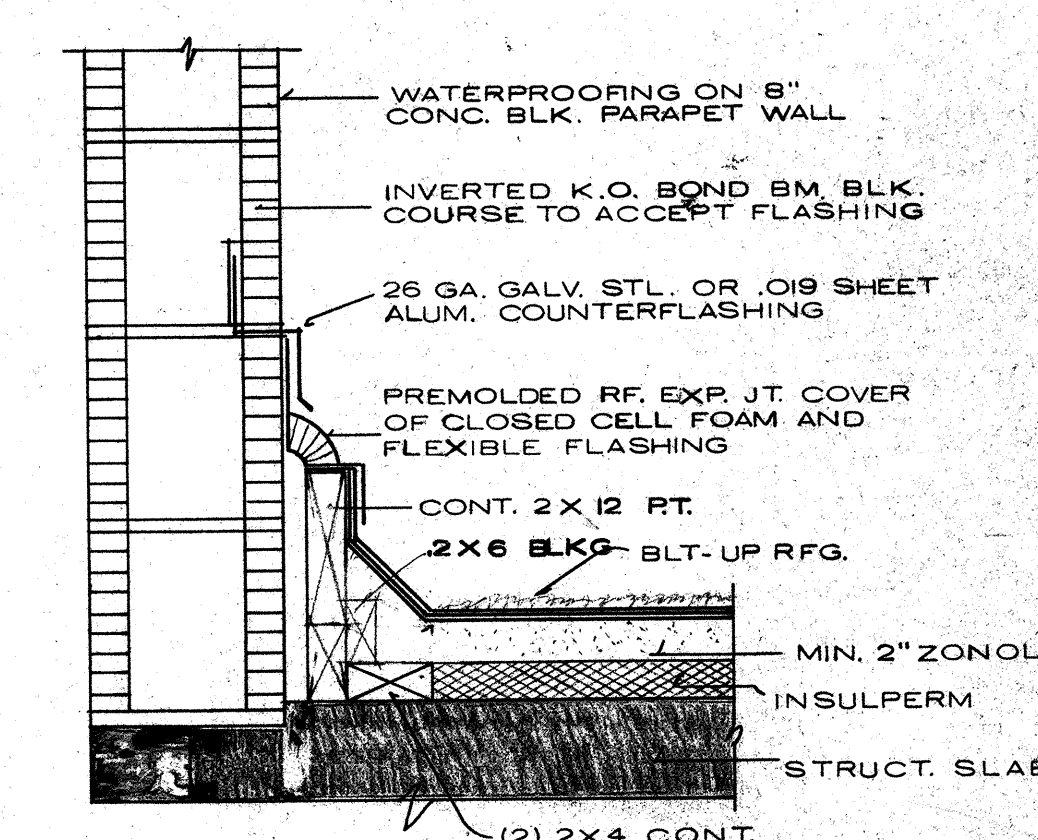


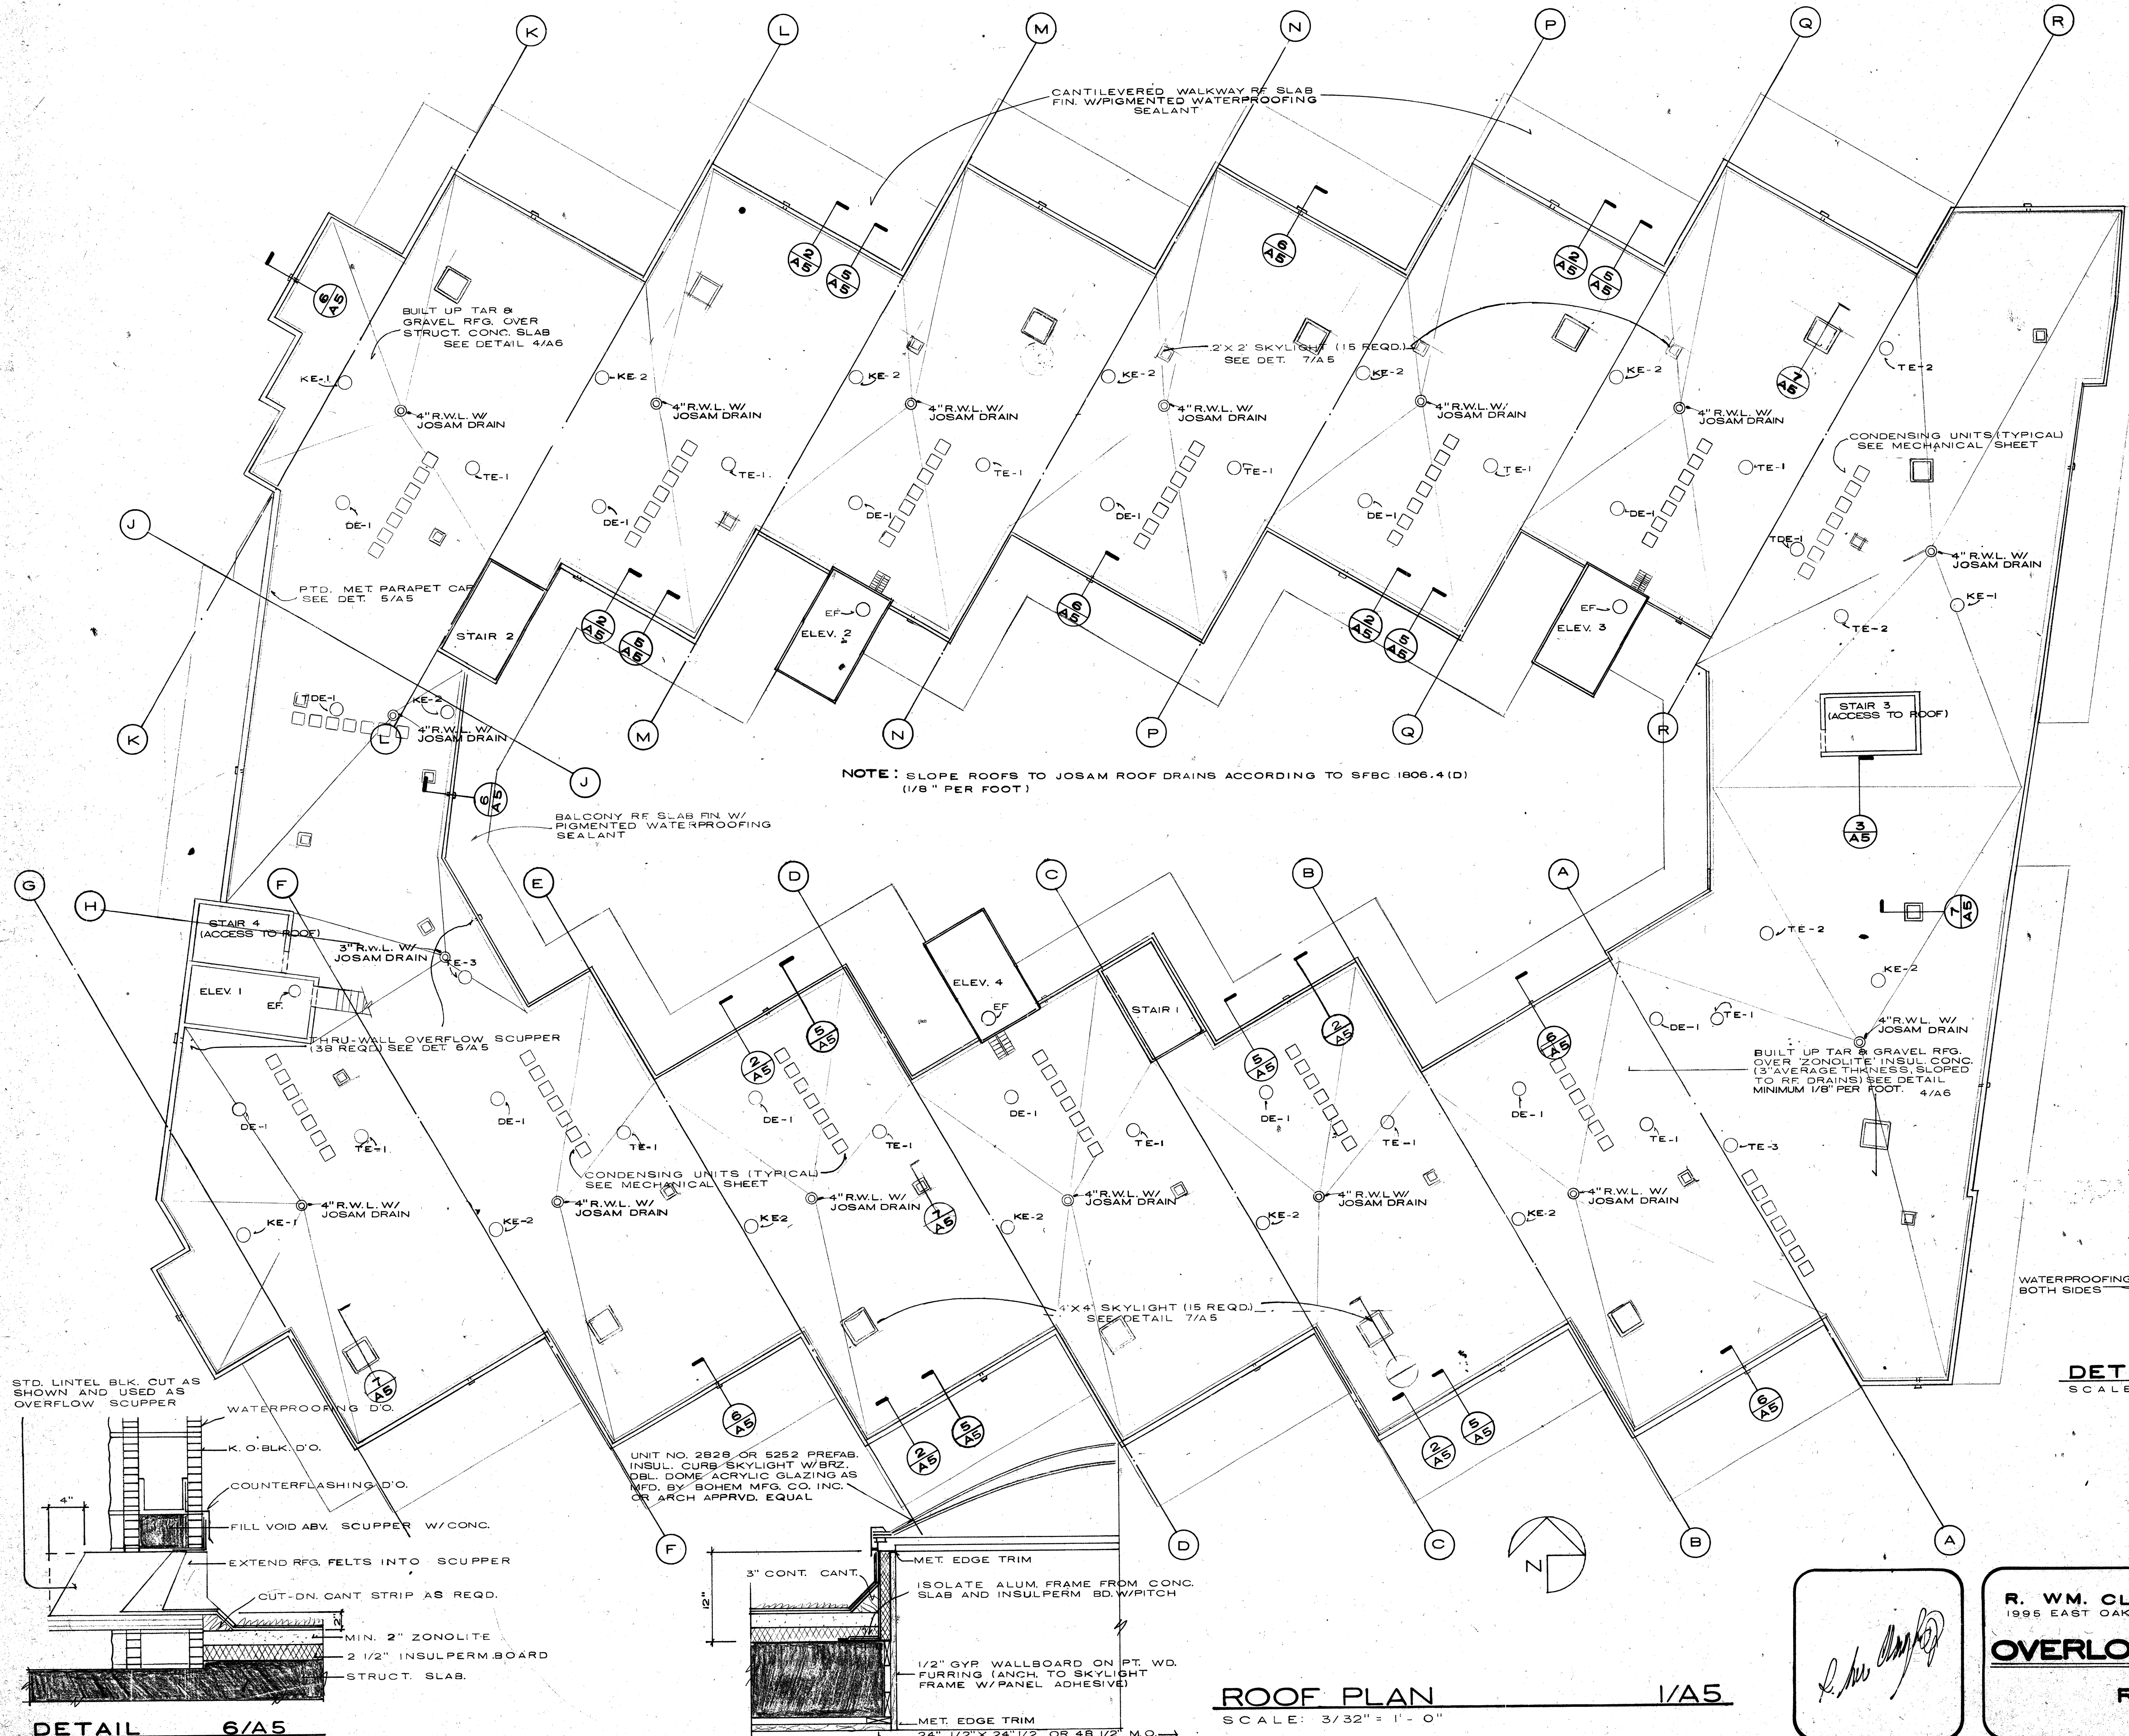


DETAIL 2/A5
SCALE: 1 1/2" = 1'-0"

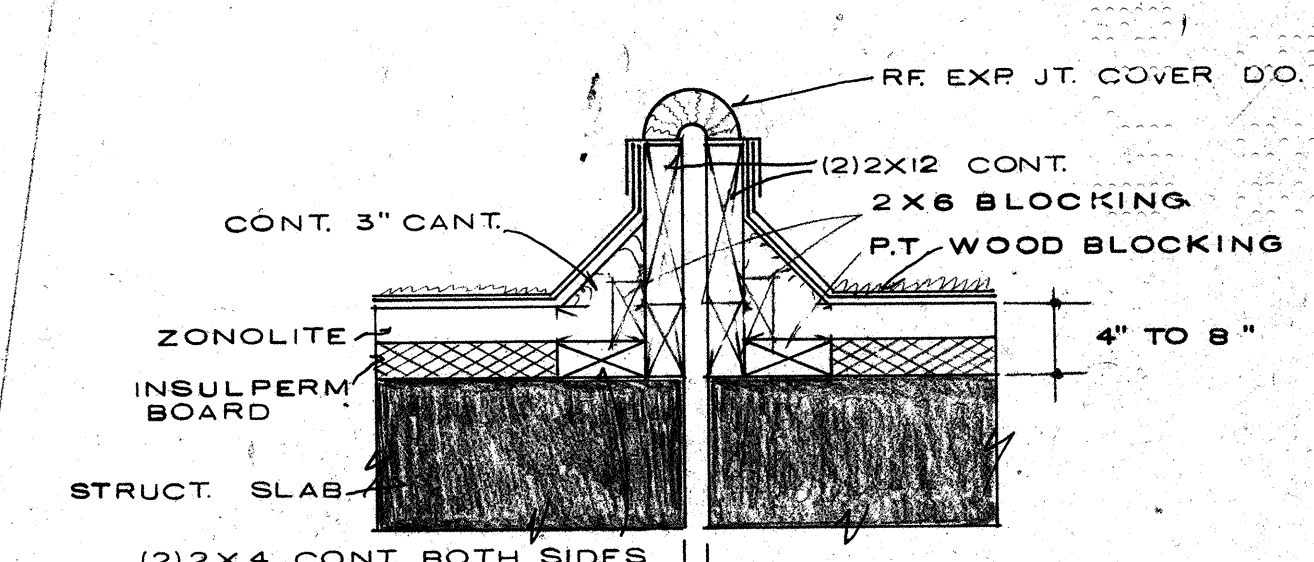


DETAIL 3/A5
SCALE: 1 1/2" = 1'-0"

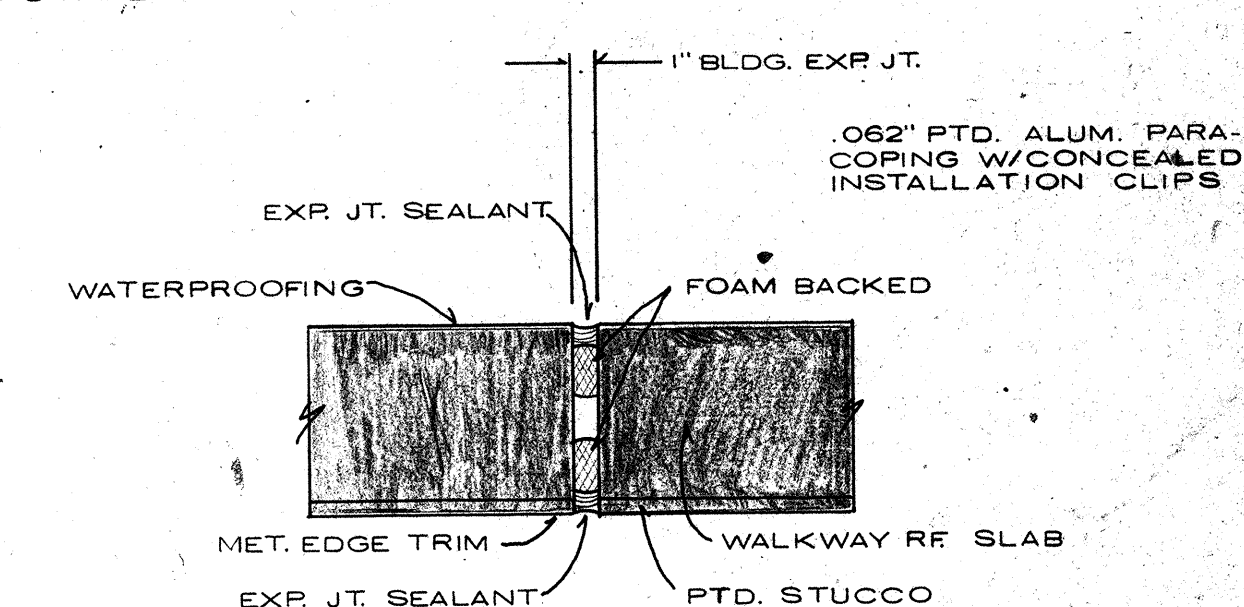


DETAIL 4/A5
SCALE: 1 1/2" = 1'-0"

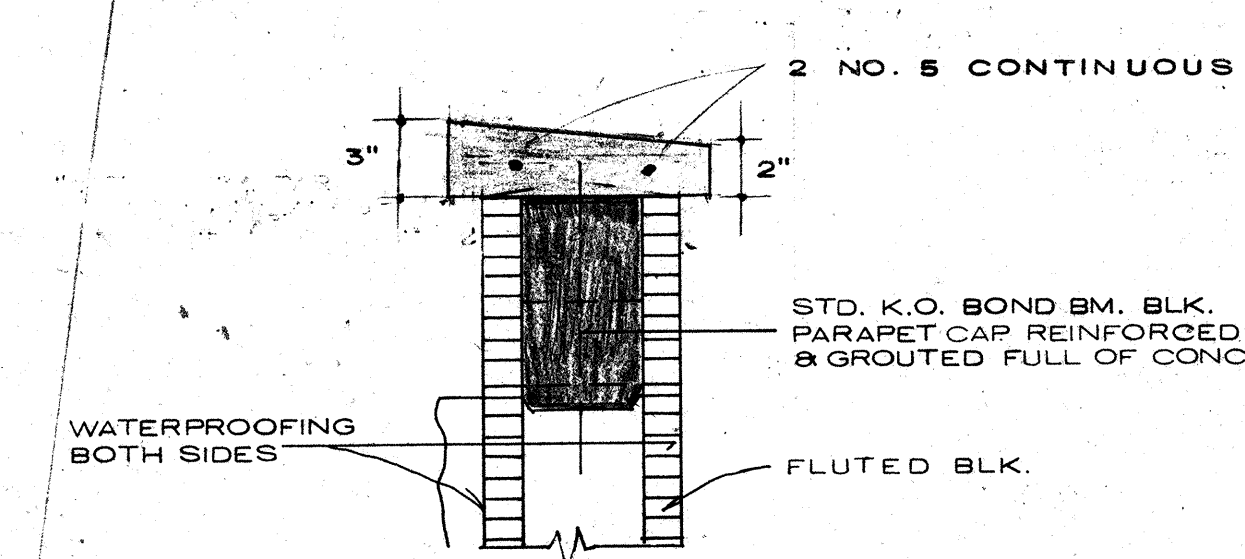

DETAIL 5/A5
SCALE: 1 1/2" = 1'-0"

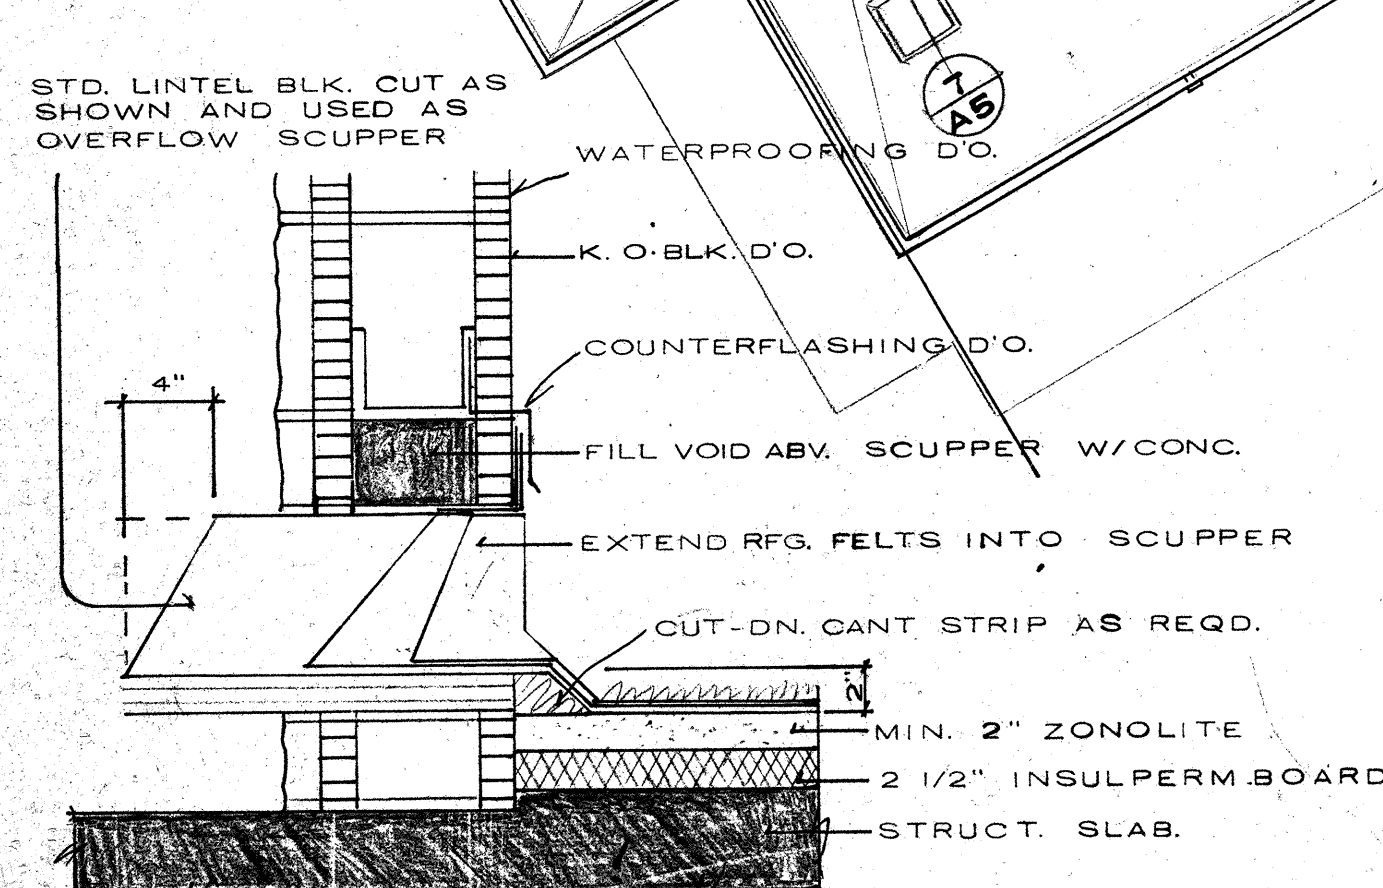

DETAIL 6/A5
SCALE: 1 1/2" = 1'-0"

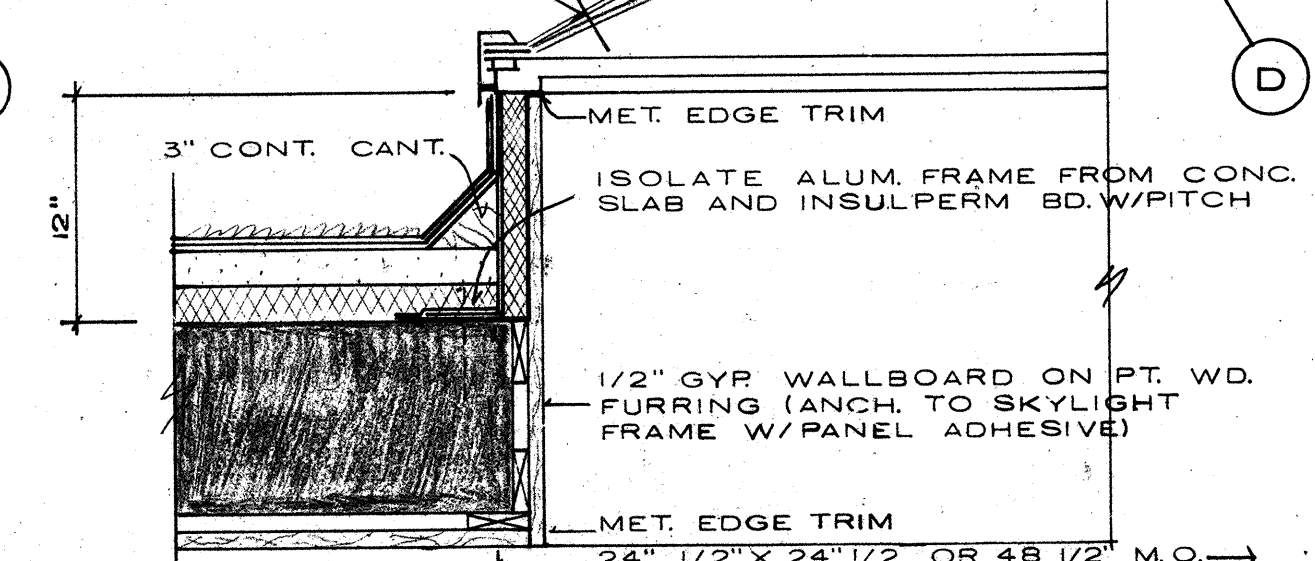

DETAIL 7/A5

ROOF PLAN
SCALE: 3/32" = 1'-0"

[Handwritten signature]

R. WM. CLAYTON JR. ARCHITECT
1995 EAST OAKLAND PARK BLVD. FT. LAUDERDALE, FLA.
OVERLOOK CONDOMINIUM
ROOF PLAN

DRAWN BY: WPS
JOB NO.: 8101
DATE: 8-12-81
REVISIONS: 6-11-84
AS BUILT 2-8-88
SHEET A5