



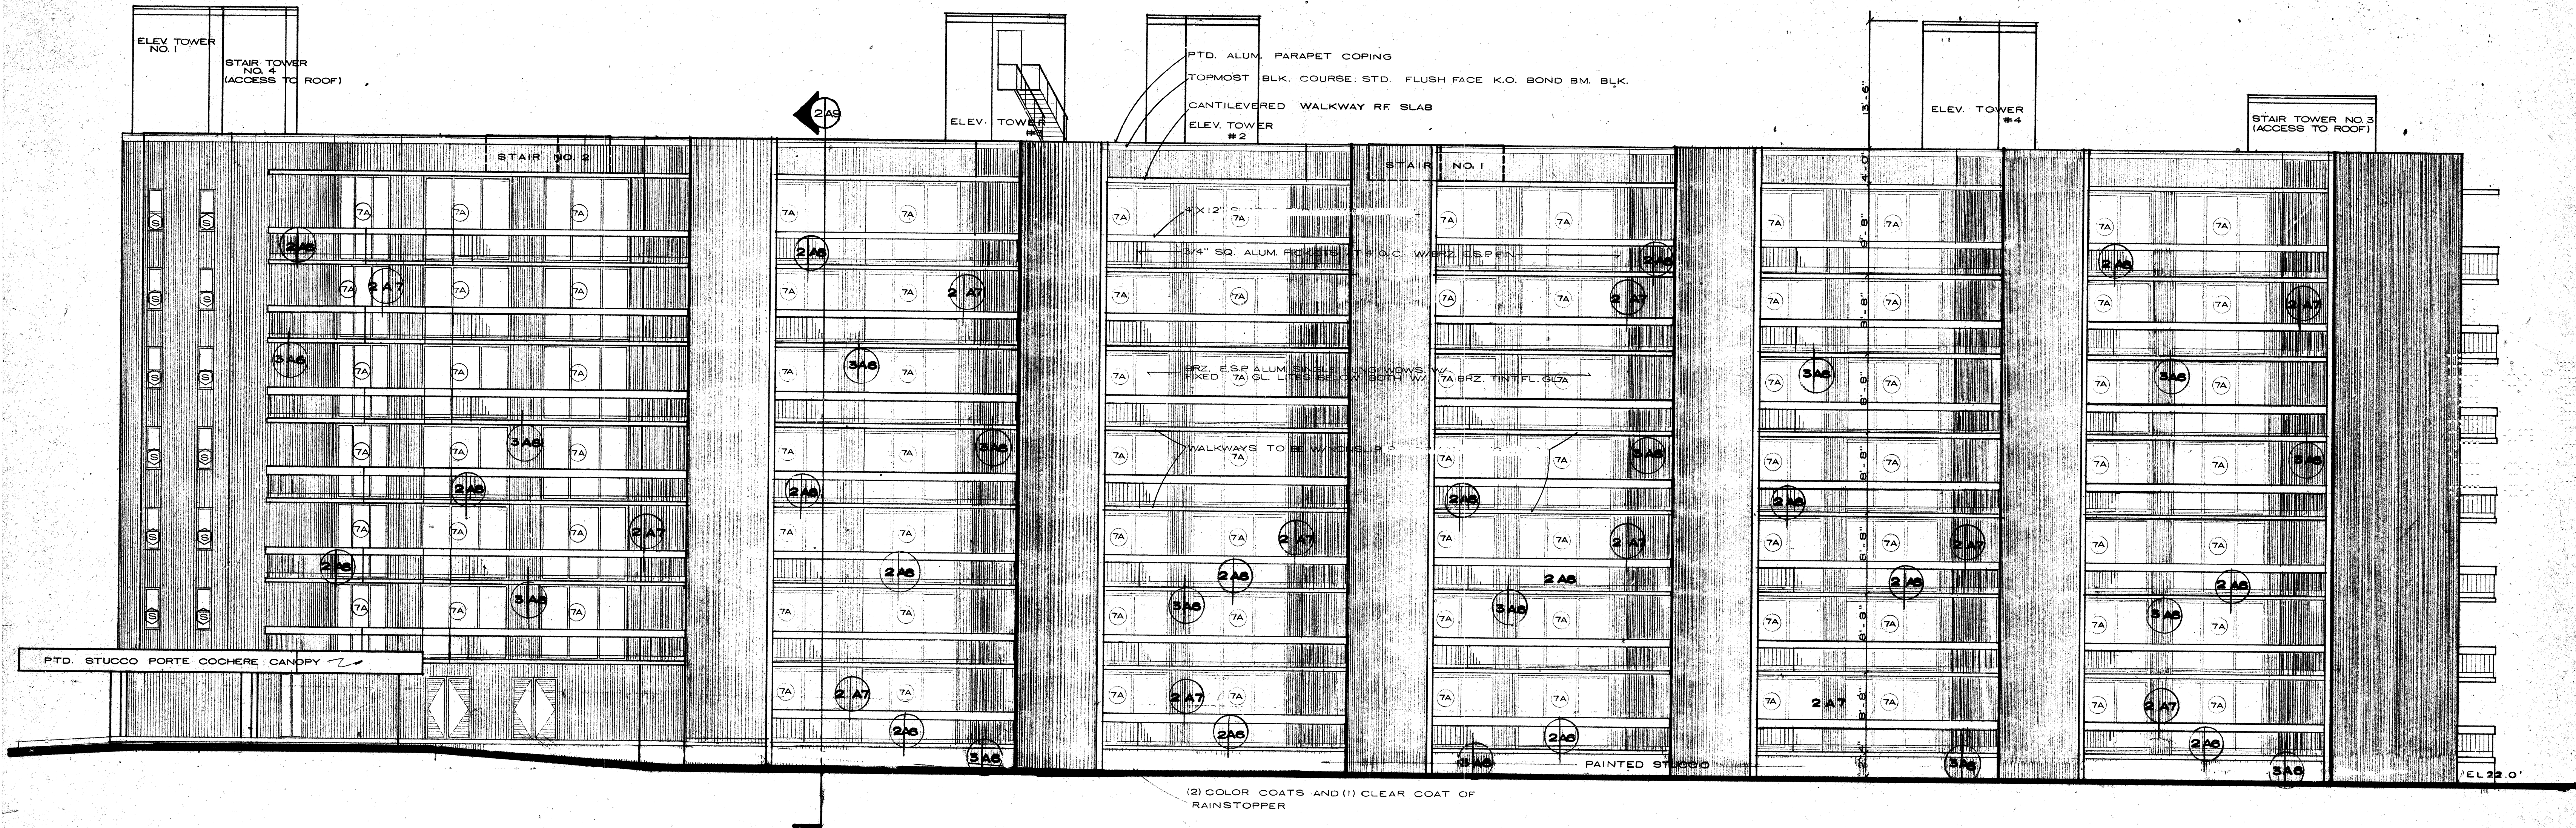

SOUTH BUILDING ELEVATION

SCALE: 1/8" = 1'-0"


1/A 6

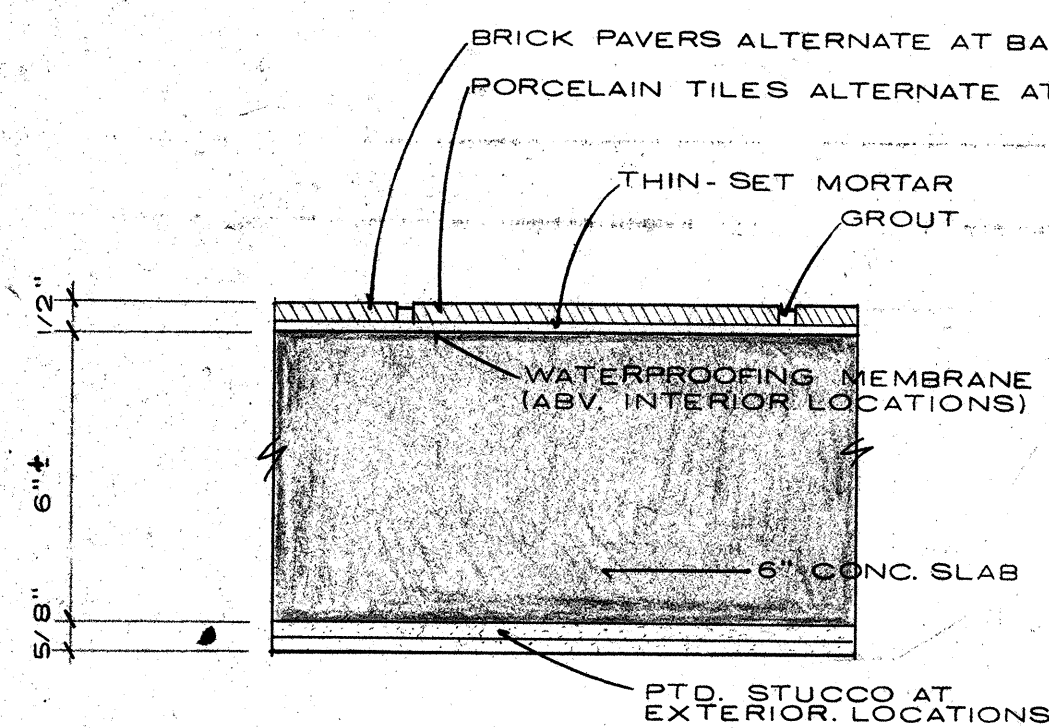

PAVING DETAIL 2/A6


SCALE: 3/8" = 1'-0"

NOTE:
BASE BID: CONCRETE SURFACED BALCONIES & WALKWAYS
ALTERNATE 1: BALCONIES - 3 5/8" X 7-1/2" PACIFIC GLAZED PAVERS AS DISTRIBUTED THRU DUNCAN BRICK CO.
ALTERNATE 2: EXTERIOR WALKWAYS - PORCELAIN TILES AS DISTRIBUTED THRU THOMPSON & CO.
ALTERNATE 3: CHARTER COCHIE ON BALCONY AND WALKWAYS

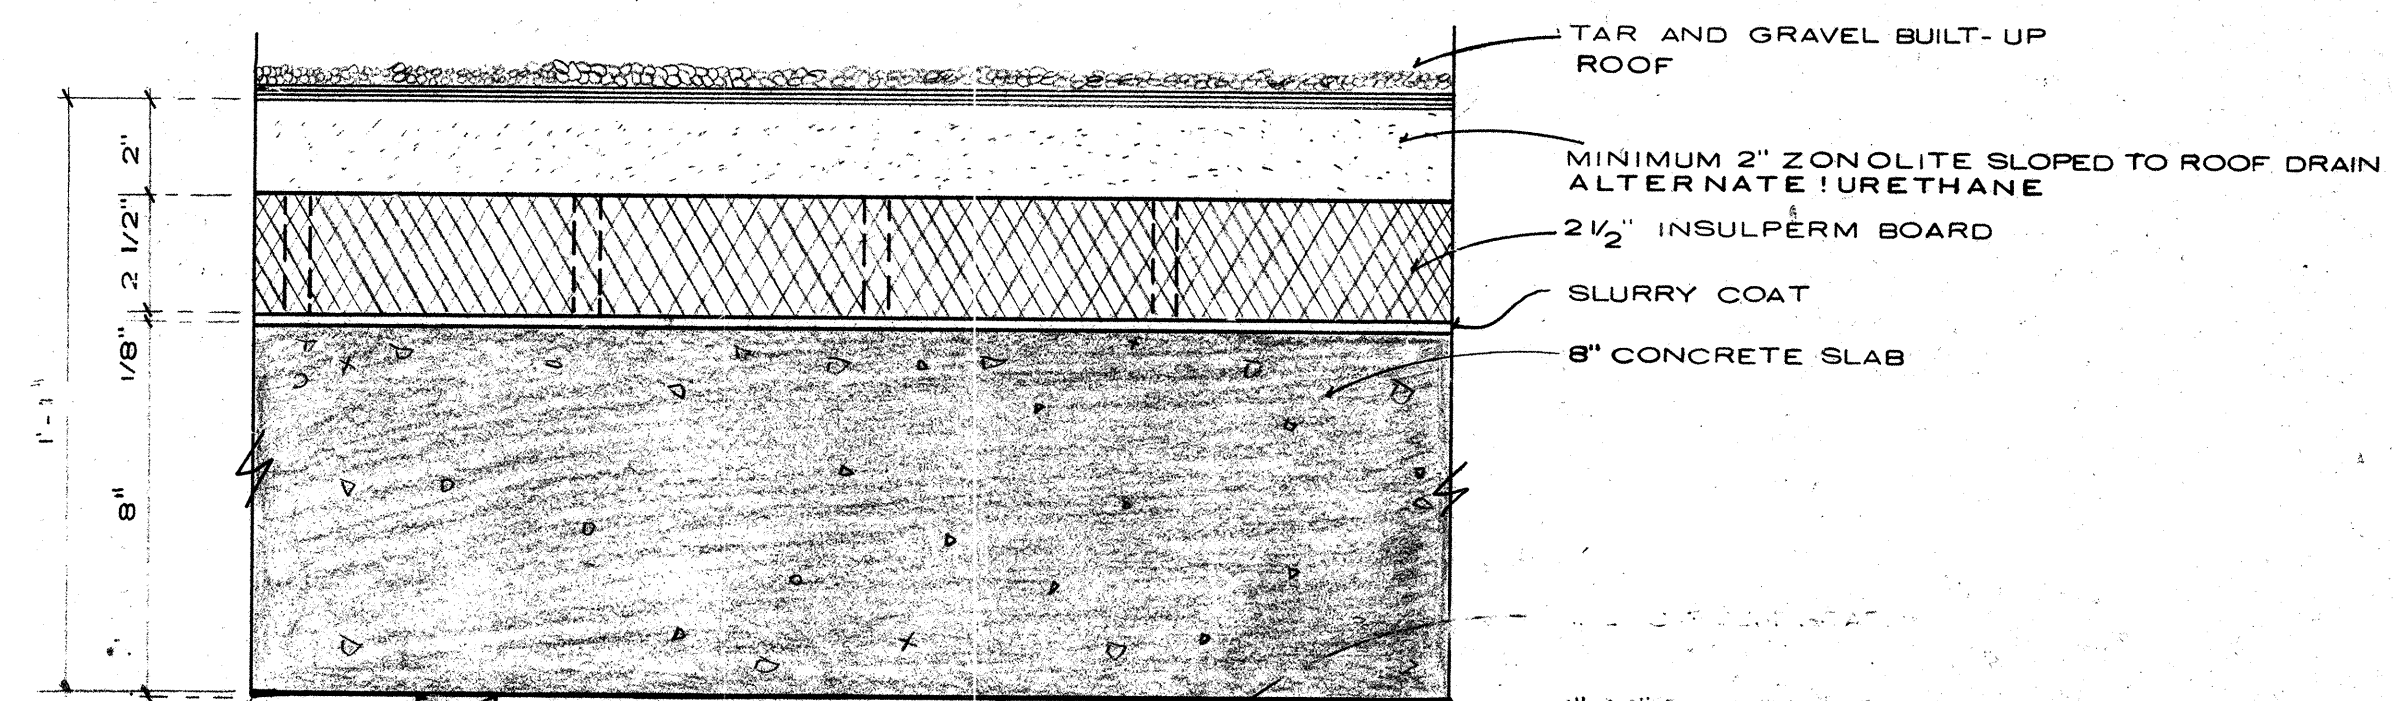

ROOF DETAIL 4/A6

SCALE: 3/8" = 1'-0"

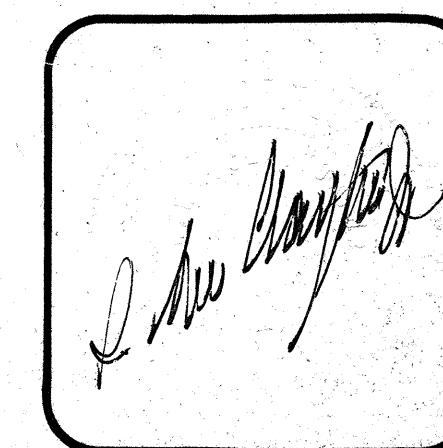

R. WM. CLAYTON JR. ARCHITECT
1995 EAST OAKLAND PARK BLVD. FT. LAUDERDALE, FLA.

OVERLOOK CONDOMINIUM

SOUTH BUILDING ELEVATION

DRAWN BY: RNS

JOB NO: 6101

DATE: 8-12-81

REVISIONS: 6-11-84

10-30-81 STAIR TOWER

11-2-81 SPRINKLER DET

AS BUILT 2-8-88

SHEET: **A 6**