
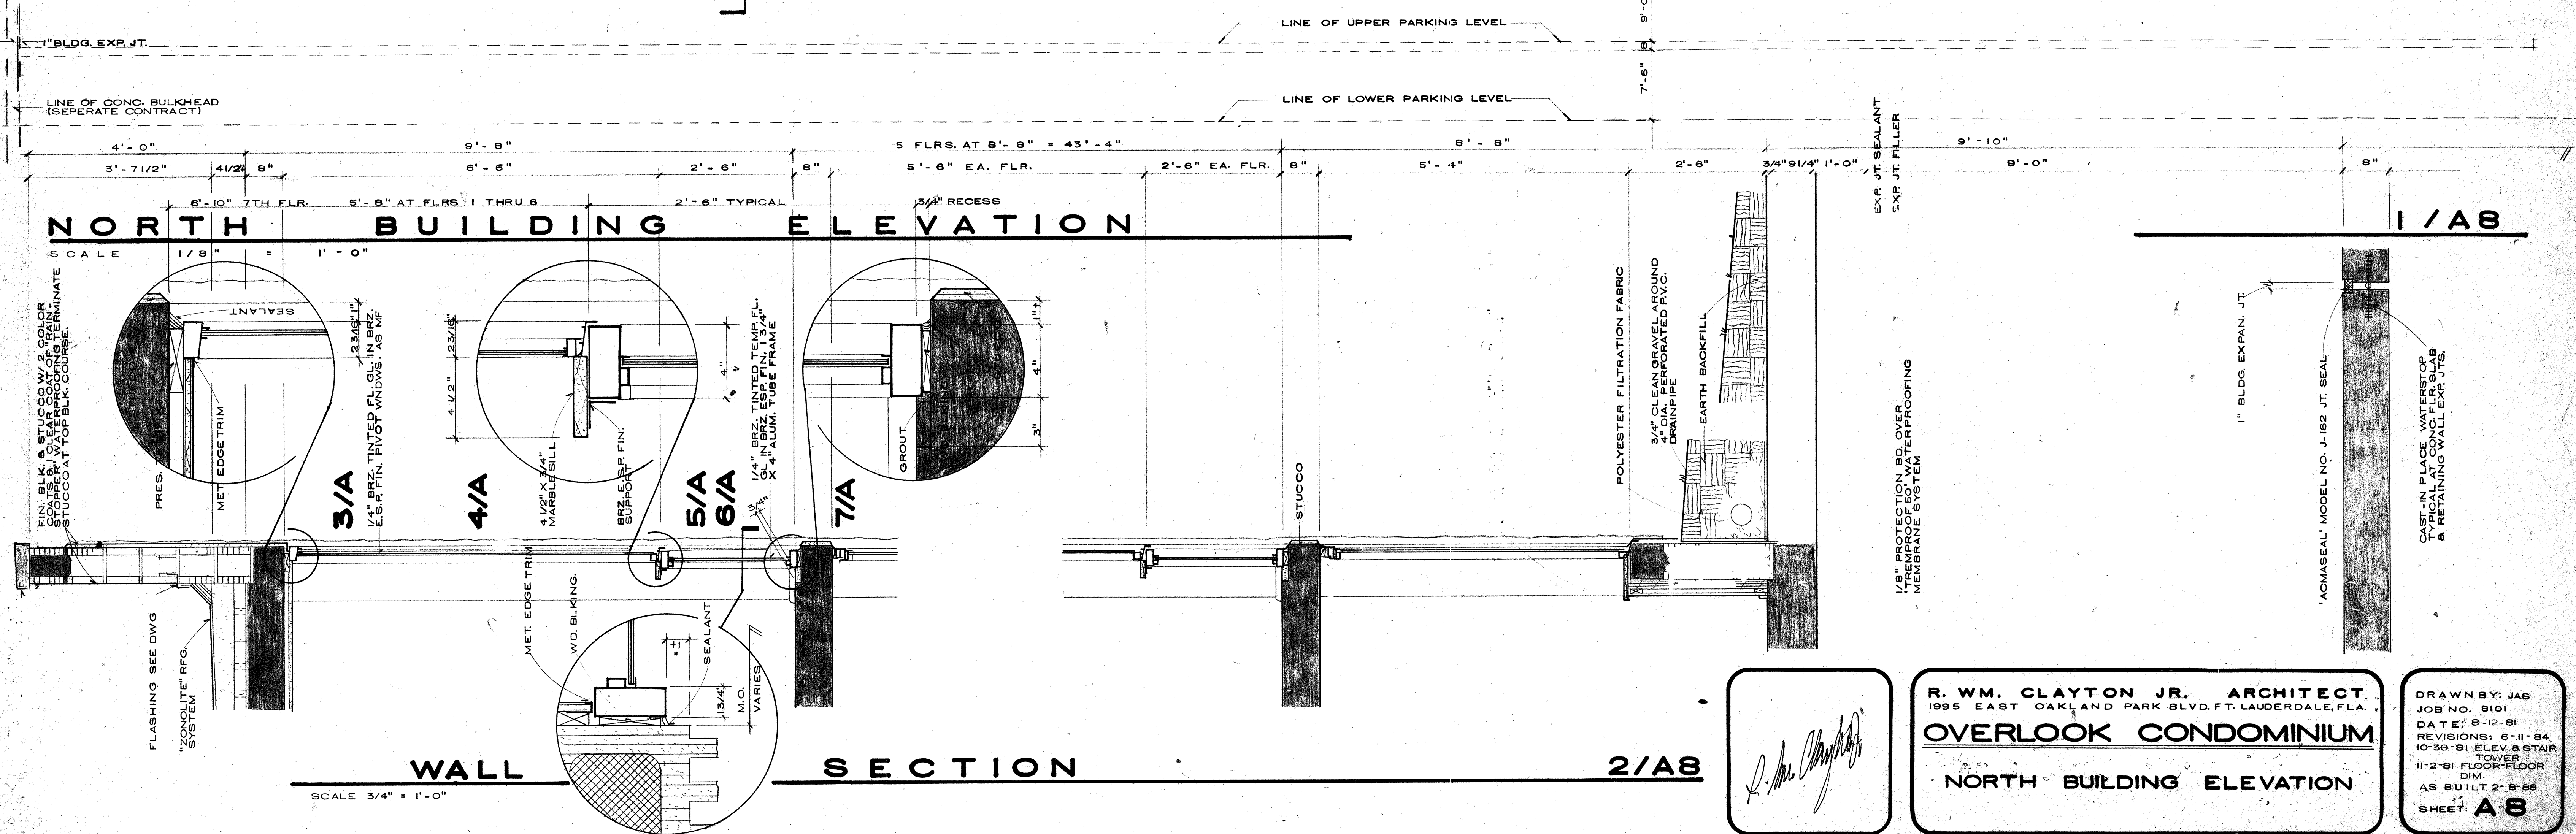


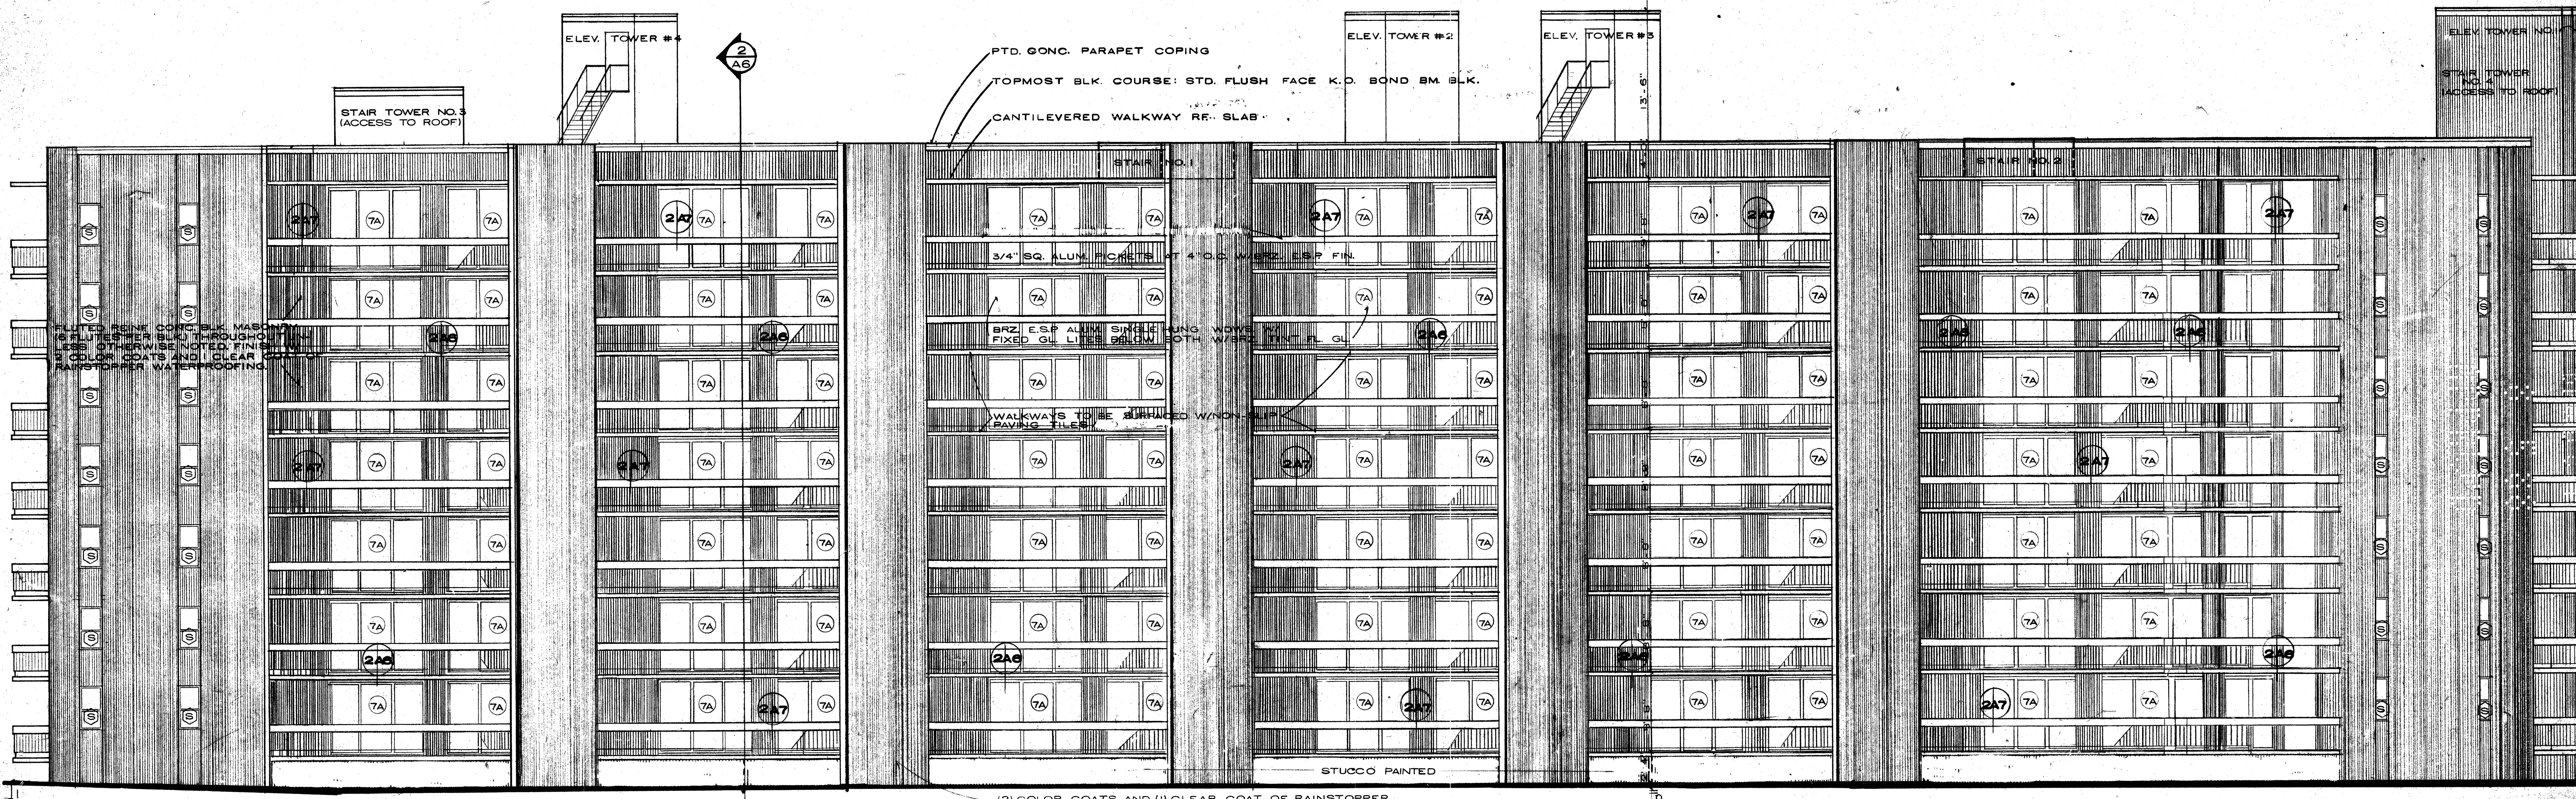

R. Wm. Clayton Jr.

R. WM. CLAYTON JR. ARCHITECT.
1995 EAST OAKLAND PARK BLVD. FT. LAUDERDALE, FLA.
OVERLOOK CONDOMINIUM
NORTH BUILDING ELEVATION

DRAWN BY: JAS
JOB NO. 8101
DATE: 8-12-81
REVISIONS: 6-11-84
10-30-81 ELEV. & STAIR
11-2-81 FLOOR-FLOOR
DIM.
AS BUILT 2'-8-89
SHEET **A 8**