




HA

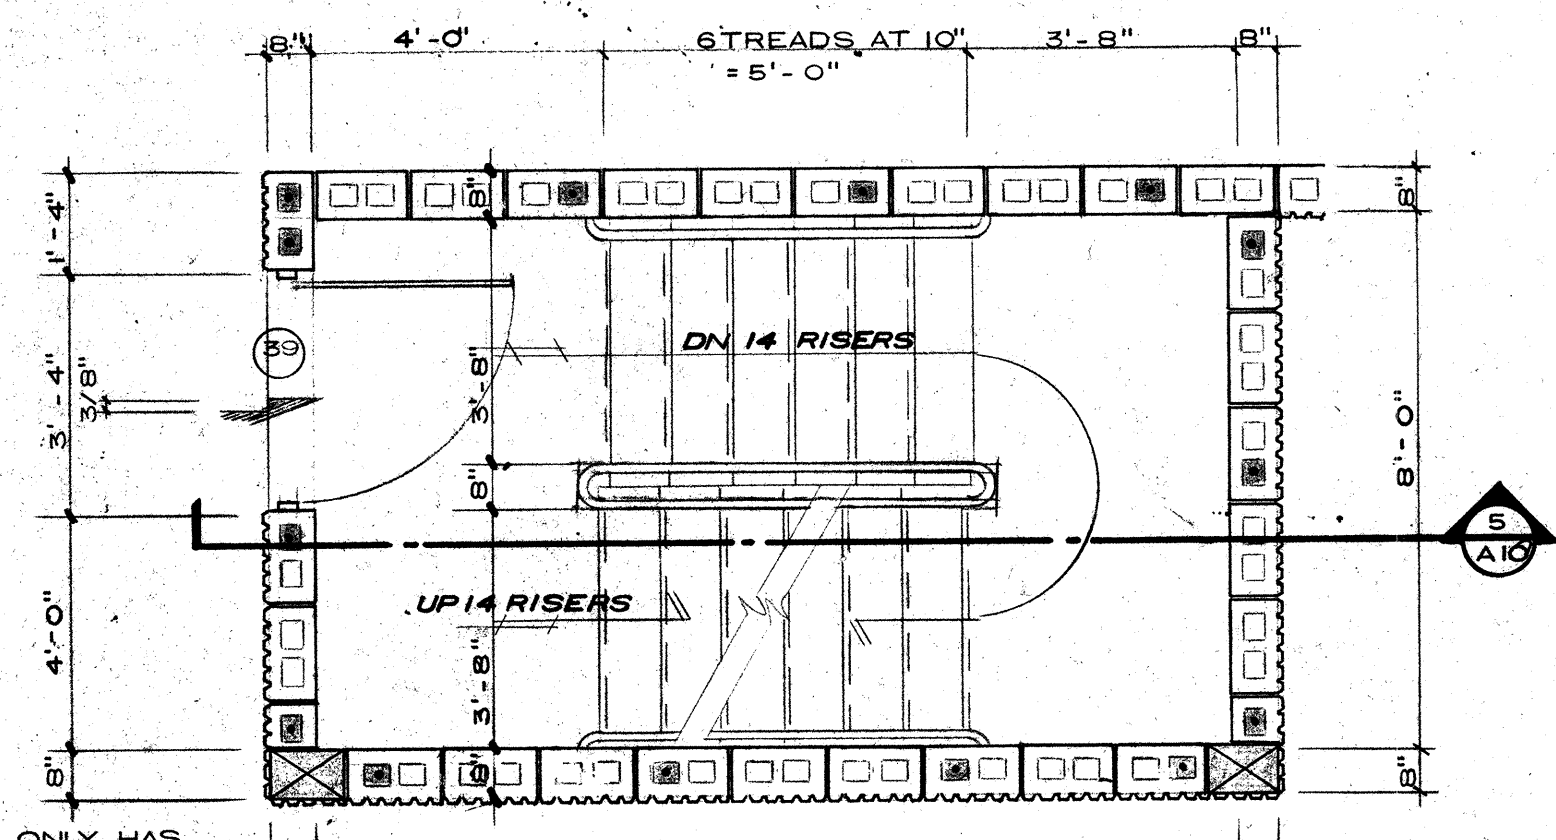


TYPICAL FLOOR (2ND THRU 7TH) 1/A10
SCALE: 3/8" = 1'-0"

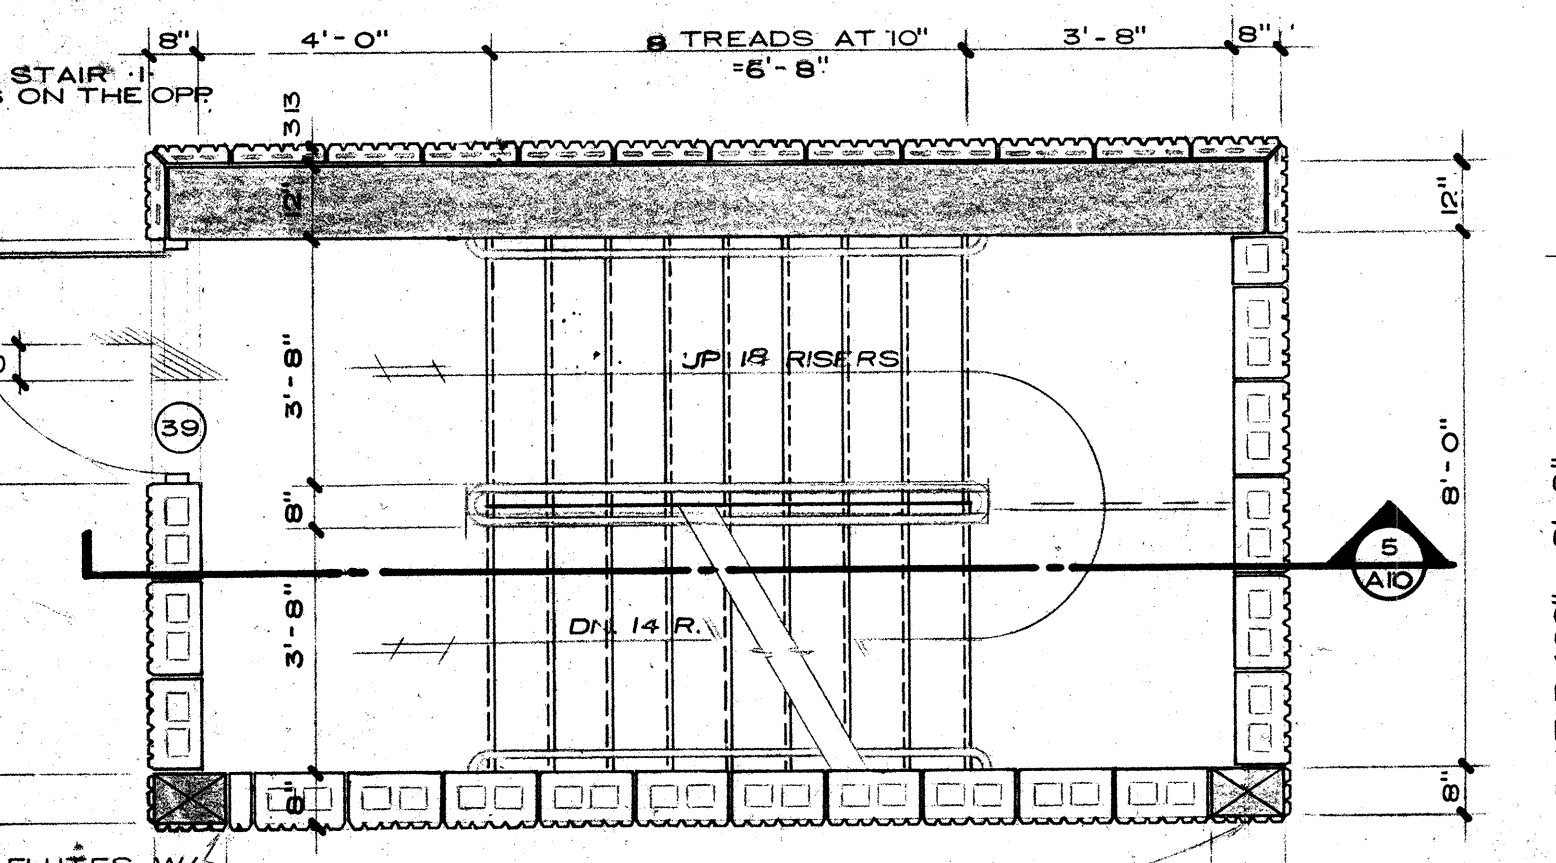


UPPER PARKING & 1ST FLOOR 2/A10
SCALE: 3/8" = 1'-0"

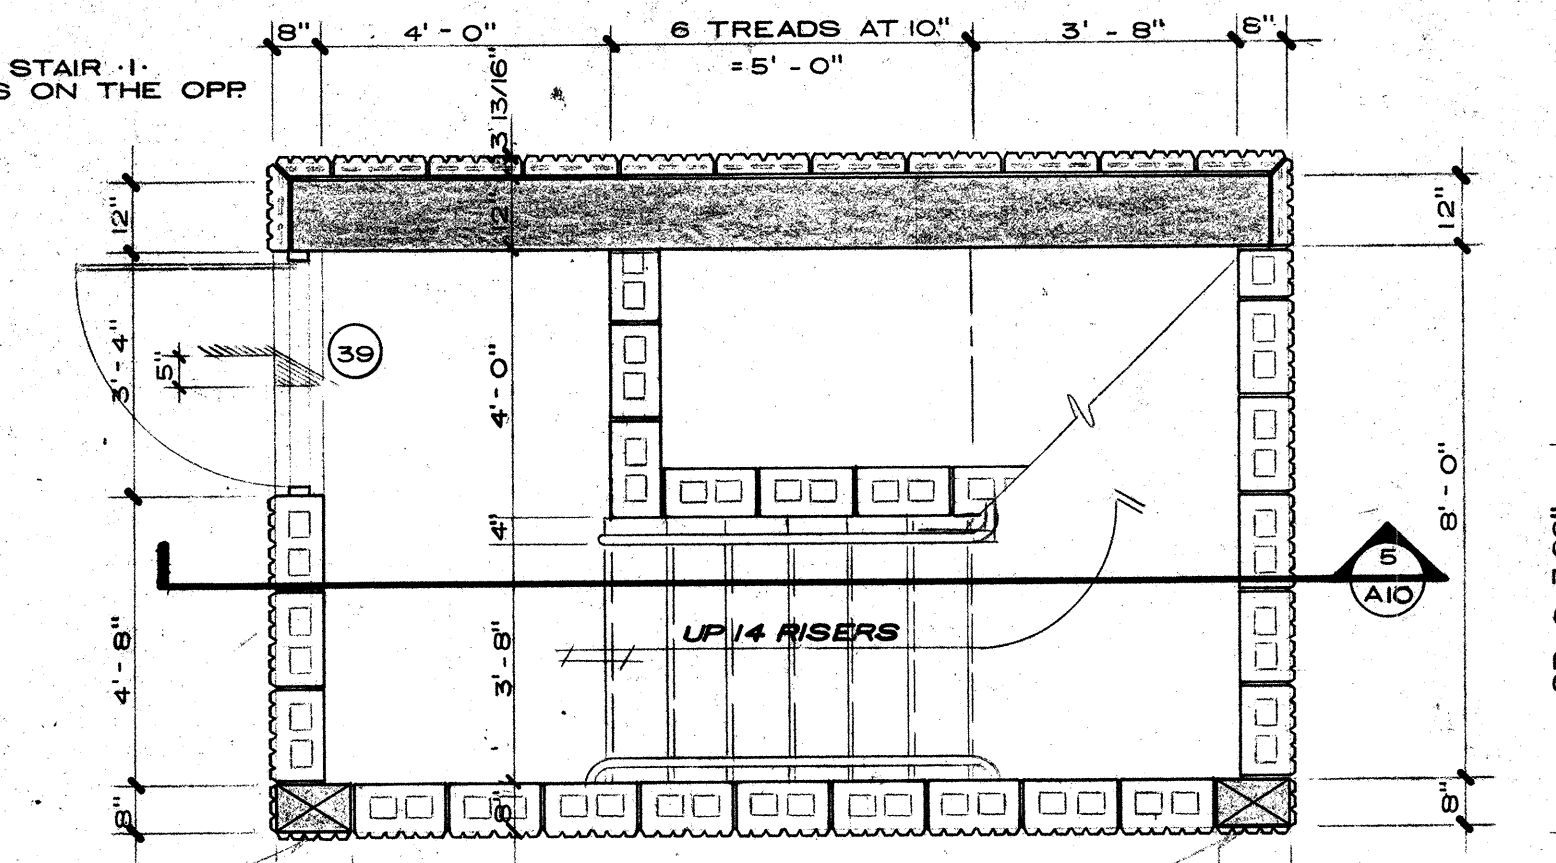


LOWER PARKING LEVEL 3/A10
SCALE: 3/8" = 1'-0"

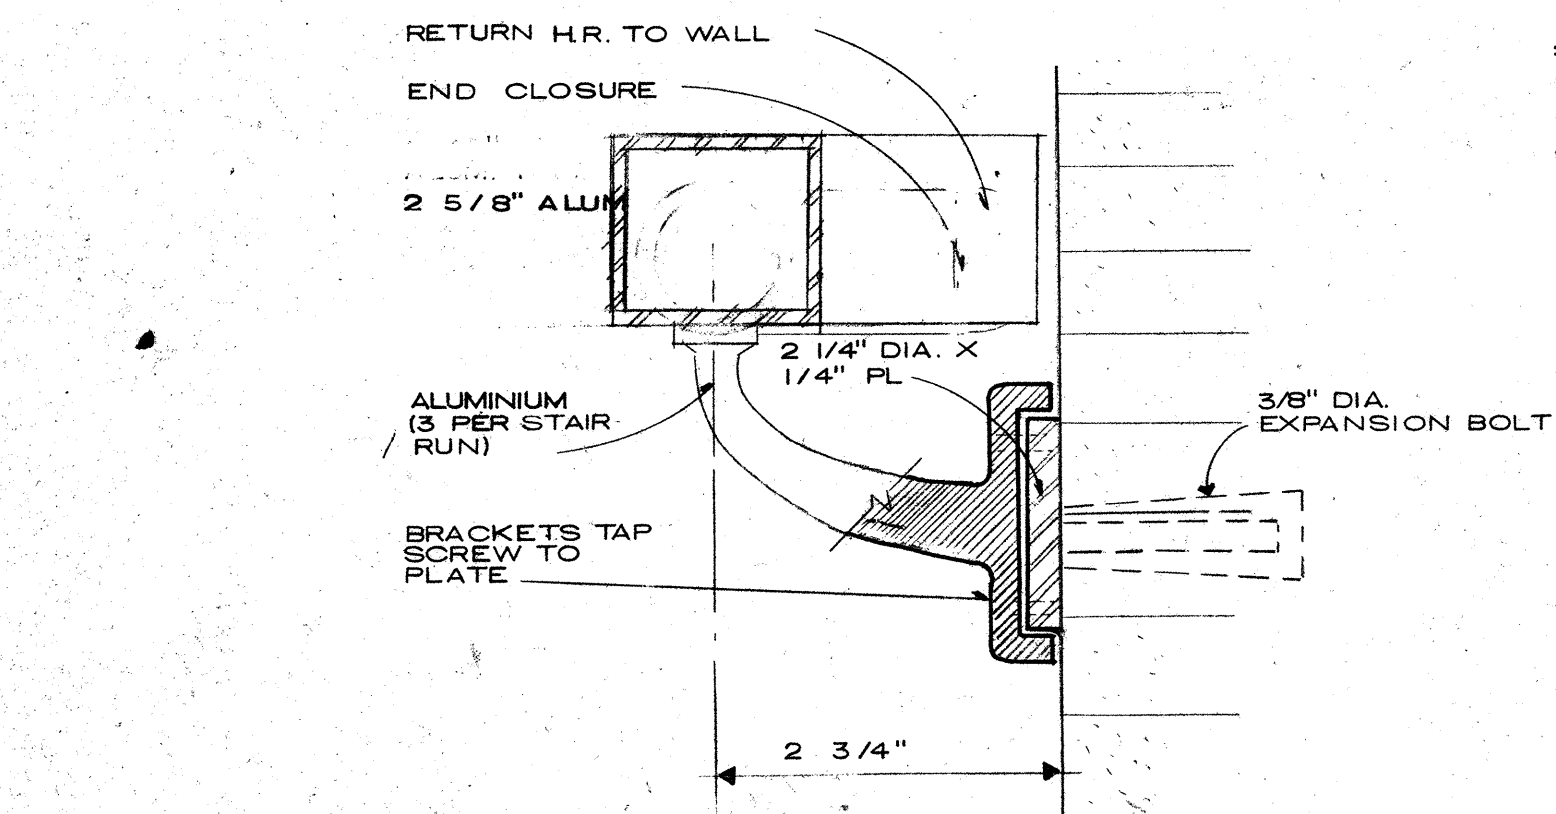


WALL HANDRAIL DETAIL (ALTERNATE COLORED PVC) 4/A10
N.T.S.

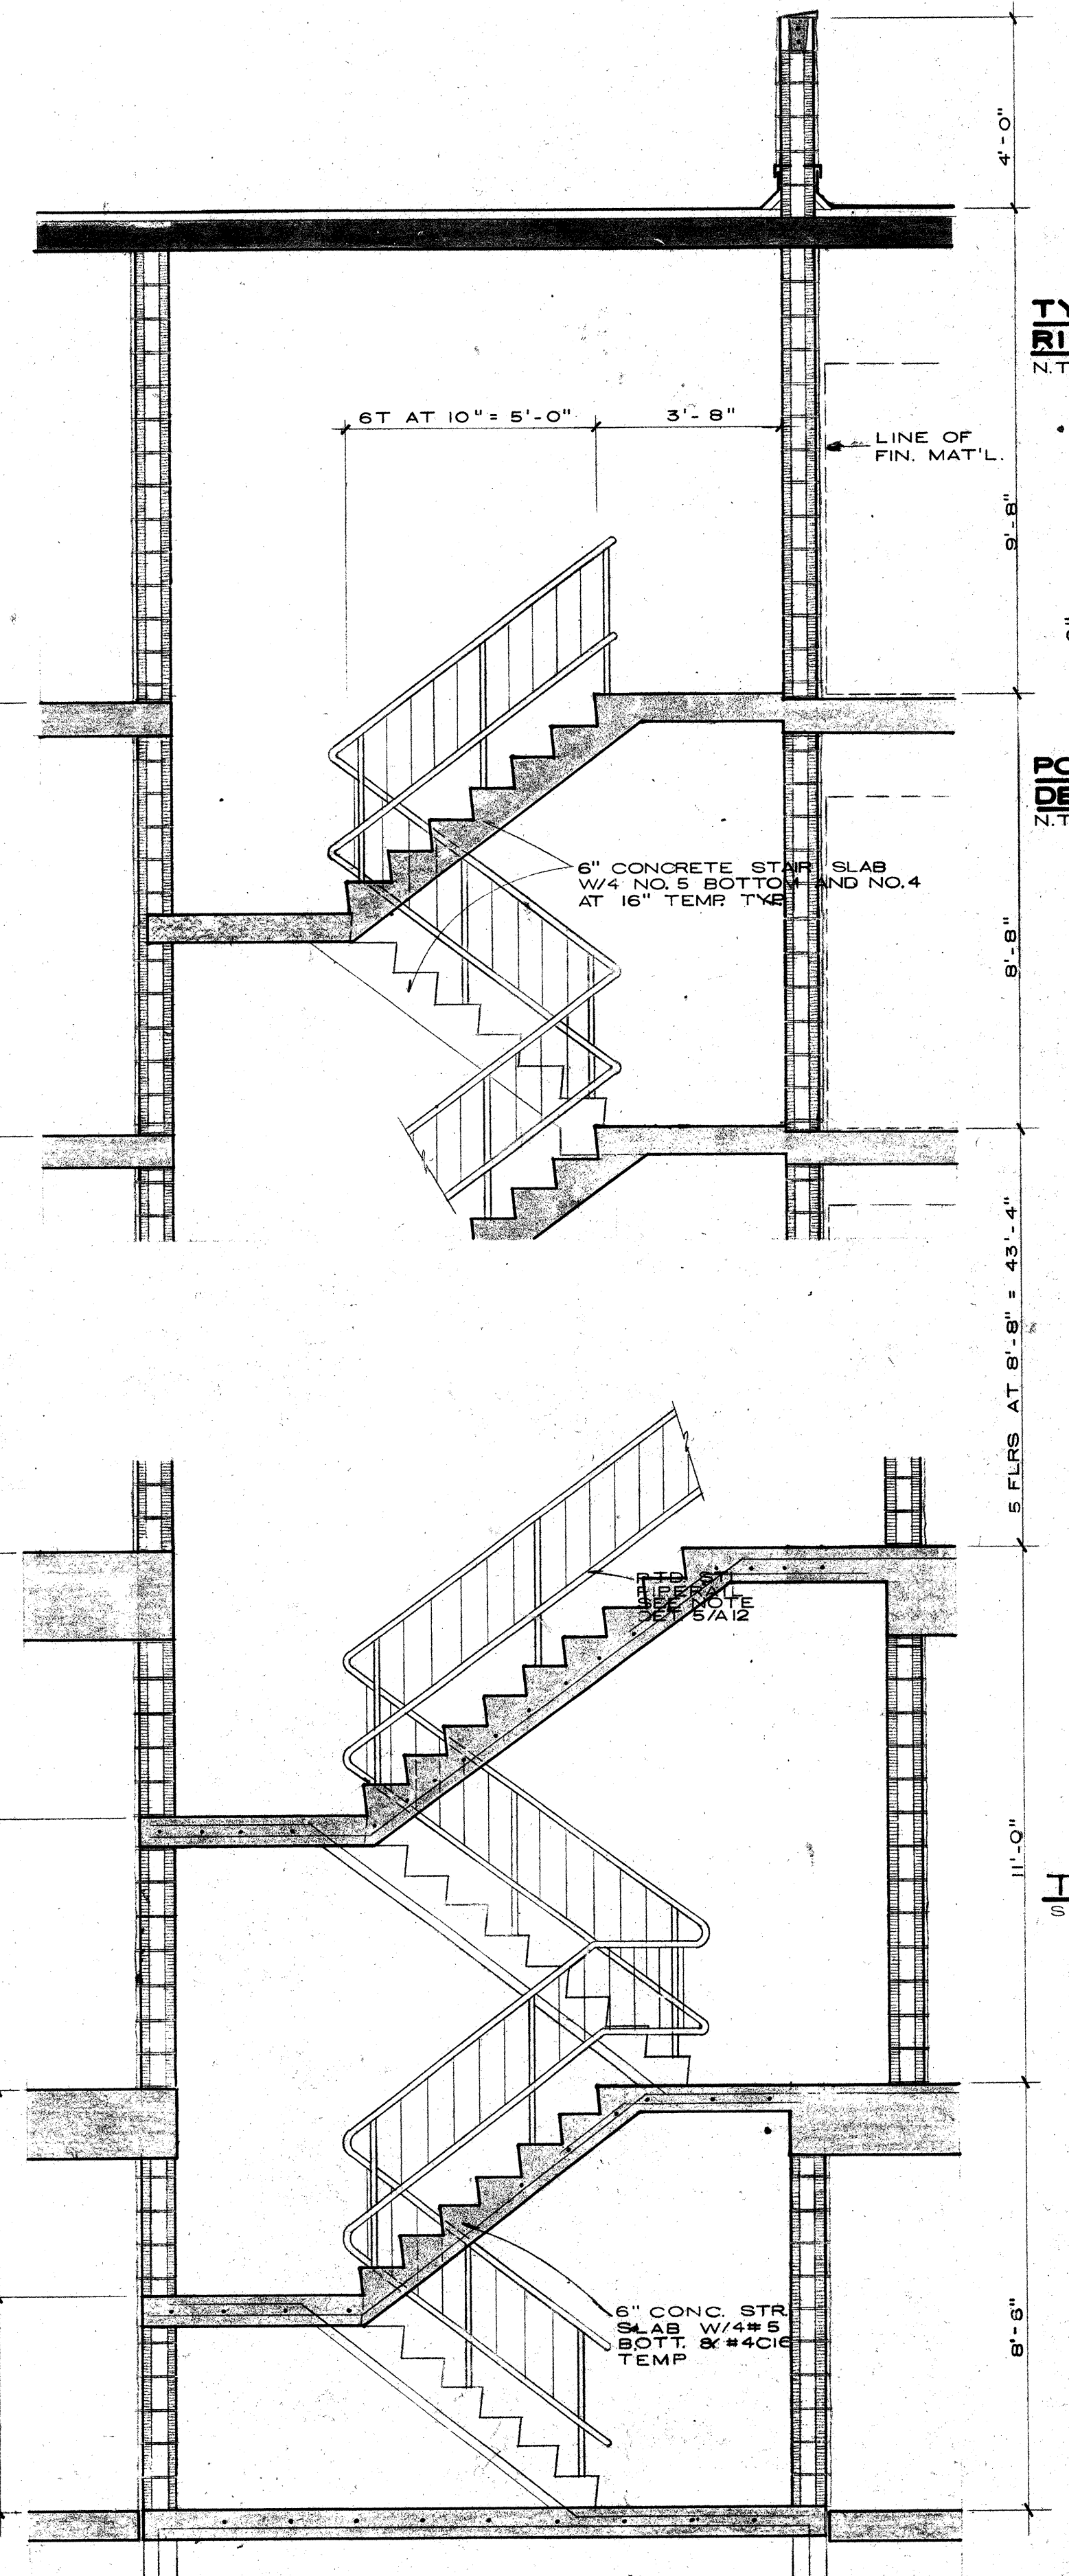


SECTION THRU STAIR 1 & 2 5/A10
SCALE: 3/8" = 1'-0" (ALL STAIRS SIMILAR)

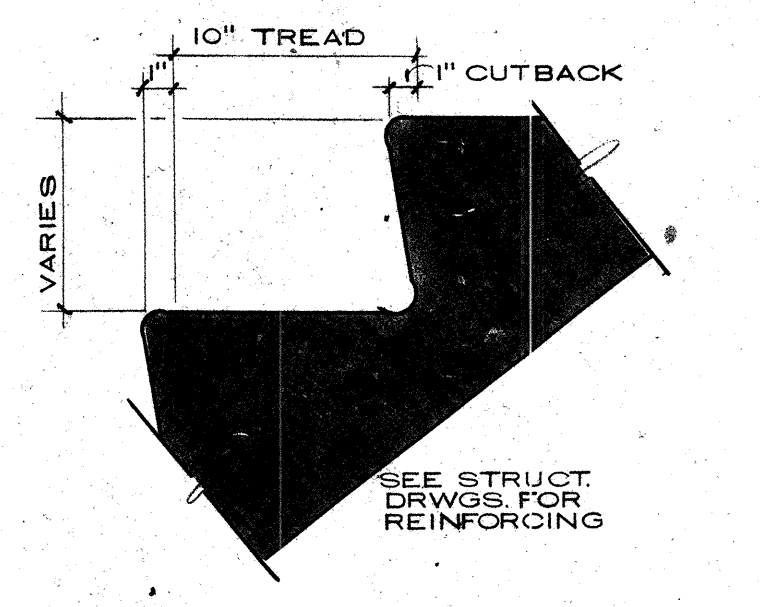


TYPICAL TREAD AND RISER DETAIL 6/A10
N.T.S.

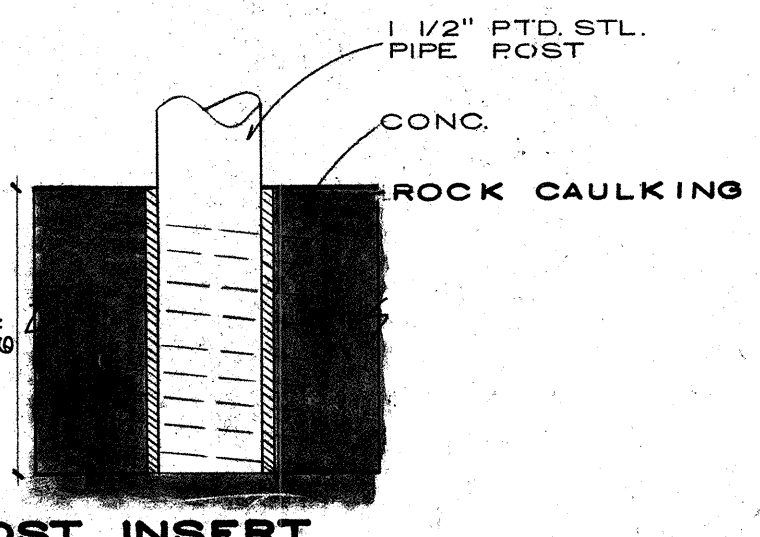



POST INSERT DETAIL 7/A10
N.T.S.

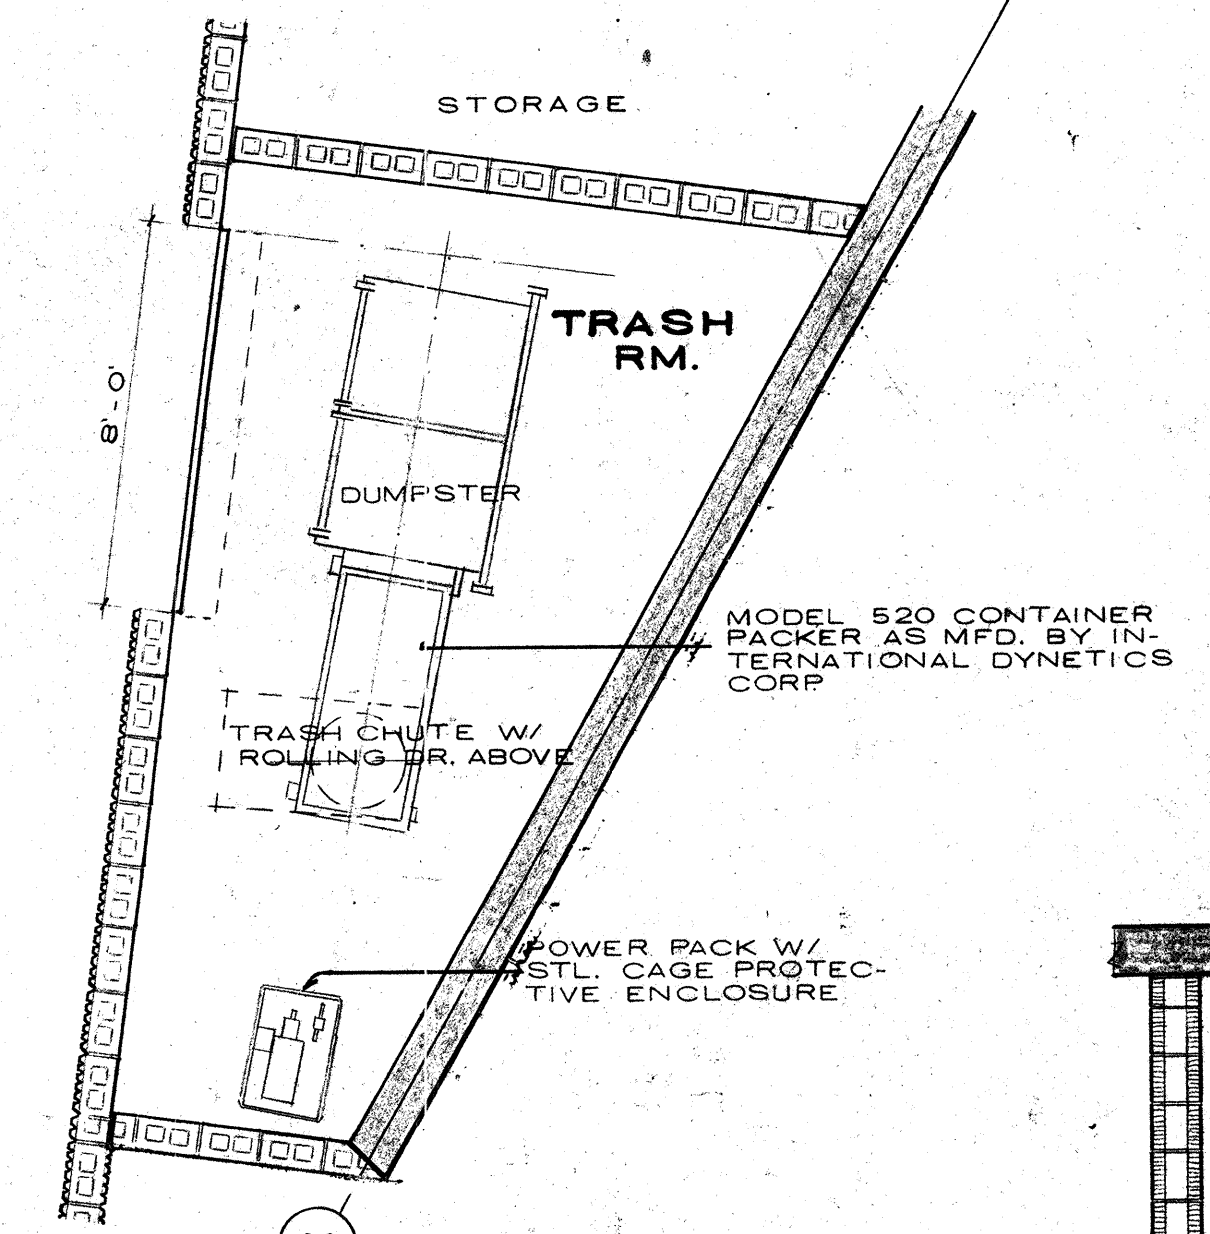

TRASH RM. 8/A10
SCALE: 1/4" = 1'-0"

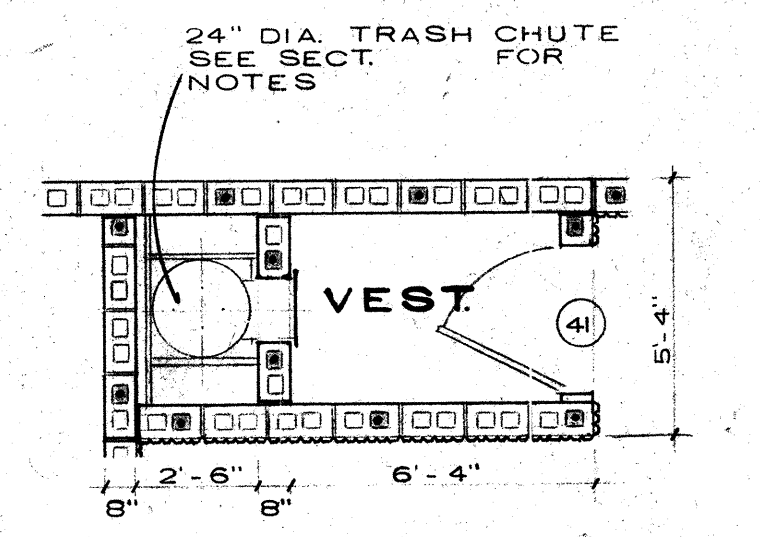

TRASH CHUTE AT TYPICAL LEVEL
SCALE: 1/4" = 1'-0"

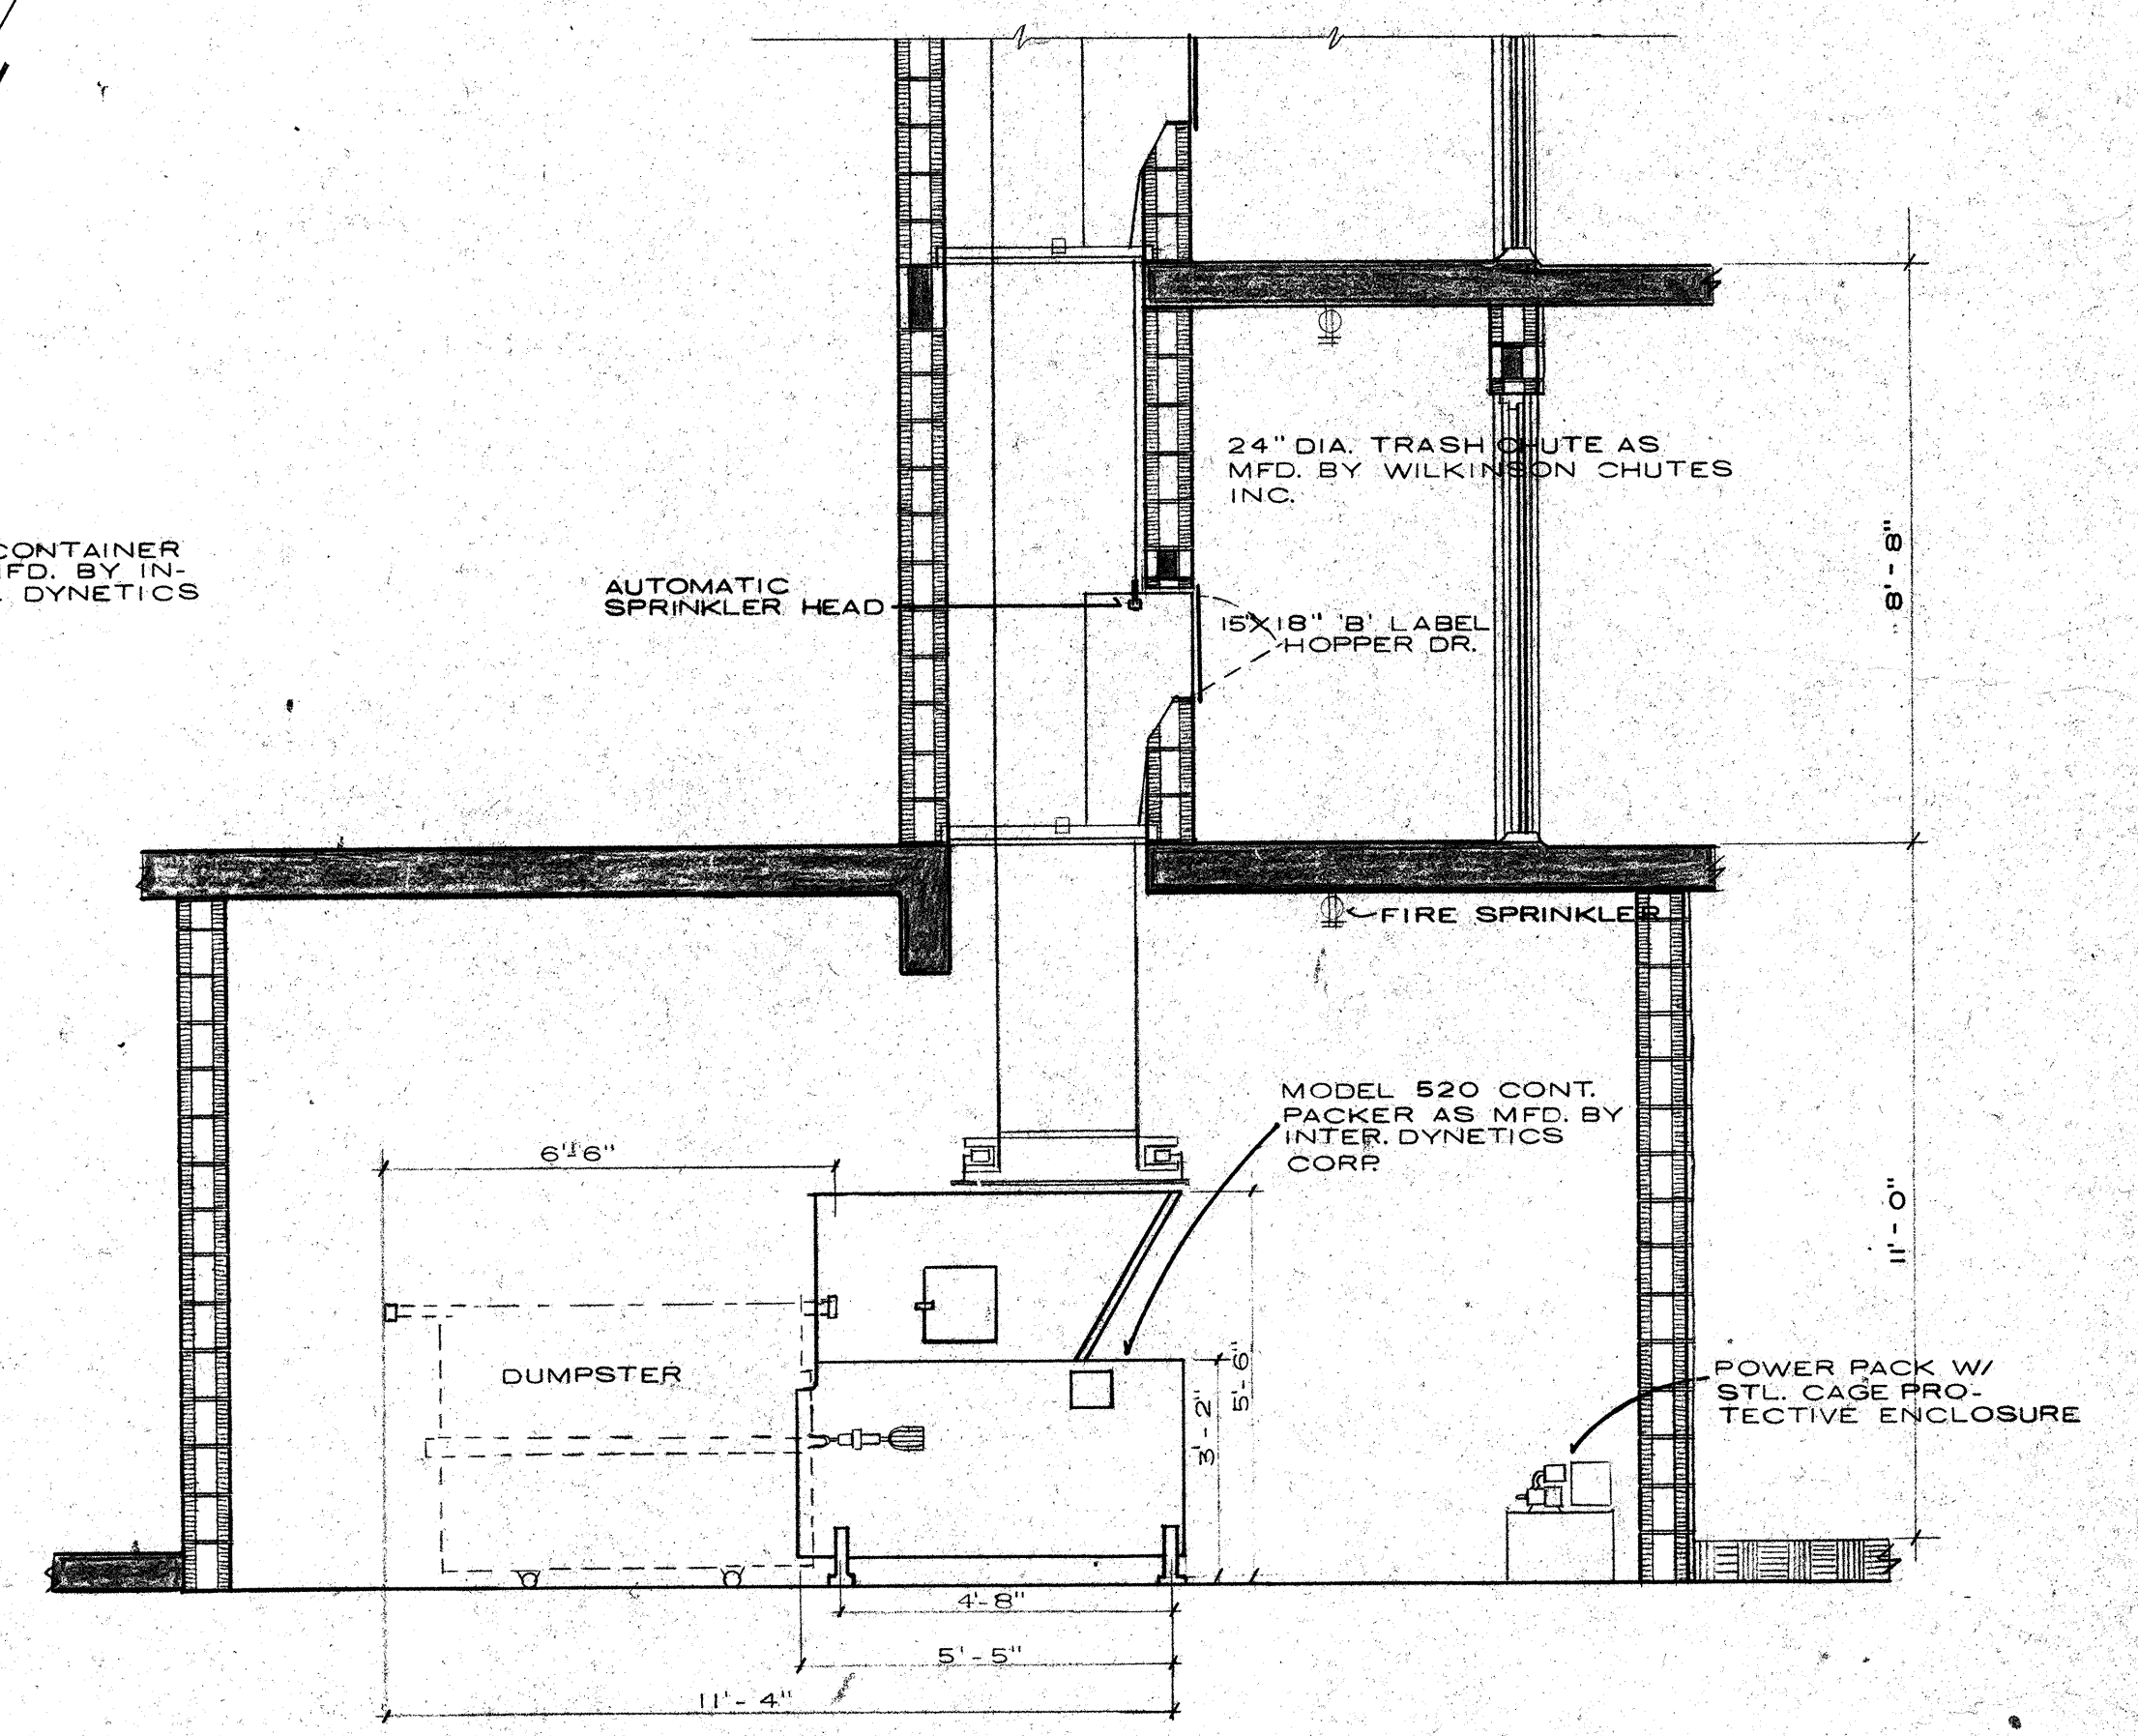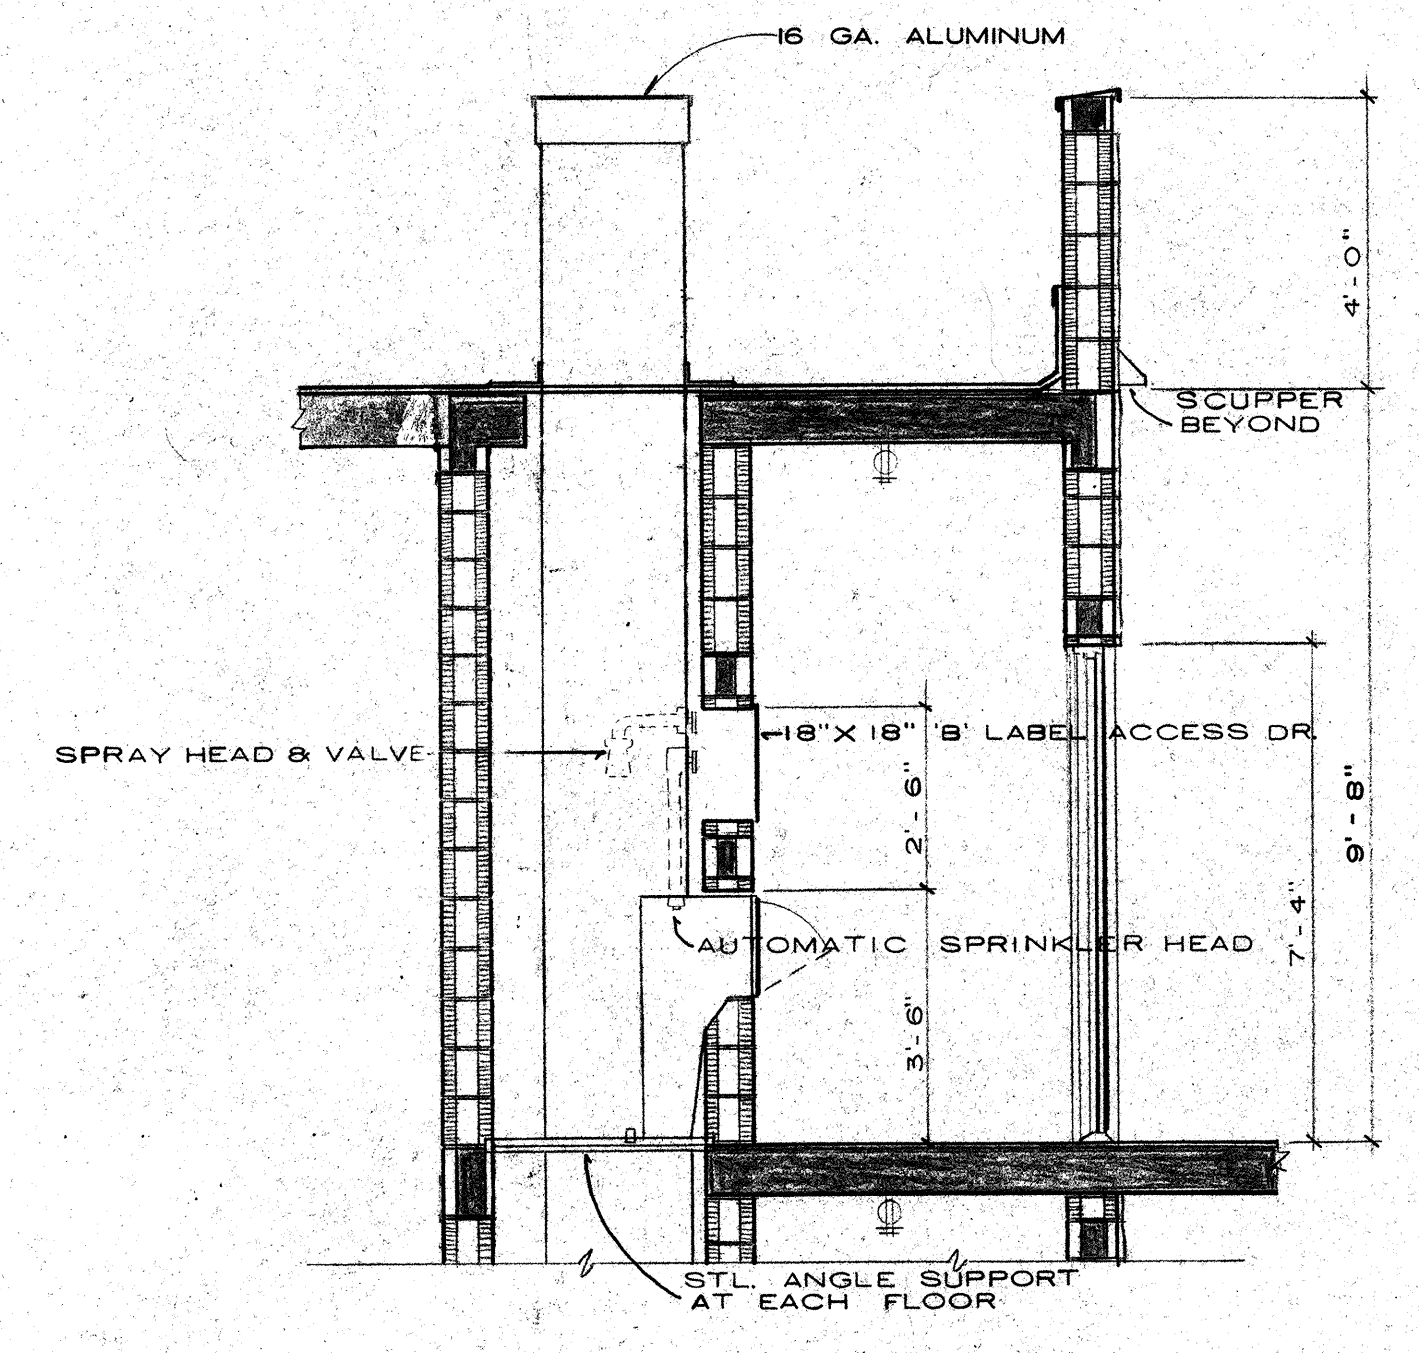

TRASH CHUTE SECTION - LOBBY LEVEL 9/A10
SCALE: 3/8" = 1'-0"

R. Wm. Clayton Jr.

R. WM. CLAYTON JR. ARCHITECT
1995 EAST OAKLAND PARK BLVD. FT. LAUDERDALE, FLA.

OVERLOOK CONDOMINIUM

TRASH AND STAIR DETAILS

DRAWN BY: WPS
JOB NO: 8101
DATE: 8-12-81
REVISIONS: 8-11-84
8-27-84
AS BUILT 2-6-89
SHEET **A10**