



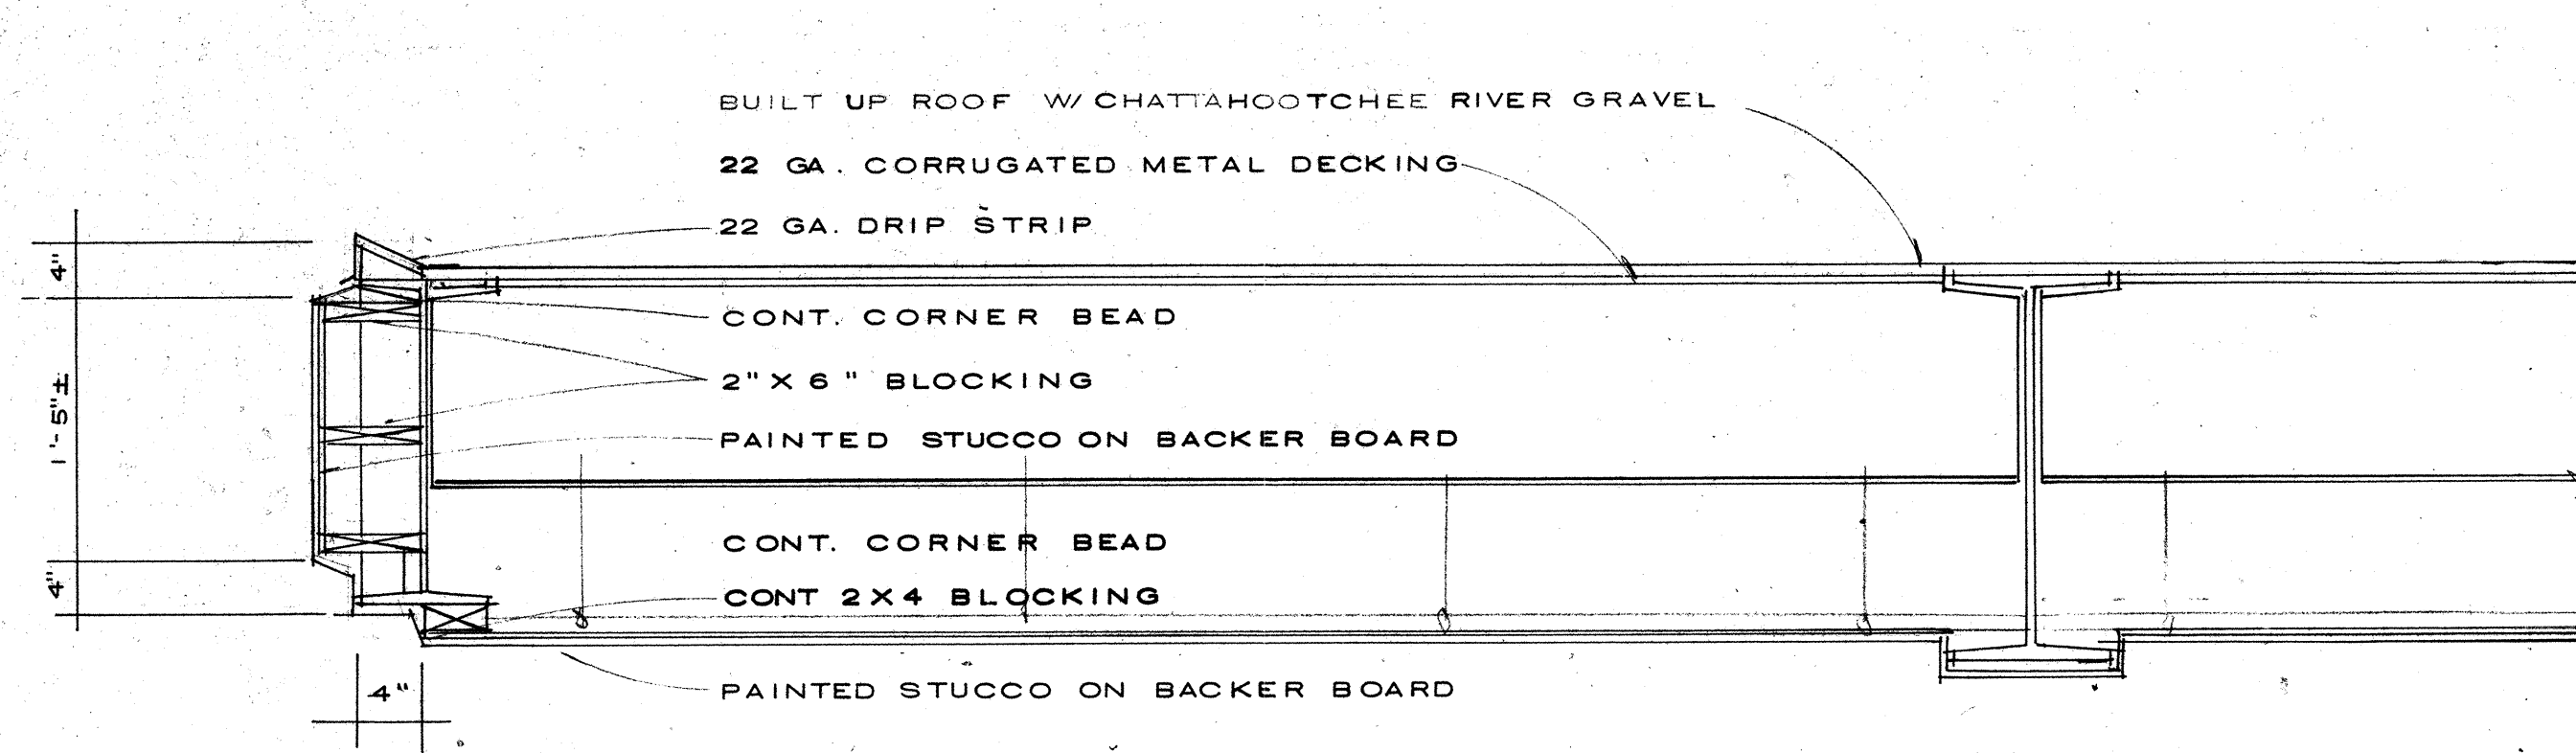


CANOPY DETAIL SCALE 1" = 1'-0"

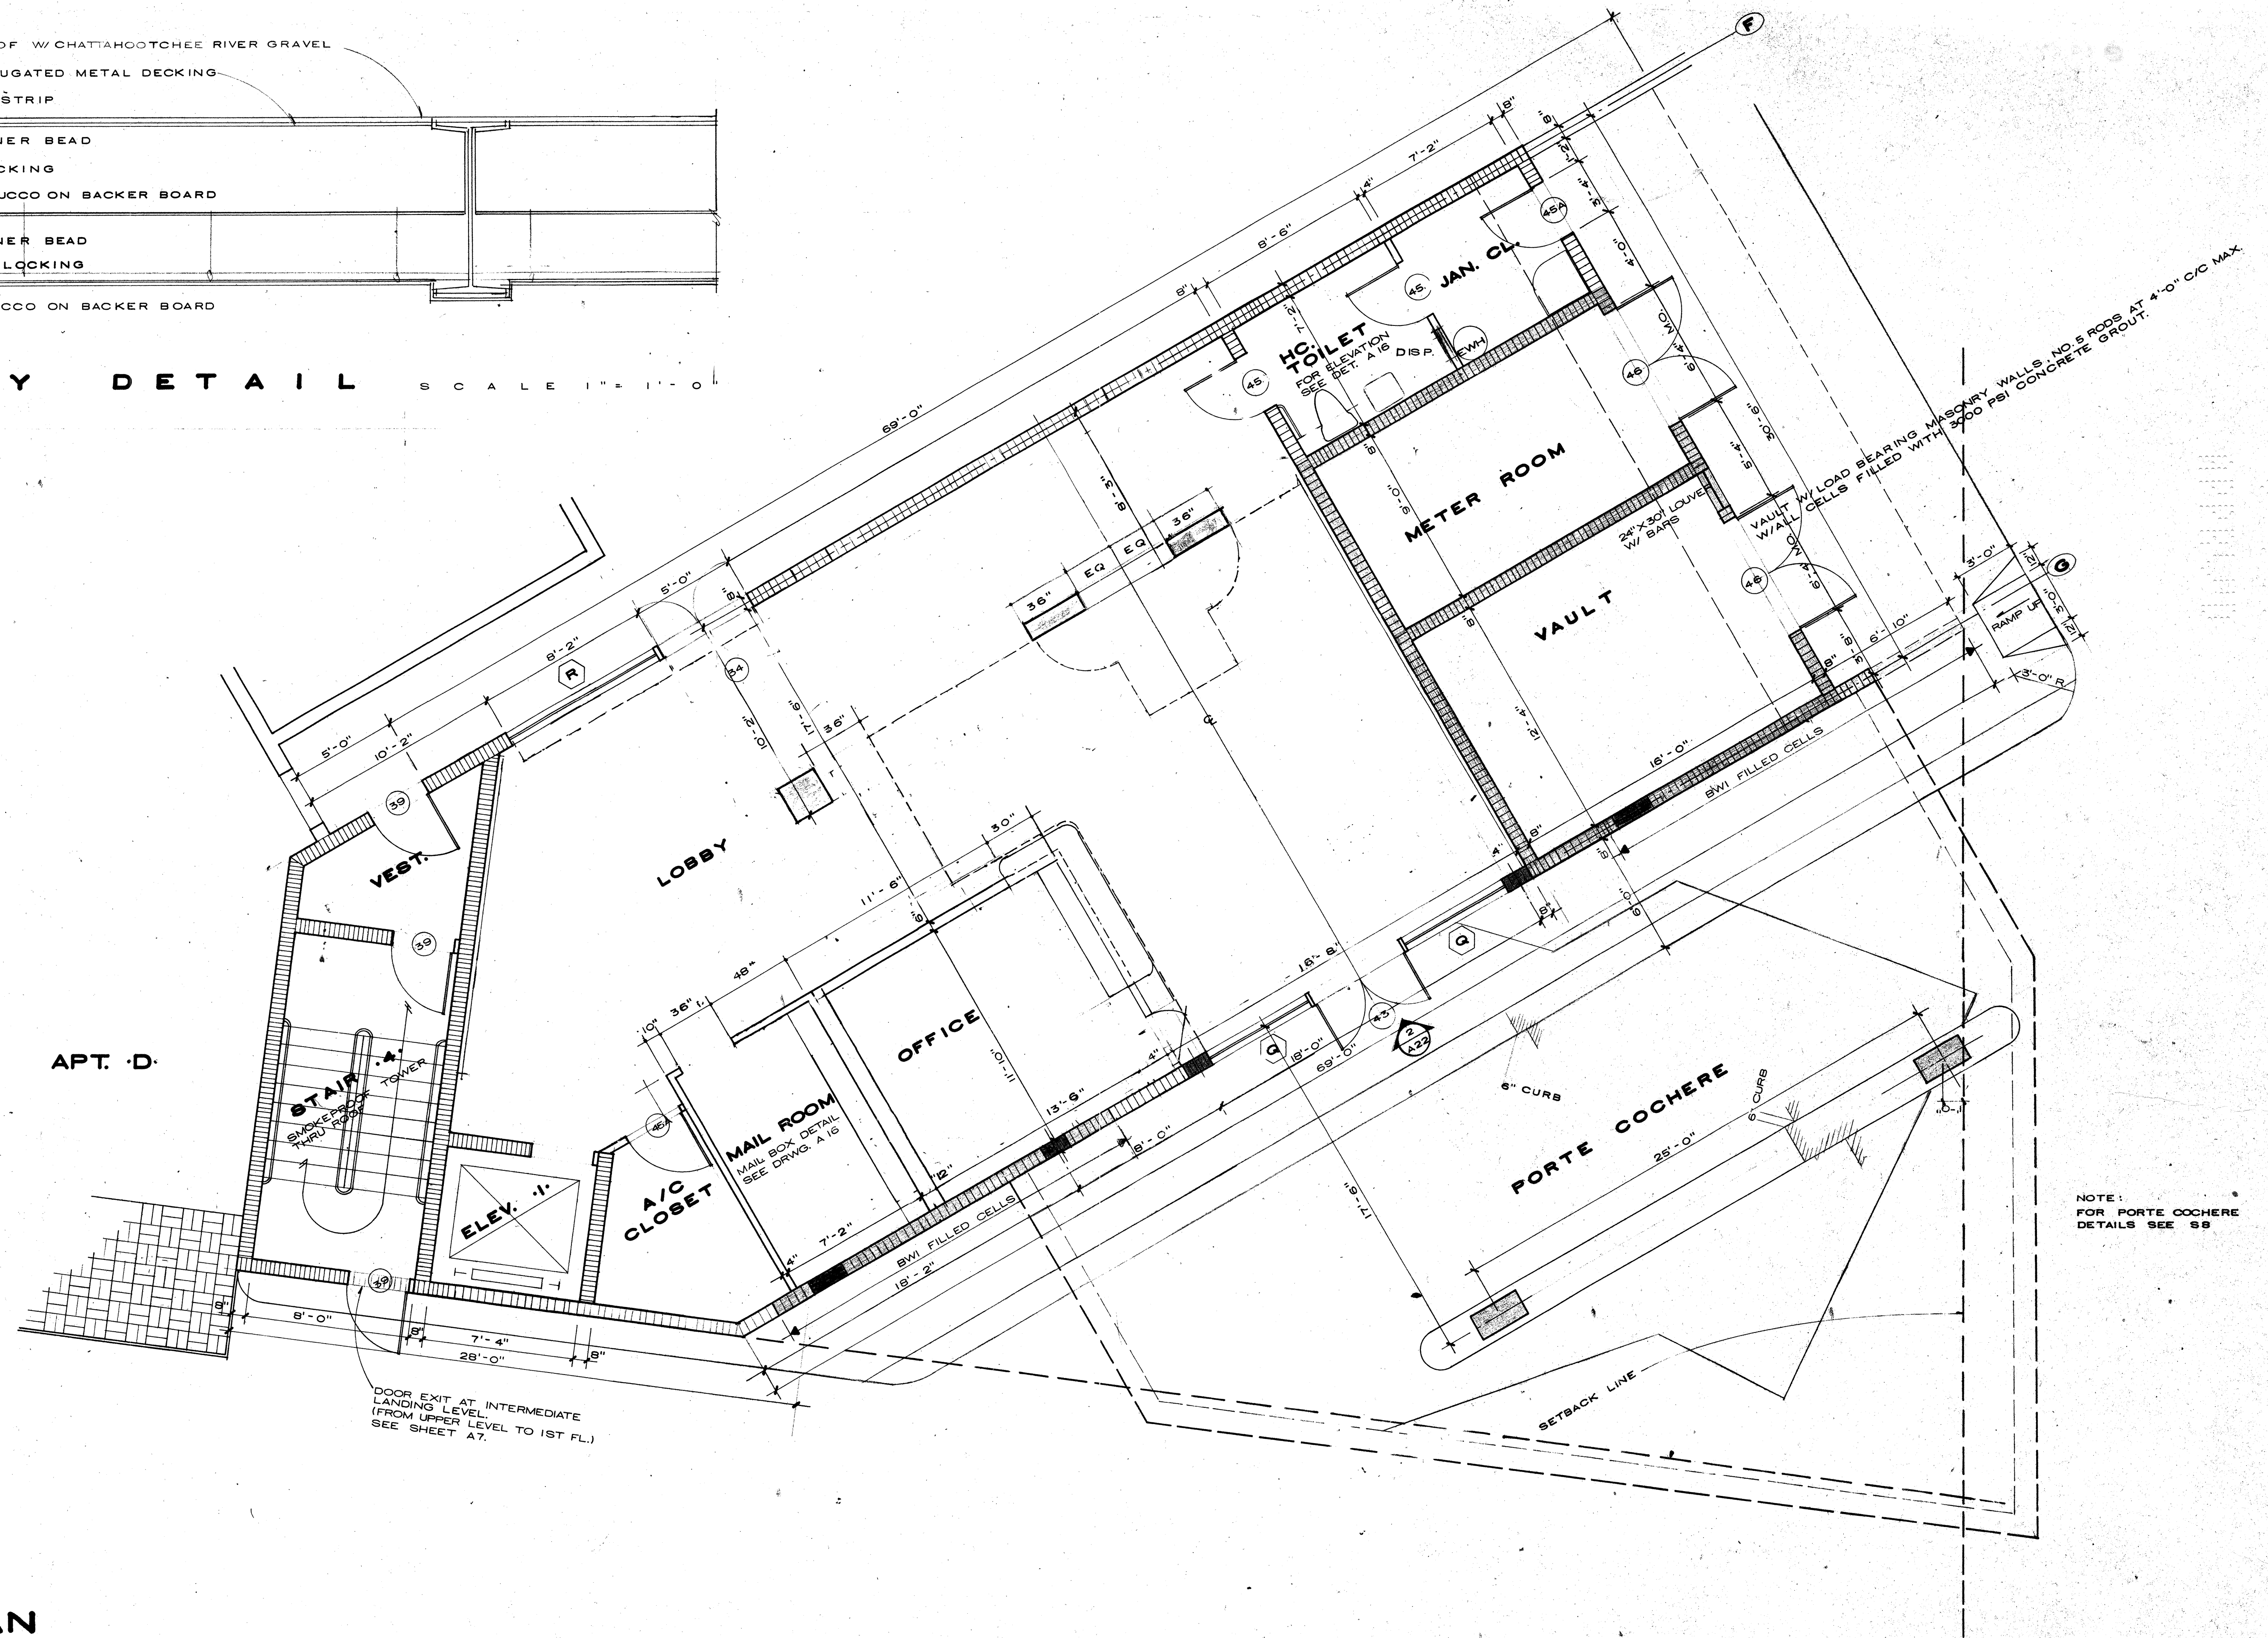

LOBBY PLAN

SCALE: 1/4" = 1'-0"

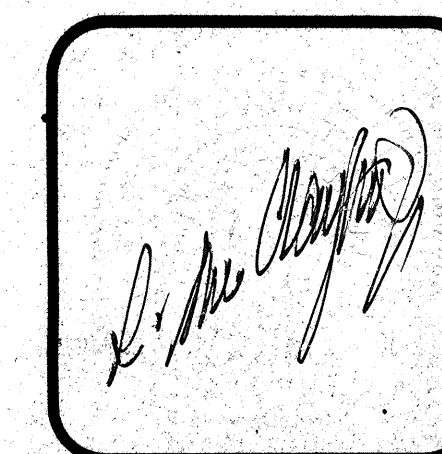

R. WM. CLAYTON JR. ARCHITECT
 1995 EAST OAKLAND PARK BLVD. FT. LAUDERDALE, FLA.
OVERLOOK CONDOMINIUM
LOBBY PLAN

DRAWN BY: ACS, ALP
 JOB NO: 8101
 DATE: 8-12-81
 REVISIONS: 6-11-84
 8-27-84
 AS BUILT 2-8-88
 SHEET: **A11**