

SPECIFICATIONS

MODELS ELEVATOR NO. 1, 3 & 4 ARE DOVER MODEL SPF 30/35. ELEVATOR NO. 2 ARE DOVER MODEL SPF 21-H, WITH SPECIAL PROVISIONS FOR THE PHYSICALLY HANDICAPPED.

TYPE OVER-HEAD GEARED TRACTION.

CAPACITY AND SPEED ELEV. NO. 1, 3 & 4 SPF 30/35; 3,000 LB. @ 350 FPM. ELEV. NO. 2 SPF 21-H; 3,000 LB. @ 350 FPM.

OPERATION DOVER COMPUTAMATIC GROUP SUPERVISORY.

CONTROL GENERATOR FIELD.

NET TRAVEL 250' MAXIMUM.

STOPS AND OPENINGS 25 MAXIMUM, IN LINE AT FRONT OF HOISTWAY.

CLEAR CAR INSIDE ELEV. 1, 3 & 4 SPF 30/35; 6'-8" WIDE X 4'-9" DEEP. ELEV. 2 SPF 21-H; 5'-8" WIDE X 4'-3" DEEP.

ENTRANCES SPF 30/35; 3'-6" WIDE X 7'-0" HIGH, SINGLE-SLIDE DOOR. SPF 21-H; 3'-0" WIDE X 7'-0" HIGH, SINGLE-SLIDE DOOR. FACTORY FINISHED IN ENAMEL.

DOOR OPERATION AUTOMATIC, DIRECT, CURRENT, POWERED.

SIGNALS POSITION INDICATOR IN CAR, "LIGHT-UP" OPERATING BUTTONS, AND ENTRANCE COLUMNS, TELEPHONE COMPARTMENT, CAR POSITION INDICATOR, HALL POSITION INDICATOR, EMERGENCY LIGHT AND ALARM BELL, SELECTED DOVER CARPET, INDEPENDENT SERVICE, LOAD-WEIGHING HALL CALL BY PASS, AUTOMATIC STANDBY OPERATION FOR ENERGY CONSERVATION, ROLLER GUIDES, NEMA 1 (FULLY ENCLOSED) CONTROLLER, CABINETS, EMERGENCY SERVICE IN ACCORDANCE WITH THE SAFETY CODE FOR ELEVATORS AND ESCALATORS (ANSI/ASME A17.1) IS INCLUDED.

OPTIONAL FEATURES DOVER CAP 1 CAR FAN, HOISTWAY ACCESS PACKAGE, EMERGENCY POWER OPERATION, DUAL PHOTO-EYE PROTECTIVE DEVICE, SPECIAL REQUIREMENTS OF STATE OR LOCAL CODES, AND SINGLE-SLIDE DOOR.


PROVISIONS FOR HANDICAPPED ELEVATOR DIMENSIONS AND LOCATION OF CAR OPERATING STATION, TELEPHONE COMPARTMENT, AND HAND-RAIL COMPLY WITH THE REQUIREMENTS OF ANSI A117.1 FOR USE BY THE PHYSICALLY HANDICAPPED. OTHER FEATURES THAT MAY BE REQUIRED BY LOCAL ELEVATOR CODES ARE AVAILABLE AS OPTIONS, INCLUDING ELECTRONIC DOOR SENSING DEVICE, VISUAL AND AUDIBLE SIGNALS, TACTILE MARKINGS AND SINGLE-SLIDE DOOR.

NATIONAL CODE COMPLIANCE DOVER PRE-ENGINEERED ELEVATORS INCLUDE ALL FEATURES REQUIRED BY THE SAFETY CODE FOR ELEVATORS AND ESCALATORS (ANSI/ASME A17.1).

MAINTENANCE THREE MONTHS MAINTENANCE INCLUDED WITH INSTALLATION.

CONTROLS ACCORDING TO SFBC 515.3 (1)


NOTE: 350 FT. OF VENTILATION OPENINGS REQUIRED FOR ELEVATOR SHAFT PRESSURE RELIEF.

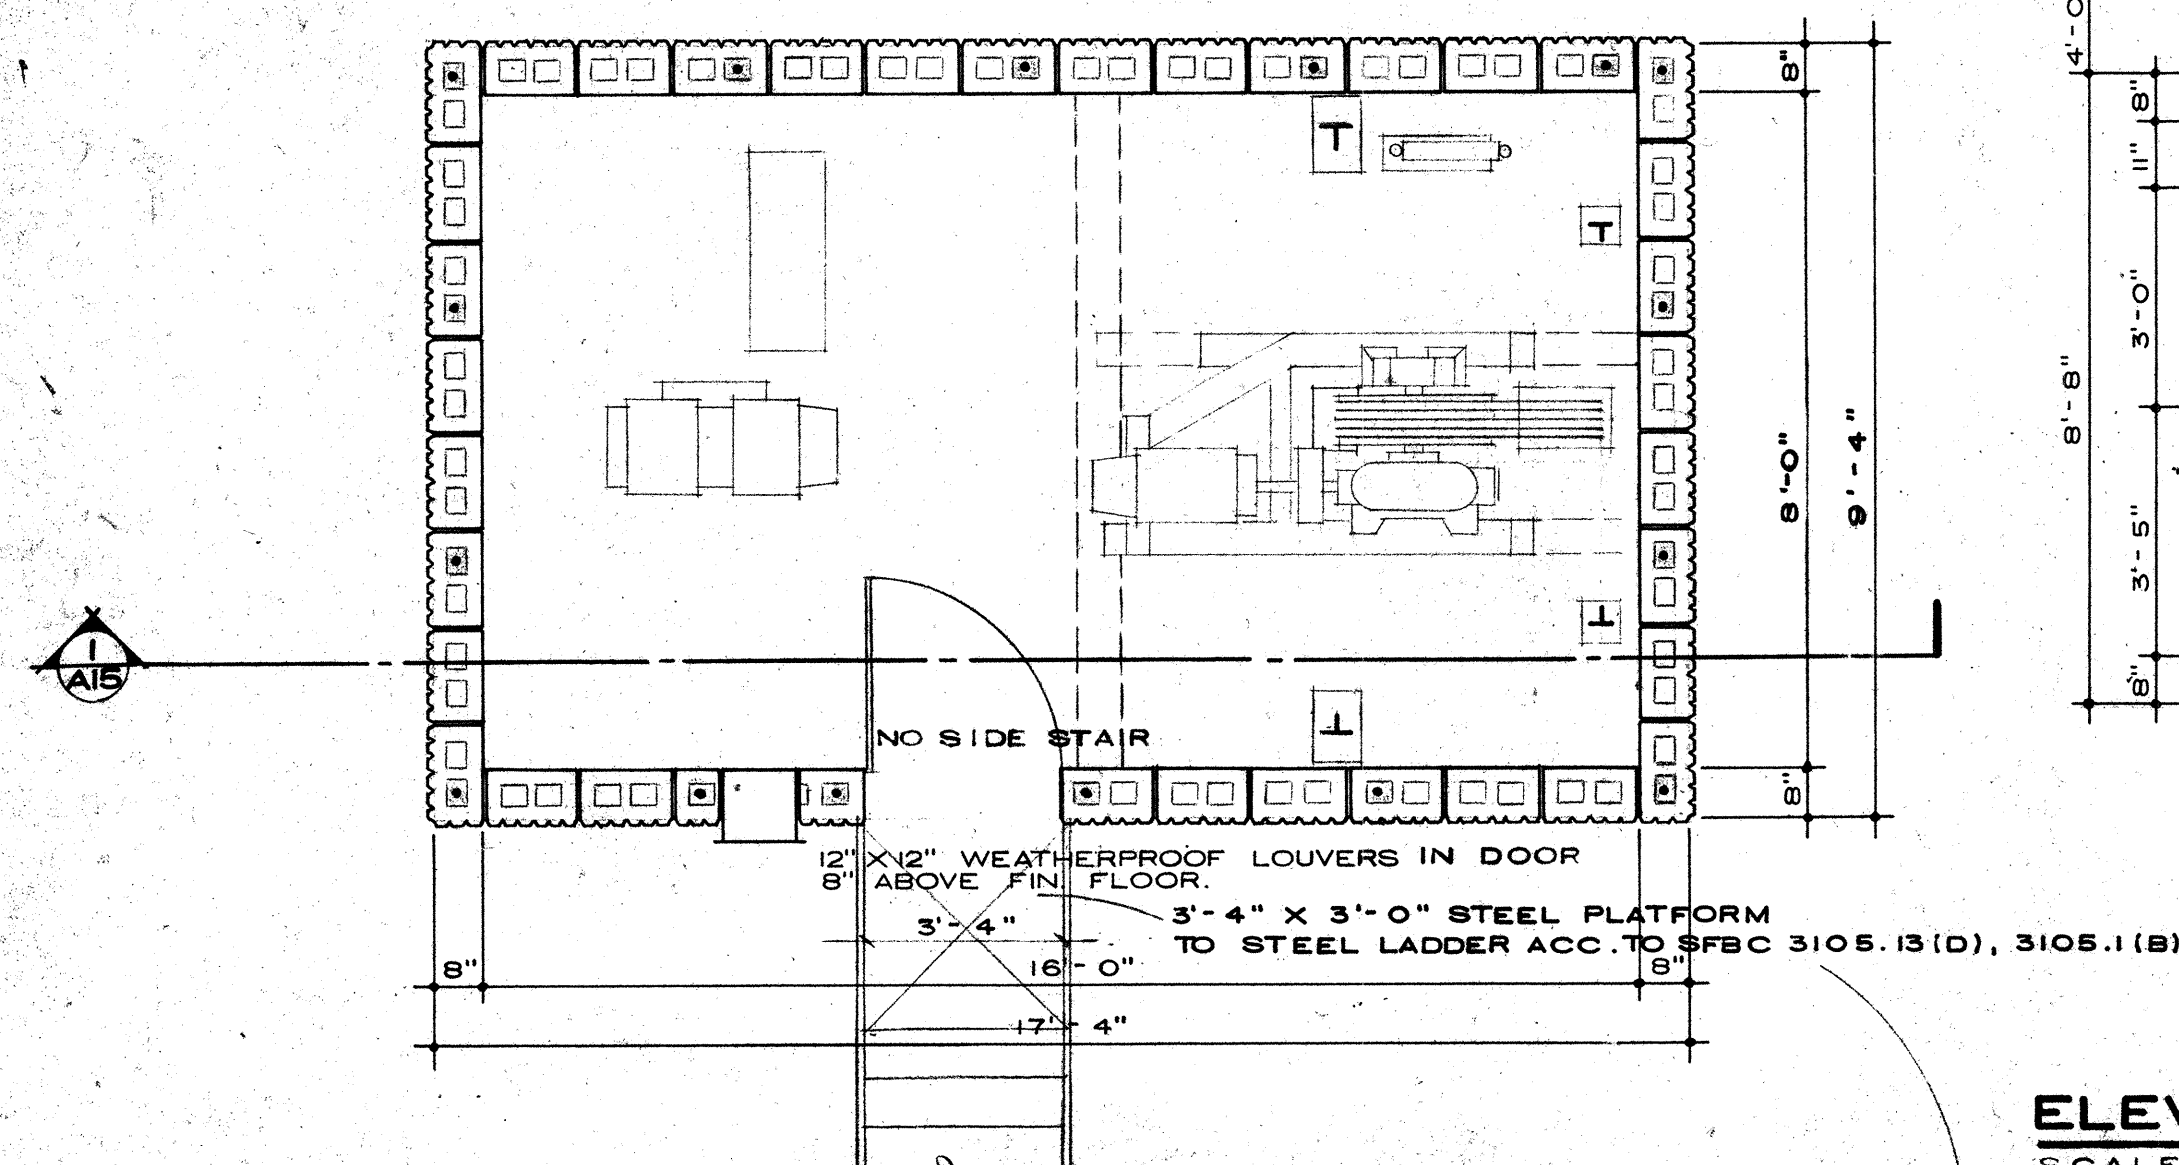


ELEVATOR 1, 3, 4 PENTHOUSE 1/A12
SCALE: 3/8" = 1'-0"

ELEV. 1, 3, 4 TYP. FLOOR PLAN 2/A12


SCALE: 3/8" = 1'-0"
NOTE: THIS CAB IS EQUIPPED FOR THE HANDICAPPED, SEE SPECIFICATIONS. OPEN SIDES OF ELEVATORS TO HAVE KNOCK OUT BLOCK W/2 NOS CONT. AT EACH FLOOR LEVEL.

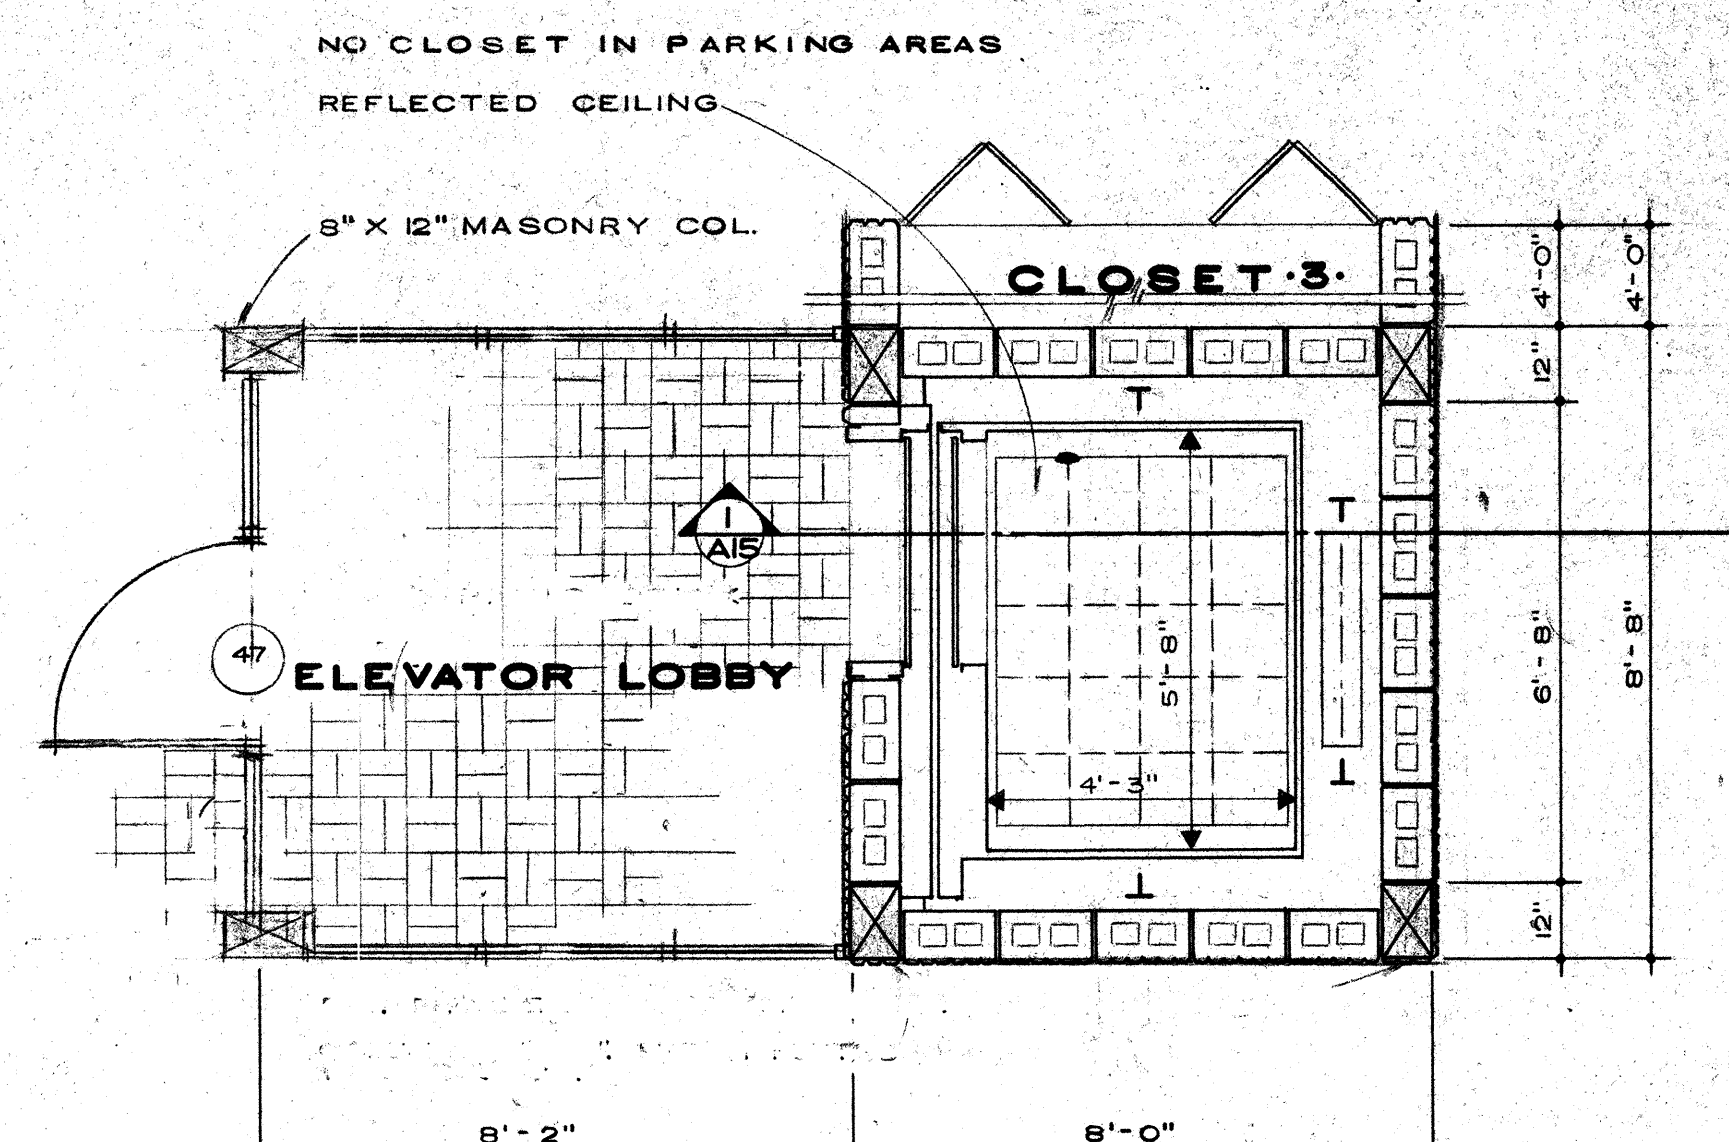


ELEV. 1, 3, 4 UPPER LEVEL PARKING PLAN 3/A12

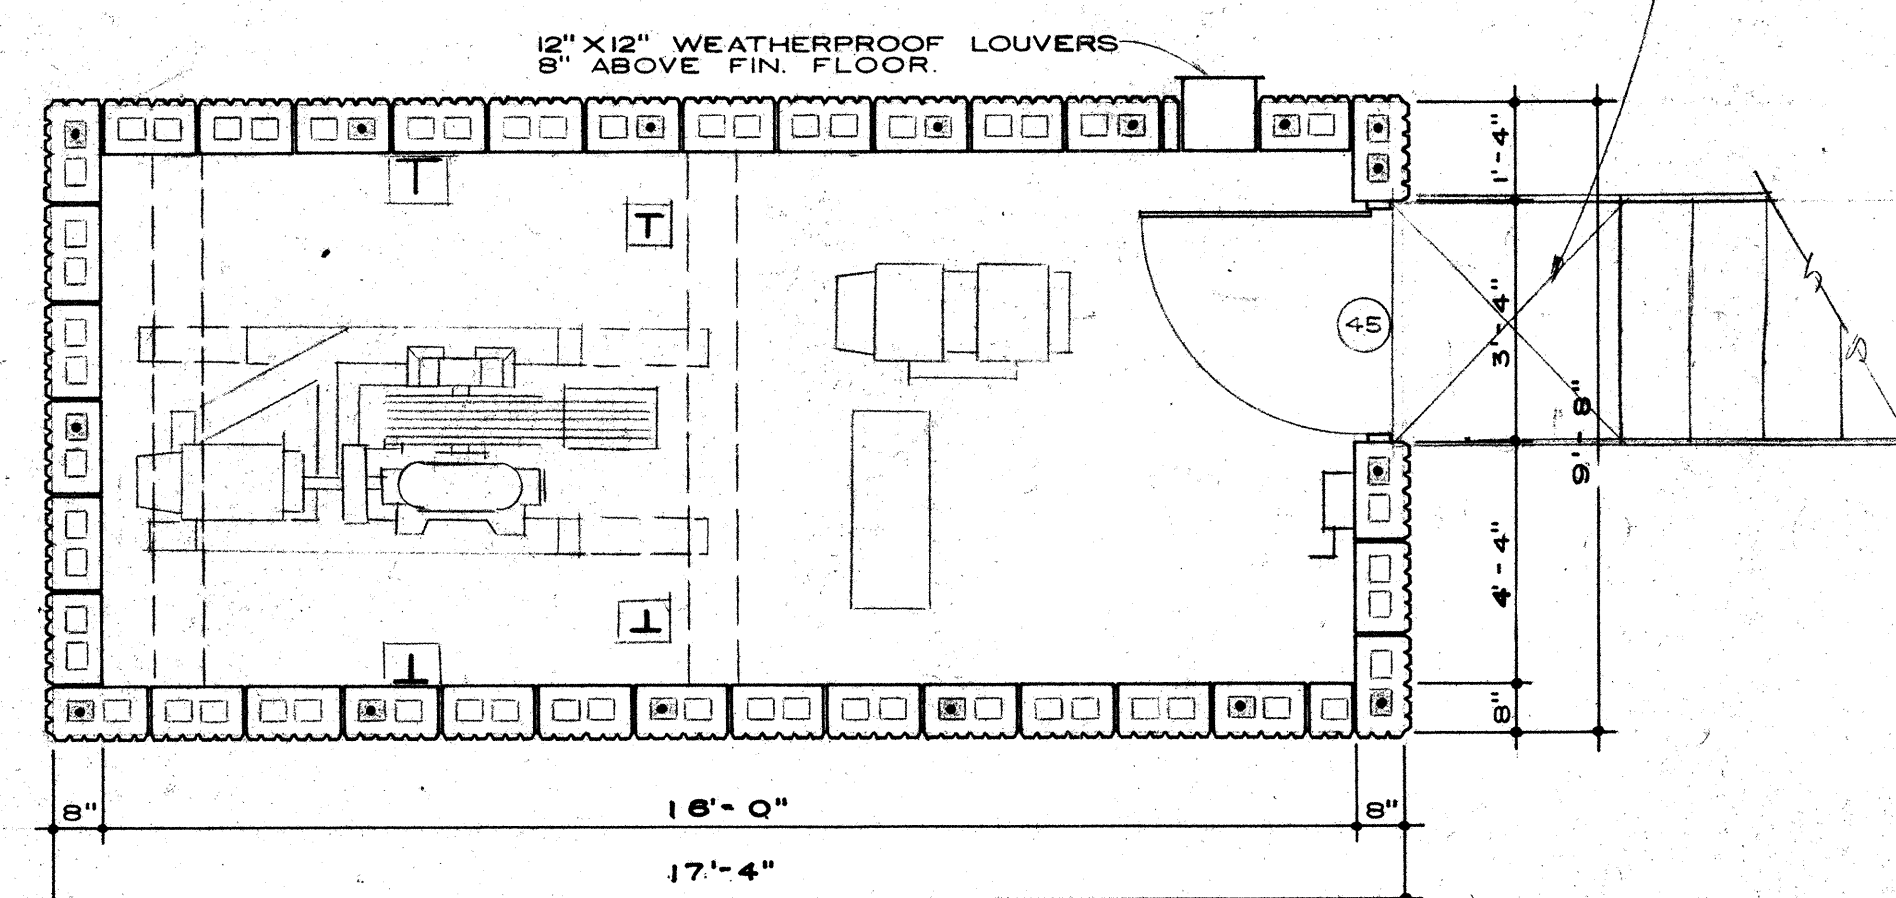


ELEVATOR 2 PENTHOUSE 4/A12
SCALE: 3/8" = 1'-0"

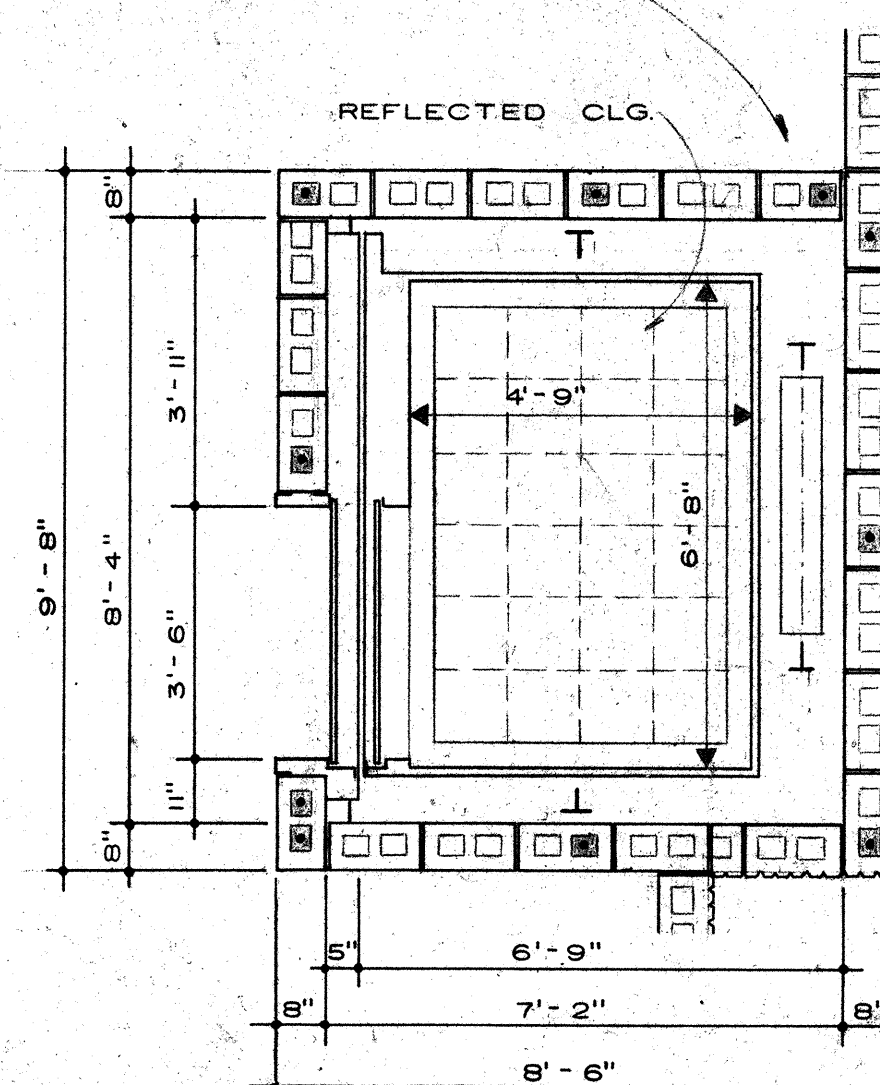

ELEVATOR 2 TYP. FL. PLAN 5/A12
SCALE: 3/8" = 1'-0"

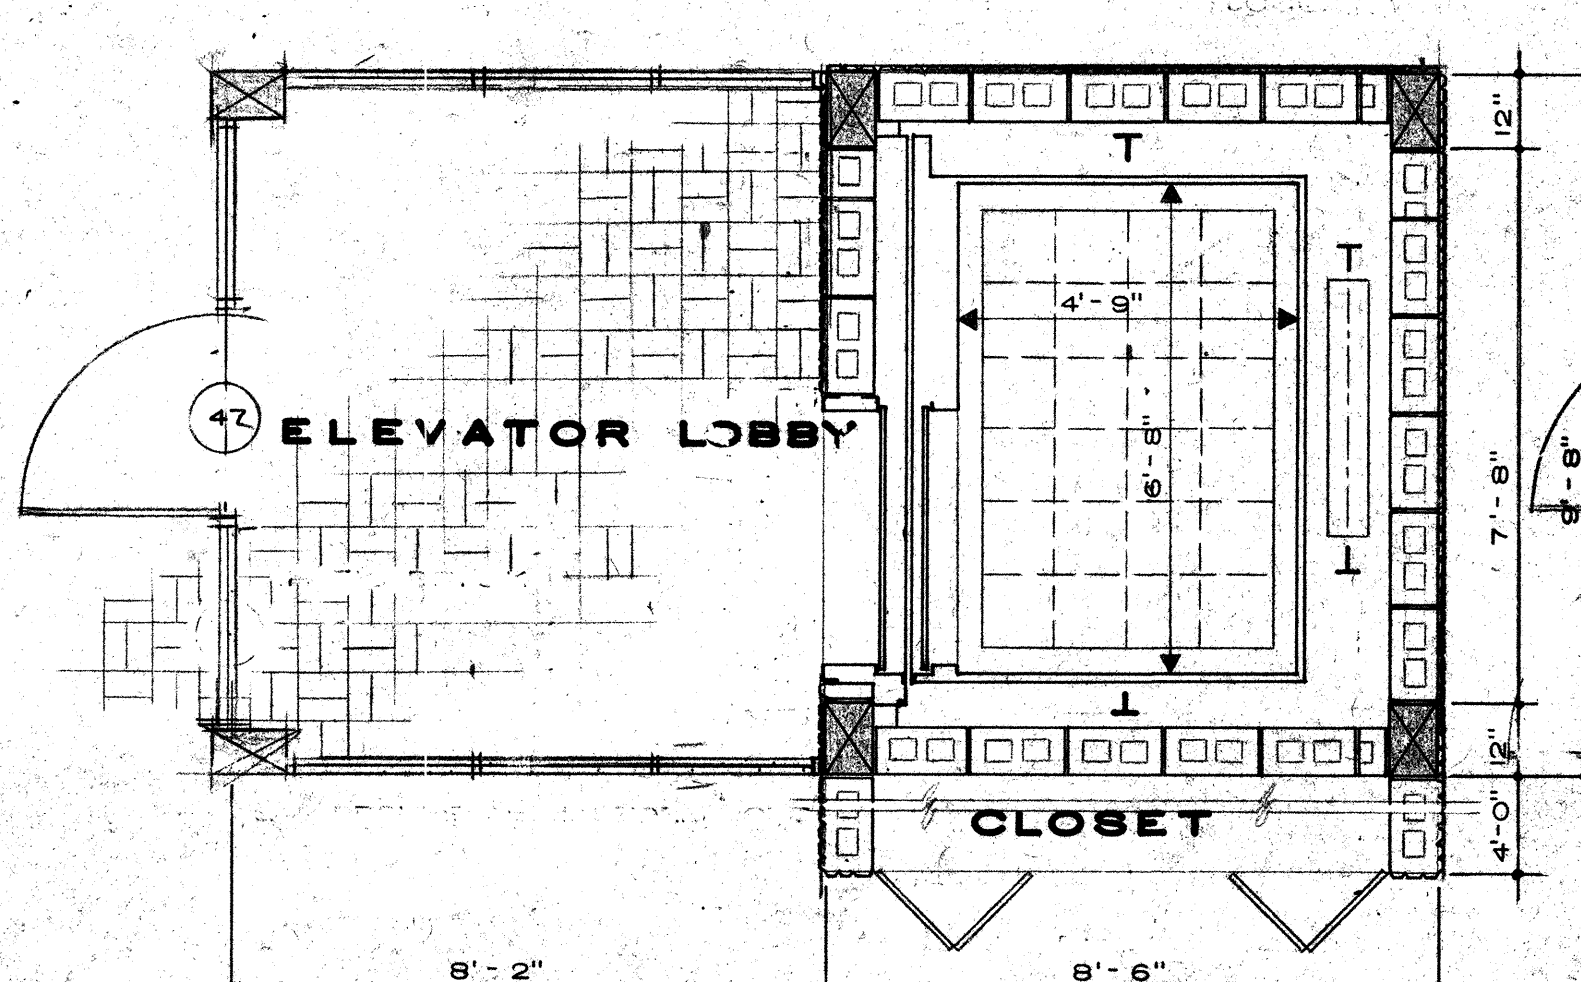


ELEVATOR 2 UPPER LEVEL PARKING PLAN 6/A12

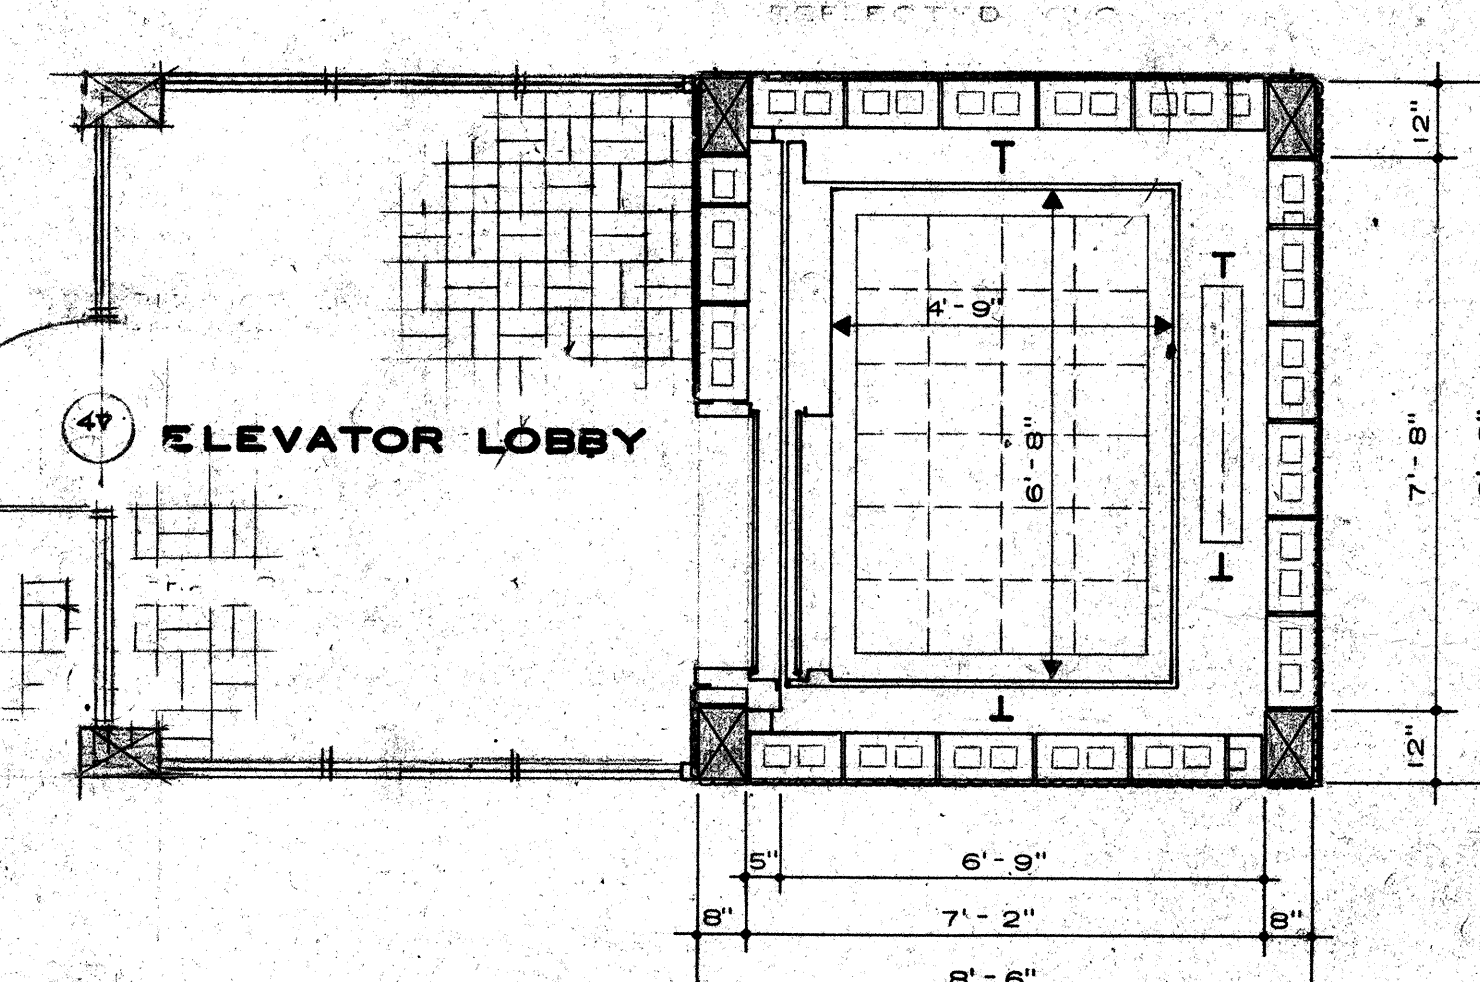

ELEVATOR 2 LOWER LEVEL PARKING PLAN 7/A12

NOTE: THIS ELEV. IS TYPICAL FOR 1, 3, 4

NOTE: VOID THESE DETAILS FOR STD. CO. FINISHES

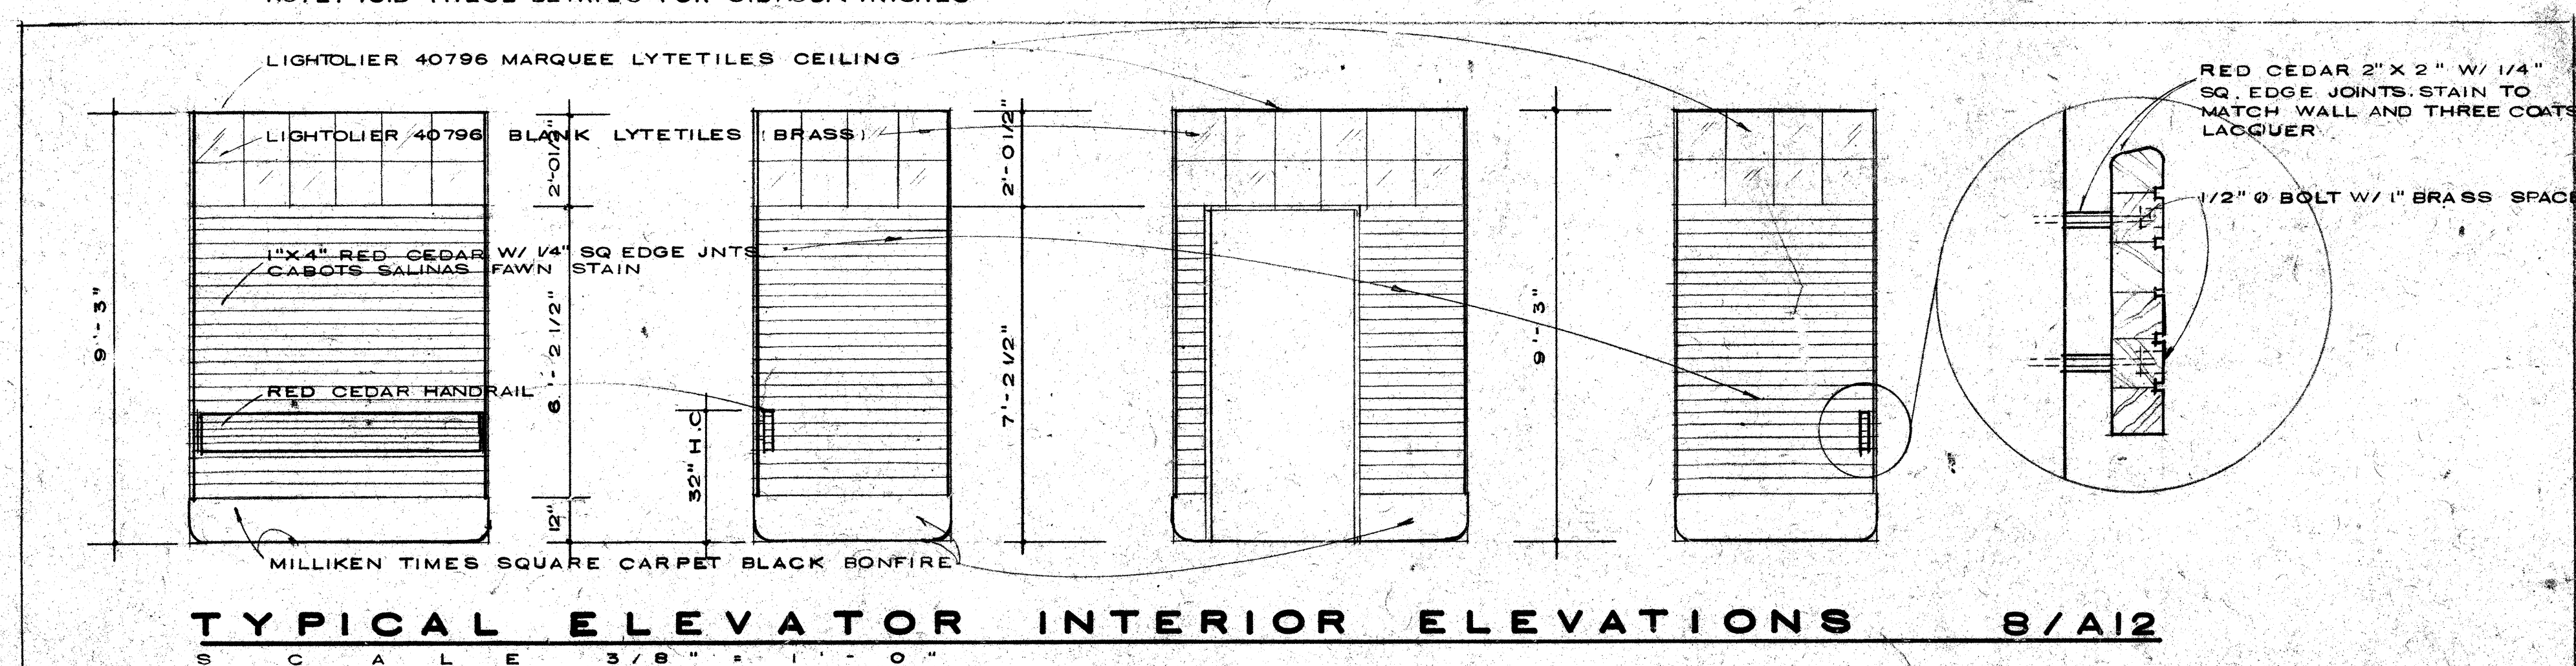

TYPICAL ELEVATOR INTERIOR ELEVATIONS 8/A12
SCALE: 3/8" = 1'-0"

[Signature]

R. WM. CLAYTON JR. ARCHITECT
1995 EAST OAKLAND PARK BLVD. FT. LAUDERDALE FLA.
OVERLOOK CONDOMINIUM
ELEVATOR DETAILS

DRAWN BY: LRP
JOB NO: 9101
DATE: 8-12-81
REVISIONS: 5-11-84
DIMENSIONS: 8-30-84
AS BUILT 2-8-88
SHEET **A12**