




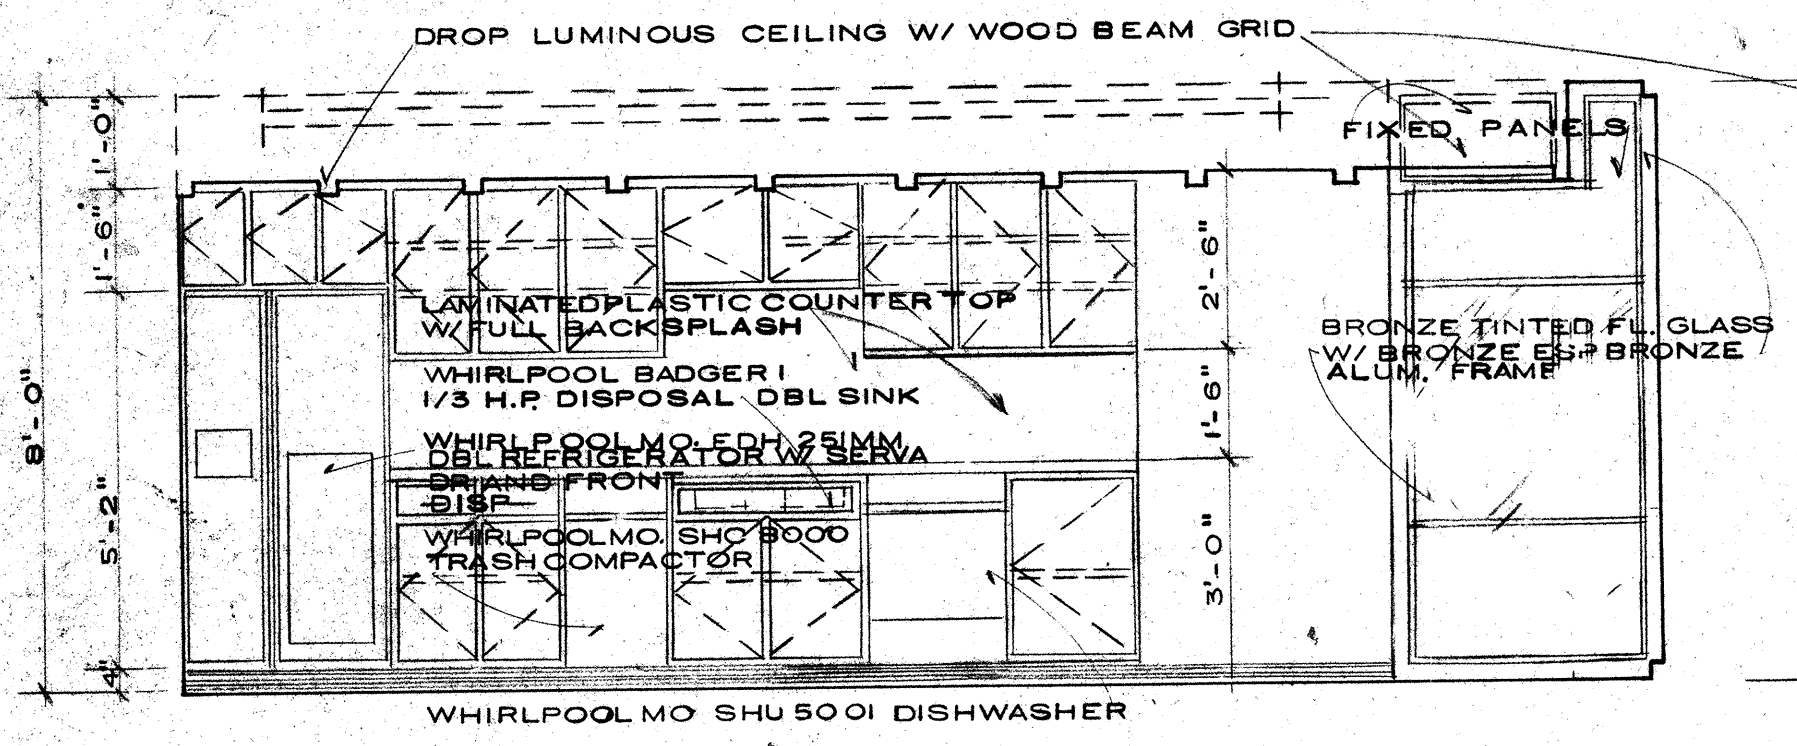


KITCHEN A1/A14
SCALE: 3/8" = 1'-0"

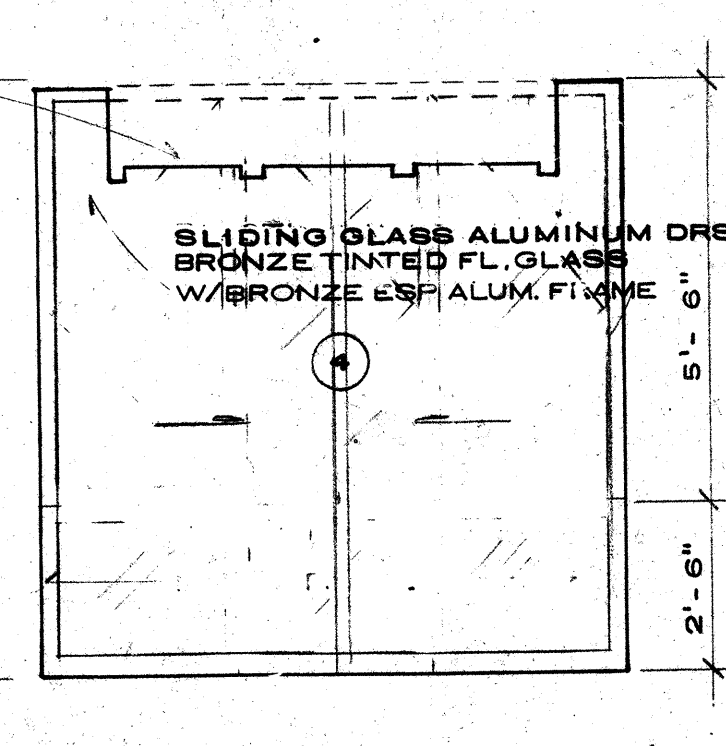


BREAKFAST A2/A14

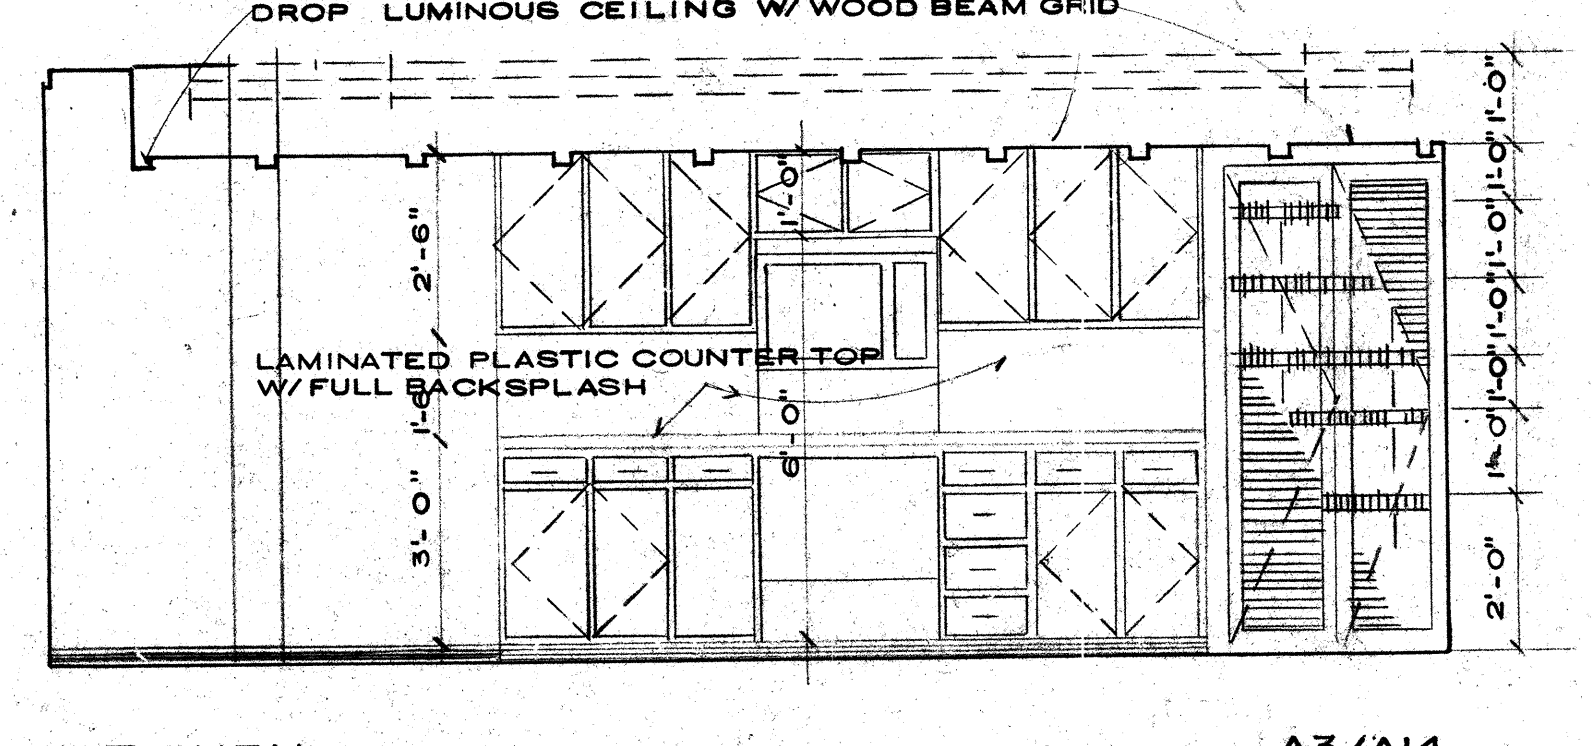


KITCHEN A3/A14

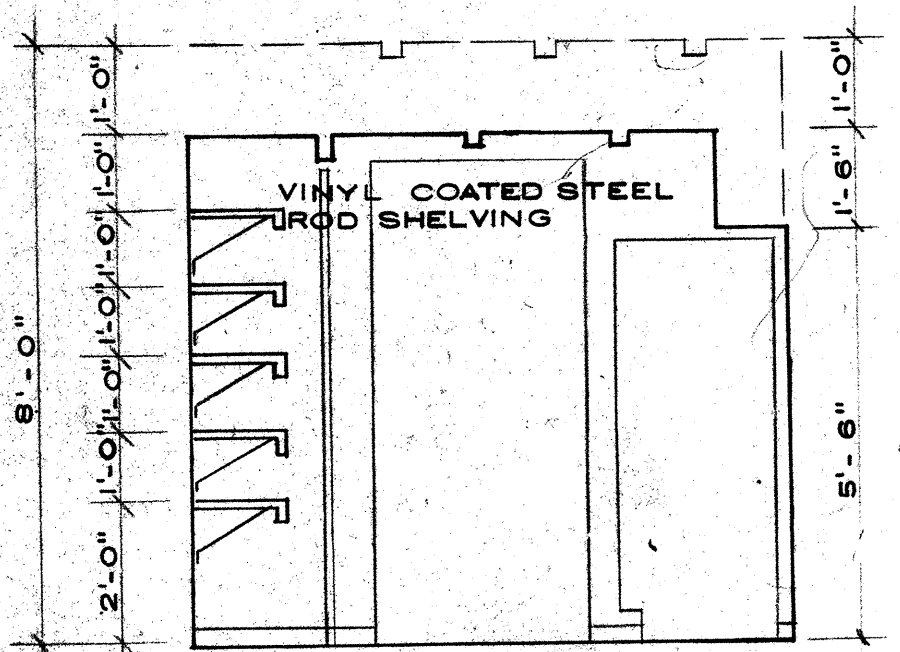


KITCHEN A4/A14
SCALE: 3/8" = 1'-0"

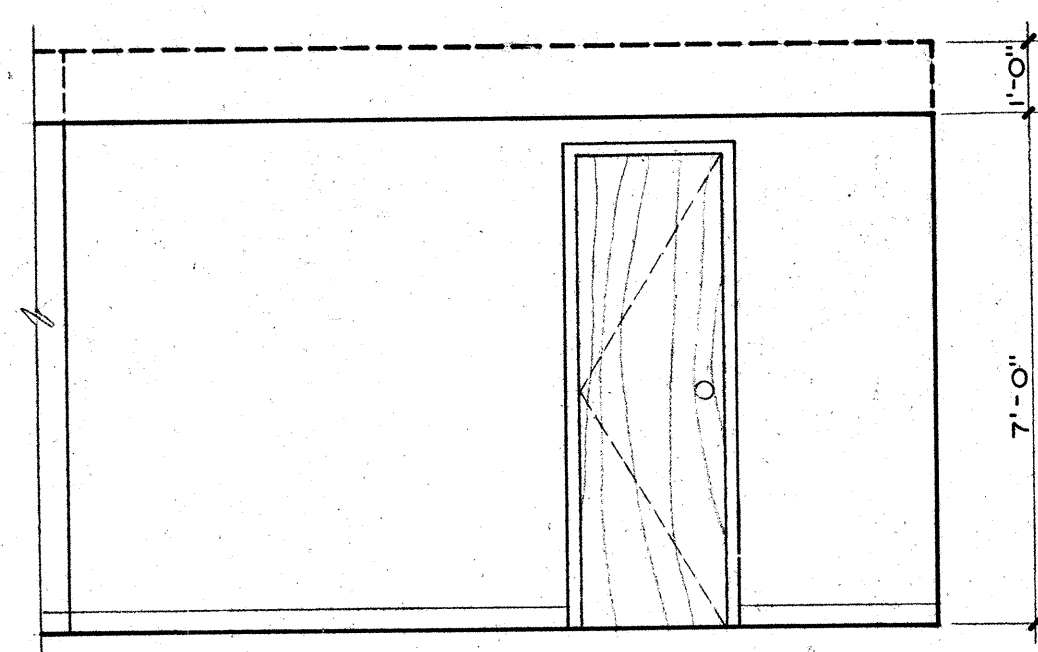


HALLWAY A5/A14

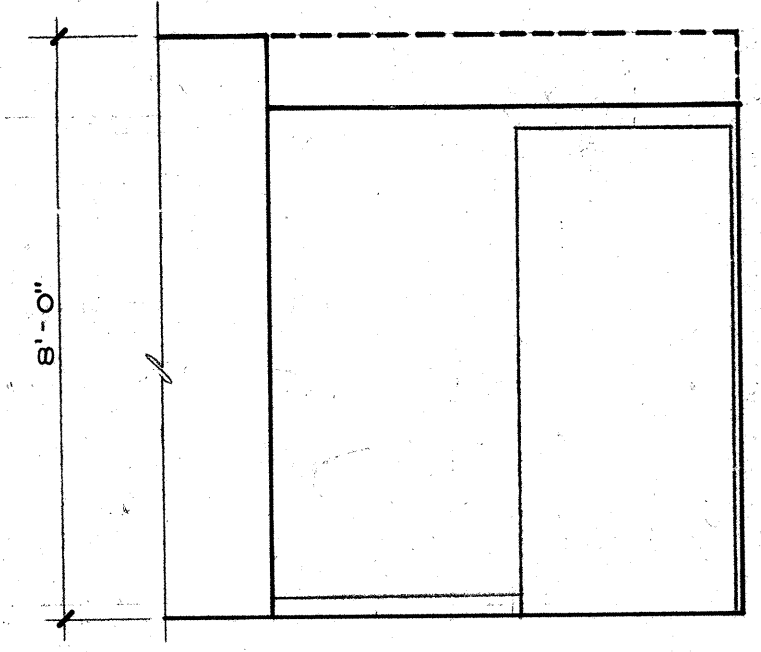


DINING A7/A14

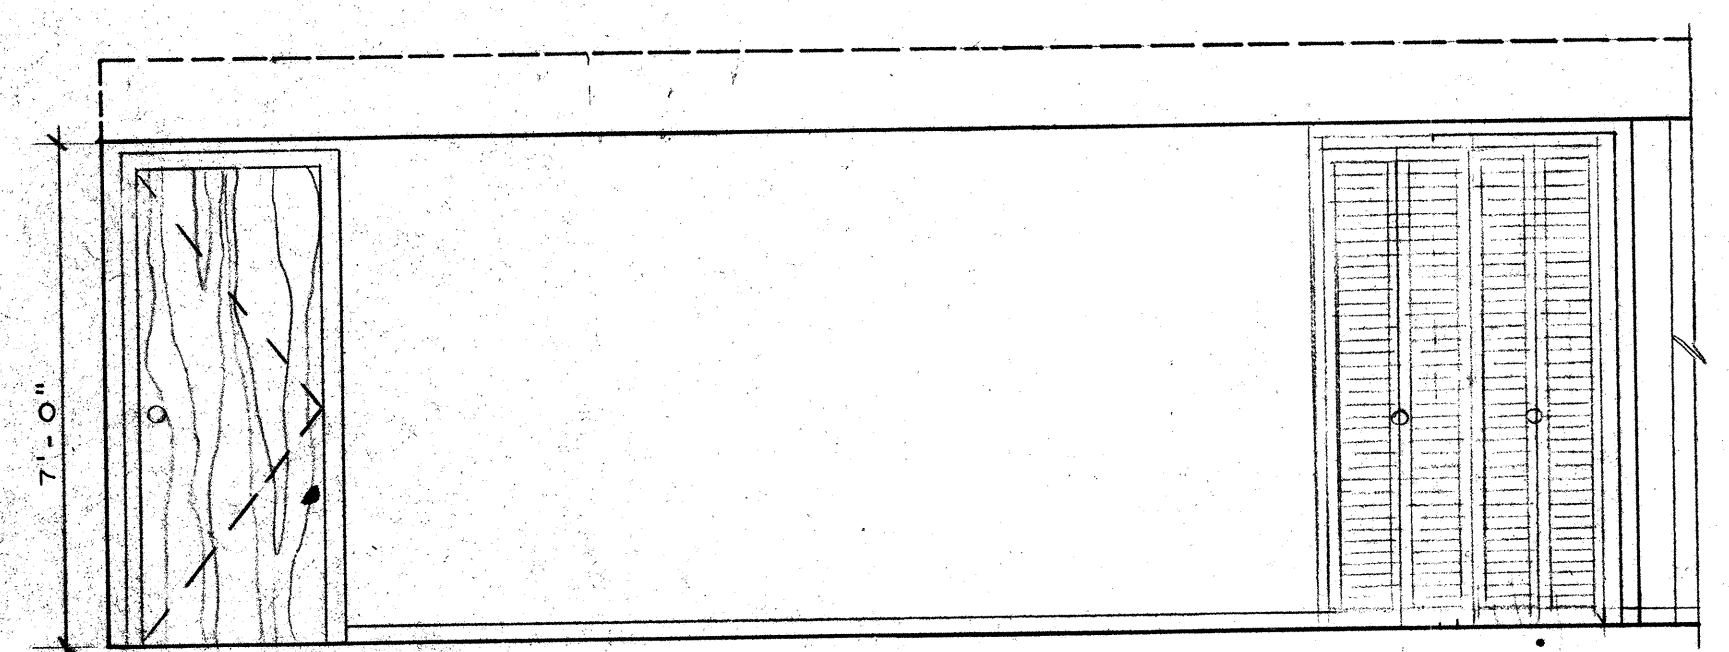


DINING A8/A14
SCALE: 3/8" = 1'-0"

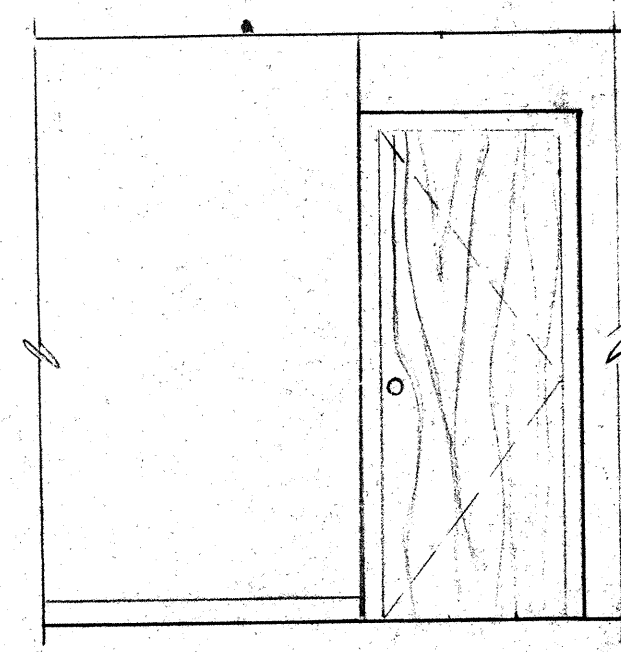


LIVING A9/A14

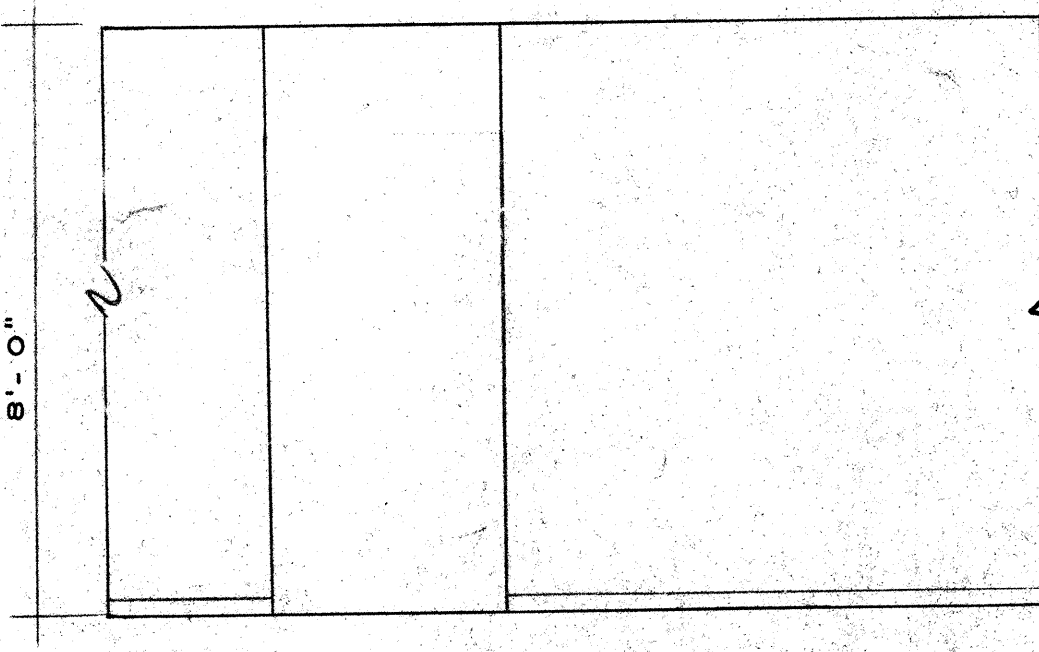


LIVING A10/A14

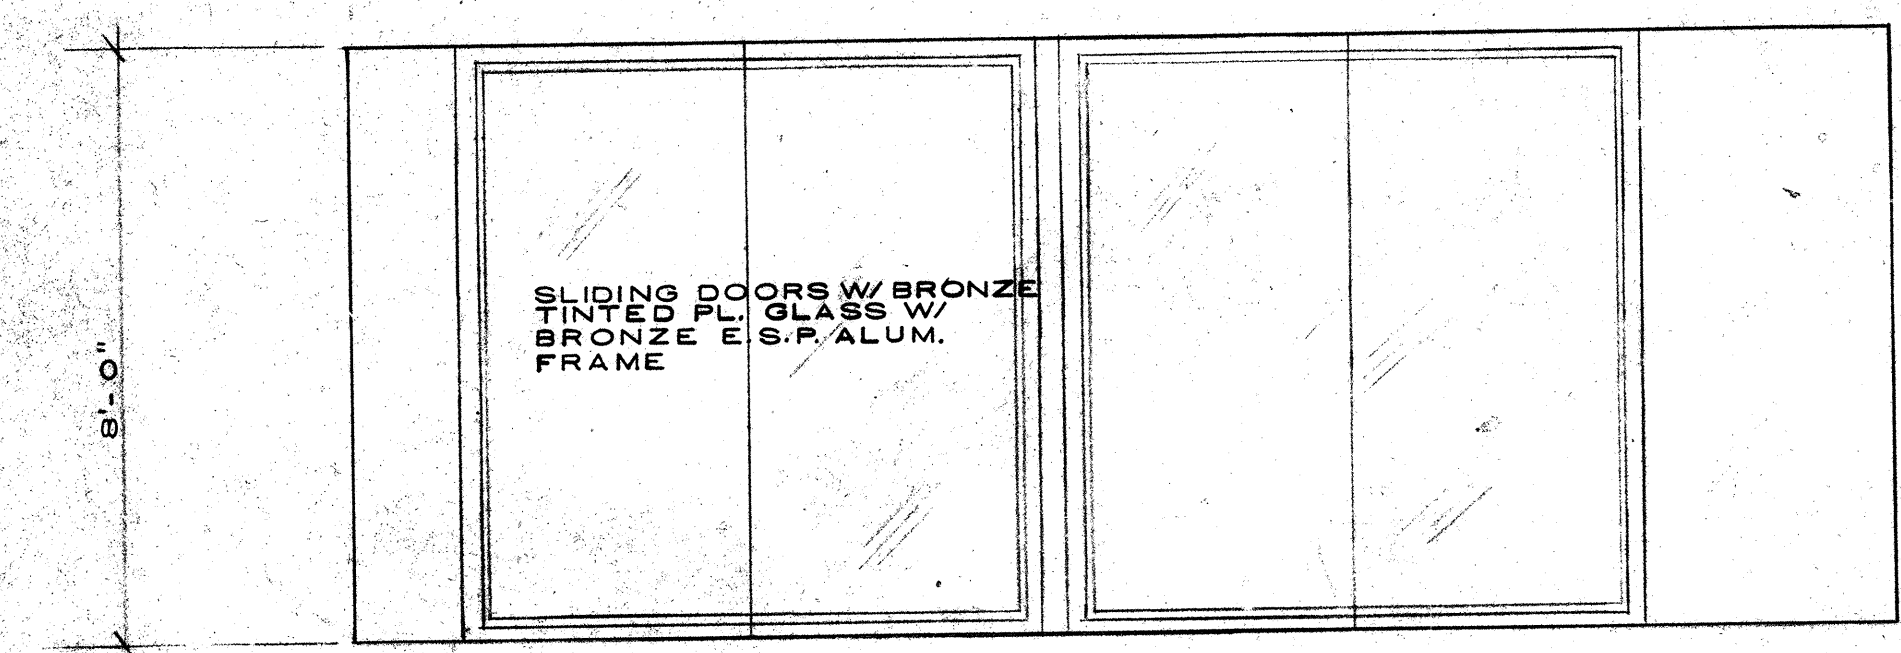


LIVING A11/A14
SCALE: 3/8" = 1'-0"

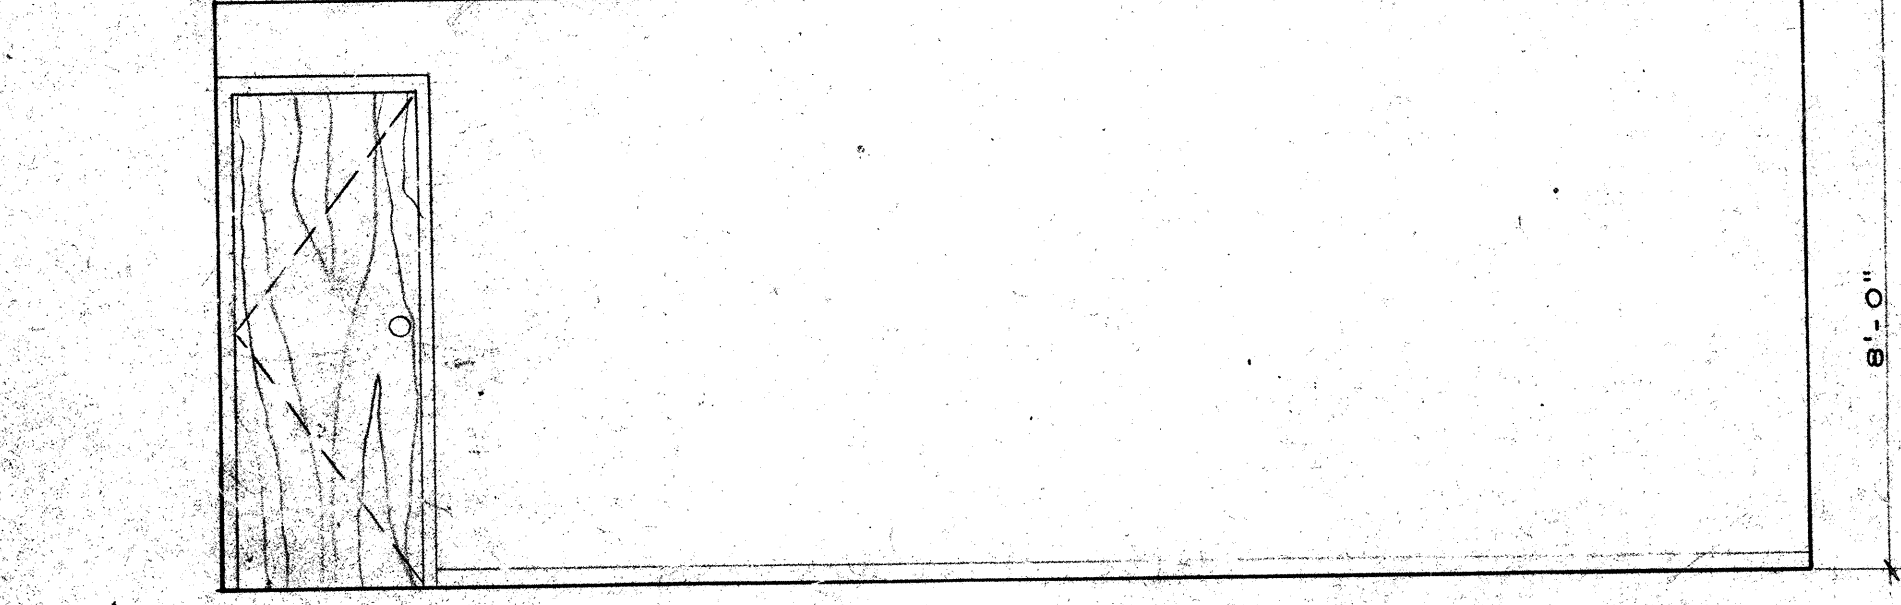

MASTER BEDROOM A12/A14

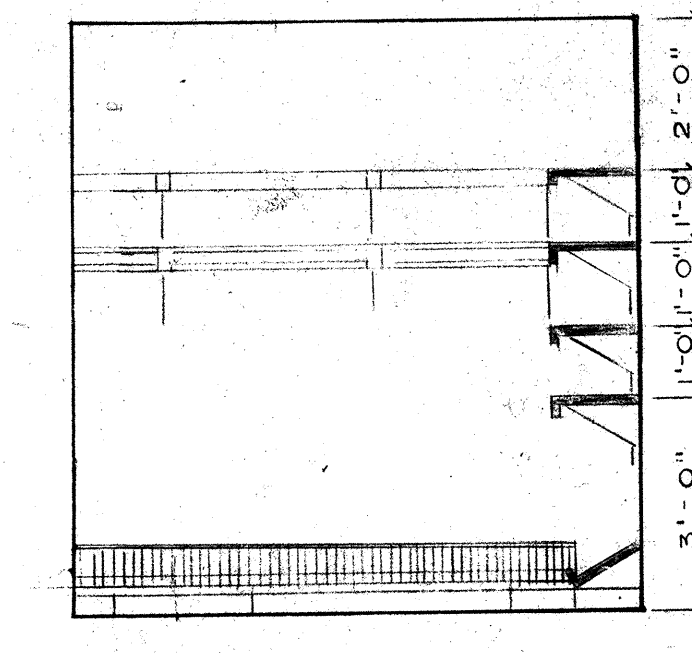

CLOSET A19/A14

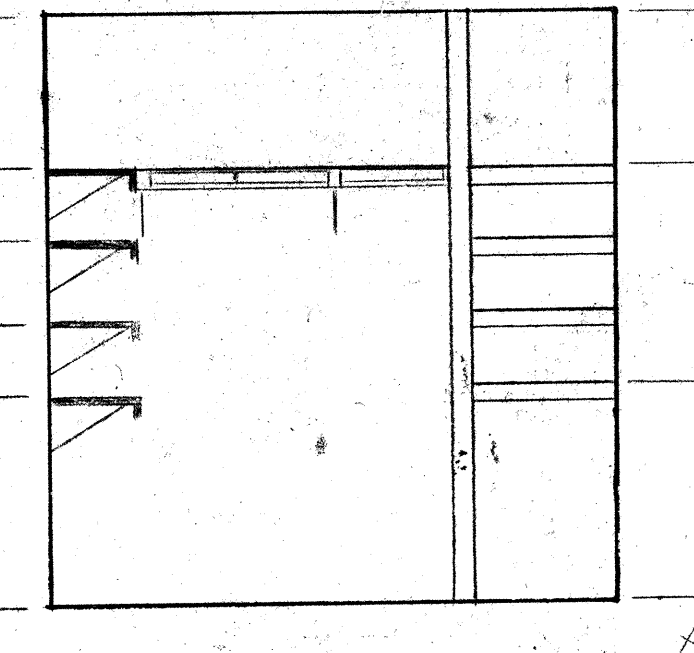


CLOSET A21/A14

FLOOR PLAN APT. A

SCALE: 1/4" = 1'-0"
SQ. FT. OF APT. = 2615
SQ. FT. OF BALC. = 474
TOTAL SQ. FT. = 3089

ELEVATIONS APARTMENT "A"	PAGE
A1-12, 19, 21	A14
A13, 22-27, 29, 36, 40, 42, 43	A15
A14-18, 20, 28, 31, 32, 37	A17
A30, 38, 41, 44	A18

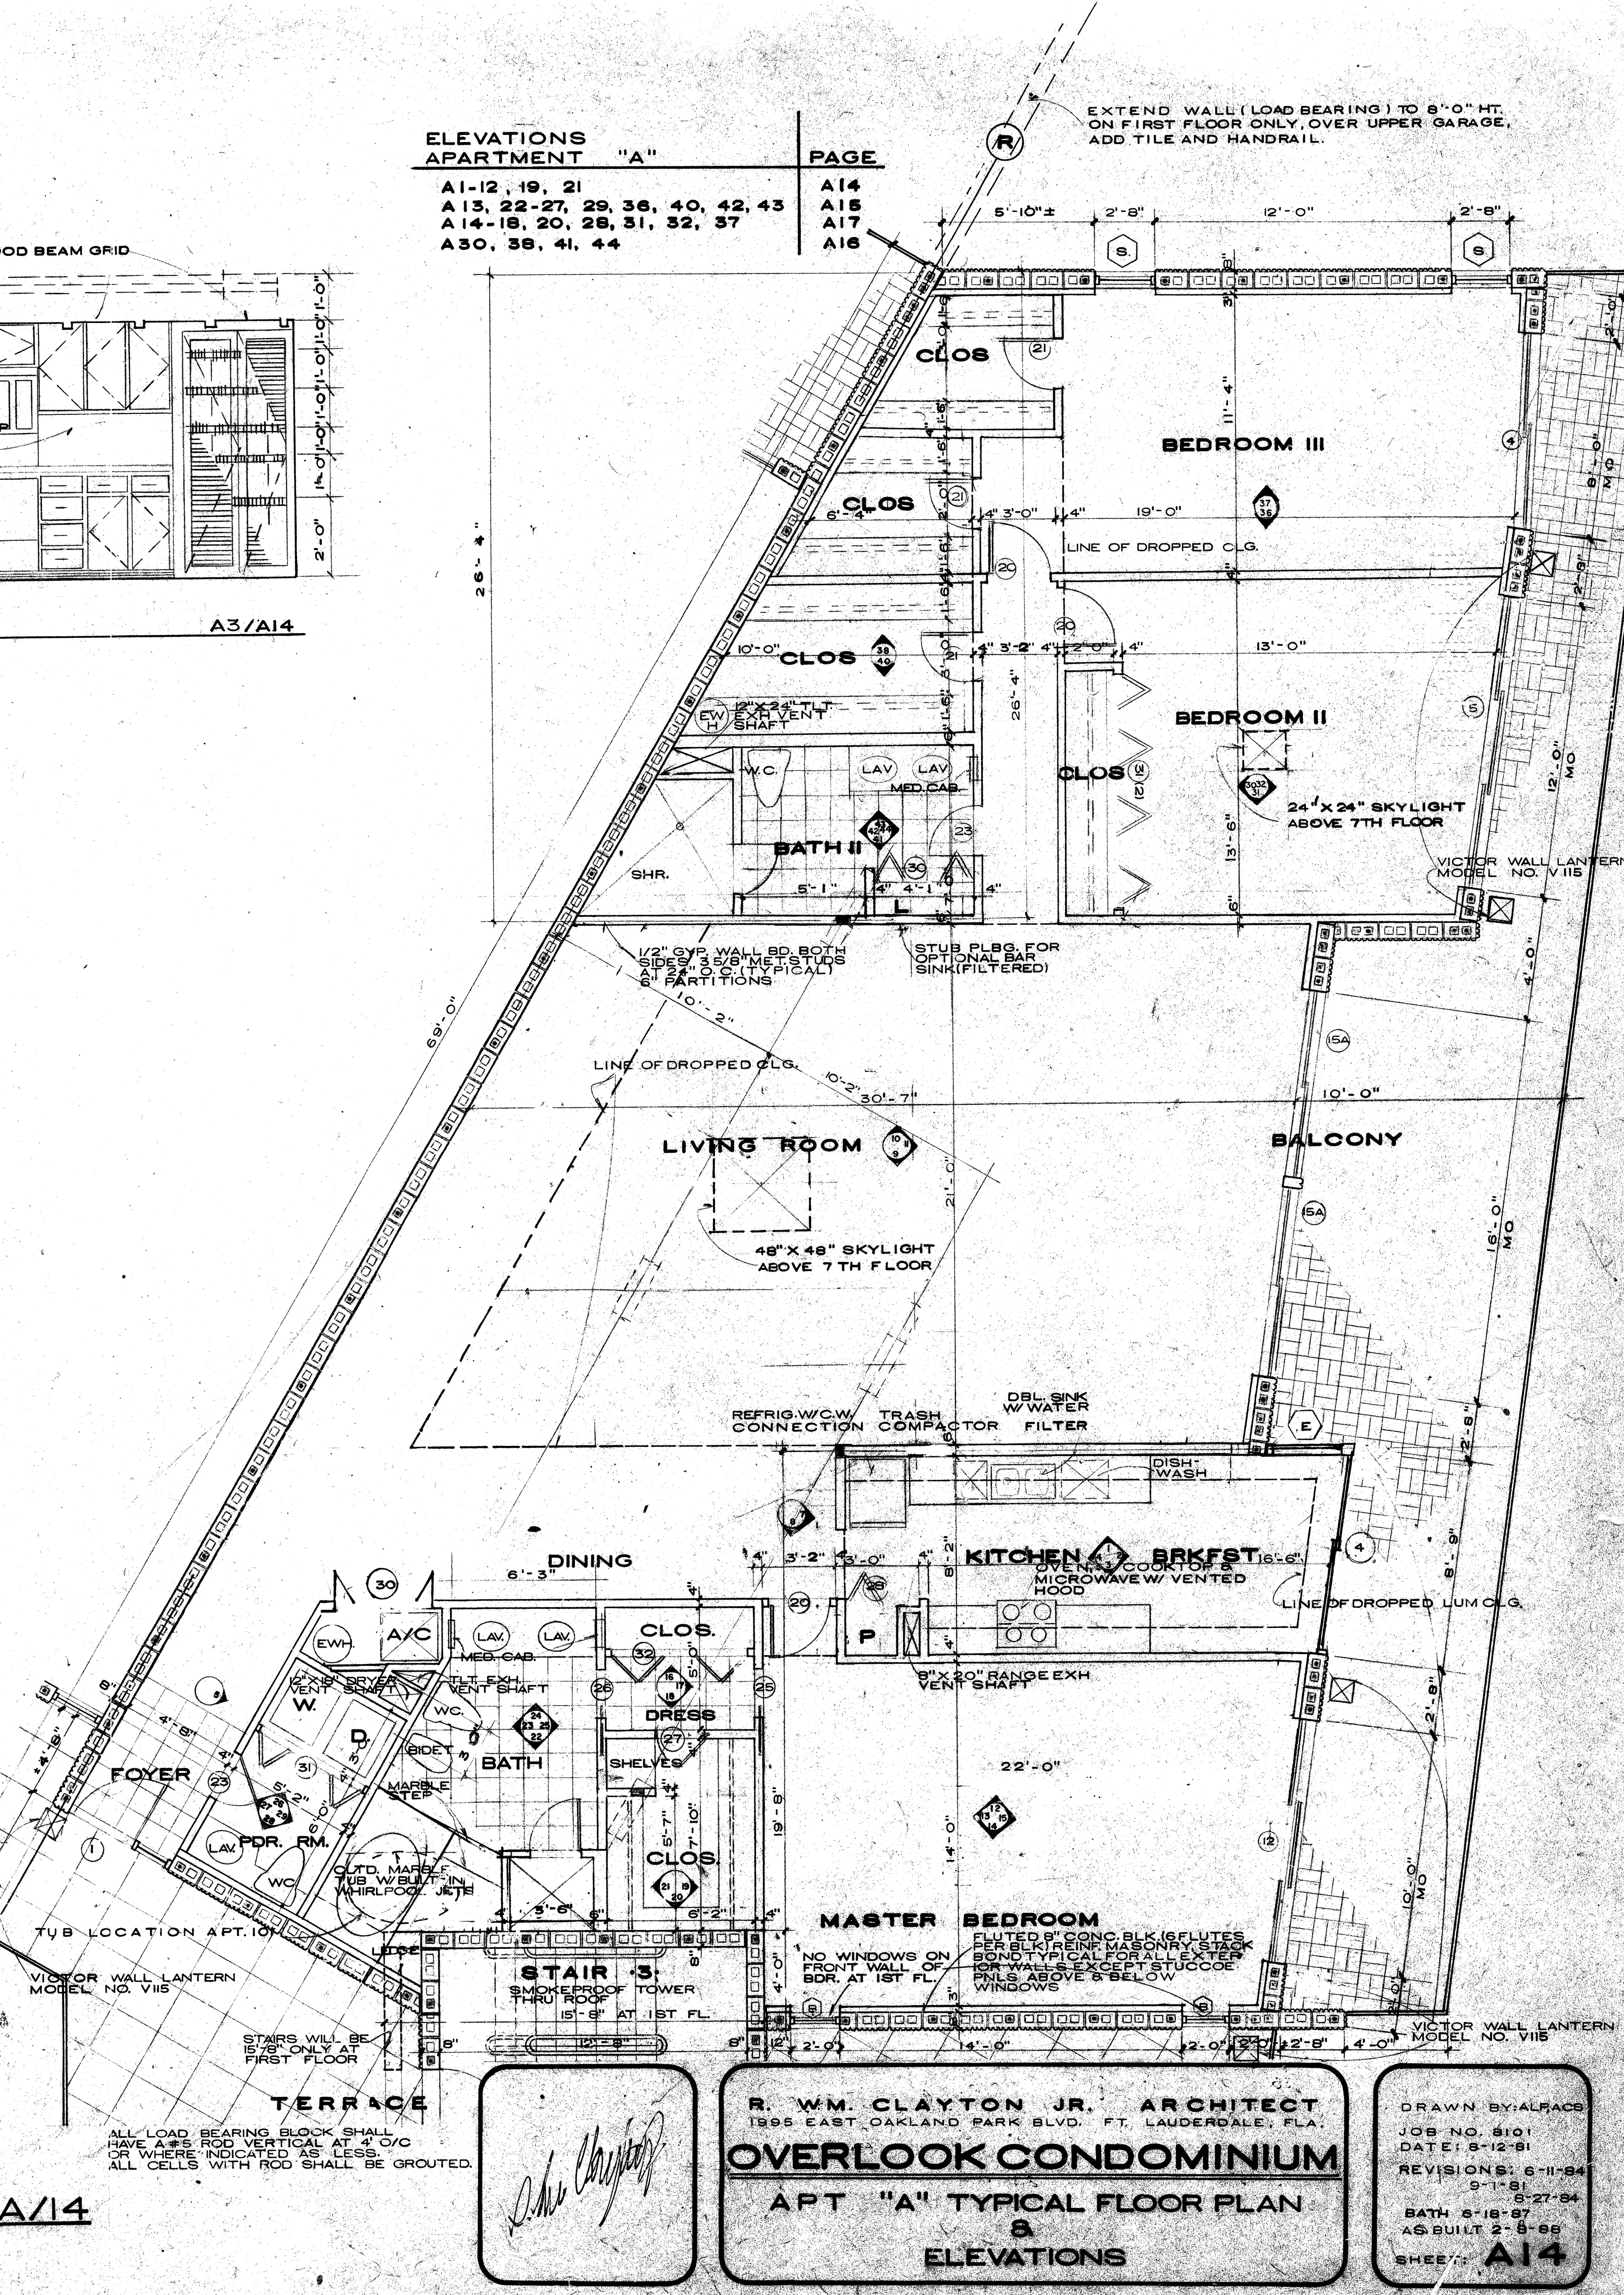

R. Wm. Clayton Jr.

R. WM. CLAYTON JR. ARCHITECT
1995 EAST OAKLAND PARK BLVD. FT. LAUDERDALE, FLA.
OVERLOOK CONDOMINIUM
APT "A" TYPICAL FLOOR PLAN
ELEVATIONS

DRAWN BY: ALFACB
JOB NO. 8101
DATE: 8-12-81
REVISIONS: 6-11-84
9-11-81
6-27-84
BATH 8-18-87
AS BUILT 2-8-88
SHEET: A14