

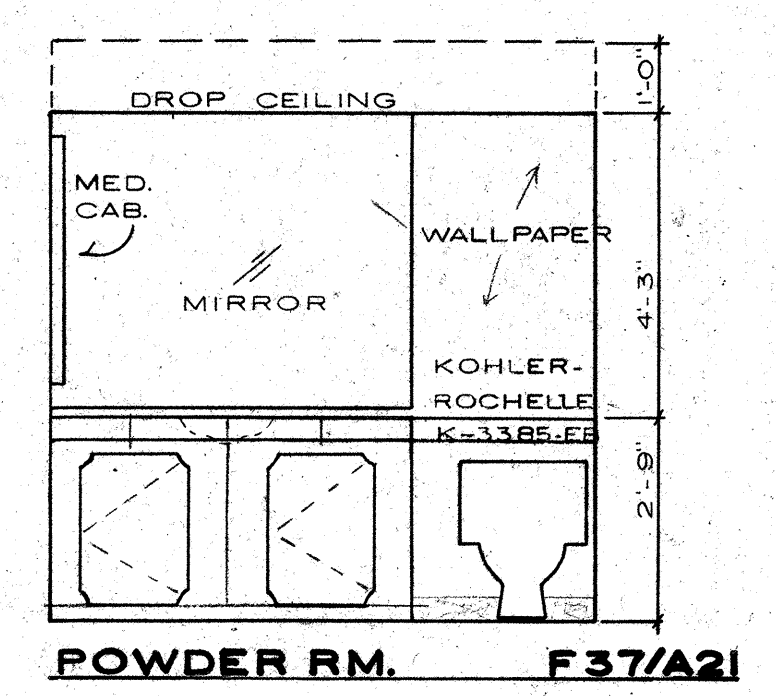
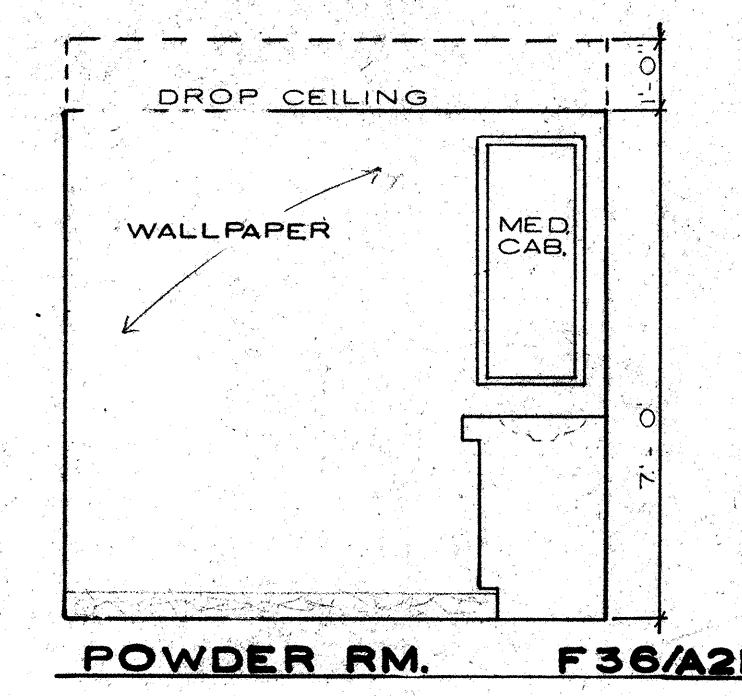
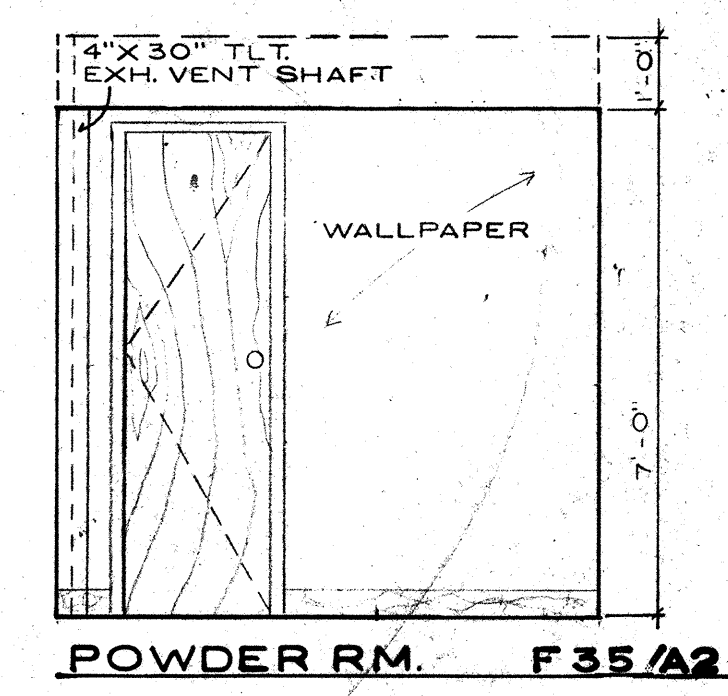
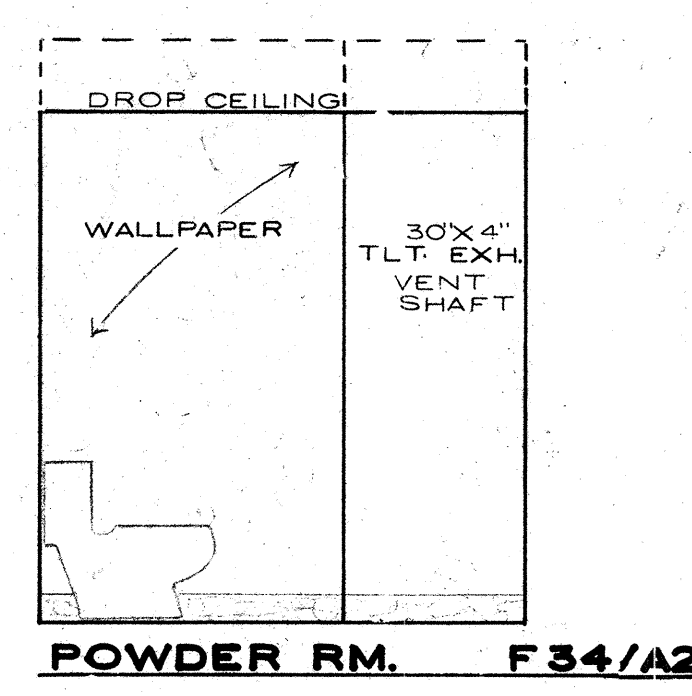
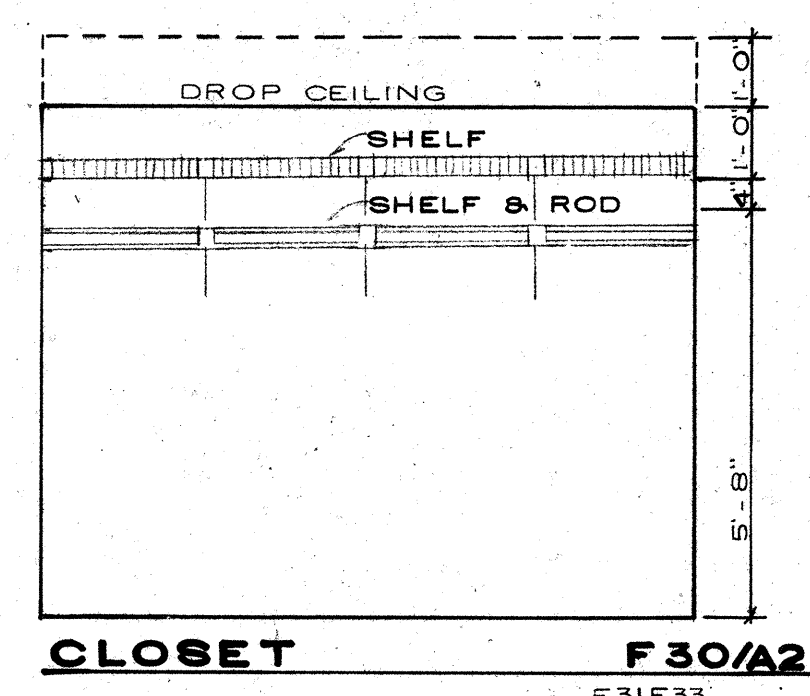
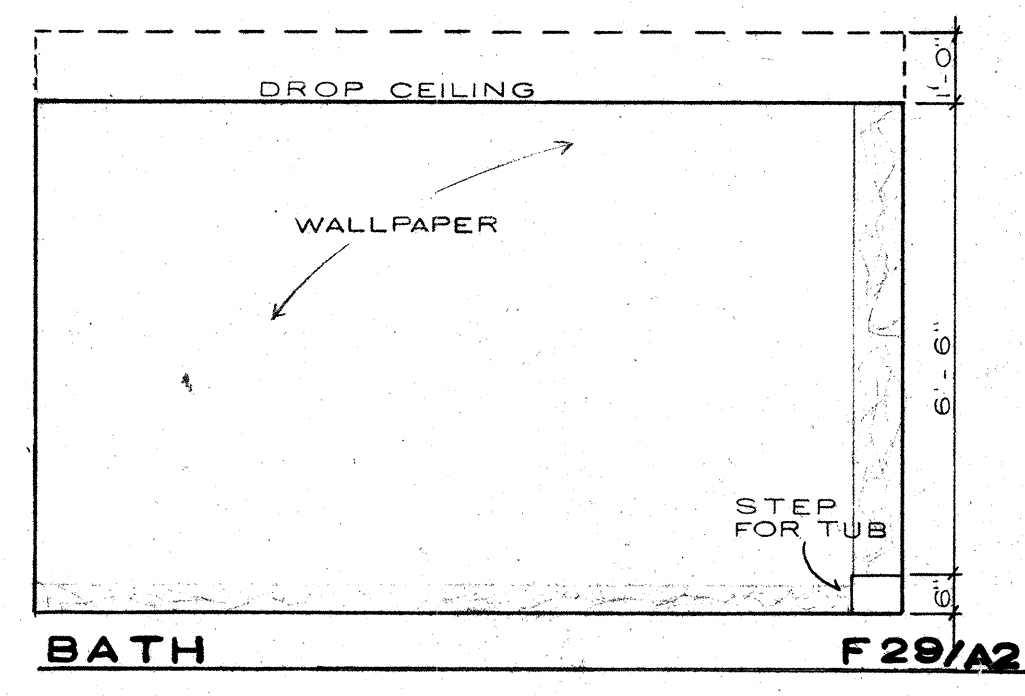
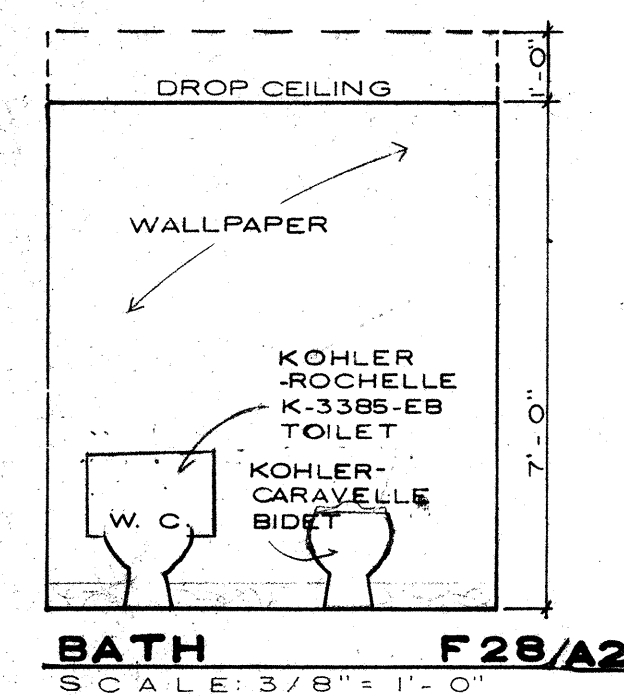
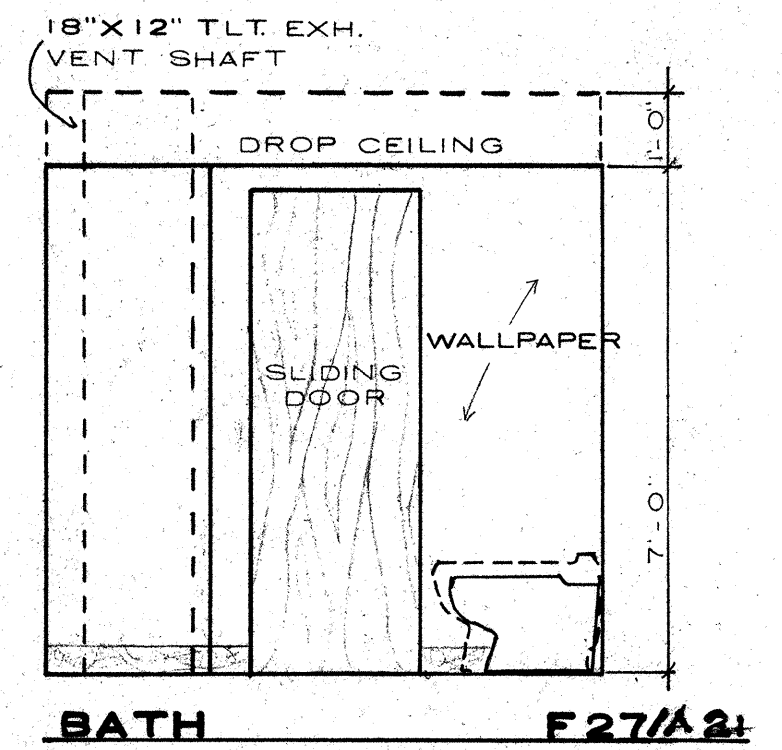
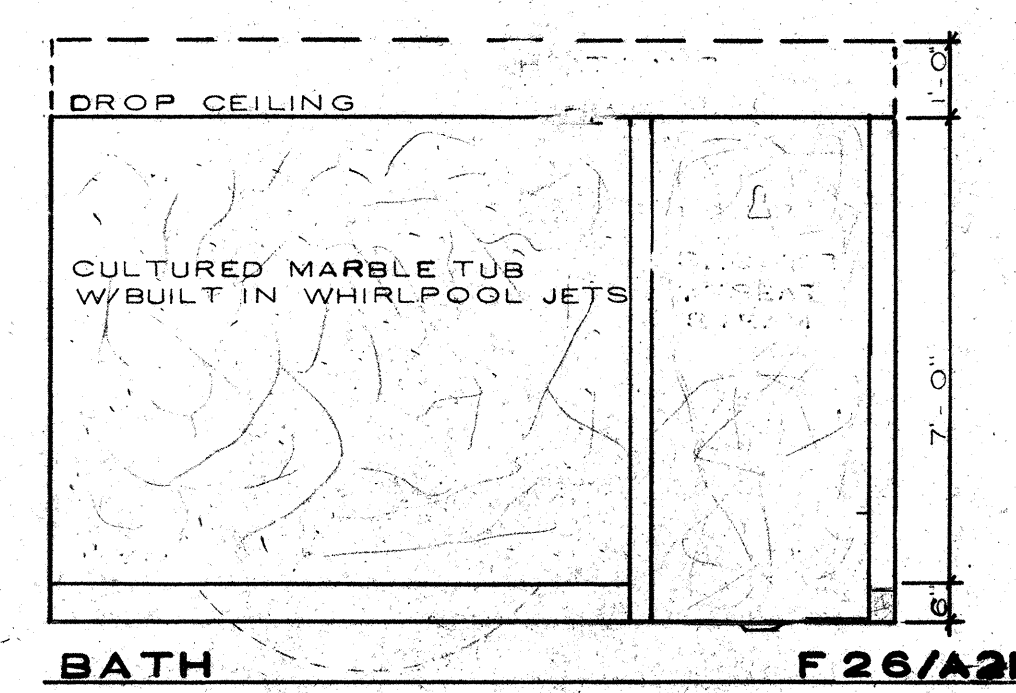
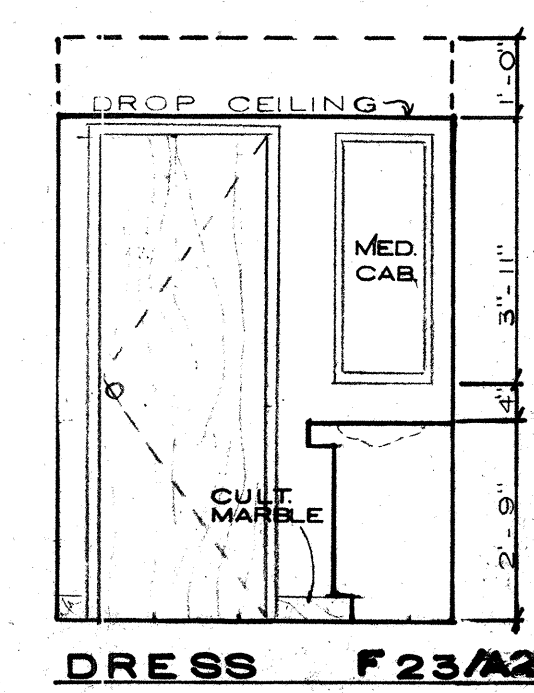
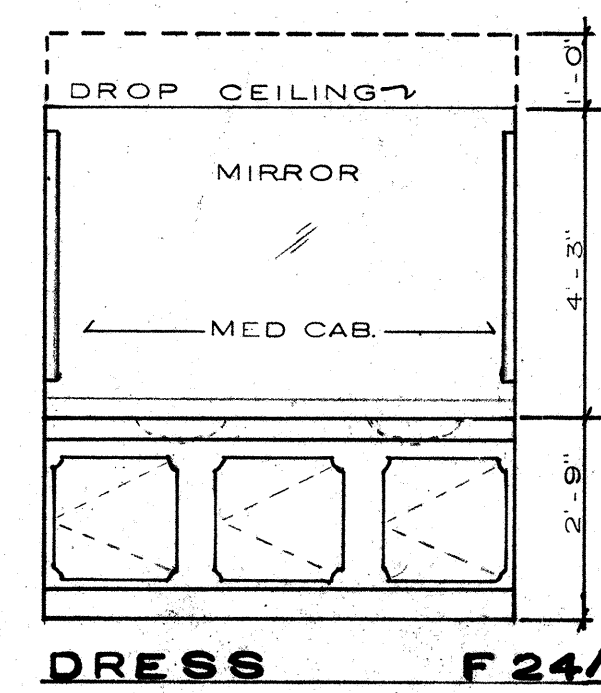
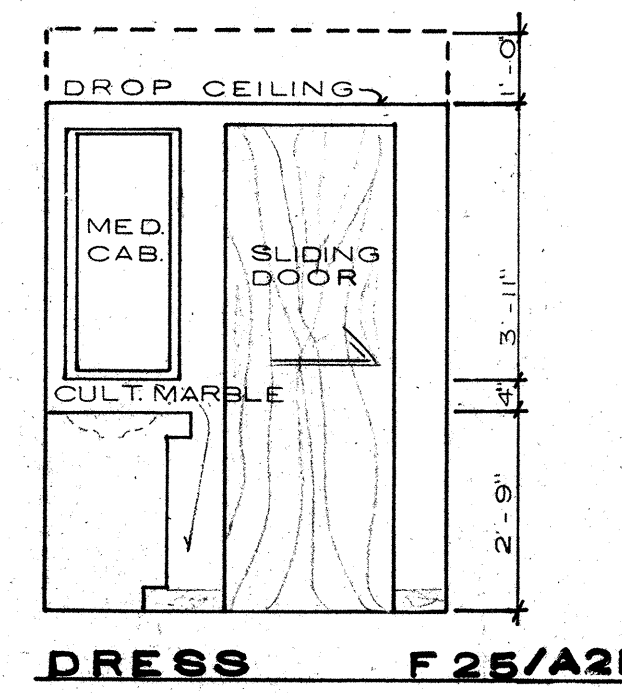
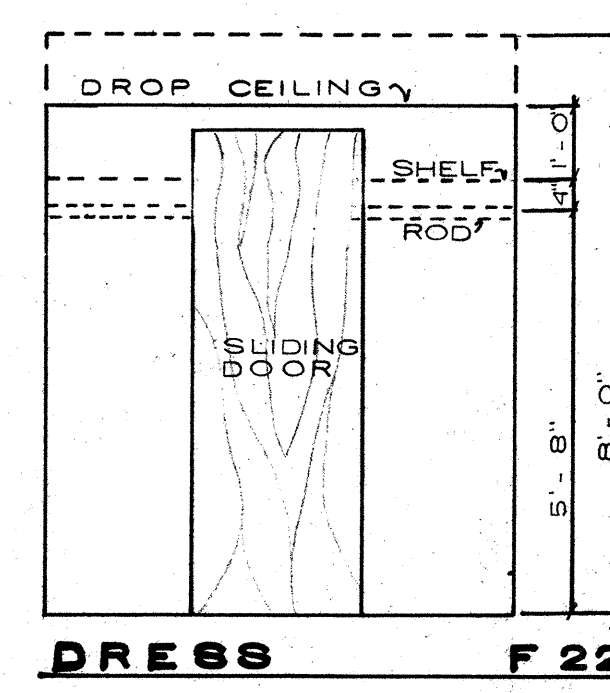
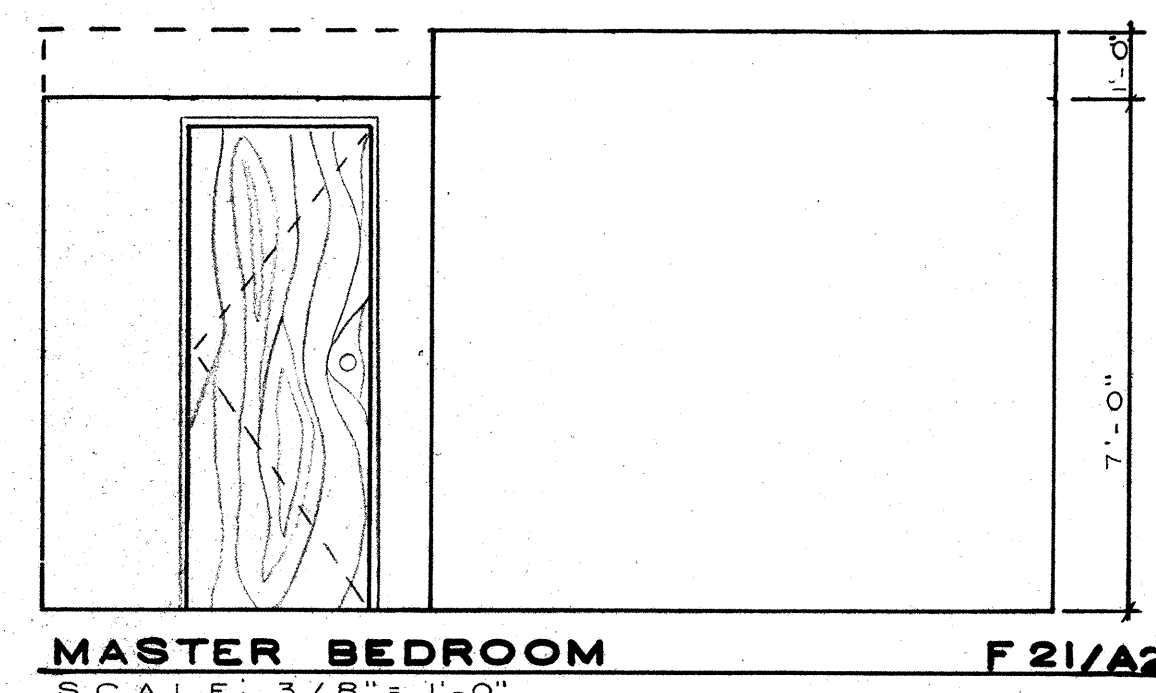
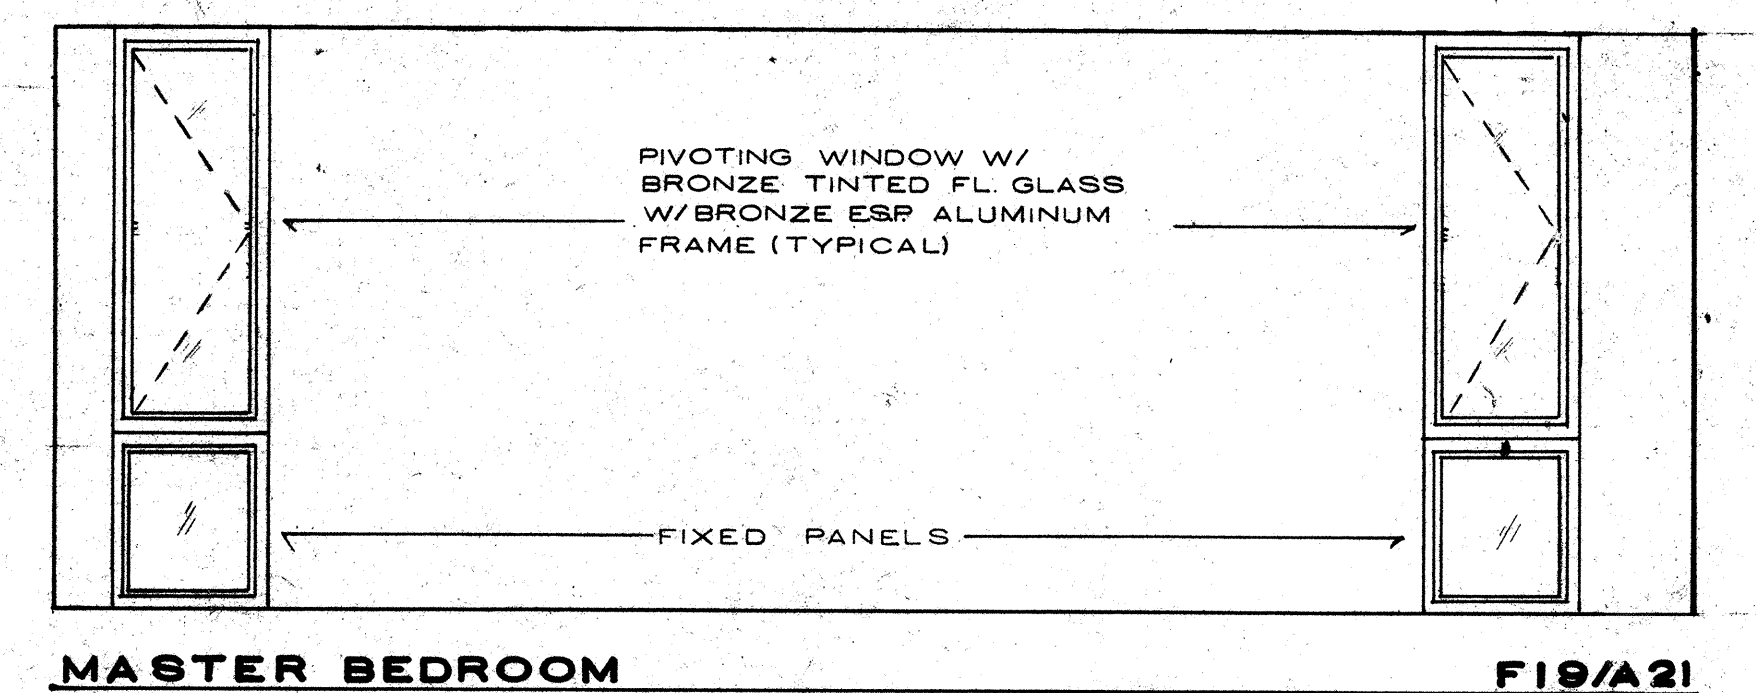
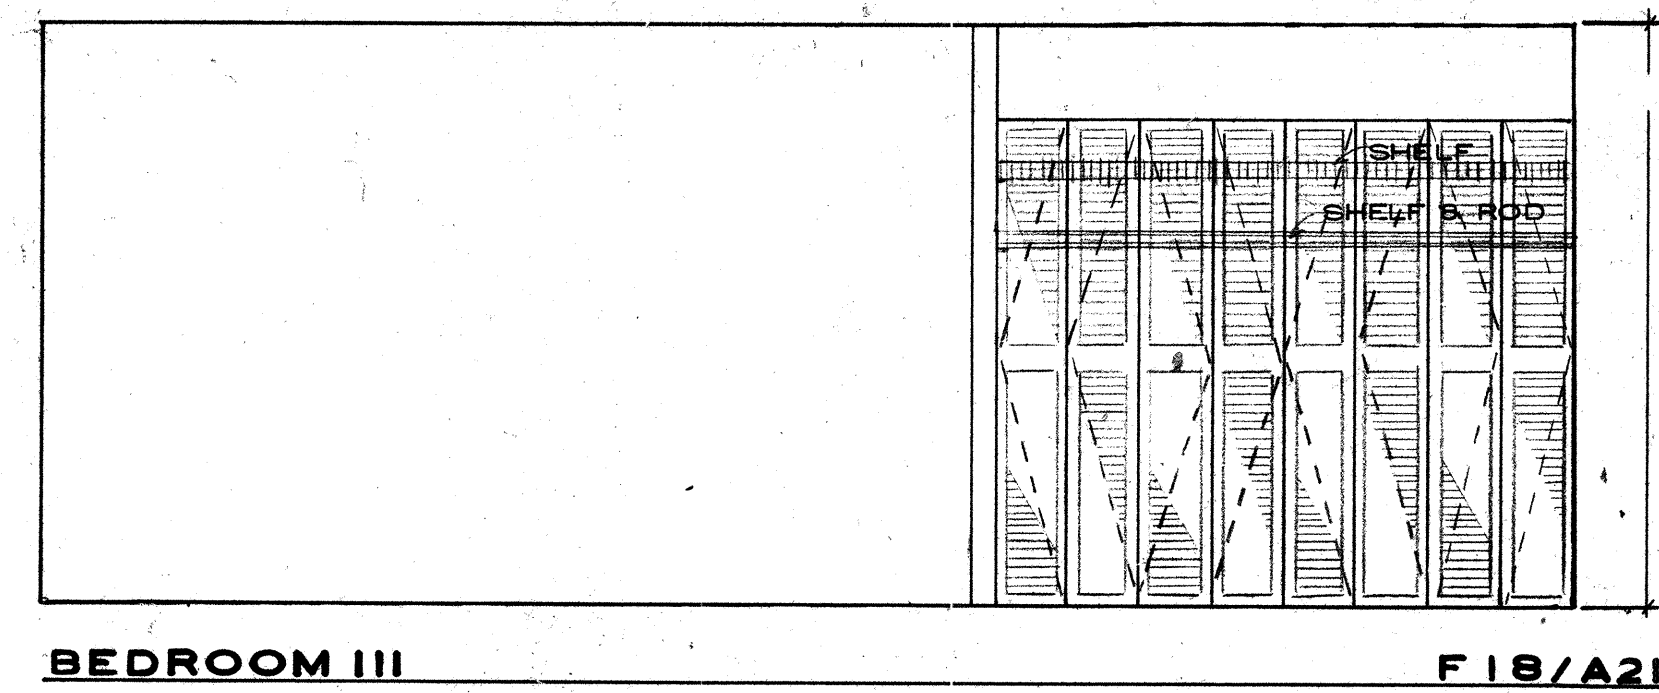
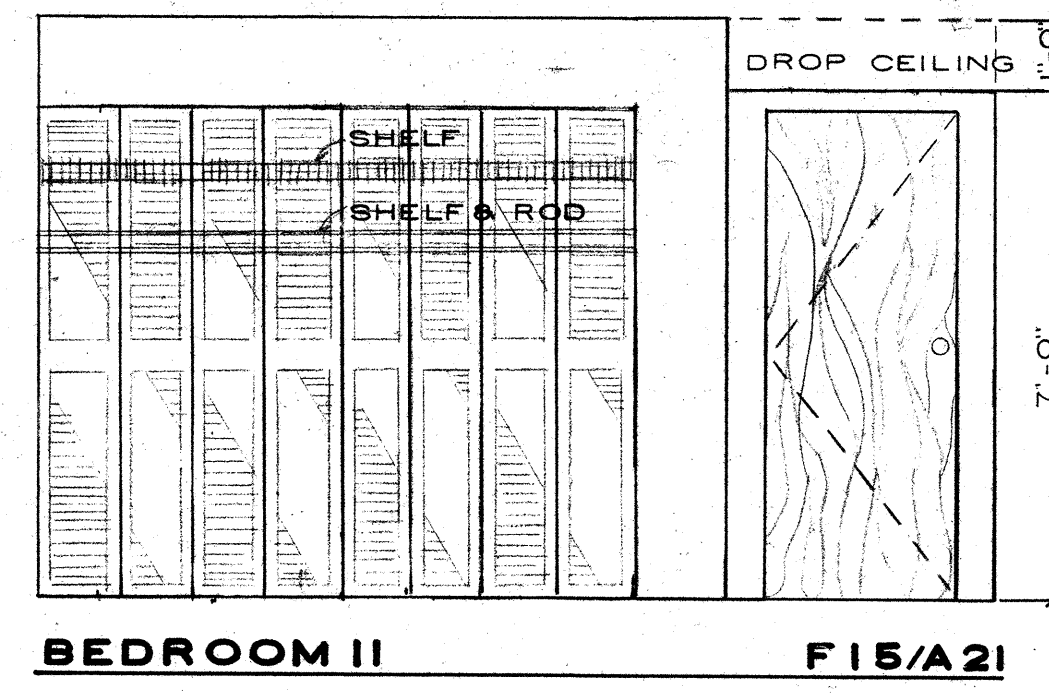
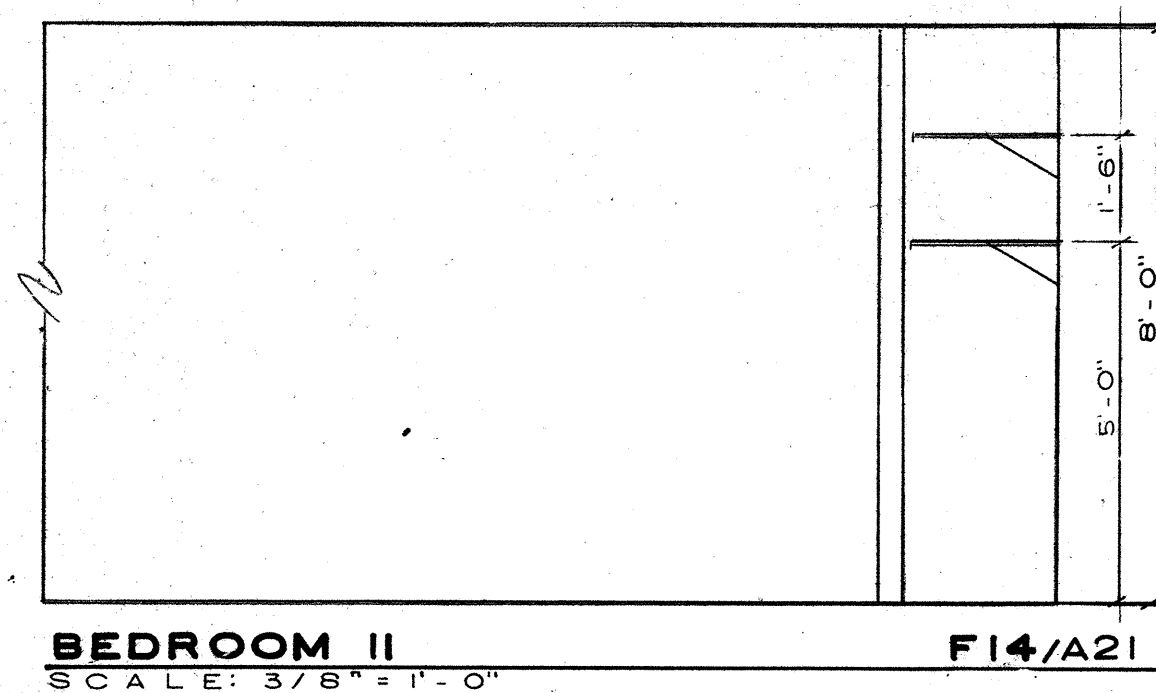
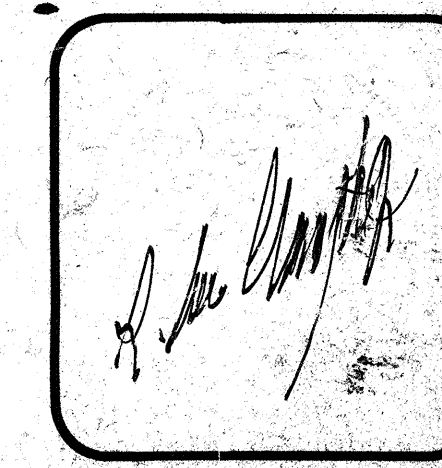
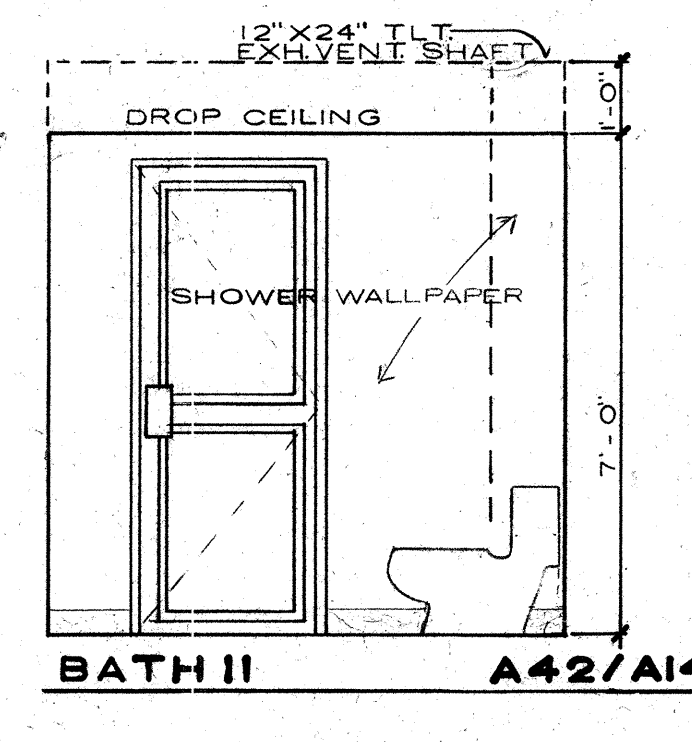
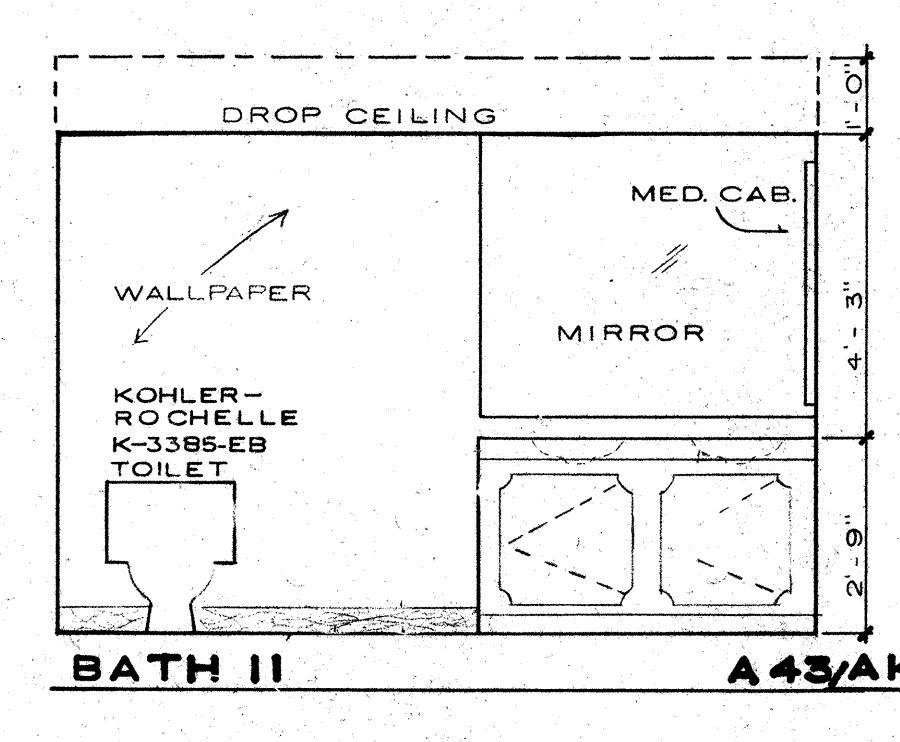
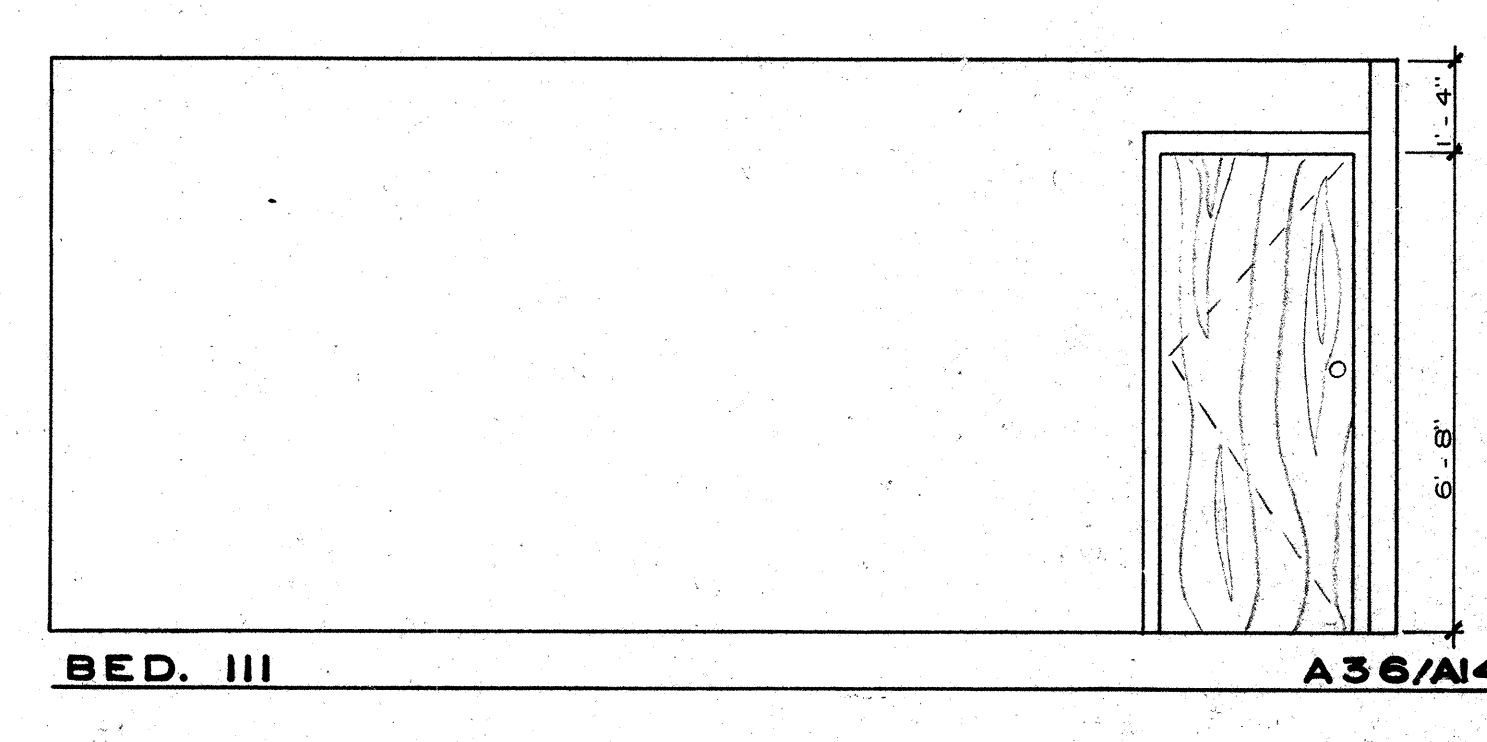
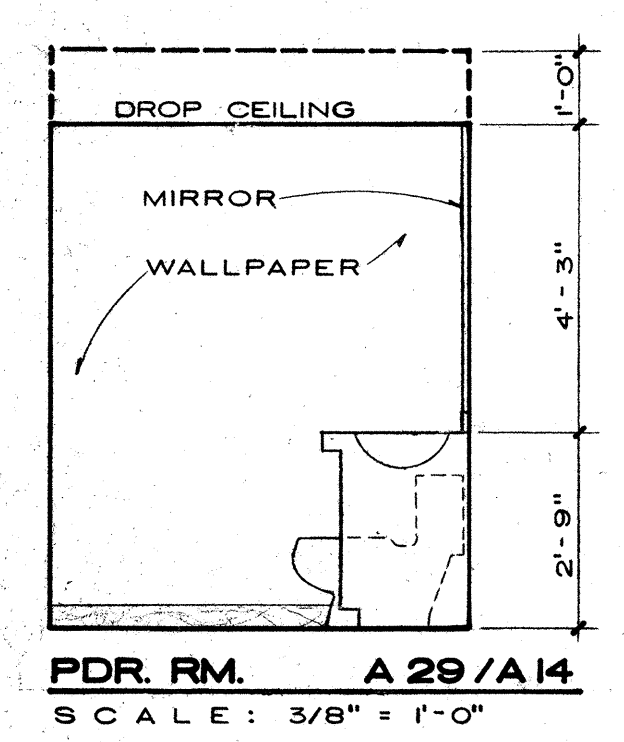
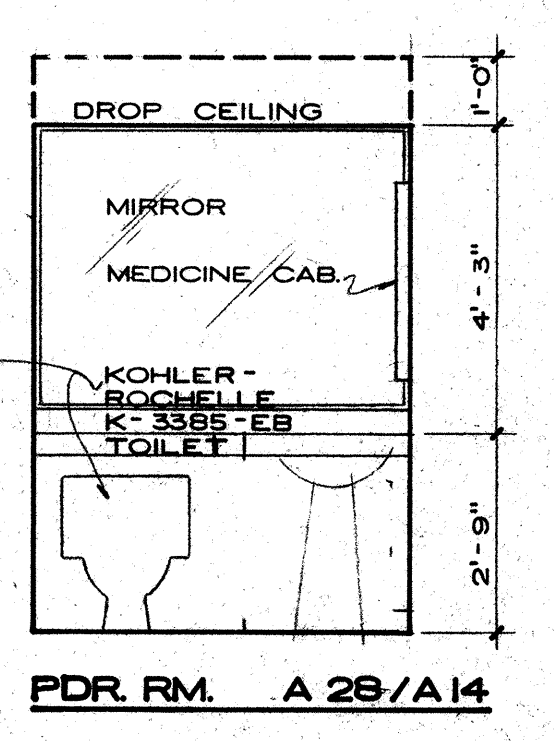
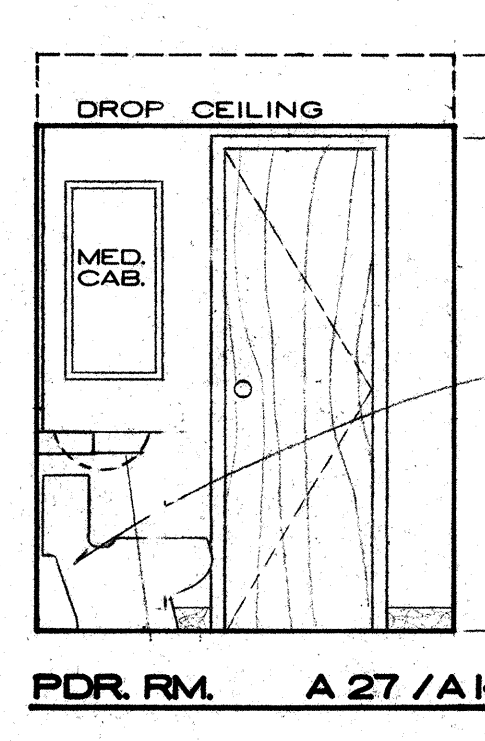
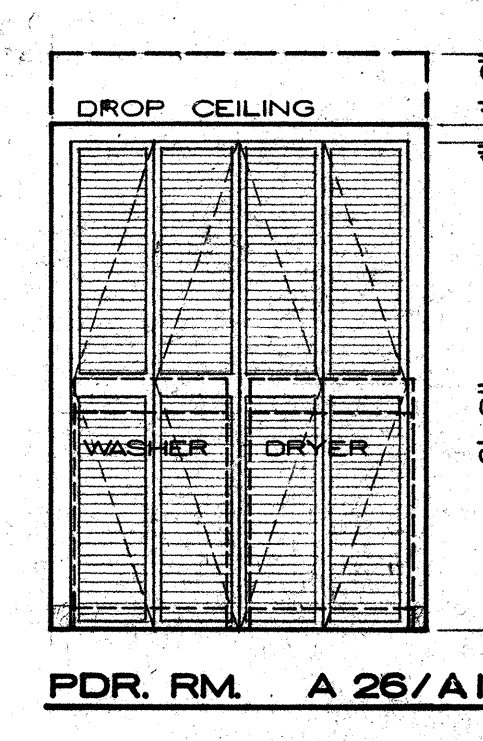
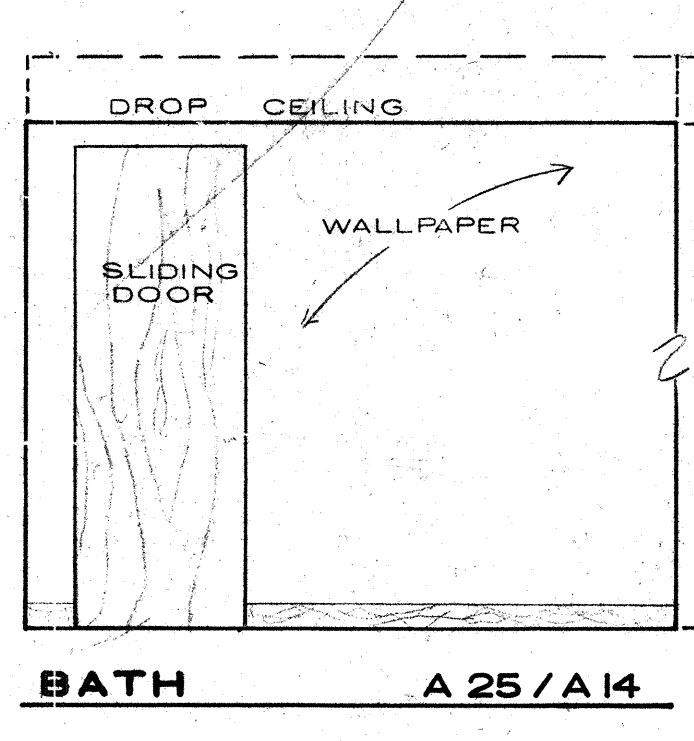
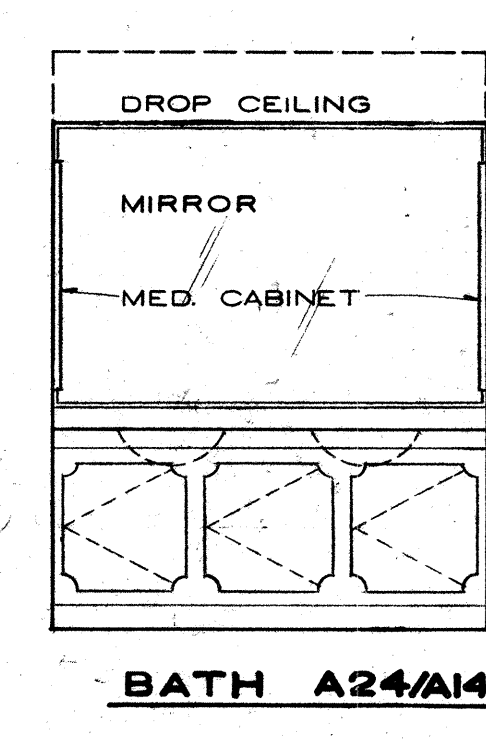
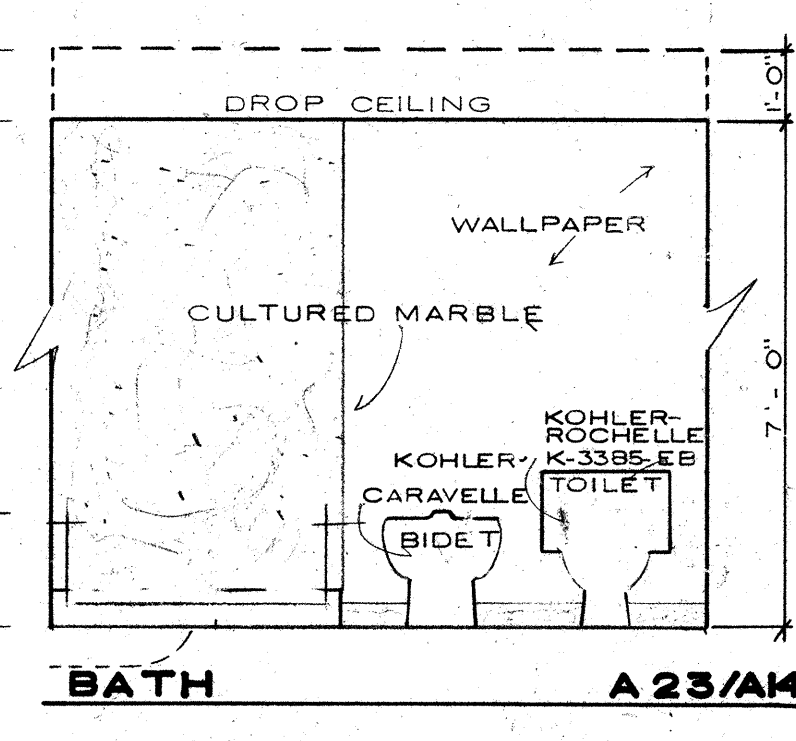


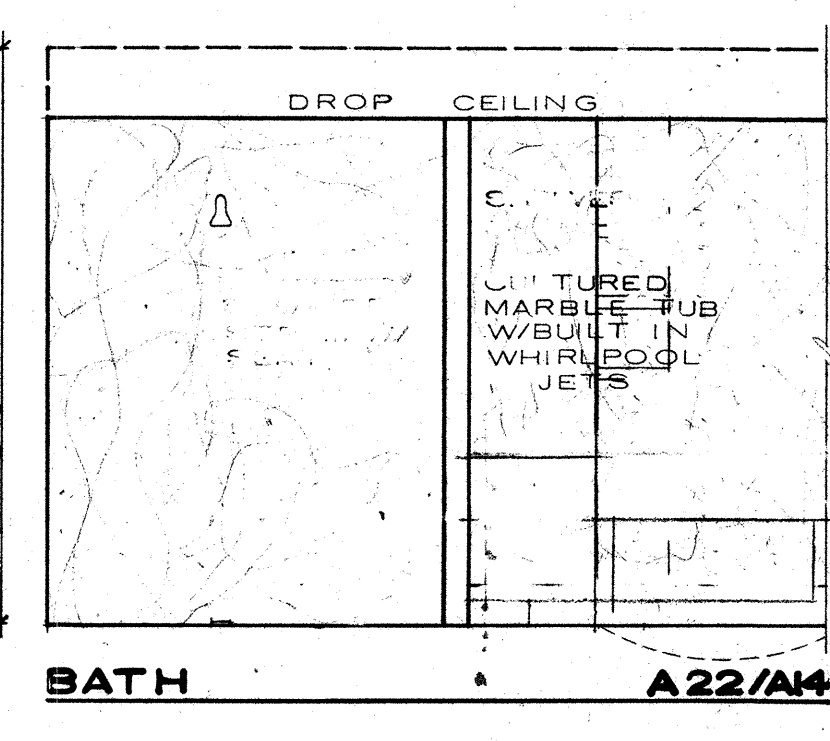

ELEVATIONS "A"

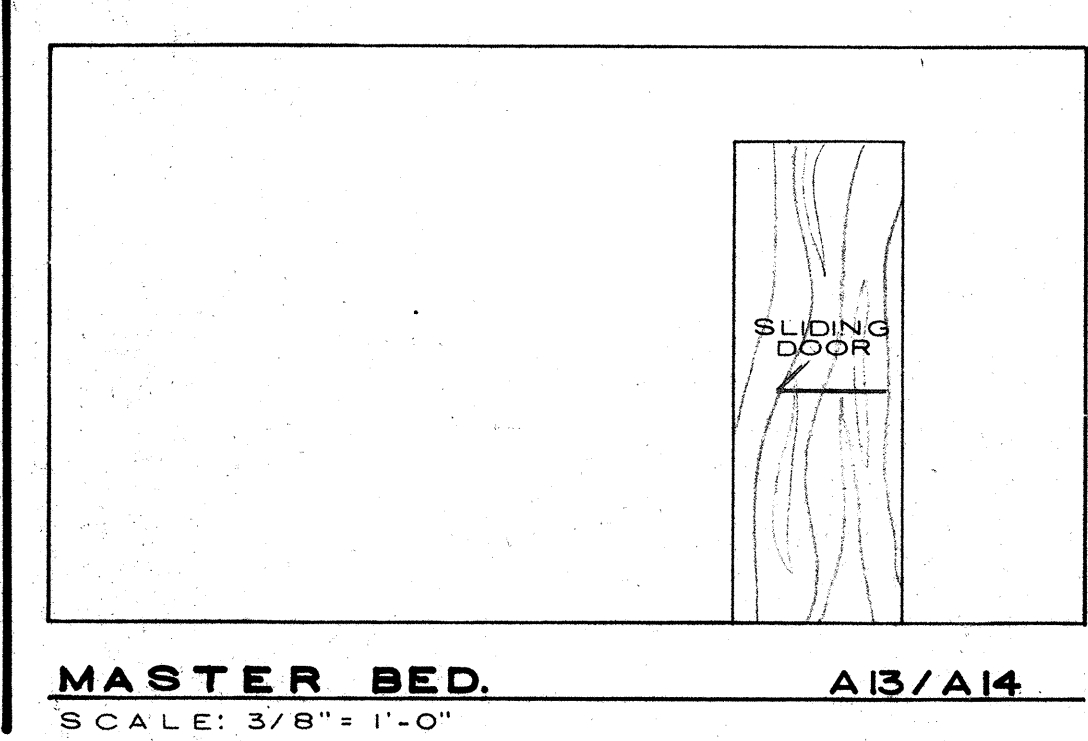

R. WM. CLAYTON JR. ARCHITECT
1995 EAST OAKLAND PARK BLVD. FT. LAUDERDALE, FLA.

OVERLOOK CONDOMINIUM
INTERIOR ELEVATIONS
APTS. "A" & "F"

DRAWN BY: WPS
JOB NO. 8101
DATE: 8-10-81
REVISIONS: 8-11-84
AS BUILT 2-8-88
SHEET: **A15**