

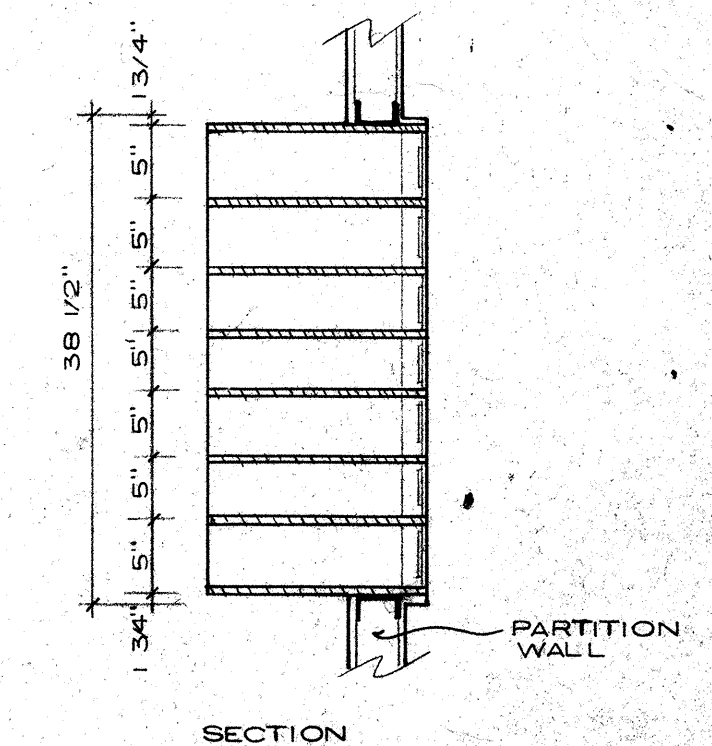
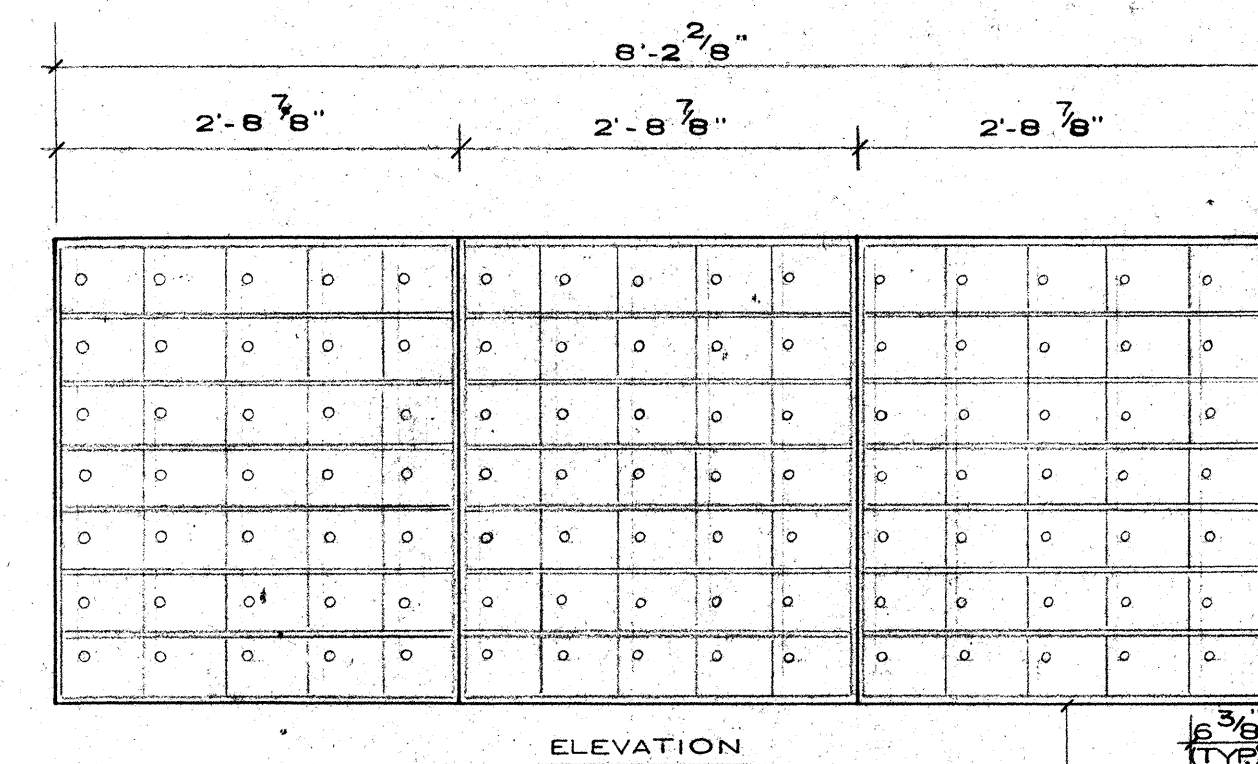
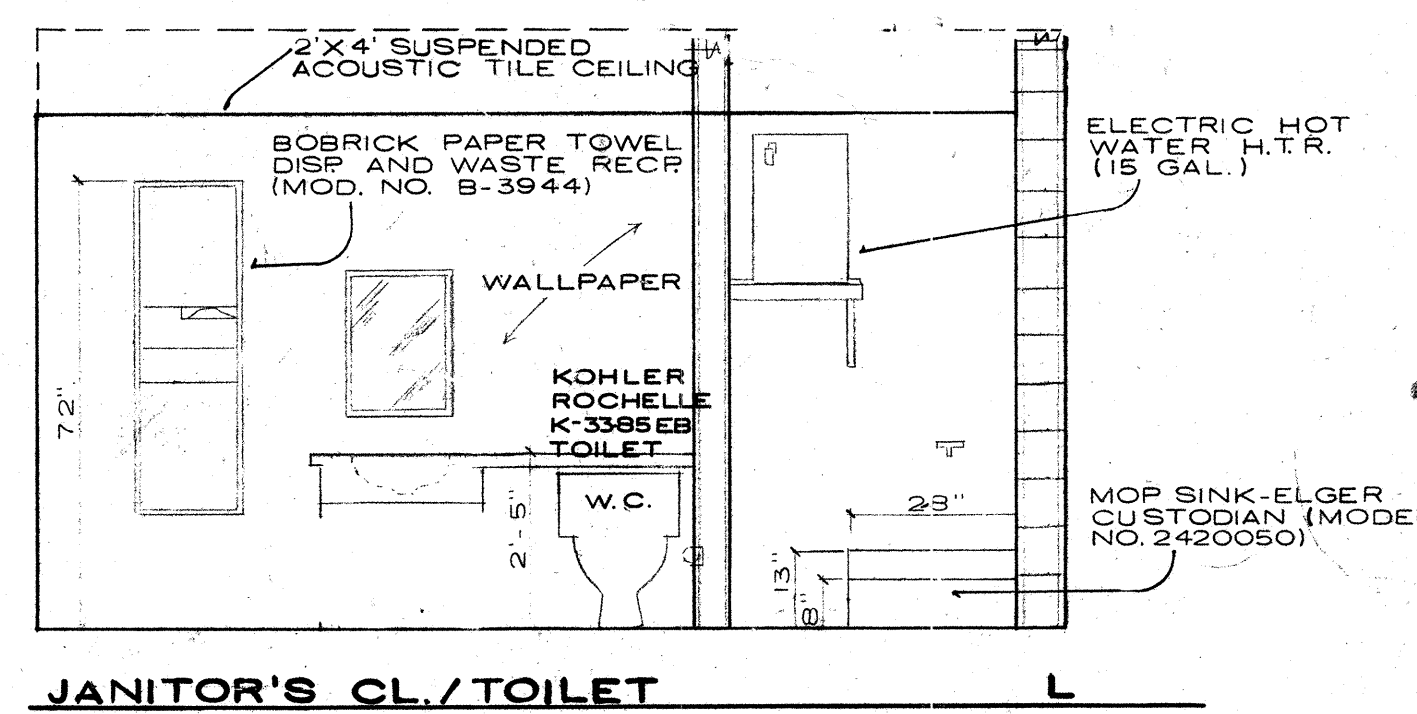
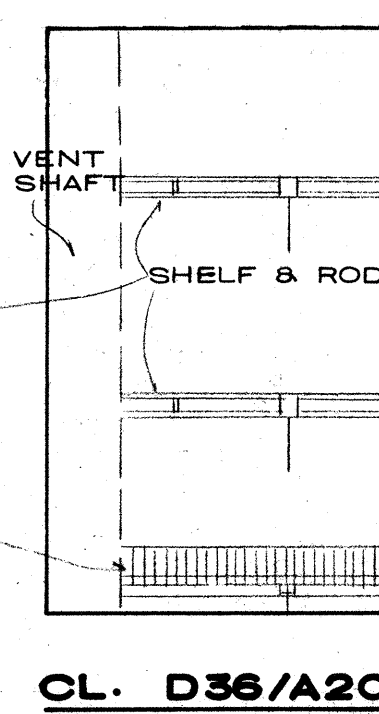
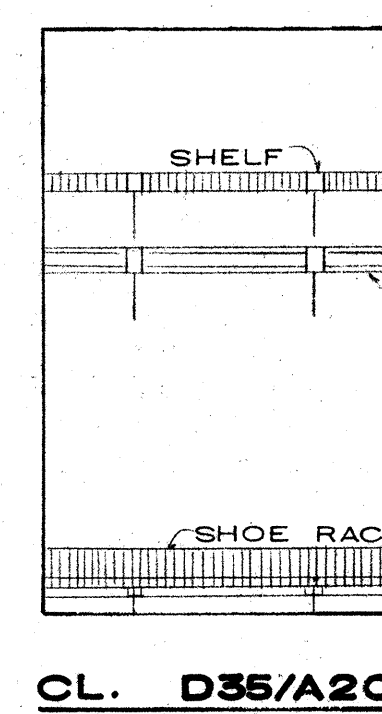
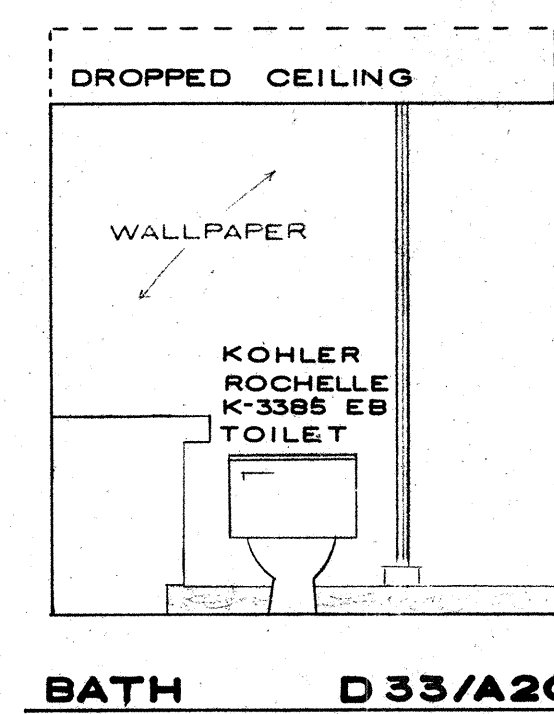
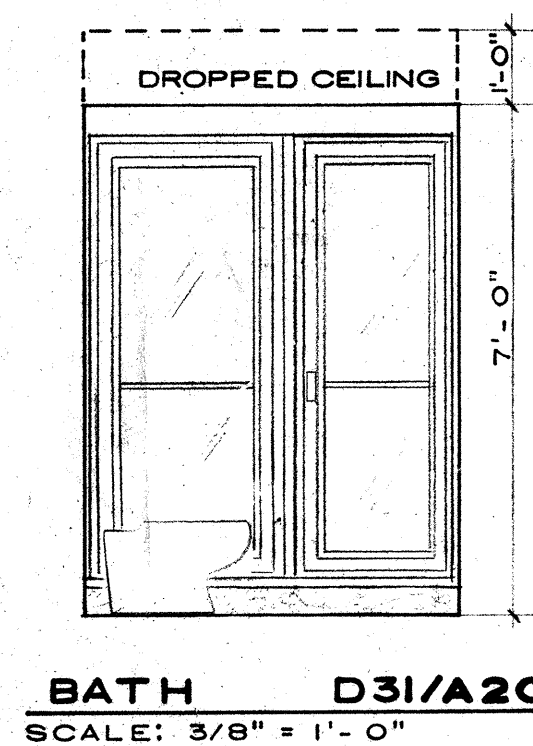
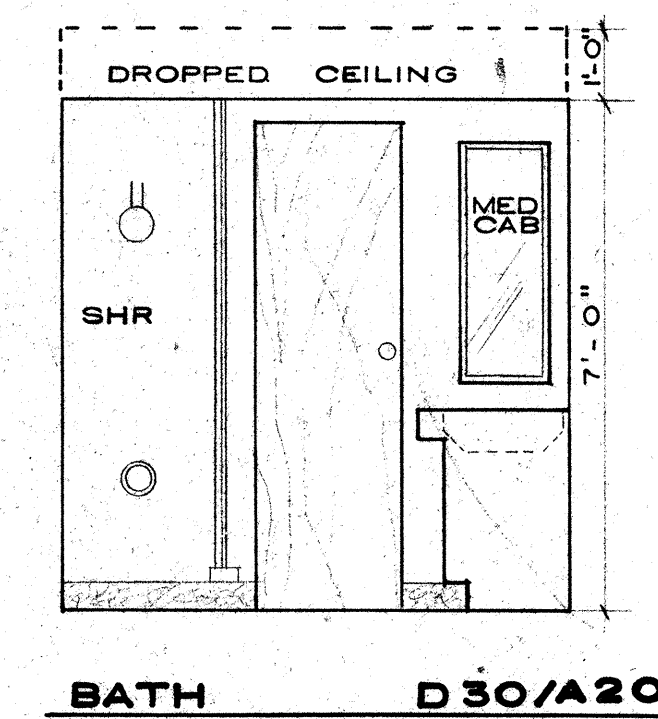
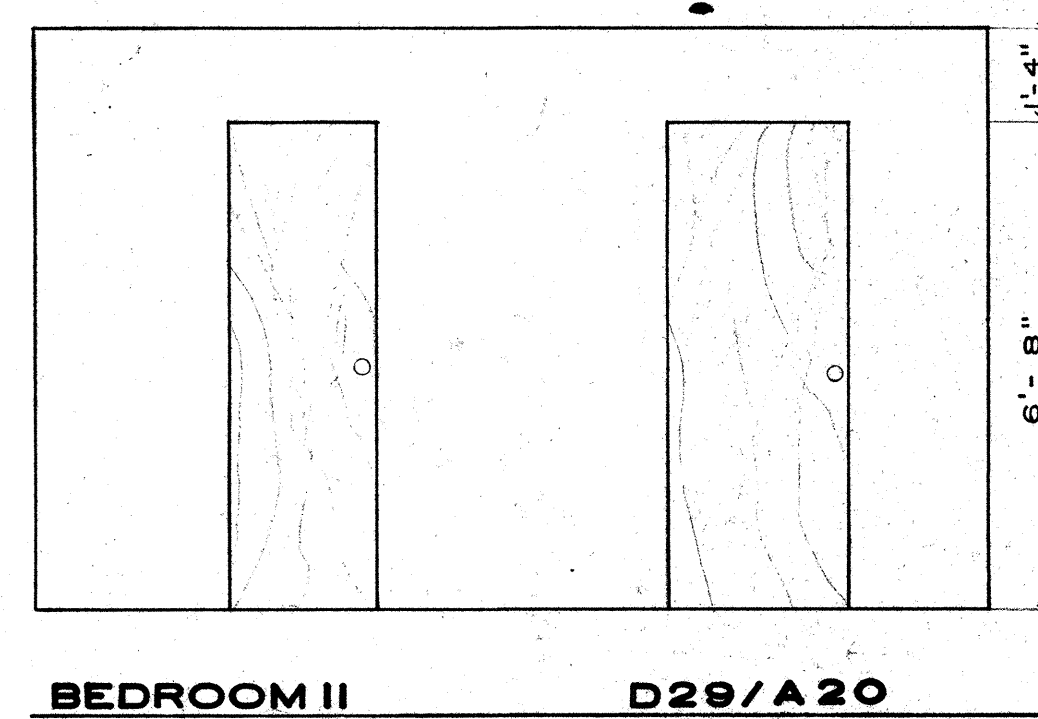
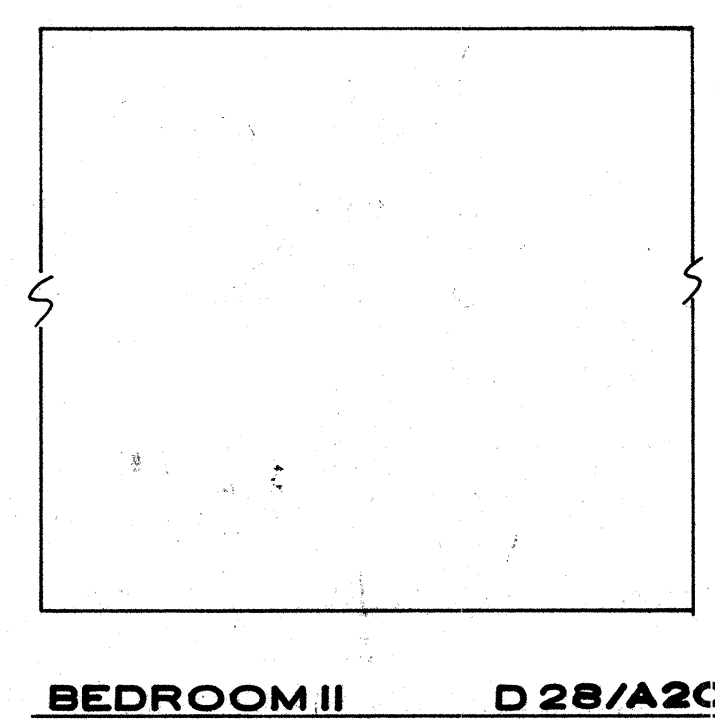
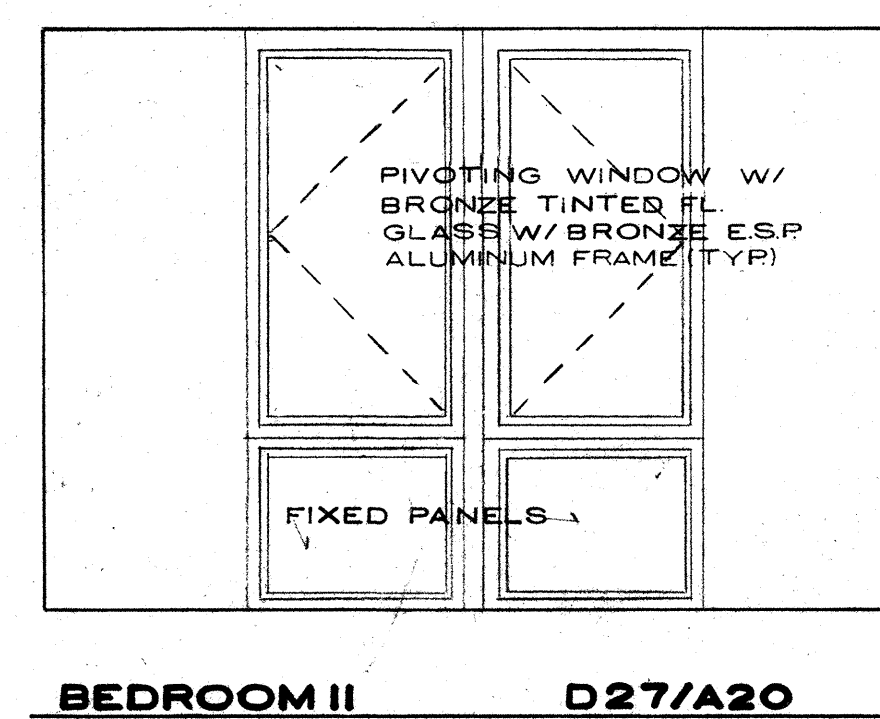
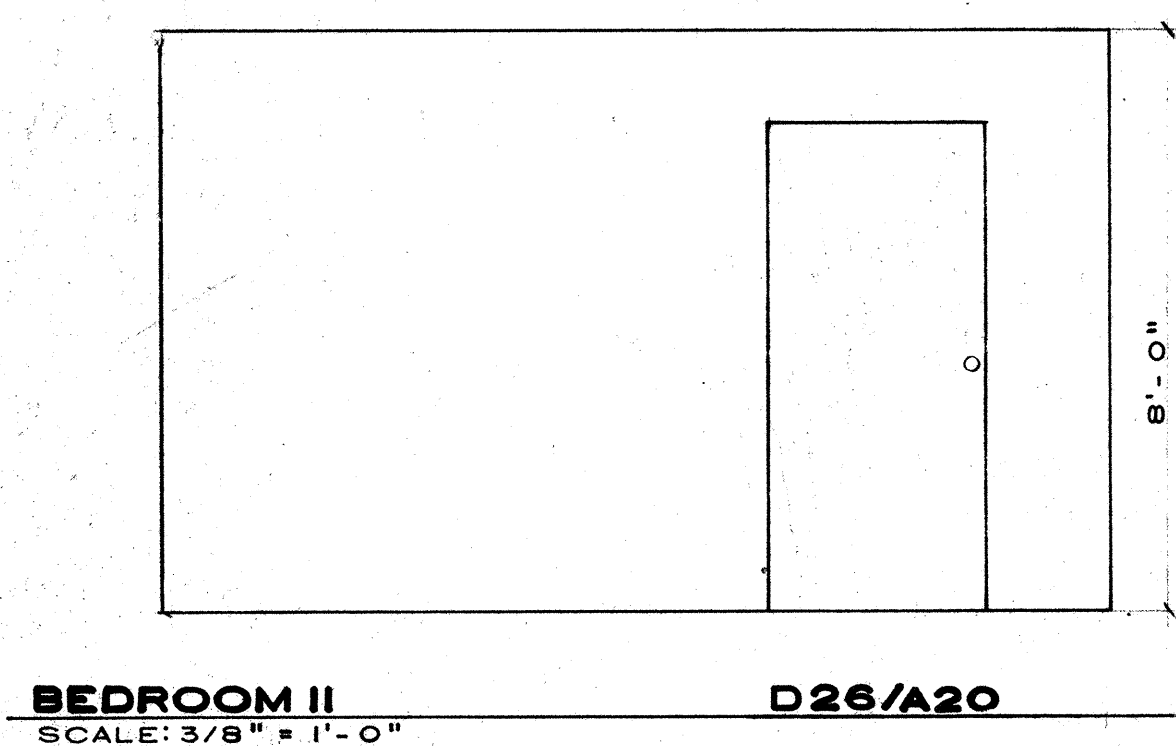
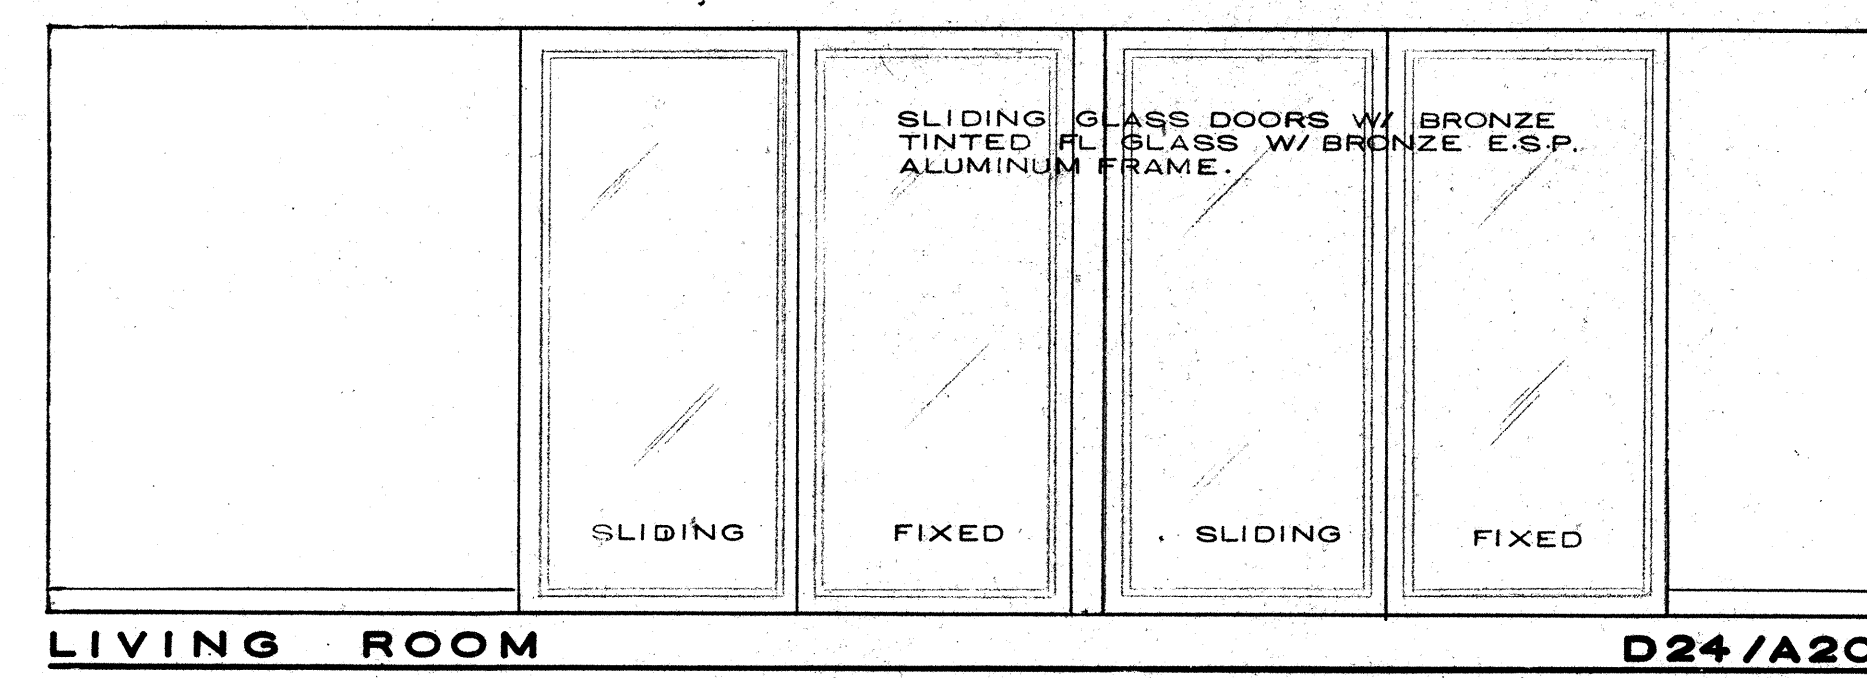
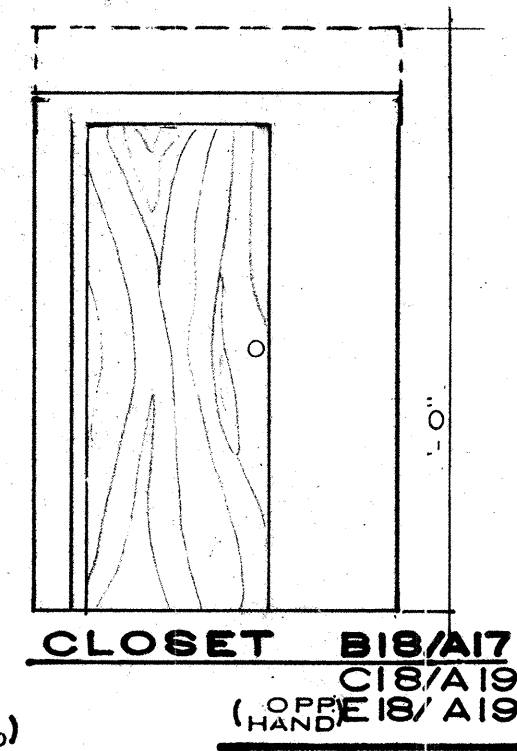
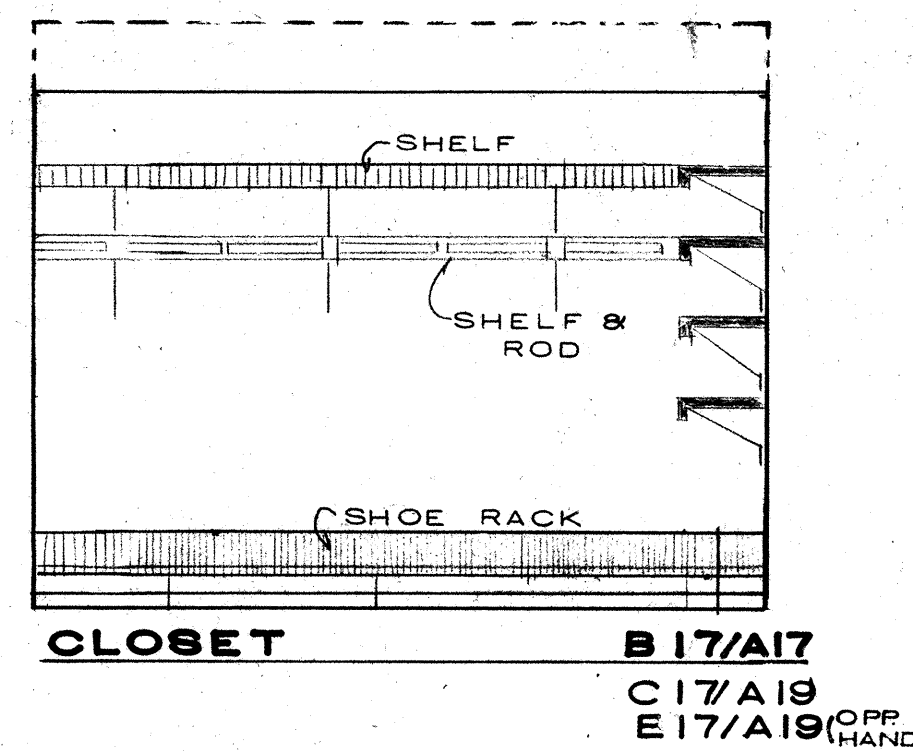
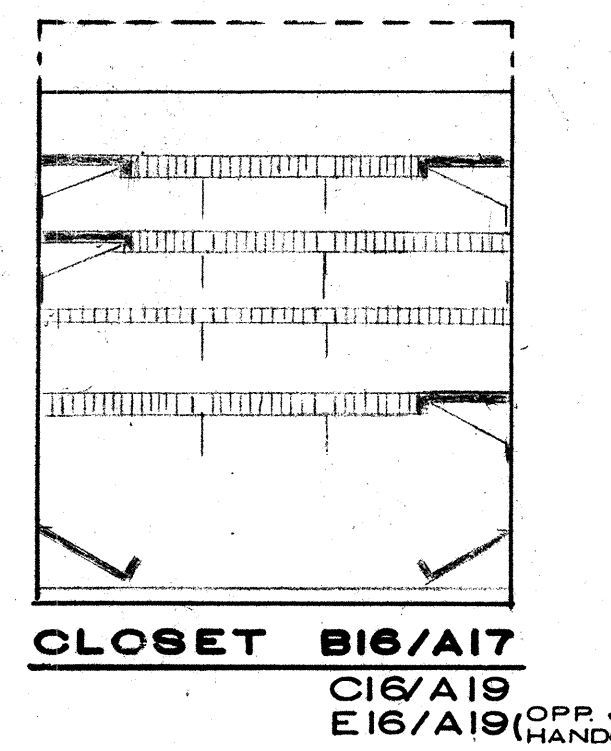
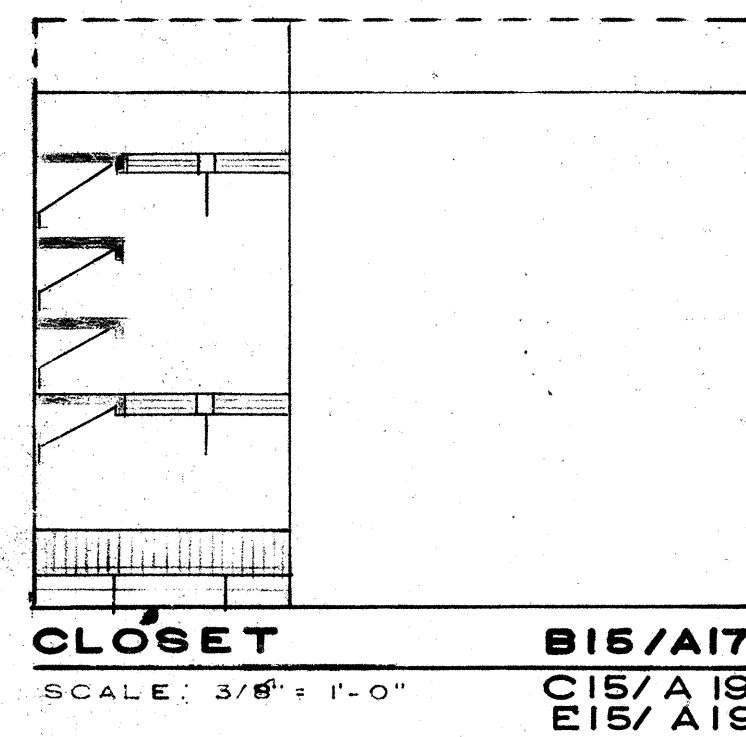
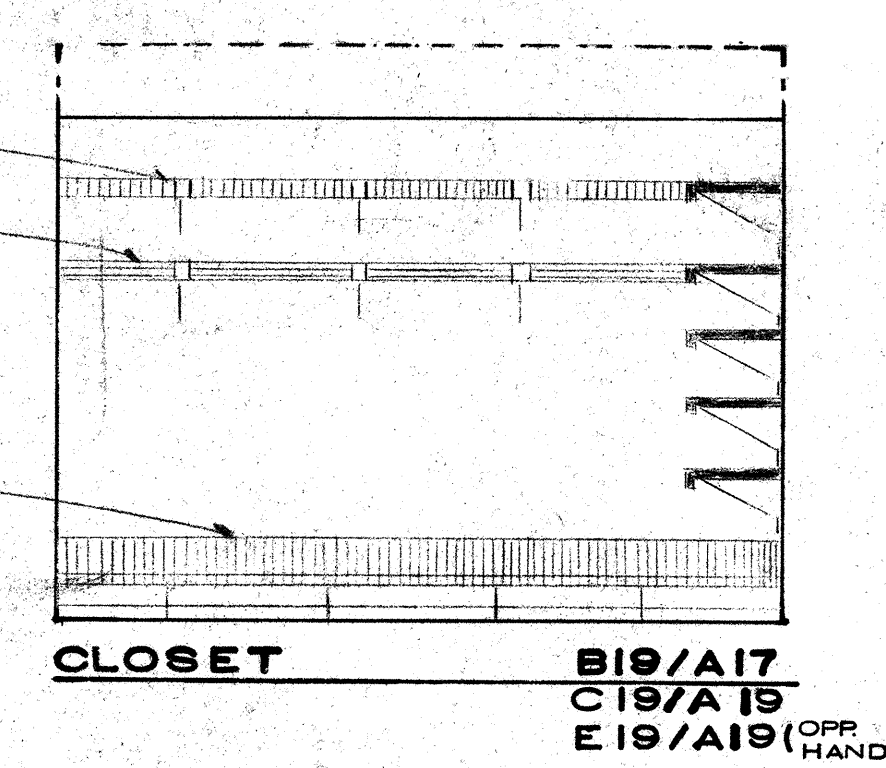
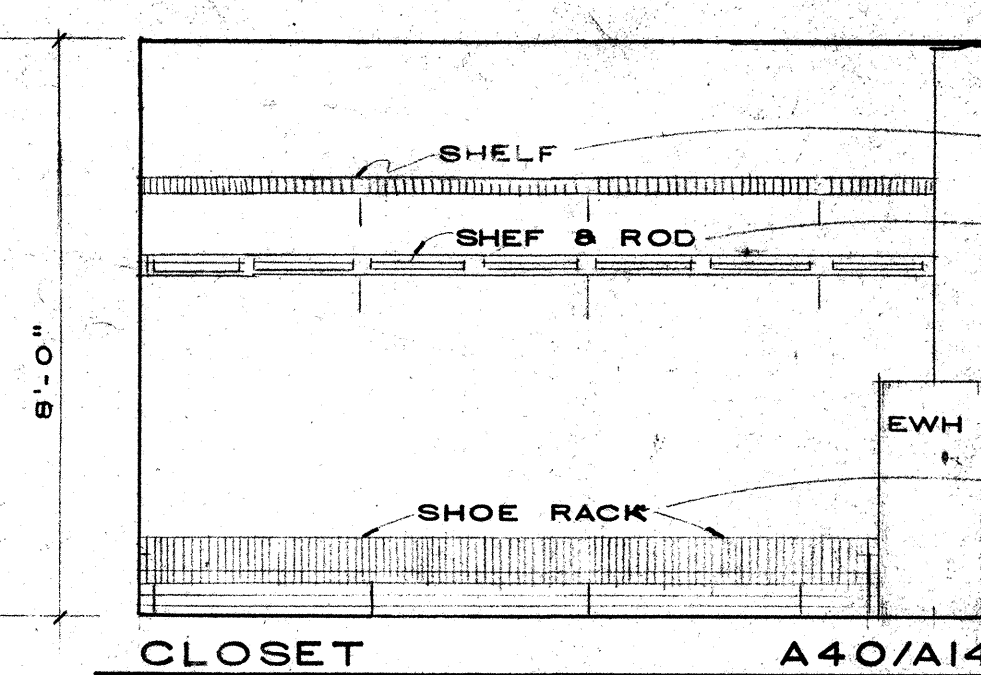
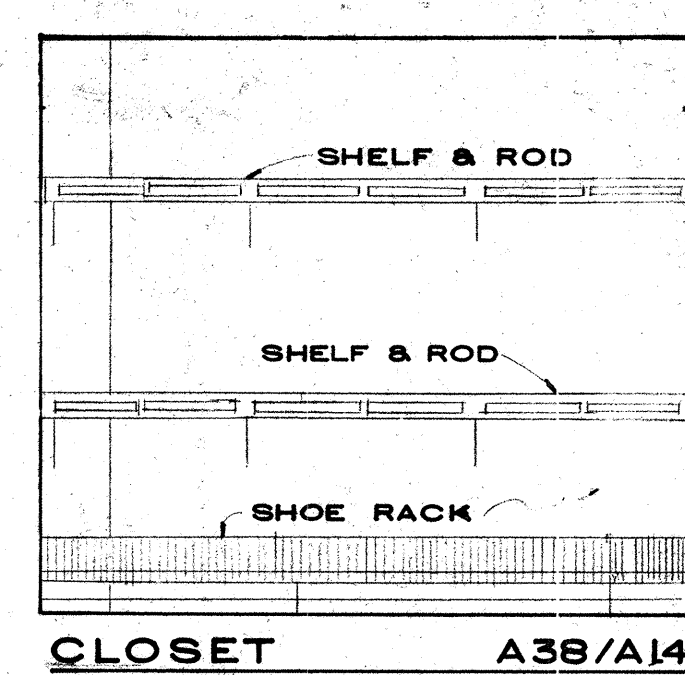
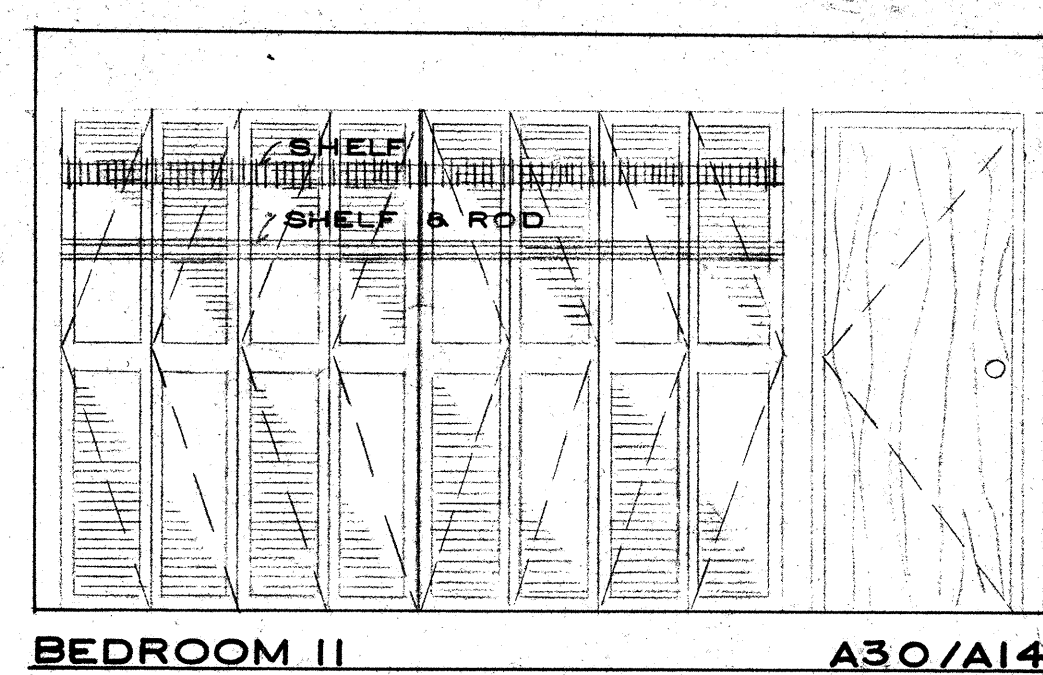
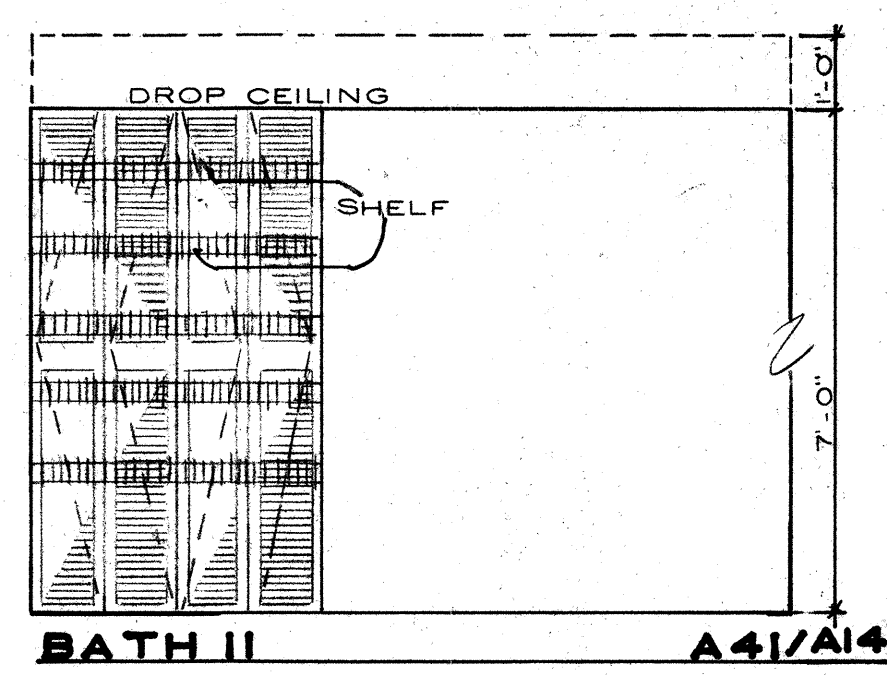
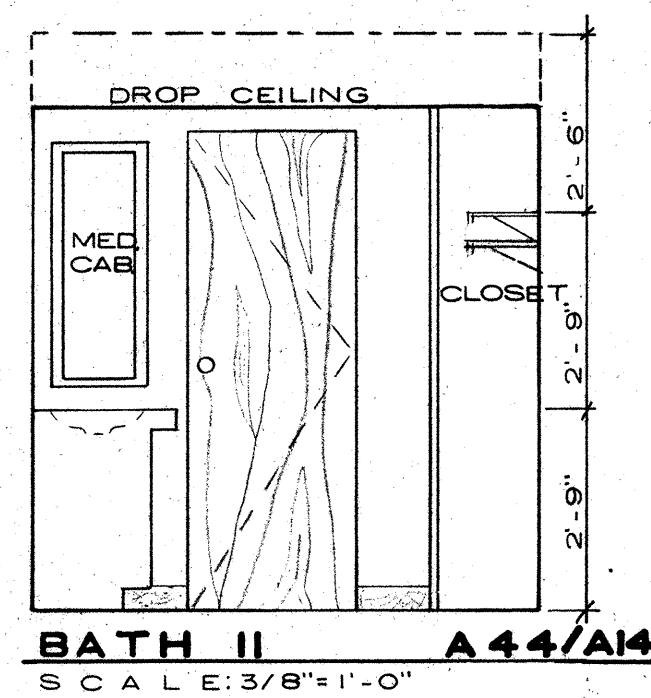
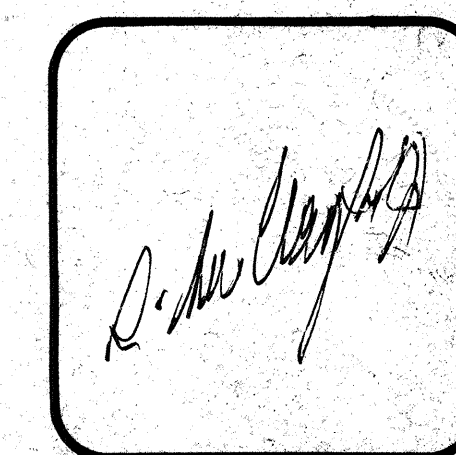
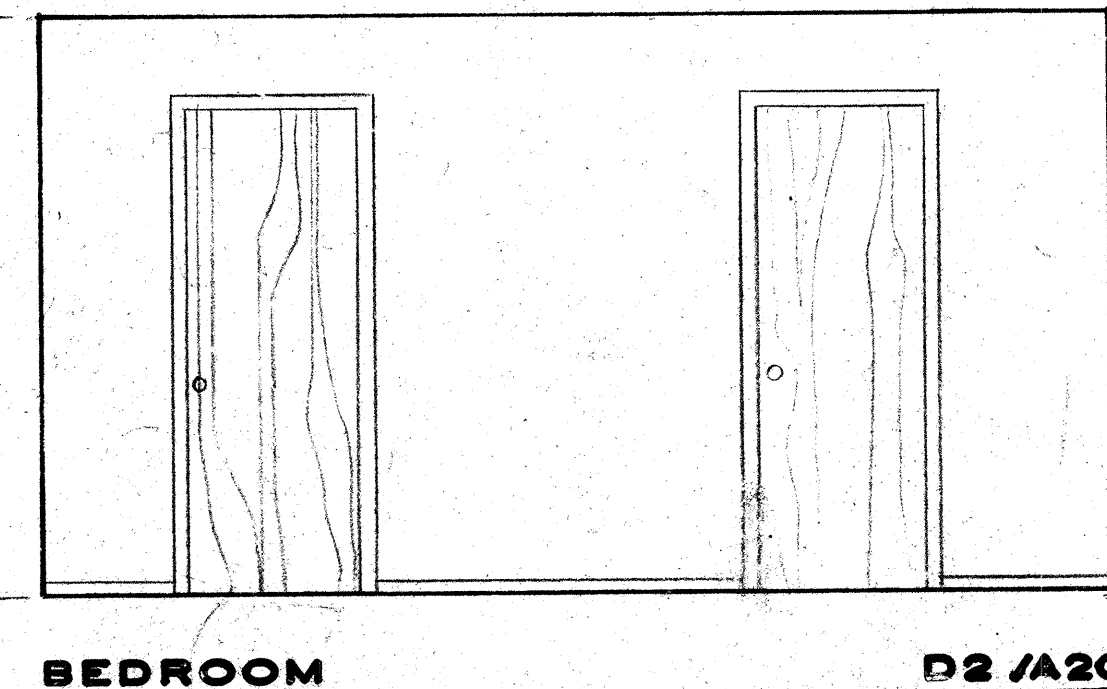
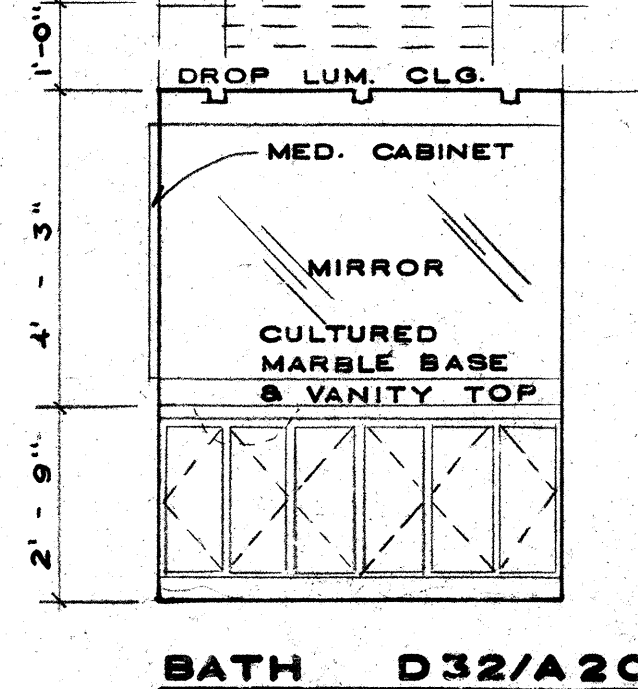


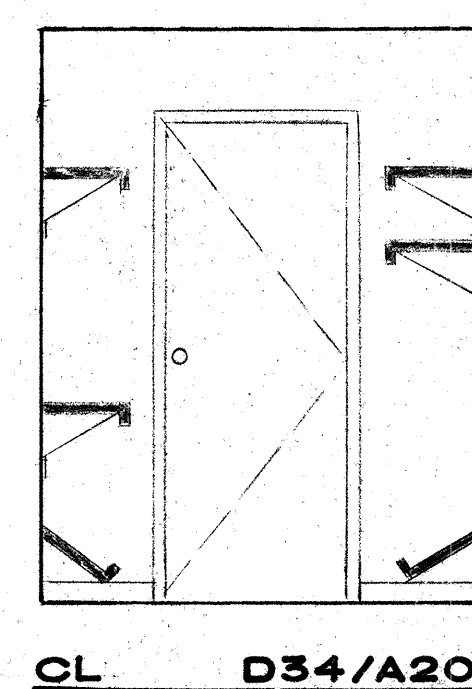

NOTE:
MAILBOXES SHALL BE REAR LOAD
SERIES 1500 AS MANUFACTURED BY
ALLCOM-FLORENCE CORP.

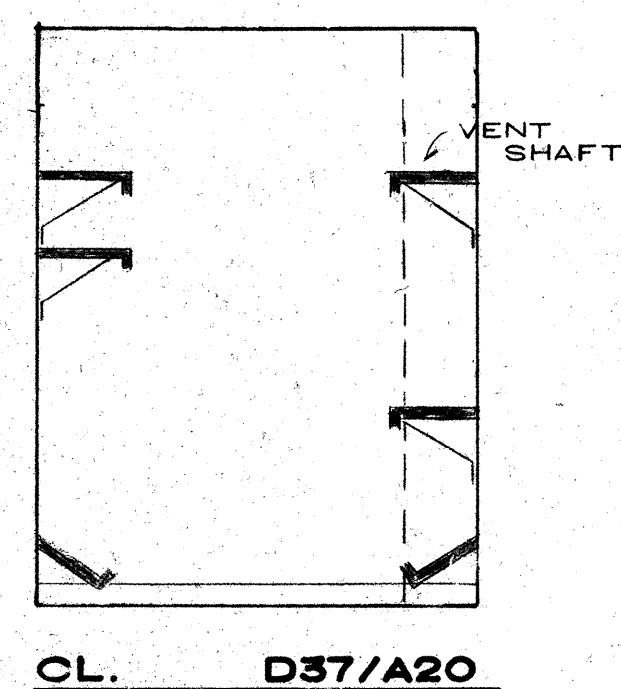

R. WM. CLAYTON JR., ARCHITECT
1995 EAST OAKLAND PARK BLVD. FT. LAUDERDALE, FLA.
OVERLOOK CONDOMINIUM
TYPICAL ELEVATIONS
APTS. 'A', 'B' & 'D'

DRAWN BY: ACS, ALP
JOB NO. 9101
DATE: 8-12-81
REVISIONS: 6-11-84
9-1-81
AS BUILT 2-8-88
SHEET: **A16**