



ELEVATIONS
APARTMENT "C"

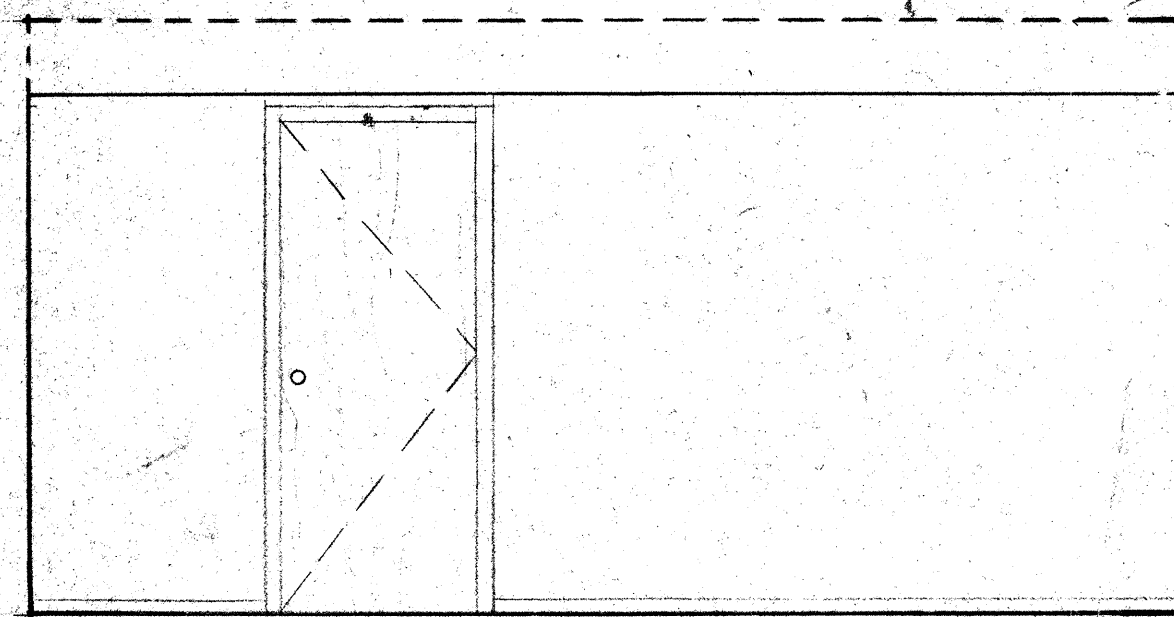

BEDROOM III

C33/A19


SCALE 3/8" = 1'-0" **E33/A19** (OPP. HAND)

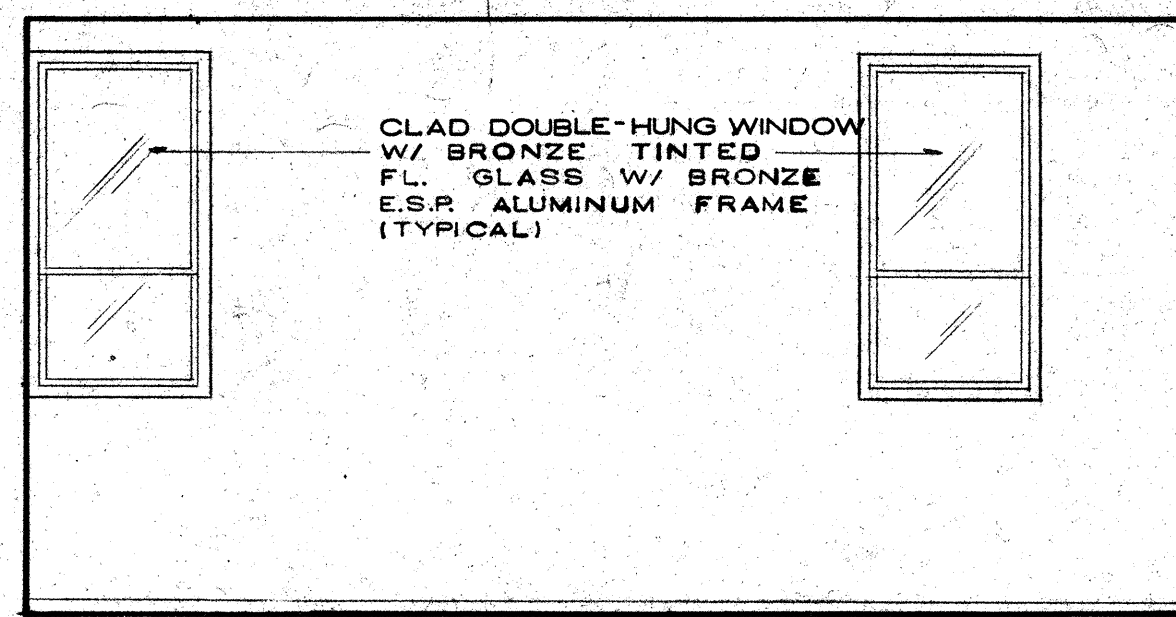

BEDROOM III

C34/A19


E34/A19 (OPP. HAND)

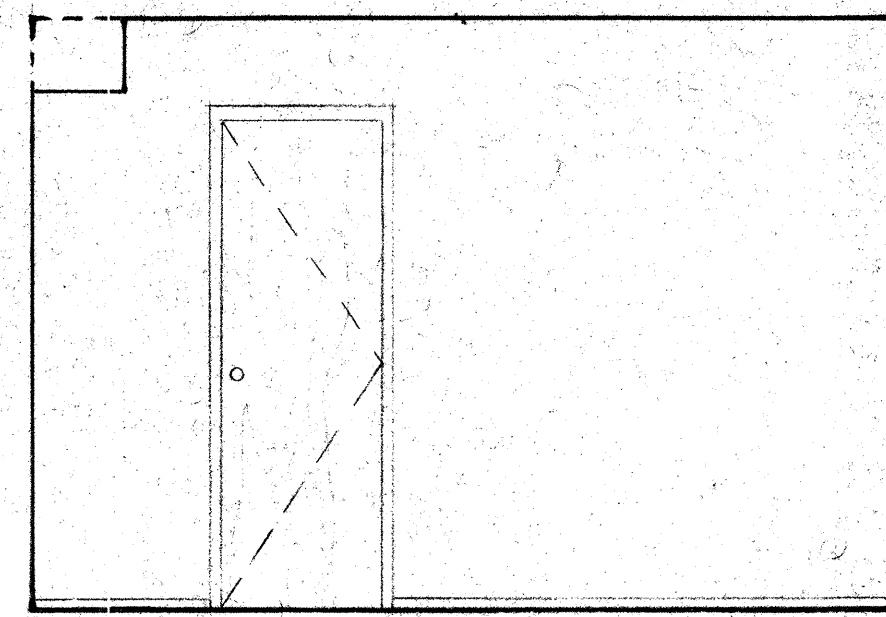

BEDROOM III

C35/A19


E35/A19 (OPP. HAND)

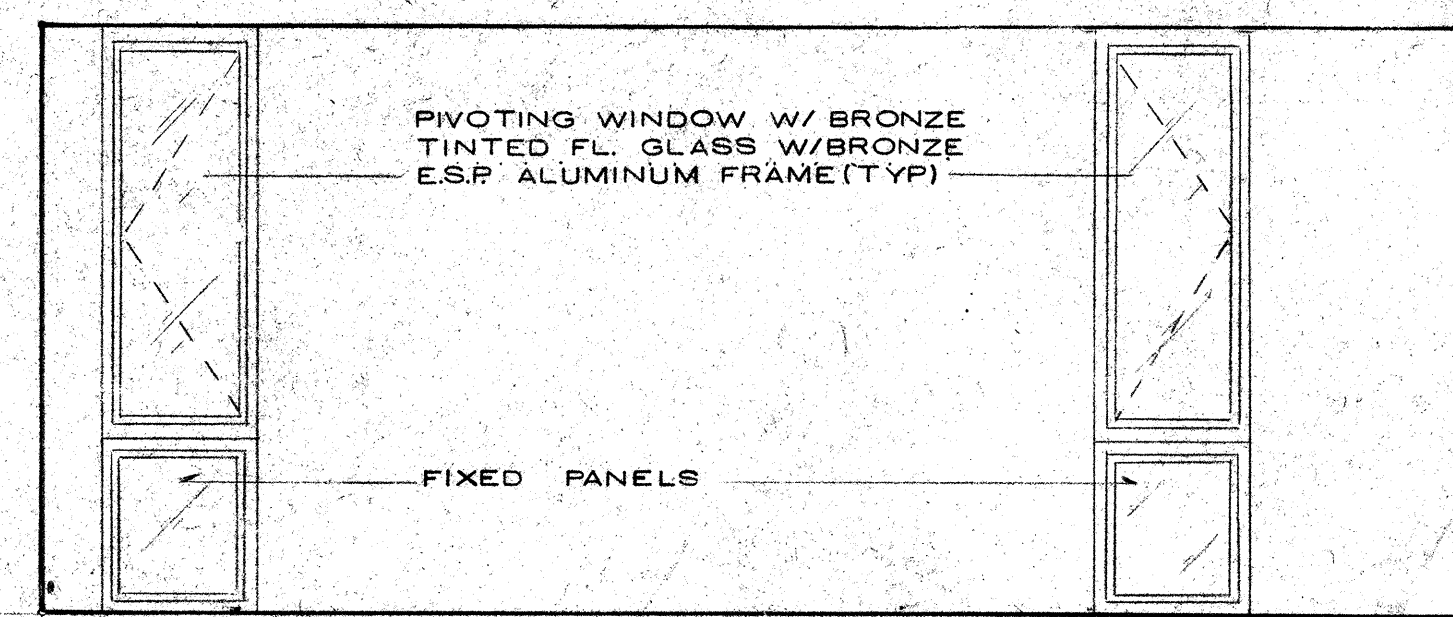

MASTER BEDROOM


A14/A14

ELEVATIONS
APARTMENT "A"

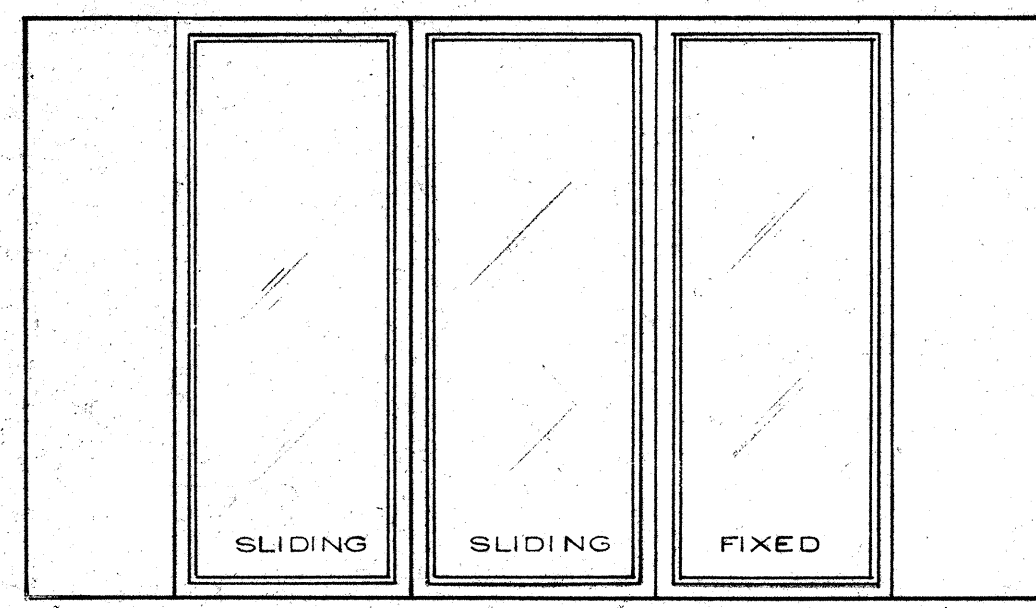


MASTER BEDROOM

A15/A14

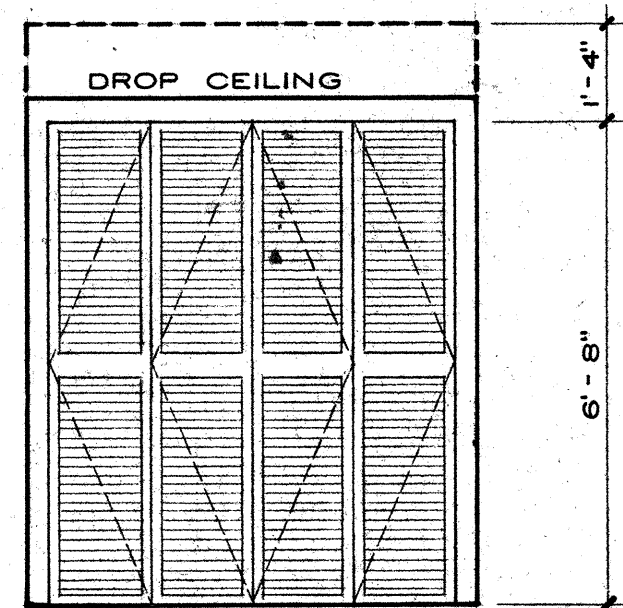


DRESS

A16/A14

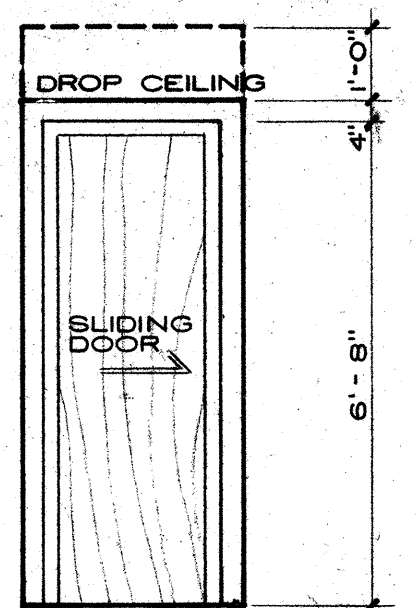


DRESS

A17/A14

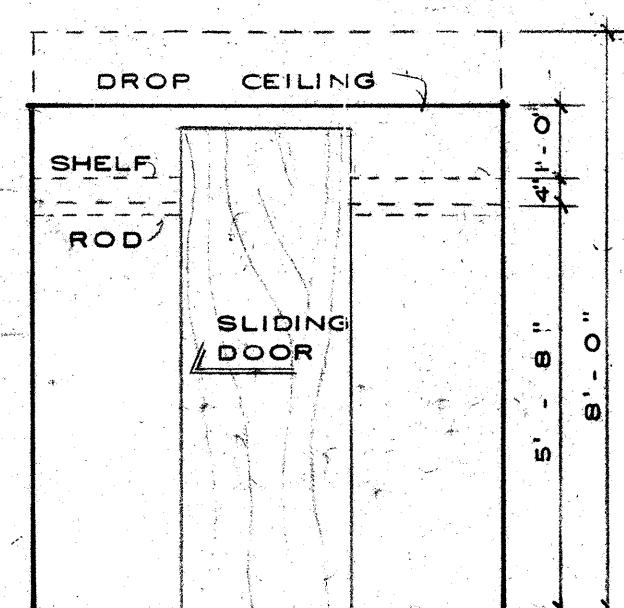


DRESS

A18/A14

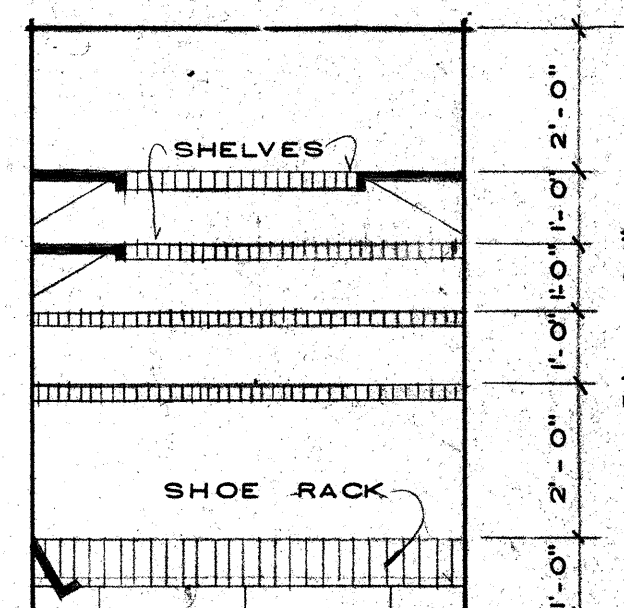


CLOSET

A20/A14

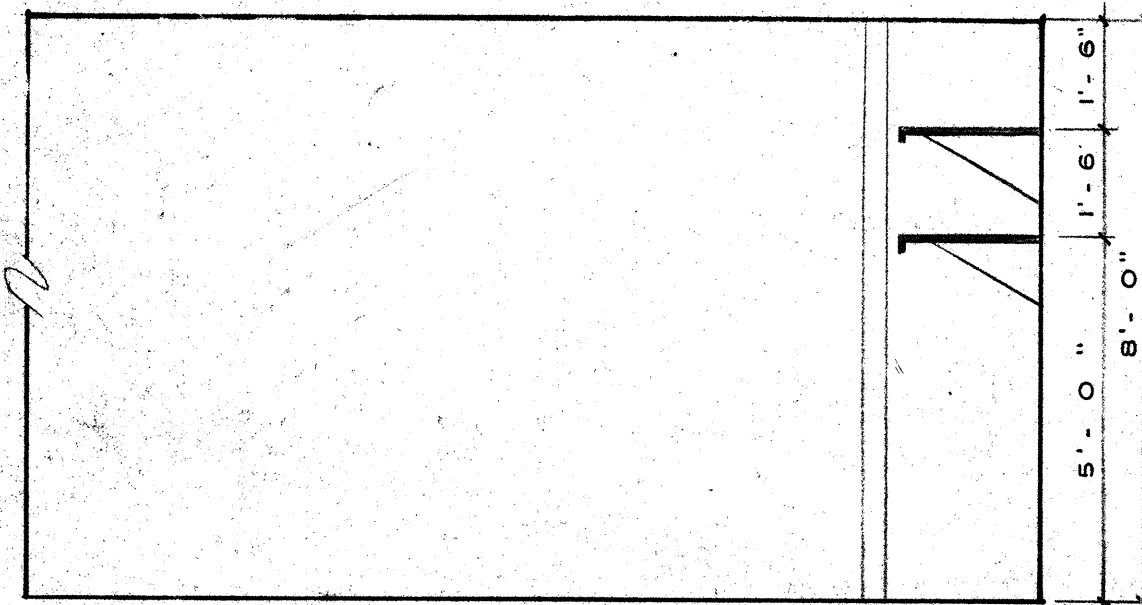


BEDROOM

A31/A14

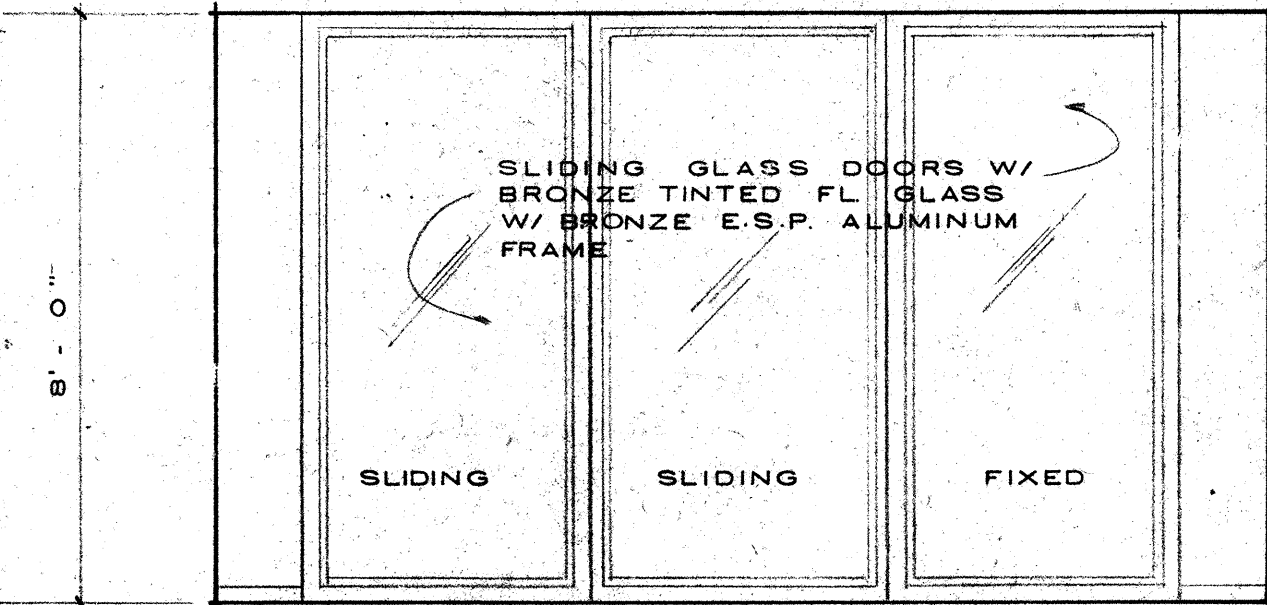

BEDROOM


A32/A14

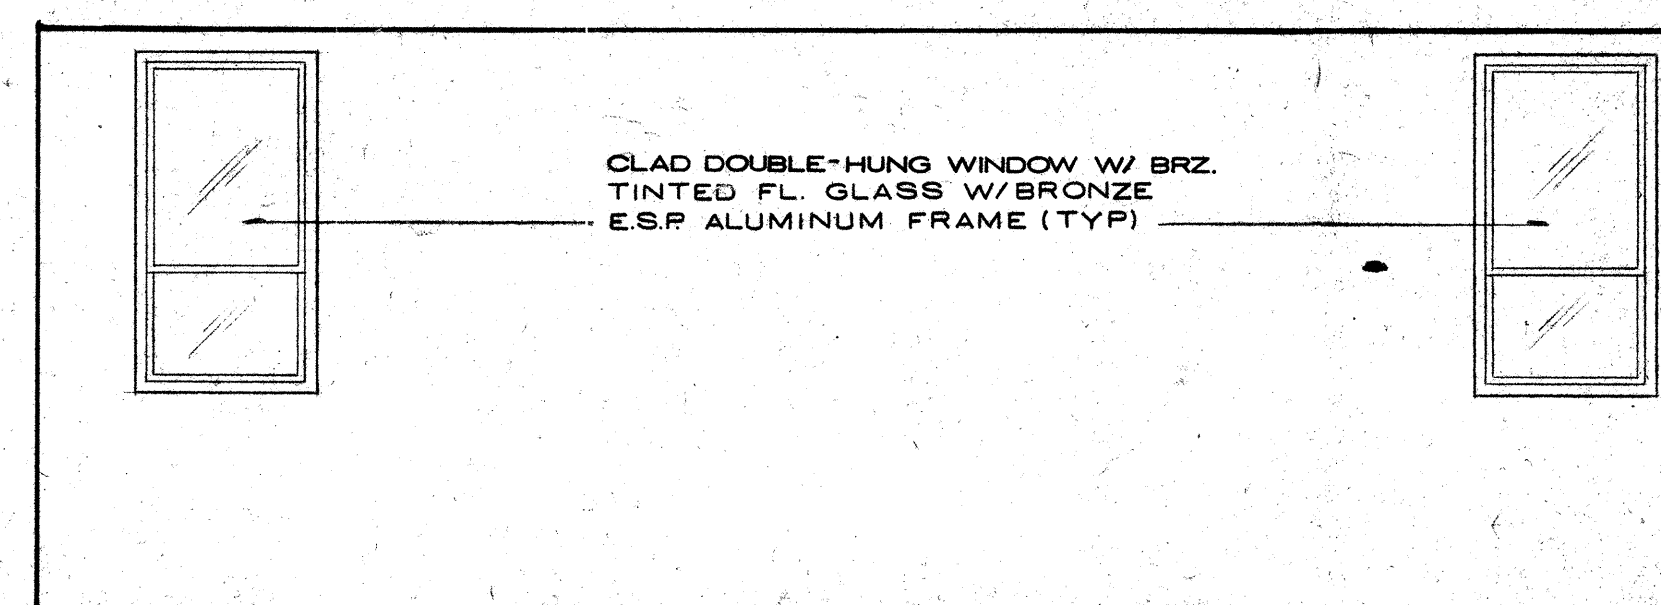

BEDROOM

A37/A14

ELEVATIONS
APARTMENT "B"

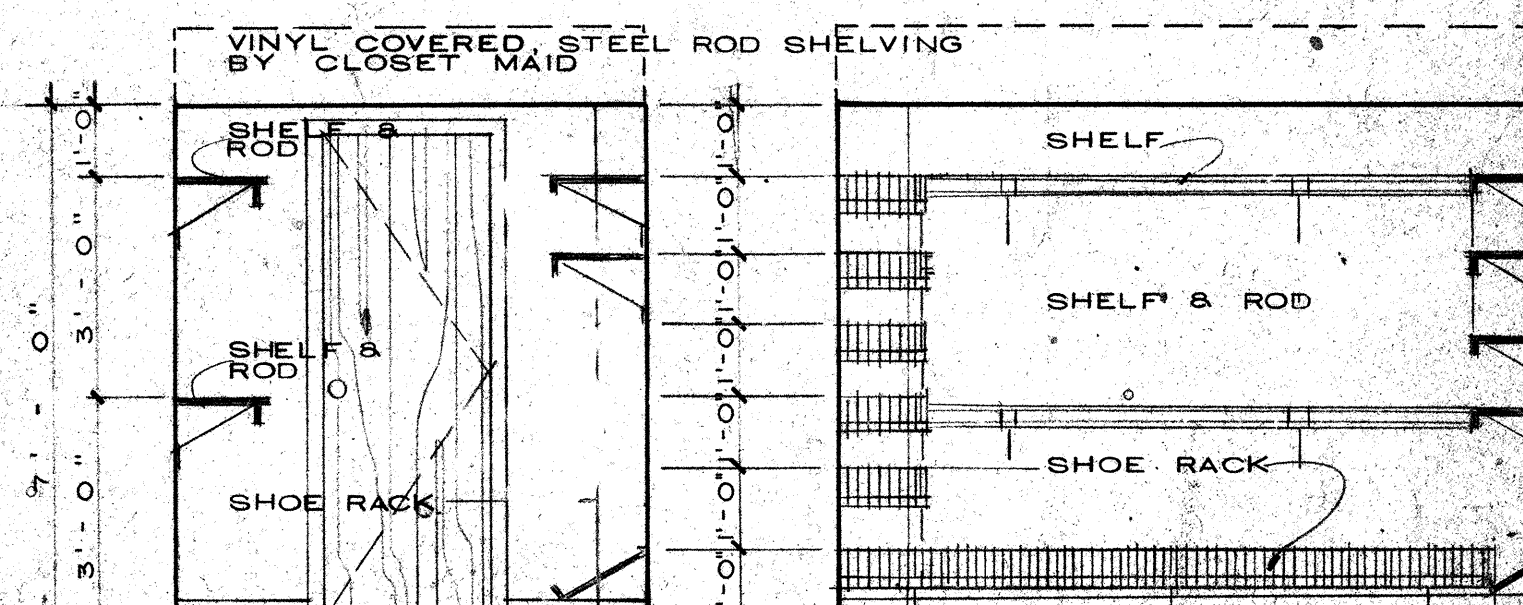


CLOSET

B20/A17
C20/A19
E20/A19 (OPP. HAND)


CLOSET

B21/A17
C21/A19
E21/A19 (OPP. HAND)

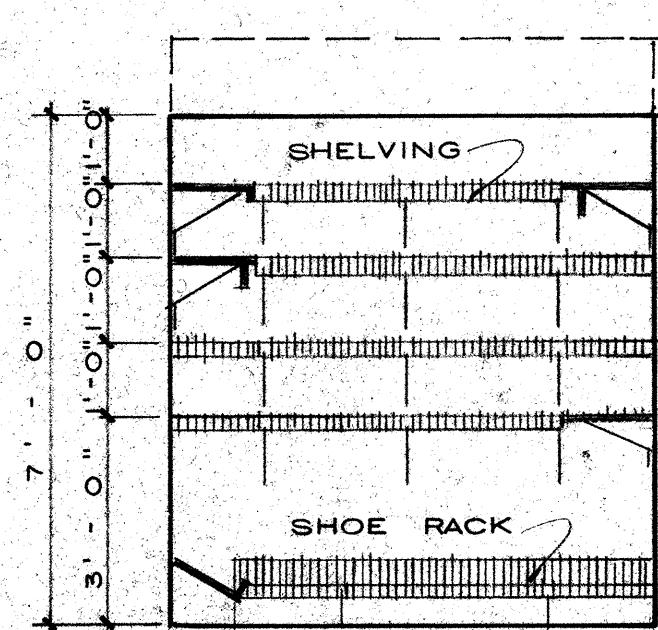

CLOSET


B22/A17
C22/A19
E22/A19 (OPP. HAND)

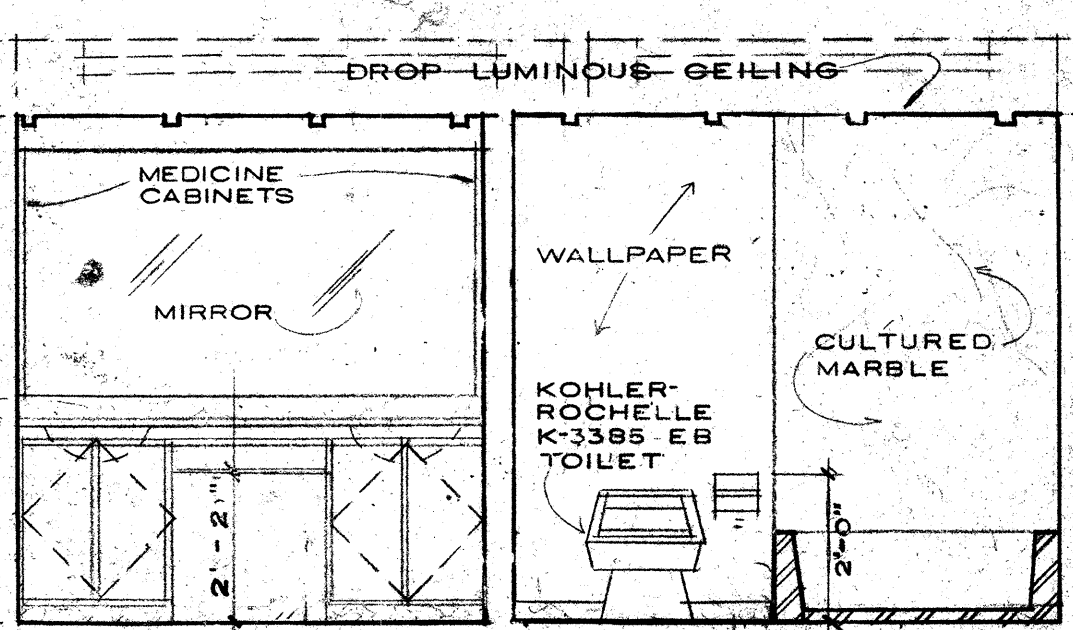

BATH

B23/A17


C23/A19
E23/A19 (OPP. HAND)

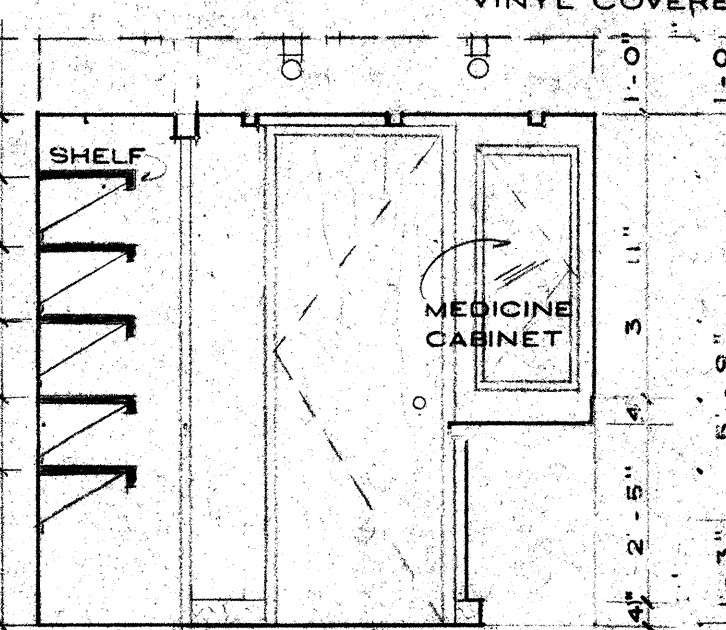

BATH

B24/A17


C24/A19
E24/A19 (OPP. HAND)

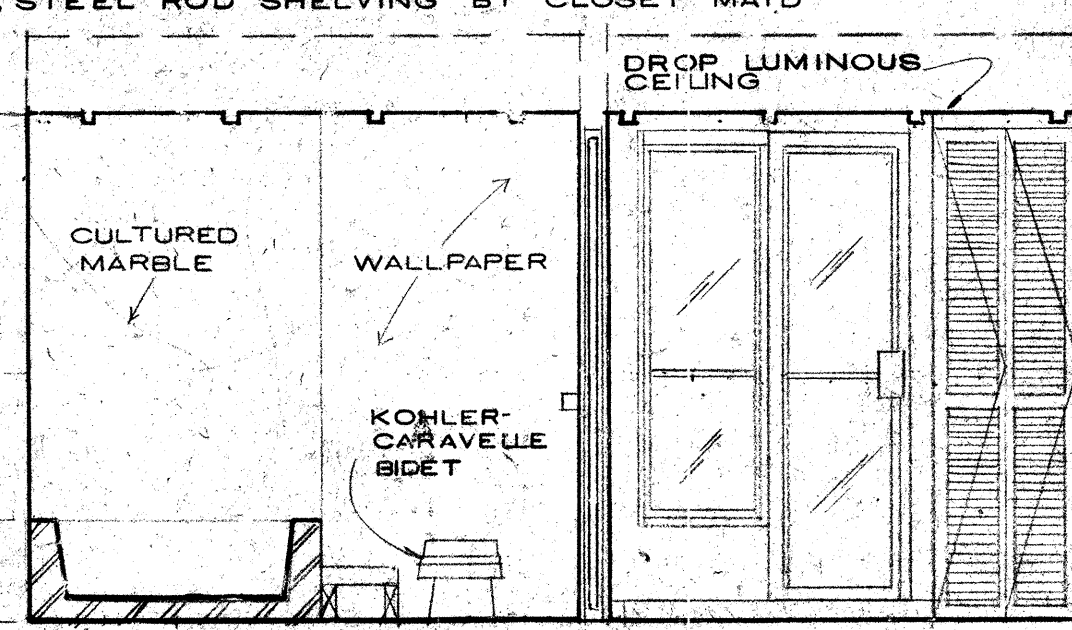

BATH

B25/A17


C25/A19
E25/A19 (OPP. HAND)

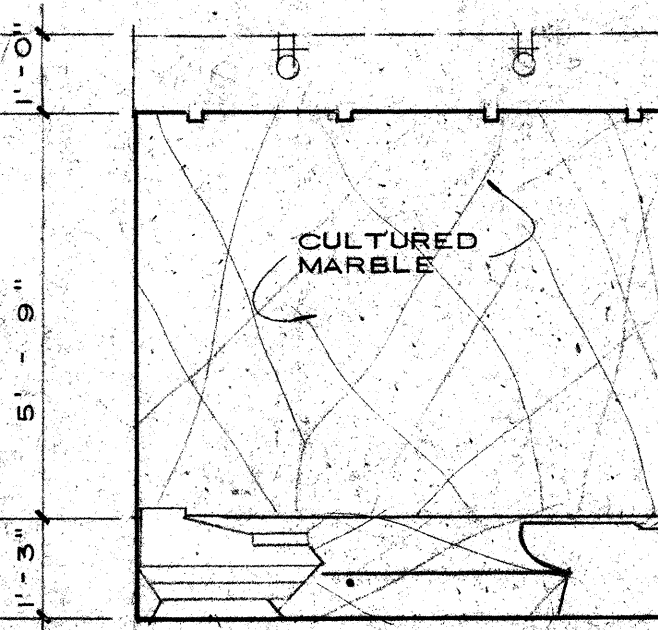

BATH

B26/A17


C26/A19
E26/A19 (OPP. HAND)

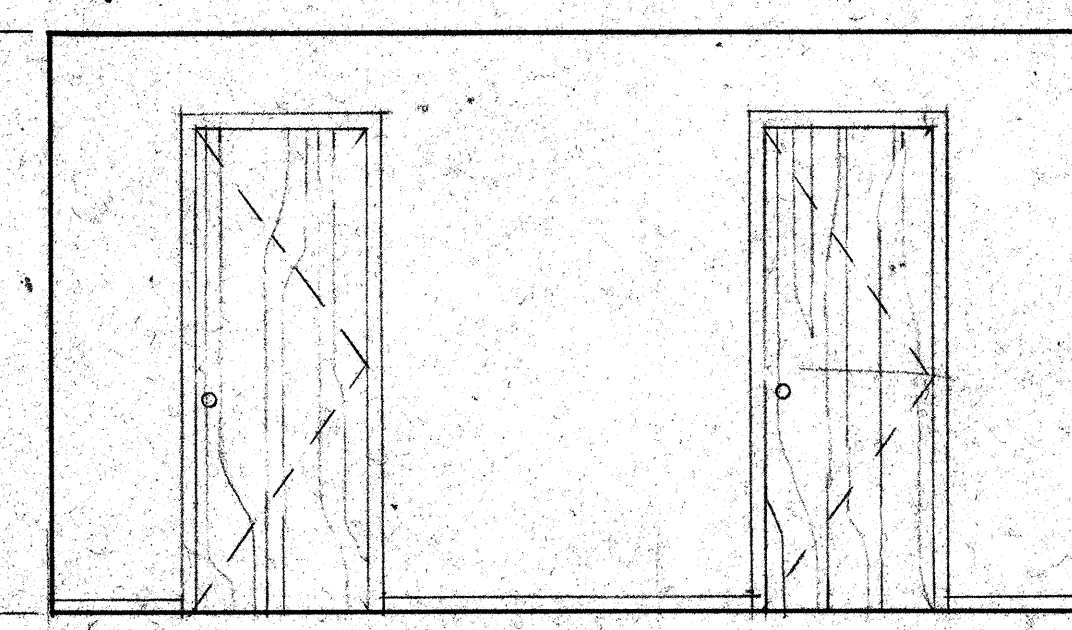

BEDROOM

B27/A17


C27/A19
E27/A19 (OPP. HAND)

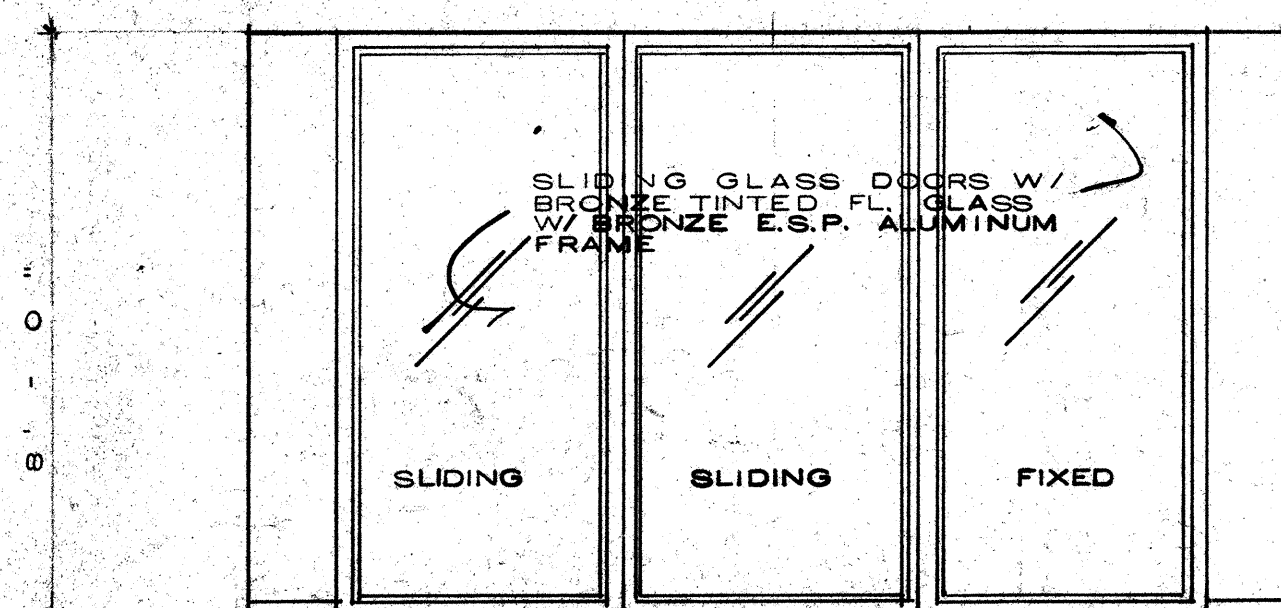

BEDROOM

B28/A17

C28/A19
E28/A19 (OPP. HAND)

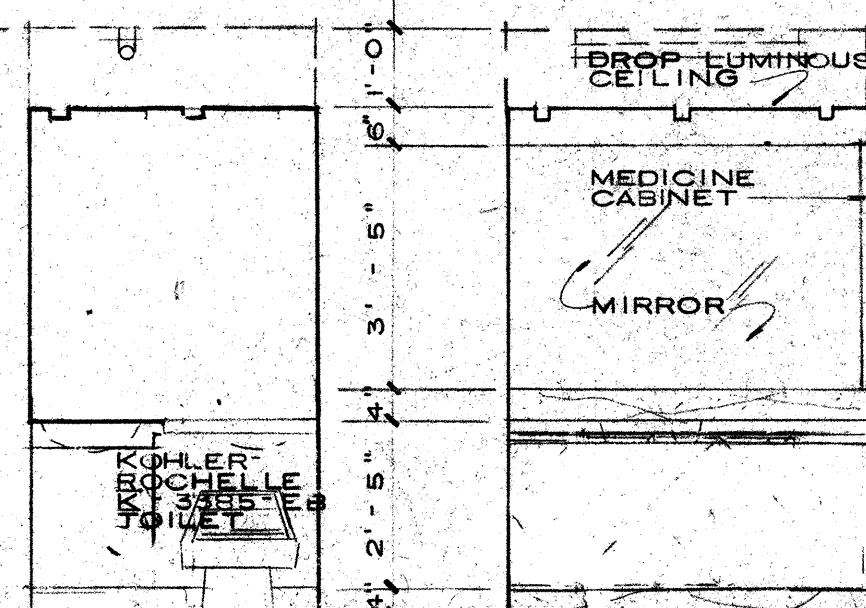

BATH

B29/A17


C29/A19
E29/A19 (OPP. HAND)



B.

B31/A17

C31/A19
E31/A19 (OPP. HAND)

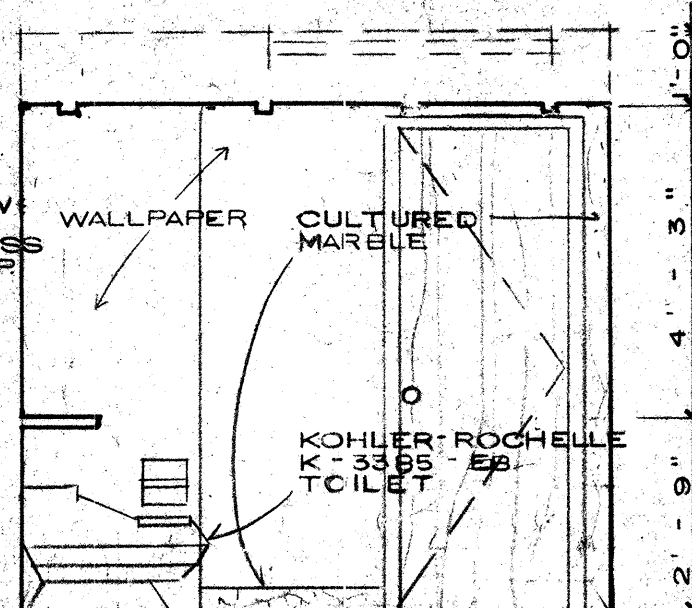


BATH

B32/A17

C32/A19
E32/A19 (OPP. HAND)

INTERIOR ELEVATIONS

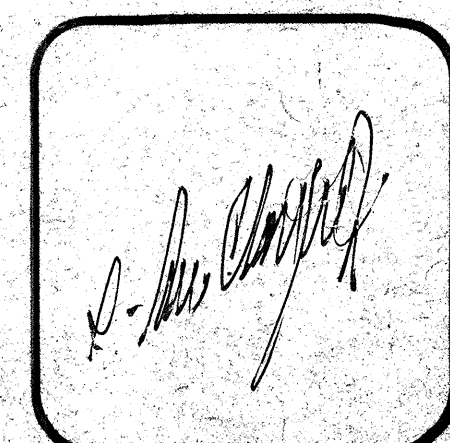

R. WM. CLAYTON JR. ARCHITECT
1995 EAST OAKLAND PARK BLVD. FT. LAUDERDALE, FLA.

OVERLOOK CONDOMINIUM

APT "B" & "C" ELEVATIONS

DRAWN BY: ALP, ACS
JOB NO: 8101
DATE: 8-12-81
REVISIONS: 6-11-84
AS BUILT 2-8-88
SHEET **A18**