


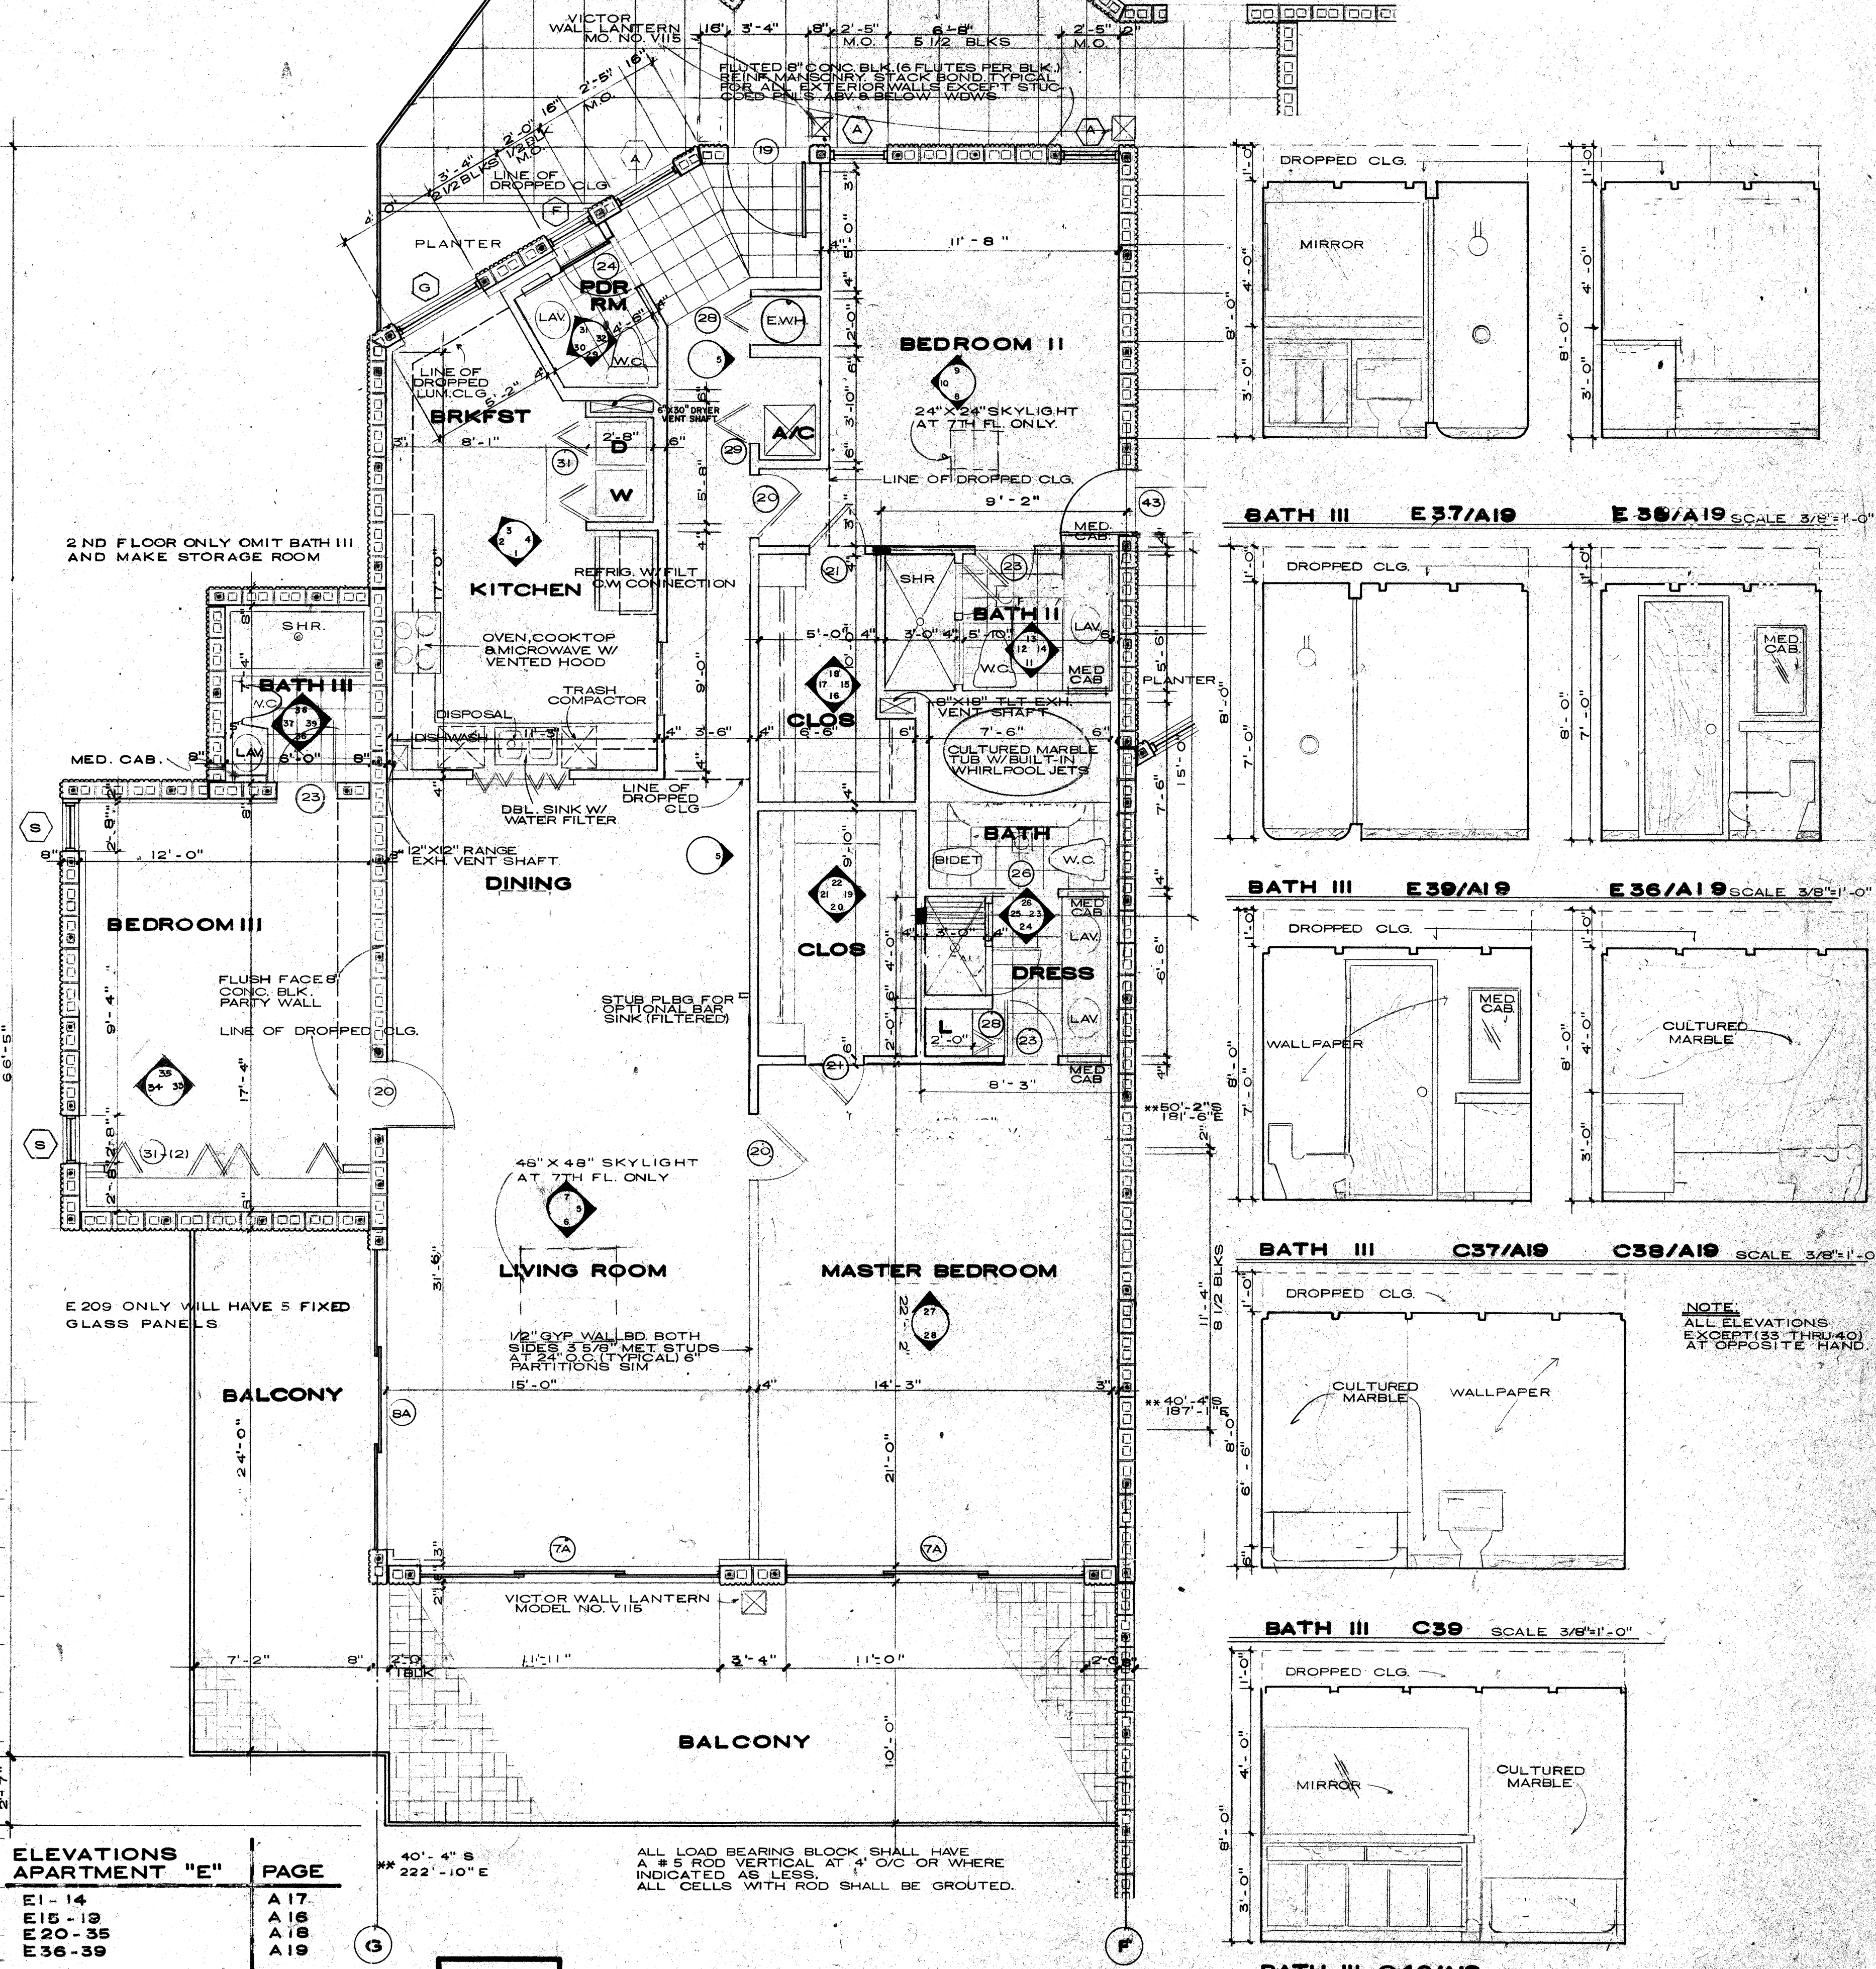

DRAWN BY: ALP
JOB NO: 8101
DATE: 8-12-81
REVISIONS: 6-11-84
8-27-84
AS BUILT 2-8-88
SHEET: A19