
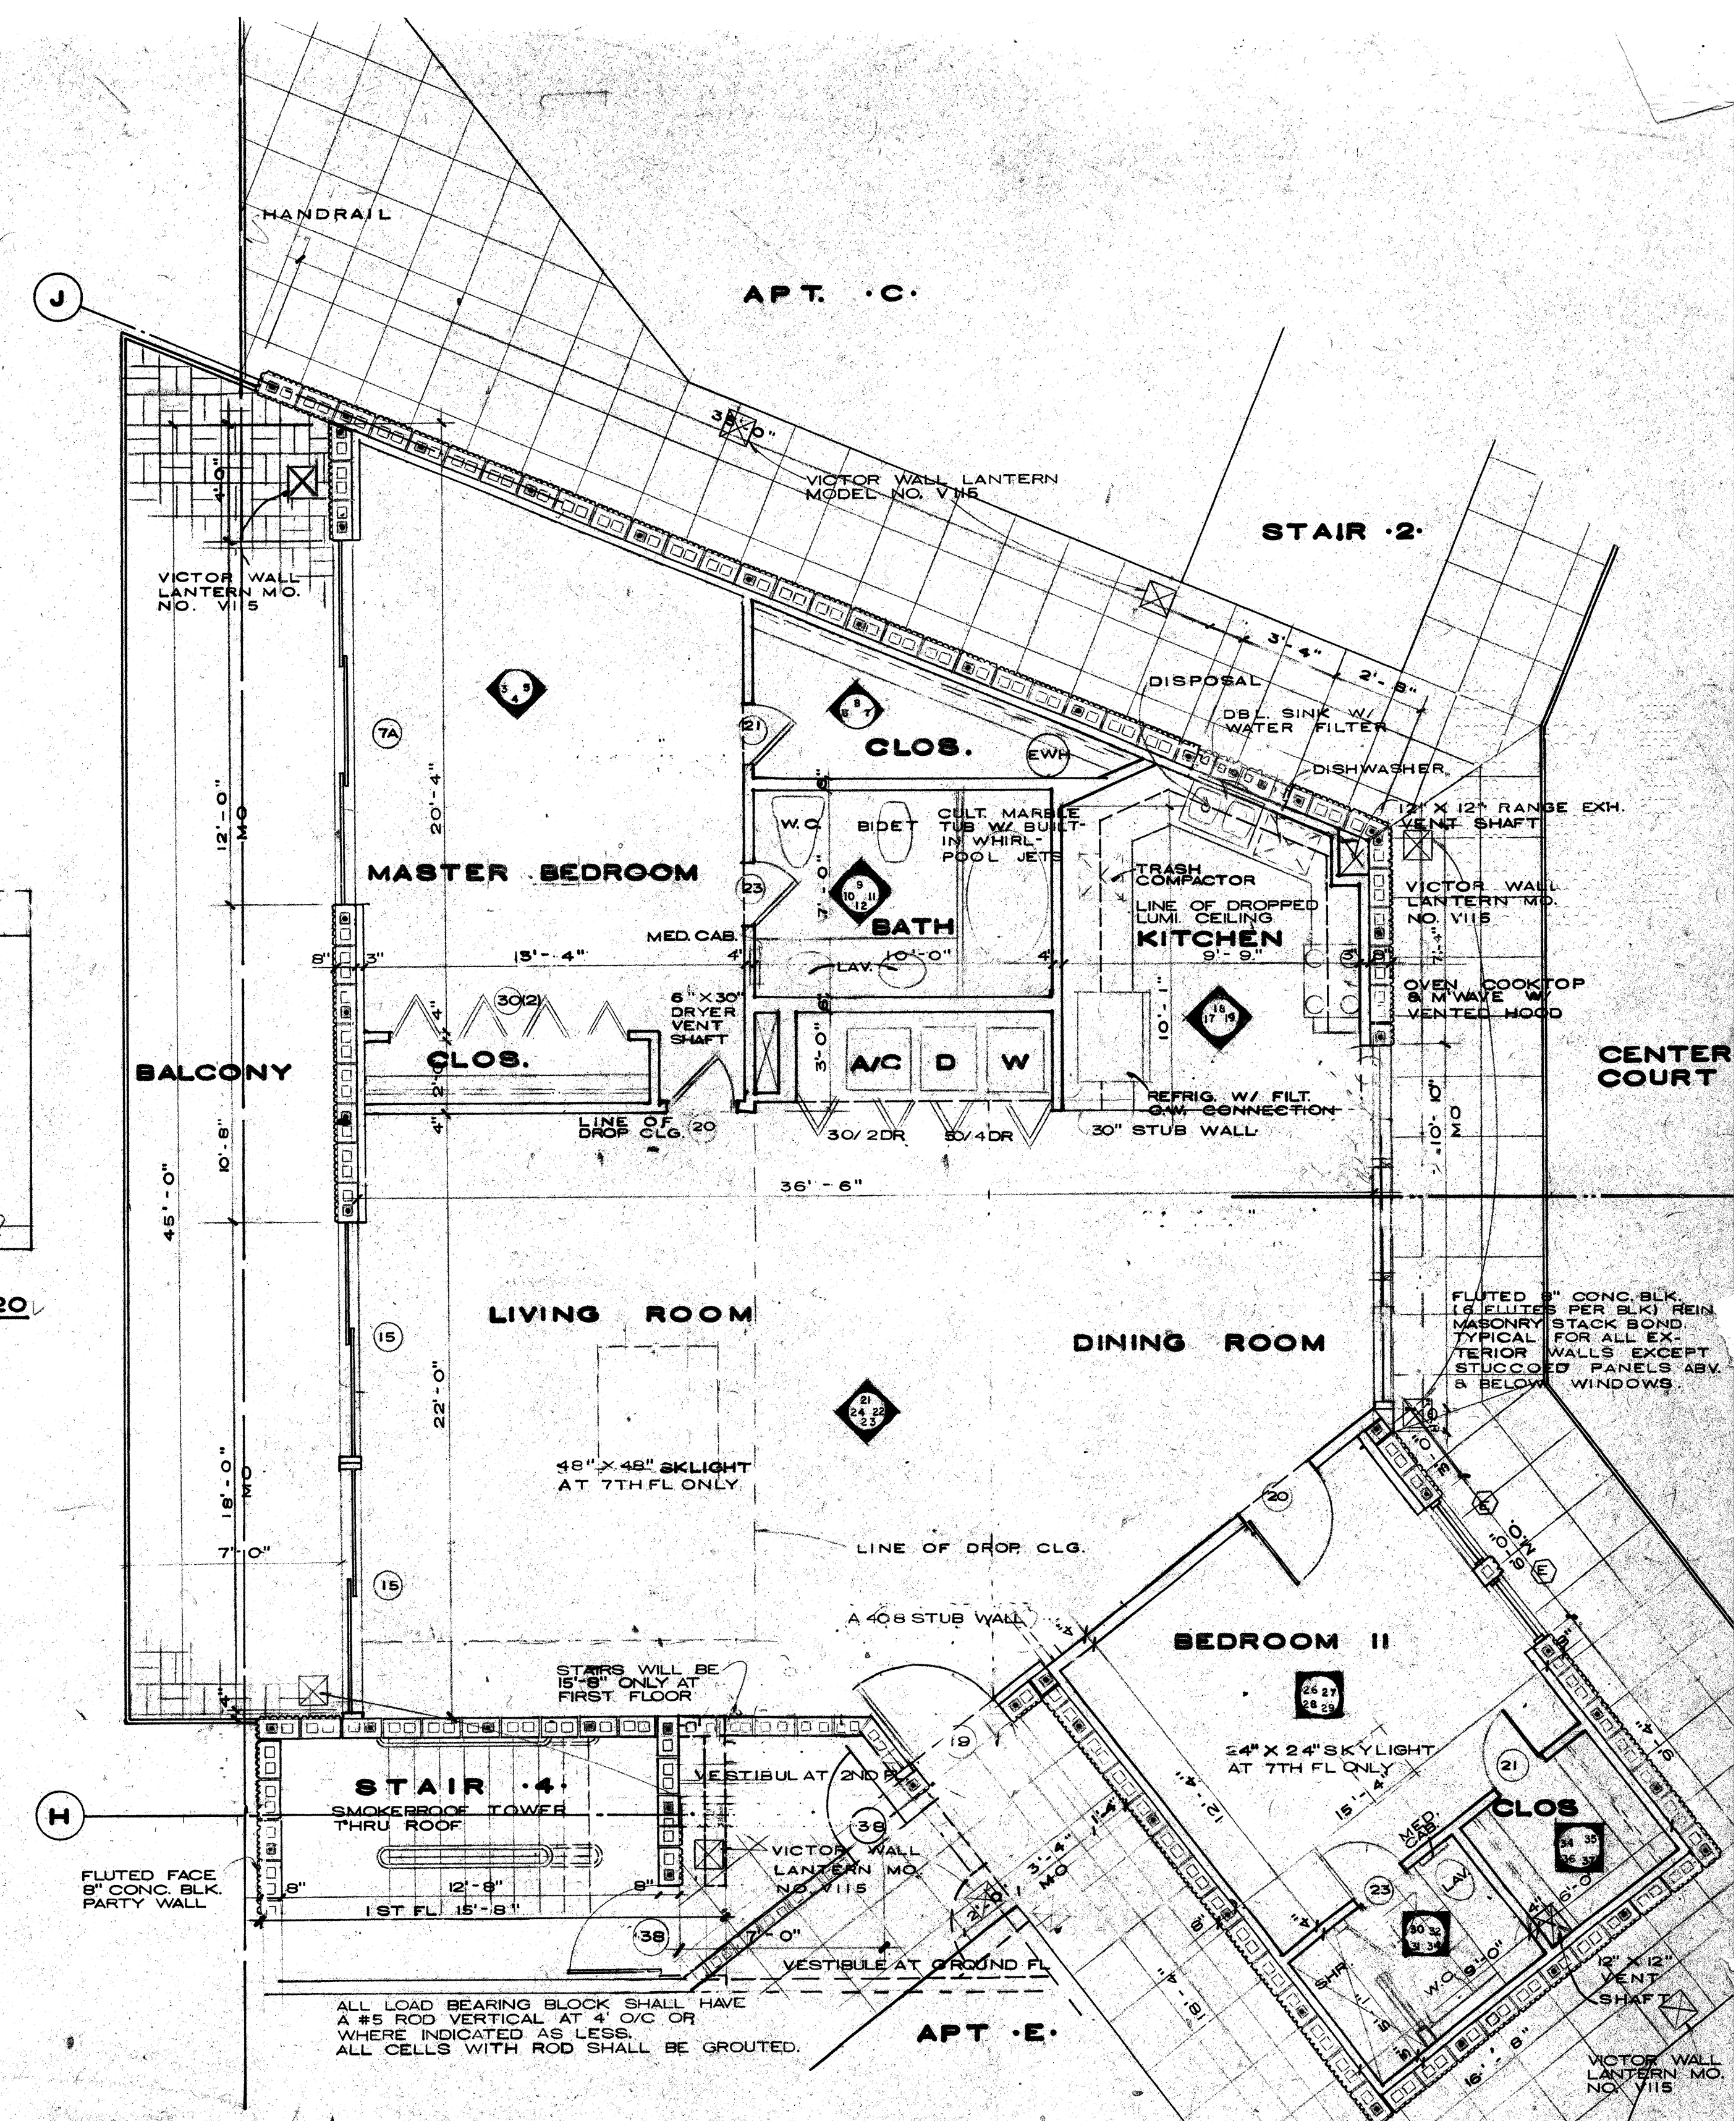
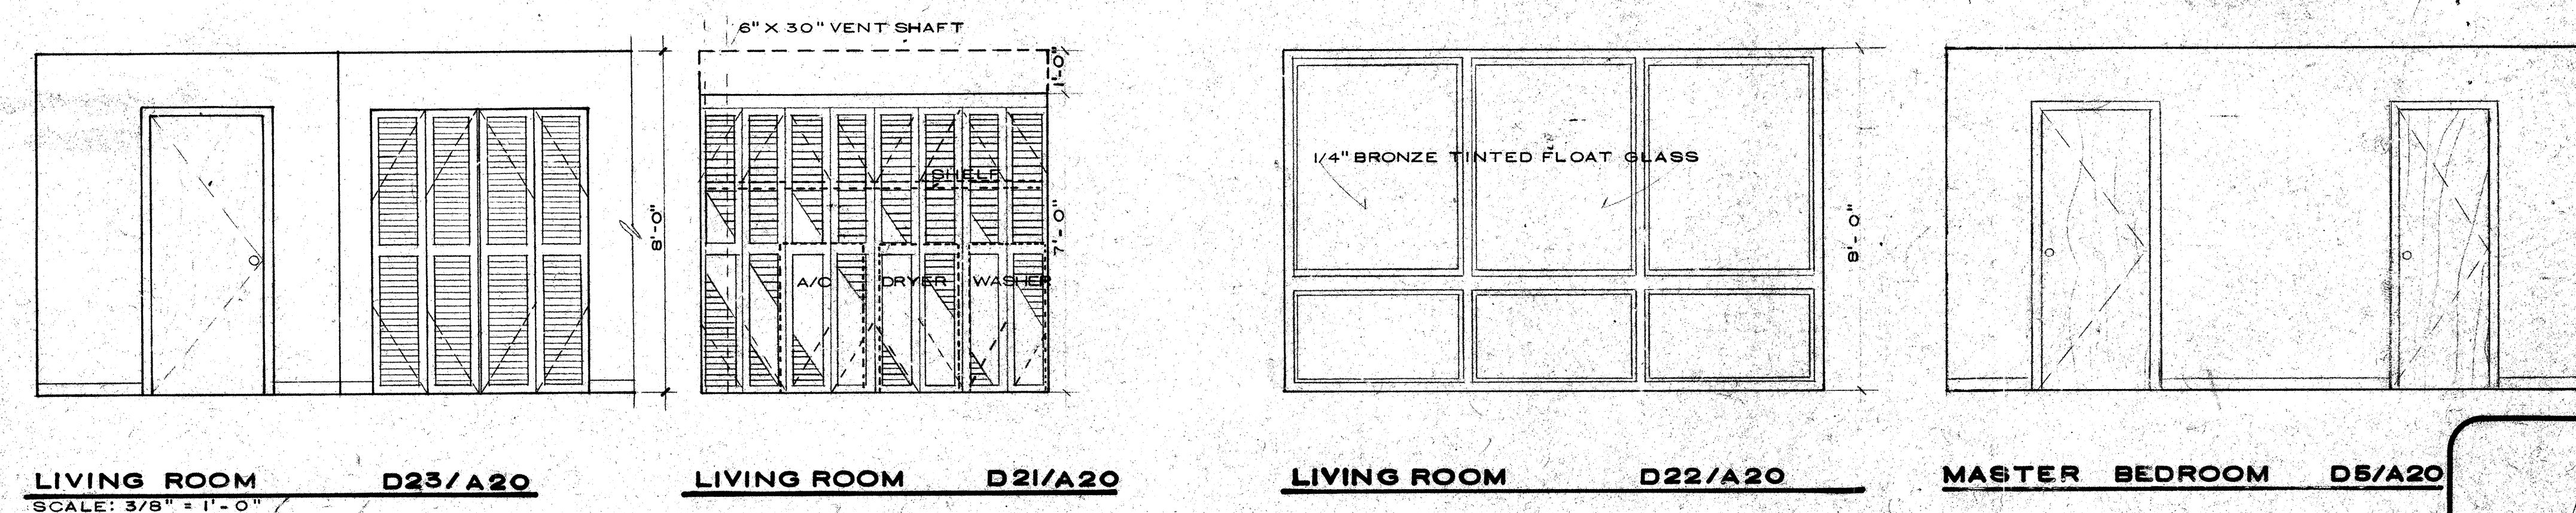
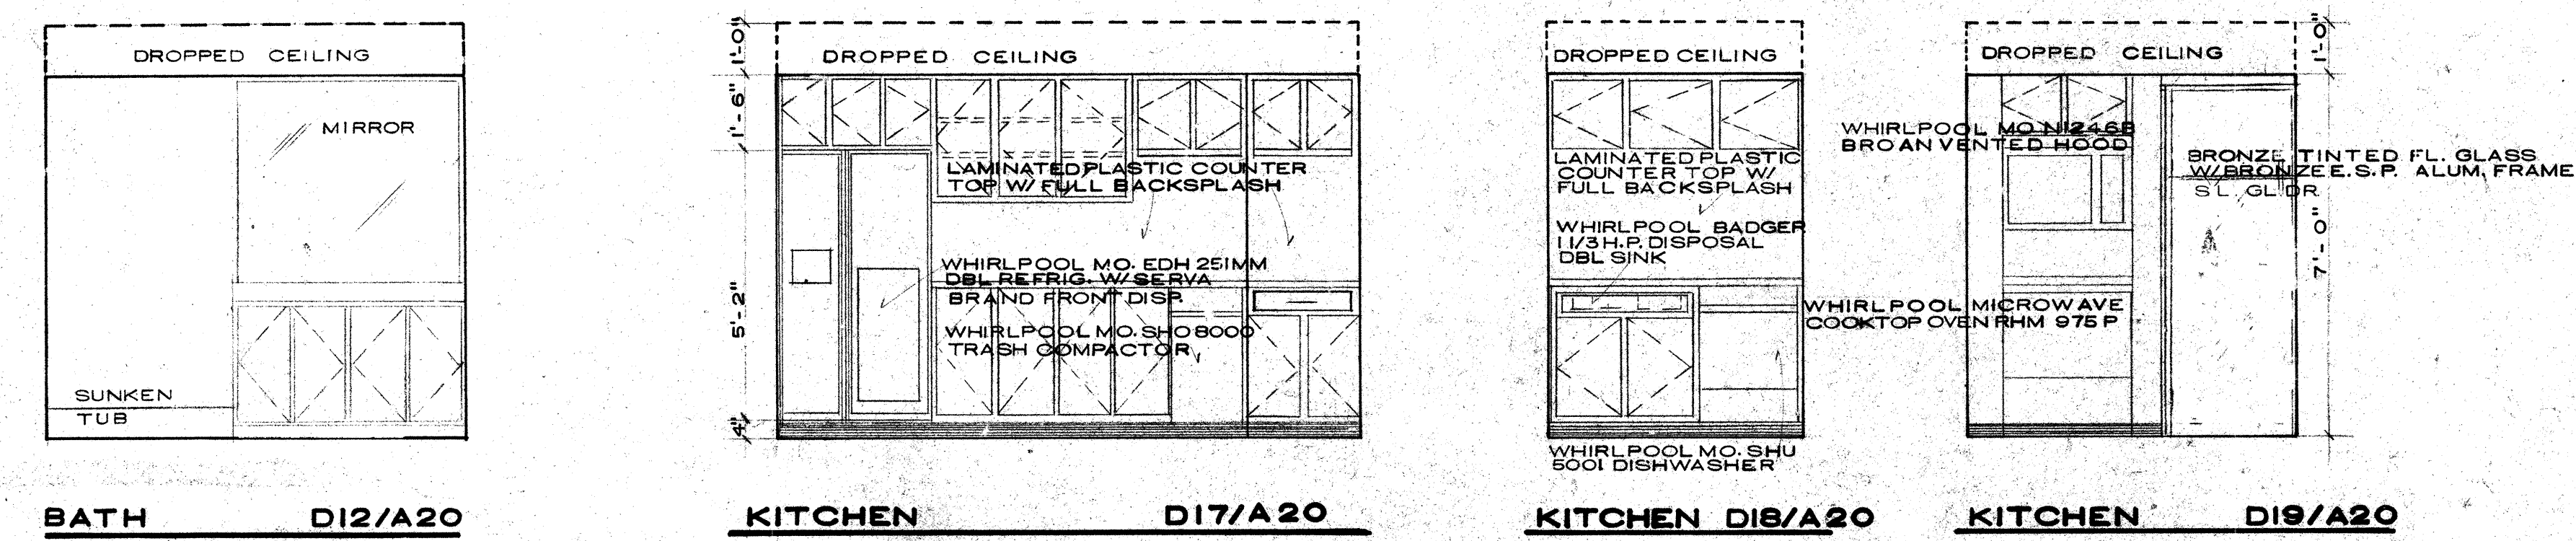
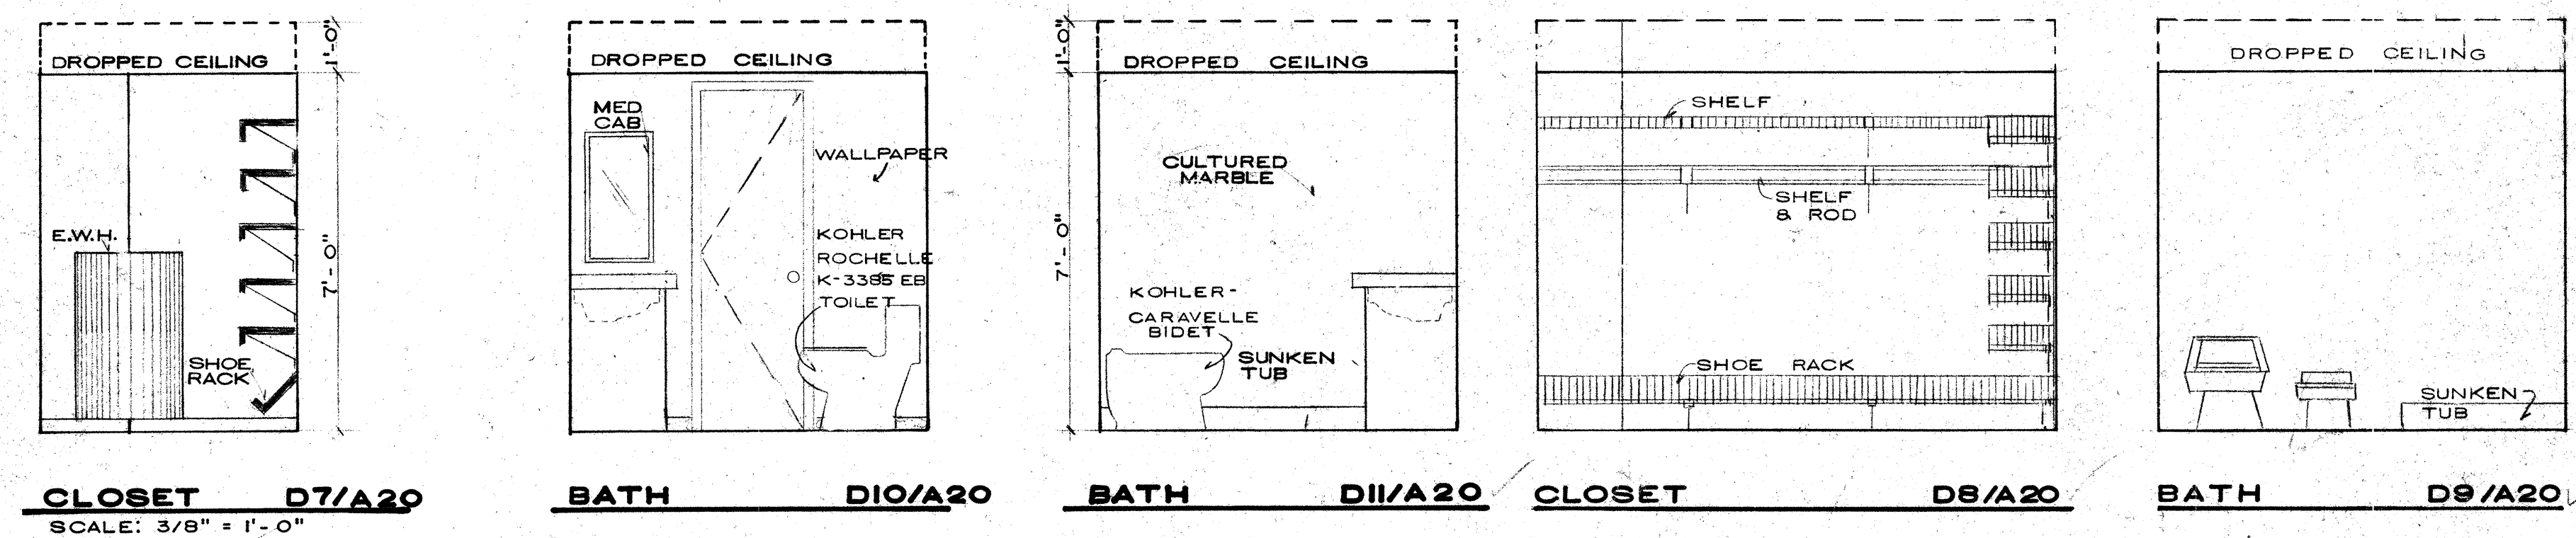


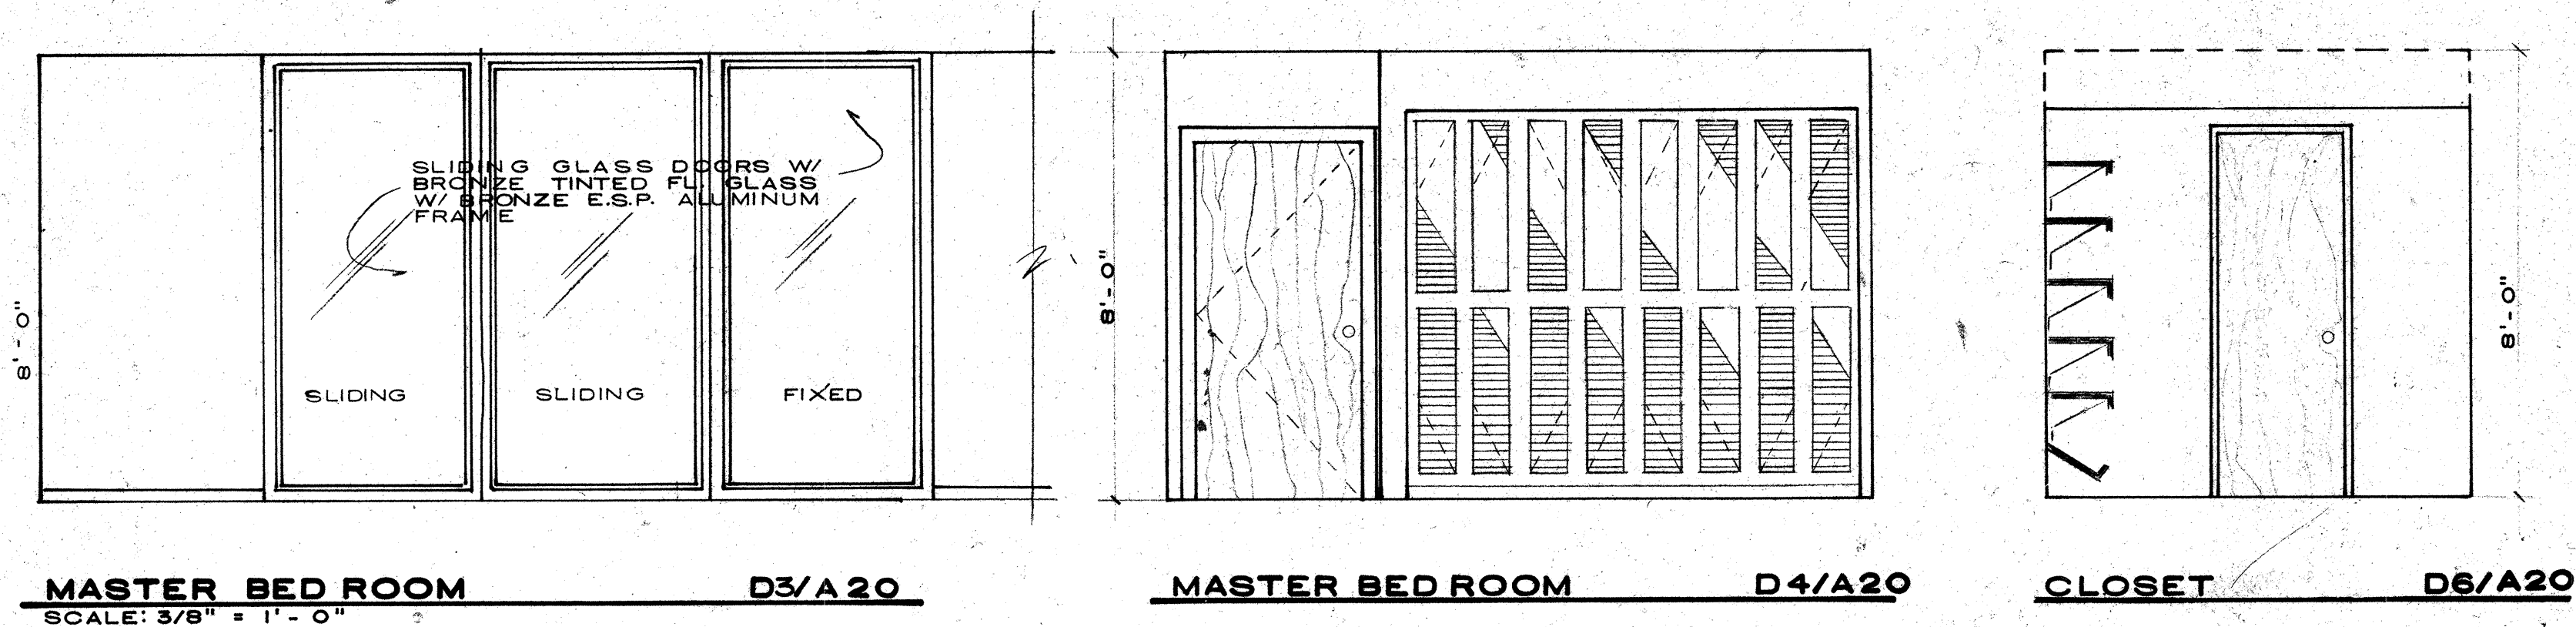

ELEVATIONS	PAGE
APT. D	A20
D3-12, 17-23	A16
D24, 26-37	

FLOOR PLAN APT.

SCALE: 1/4" = 1'-0"
1000 SQ. FT. OF APT. = 1613.0 SQ. FT.
1000 SQ. FT. OF BAL. = 295.5 SQ. FT.
TOTAL SQ. FT. = 1908.5 SQ. FT.

R. Wm. Clayton Jr.

R. WM. CLAYTON JR. ARCHITECT
1995 EAST OAKLAND PARK BLVD. FT. LAUDERDALE, FLA.
OVERLOOK CONDOMINIUM
TYPICAL FLOOR PLAN
APT. D

DRAWN BY: ALP.VPS
JOB NO. 8101
DATE: 10-12-81
REVISIONS: 6-11-84
8-27-84
AS BUILT 2-9-85
SHEET **A20**