


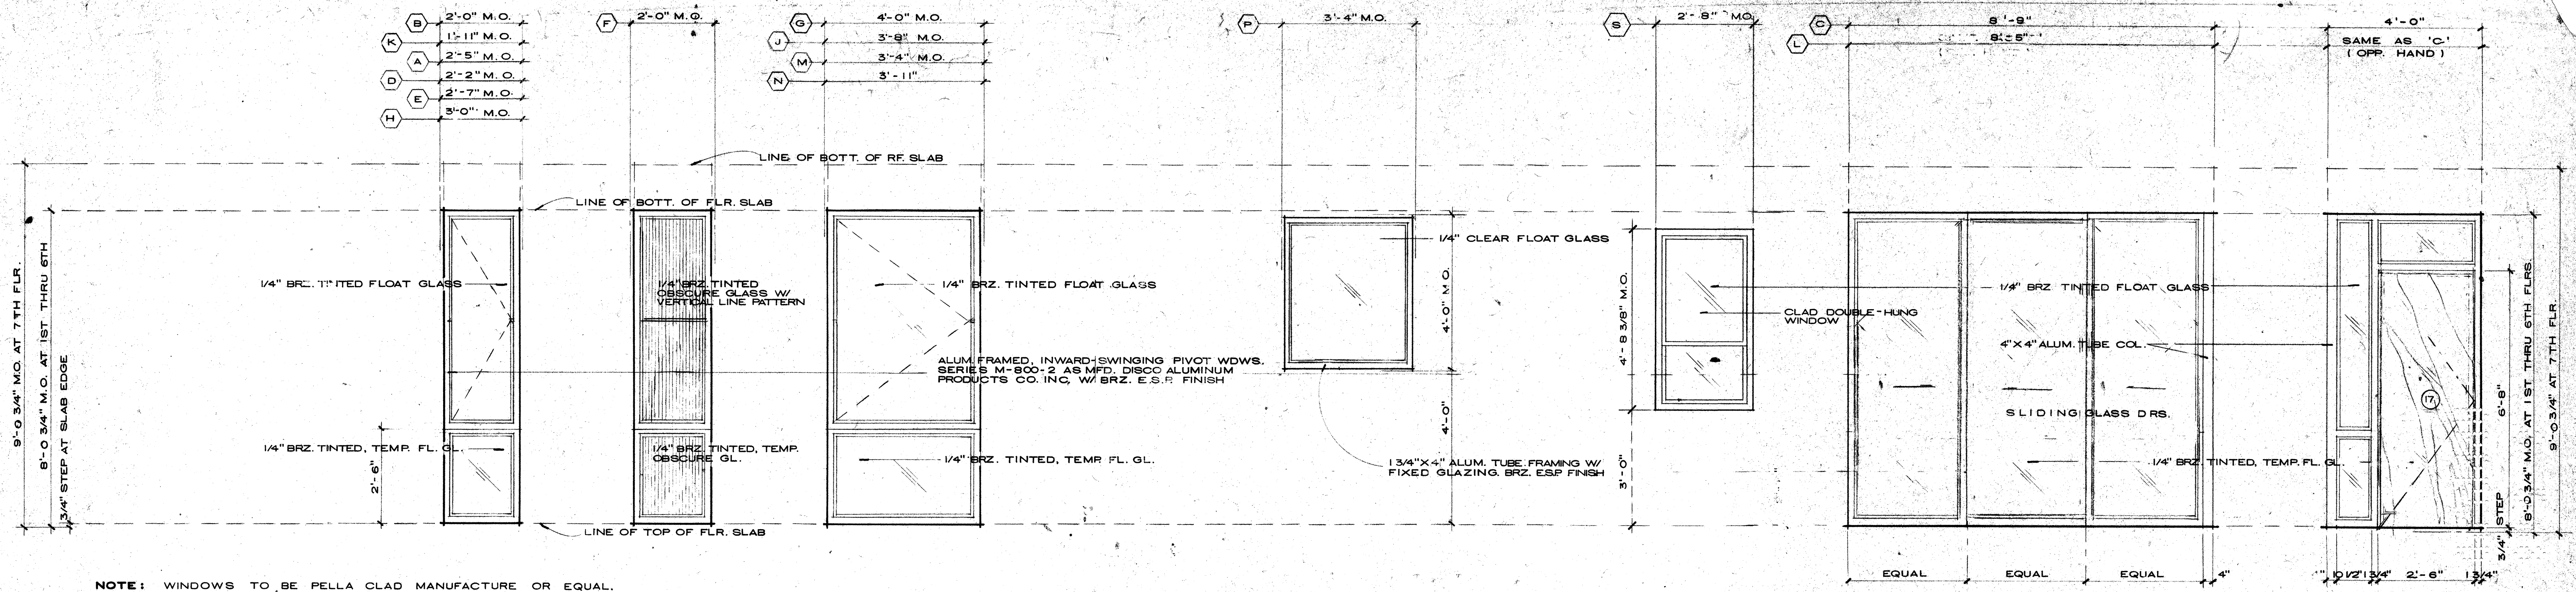


NOTE: WINDOWS TO BE PELLA CLAD MANUFACTURE OR EQUAL.

## WINDOW ELEVATIONS

SCALE: 1/2" = 1'-0"


1 / A22

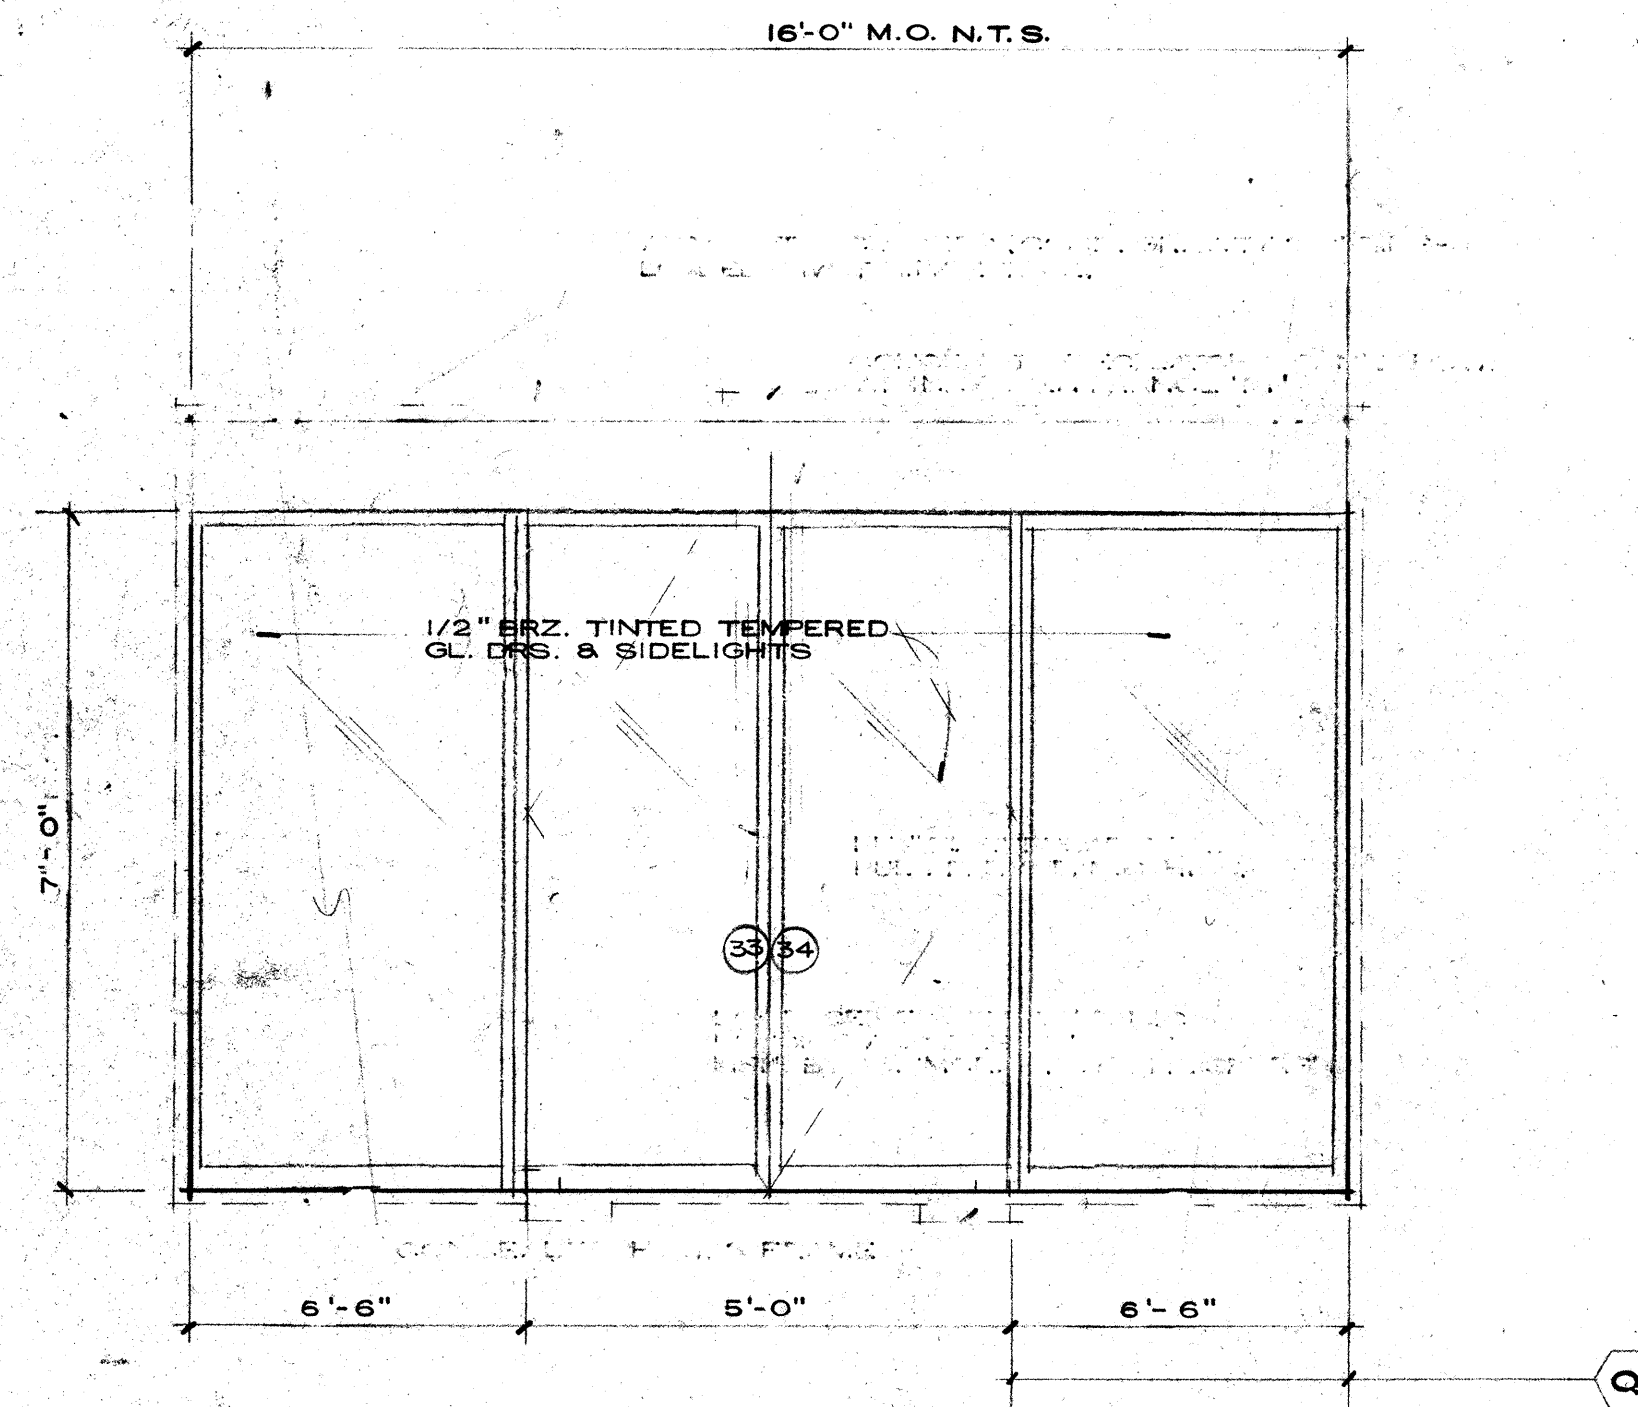

## ENTRANCE ELEVATIONS


SCALE: 1/2" = 1'-0"

2 / A22

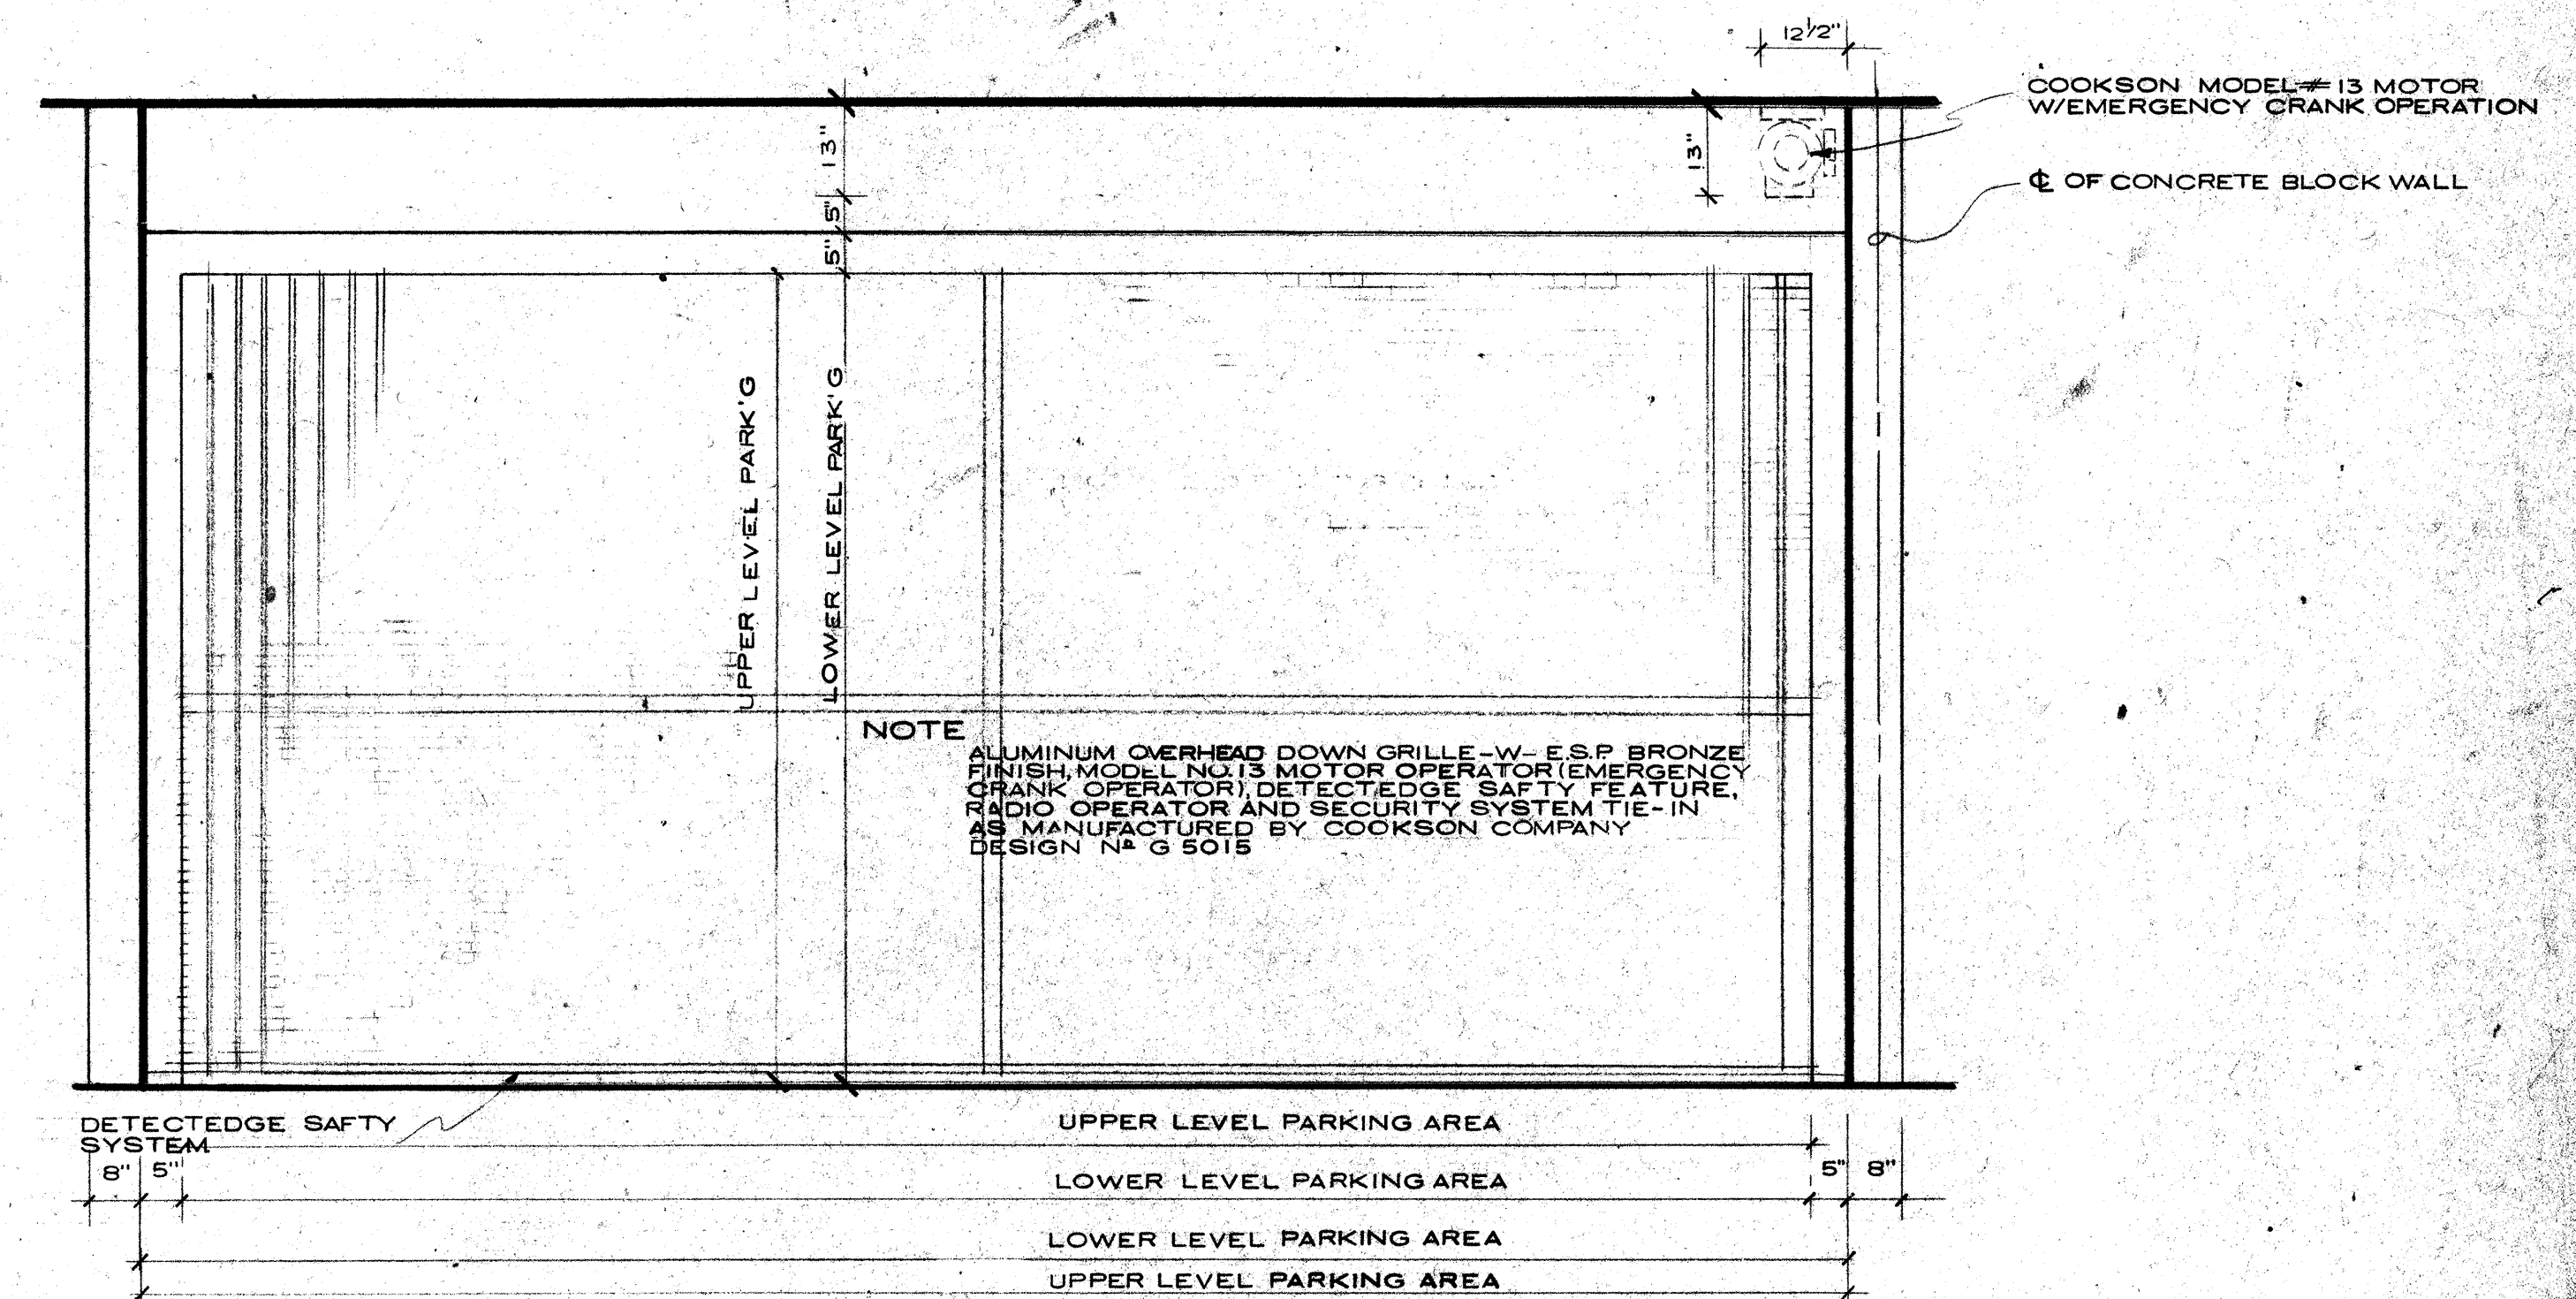

## OVERHD. SECURITY GRILLE 3/A22


SCALE: 1/2" = 1'-0"

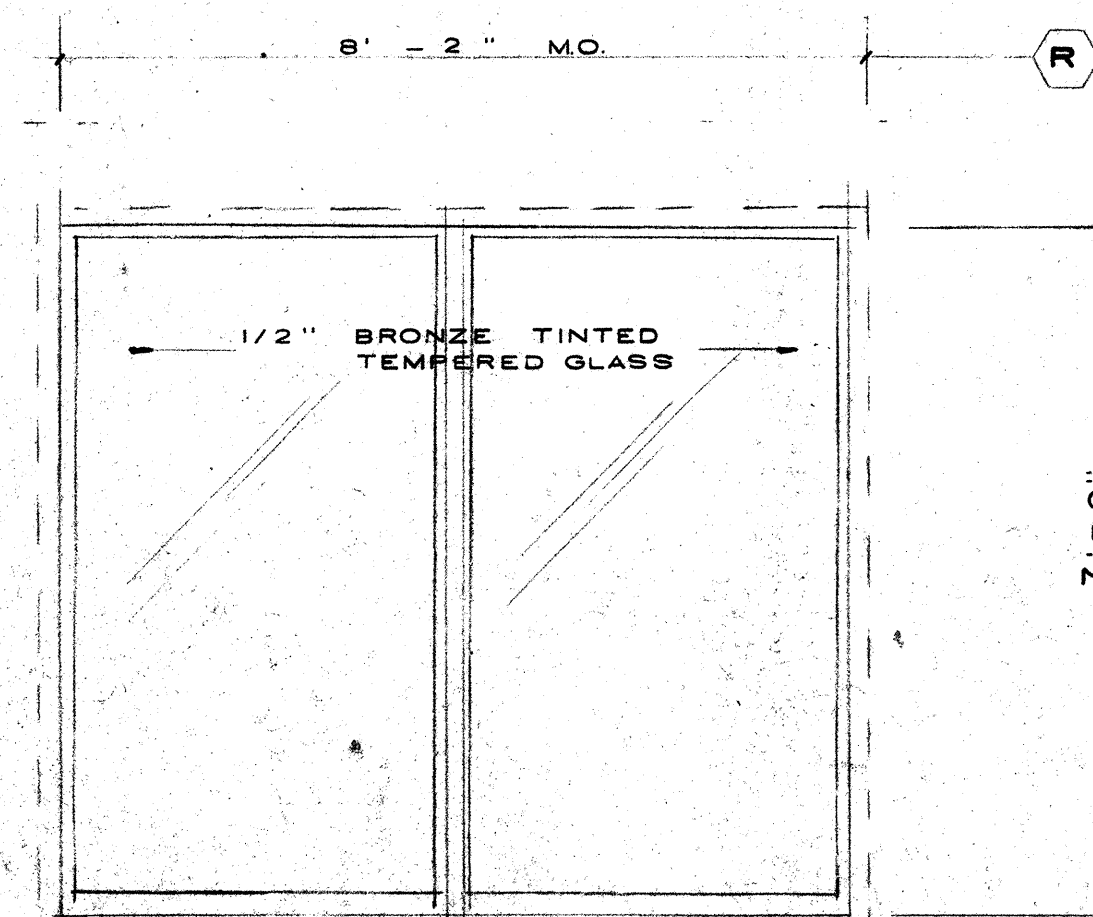

## WINDOW ELEVATIONS

SCALE: 1/2" = 1'-0"

4 / A22

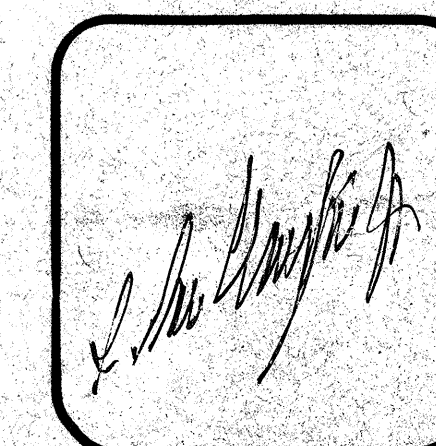

R. WM. CLAYTON JR. ARCHITECT  
1995 EAST OAKLAND PARK BLVD. FT. LAUDERDALE FLA

## OVERLOOK CONDOMINIUM

DOOR & WINDOW TYPES

DRAWN BY: LRK  
JOB NO: 8101  
DATE: 8-12-81  
REVISIONS: 6-11-84  
AS BUILT 2-8-88  
SHEET **A22**