


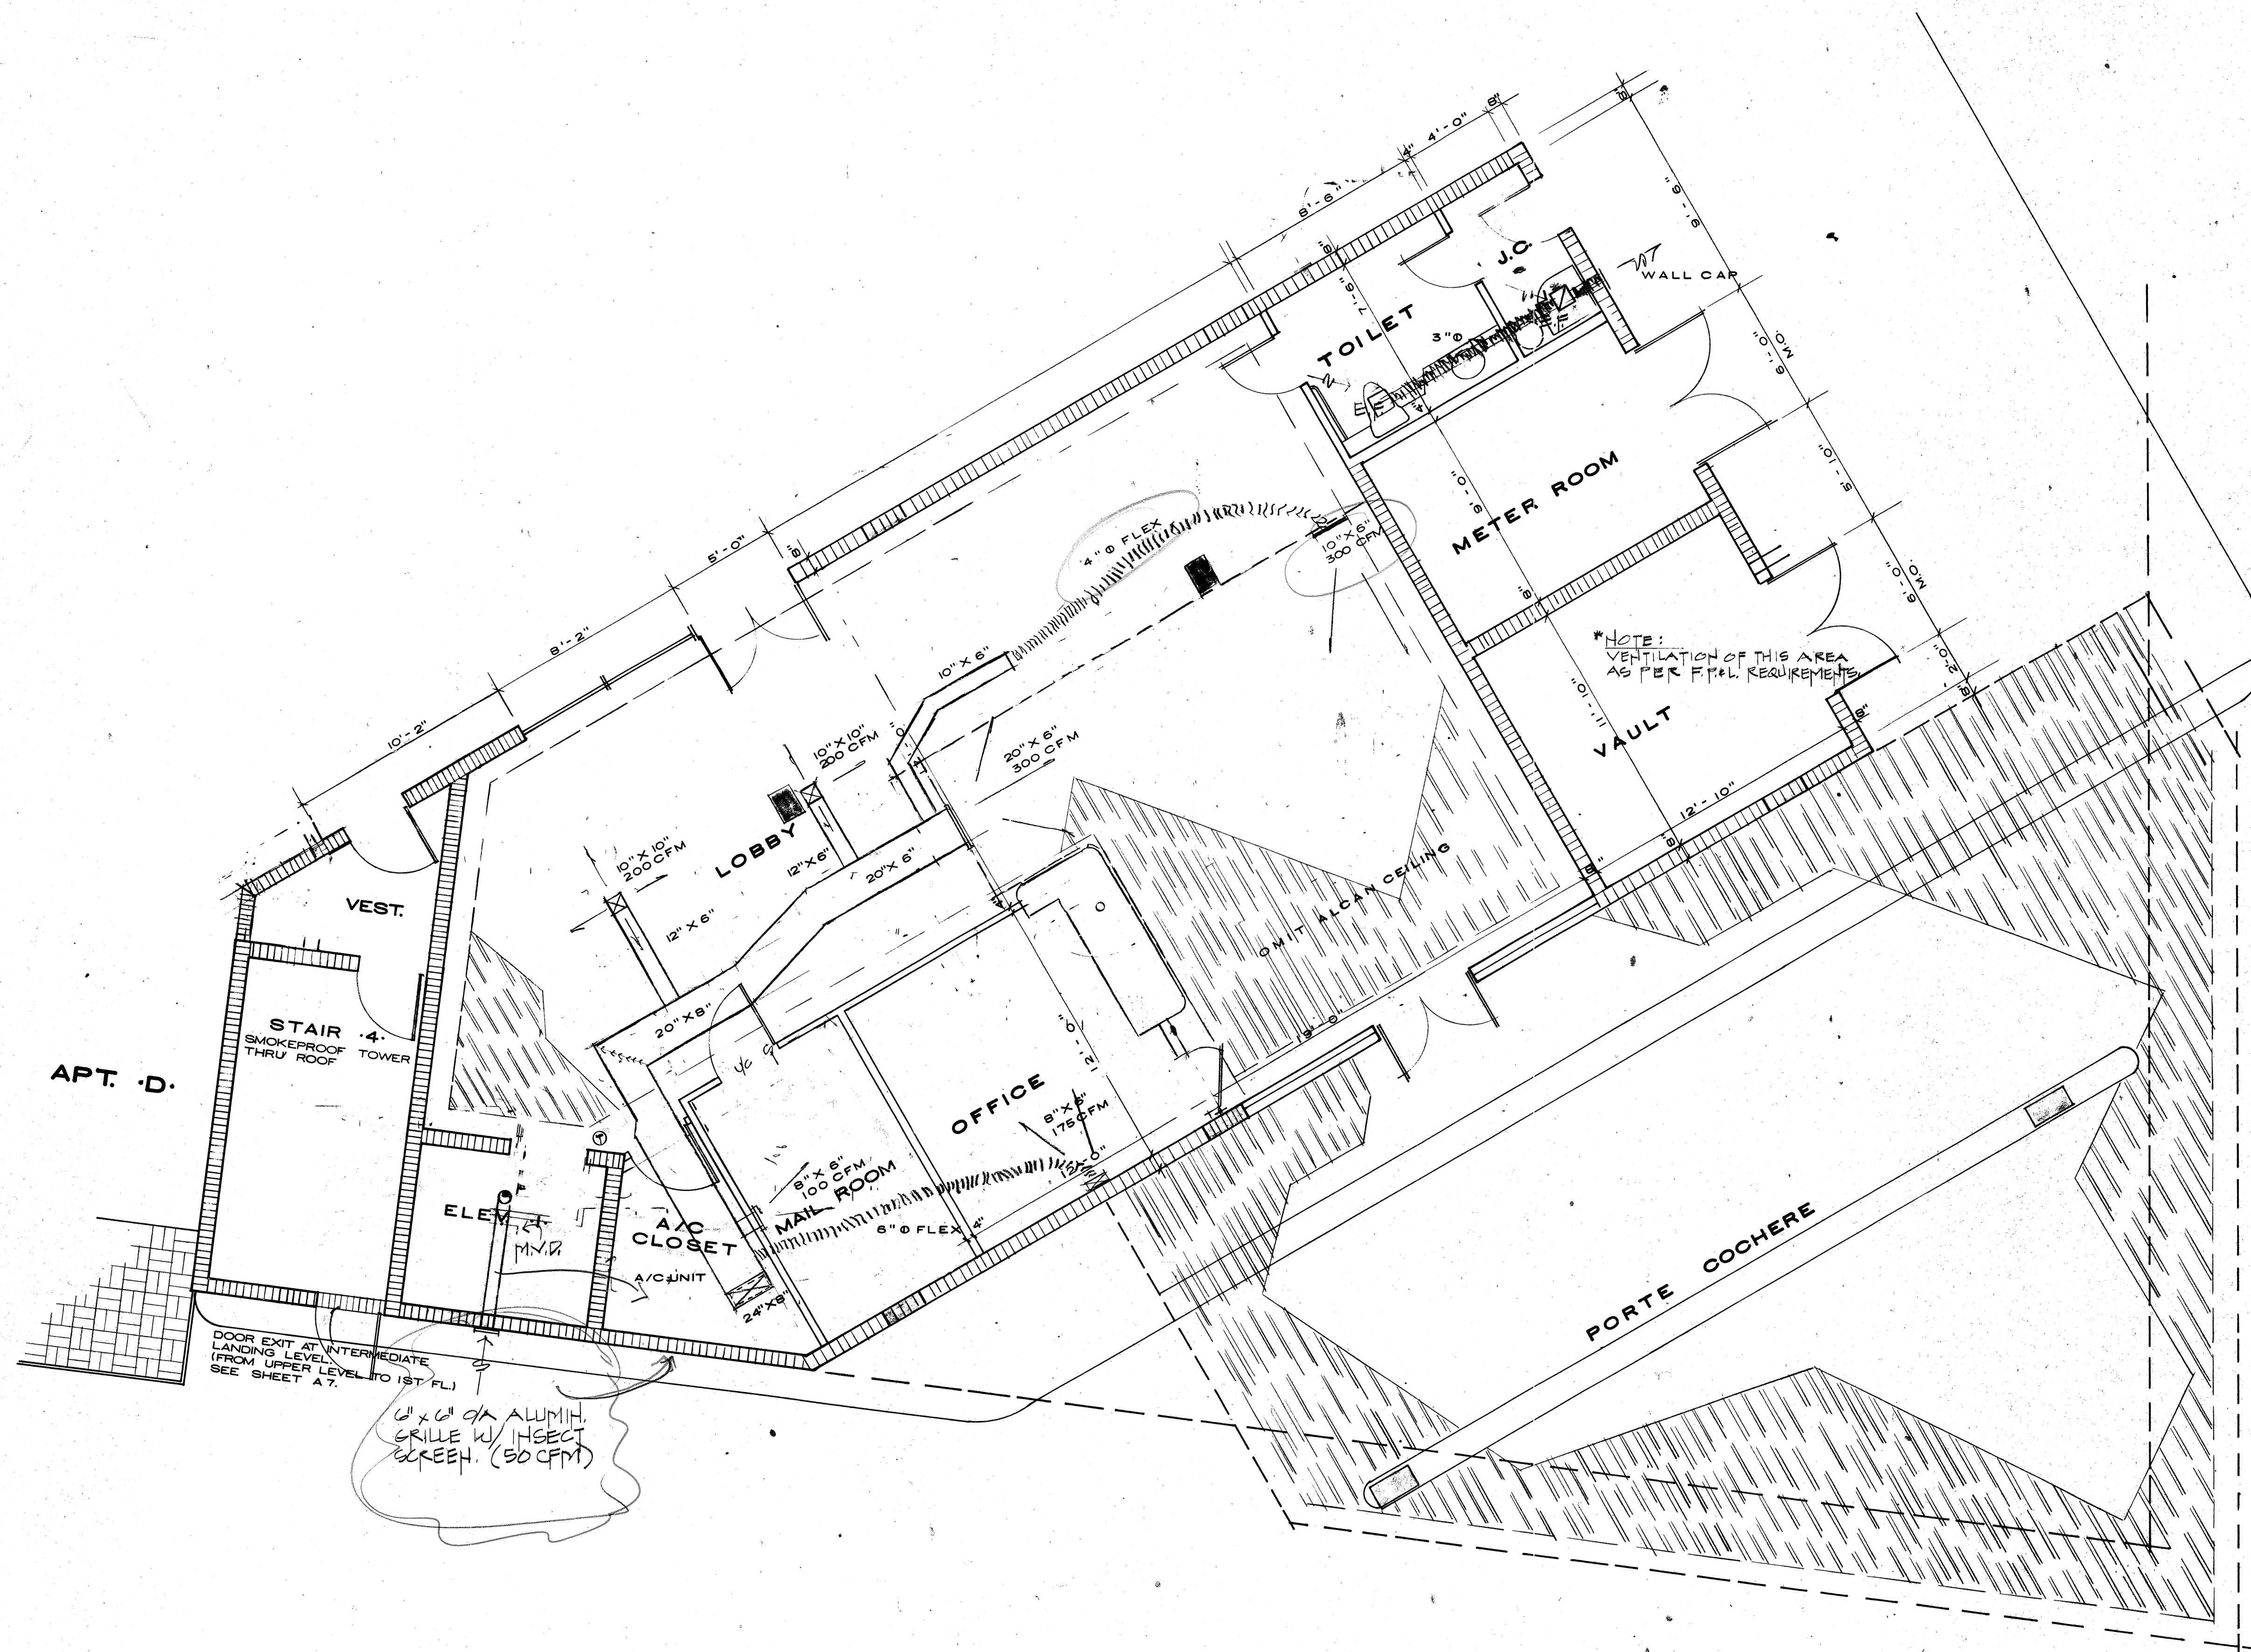

AIR CONDITIONING CONTRACTOR SHALL VERIFY STRUCTURAL
SYSTEM AND COORDINATE WITH ELECTRICAL AND PLUMBING
CONTRACTOR, PRIOR TO CONSTRUCTION.

Eugenio
3/3/88
Espinoza

R. WM. CLAYTON JR. ARCHITECT
1995 EAST OAKLAND PARK BLVD. FT. LAUDERDALE, FLA.
E & E CONSULTING ENGINEERS
2701 EAST SUNRISE BLVD. FT. LAUDERDALE, FLA.
OVERLOOK CONDOMINIUM

DRAWN BY: P.L.H.
JOB NO. 8101
DATE: 8-12-81
REVISIONS: 6-11-84
AS BUILT 2-8
SHEET **A**