



R O O M						F I N I S H												S C H E D U L E													
AREA IDENTIFICATION		FLOOR						BASE				WALLS				WAINSCOT MATERIAL		HT.	CEILING MATERIAL						HT.	REMARKS					
		CONCRETE	RESILIENT SHEET VINYL	MARBLE	1"X2" CERAMIC TILE	CARPET	1/2" WOOD (PRIMED)	NONE	1"X2" CERAMIC TILE	VINYL COVE		PRIMED DRYWALL	WOOD TO CEILING	WALLS	PAINTED CONCRETE BLOCK	1"X2" CERAMIC TILE	SUEDE VINYL	PTD DRYWALL	WALL PAPER (WHERE NO MARBLE)	NONE		SIM. ACOUSTICAL PLASTER W/ DIAMOND DUST	DROPPED 2"X2" WOOD FRAMED LUMINOUS CLG	PRIMED DRYWALL	PAINTED CONCRETE	ALCAN' METAL CLG.	PAINTED DRYWALL	SUSPENDED 2"X4" TILE IN ACOUSTICAL			
	LIVING ROOM	•					•					•									•		•							8'-0"	
	MASTER BEDROOM	•					•					•									•		•							8'-0"	
	BEDROOM II	•					•					•									•		•							8'-0"	
	BEDROOM III (APTS. A,E,&H)	•					•					•									•		•							8'-0"	
	KITCHEN	•	•				•					•									•		•							7'-0"	
	DINING ROOM	•					•					•									•		•							7'-0"	
	BREAKFAST ROOM		•				•					•	•								•		•							7'-0"	
	BATH			•				•						•							•		•							7'-0"	
	BATH II			•				•						•							•		•							7'-0"	
	POWDER ROOM			•				•						•							•		•							7'-0"	
	DRESSING ROOM			•				•						•							•		•							7'-0"	
	FOYER			•				•						•							•		•							7'-0"	
	CLOSETS	•					•					•									•			•						7'-0"	
	WASHER/DRYER CLOSET	•					•					•									•			•						7'-0"	
	AIR CONDITIONER CLOSET	•					•					•									•			•						7'-0"	
	WATER HEATER CLOSET	•					•					•									•			•						7'-0"	
	BATH III (APT. E ONLY)			•				•						•							•		•							7'-0"	
	STAIR TOWERS (1,2,&3)	•						•						•							•					•				VARIES	
	STORAGE ROOMS (1 THRU 6)	•						•						•							•					•				VARIES	
	TENANT STORAGE ROOMS (1 THRU 4)	•						•						•							•					•				VARIES	
	TRANSFORMER VAULT	•						•						•							•					•				10'-0"	
	METER ROOMS (1,2,&3)	•						•						•							•					•				VARIES	
	TRASH ROOMS (1 & 2)	•						•						•							•					•				10'-0"	
	TRASH CHUTE VESTIBULES (1 & 2)	•						•						•							•					•				VARIES	
	POOL EQUIPMENT ROOM	•						•						•							•					•				9'-6"	
	PUMP ROOM I	•						•						•							•					•				8'-4"	
	LOBBY			•				•						•							•					•				8'-0"	
	LOBBY TOILET			•				•						•							•					•				7'-0"	
	LOBBY JANITOR CLOSET	•						•						•							•					•				8'-0"	
	LOBBY VESTIBULE							•						•							•					•				8'-0"	
	MANAGERS OFFICE							•						•							•					•				8'-0"	
	MAIL ROOM		•							•				•							•					•				8'-0"	

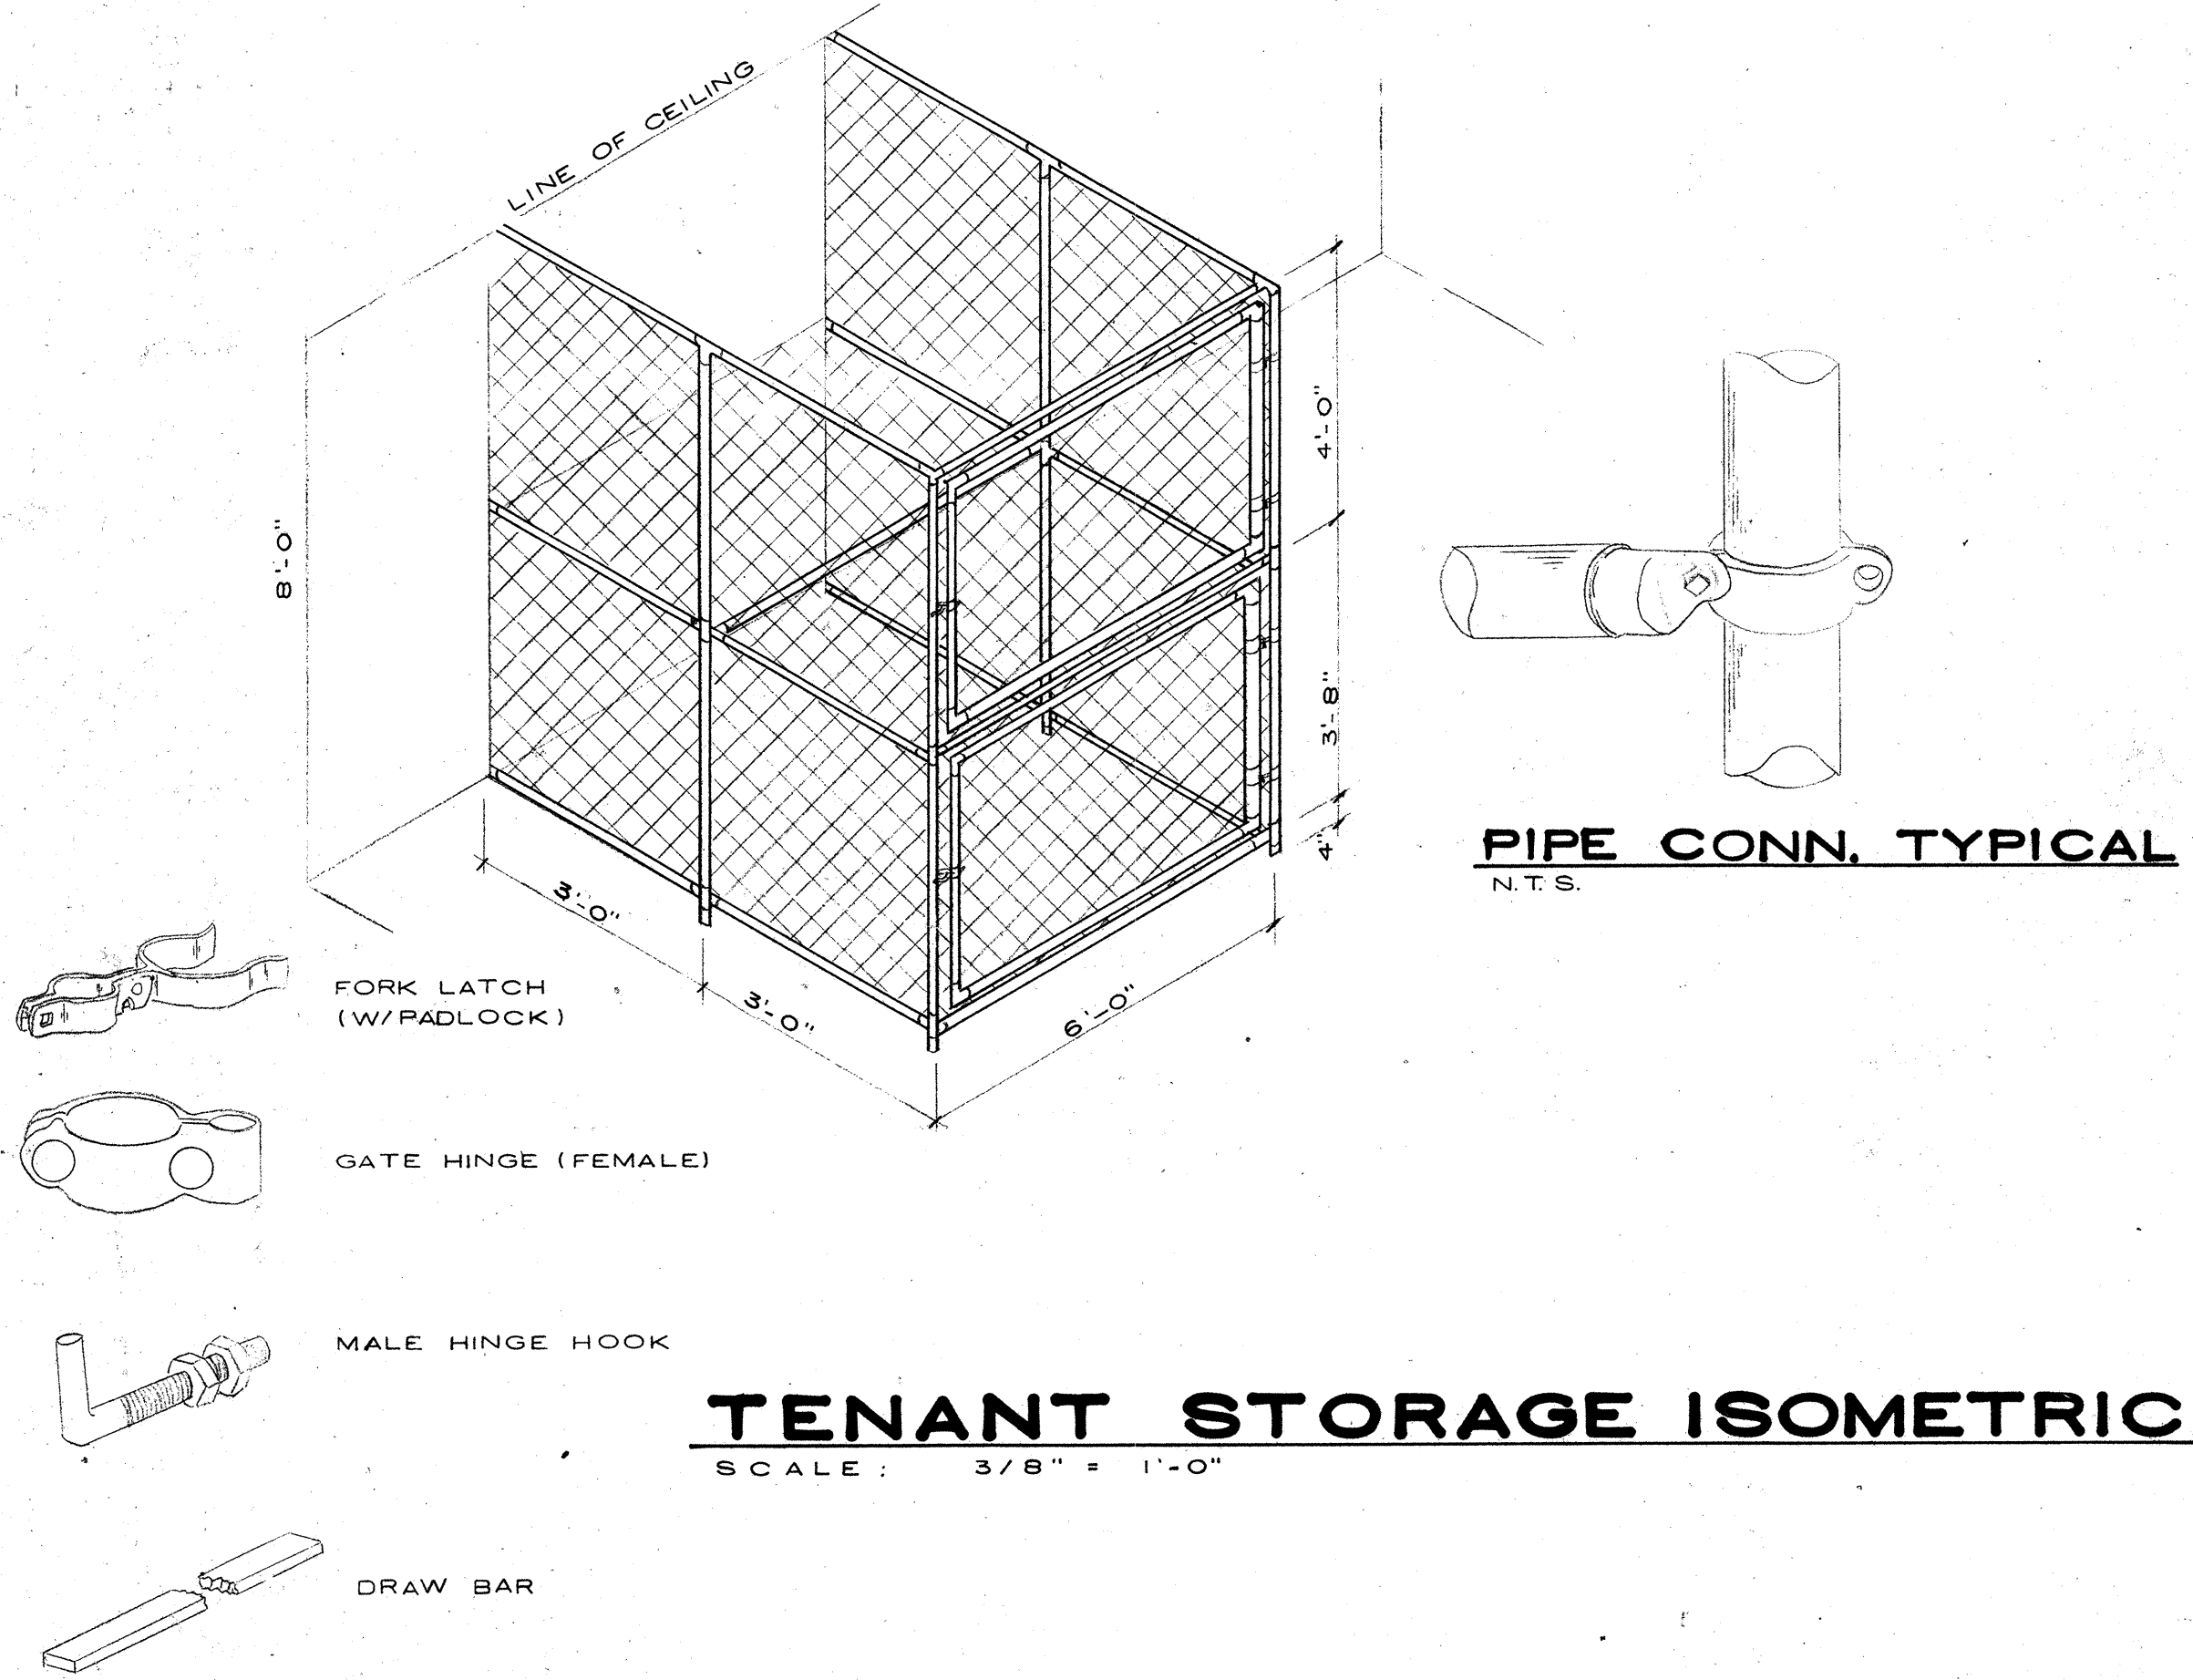

TENANT STORAGE ISOMETRIC

SCALE: 3/8" = 1'-0"

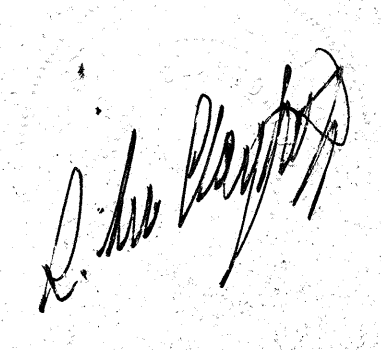

R. WM. CLAYTON JR. ARCHITECT
1995 EAST OAKLAND PARK BLVD. FT. LAUDERDALE, FLA.

OVERLOOK CONDOMINIUM

ROOM FINISH SCHED., TEN. STOR.
ISO., HOT TUB ISOMETRIC & PLAN

DRAWN BY: WPS, JAS
JOB NO.: 8101
DATE: 8-12-81
REVISIONS: 6-11-84

AS BUILT 2-8-88

SHEET: **A23**