



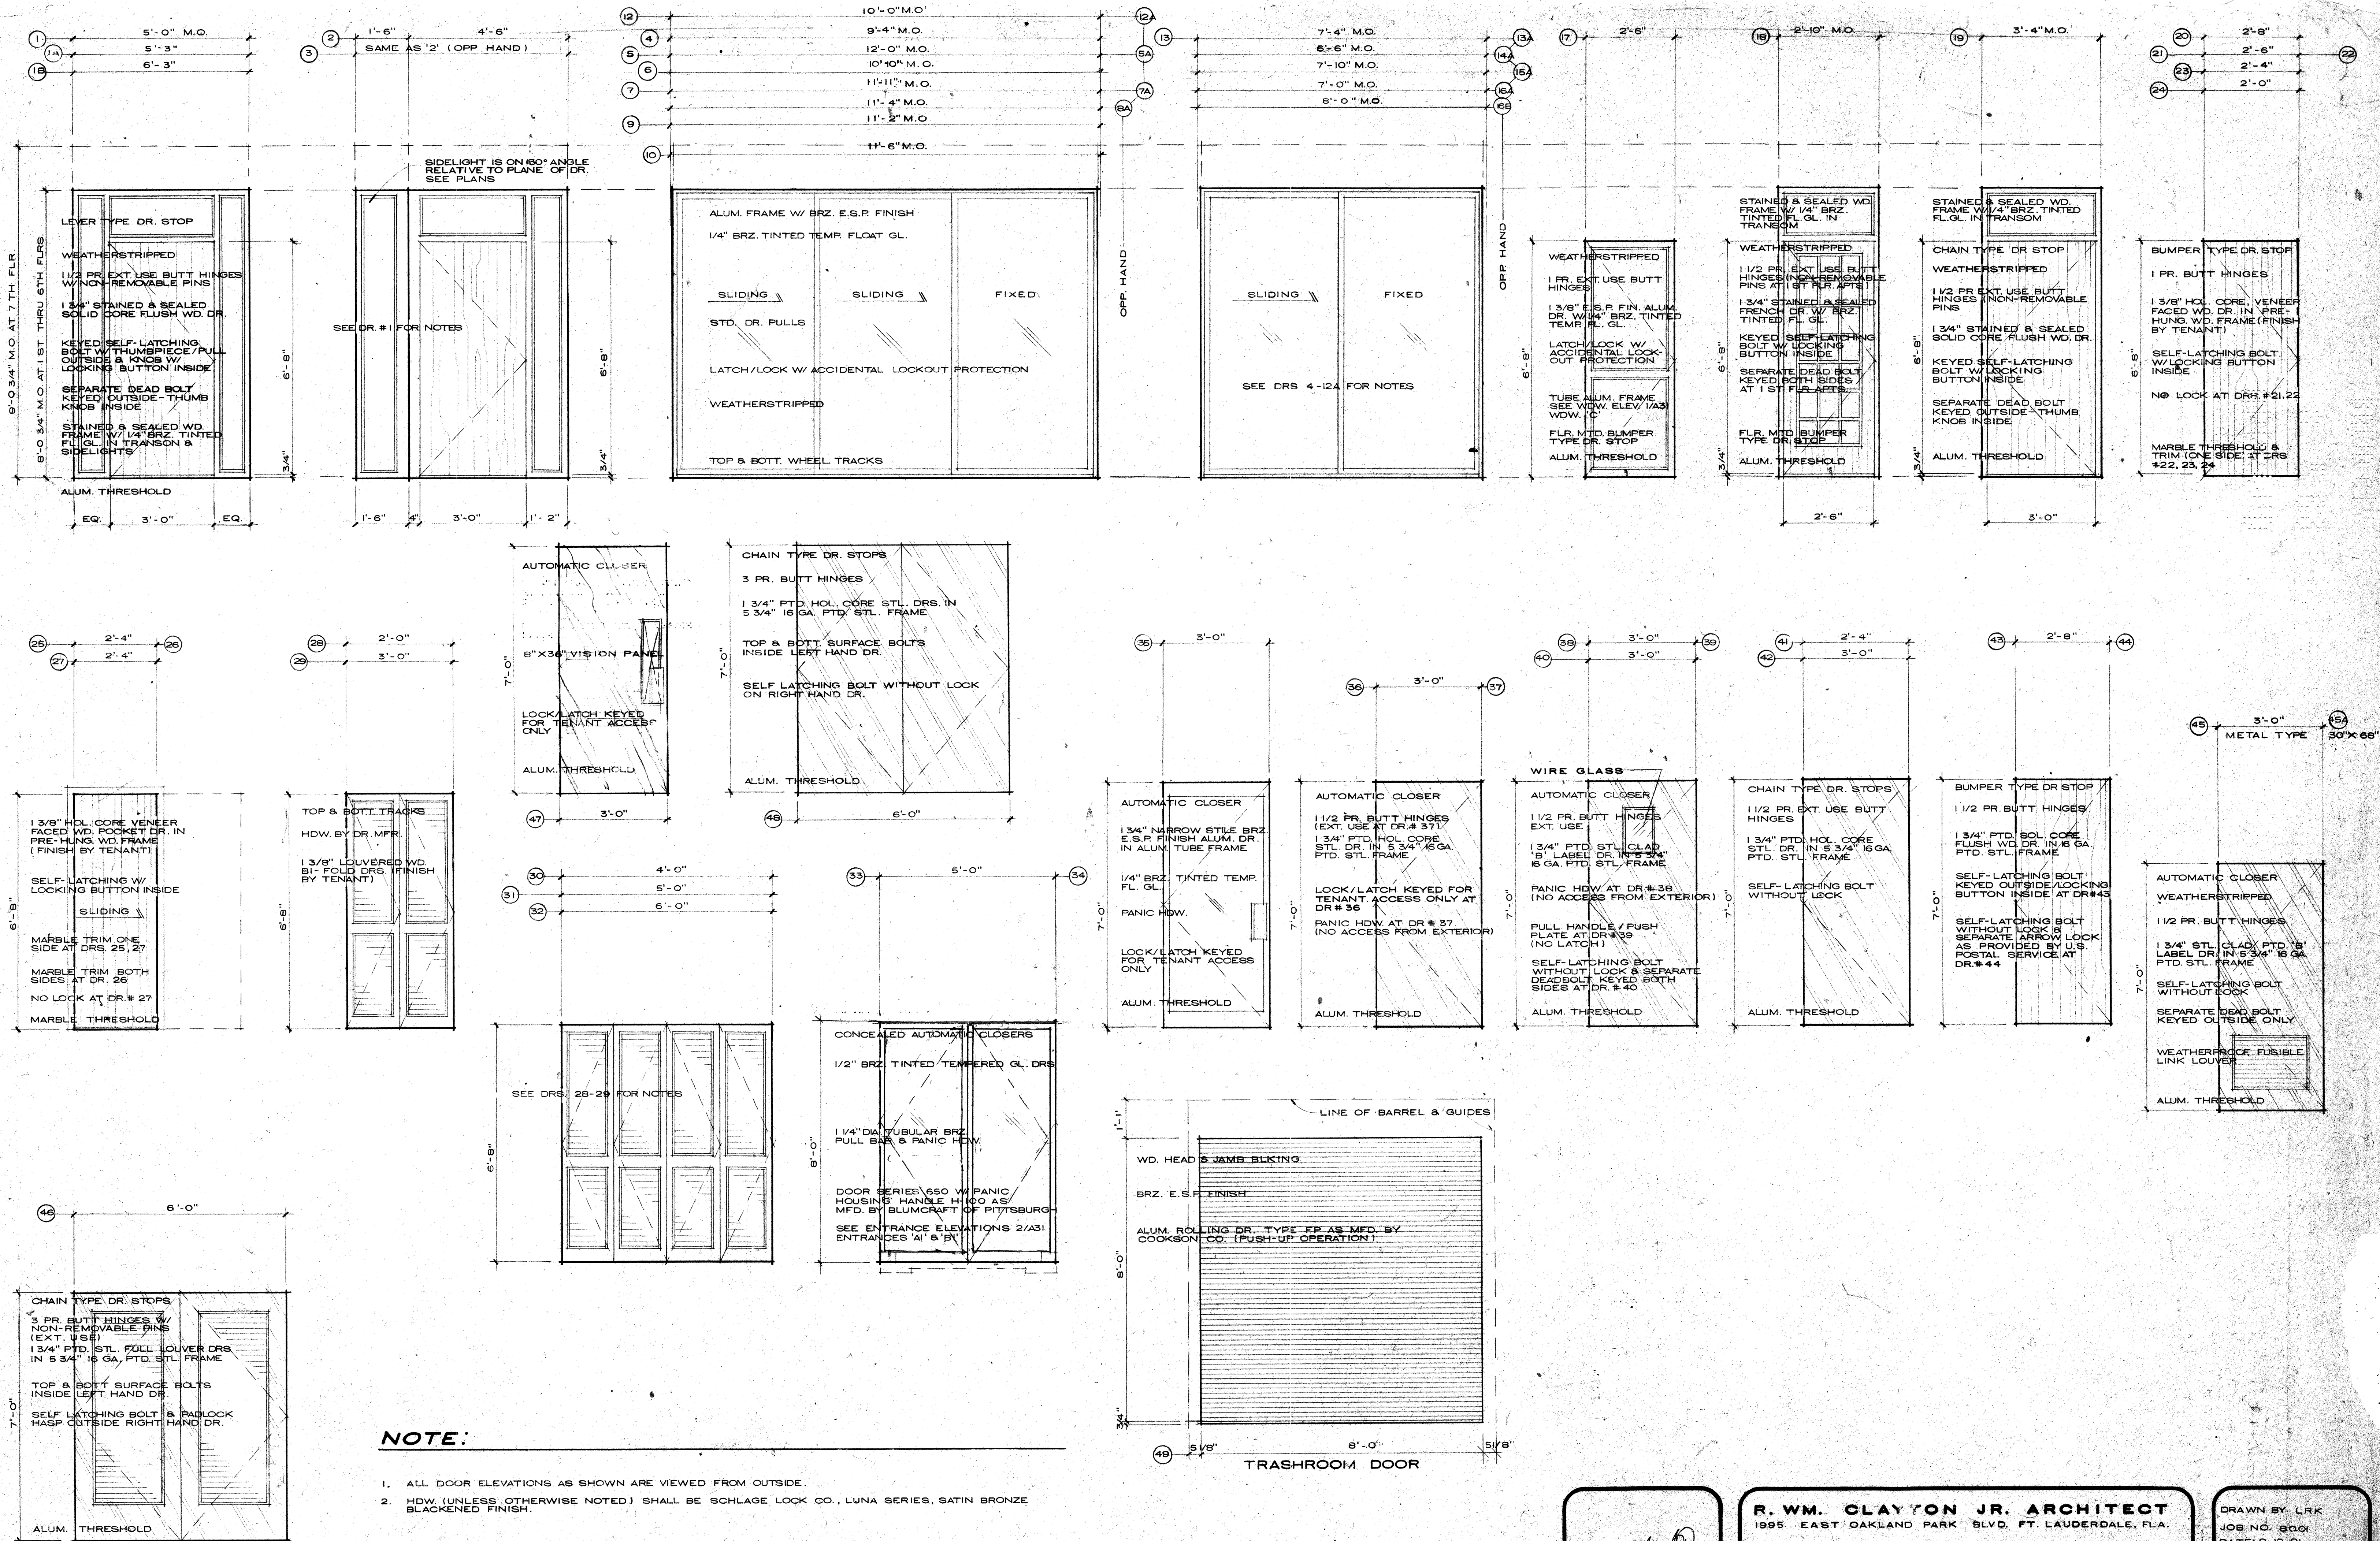

DOOR SCHEDULE

SCALE: 1/2" = 1' - 0"

1/A24

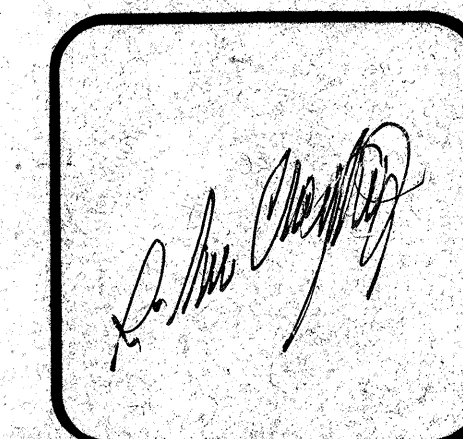

R. WM. CLAYTON JR. ARCHITECT
1995 EAST OAKLAND PARK BLVD. FT. LAUDERDALE, FLA.

OVERLOOK CONDOMINIUM

DOOR SCHEDULE

DRAWN BY L.R.K.
JOB NO. 8601
DATE: 8-12-91
REVISIONS: 6-11-94
AS BUILT 2-8-98
SHEET **A24**