



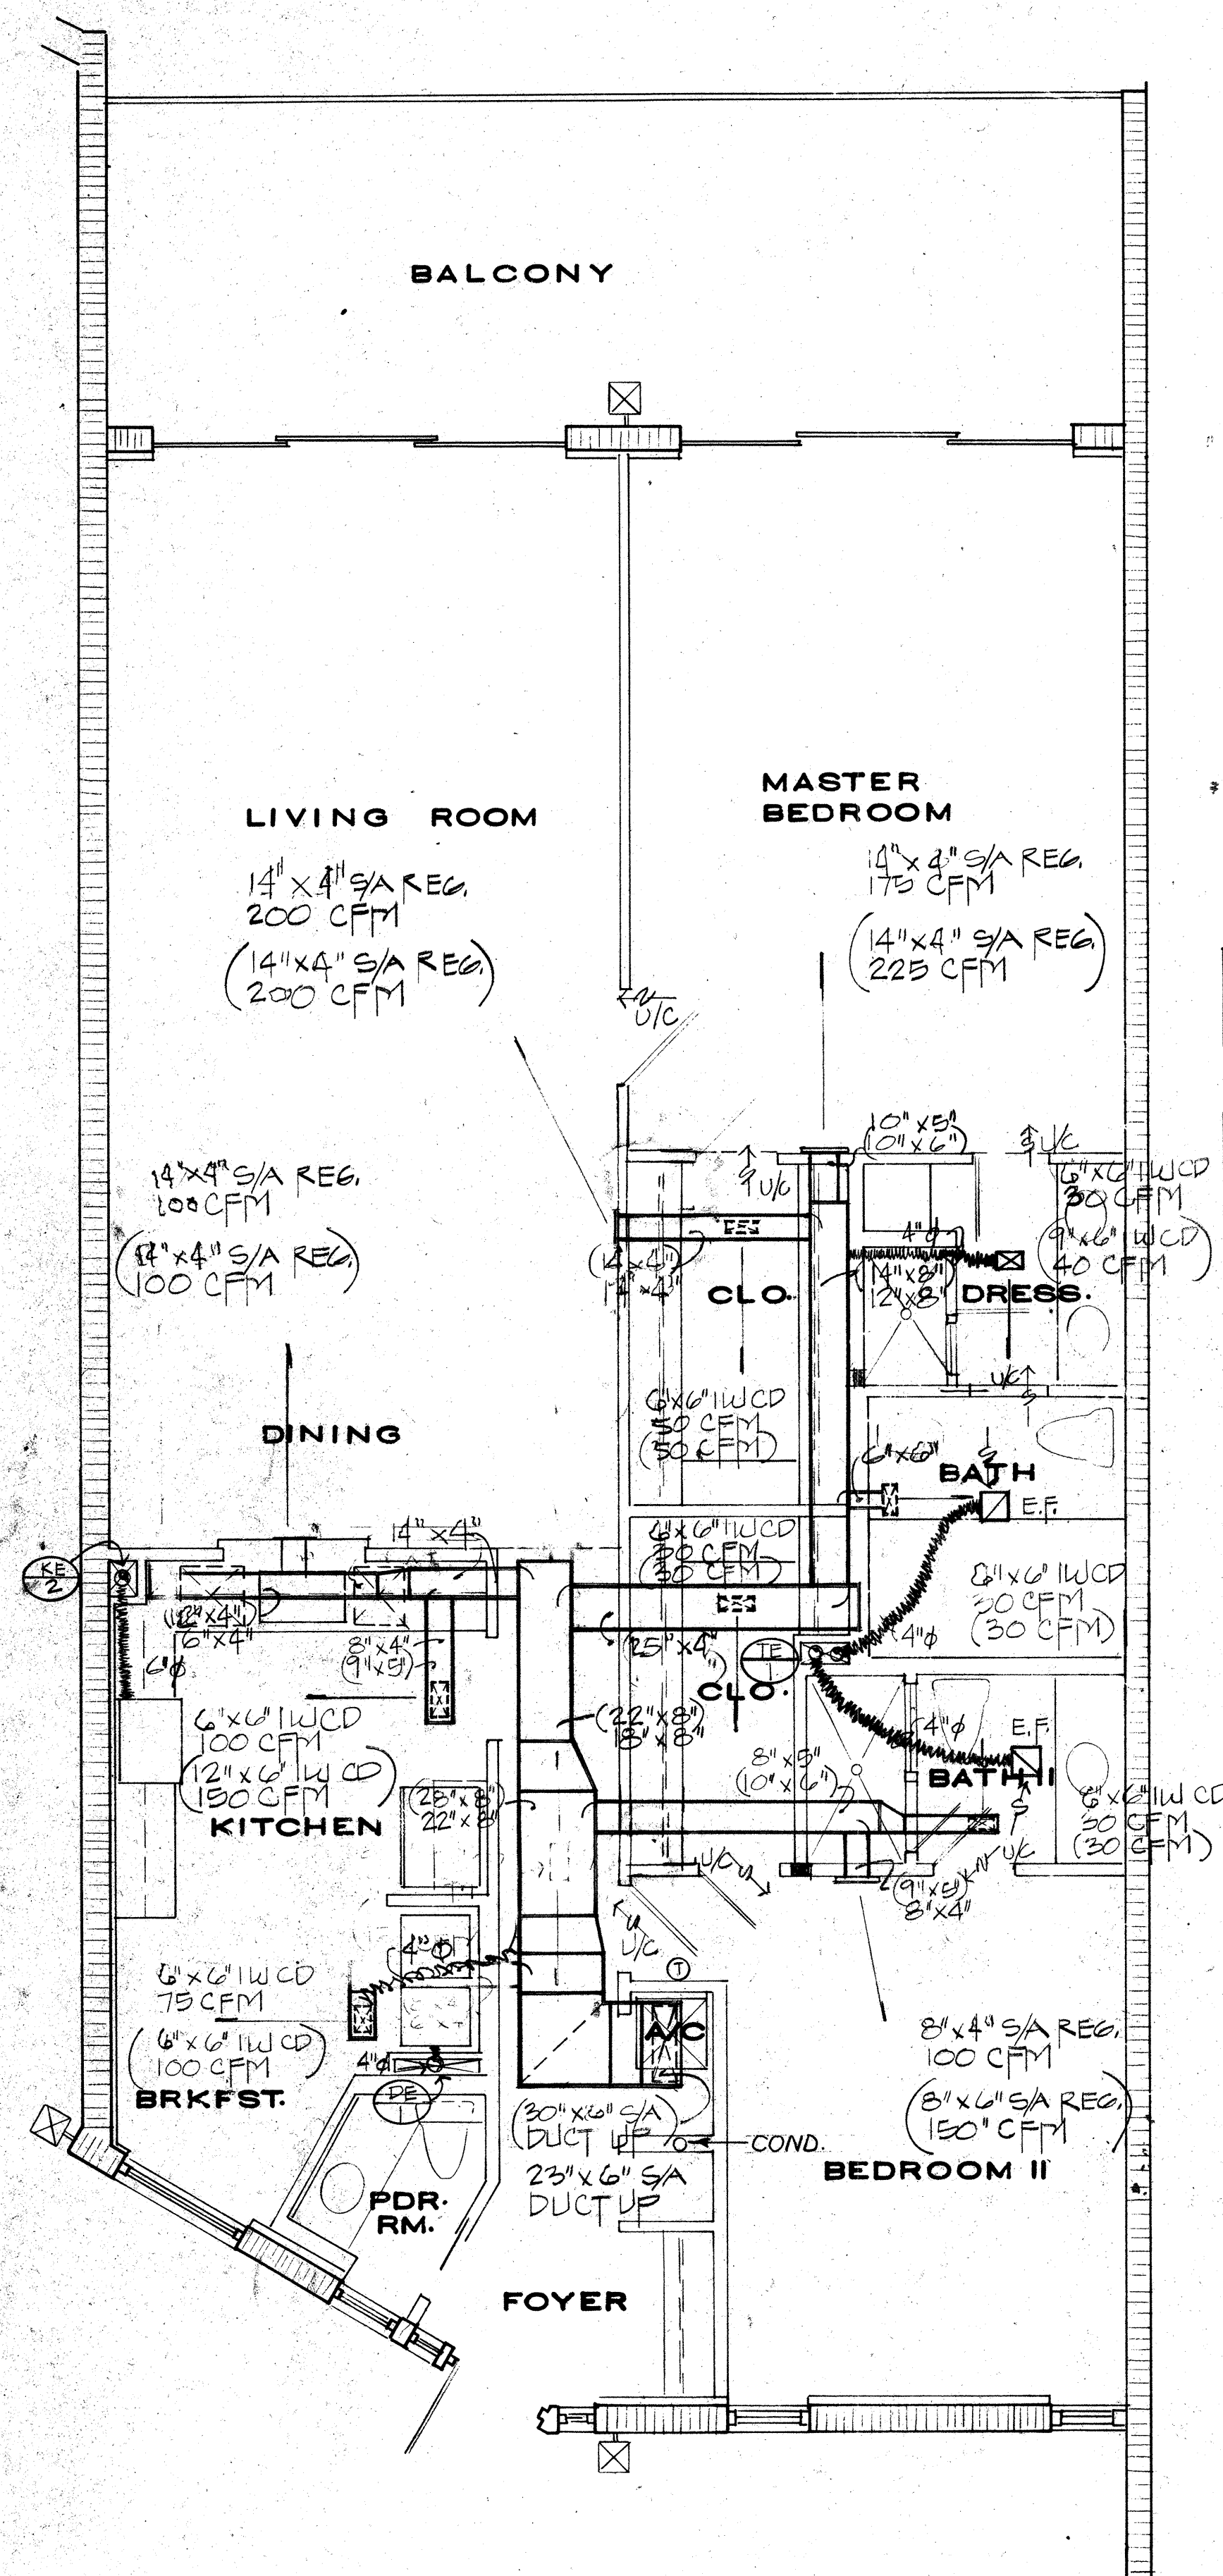

FLOOR PLAN APT. **B**

SCALE: 1/4" = 1'-0"

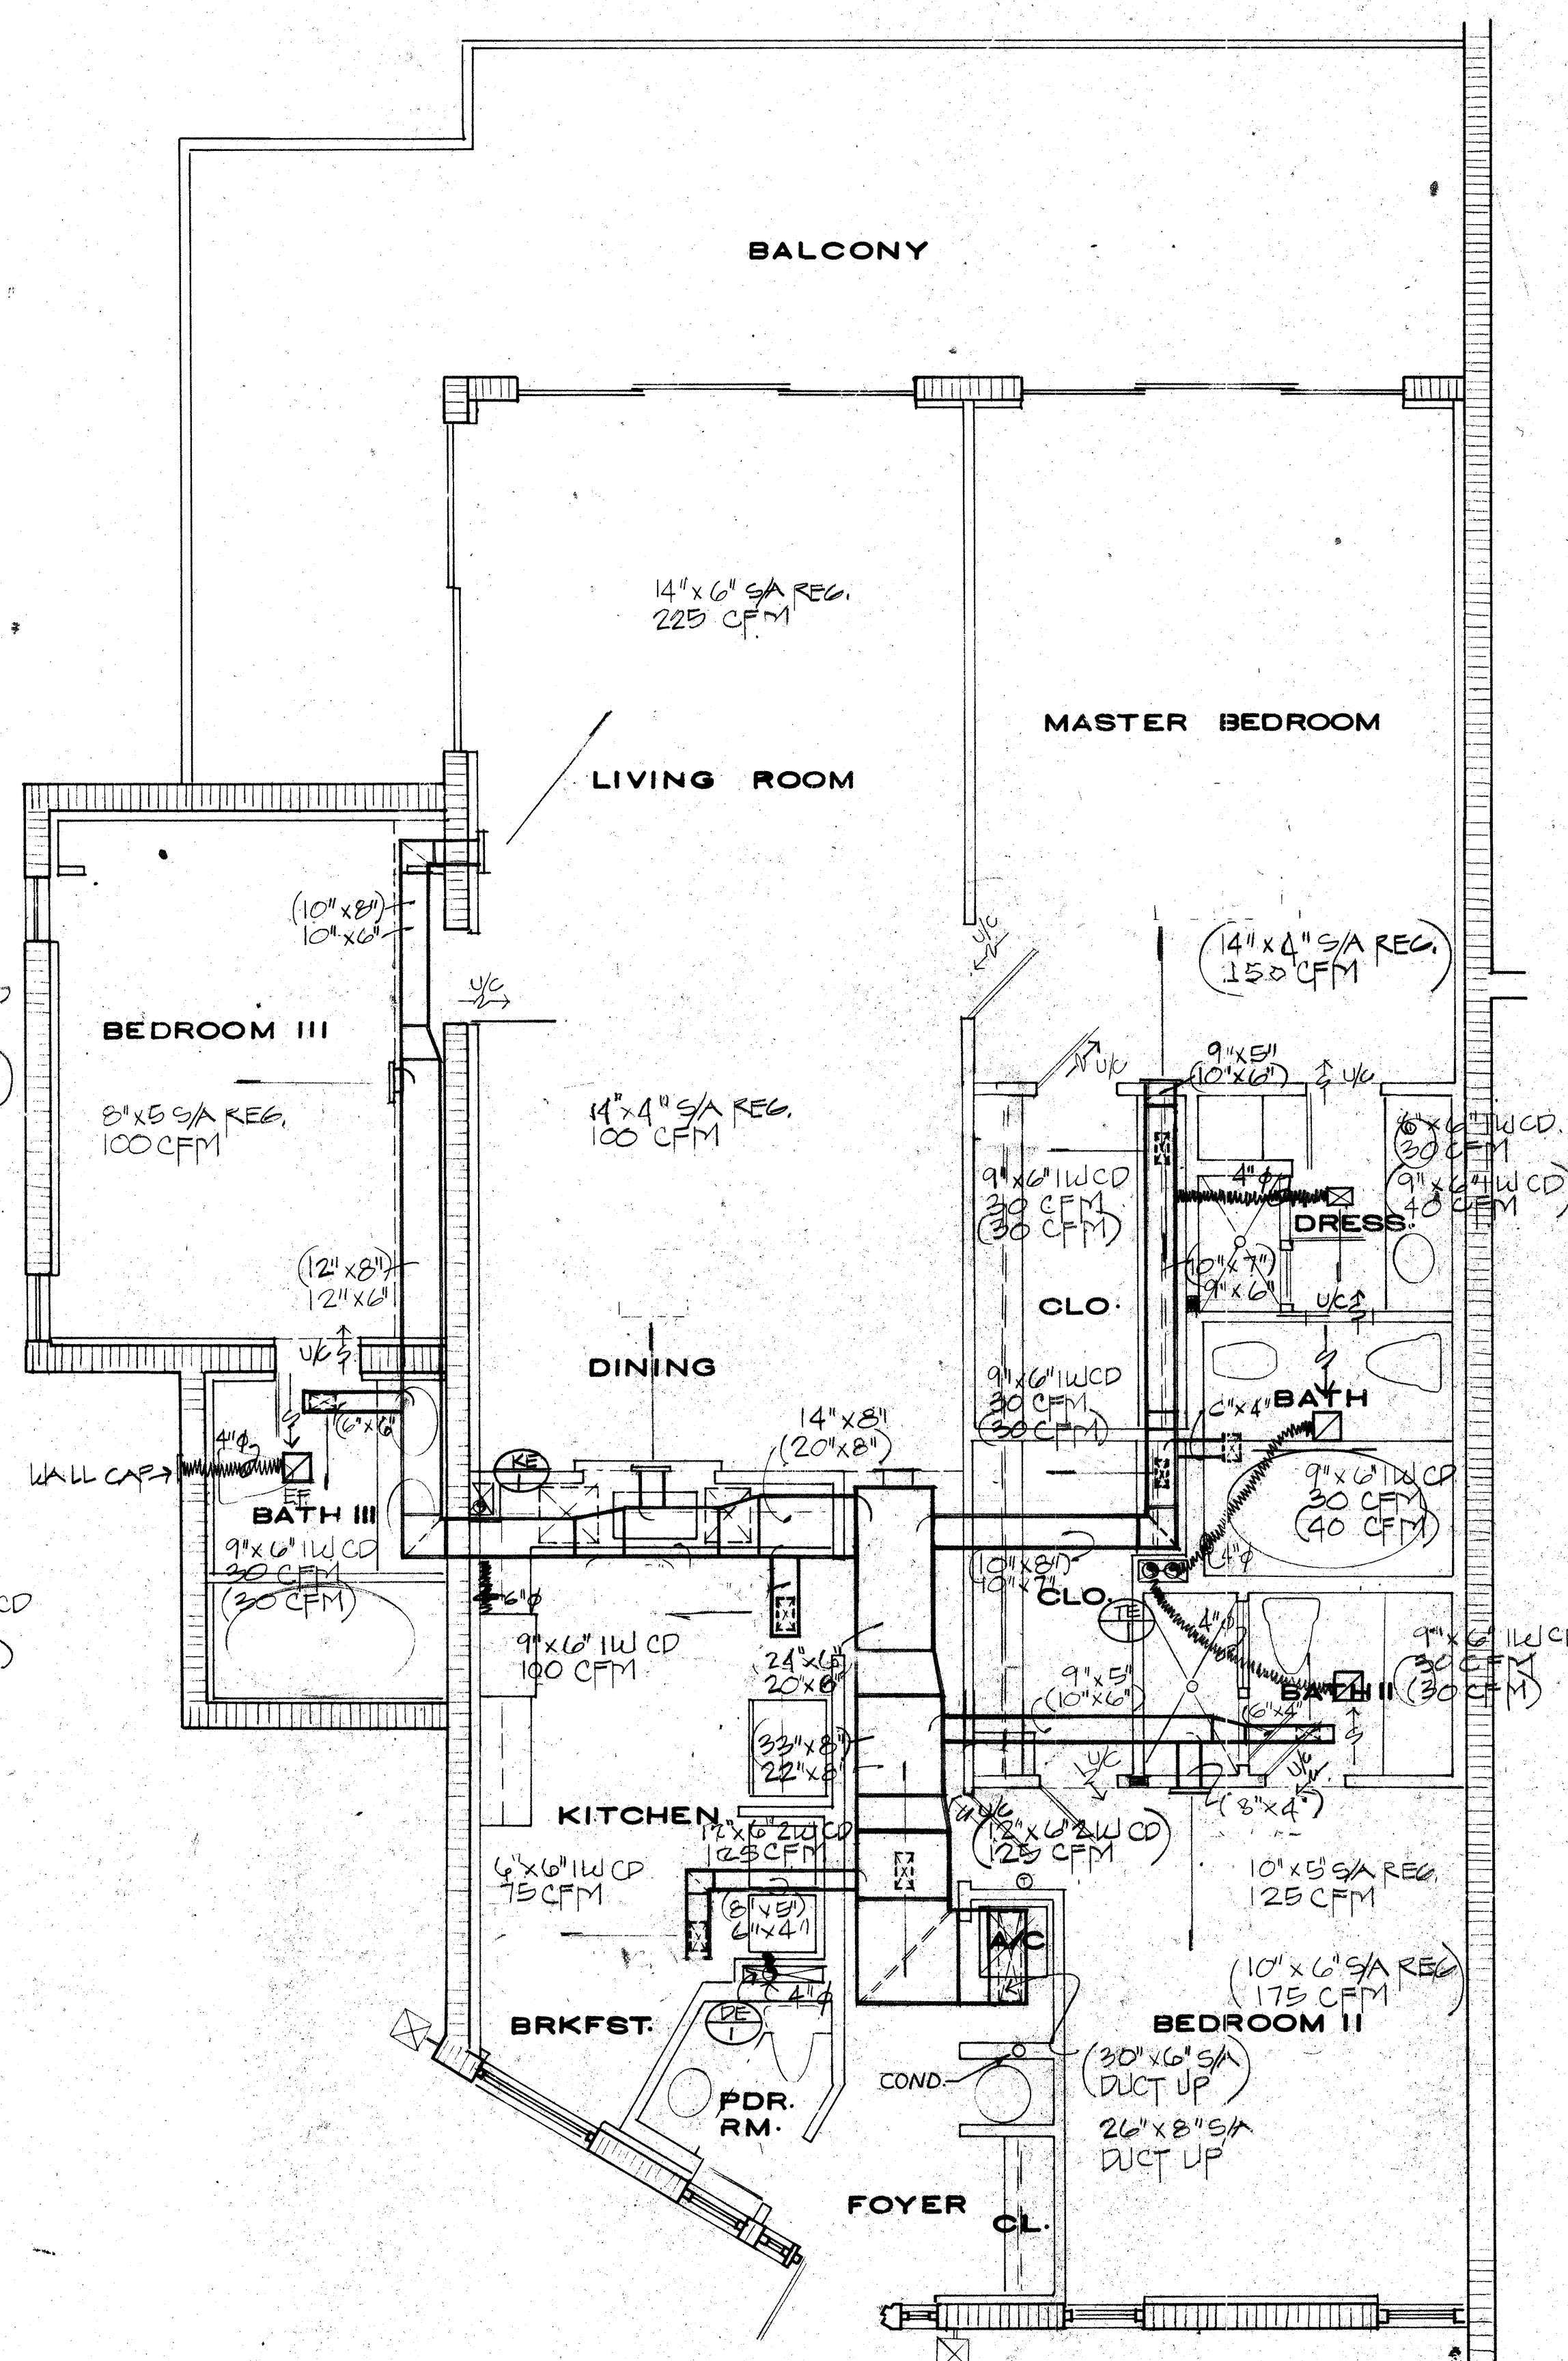


FLOOR PLAN APT. **C**

SCALE: 1/4" = 1'-0"

* NOTE:

1. () INDICATE CFM FOR TOP FLOOR ONLY.
2. PROVIDE FULL LOUVER DOOR FOR A/C CLOSETS.

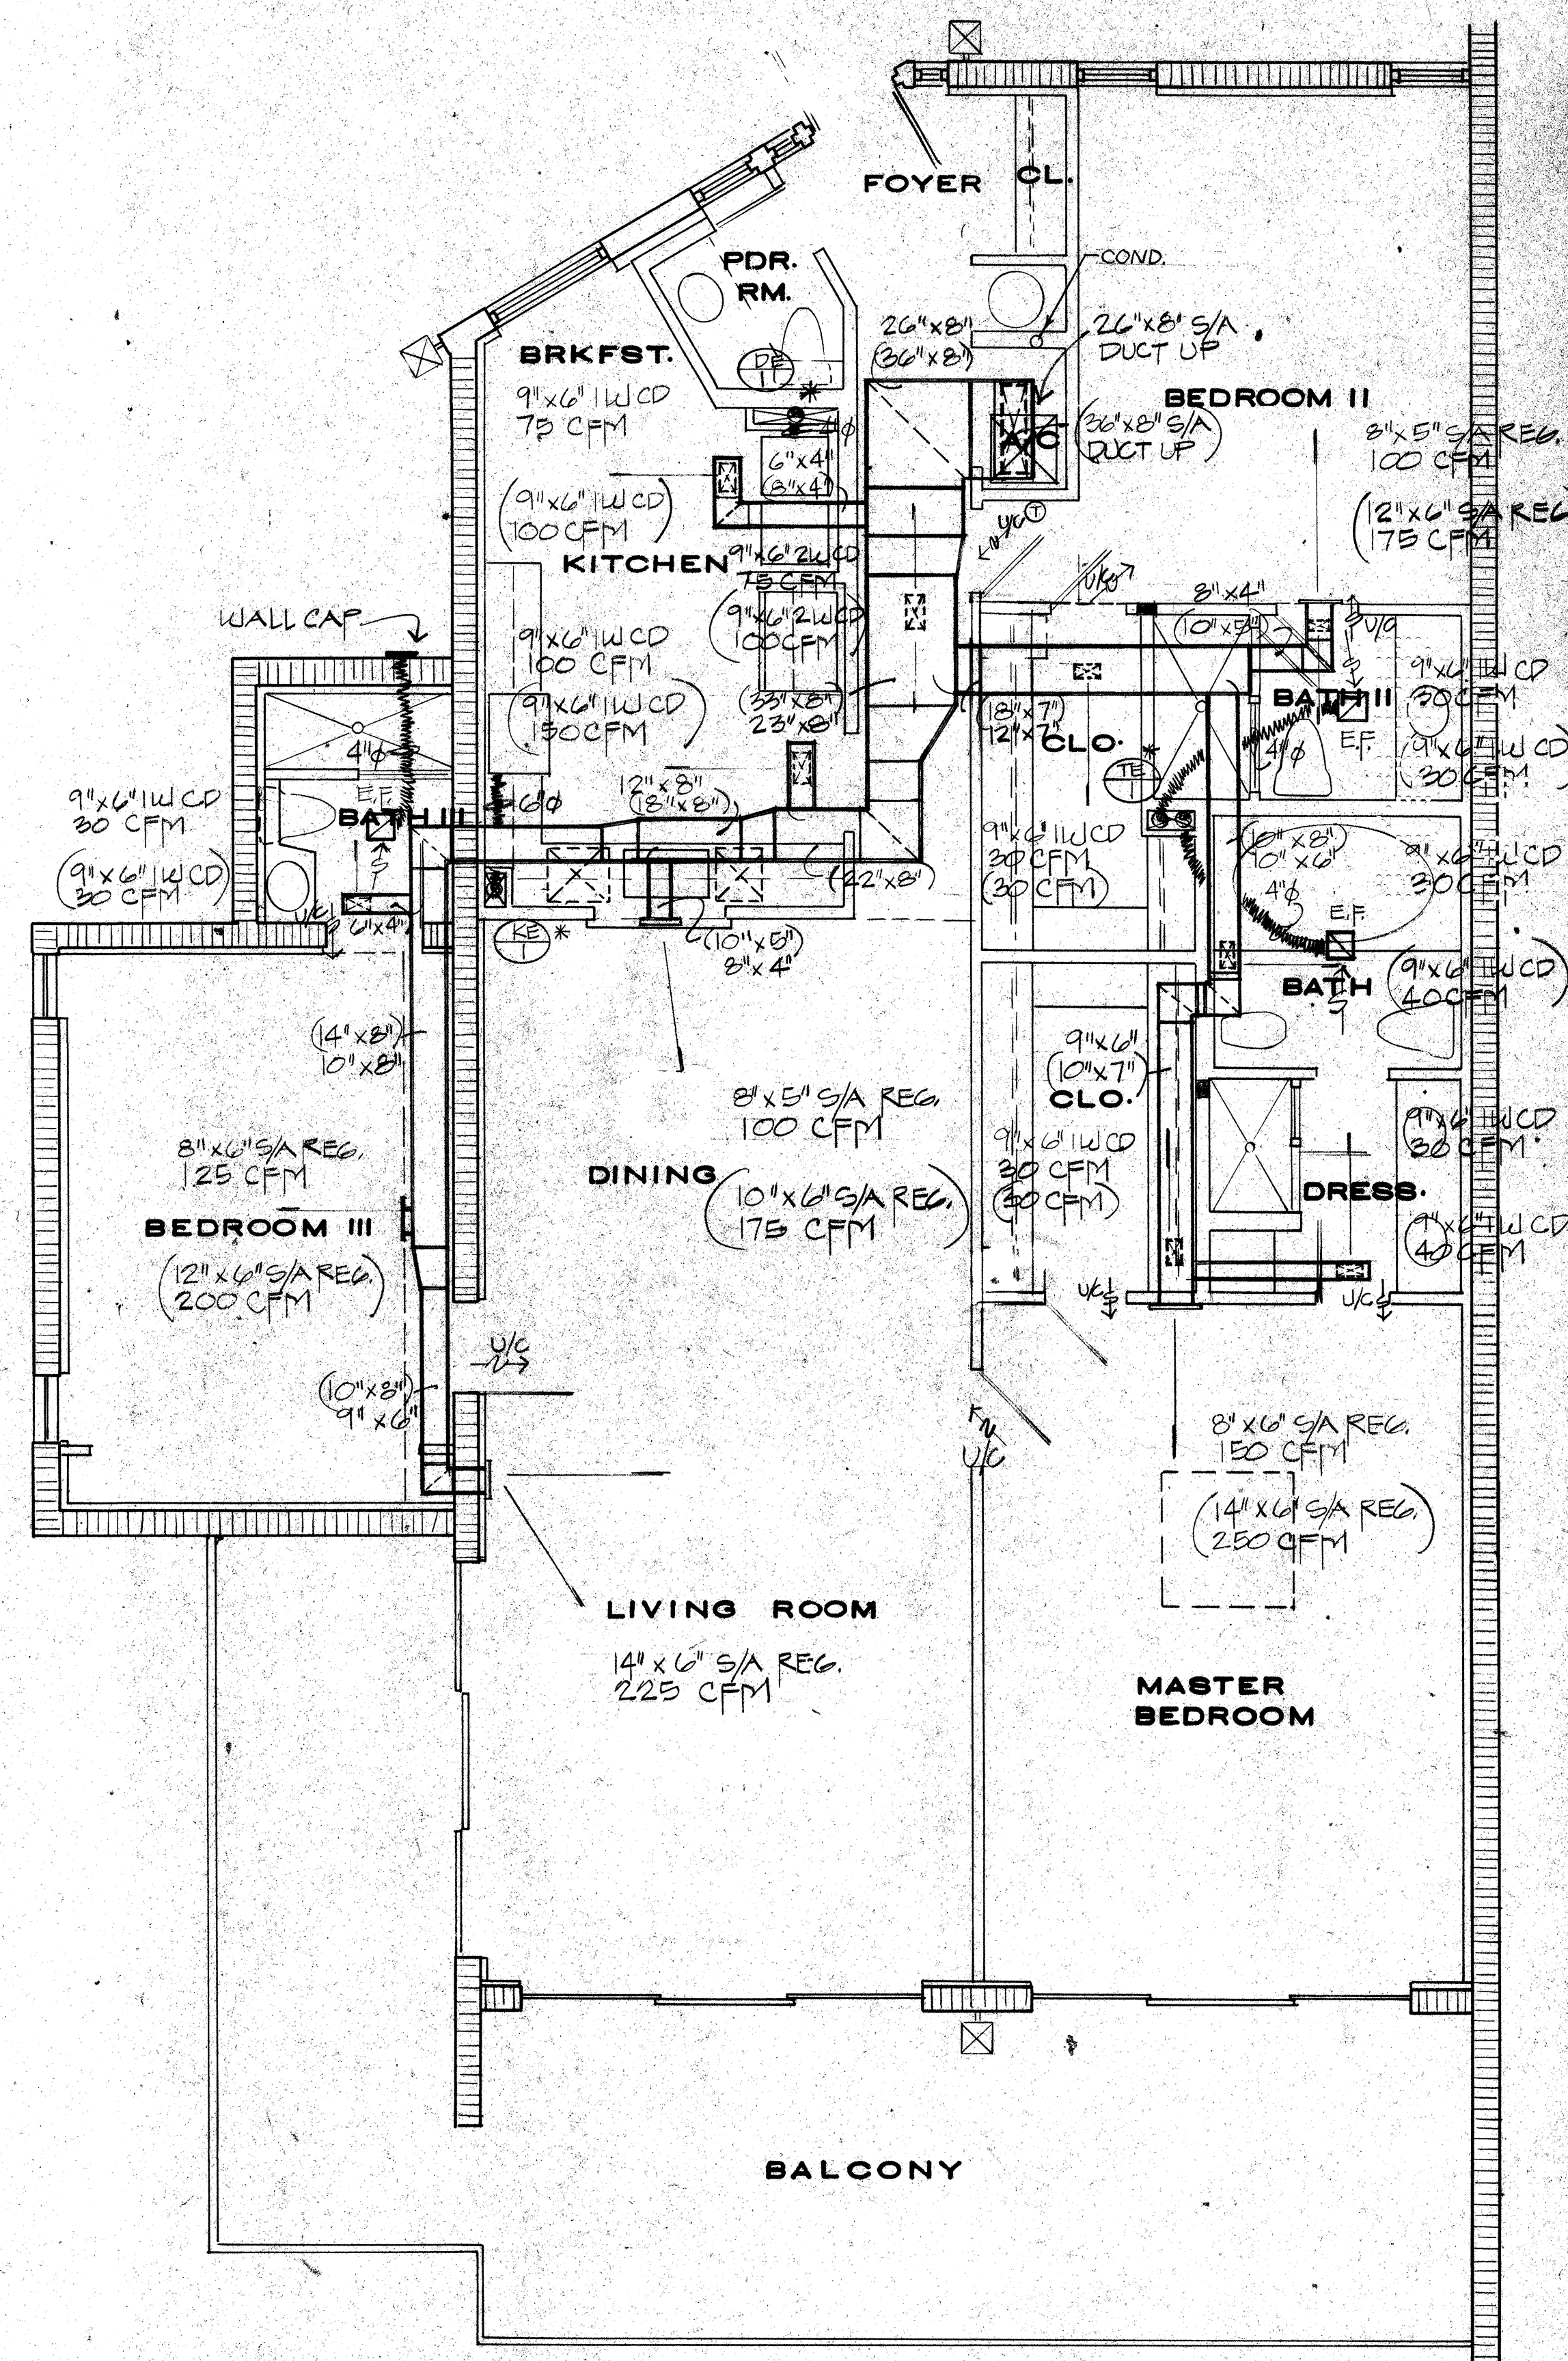

FLOOR PLAN APT. **E**

SCALE: 1/4" = 1'-0"

* SEE RISER, SHEET AC-6

Eugenio
8/3/88
Espinoza

R. WM. CLAYTON JR. ARCHITECT
1995 EAST OAKLAND PARK BLVD. FT. LAUDERDALE, FLA.
E & E CONSULTING ENGINEERS
2701 EAST SUNRISE BLVD. FT. LAUDERDALE, FLA.

OVERLOOK CONDOMINIUM

APT. 'B','C','E' - A/C PLAN

DRAWN BY: P.L.H.
JOB NO: 8101

DATE: 8-12-81
REVISIONS: 6-11-84

AS BUILT 2-8-88

SHEET: **A/C3**