


44

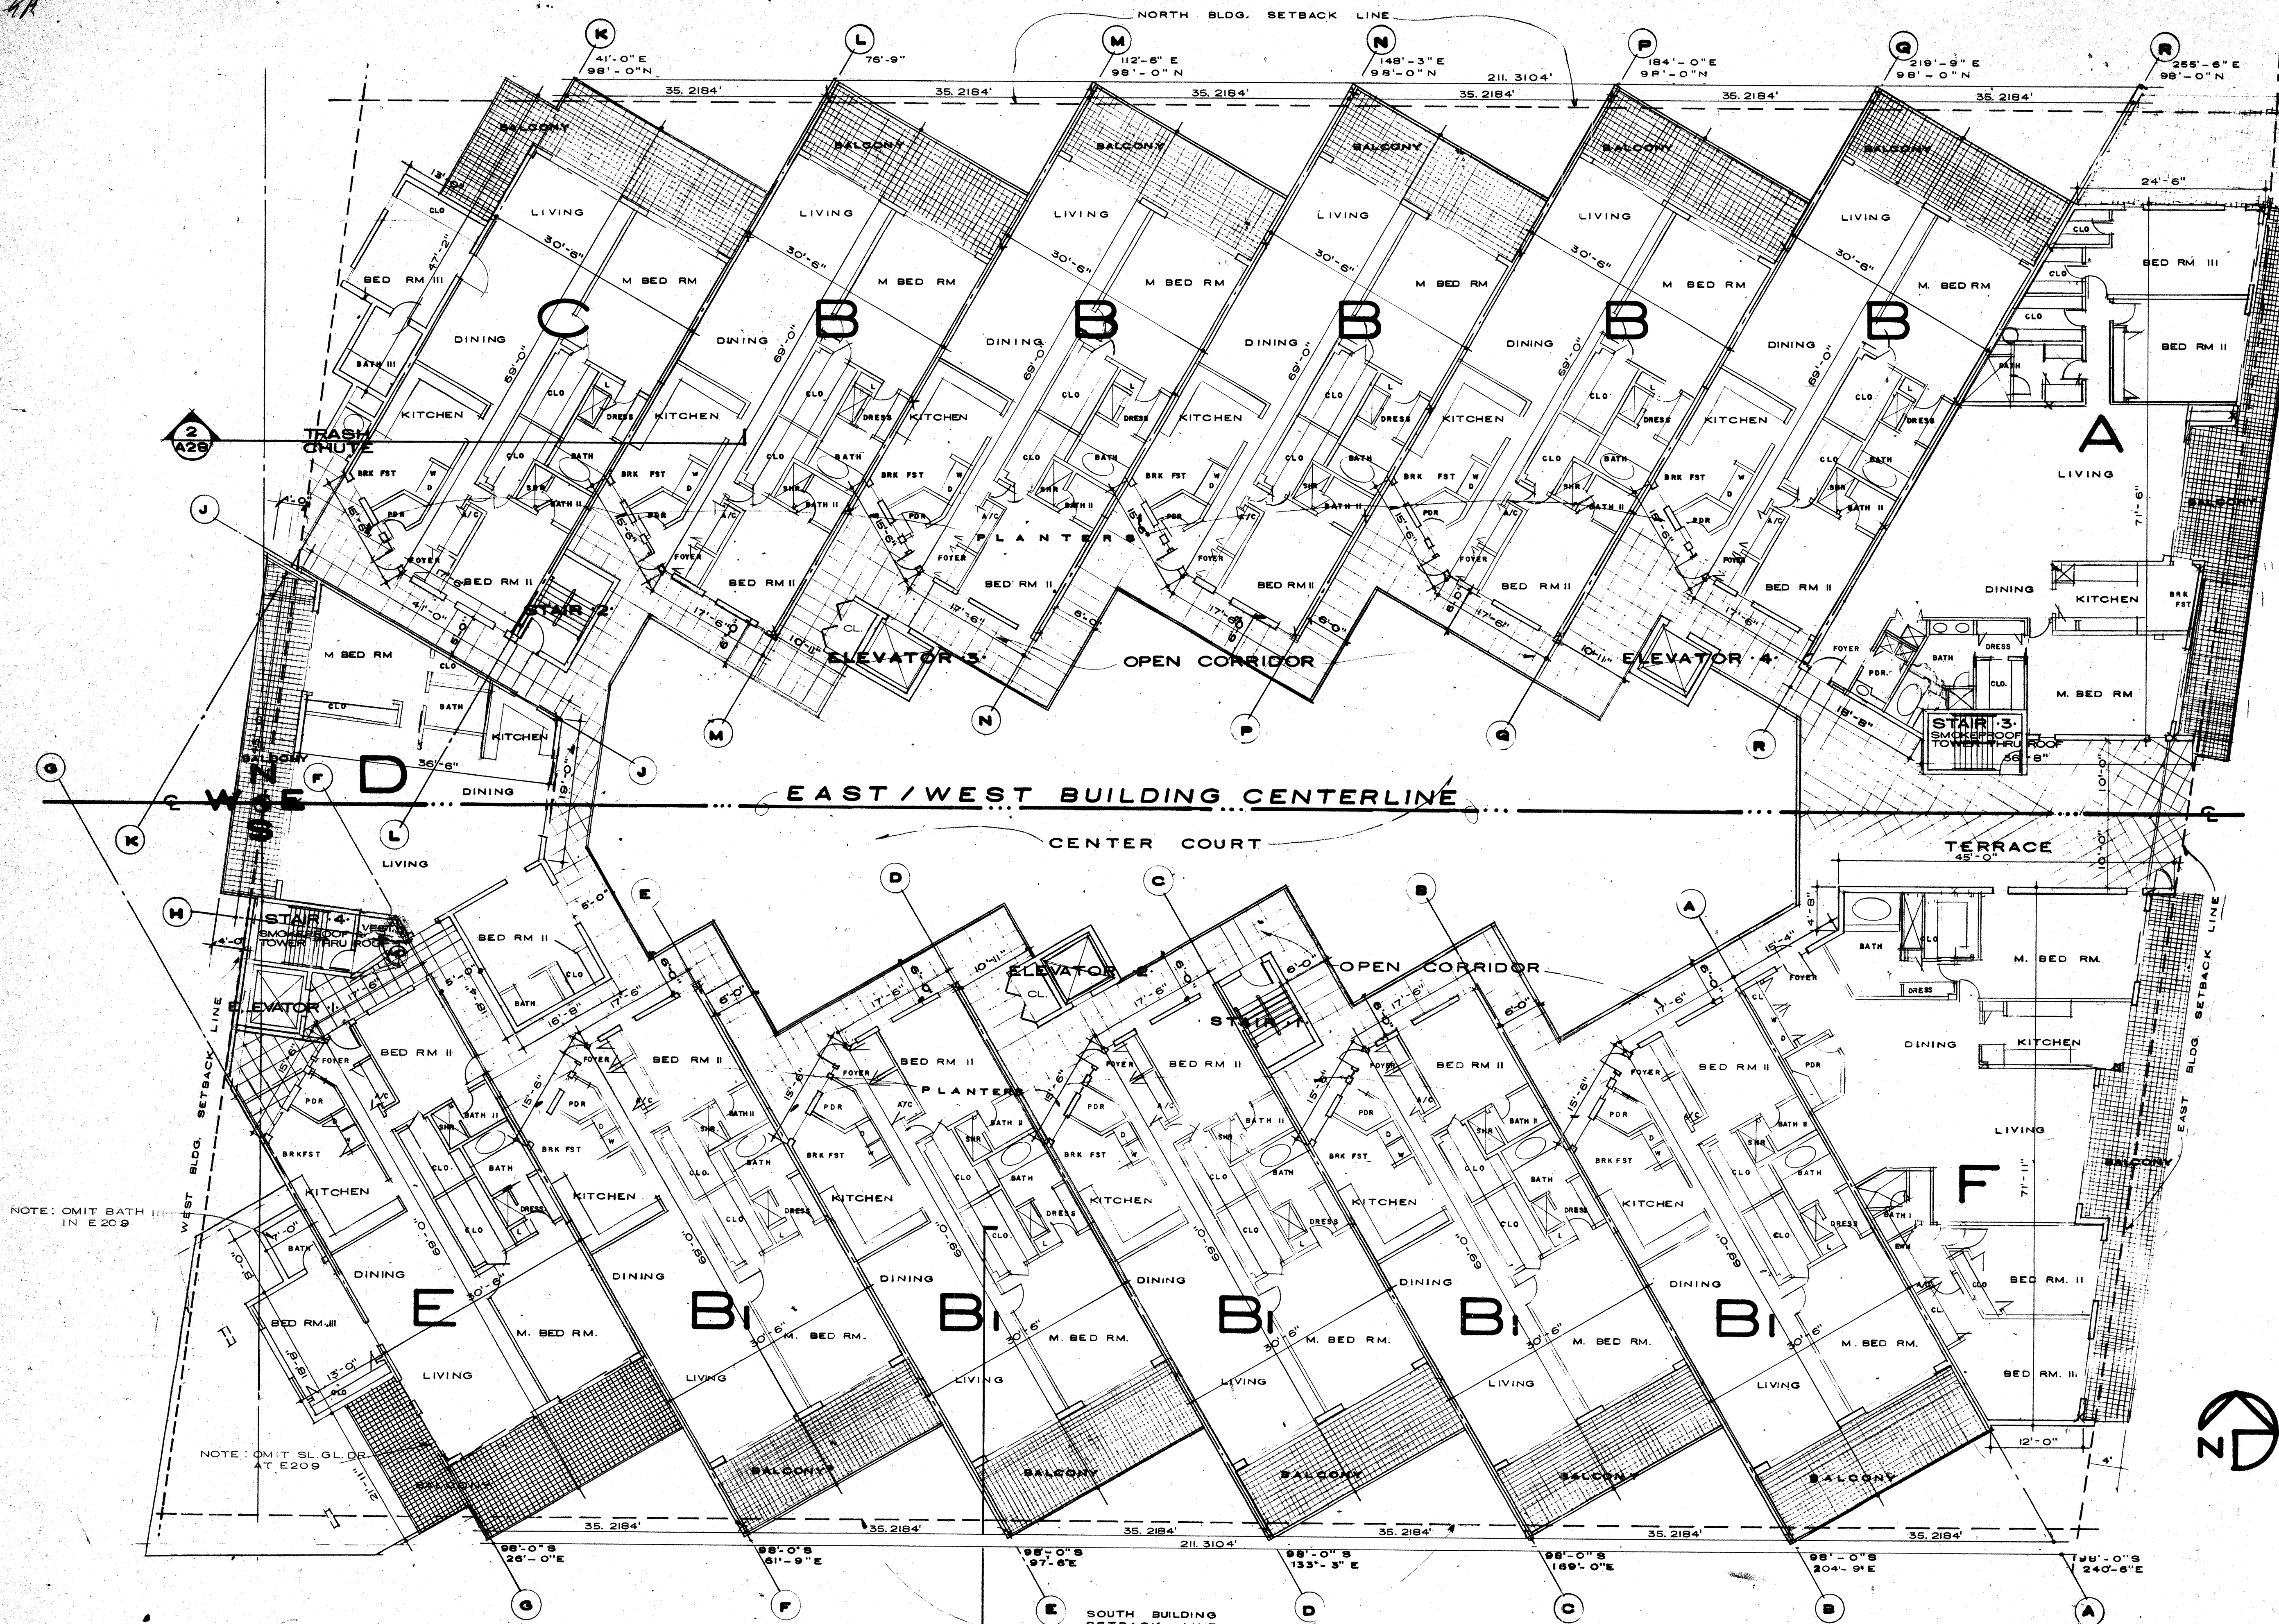

DIMENSIONING NOTES



MAJOR DIMENSIONING IS BASED ON A BUILDING NORTH SOUTH, EAST, WEST COORDINATE SYSTEM.

BASE LINES FOR THIS SYSTEM ARE: (1) THE EAST/WEST BUILDING CENTERLINE (N. 89°09'58"E.) AND (2) AN IMAGINARY NORTH/SOUTH LINE (S. 1°50'2"E.) PASSING THRU THE INTERSECTION OF SAID EAST/WEST BLDG. CENTERLINE AND THE FRONT BLDG. SETBACK LINE.

ALL COORDINATES ARE MEASURED PERPENDICULAR TO THESE BASE LINES.

ALL COORDINATES ARE AT INTERSECTING CENTER LINES OF MASONRY WALLS UNLESS OTHERWISE NOTED. SEE EXAMPLE BELOW.

DUE TO THE COMPLEX ANGULAR NATURE OF THIS STRUCTURE, EXTREME CARE MUST BE EXERCISED DURING LAYOUT AND THE ARCHITECT CONSULTED IMMEDIATELY CONCERNING ANY DISCREPANCY BETWEEN THE PLANS AND ACTUAL CONDITIONS AT THE SITE.

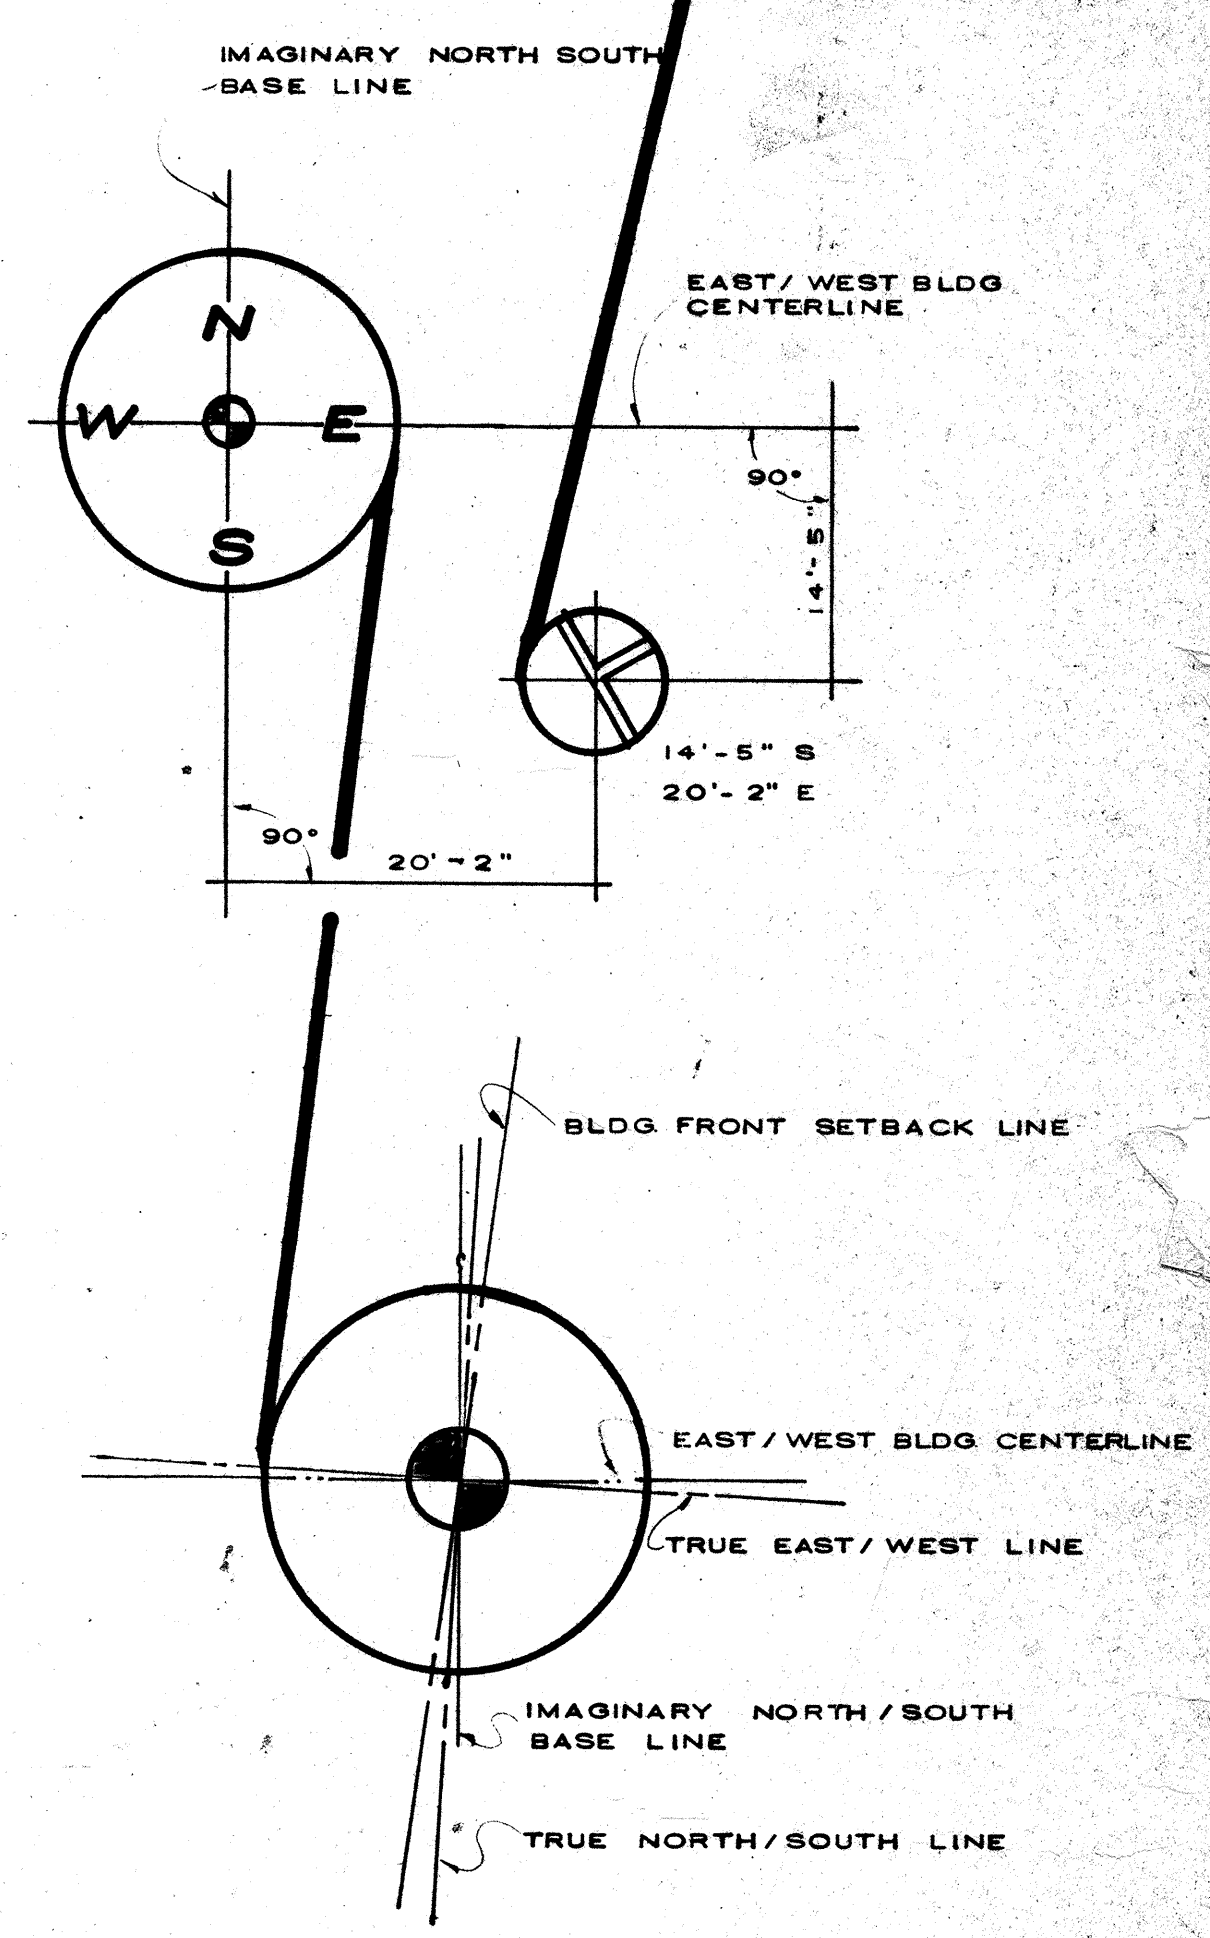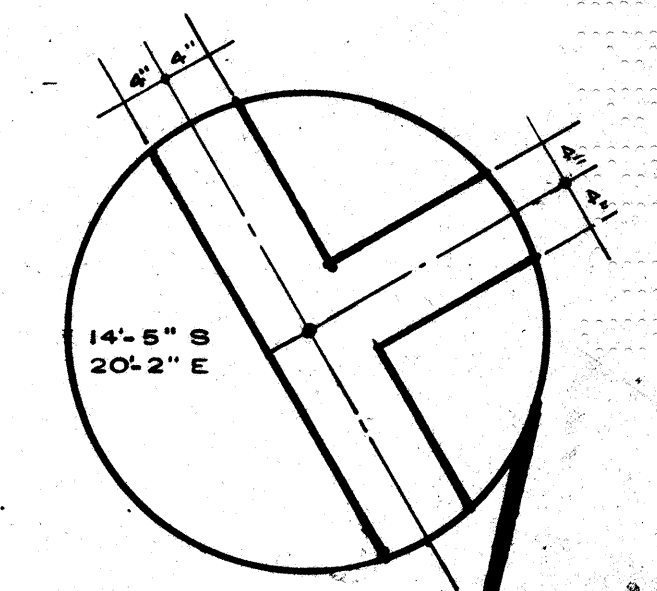

NOTE: OMIT BATH III IN E209

NOTE: OMIT SL GL DR AT E209

NOTE: ALL CONCRETE BLOCK IS LOAD BEARING WITH NO. 5 RODS AT 4'-0" O.C. MAXIMUM WITH BLOCK STACKED AND CELLS WITH RODS FULLY GROUTED USING 3000 PSI CONC. W/PEA ROCK

SECOND THRU SEVENTH TYPICAL FLOORS

1/A2

SCALE 3/32" = 1'-0"

R. Wm. Clayton Jr.

R. WM. CLAYTON JR. ARCHITECT
1995, EAST OAKLAND PARK BLVD. FT. LAUDERDALE, FLA.

OVERLOOK CONDOMINIUM

2ND THRU 7TH TYPICAL FLOORS

DRAWN BY: ACS
JOB NO: 8101
DATE:
REVISIONS: 6-11-84
ELEV. STAIR E.L.
D. ART. DIM. 8-30-84
S.T. VEST. 6-18-87
AS BUILT 2-2-88
SHEET NO. A2A