



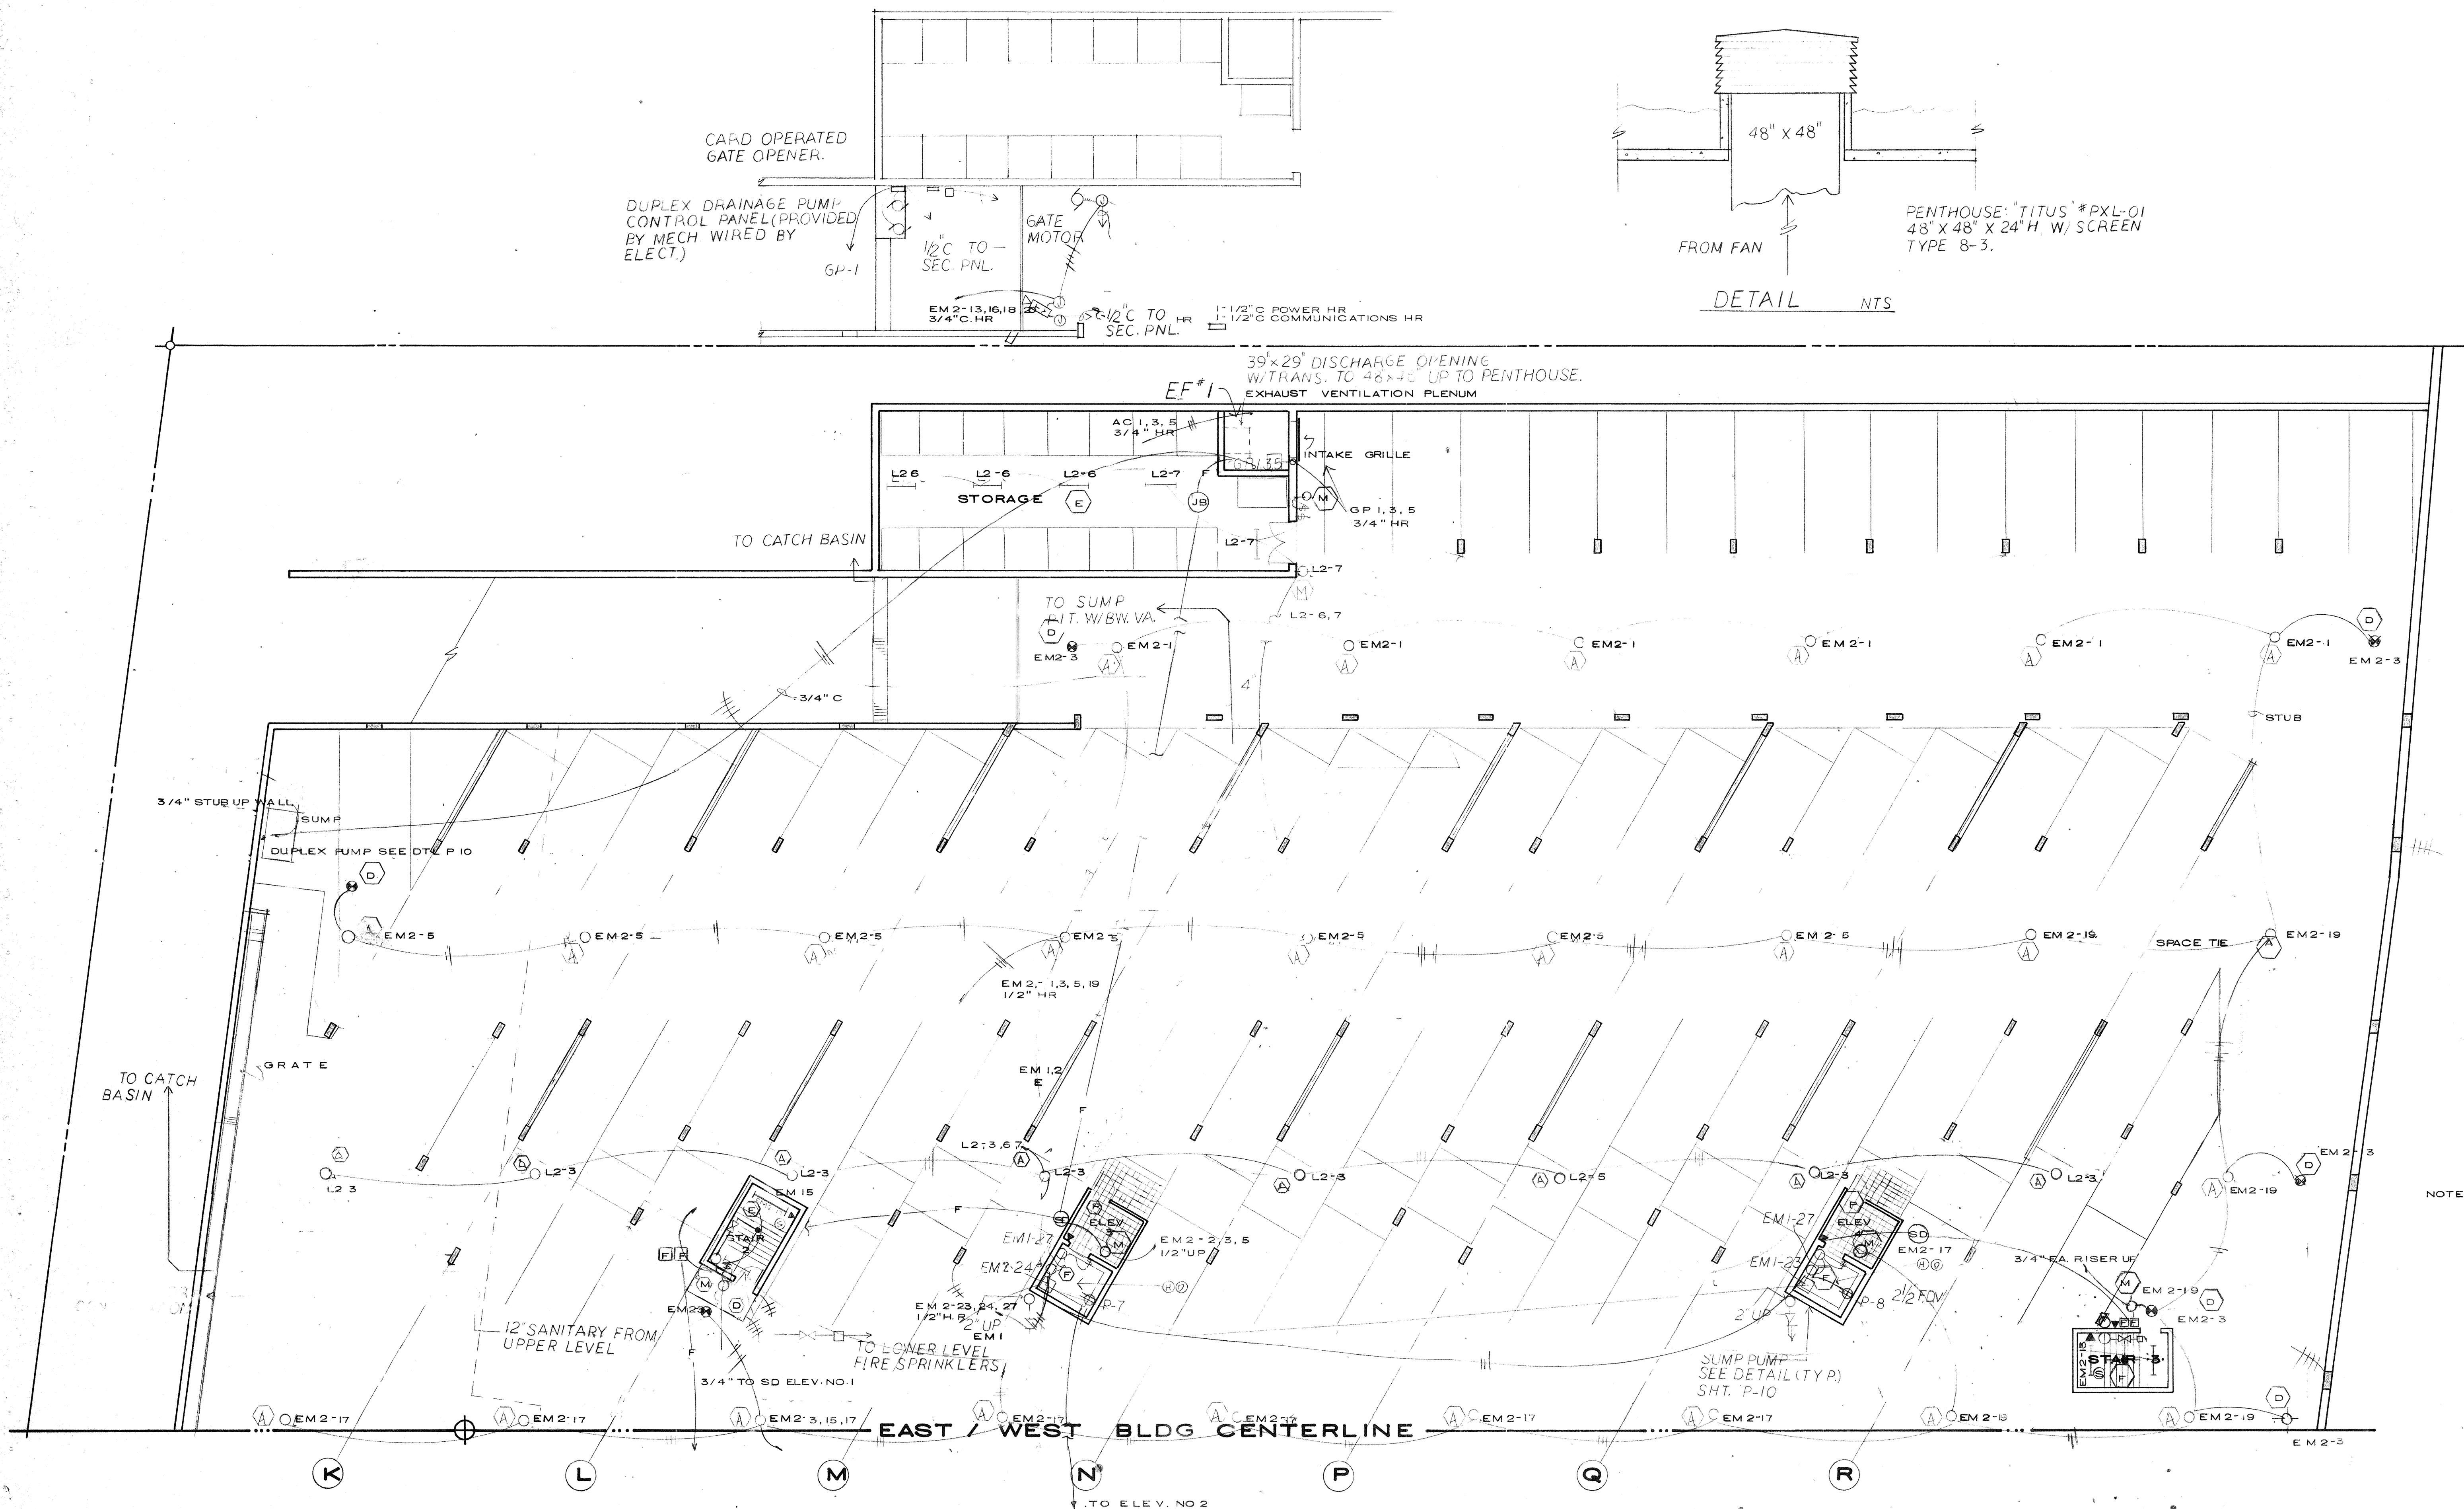

LOWER LEVEL PARKING PLAN / NORTH

SCALE: 3/32" = 1'-0"

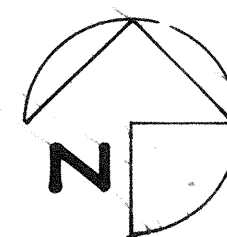

Eugenio 8/5/84
E. Clayton

R. WM. CLAYTON JR. ARCHITECT
1995 EAST OAKLAND PARK BLVD. FT. LAUDERDALE, FLA.
E & E CONSULTING ENGINEERS
2701 EAST SUNRISE BLVD. FT. LAUDERDALE, FLA.
OVERLOOK CONDOMINIUM

DRAWN BY: S.S.
JOB NO. 8101
DATE: 8-12-81
REVISIONS: 6-11-84
2-7-84
AS BUILT 2-8-88
SHEET: **MI**