


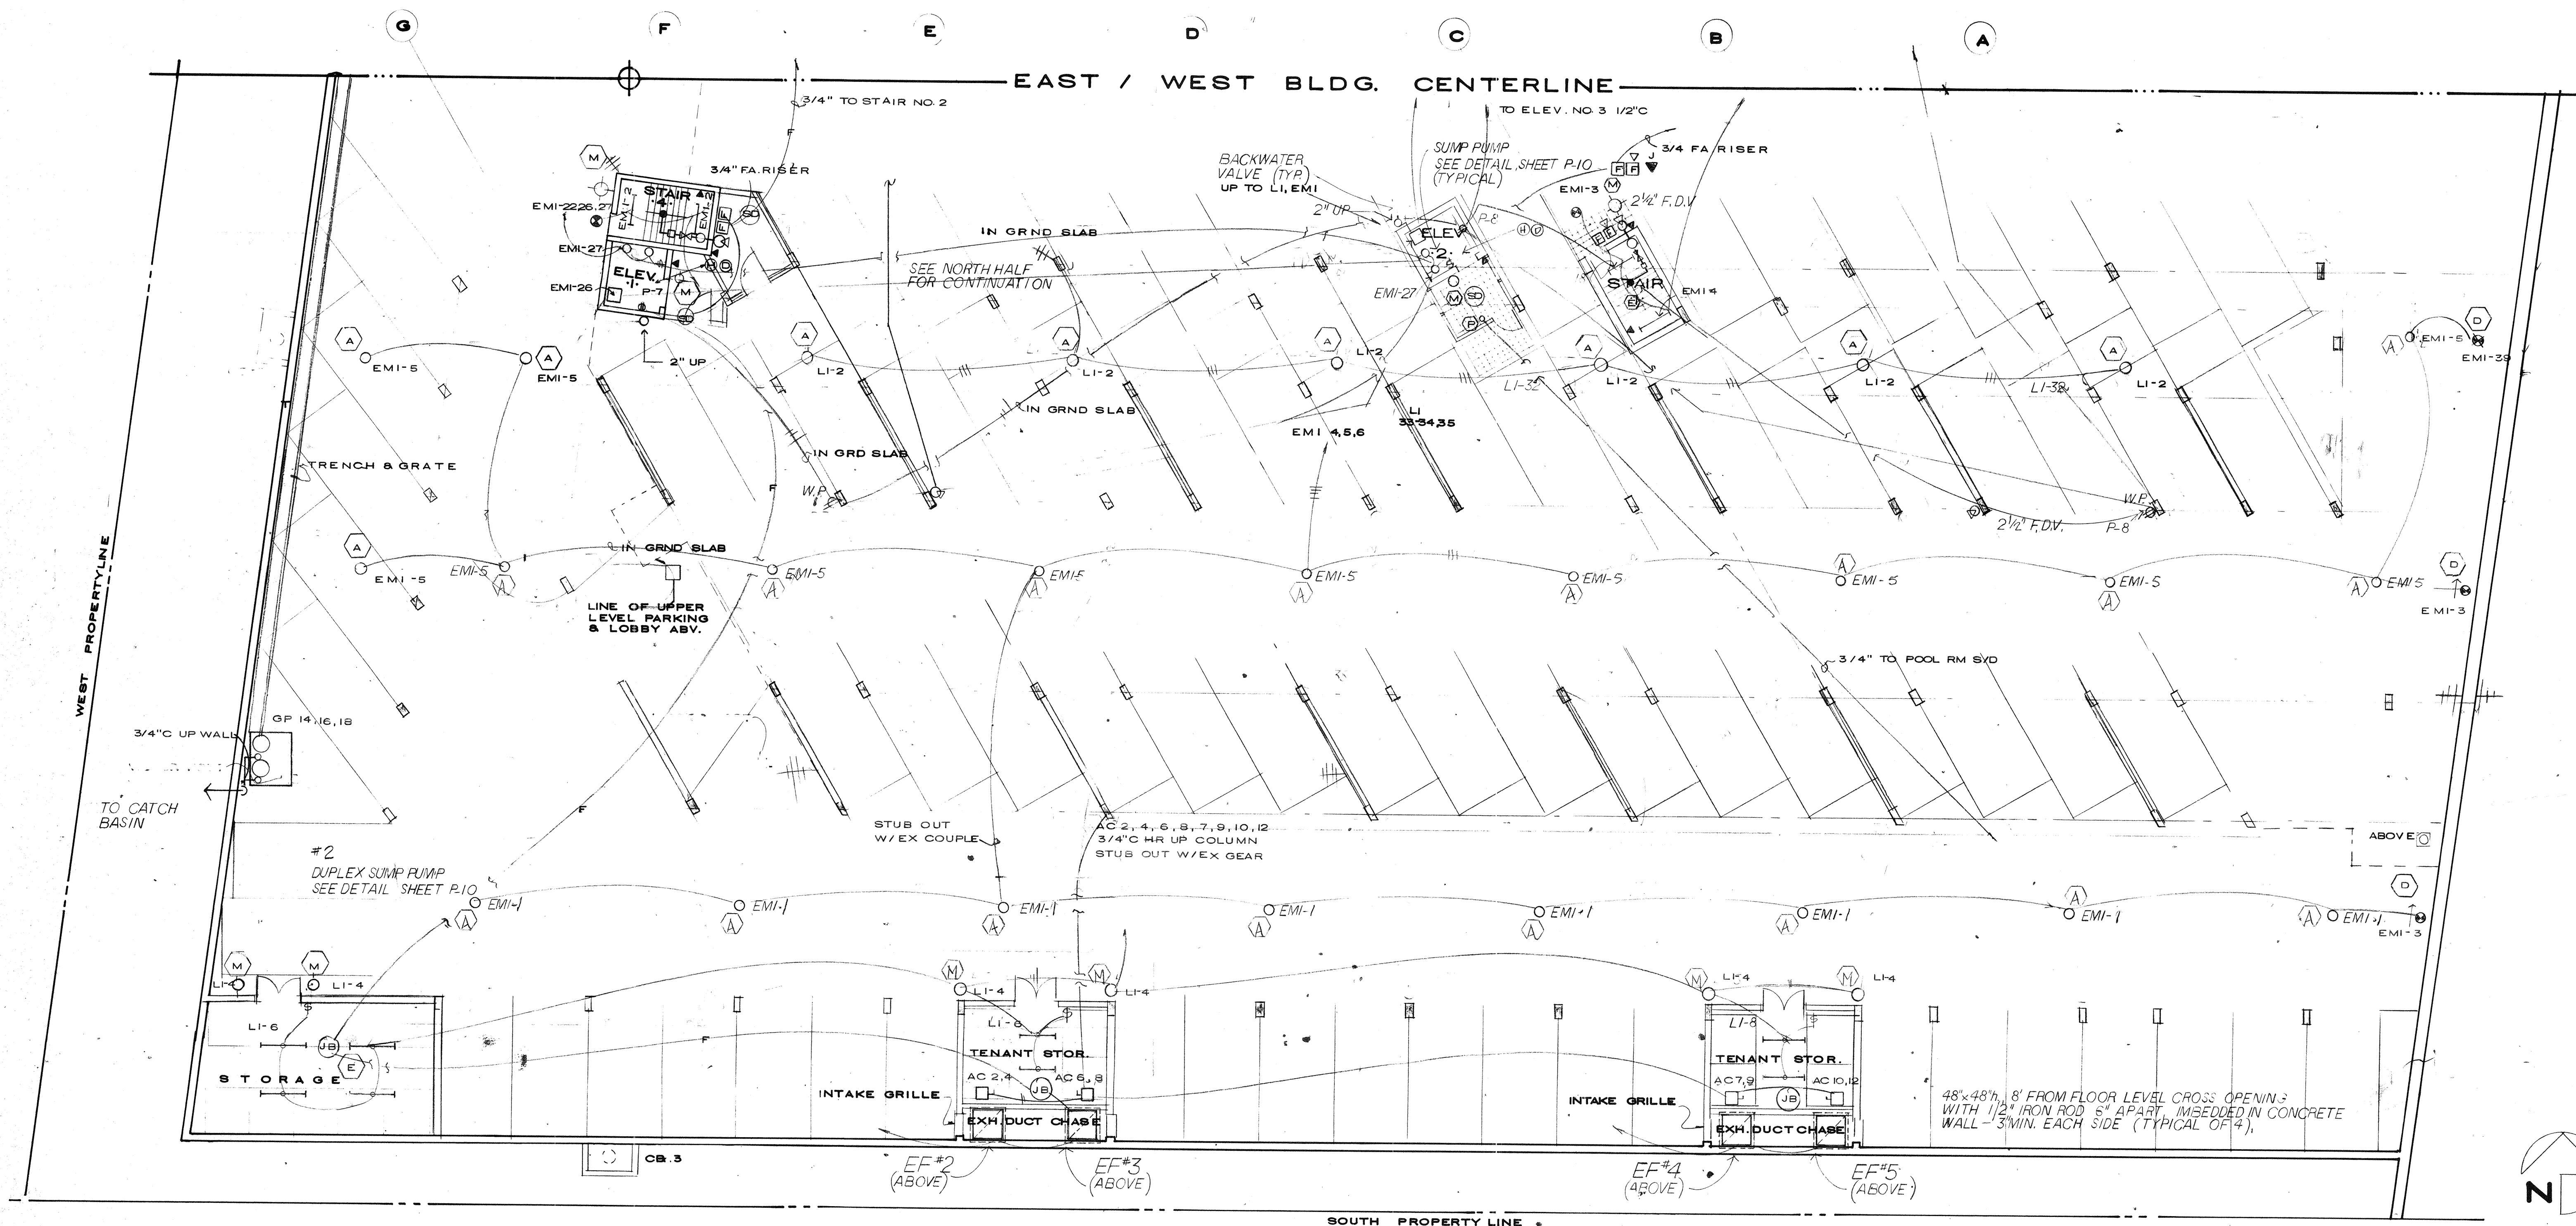

LOWER LEVEL PARKING PLAN / SOUTH

SCALE 3/32" = 1' - 0"

Espino
8/3/88
Espino

R. WM. CLAYTON JR.
1995 EAST OAKLAND PARK BLVD.
FT. LAUDERDALE, FLA.
ARCHITECT
E & E CONSULTING ENGINEERS
2701 EAST SUNRISE BLVD.
FT. LAUDERDALE, FLA.
OVERLOOK CONDOMINIUM

DRAWN BY: R.H.
JOB NO: 8101
DATE: 8-12-81
REVISIONS: 6-11-84
2-7-84
AS BUILT 2-8-88
SHEET: **M2**