



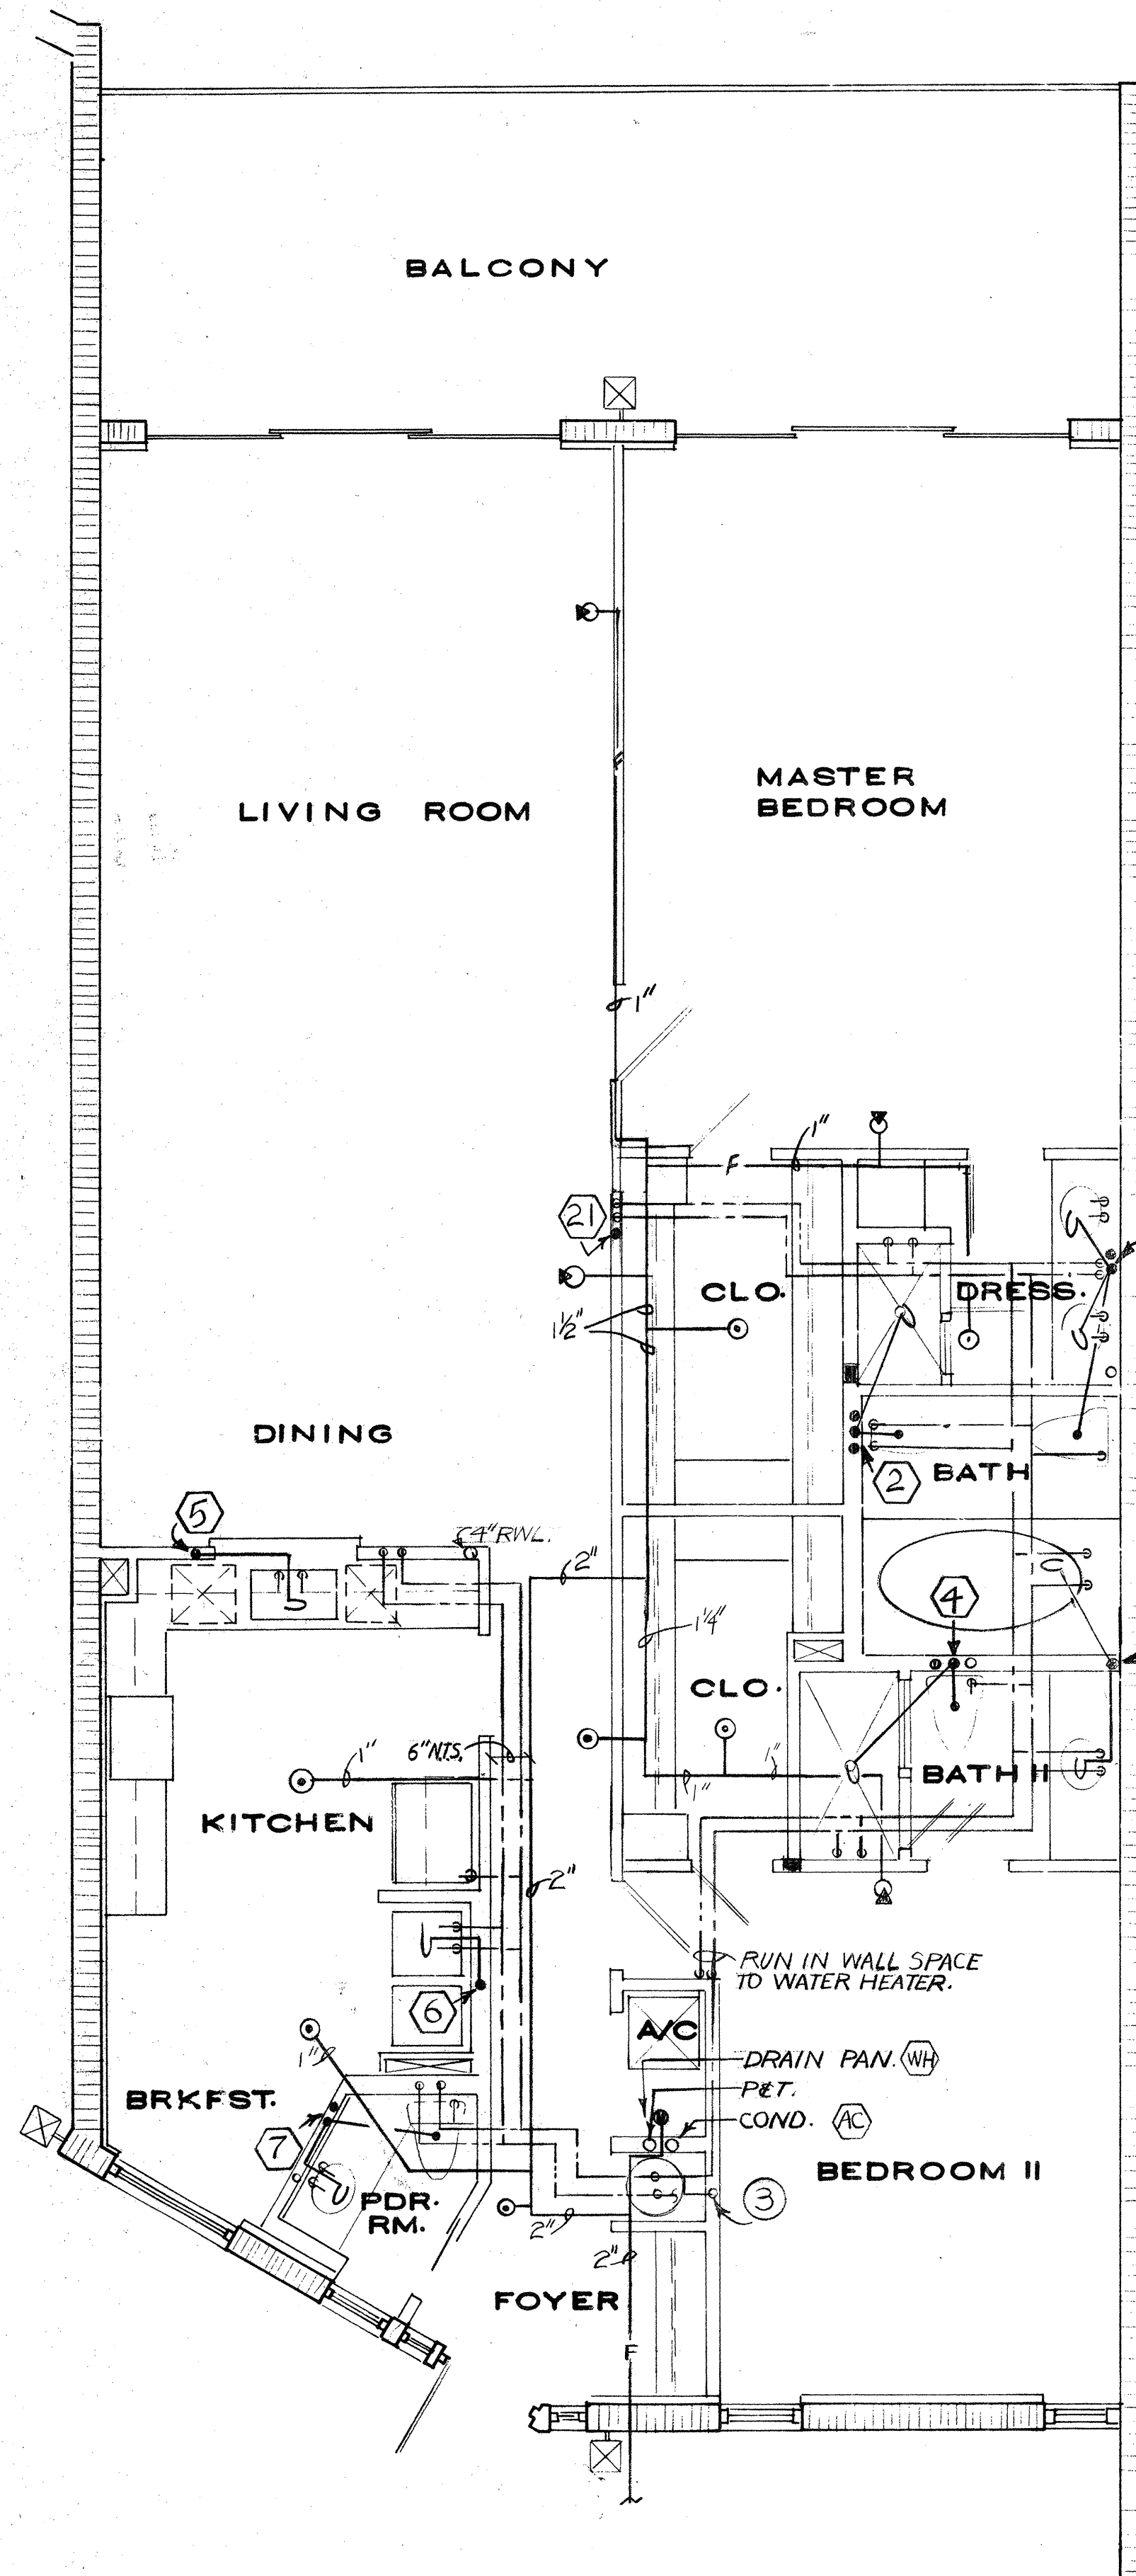

FLOOR PLAN APT. **B**


SCALE: 1/4" = 1'-0"

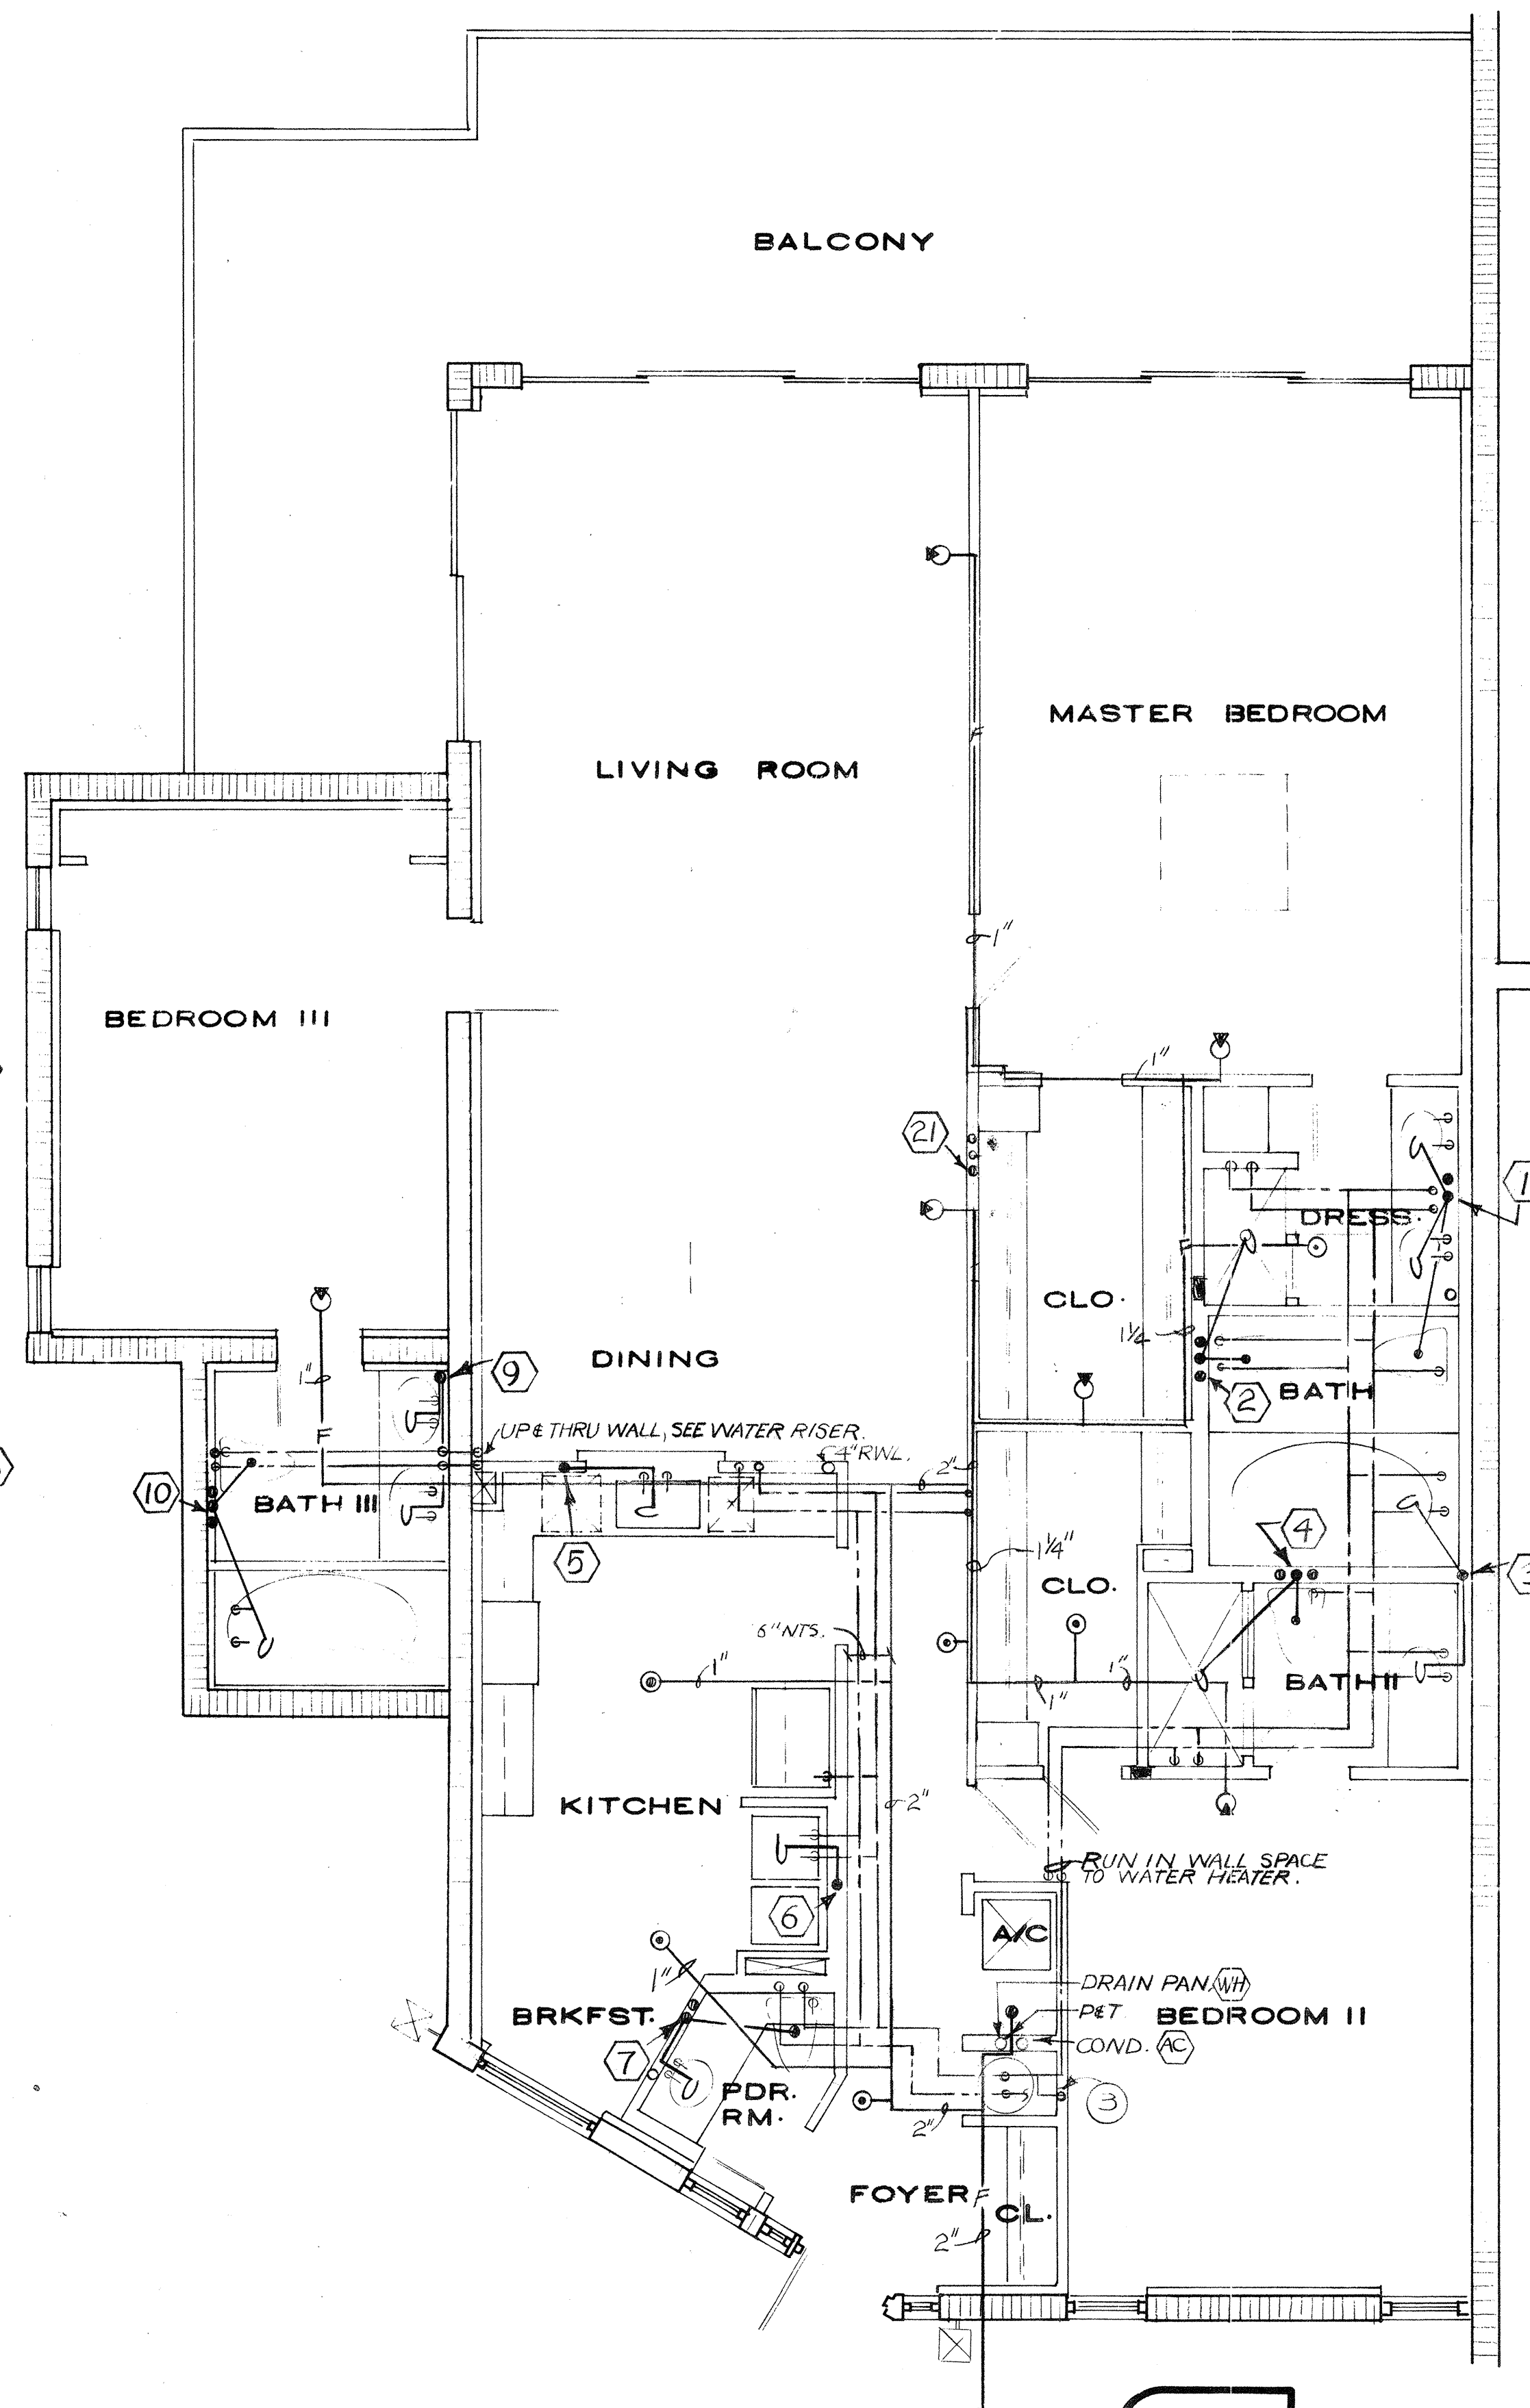

FLOOR PLAN APT. **C**

SCALE: 1/4" = 1'-0"

SEE SPRINKLER NOTE
SUBMIT A COMPLETE SET OF SHOP
DRAWINGS & HYDRAULIC CALCULATIONS
TO ALL GOVERNING AUTHORITIES PRIOR
TO CONSTRUCTION.

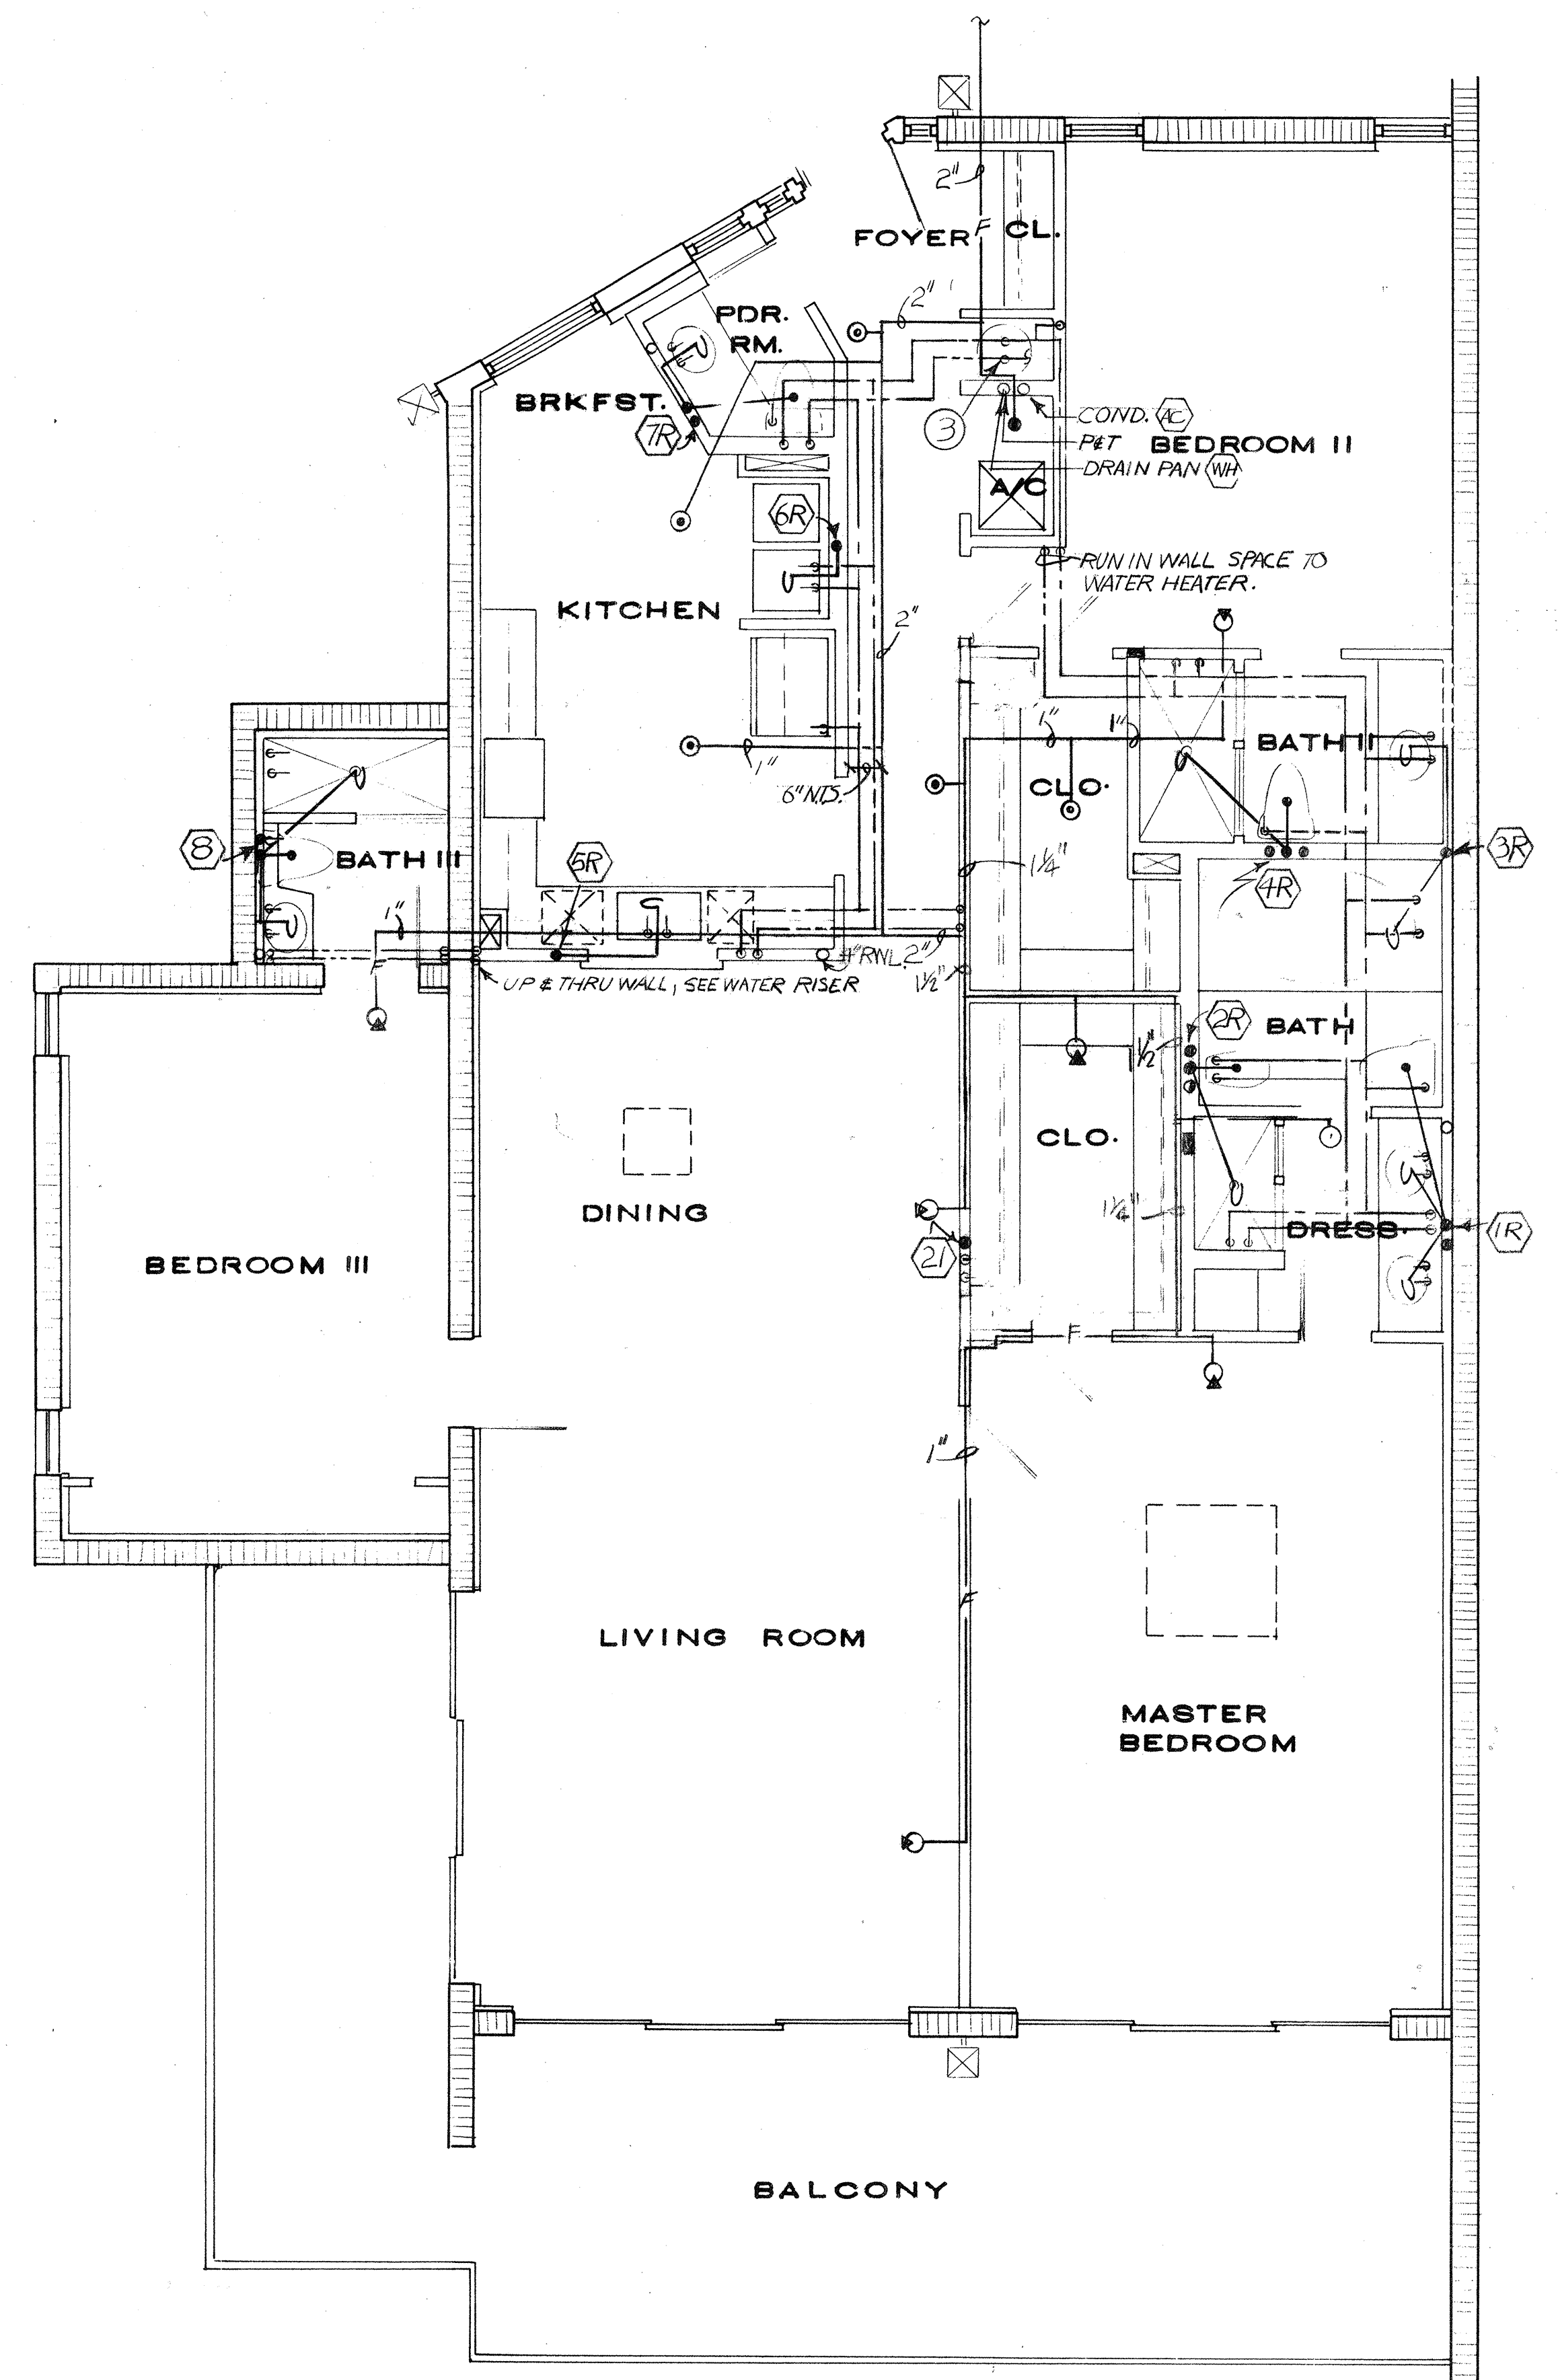

FLOOR PLAN APT. **E**

SCALE: 1/4" = 1'-0"

*Eugenio
2/3/88
Espinoza*

R. WM. CLAYTON JR. ARCHITECT
1995 EAST OAKLAND PARK BLVD. FT. LAUDERDALE, FLA.
E & E CONSULTING ENGINEERS
2701 EAST SUNRISE BLVD. FT. LAUDERDALE, FLA.

OVERLOOK CONDOMINIUM

APT. 'B','C','E' PLUMBING

DRAWN BY: S.S.
JOB NO: 8101

DATE: 8-12-81
REVISIONS: 6-11-84

AS BUILT 2-8-88

SHEET: **P3**