



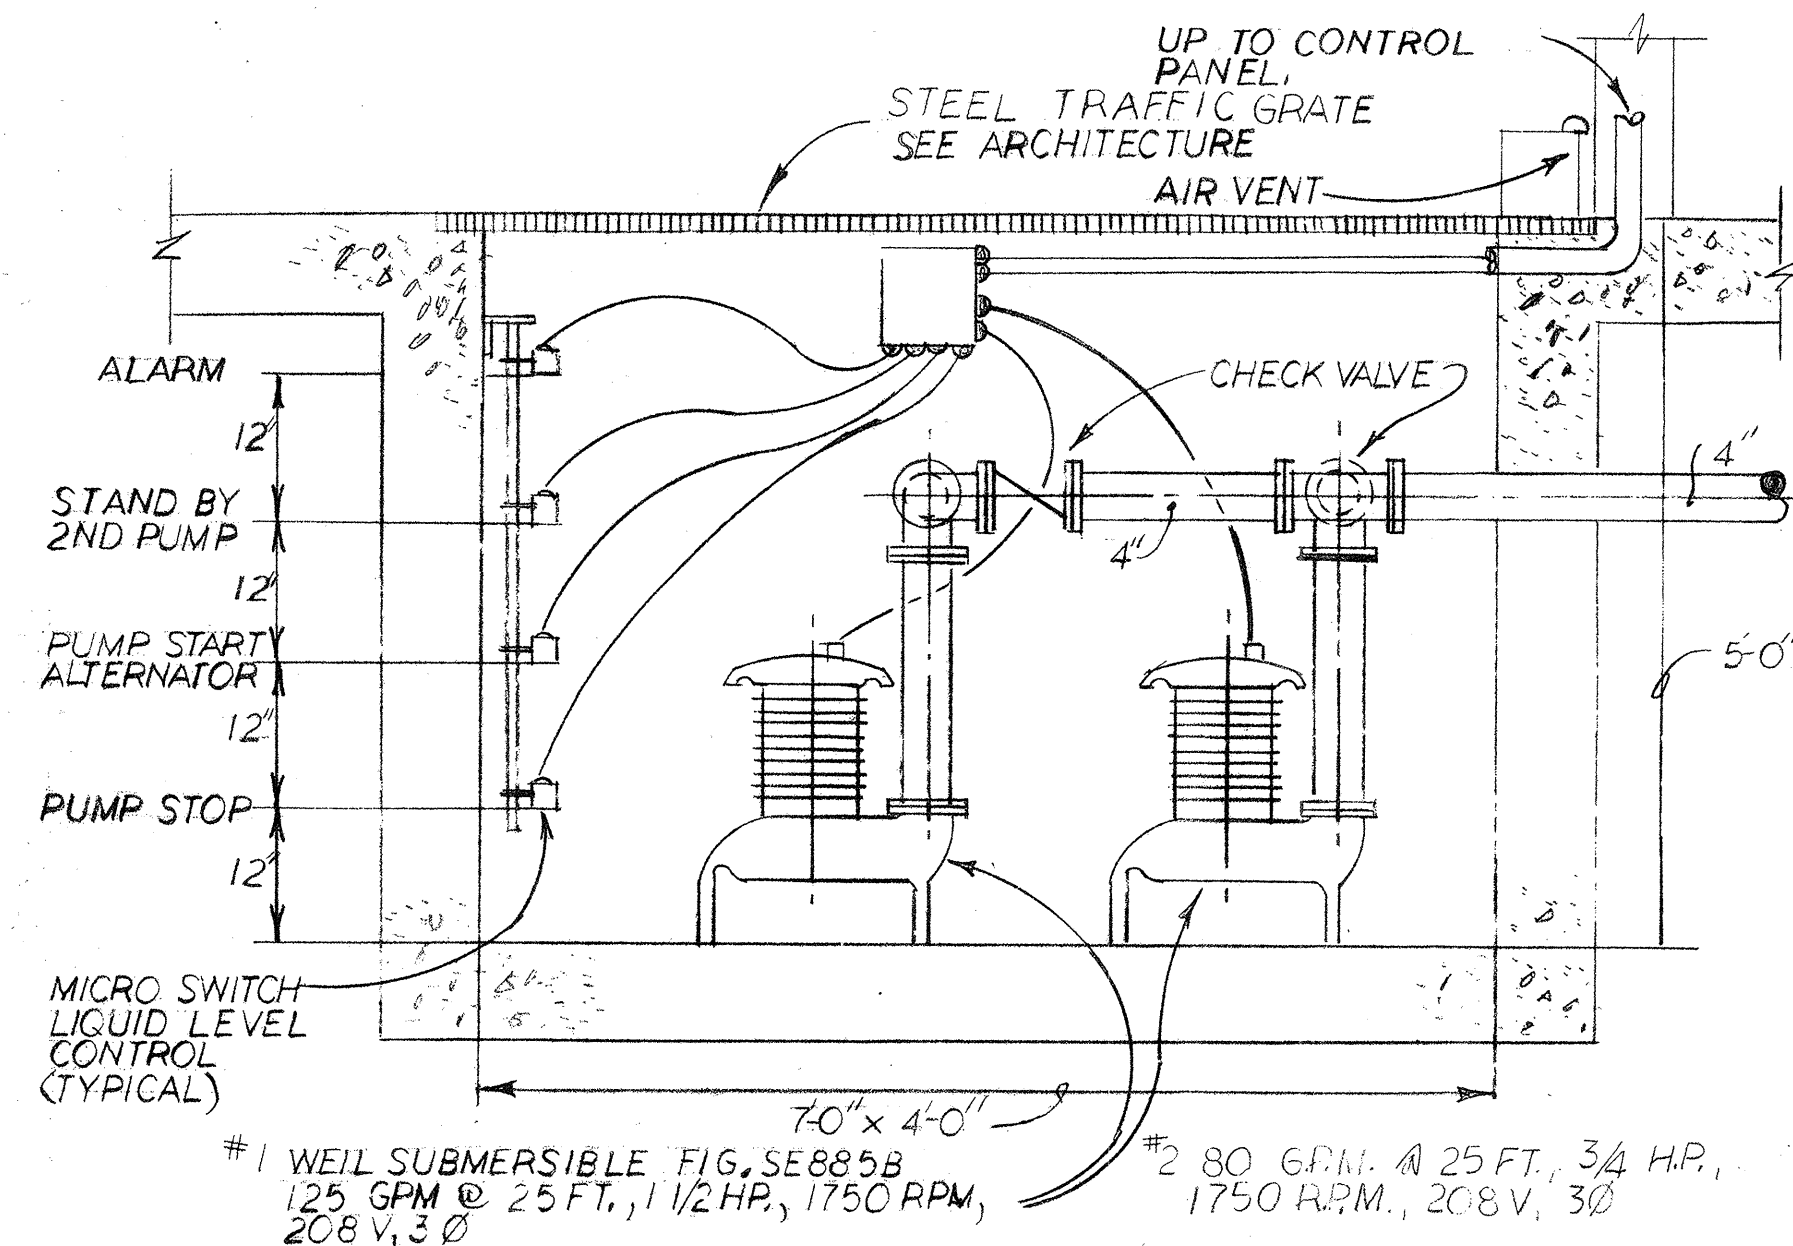


DUPLEX DRAINAGE PUMP DETAIL


NO SCALE

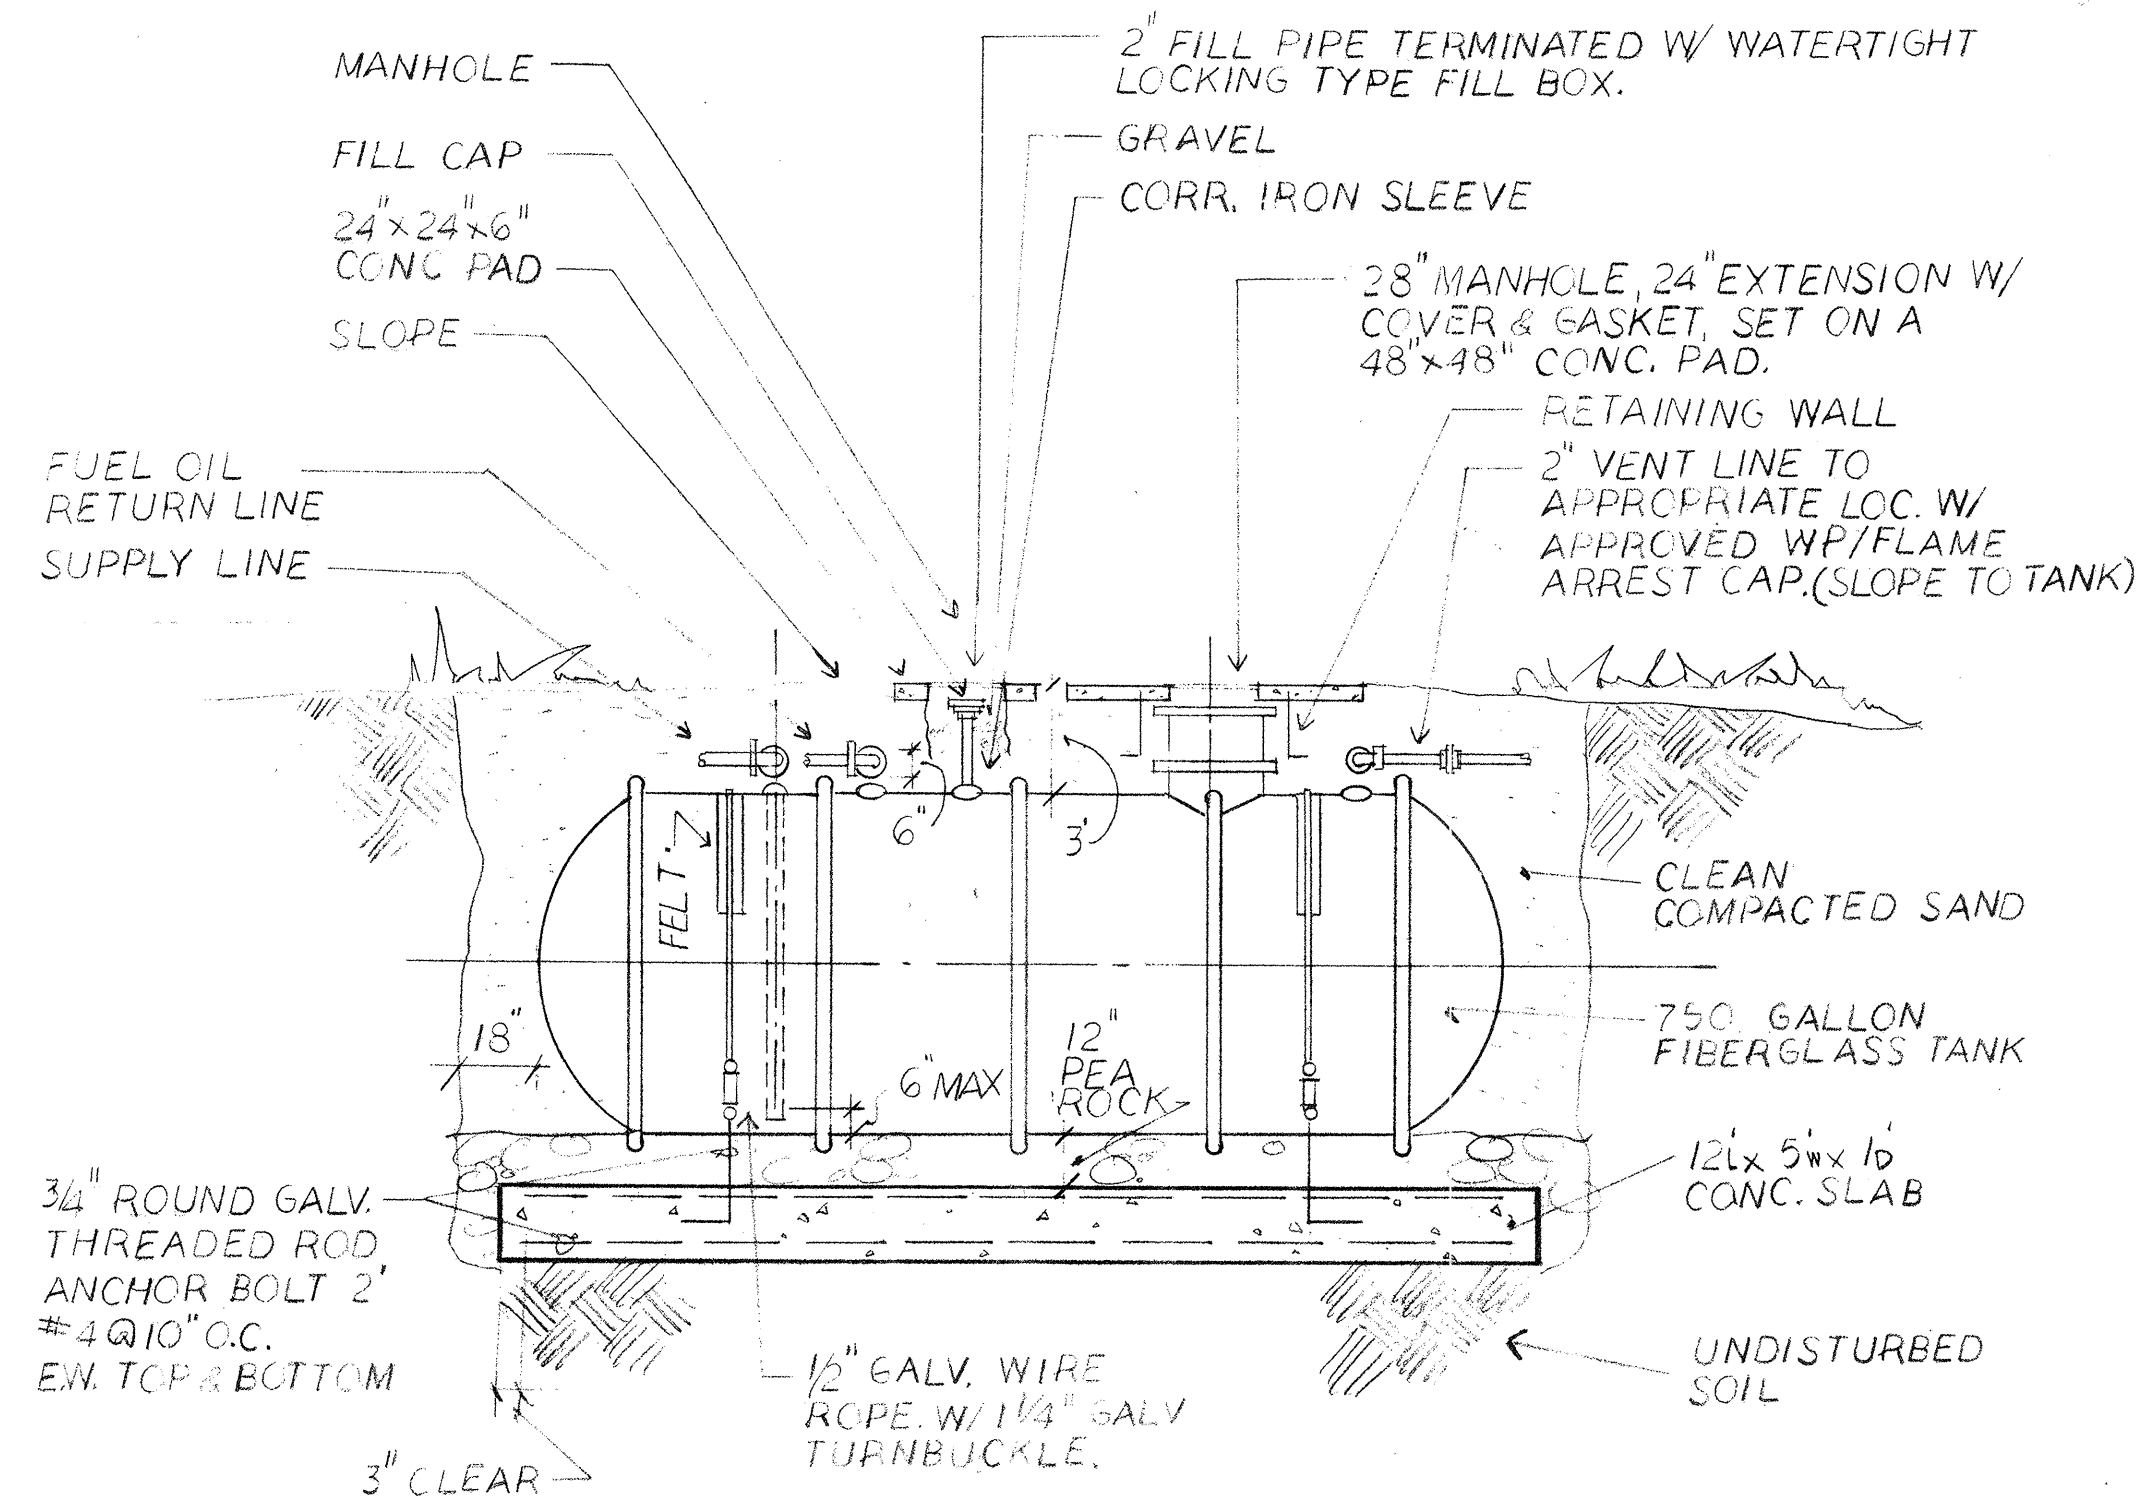

DIESEL FUEL STORAGE TANK DETAIL

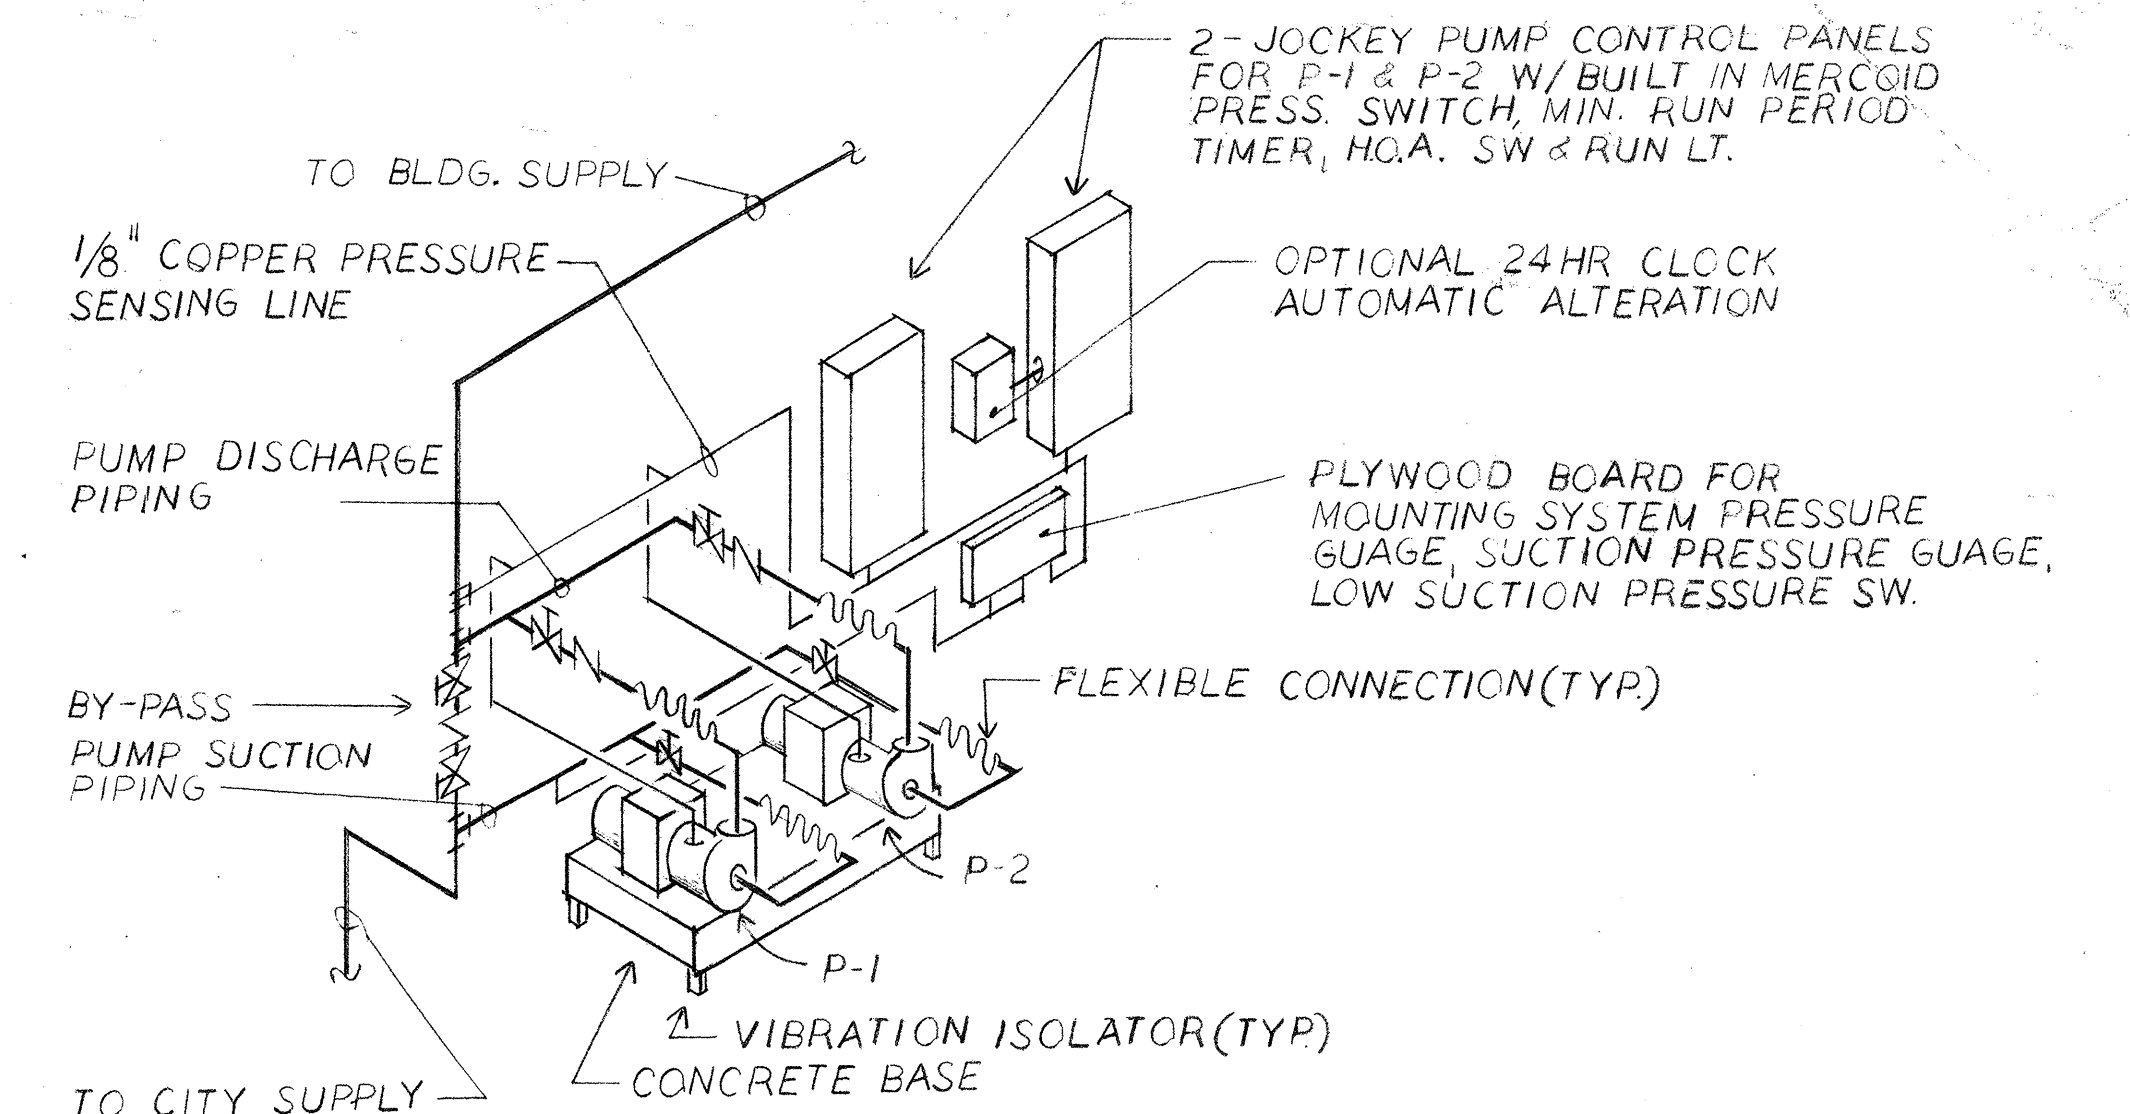

DOMESTIC BOOSTER SYSTEM

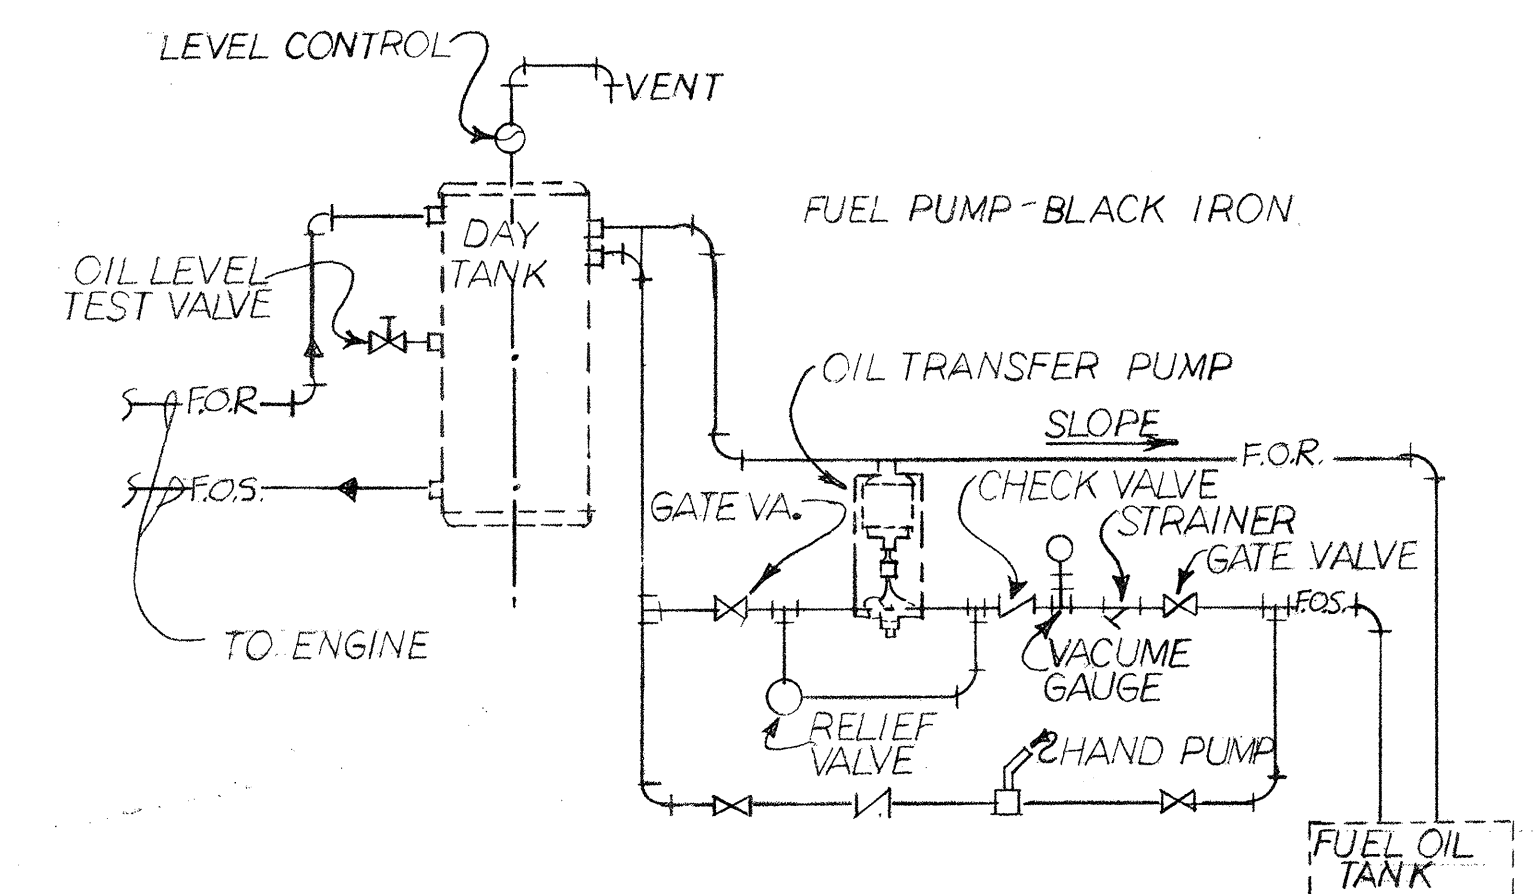


FUEL OIL PIPING SCHEMATIC

NO SCALE


NO SCALE

- NOTES:
1. DAY TANK, EMERGENCY GENERATOR, FUEL OIL, FLEX, FUEL CONNECTOR, FUEL STORAGE TANK, HAND PUMP AND LEVEL CONTROL ARE FURNISHED BY ELECTRICAL CONTRACTOR.
 2. PLUMB. CONTRACTOR SHALL INSTALL ALL ABOVE ITEMS EXCEPT GENERATOR.
 3. PLUMBING CONTRACTOR SHALL FURNISH AND INSTALL ALL PIPE, AND PIPE ACCESSORIES FOR A COMPLETE INSTALLATION.

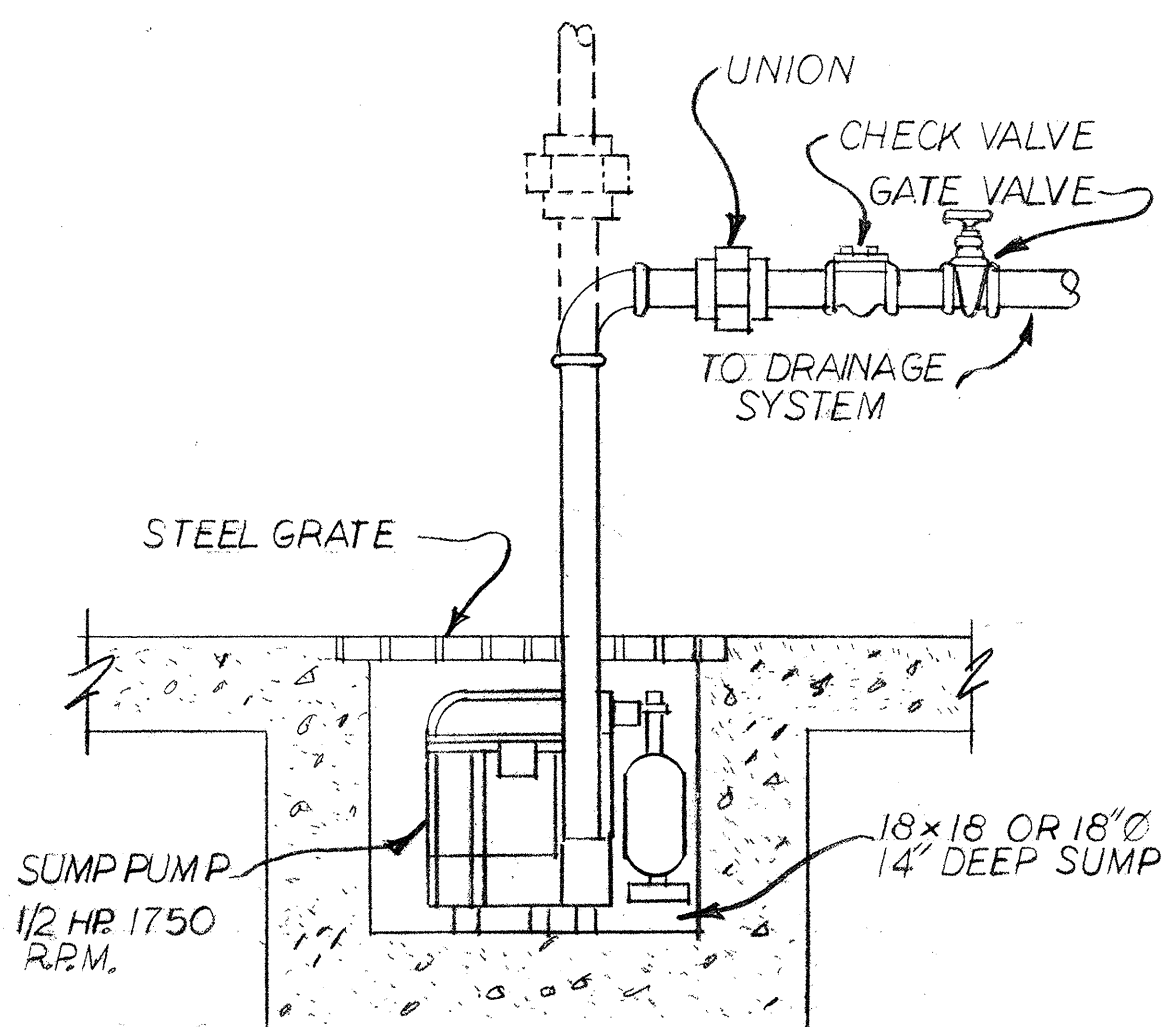


SUMP PUMP DETAIL

NO SCALE

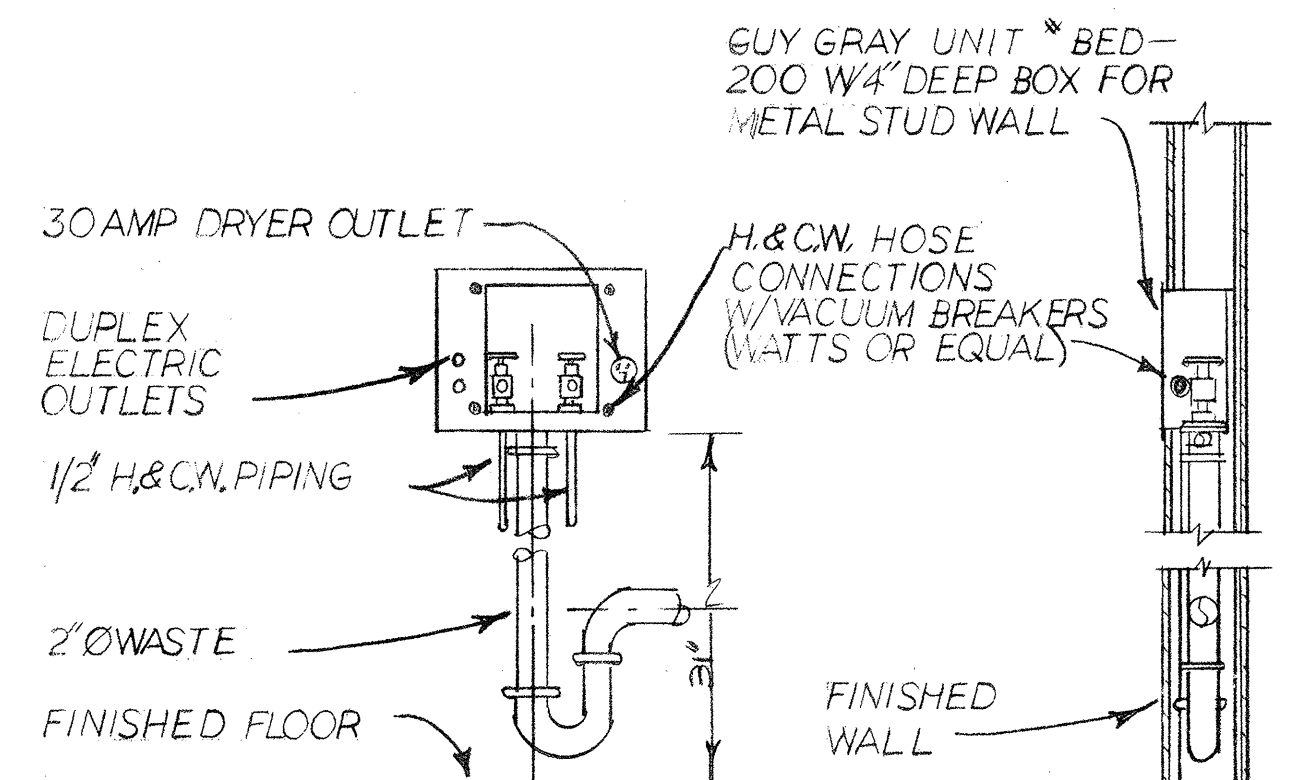


TYPICAL WASHING MACHINE CONNECTION DETAIL

N.T.S.

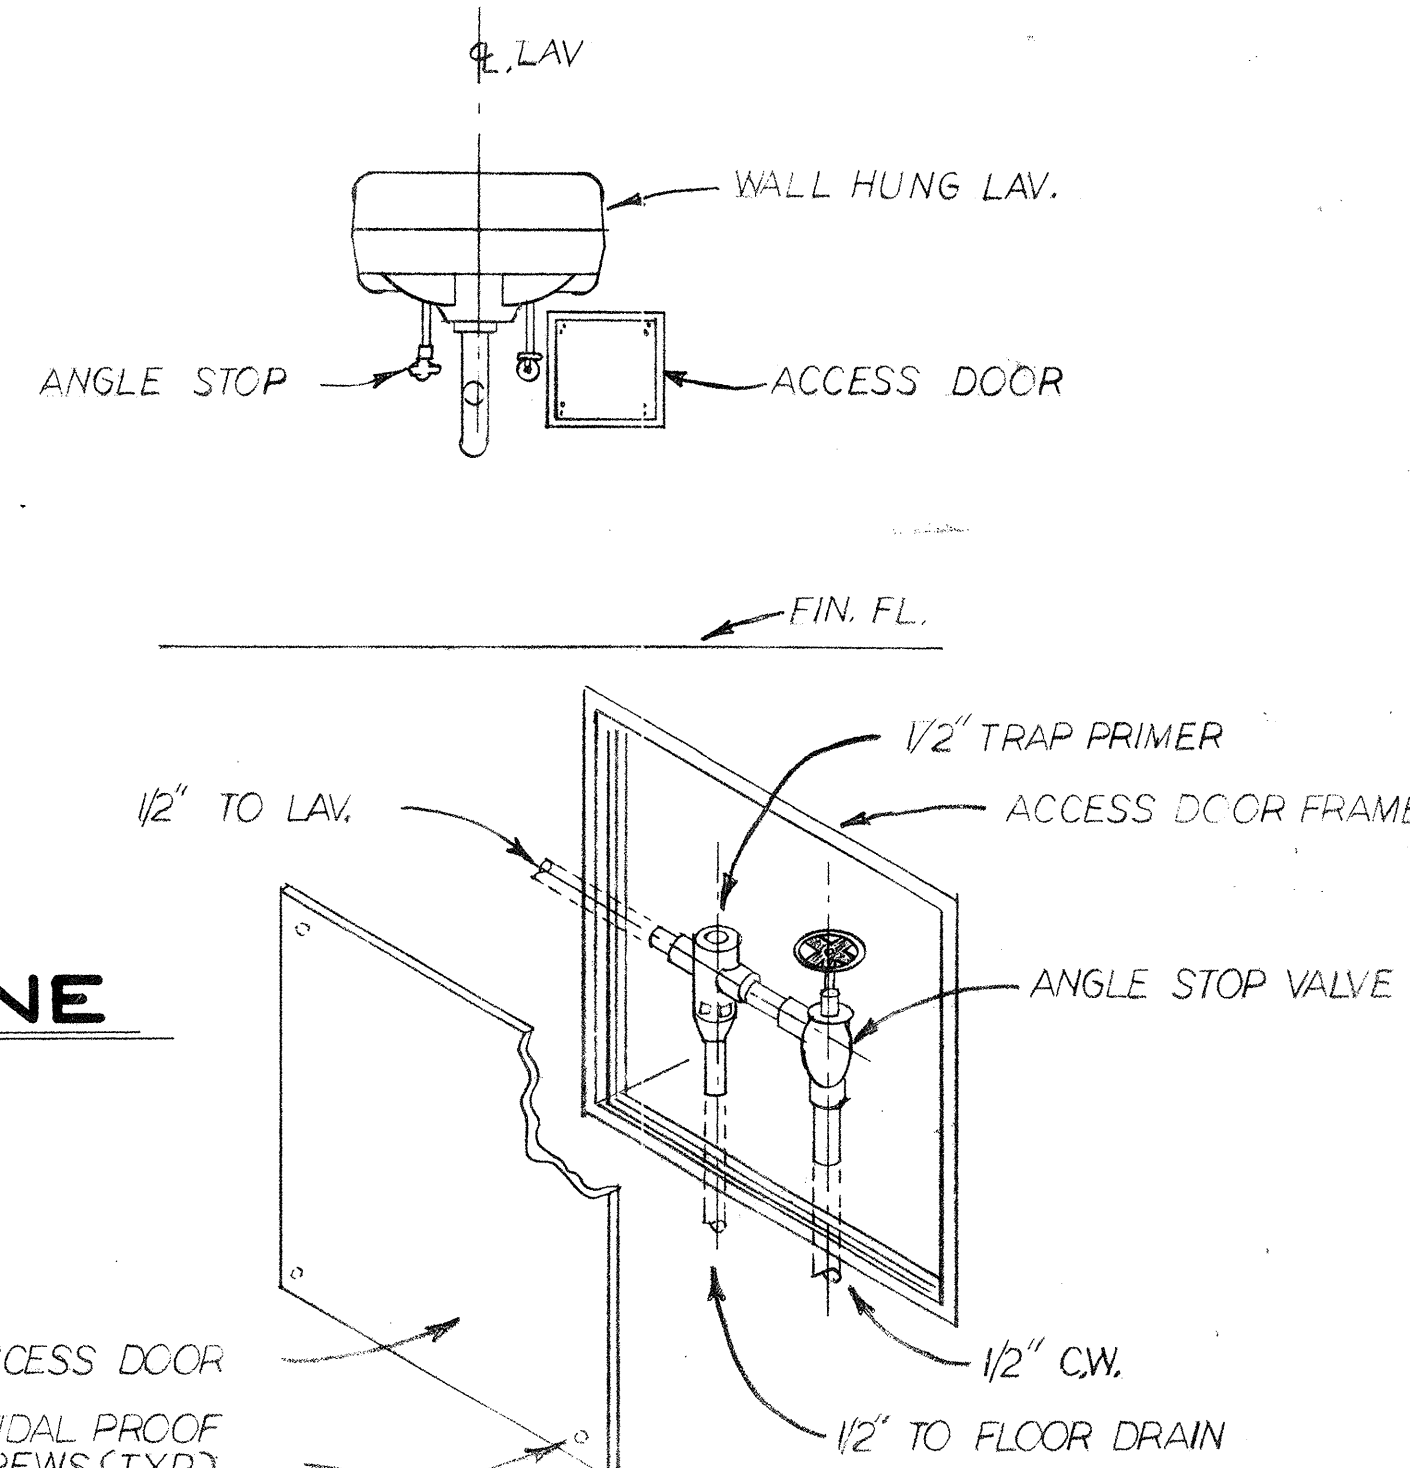


TYPICAL TRAP PRIMER DETAIL

N.T.S.

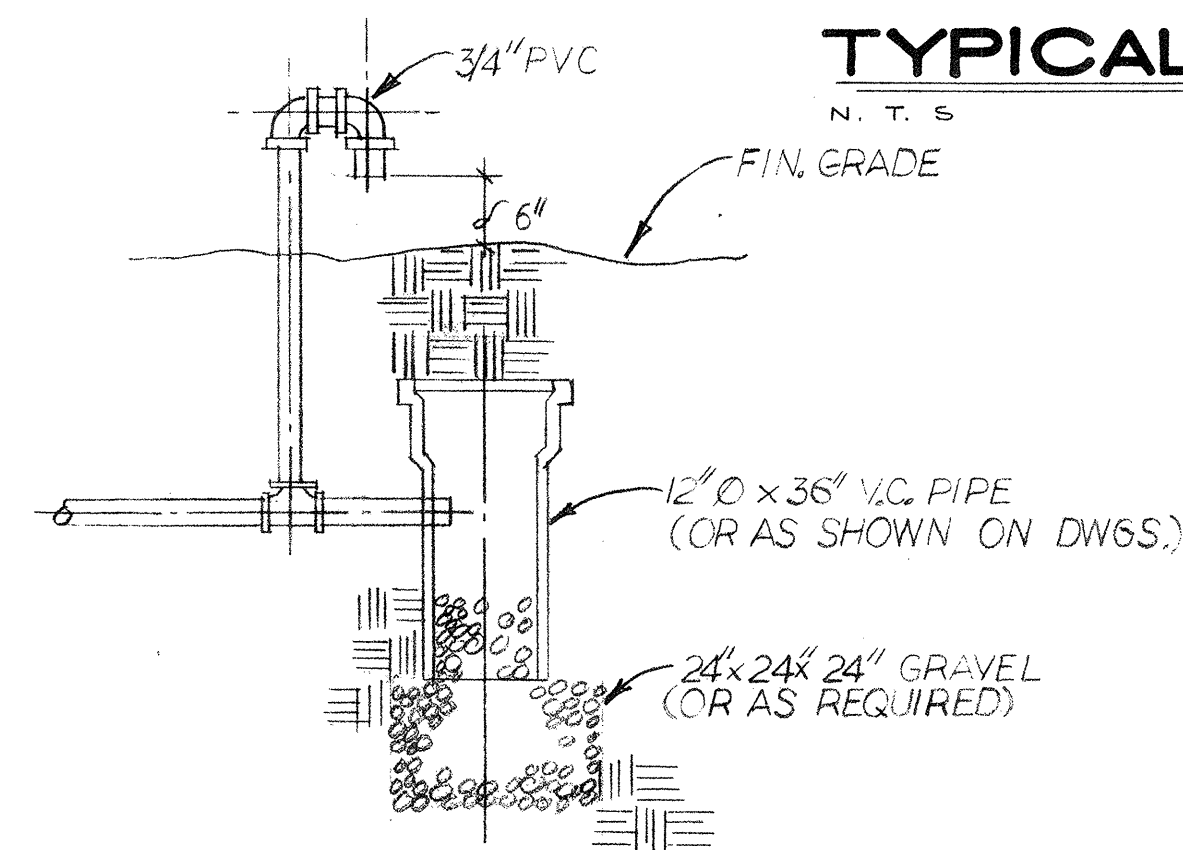

DRYWELL DETAIL


NO SCALE

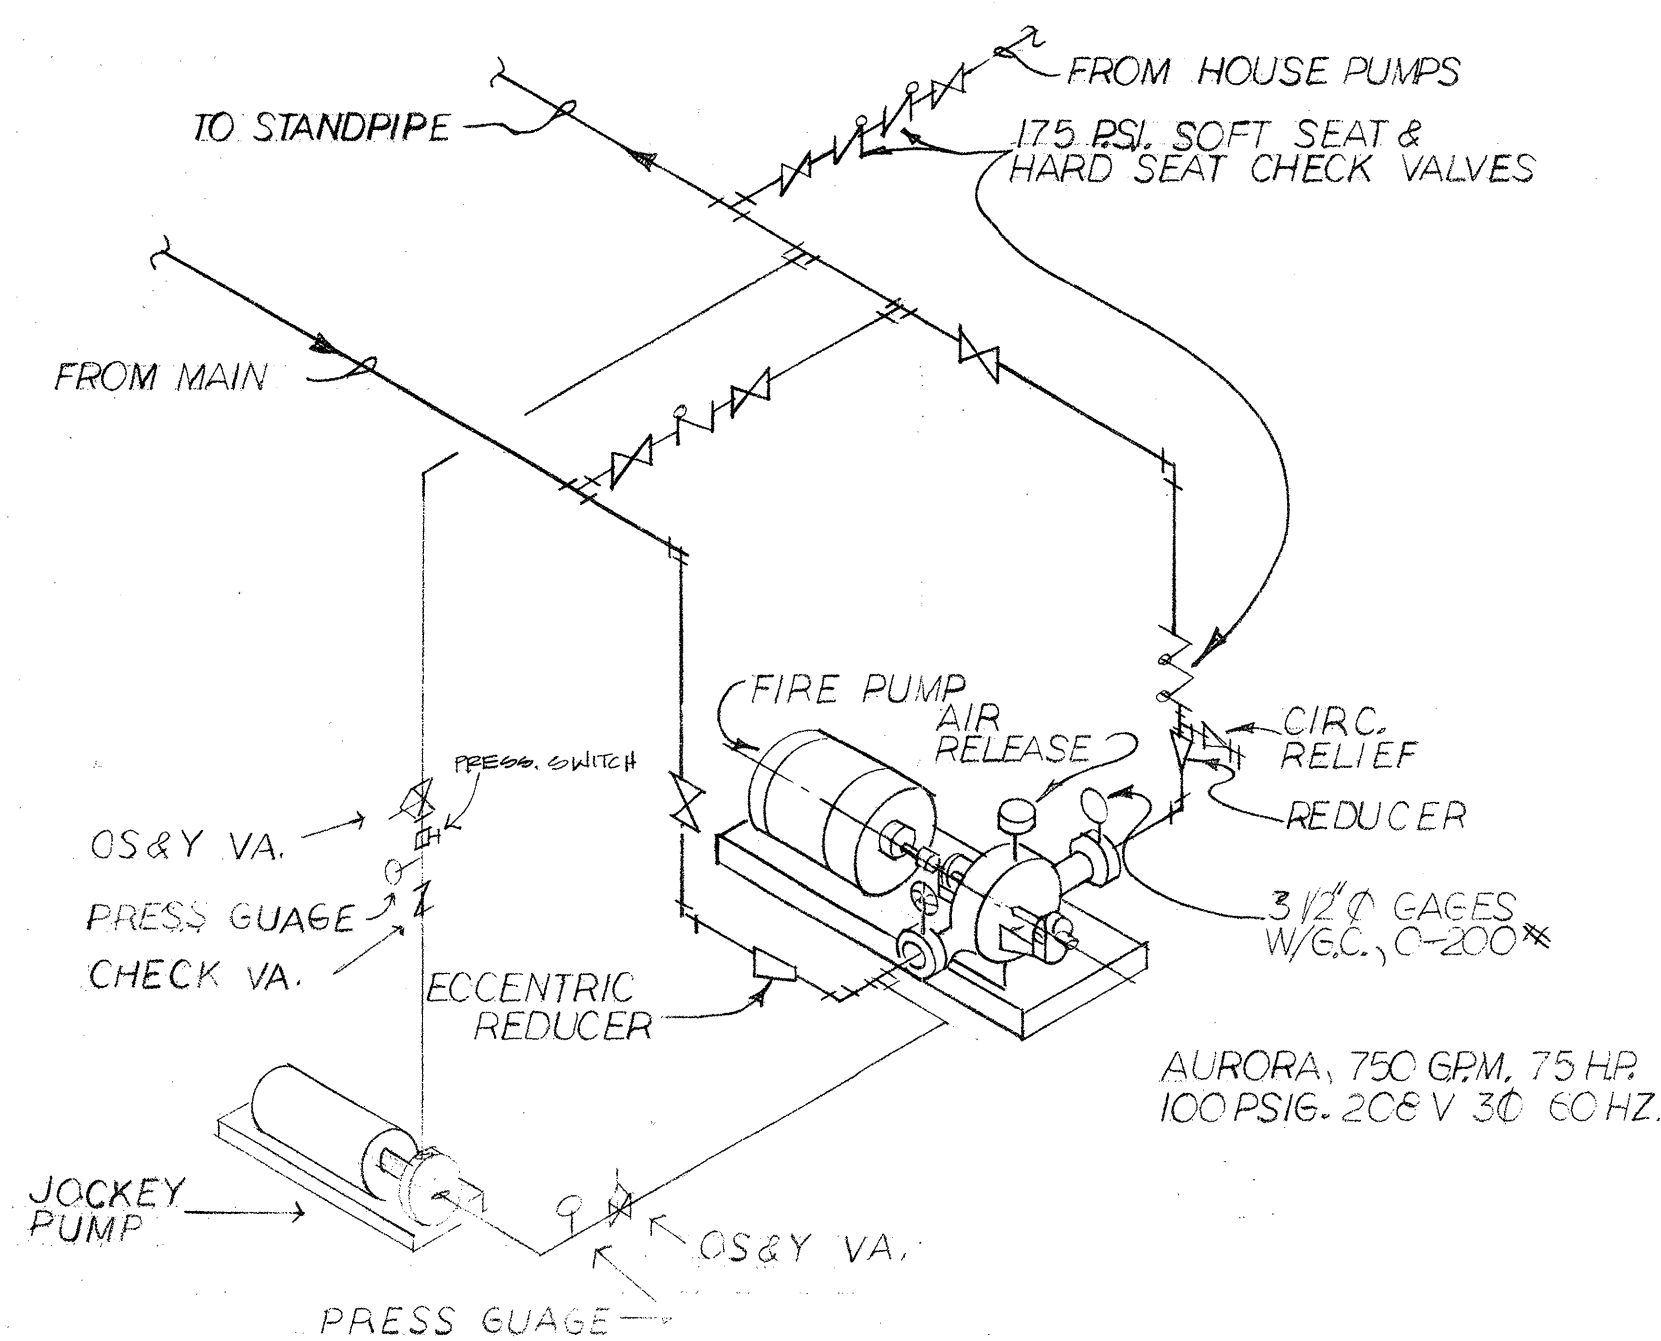

FIRE PUMP DETAIL

N.T.S.

REDUCE VOLT STARTER

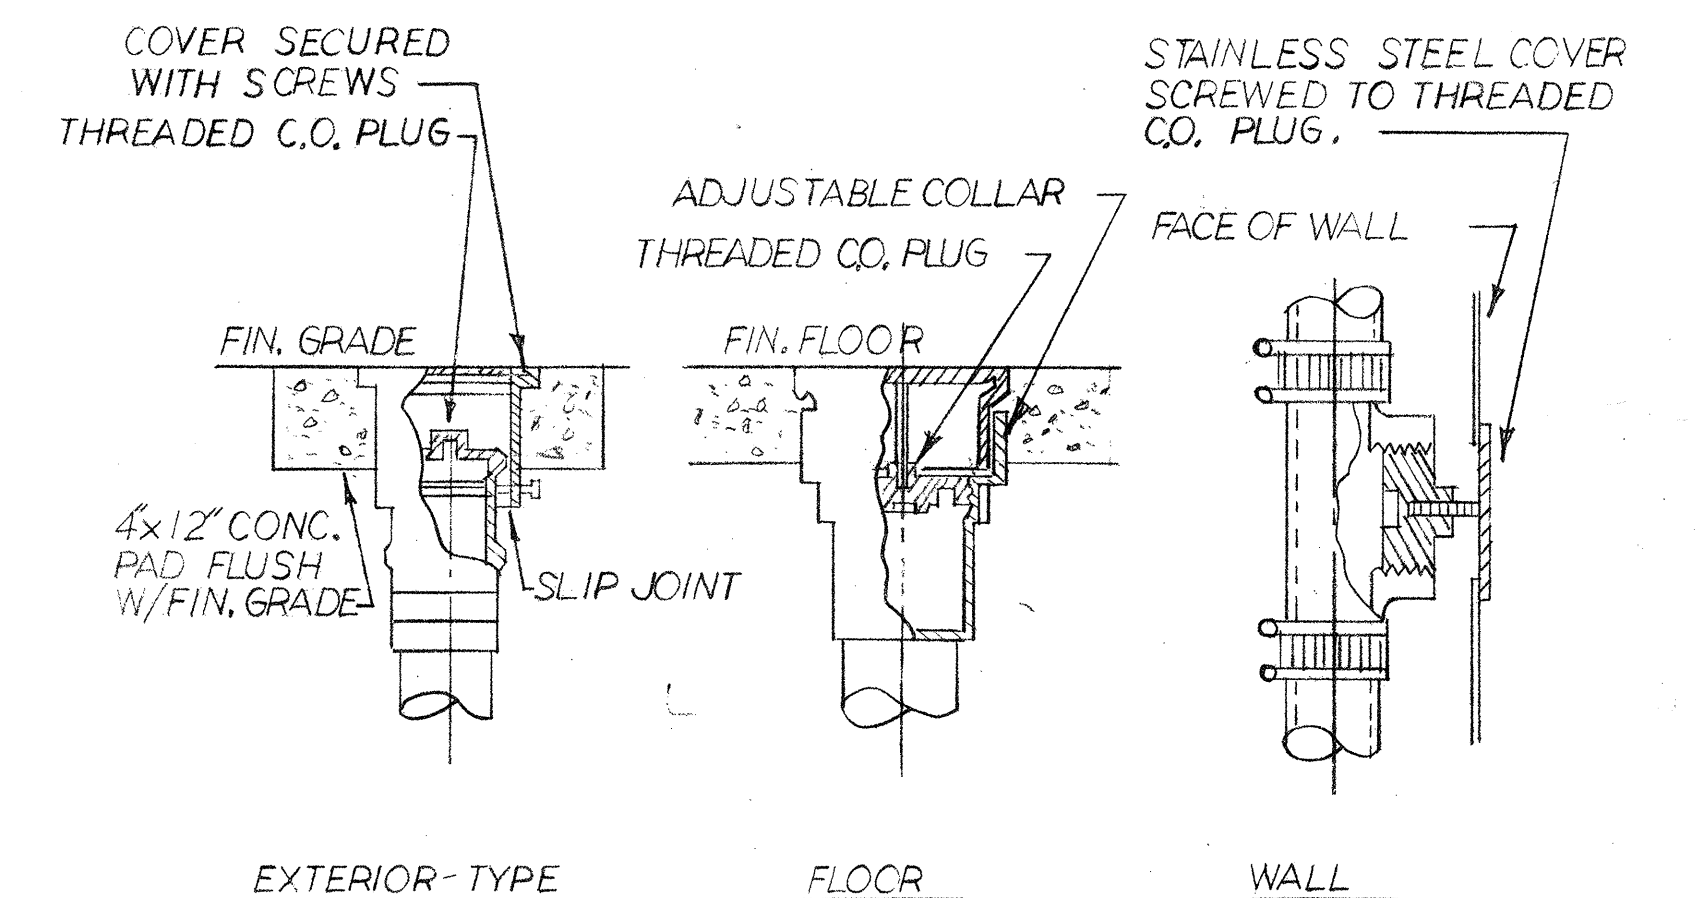

TYPICAL CLEANOUT DETAIL

N.T.S.

Eugenio
3/3/88
Erquiaga

R. WM. CLAYTON JR. ARCHITECT
1995 EAST OAKLAND PARK BLVD. FT. LAUDERDALE, FLA.
E & E CONSULTING ENGINEERS
2701 EAST SUNRISE BLVD. FT. LAUDERDALE, FLA.
OVERLOOK CONDOMINIUM
DETAILS

DRAWN BY: M.B.
JOB NO: 8101
DATE: 8-12-81
REVISIONS: 6-11-84
AS BUILT 2-8-88
SHEET: **P10**