




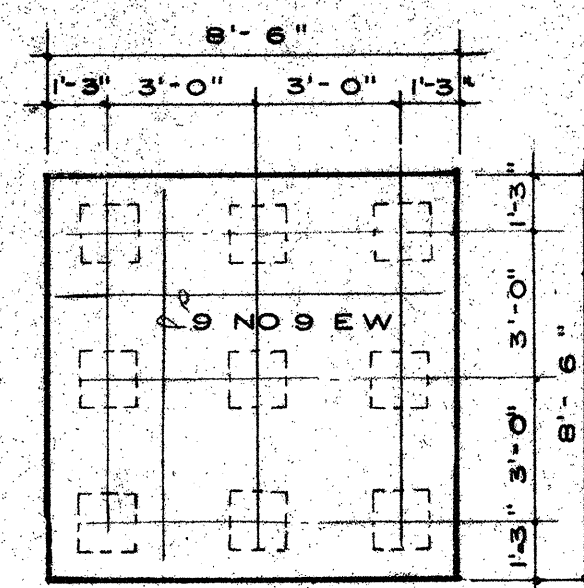


DEPTH = 3'-6"

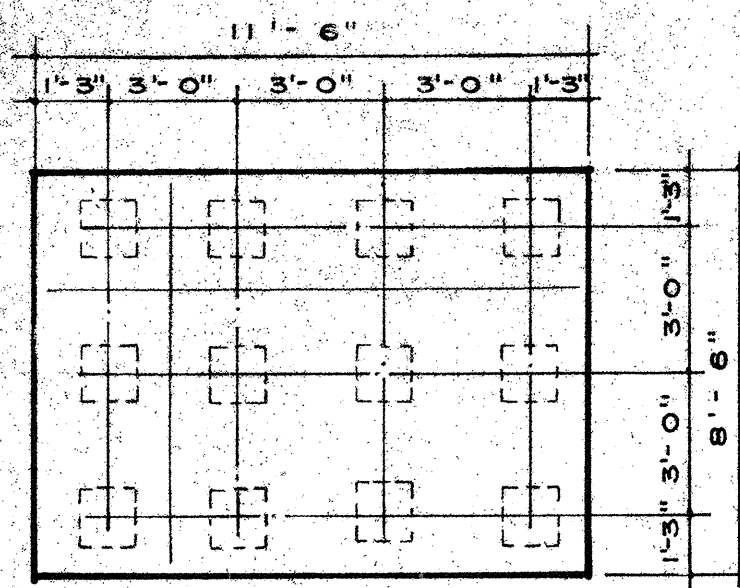

DEPTH = 4'-0"
NO. 9 AT 8" C/C SL (LONG WAY)
NO. 8 AT 10" C/C SS (SHORT WAY)

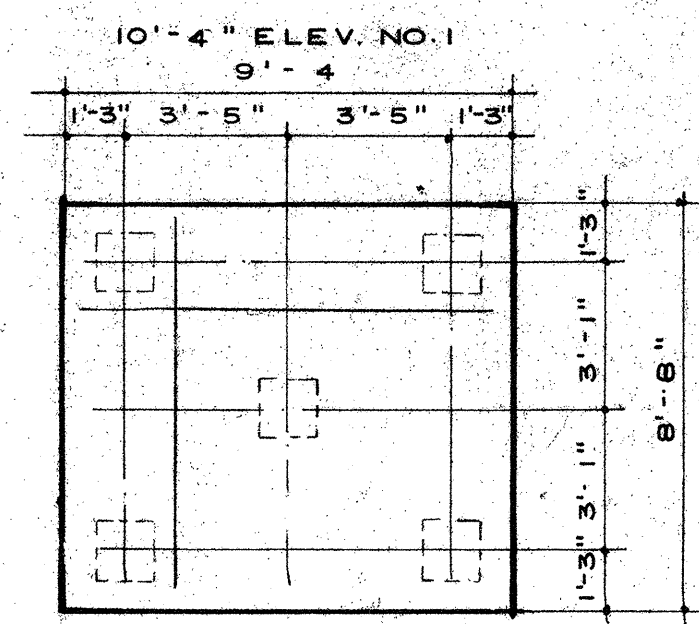


DEPTH = 3'1" 9 NO. 8 EA WAY

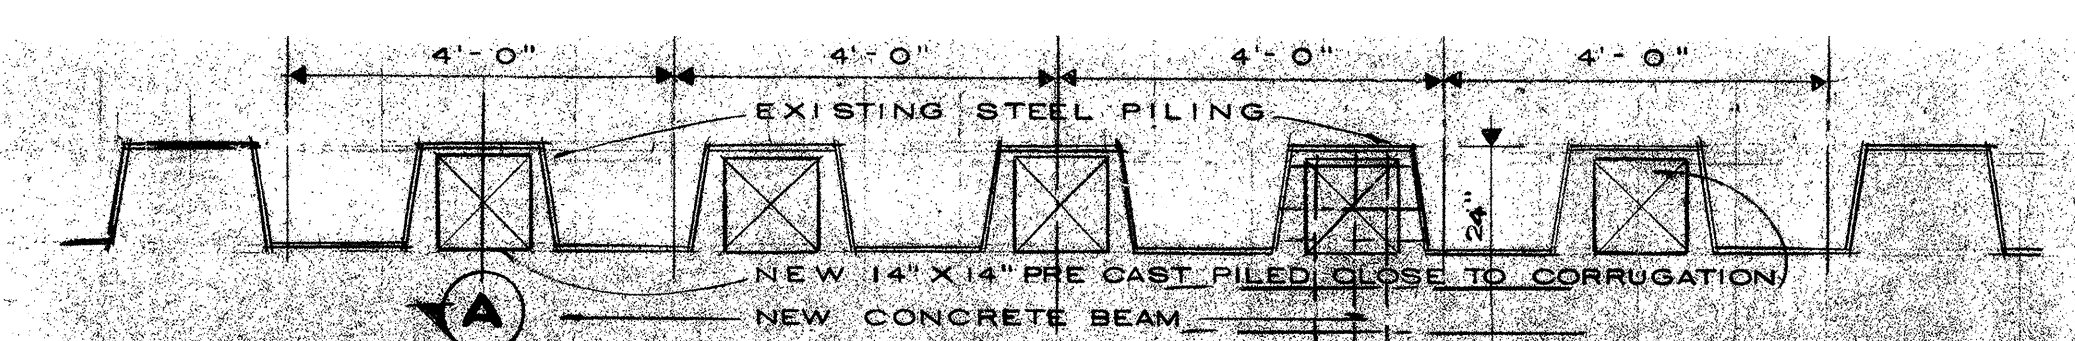


TYPICAL EAST WALL PILE PLAN

SCALE 1/2" = 1'-0"

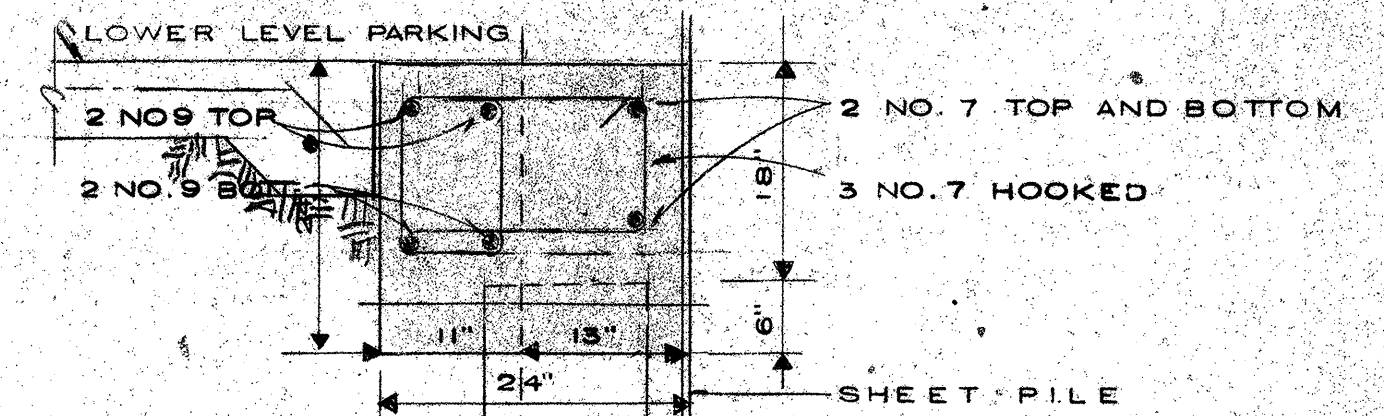

SECTION "A"

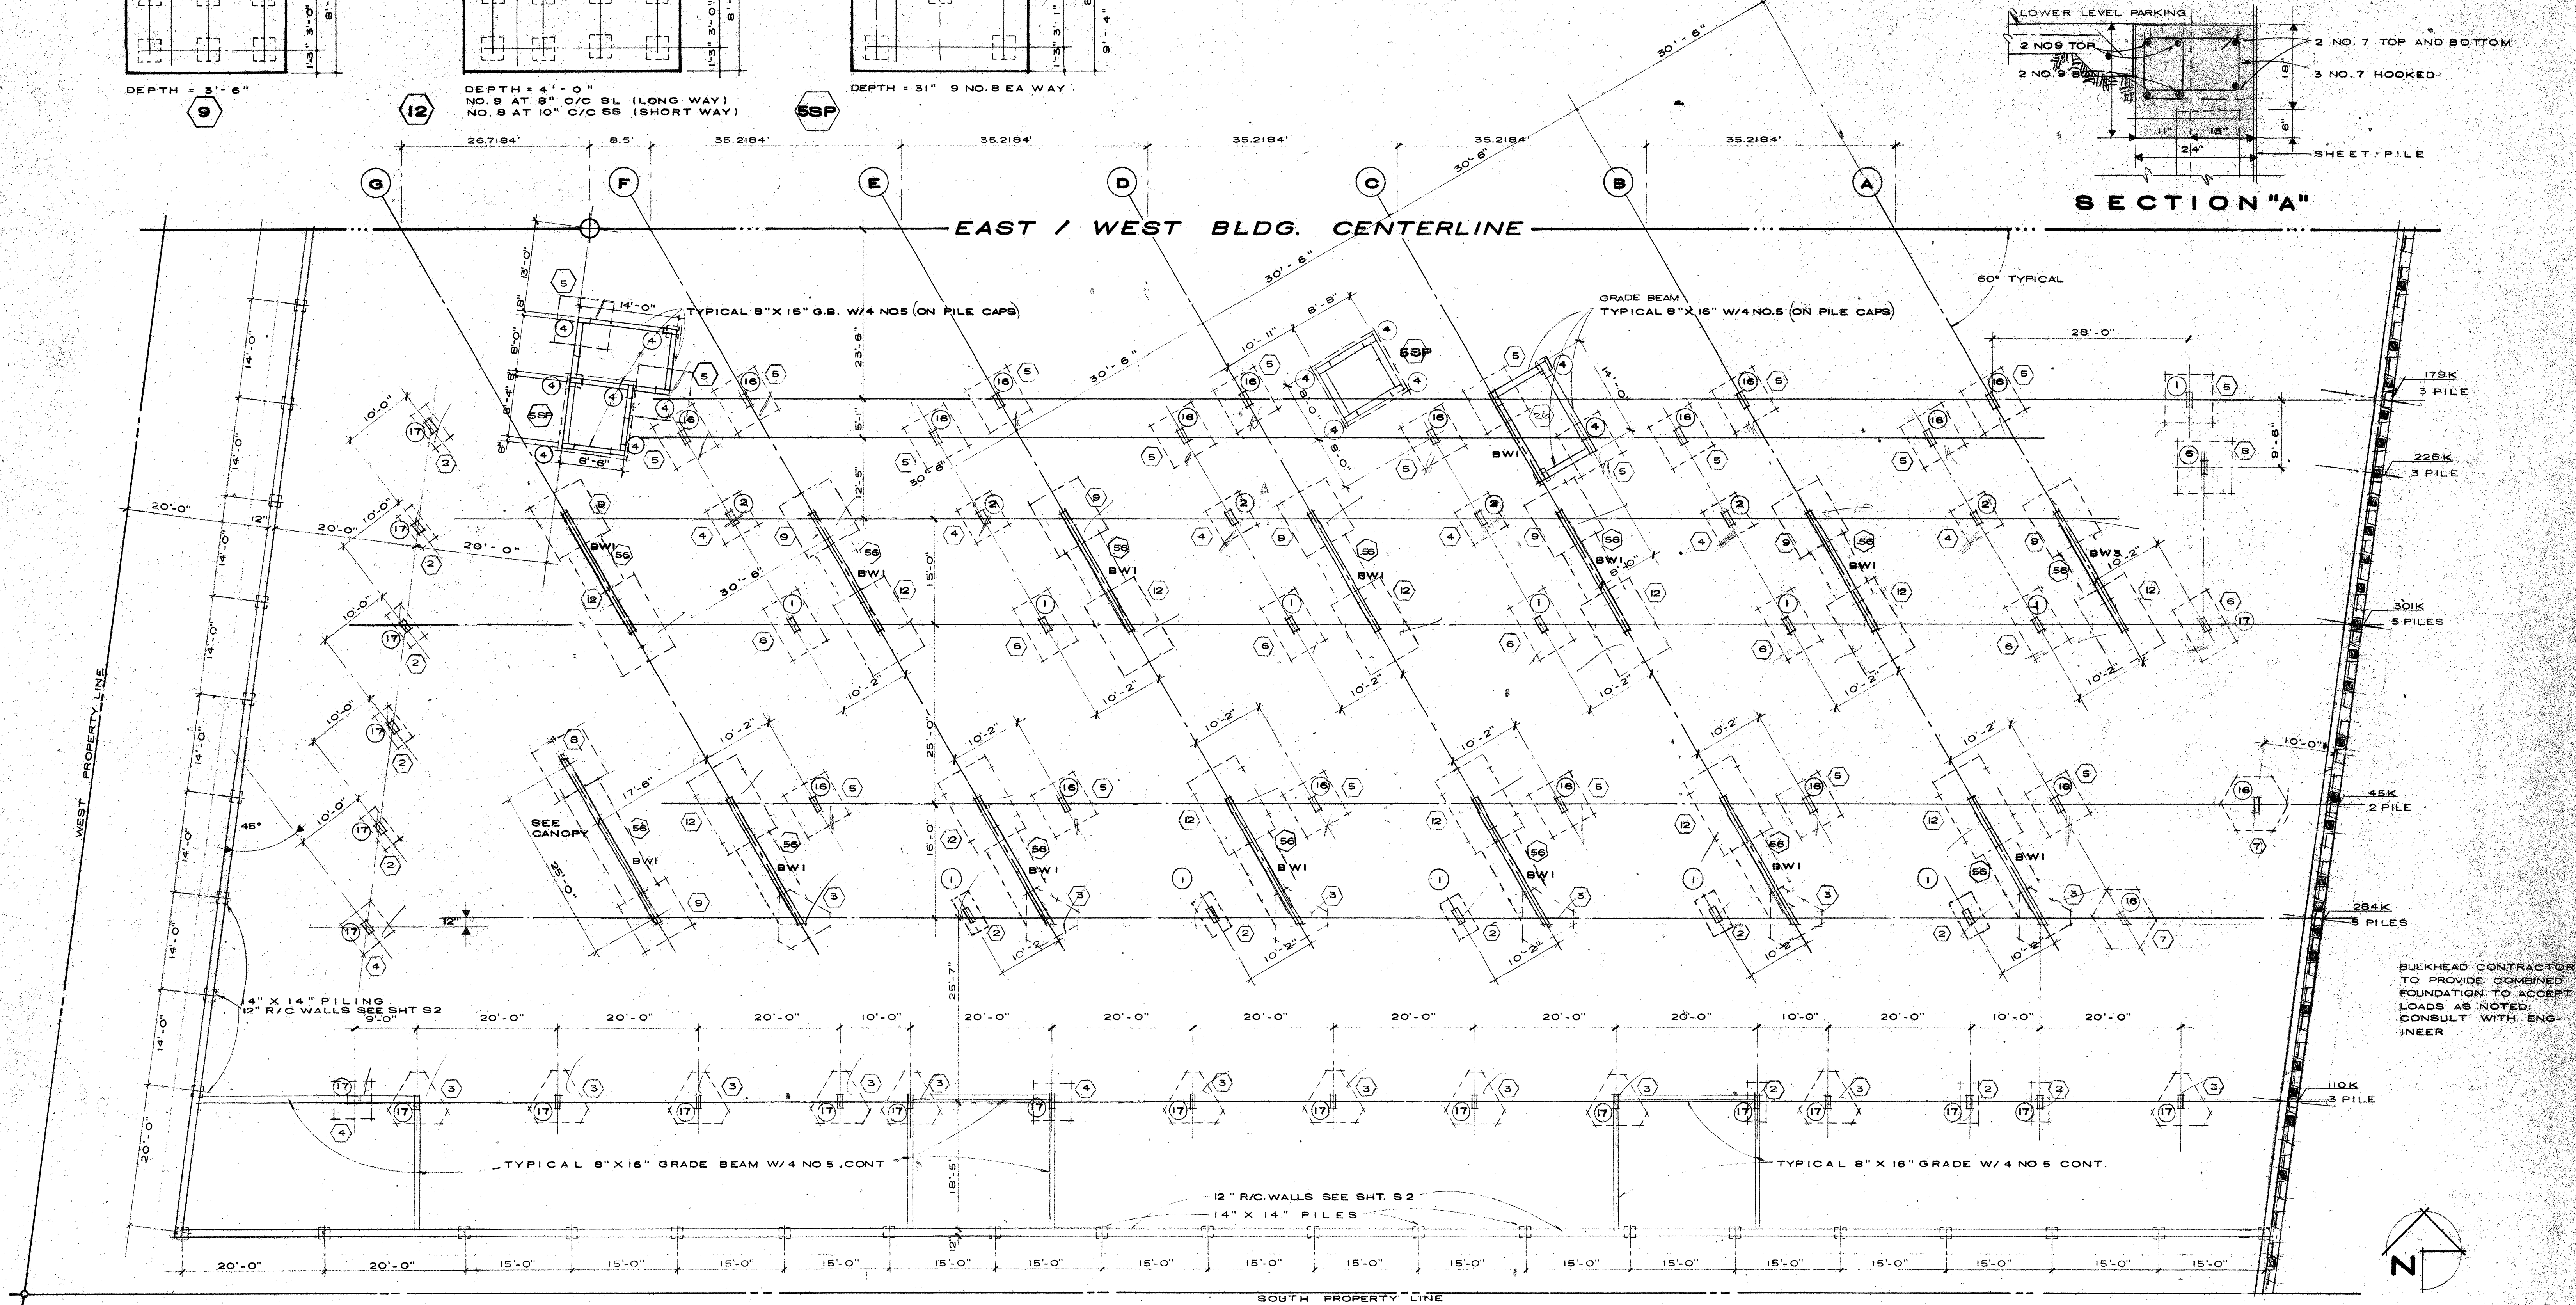

NOTE: SEE SHT. S9 FOR LOWER LEVEL PARKING FRAMING

BULKHEAD CONTRACTOR TO PROVIDE COMBINED FOUNDATION TO ACCEPT LOADS AS NOTED. CONSULT WITH ENGINEER

FOUNDATION PLAN / SOUTH

SCALE 3/32" = 1'-0"

PILE CAP NOTES

1. ALL PILES SHALL BE 14" X 14" PRESTRESSED CONCRETE AND SHALL ATTAIN A STRENGTH OF 5000 PSI. CONCRETE SHALL ATTAIN 3000 PSI. BEFORE STRANDS ARE RELEASED. THE USE OF HIGH EARLY CONCRETE OR ADDITIVES SHALL BE SUBMITTED TO THE ENGINEER FOR APPROVAL BEFORE FABRICATION BEGINS. PROVISIONS SHALL BE MADE TO TEST ONE STRAND FROM EACH ROLL.
2. ALL PILING SHALL BE JETTED OR DRIVEN TO A SAFE BEARING CAPACITY OF 36 TONS FOR 14" X 14" PILES.
3. PILES TO BE CUT OFF SQUARE AT PROPER ELEVATIONS ALLOWING A MINIMUM OF 18" OF PILE STEEL TO PROJECT INTO PILE CAPS.
4. LOAD TEST SHALL BE MADE ON THE PILING IN PLACE AND SHALL BE LOCATED AT THE DISCRETION OF THE ENGINEER.

JUN 15 1988

R. WM. CLAYTON JR. ARCHITECT
1995 EAST OAKLAND PARK BLVD. FT. LAUDERDALE, FLA.
C. S. HOUSA CONSULTING ENGINEERS
3460 N.W. 9TH AVENUE OAKLAND PARK, FLA.

OVERLOOK CONDOMINIUM

FOUNDATION PLAN

DRAWN BY: RWC
JOB NO: 8101
DATE: 9-12-81
REVISIONS: 4-3-84
6-11-84
8-27-84
AS BUILT 2-9-88
SHEET: 51