


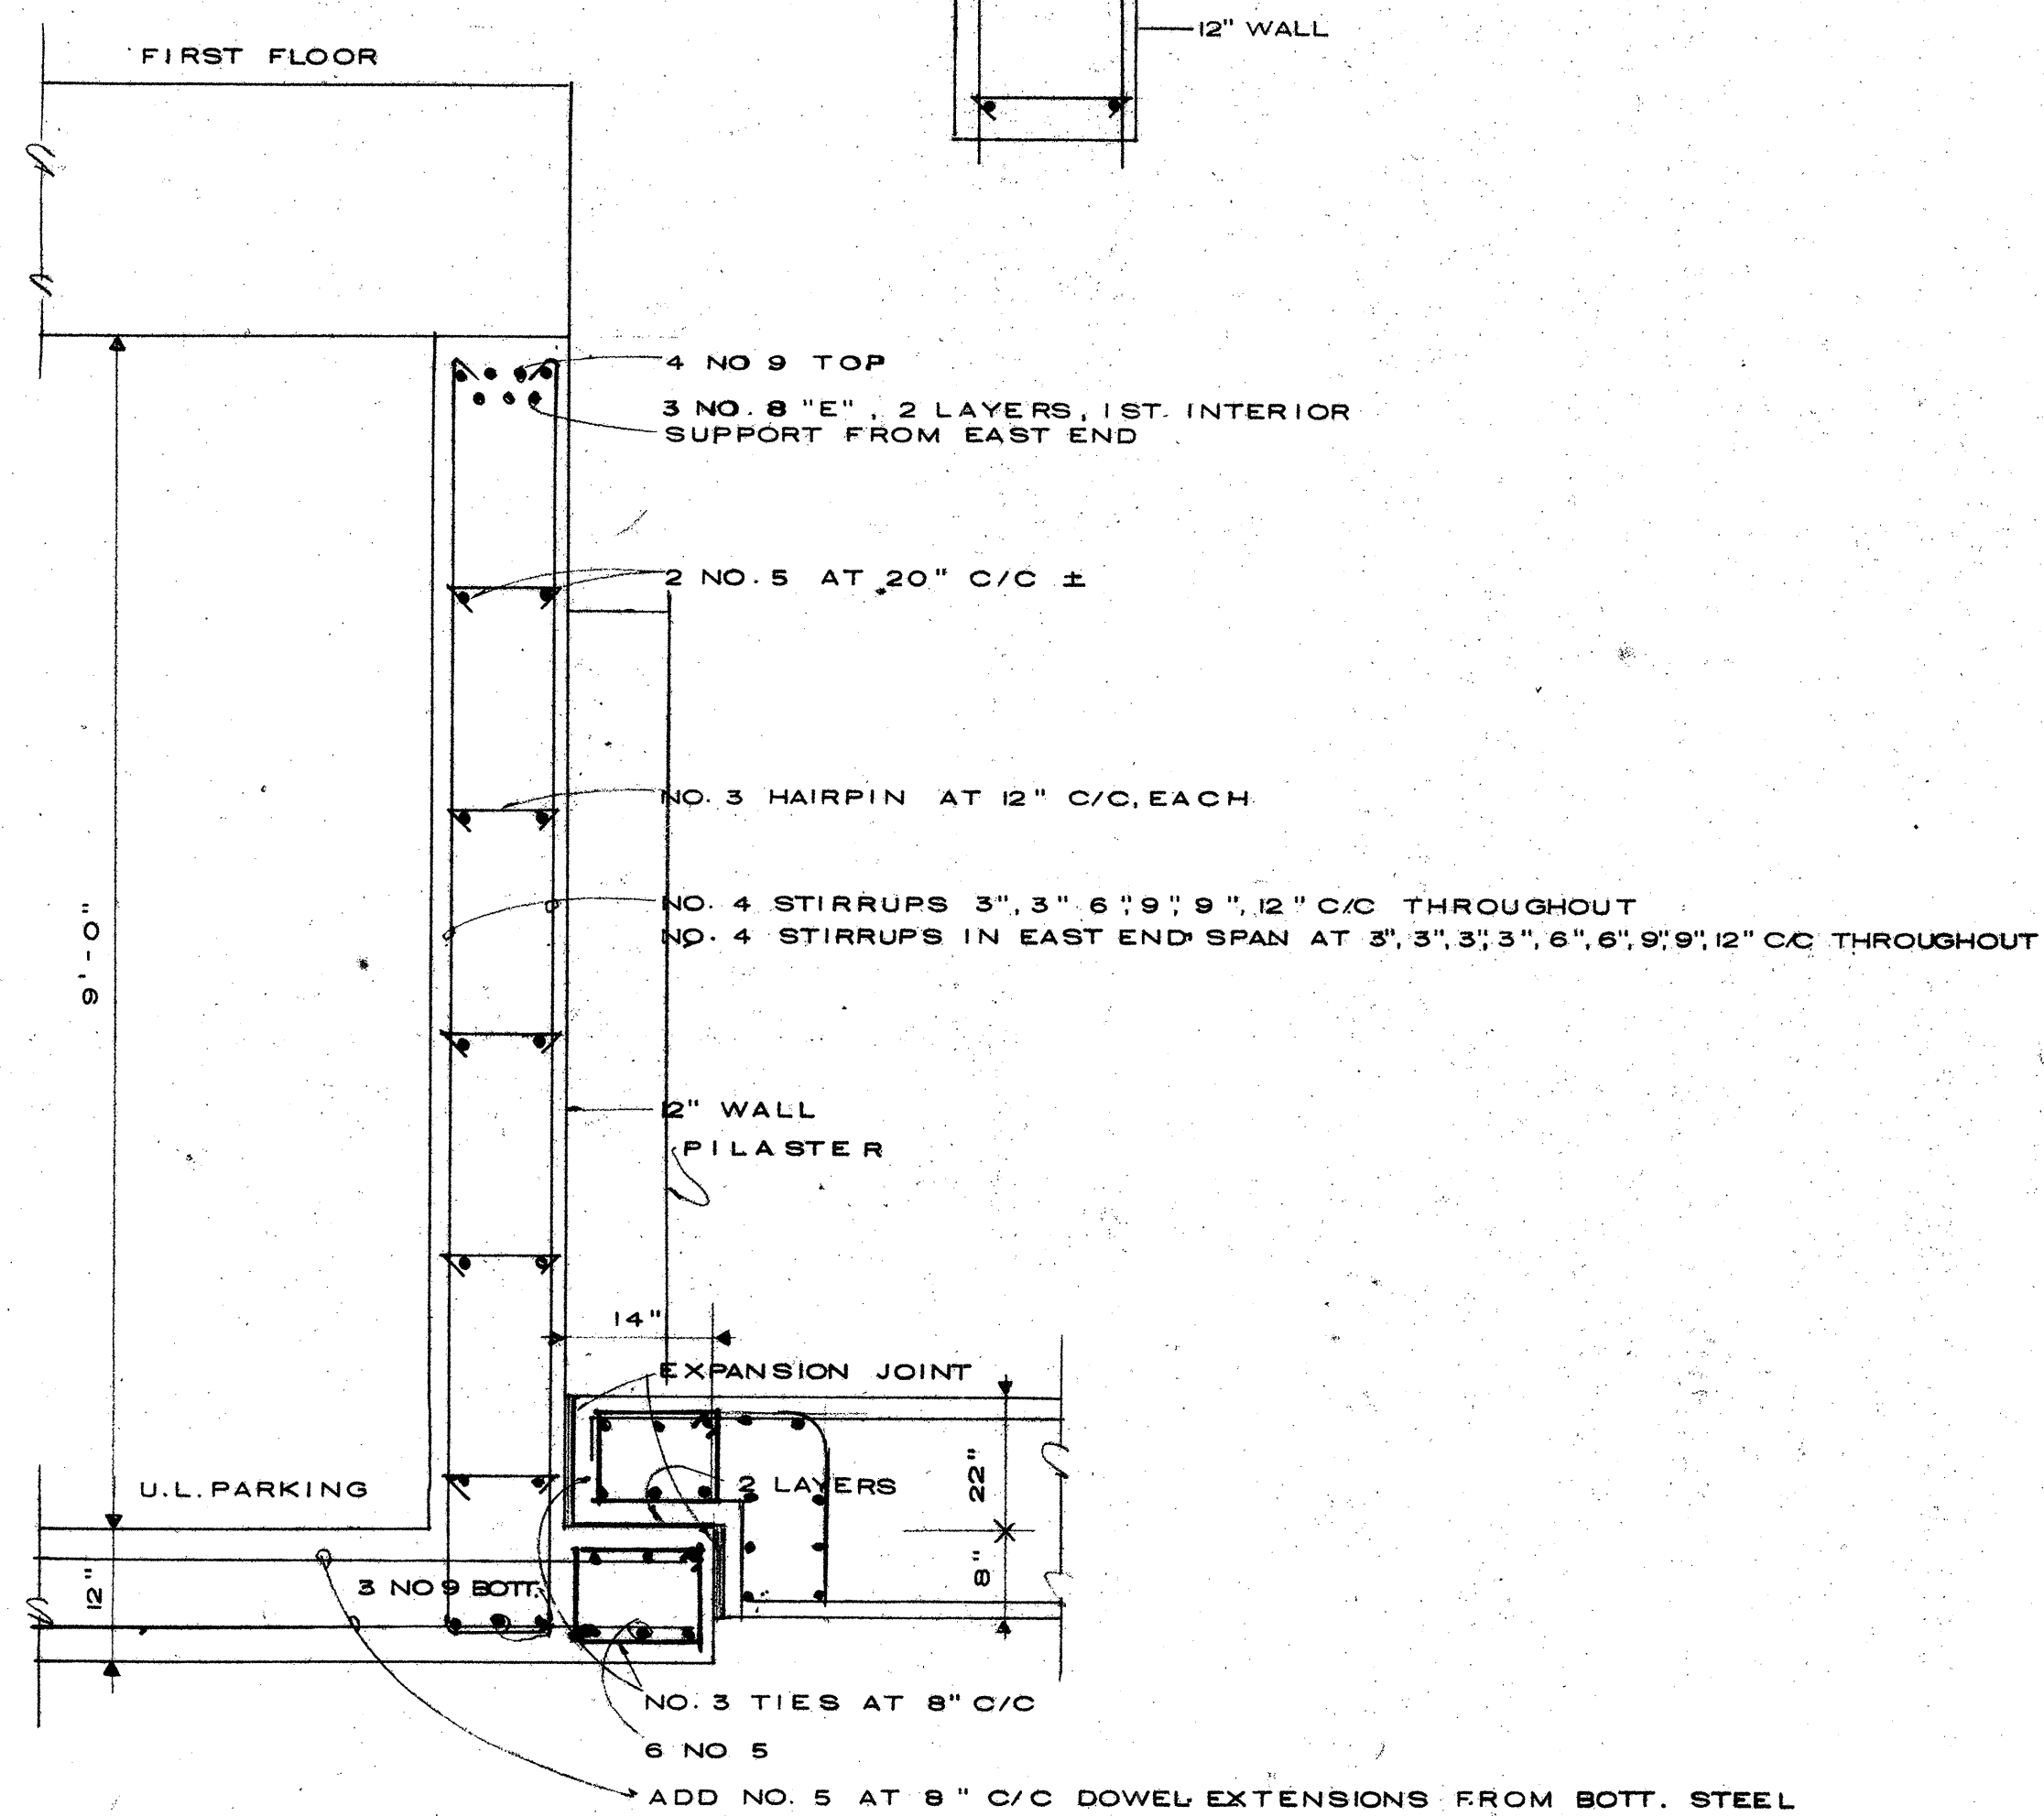


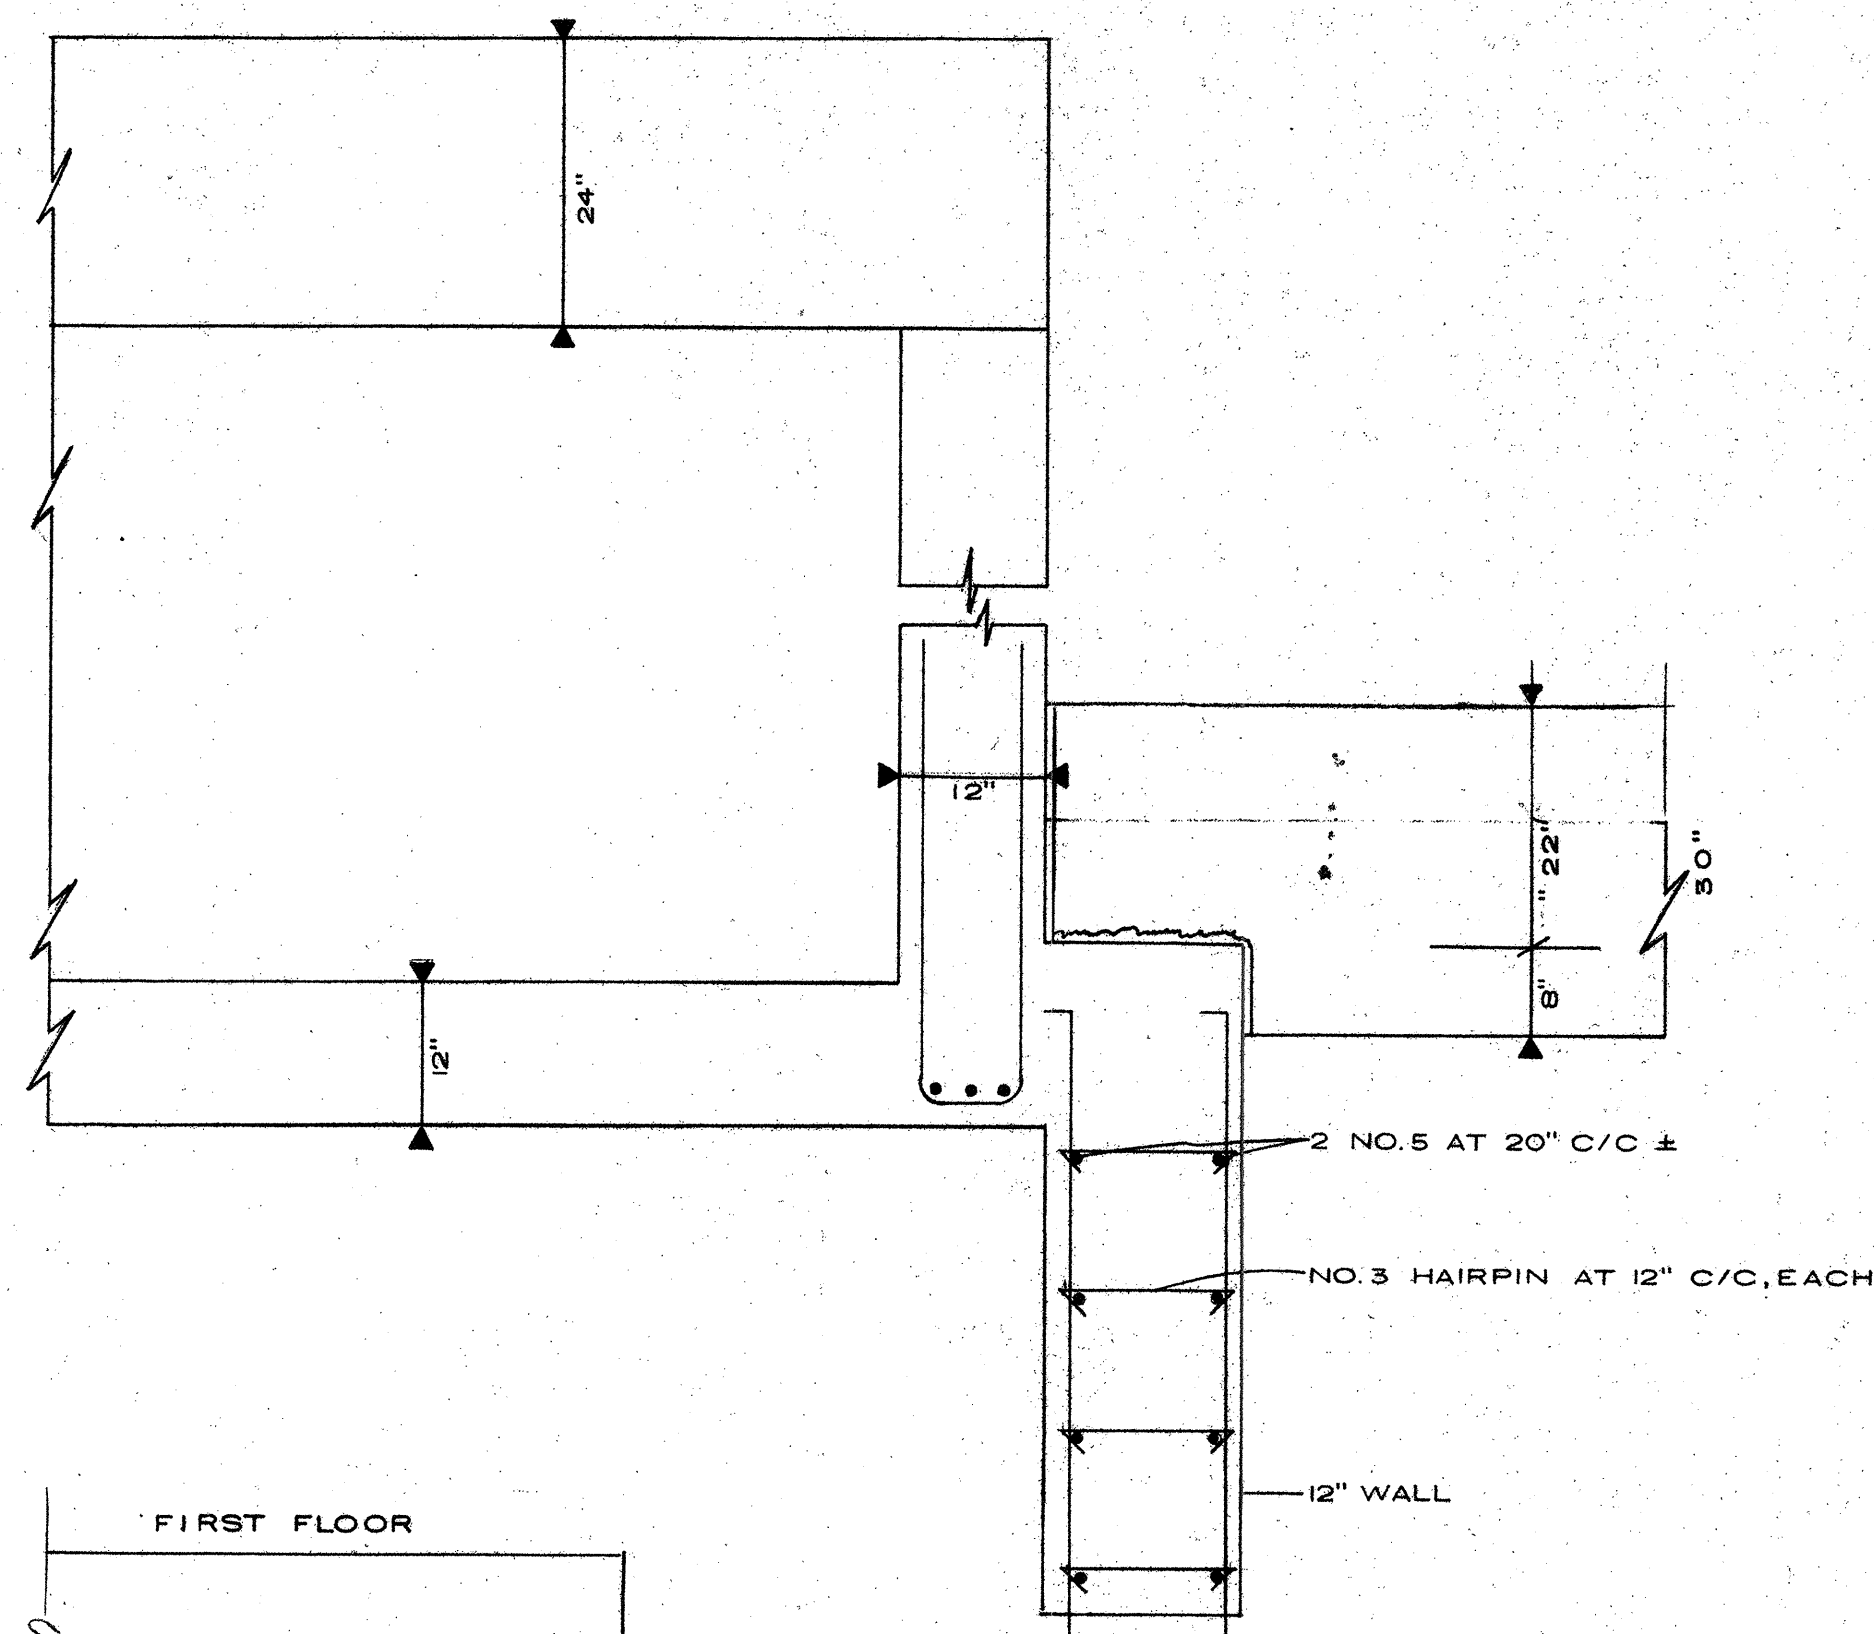

SECTION "2-2"
SCALE 3/4" = 1'-0"

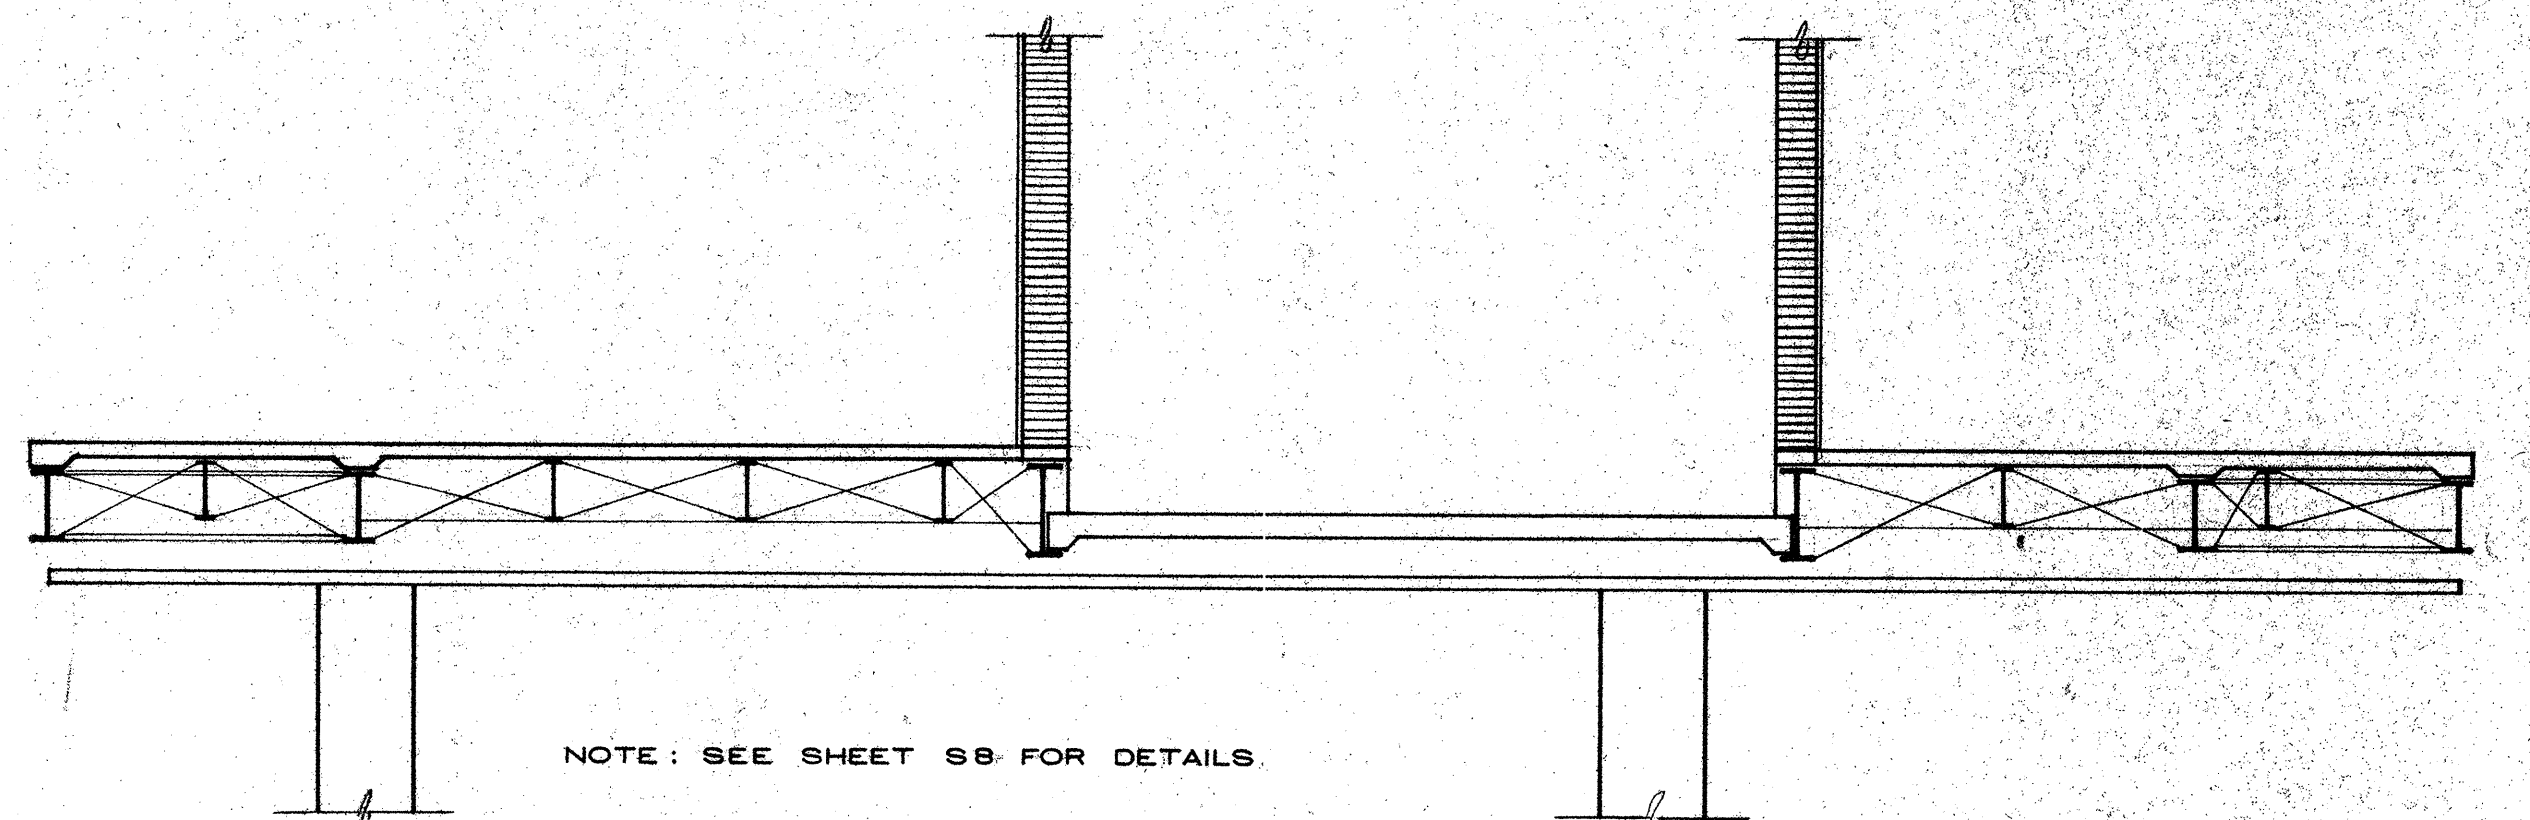


CANOPY SECTION B-B SCALE 1/4" = 1'-0"

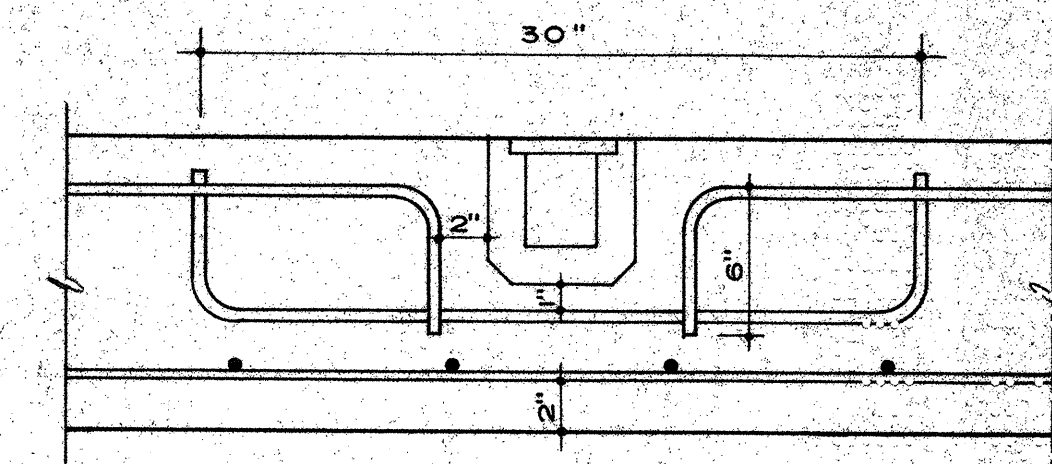


UPPER LEVEL PARKING PLAN
INTERCEPTOR DRAIN INSTALLATION


EXPANSION JOINT FOR FLOORS

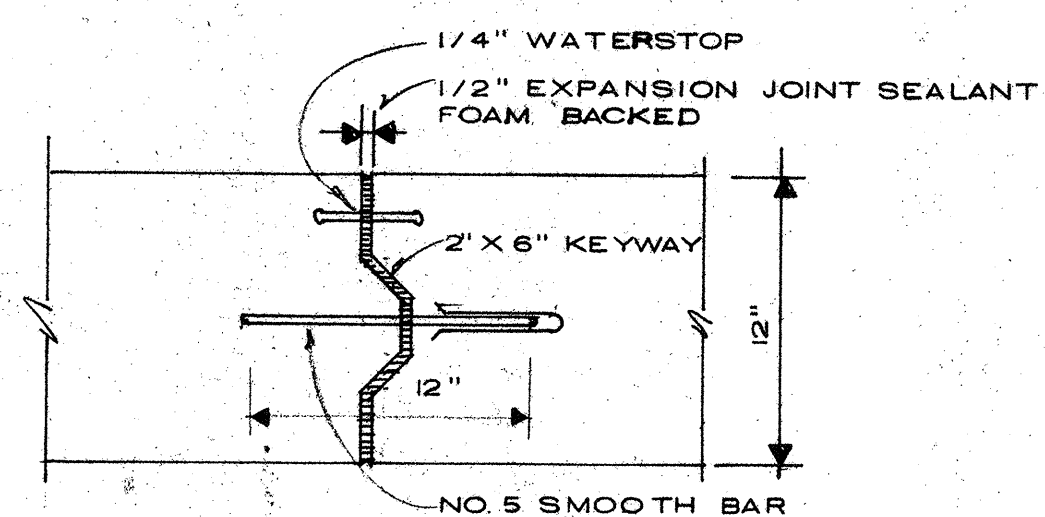



EXPANSION DETAIL FOR 12"

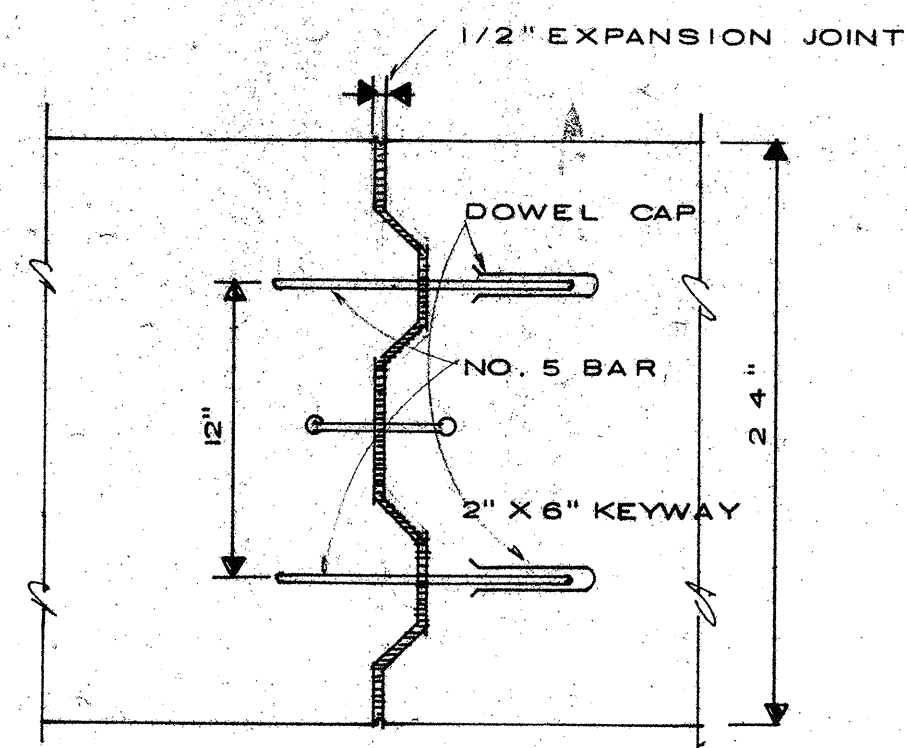


EXPANSION DETAIL FOR 24"

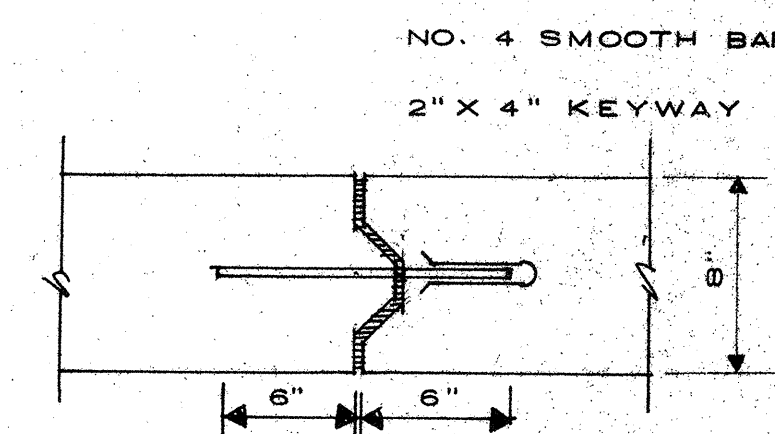

EXPANSION DETAIL FOR 8"

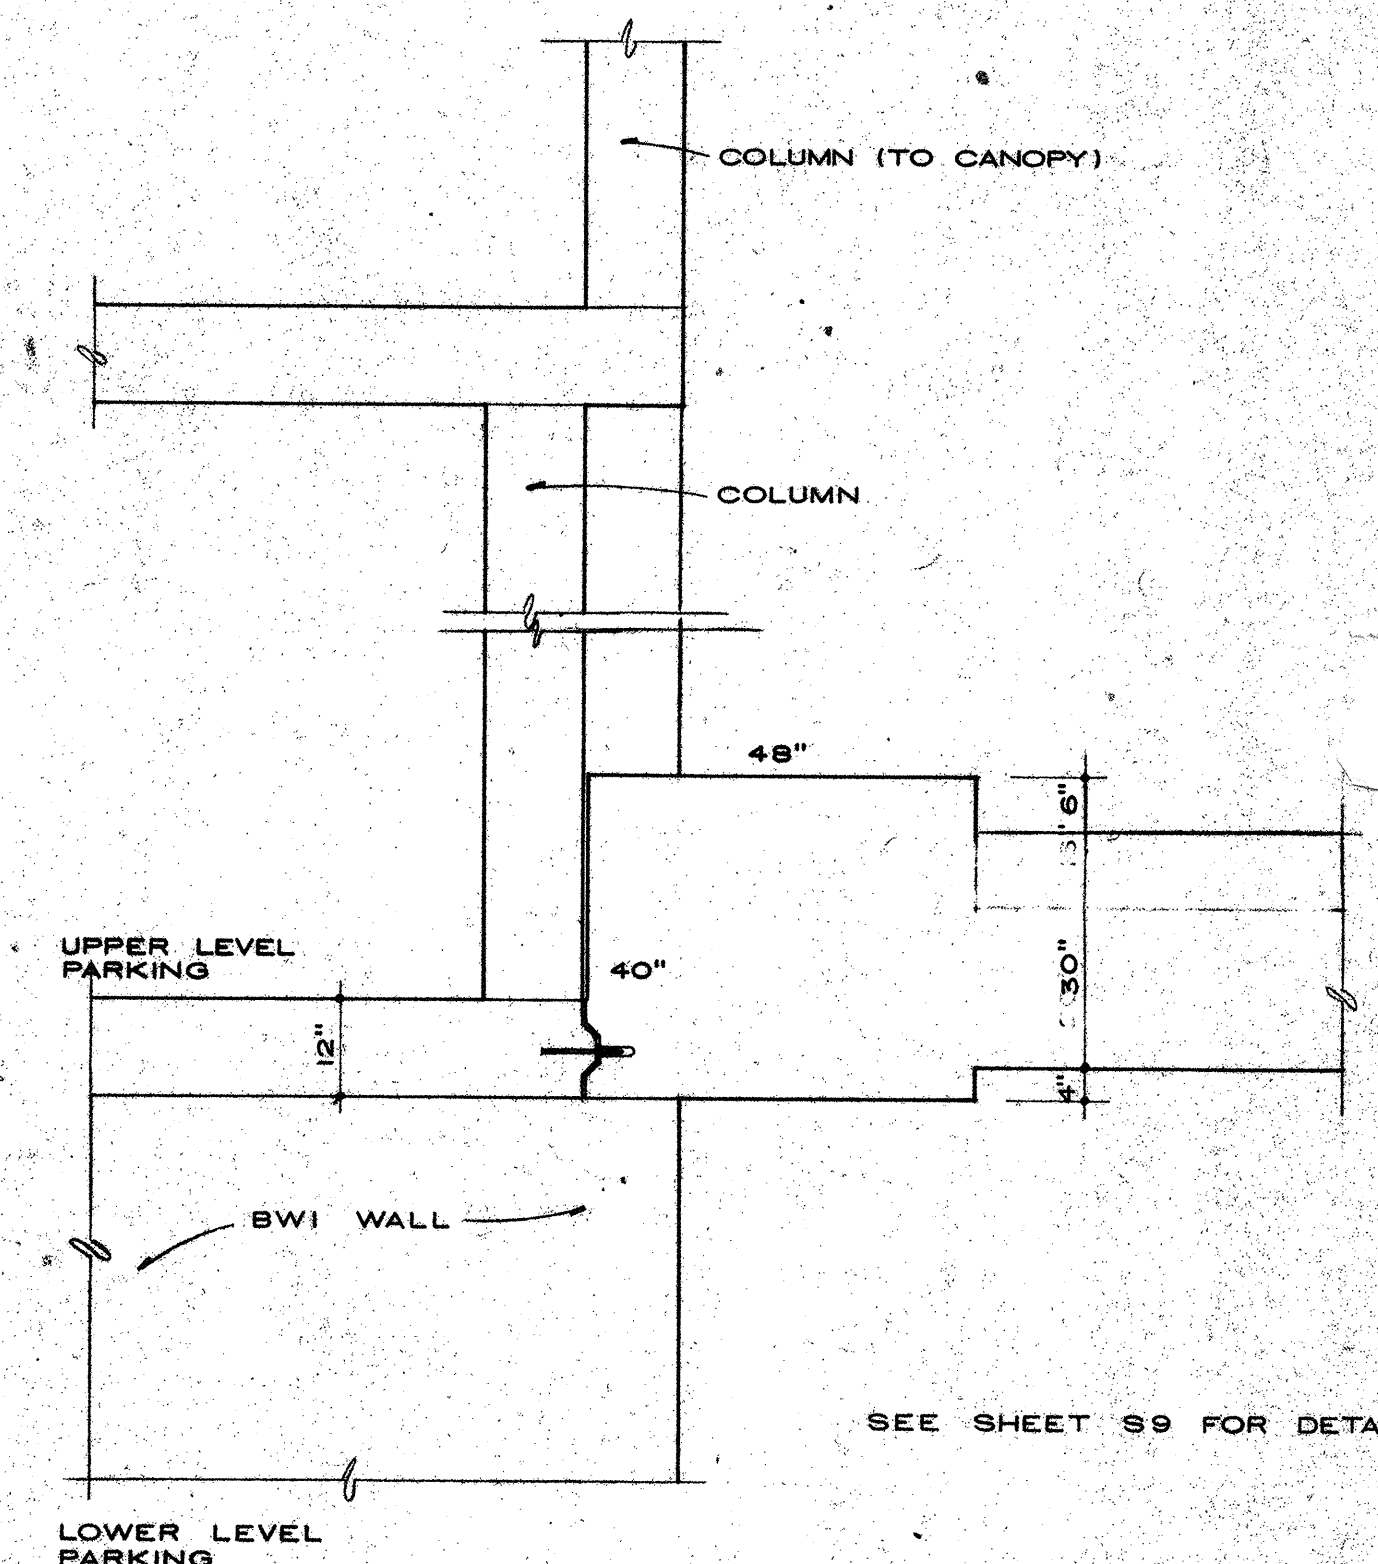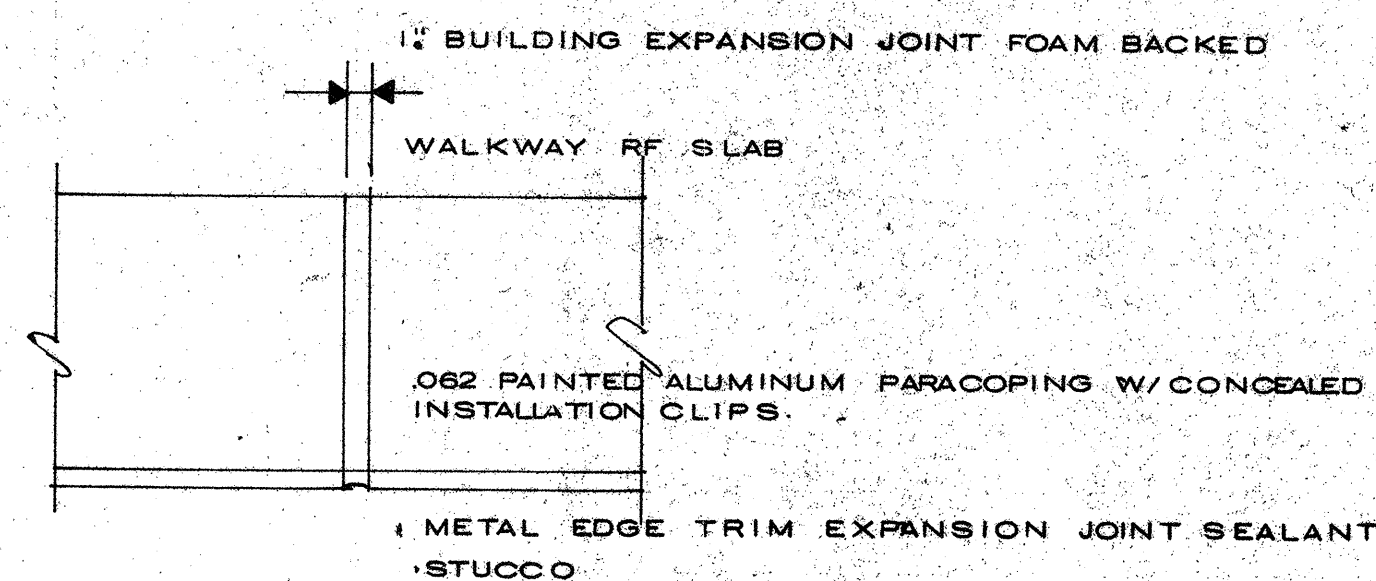

SECTION 1-1 SCALE 1/2" = 1'-0"

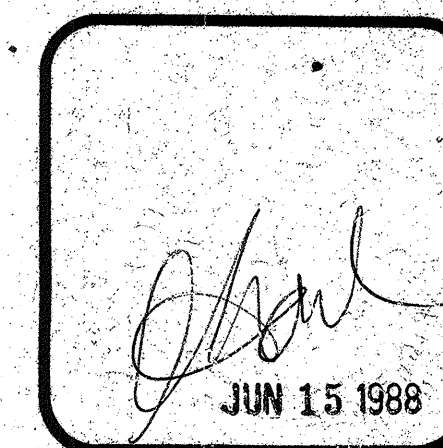

R. WM. CLAYTON, JR., ARCHITECT
1995 E. OAKLAND PARK BLVD., FT. LAUDERDALE, FL. - (305) 563-5913
C.S. HOUHA CONSULTING ENGINEERS
3460 N.W. 9TH AVENUE OAKLAND PARK, FLA.

OVERLOOK CONDOMINIUM

STRUCTURAL DETAILS

I CERTIFY, TO THE BEST OF MY KNOWLEDGE, THAT THESE PLANS
CONFORM TO ALL OF THE PREVAILING MINIMUM CODE REQUIREMENTS.

DRAWN BY: RWC
JOB NO:
DATE:
REVISIONS: 4/26/85
AS BUILT 2-8-88
SHEET NO: **S11**