



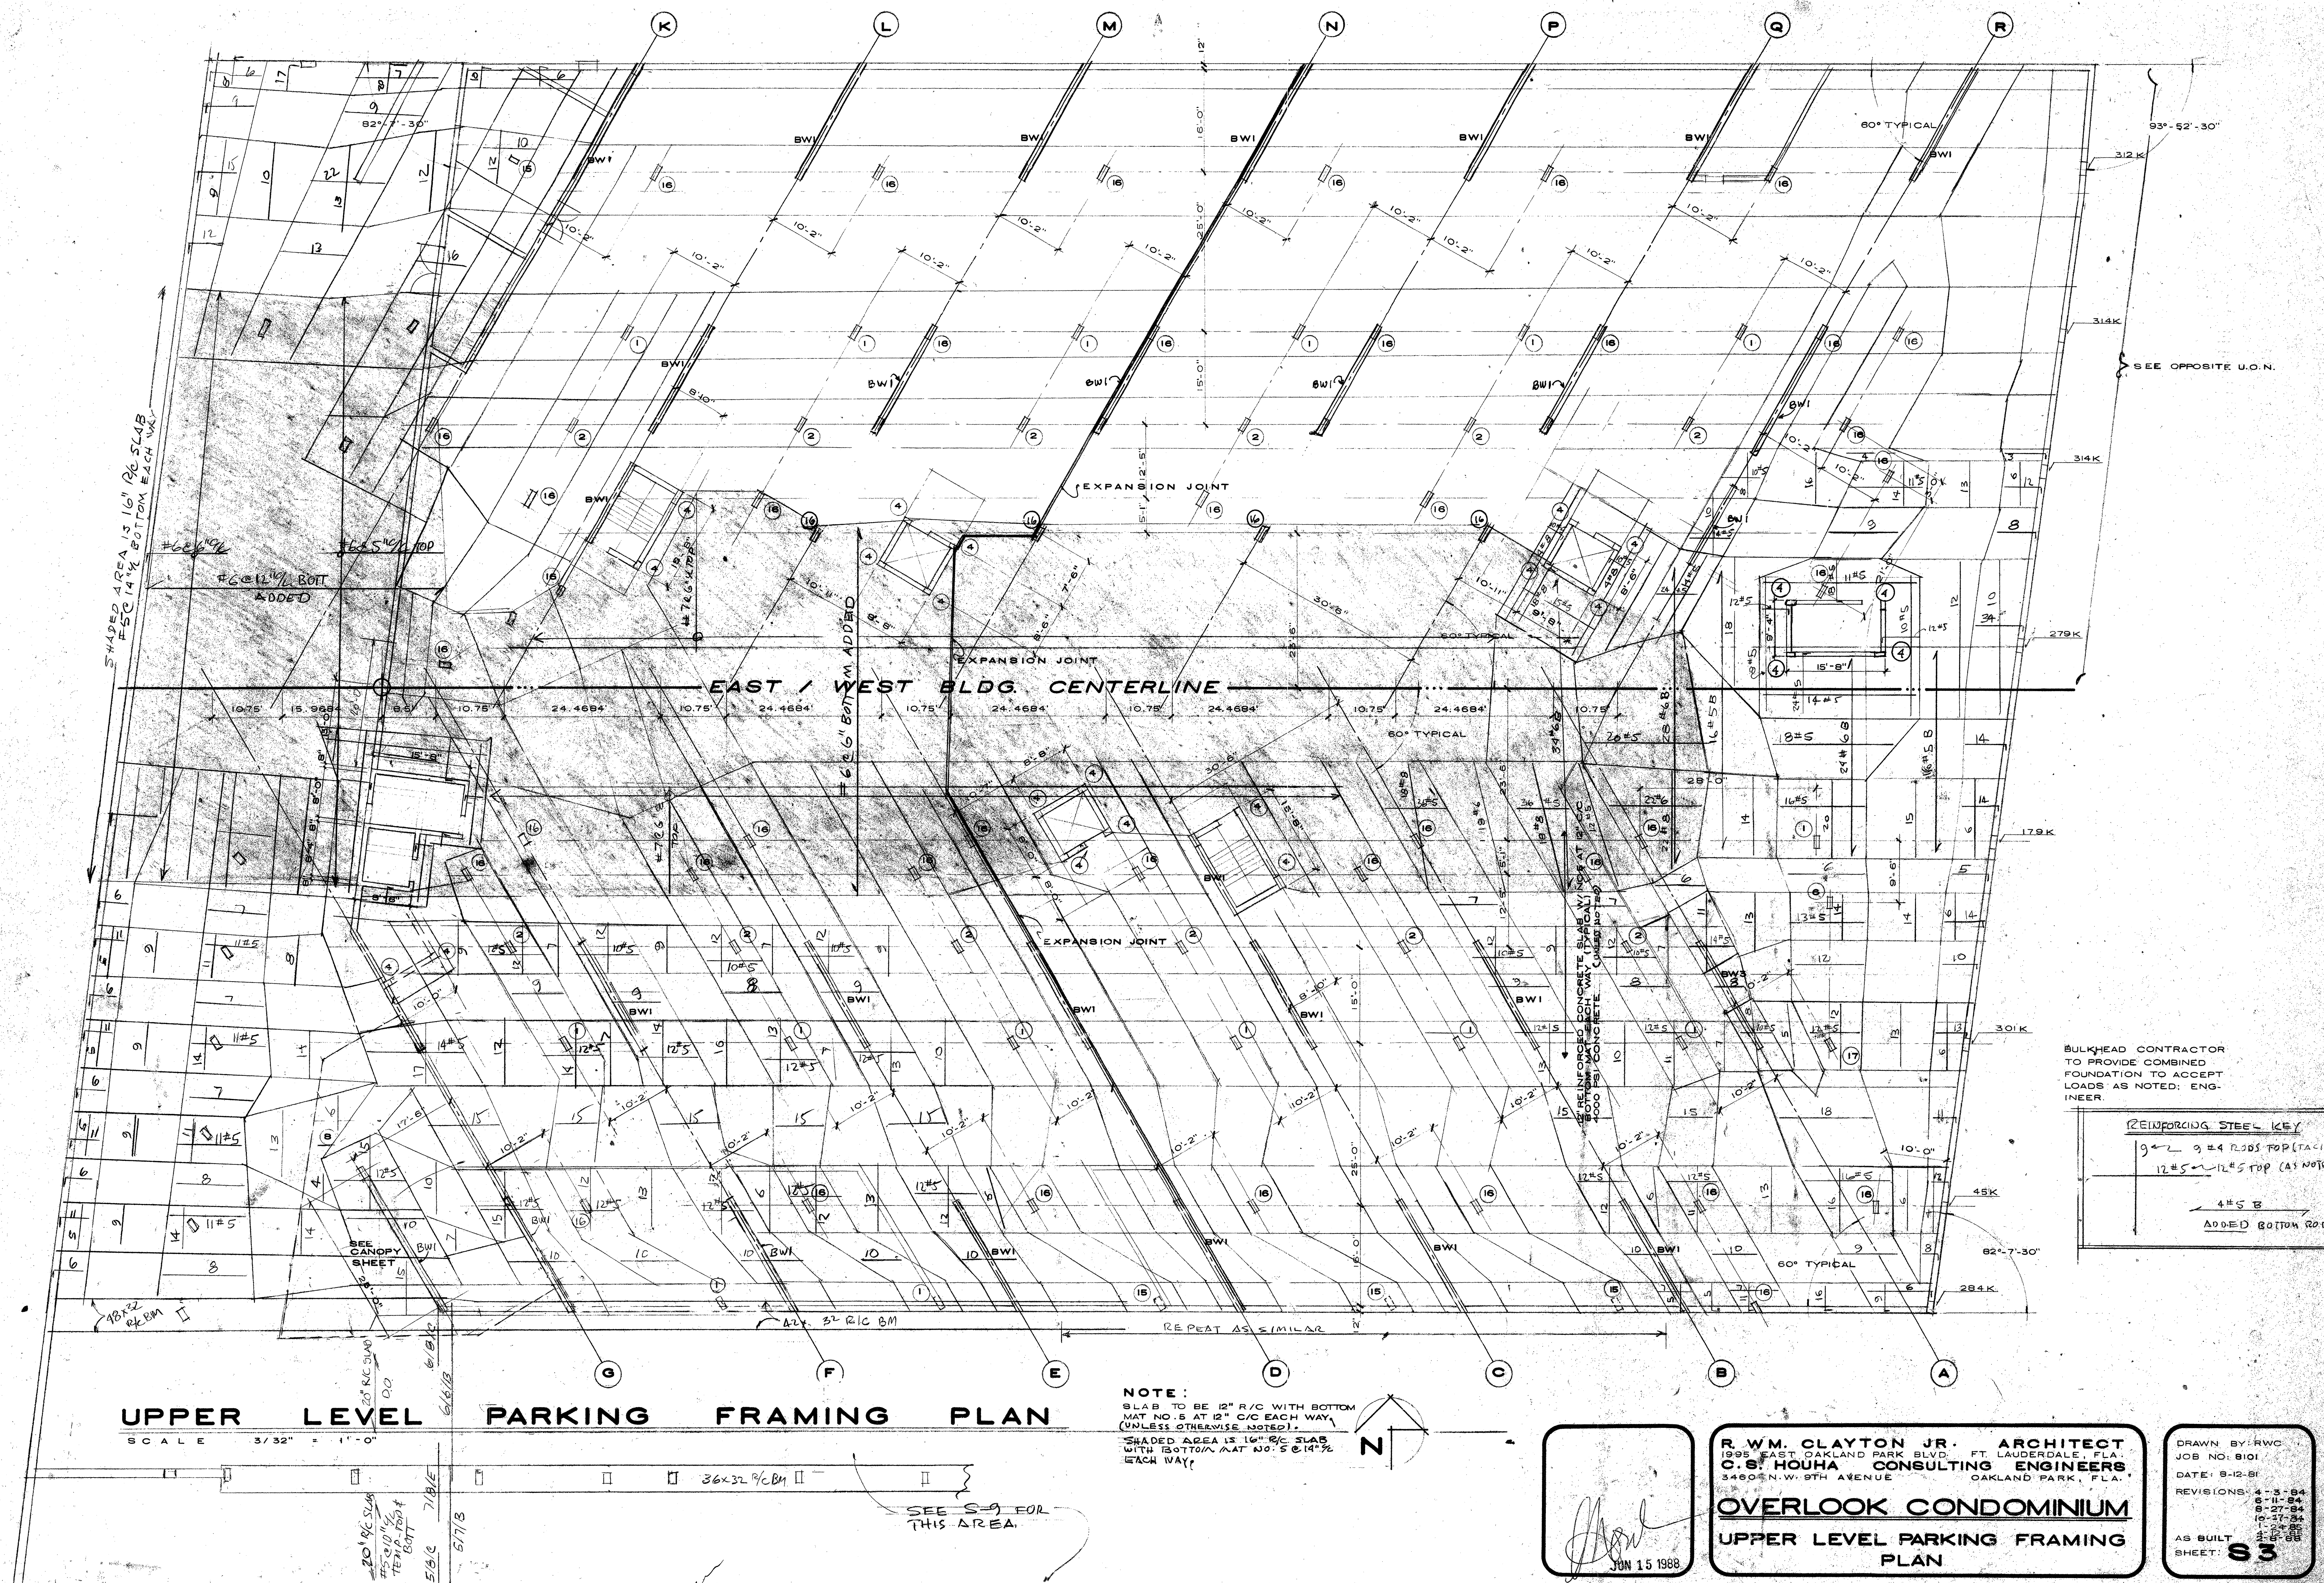

UPPER LEVEL PARKING FRAMING PLAN

SCALE 3/32" = 1'-0"

NOTE:
SLAB TO BE 12" R/C WITH BOTTOM MAT NO. 5 AT 12" C/C EACH WAY (UNLESS OTHERWISE NOTED).
SHADED AREA IS 16" R/C SLAB WITH BOTTOM MAT NO. 5 @ 14" EACH WAY.

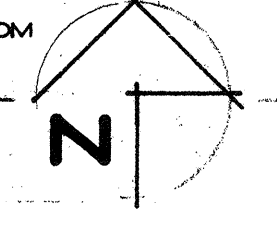

BULKHEAD CONTRACTOR TO PROVIDE COMBINED FOUNDATION TO ACCEPT LOADS AS NOTED: ENGINEER.

REINFORCING STEEL KEY	
9# 4 R/S TOP (TYPICAL)	
12# 5 - 12# 5 TOP (AS NOTED)	
4# 5 B	
ADDED BOTTOM R/S	

[Signature]
JUN 15 1988

R. WM. CLAYTON JR. ARCHITECT
1995 EAST OAKLAND PARK BLVD. FT. LAUDERDALE, FLA.
C. S. HOUHA CONSULTING ENGINEERS
3460 N.W. 9TH AVENUE OAKLAND PARK, FLA.

OVERLOOK CONDOMINIUM
UPPER LEVEL PARKING FRAMING PLAN

DRAWN BY: RWC
JOB NO: 8101
DATE: 9-12-81
REVISIONS: 4-3-84
6-11-84
8-27-84
10-27-84
1-2-85
AS BUILT
SHEET: **S3**