




RF PLAN
STAIR 2

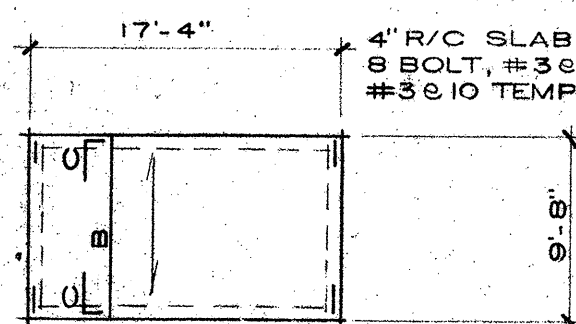


RF PLAN

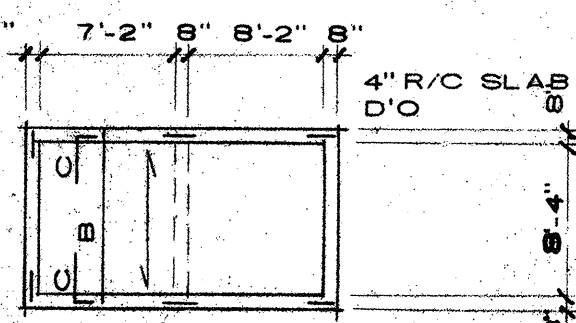


MACHINE RM PLAN
ELEVATOR 1-3-4

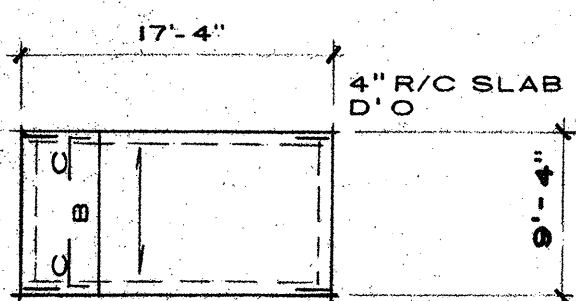


RF PLAN

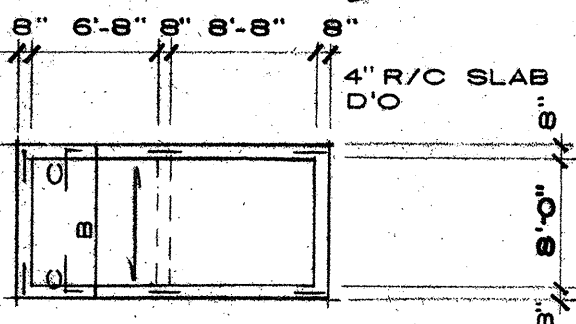

MACHINE RM PLAN
ELEV 2

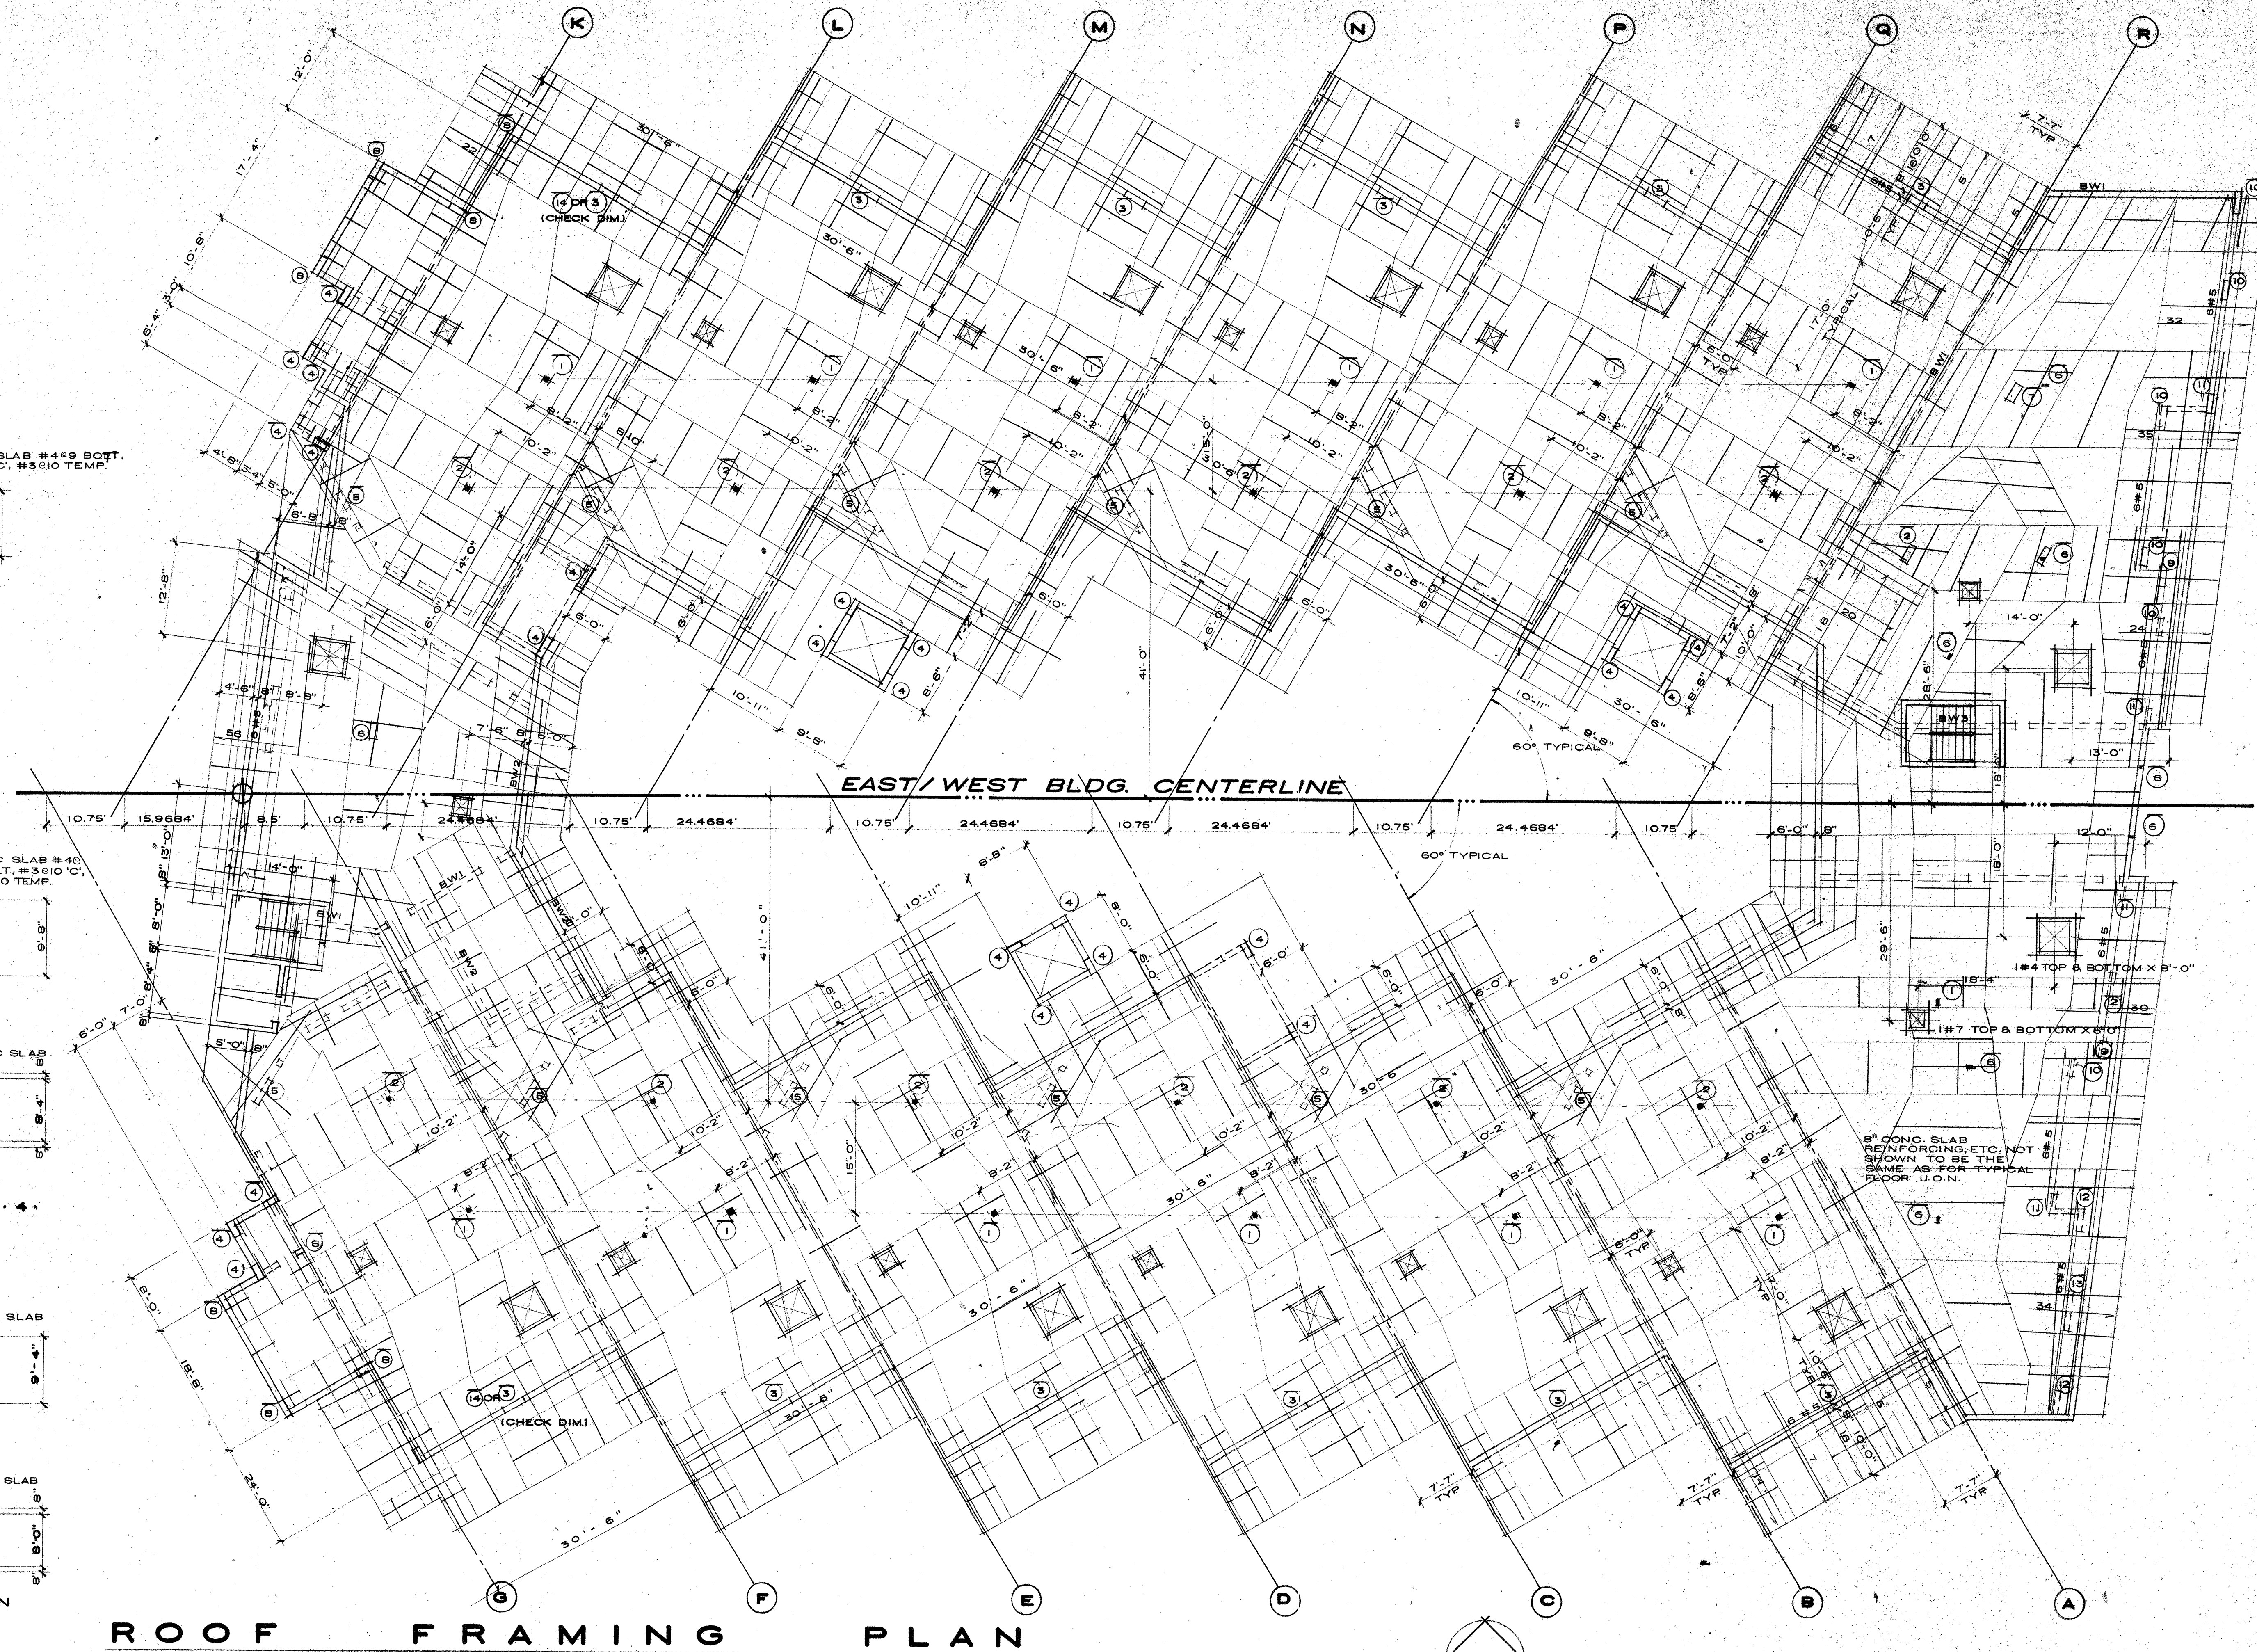

ROOF FRAMING PLAN

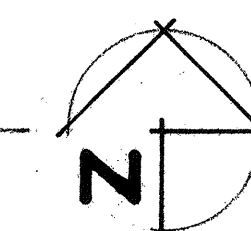

[Signature]
JUN 15 1988

R. WM. CLAYTON JR. ARCHITECT
1995 EAST OAKLAND PARK BLVD. FT. LAUDERDALE, FLA.
C. S. HOUHA CONSULTING ENGINEERS
3460 N.W. 9TH AVENUE OAKLAND PARK, FLA.

OVERLOOK CONDOMINIUM

ROOF FRAMING PLAN

DRAWN BY: RWC
JOB NO. 810
DATE: 8-12-81
REVISIONS: 4-3-84
8-11-84
AS BUILT 2-8-88
SHEET: **S6**