


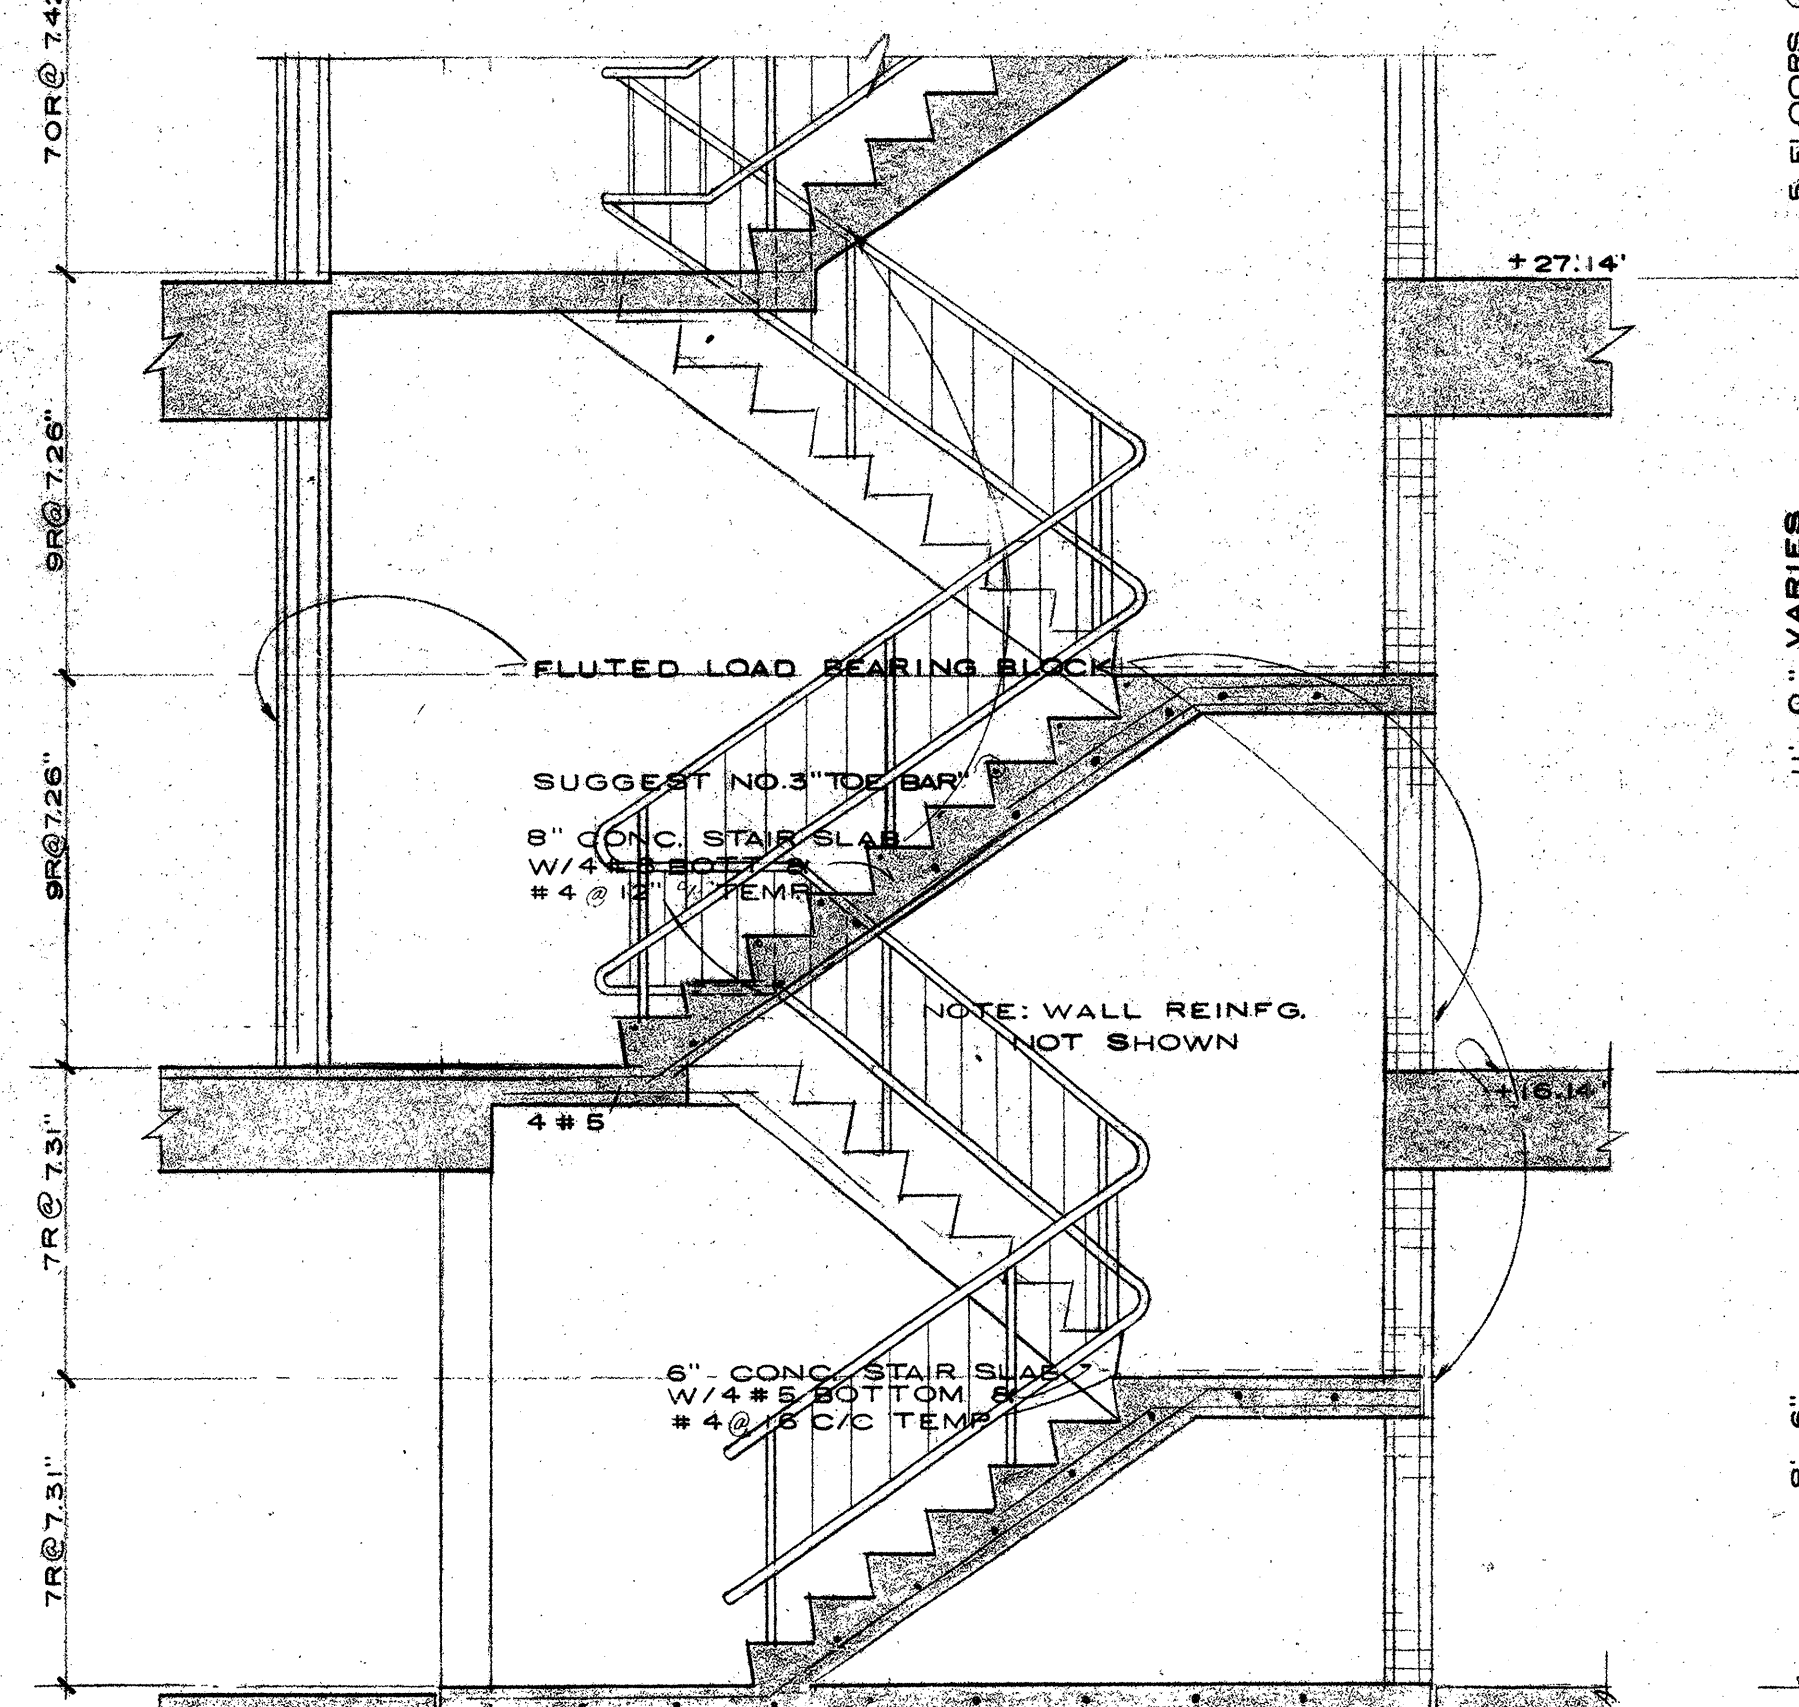
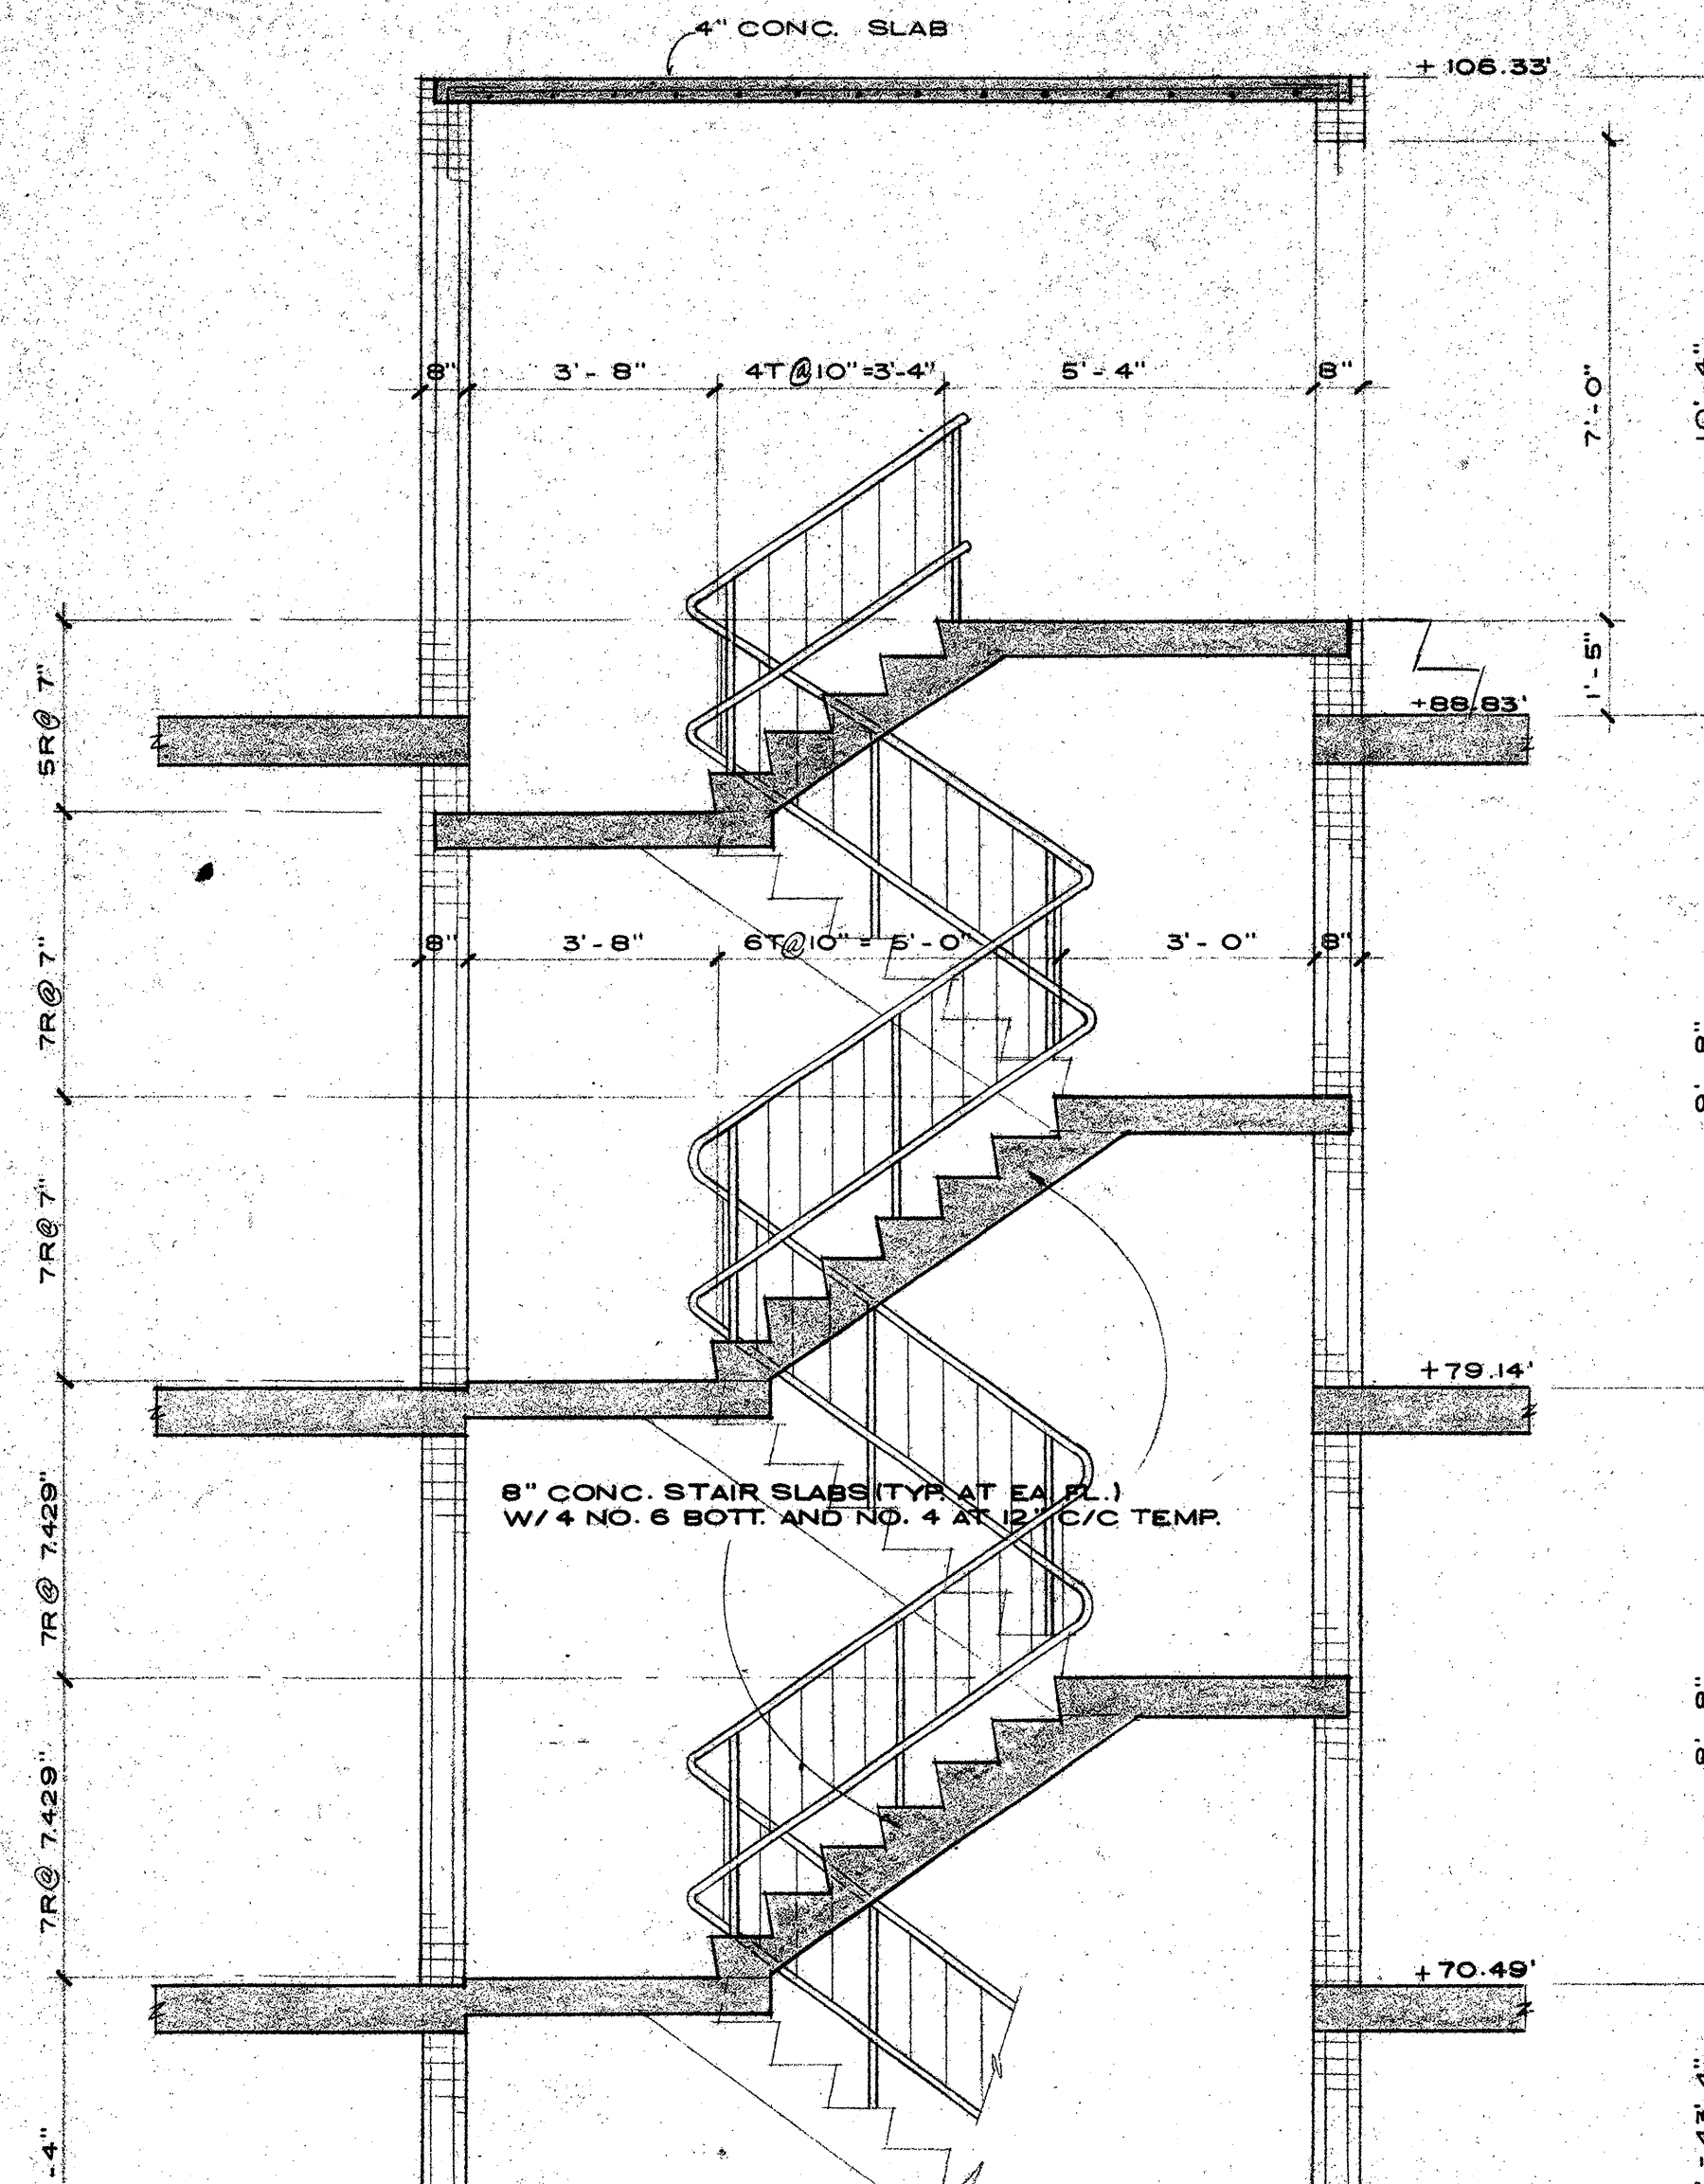


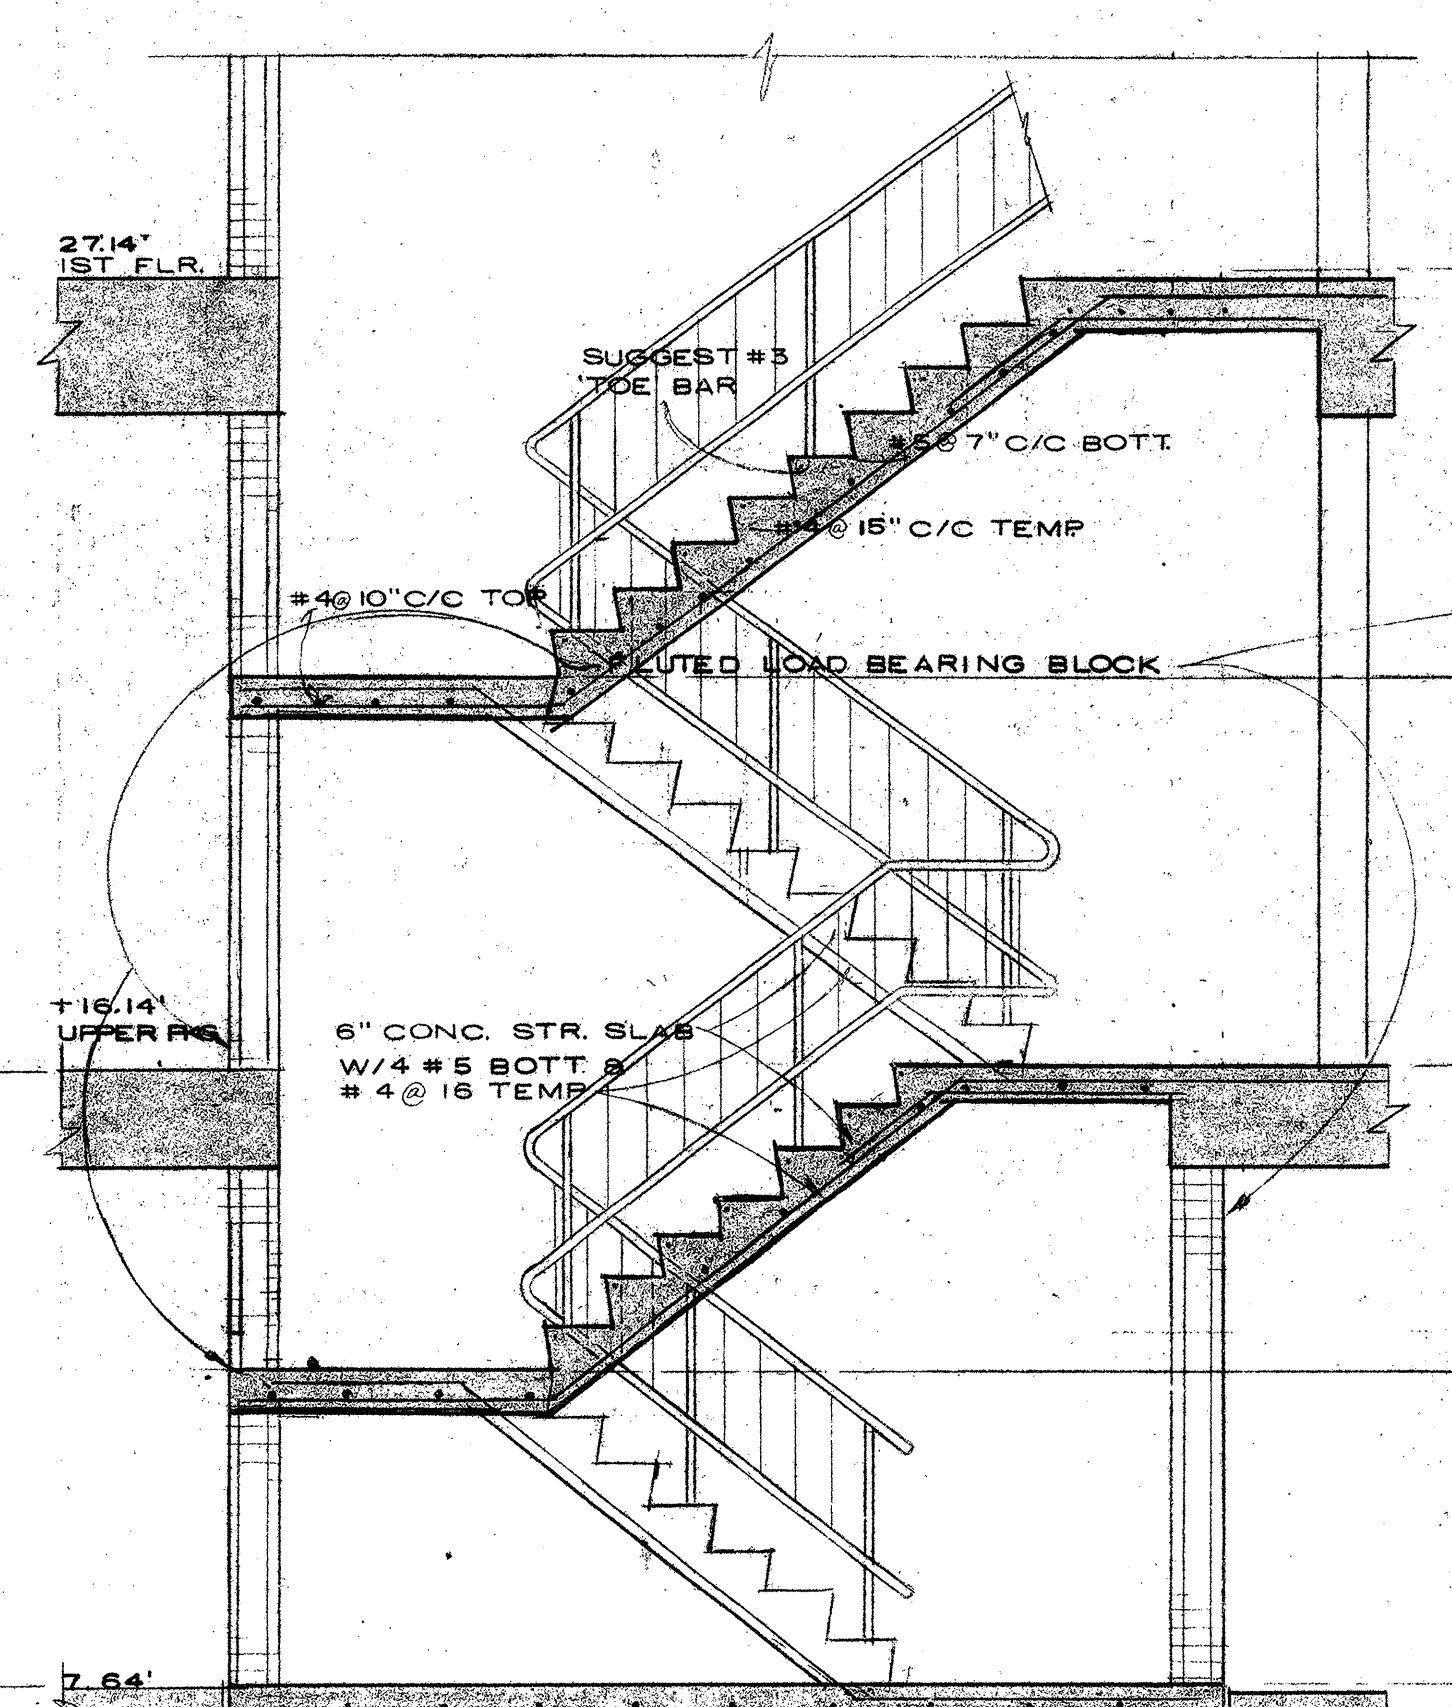

STAIR 3 & 4 SECTIONS
SCALE 3/8" = 1'-0"

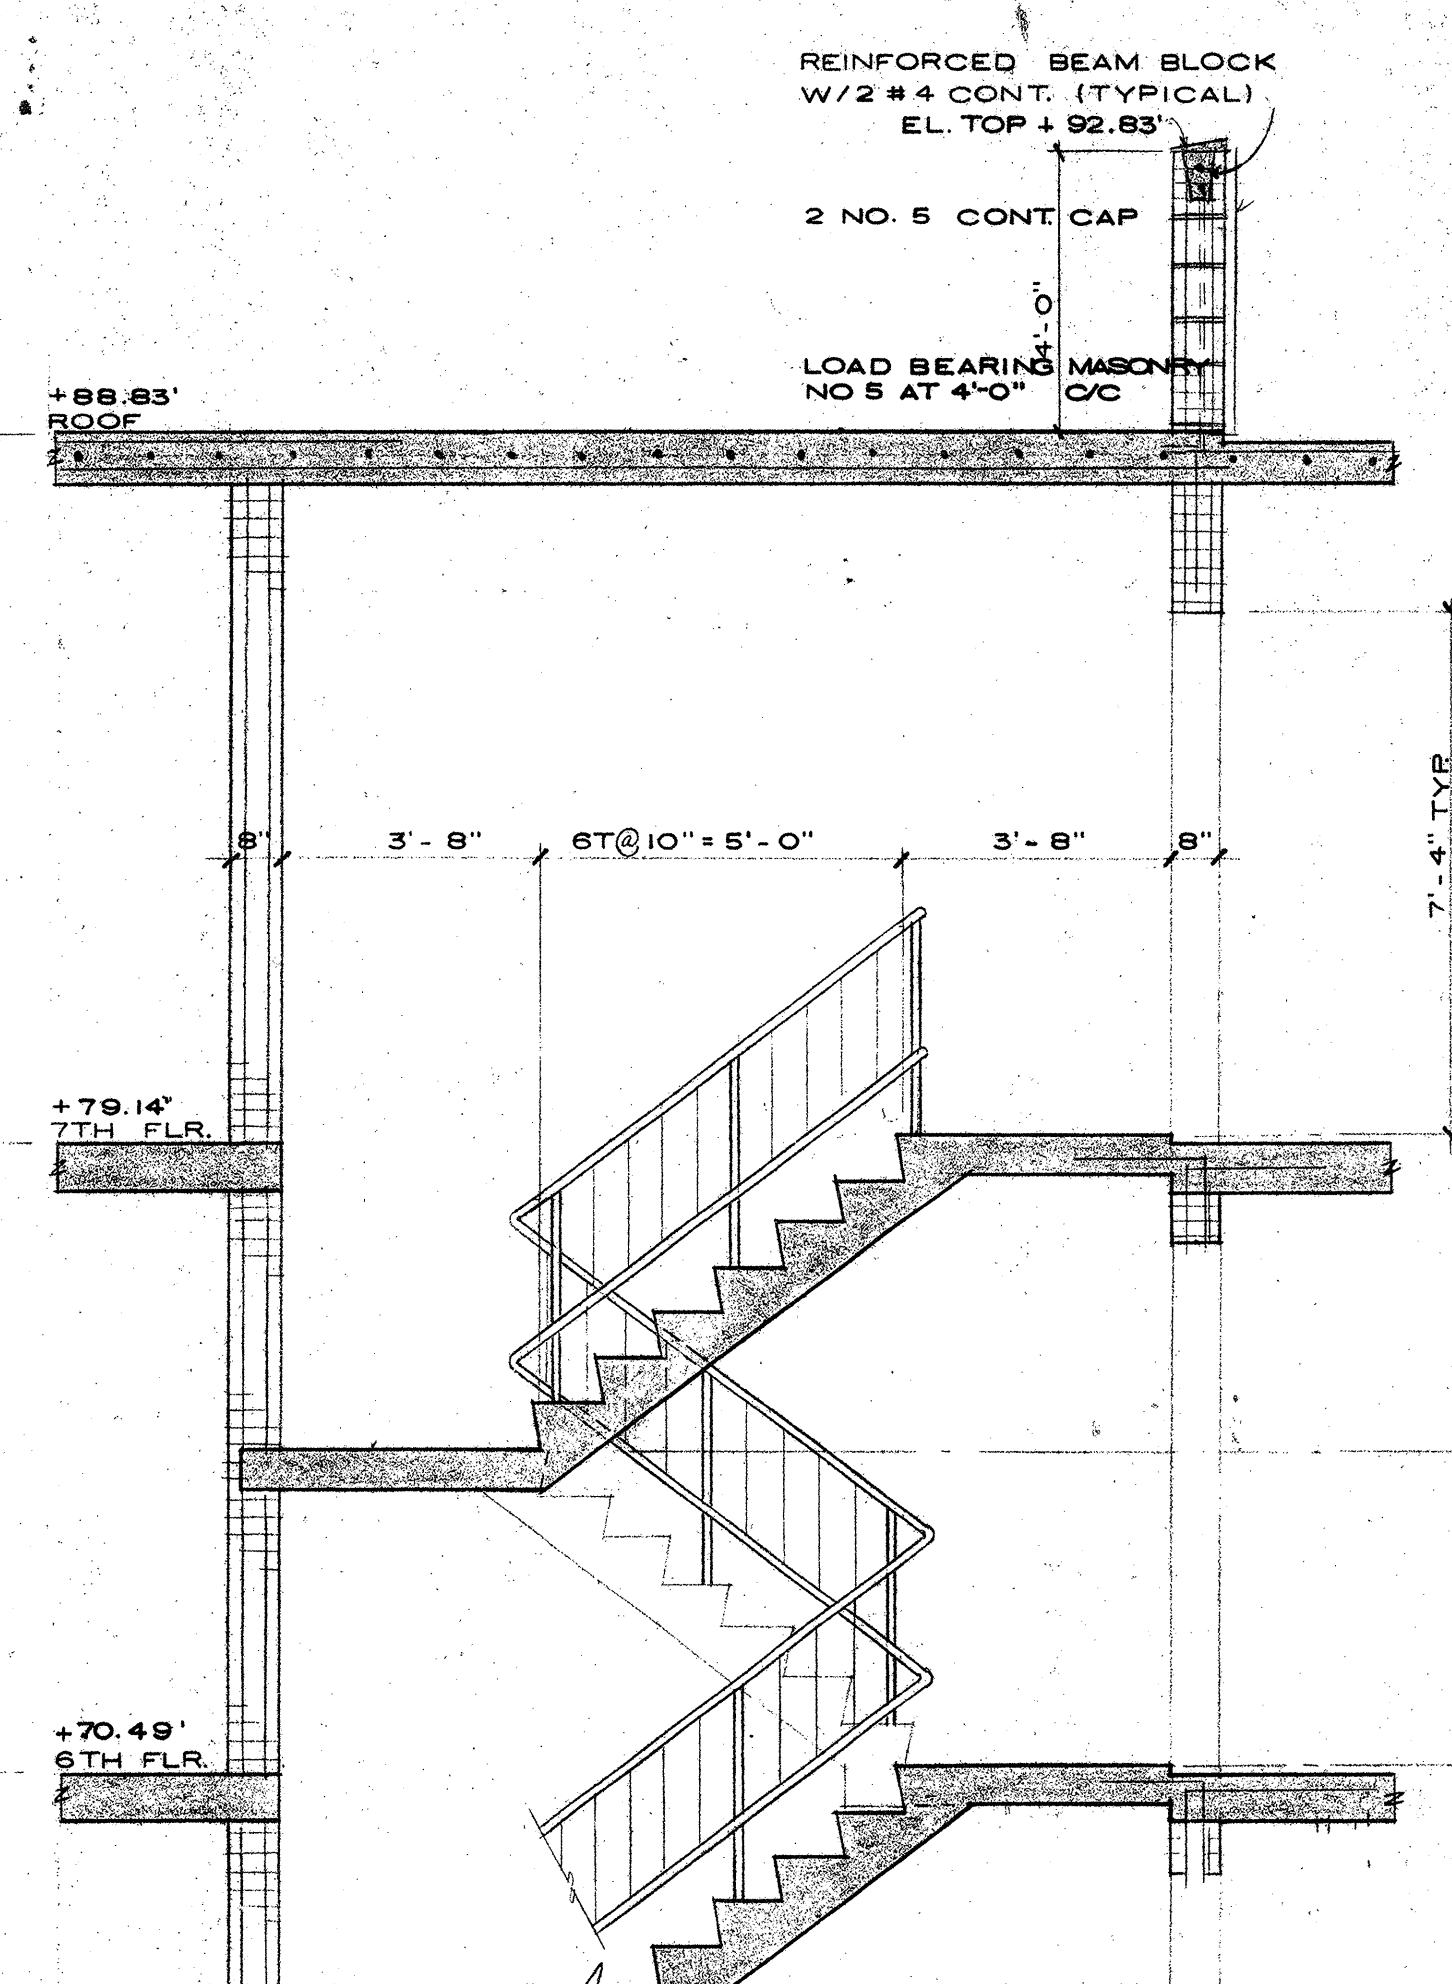

STAIR 1 & 2 SECTION
SCALE 3/8" = 1'-0"

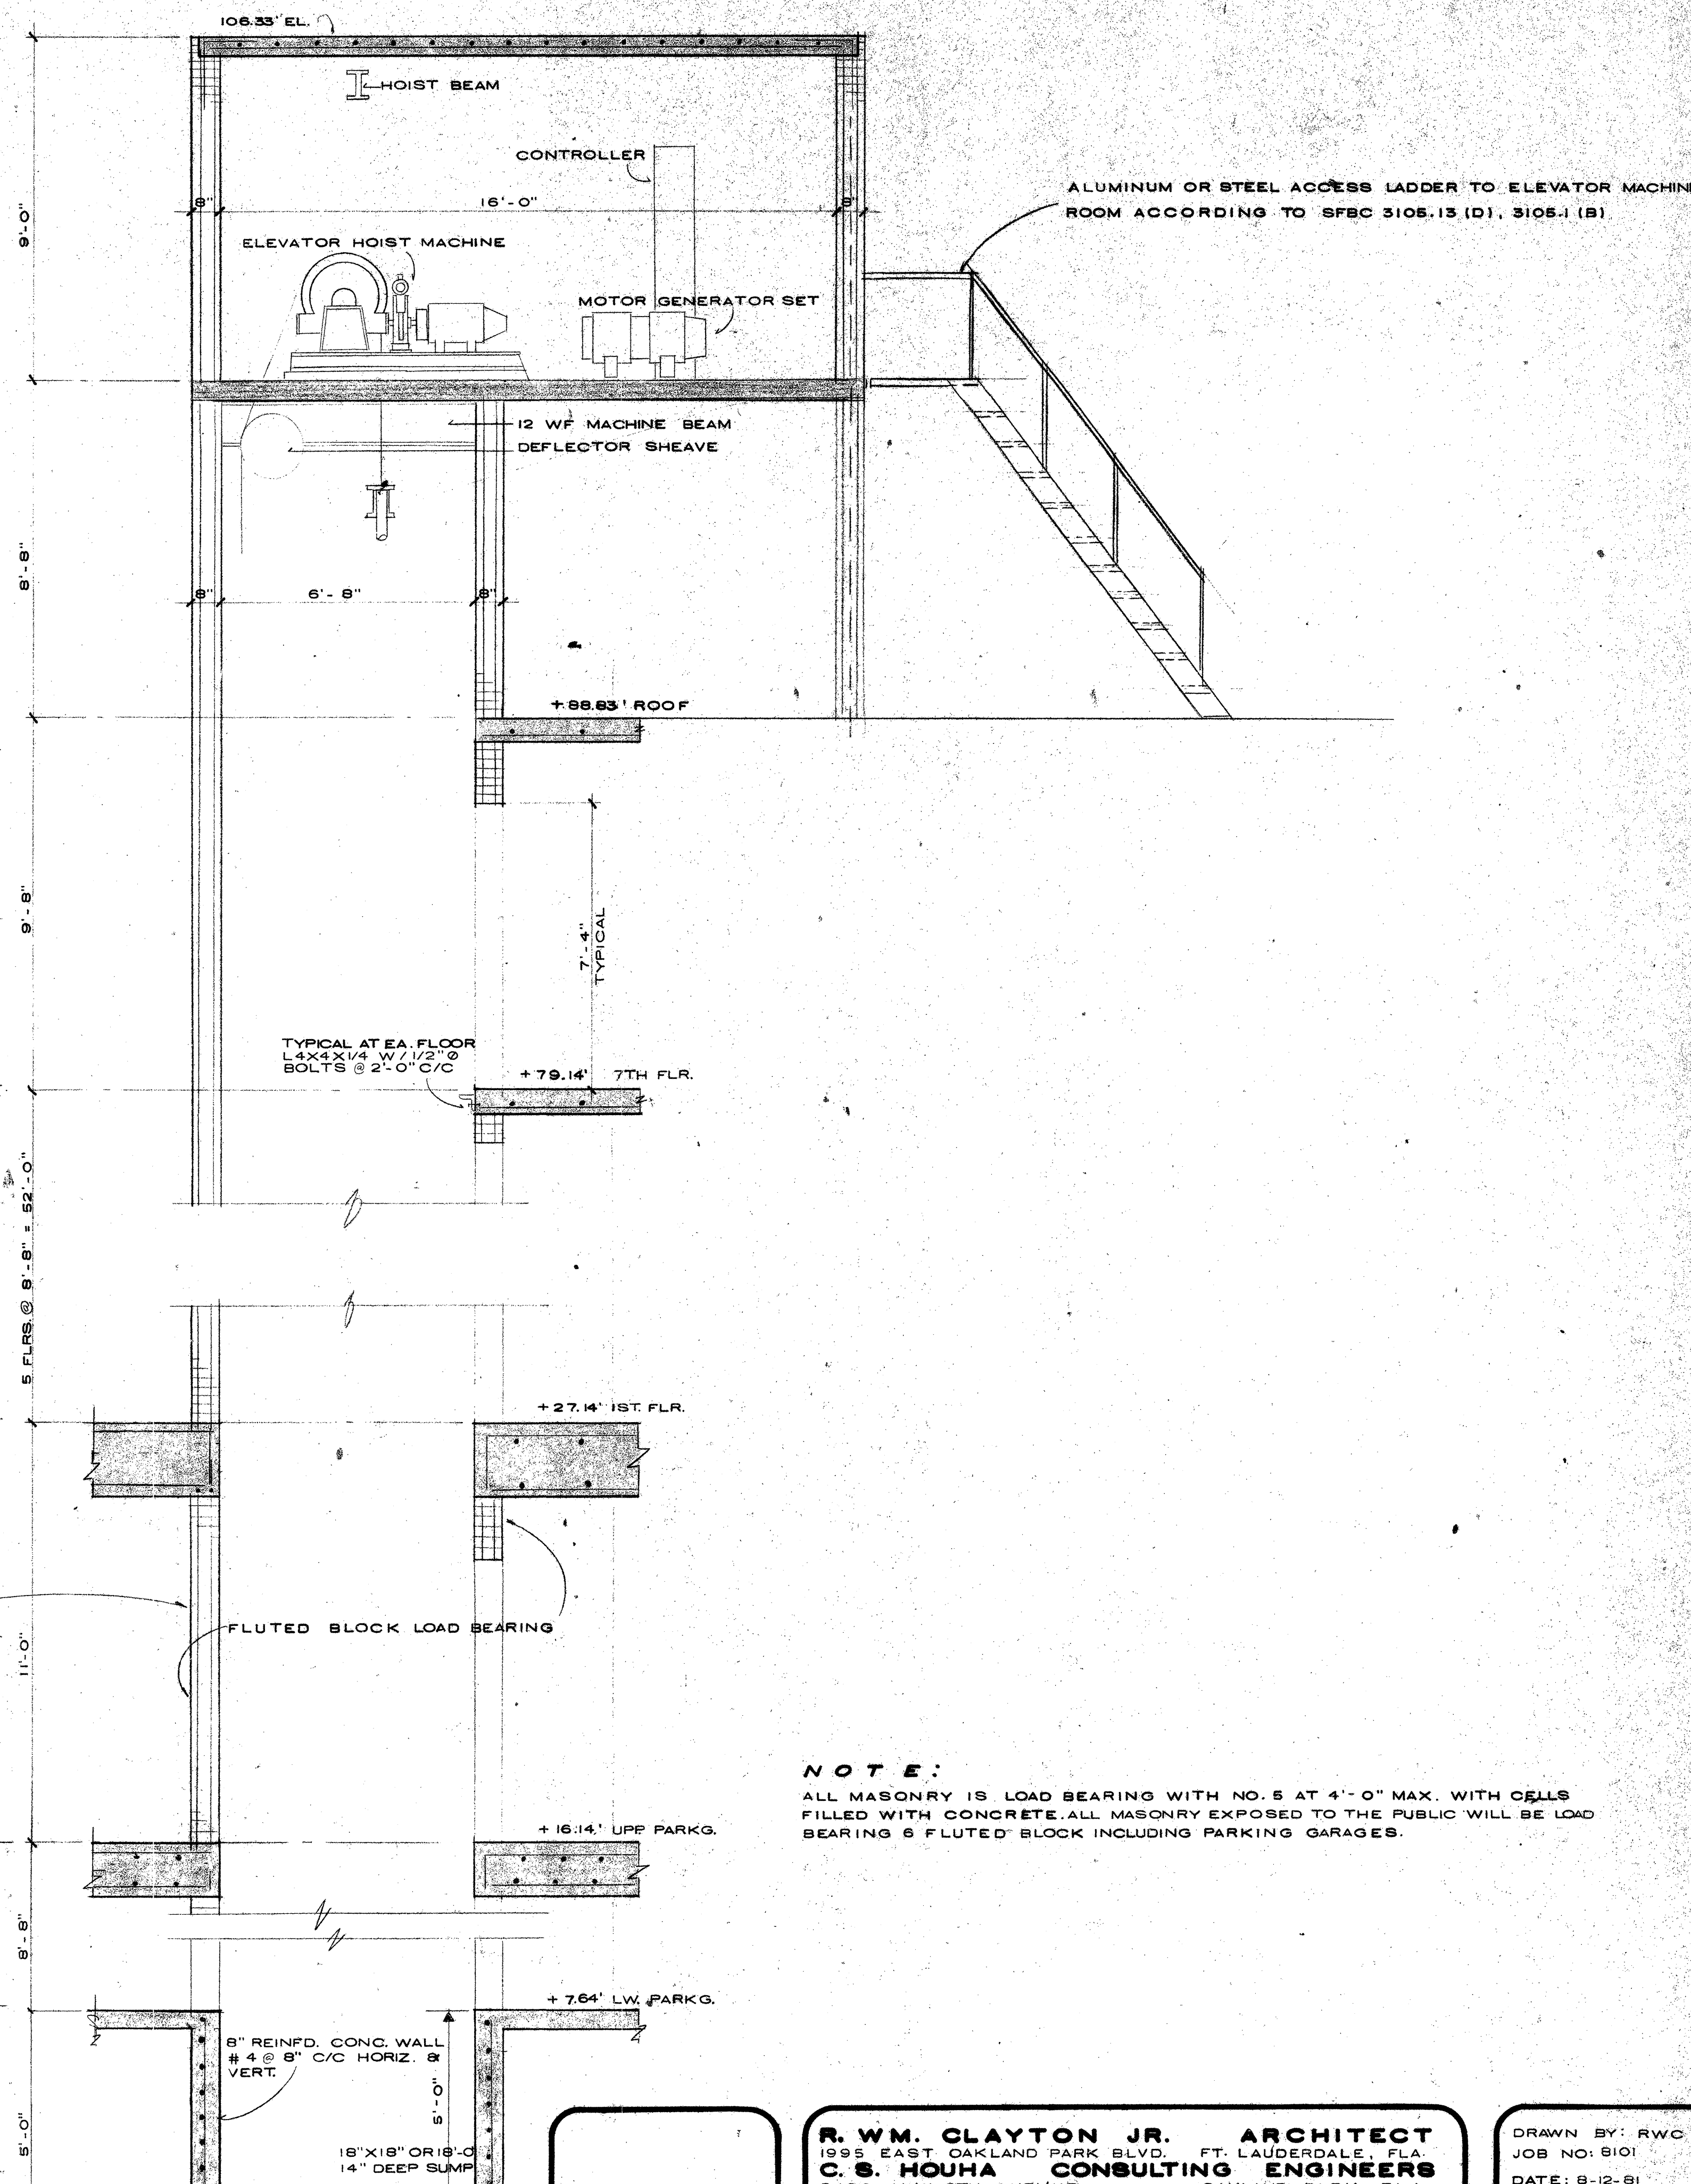

ELEV. 2,3 & 4 SECT.
SCALE 3/8" = 1'-0"

NOTE:
ALL MASONRY IS LOAD BEARING WITH NO. 5 AT 4'-0" MAX. WITH CELLS FILLED WITH CONCRETE. ALL MASONRY EXPOSED TO THE PUBLIC WILL BE LOAD BEARING 6" FLUTED BLOCK INCLUDING PARKING GARAGES.

Handwritten signature
JUN 15 1988

R. W. M. CLAYTON JR. ARCHITECT
1595 EAST OAKLAND PARK BLVD., FT. LAUDERDALE, FLA.
C. S. HOUHA CONSULTING ENGINEERS
3460 N.W. 9TH AVENUE OAKLAND PARK, FLA.

OVERLOOK CONDOMINIUM
STAIR & ELEV. SECT.

DRAWN BY: RWC
JOB NO: 8101
DATE: 8-12-81
REVISIONS: 4-3-84
6-11-84
AS BUILT 2-8-88
SHEET: **S7**