



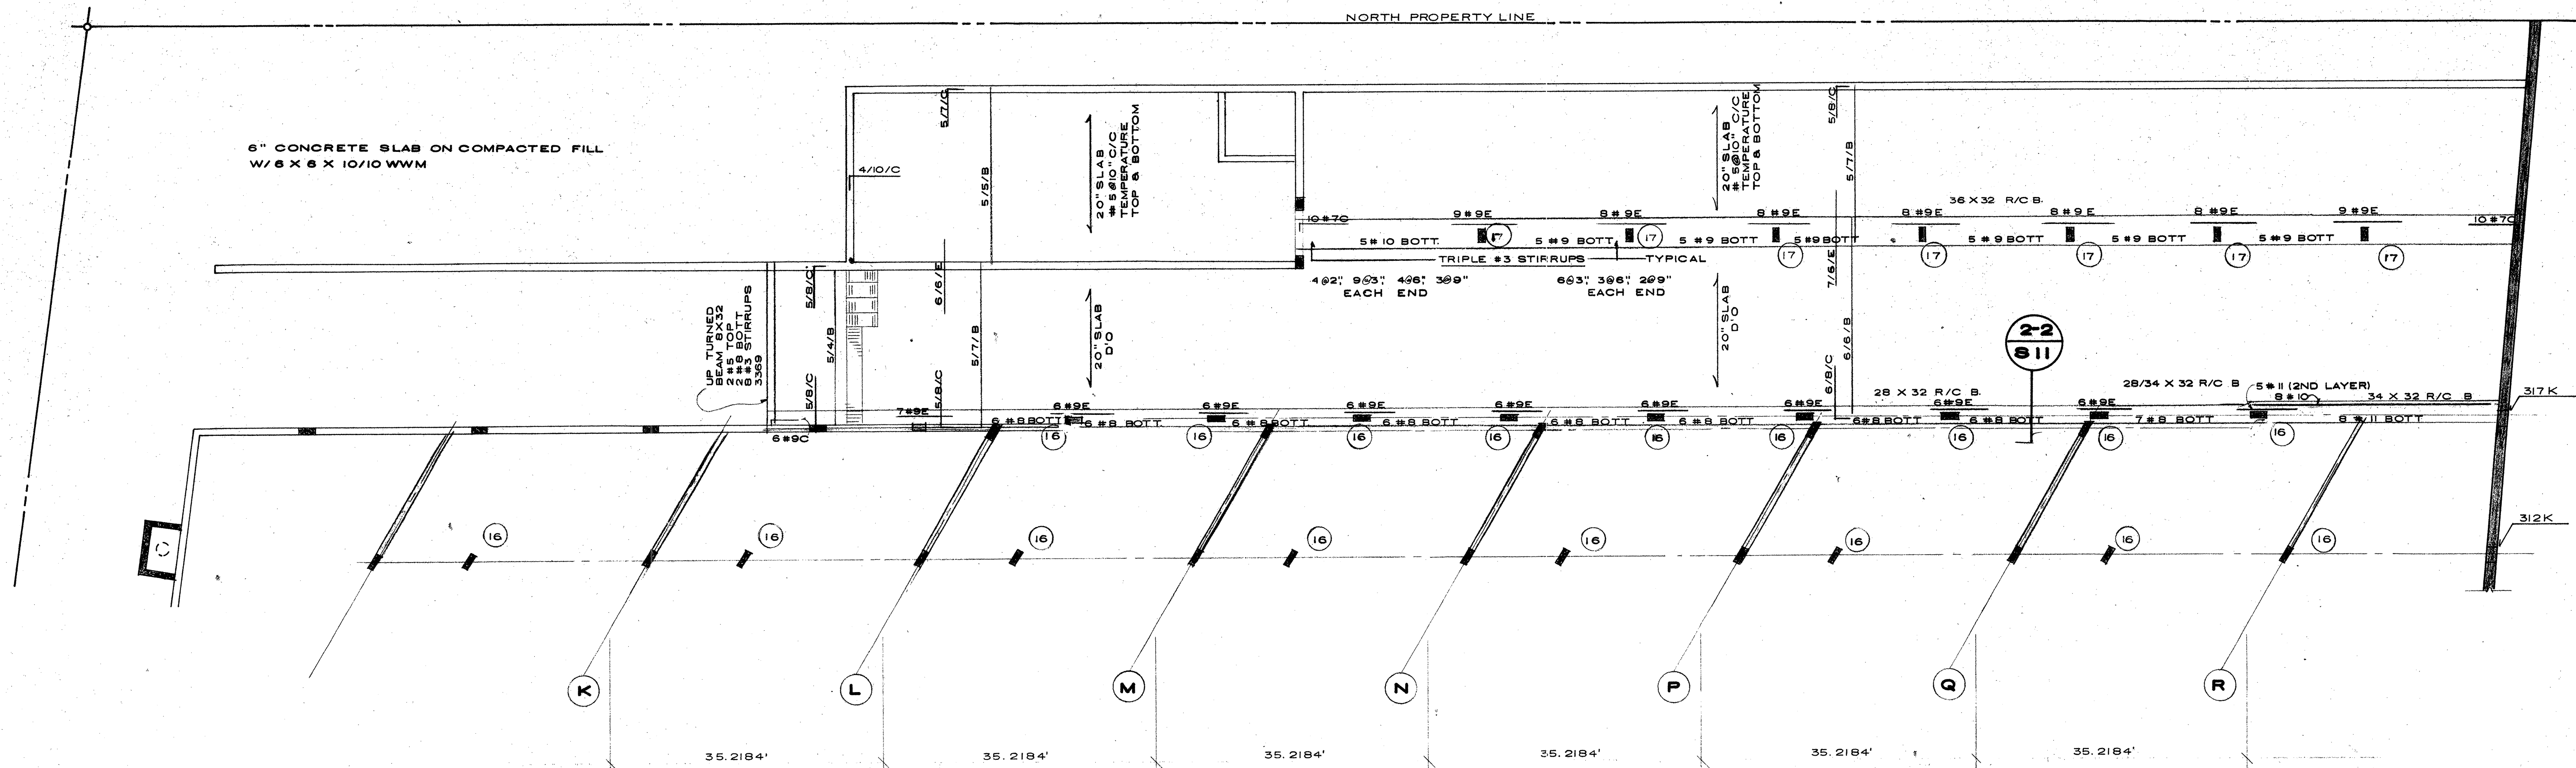


BEAM FRAMING PLAN FOR LOWER LEVEL PARKING - NORTH

SCALE: 3/32" = 1'-0"

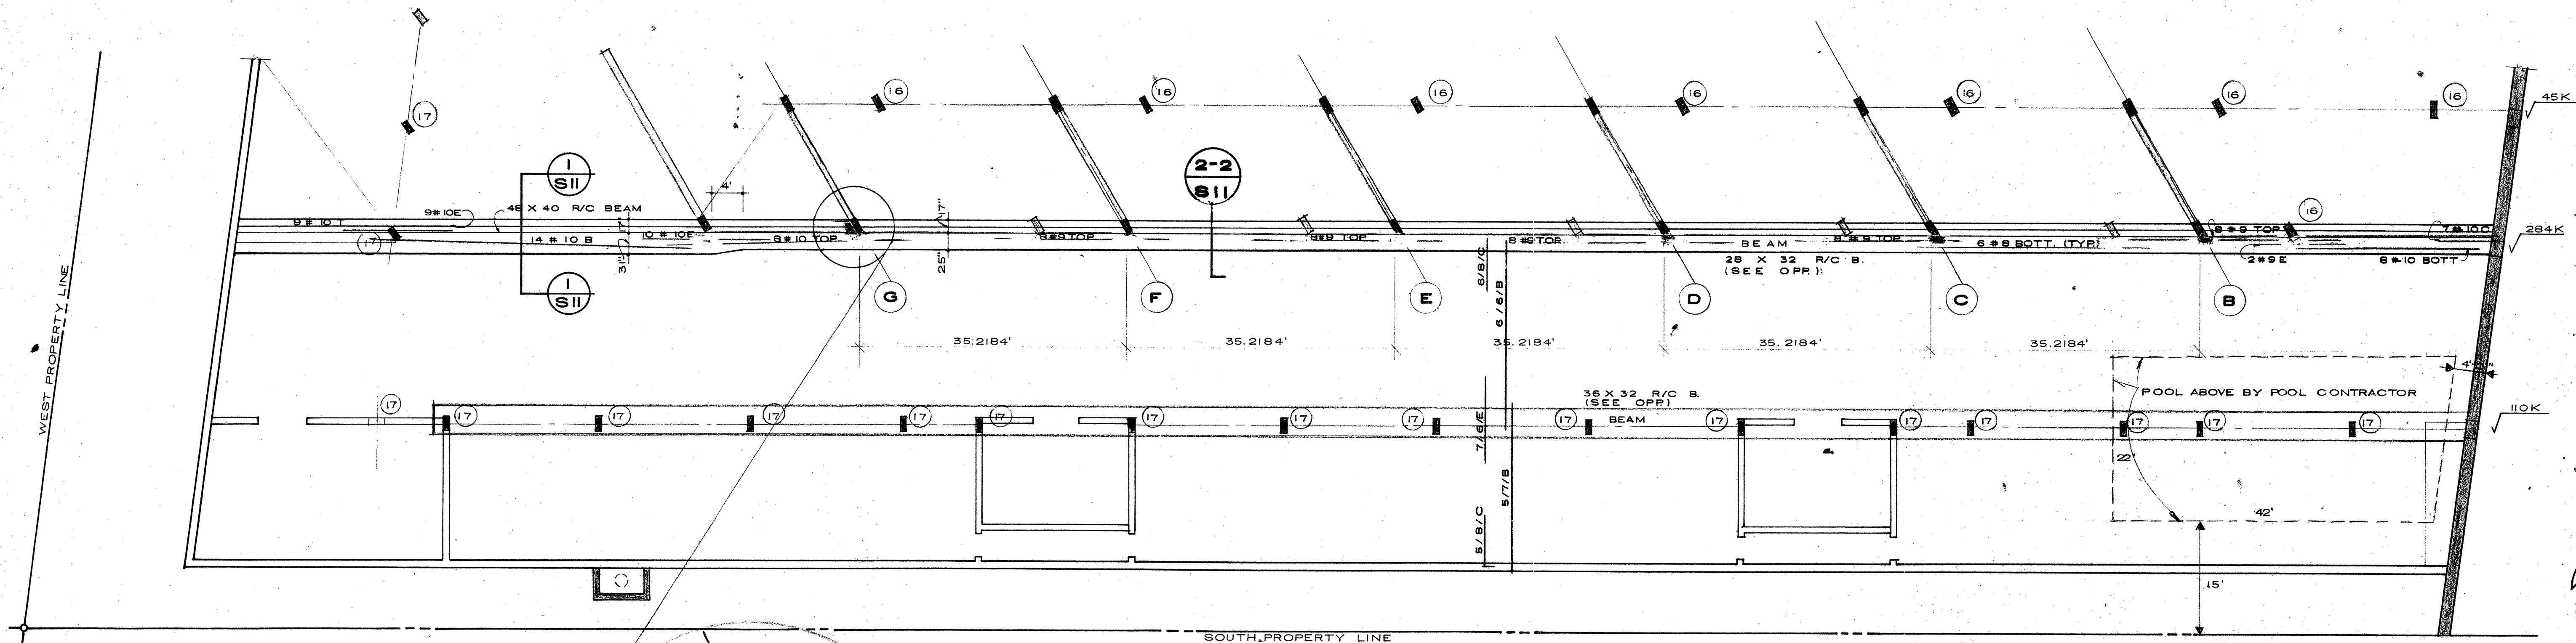

BEAM FRAMING PLAN FOR LOWER LEVEL PARKING - SOUTH

SCALE: 3/32" = 1'-0"

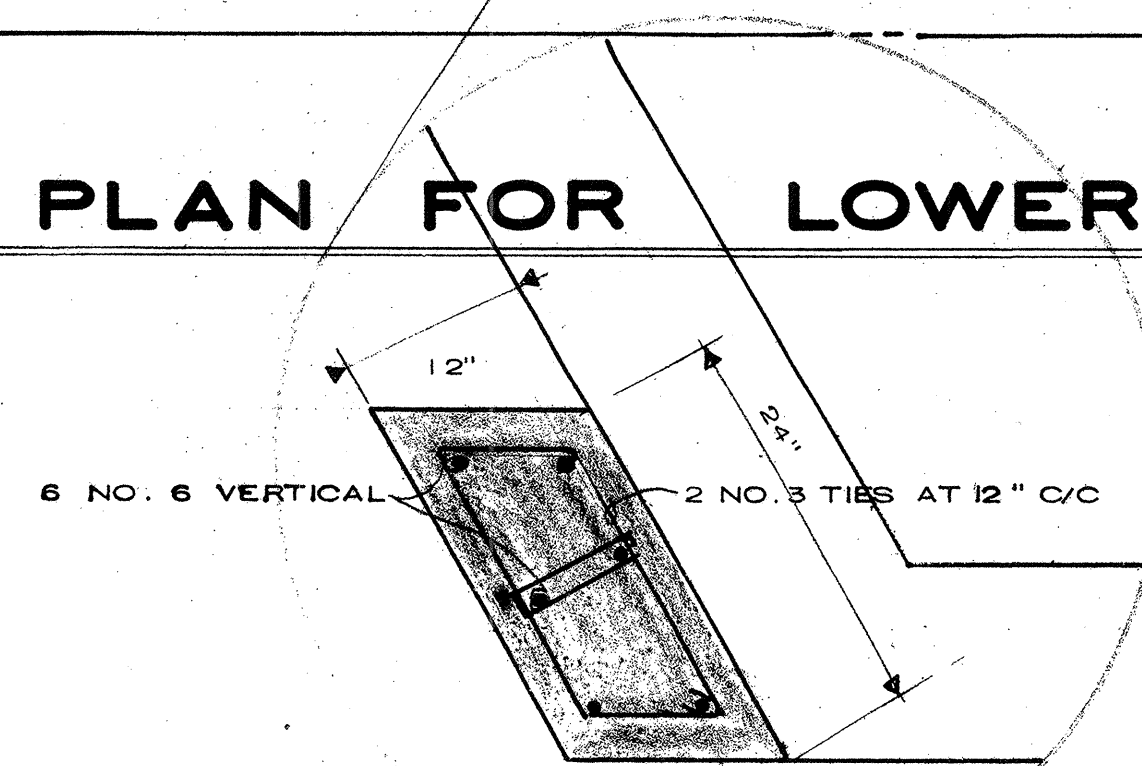

ADDED COLUMN DETAIL
SCALE: 1" = 1'-0"

[Signature]
JUN 15 1988

R. WM. CLAYTON JR. ARCHITECT
1995 EAST OAKLAND PARK BLVD. FT. LAUDERDALE, FLA.
C. S. HOUHA CONSULTING ENGINEERS
3460 N.W. 9TH AVENUE OAKLAND PARK, FLA.

OVERLOOK CONDOMINIUM
BEAM FRAMING PLAN FOR LOWER LEVEL PARKING

DRAWN BY: JAS
JOB NO: 8101
DATE: 8-12-81
REVISIONS: 4-3-84
6-11-84
4-12-85
4-26-85
AS BUILT 2-8-88
SHEET: **S9**