

SEPTIC TANK INSPECTION RECORD

Southgate

Code

Sanitation Division

5-14-71

Gaston County Health Department

Date

Rhyme Wong

Owner

J Carson

Permit By

OCCUPANT For sale

OWNER

Rhyme Wong

LOCATION

Southgate, wood bridge drive, 1/2 way down Roseboro Lane, turn right will be 3rd house on left

DESIGNED FOR:

3 Bedrooms, Washing Machine, Garbage Disposal; not more than 6 persons

SEPTIC TANK: Liquid capacity

1000

gallons; type, construction

precast concrete. (Leonard M. Shuman mfgr.)

NITRIFICATION FIELD:

30

feet of 30 inch ditch:

4

lines in

1

bed(s)

75 feet long

feet wide.

4

inch concrete terra cotta drain tile:

8

inches of crushed stone, tuff-lite with

6

inches under tile.

SAND FILTER:

feet long

feet wide with

lines on top and

lines on

bottom. inch tile.

WATER SUPPLY:

Municipal

Semi-private

Private

CONTRACTOR:


Leon Beas

INSPECTED BY:

J Carson

WSB

LOCATION

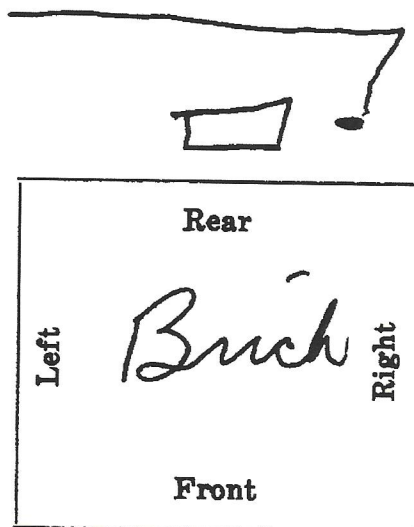

HOUSE SEWER: 25 feet from right, left, front, rear corner.

SEPTIC TANK: Front, rear, right side, left side of building. Perpendicular, parallel, angle 6 feet from building.

DISTRIBUTION BOX: 4 feet from end, side, corner of septic tank.

NITRIFICATION FIELD OR FILTER: 7 feet from building at nearest point.

WELL (IF ANY): 100 ft feet from septic tank and 100 ft feet from disposal field.

SOIL APPEARANCE: Average, above average, poor.

REMARKS: _____

